

PWO:TMO:dh
3 Nov 1976

From: Commanding General
To: Commander, Atlantic Division, Naval Facilities Engineering
Command, Norfolk, Virginia 235-11

Subj: Agreement NF(R)-14122 to Carolina Telephone and Telegraph
Company for use of 877 utility poles

Ref: (a) LANNAVFACENGCOM ltr 241:MLS over AO-54 of 24 Sep 1976,
same subj

Encl: (1) Telephone Division, CLINC Dwg. No. 2012, MCAS(H) Aerial
Cable Layout and Pole Placement (4 copies)

1. In compliance with reference (a), Carolina Telephone and Telegraph
Company has been contacted and the company desires to continue
Agreement NF(R)-14122.

2. Paragraph 1 of the subject agreement requires a change to reflect
the addition of 243 poles in the housing areas of the Marine Corps
Air Station (Helicopter), New River, as indicated in yellow on
enclosure (1).


3. Other terms of the agreement should remain the same, although an
increase in use charges would be in order due to the increase in
maintenance and pole replacement cost.

R. A. EARNST
By direction


Blind copy to:
AC/S, Fac (w/ encl)
BMaintO (w/o encl)

Handwritten: Design




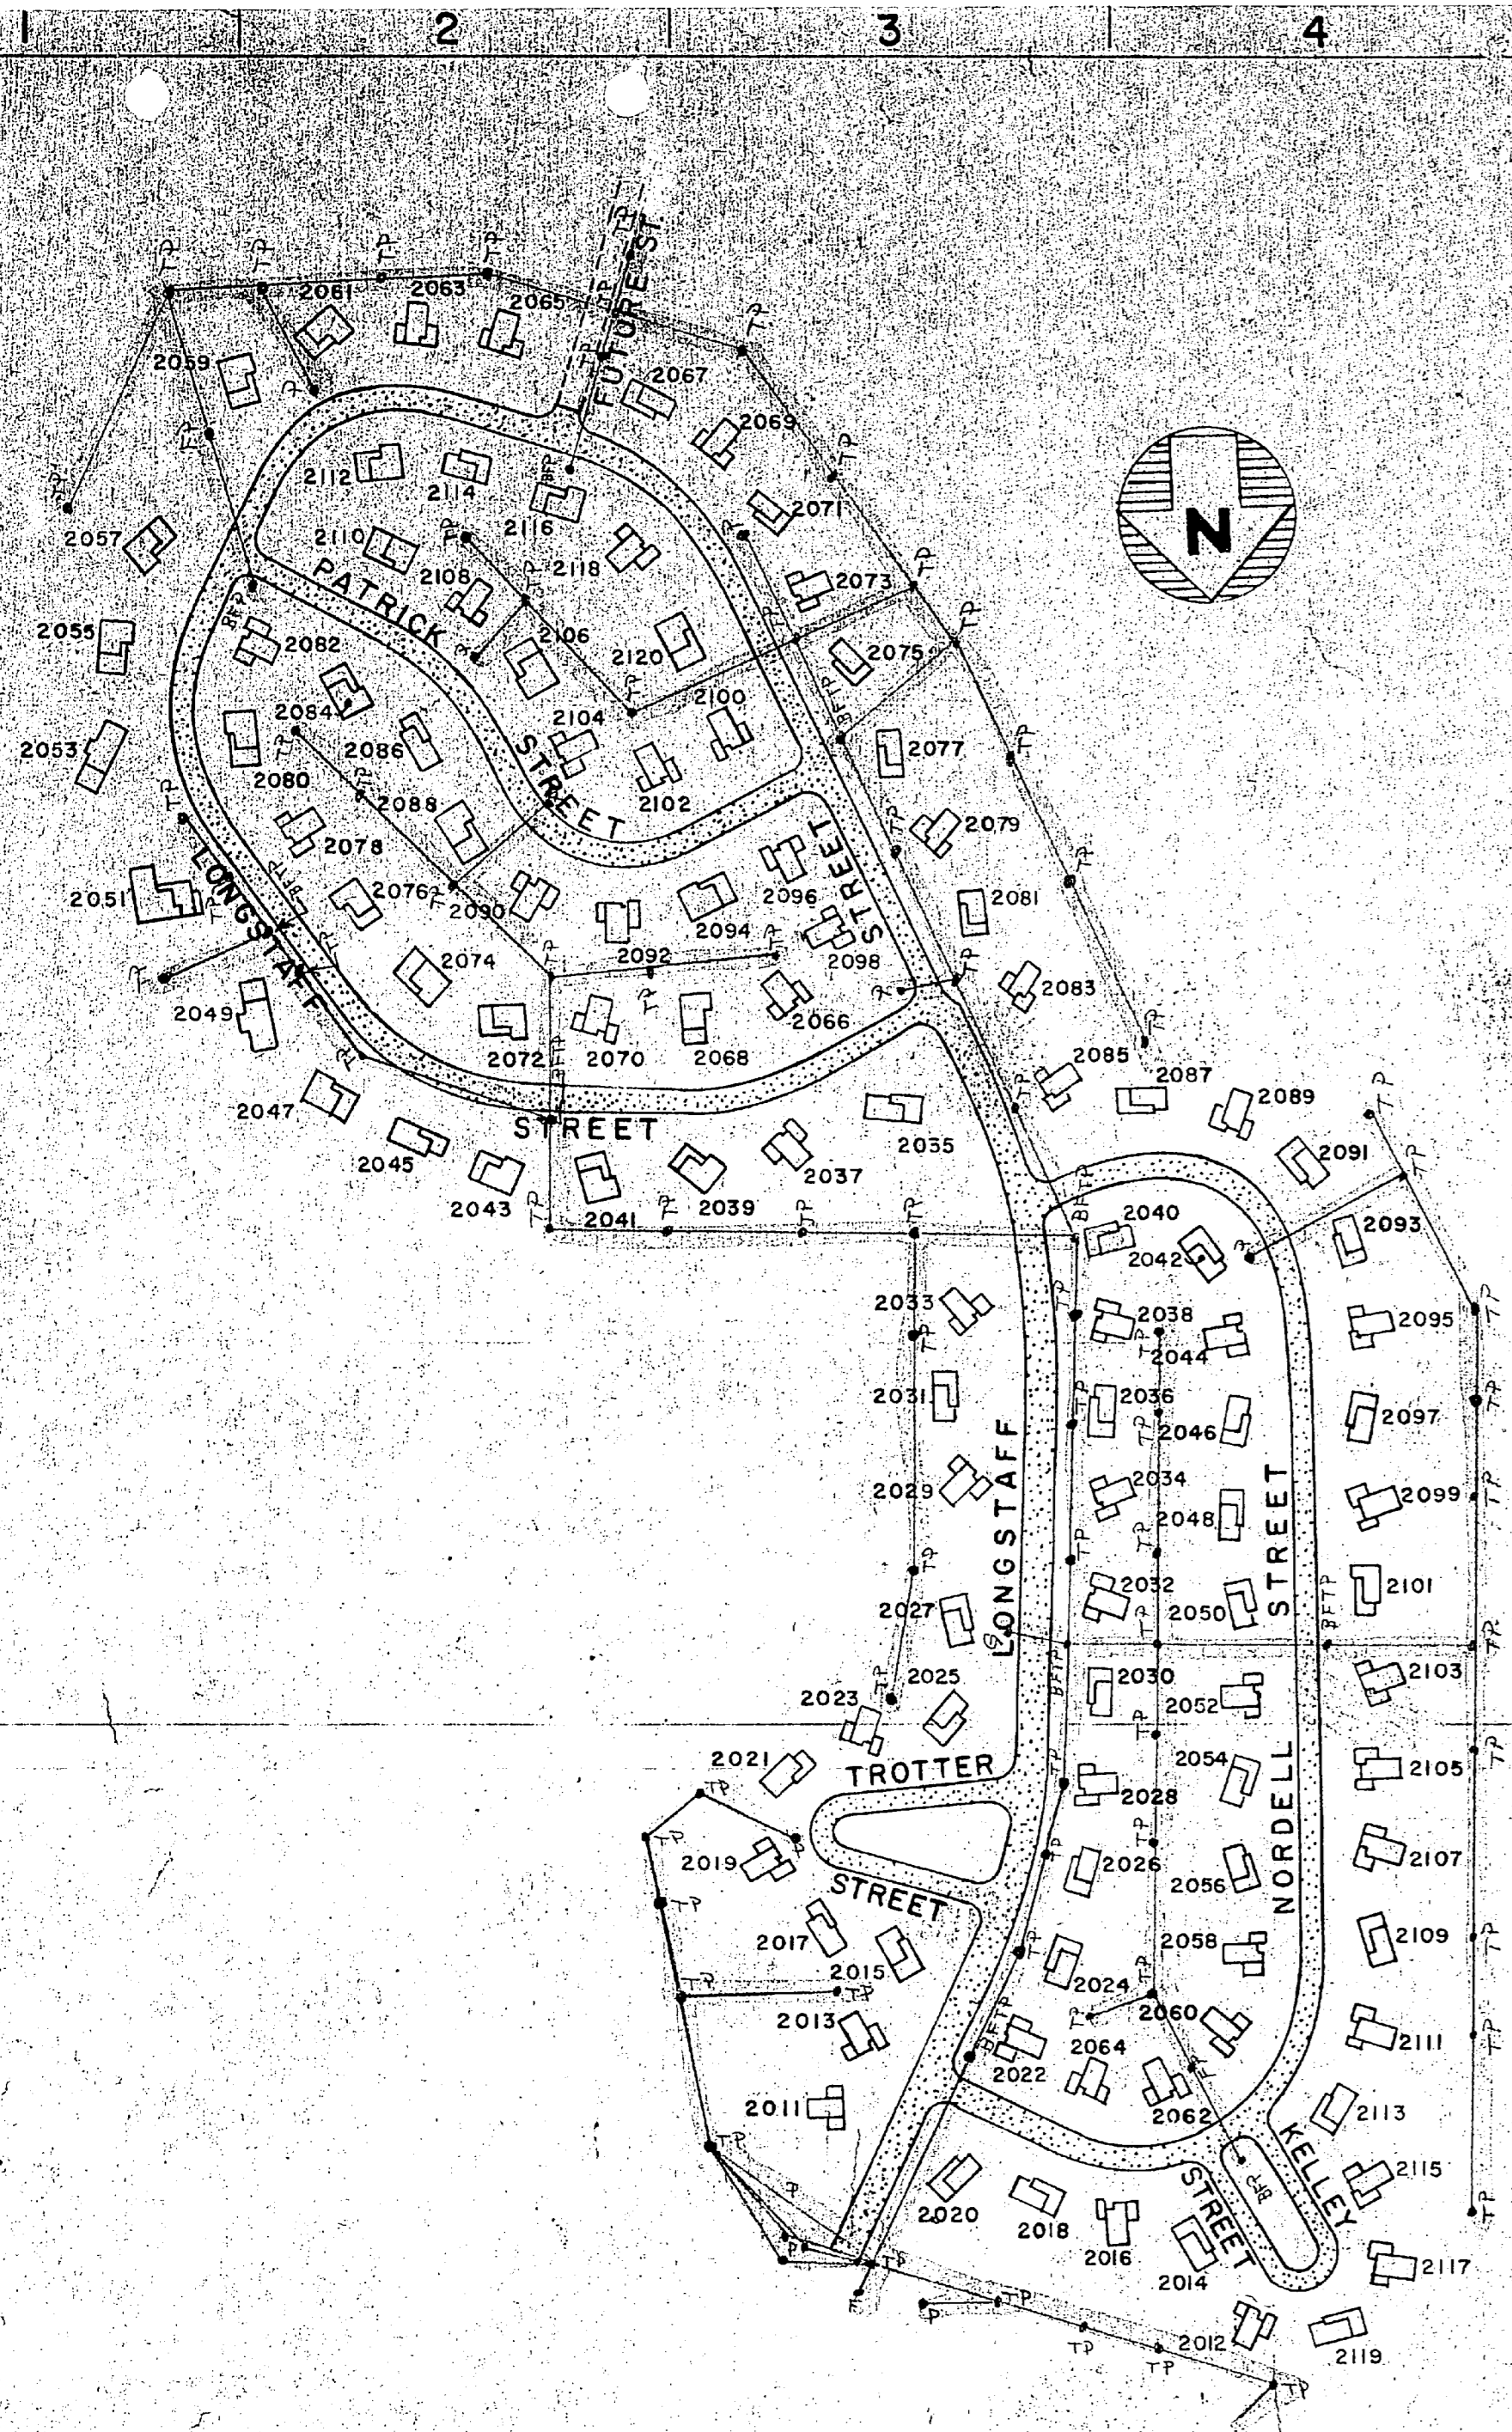


M. O. Q.
SCALE: 1" = 200'

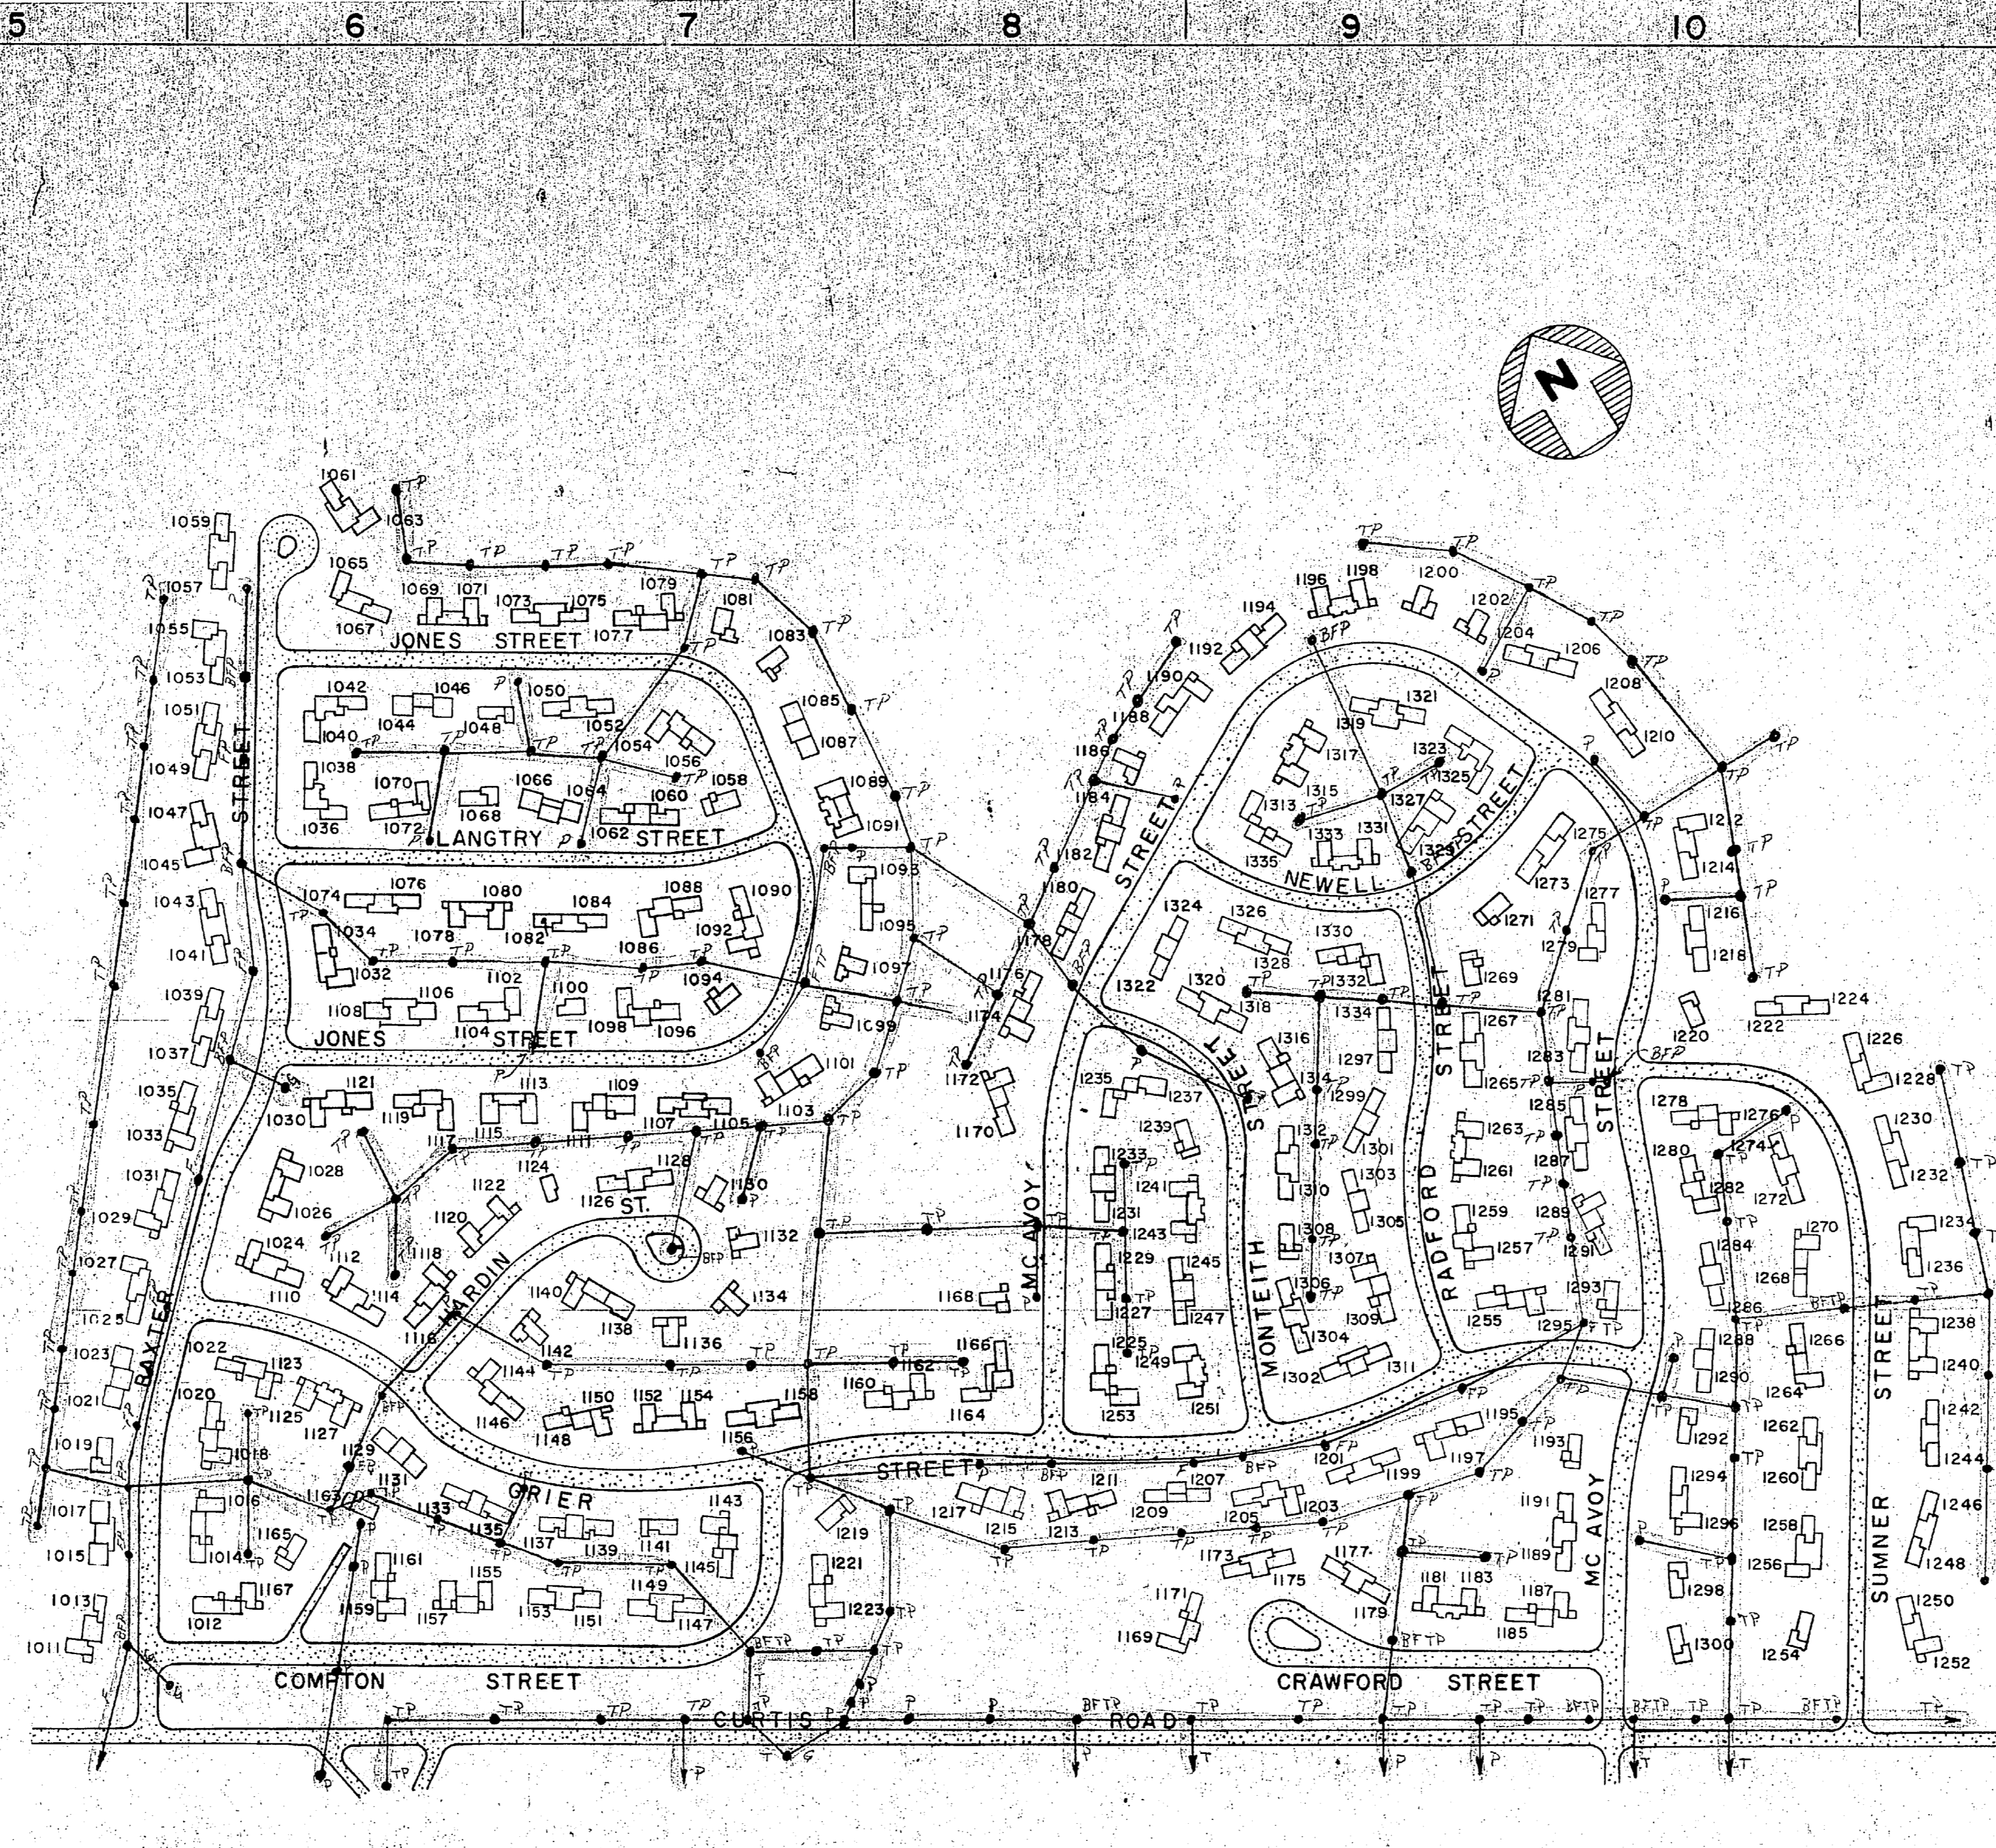

M. E. M. Q.
SCALE: 1" = 200'

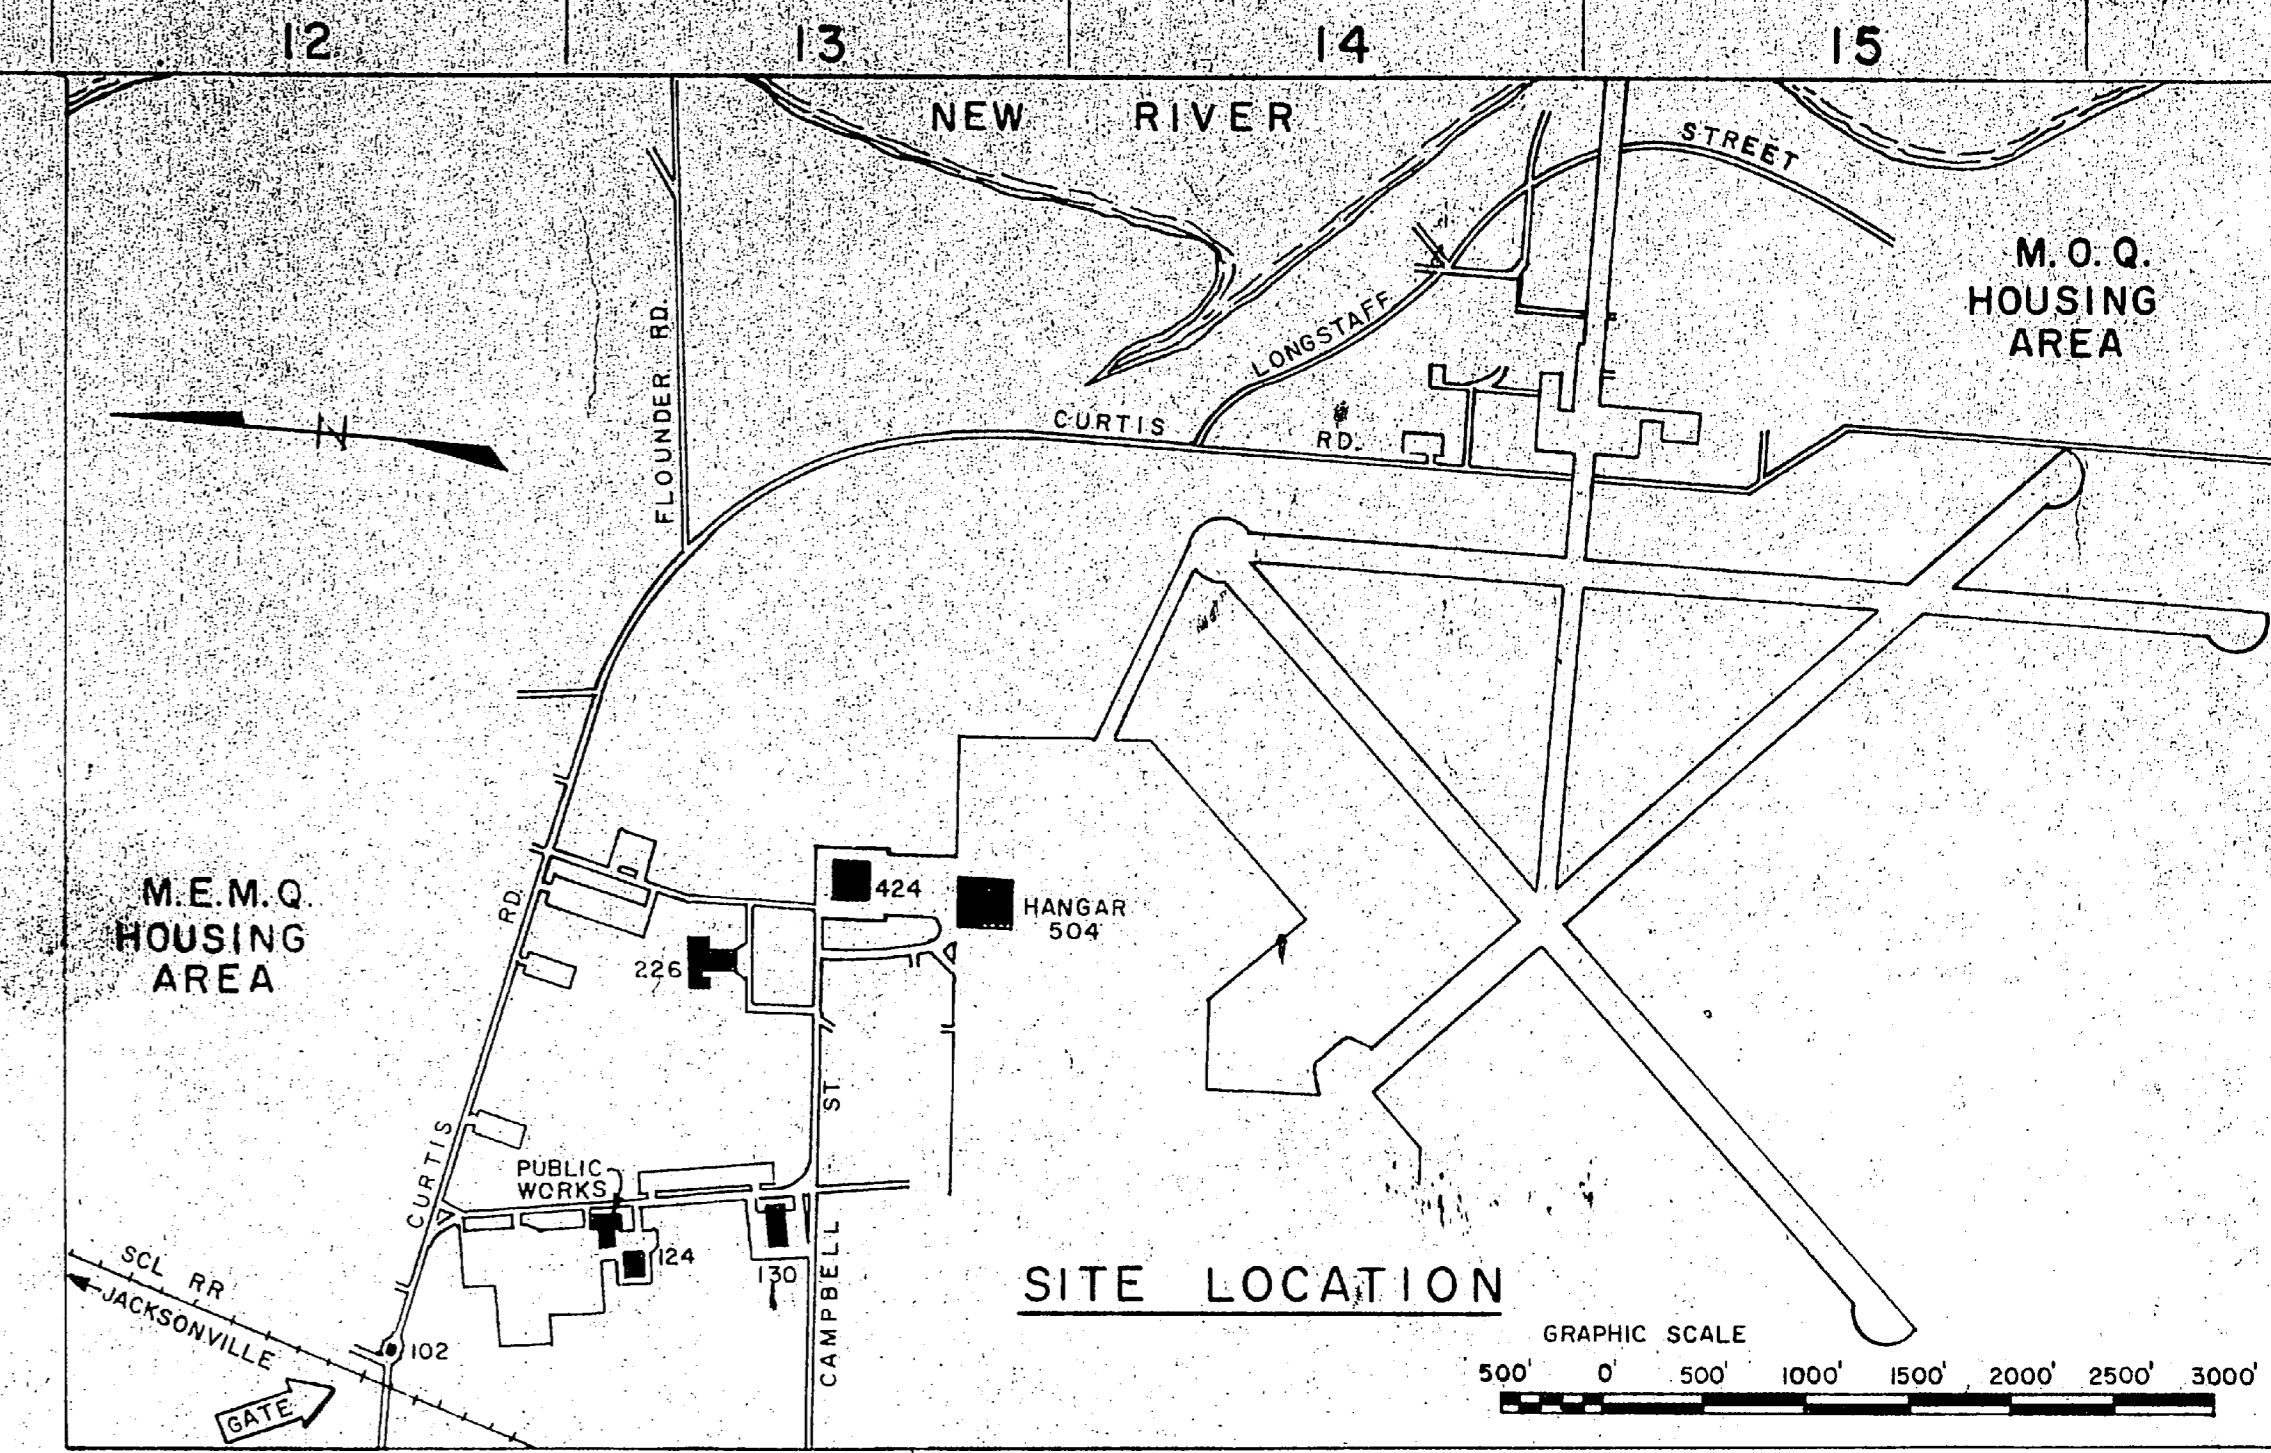


SITE LOCATION
GRAPHIC SCALE
500' 1000' 2000' 2500' 3000'

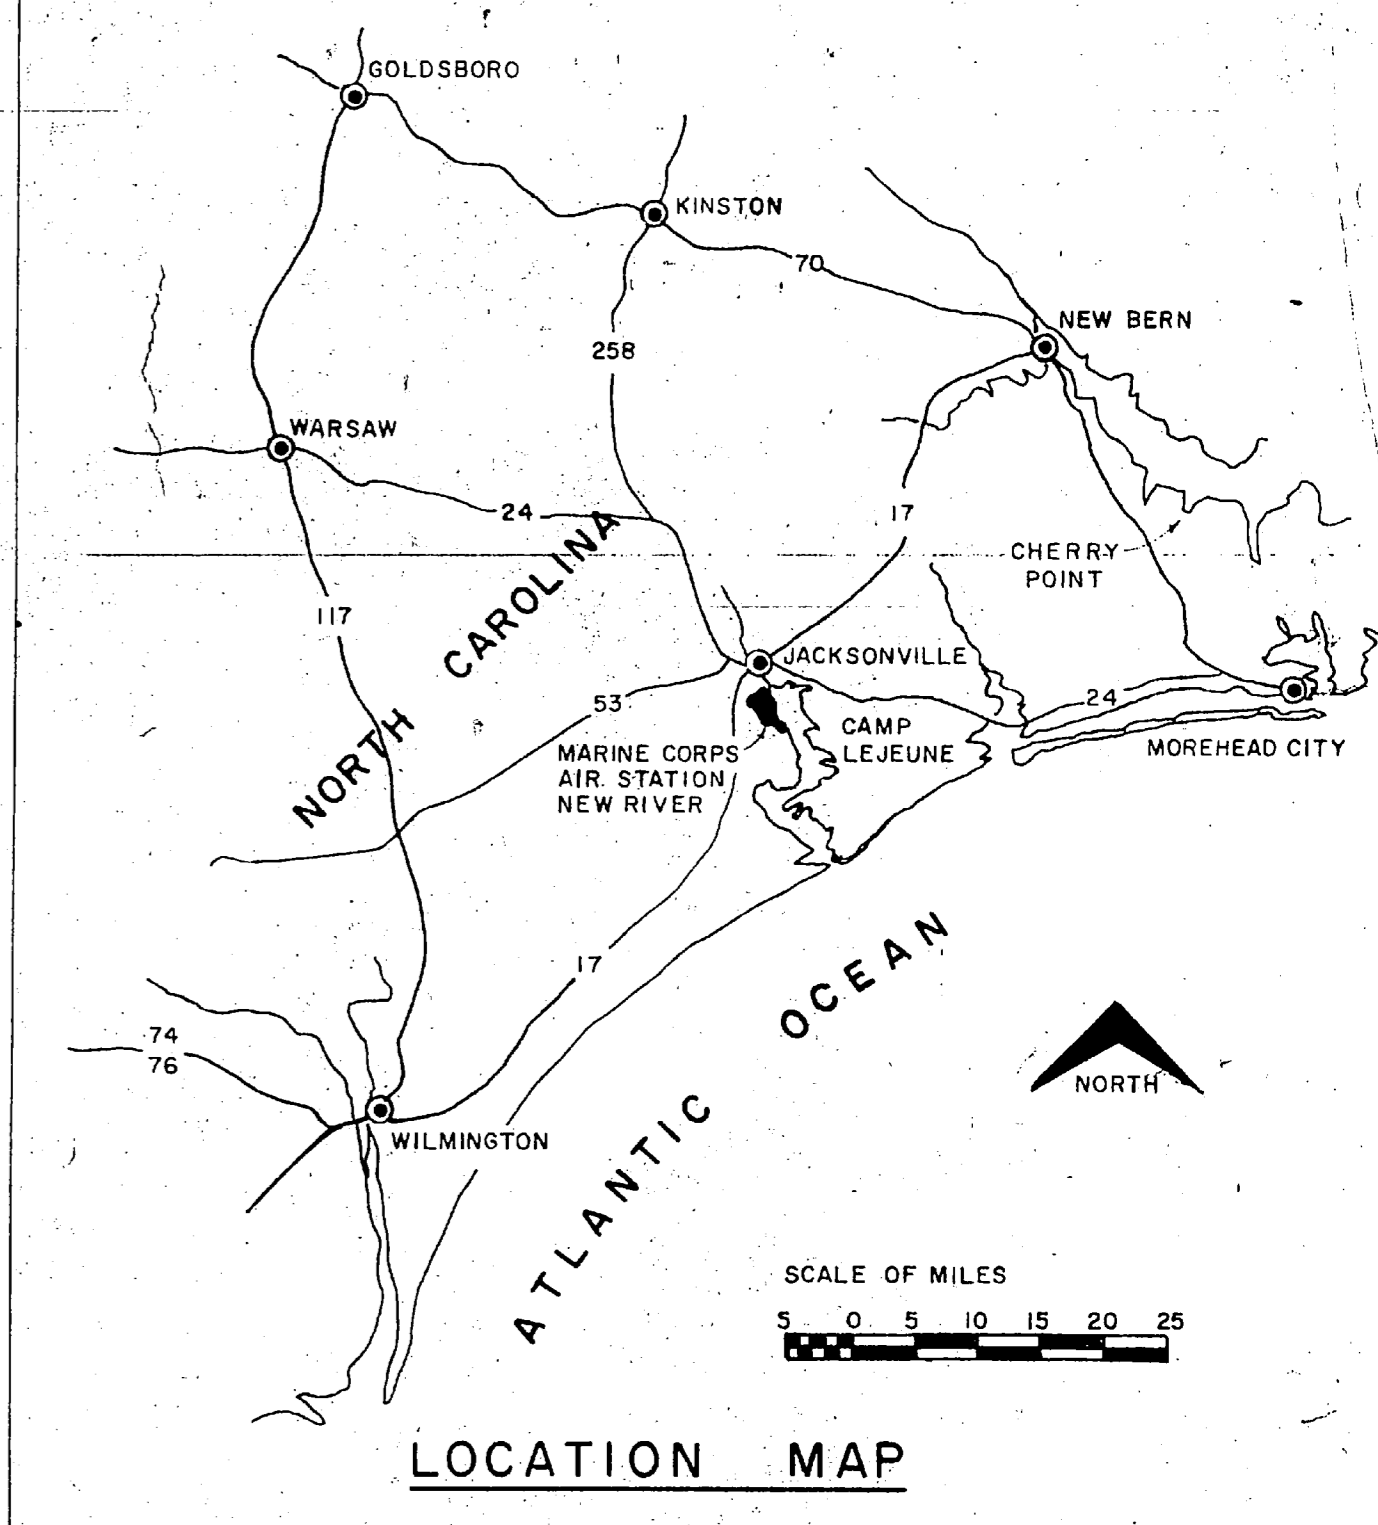


LOCATION MAP
SCALE OF MILES
5 10 15 20 25

Pole Count: MEMO 463
MOR 80
TOTAL 243


- F - Fire Alarm Cable
- T - Telephone Cable
- P - Power Cable
- B - Gas Pipe
- G - Gas Wire

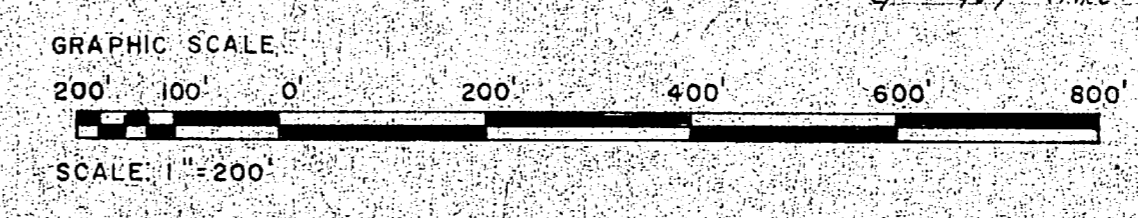

TELEPHONE DIVISION		
BASE MAINTENANCE		
CAMP LEJEUNE, N.C.		
MCAS (H)		
AERIAL CABLE LAYOUT		
& POLE PLACEMENT		
DRAWN BY W. E. H. [Signature]	CHECKED BY [Signature]	DATE 29 Oct 76
APPROVED R. D. [Signature]	SCALE 1" = 200'	DATE 2017

 

REVISIONS			
STN.	DESCRIPTION	DATE	APPROVED

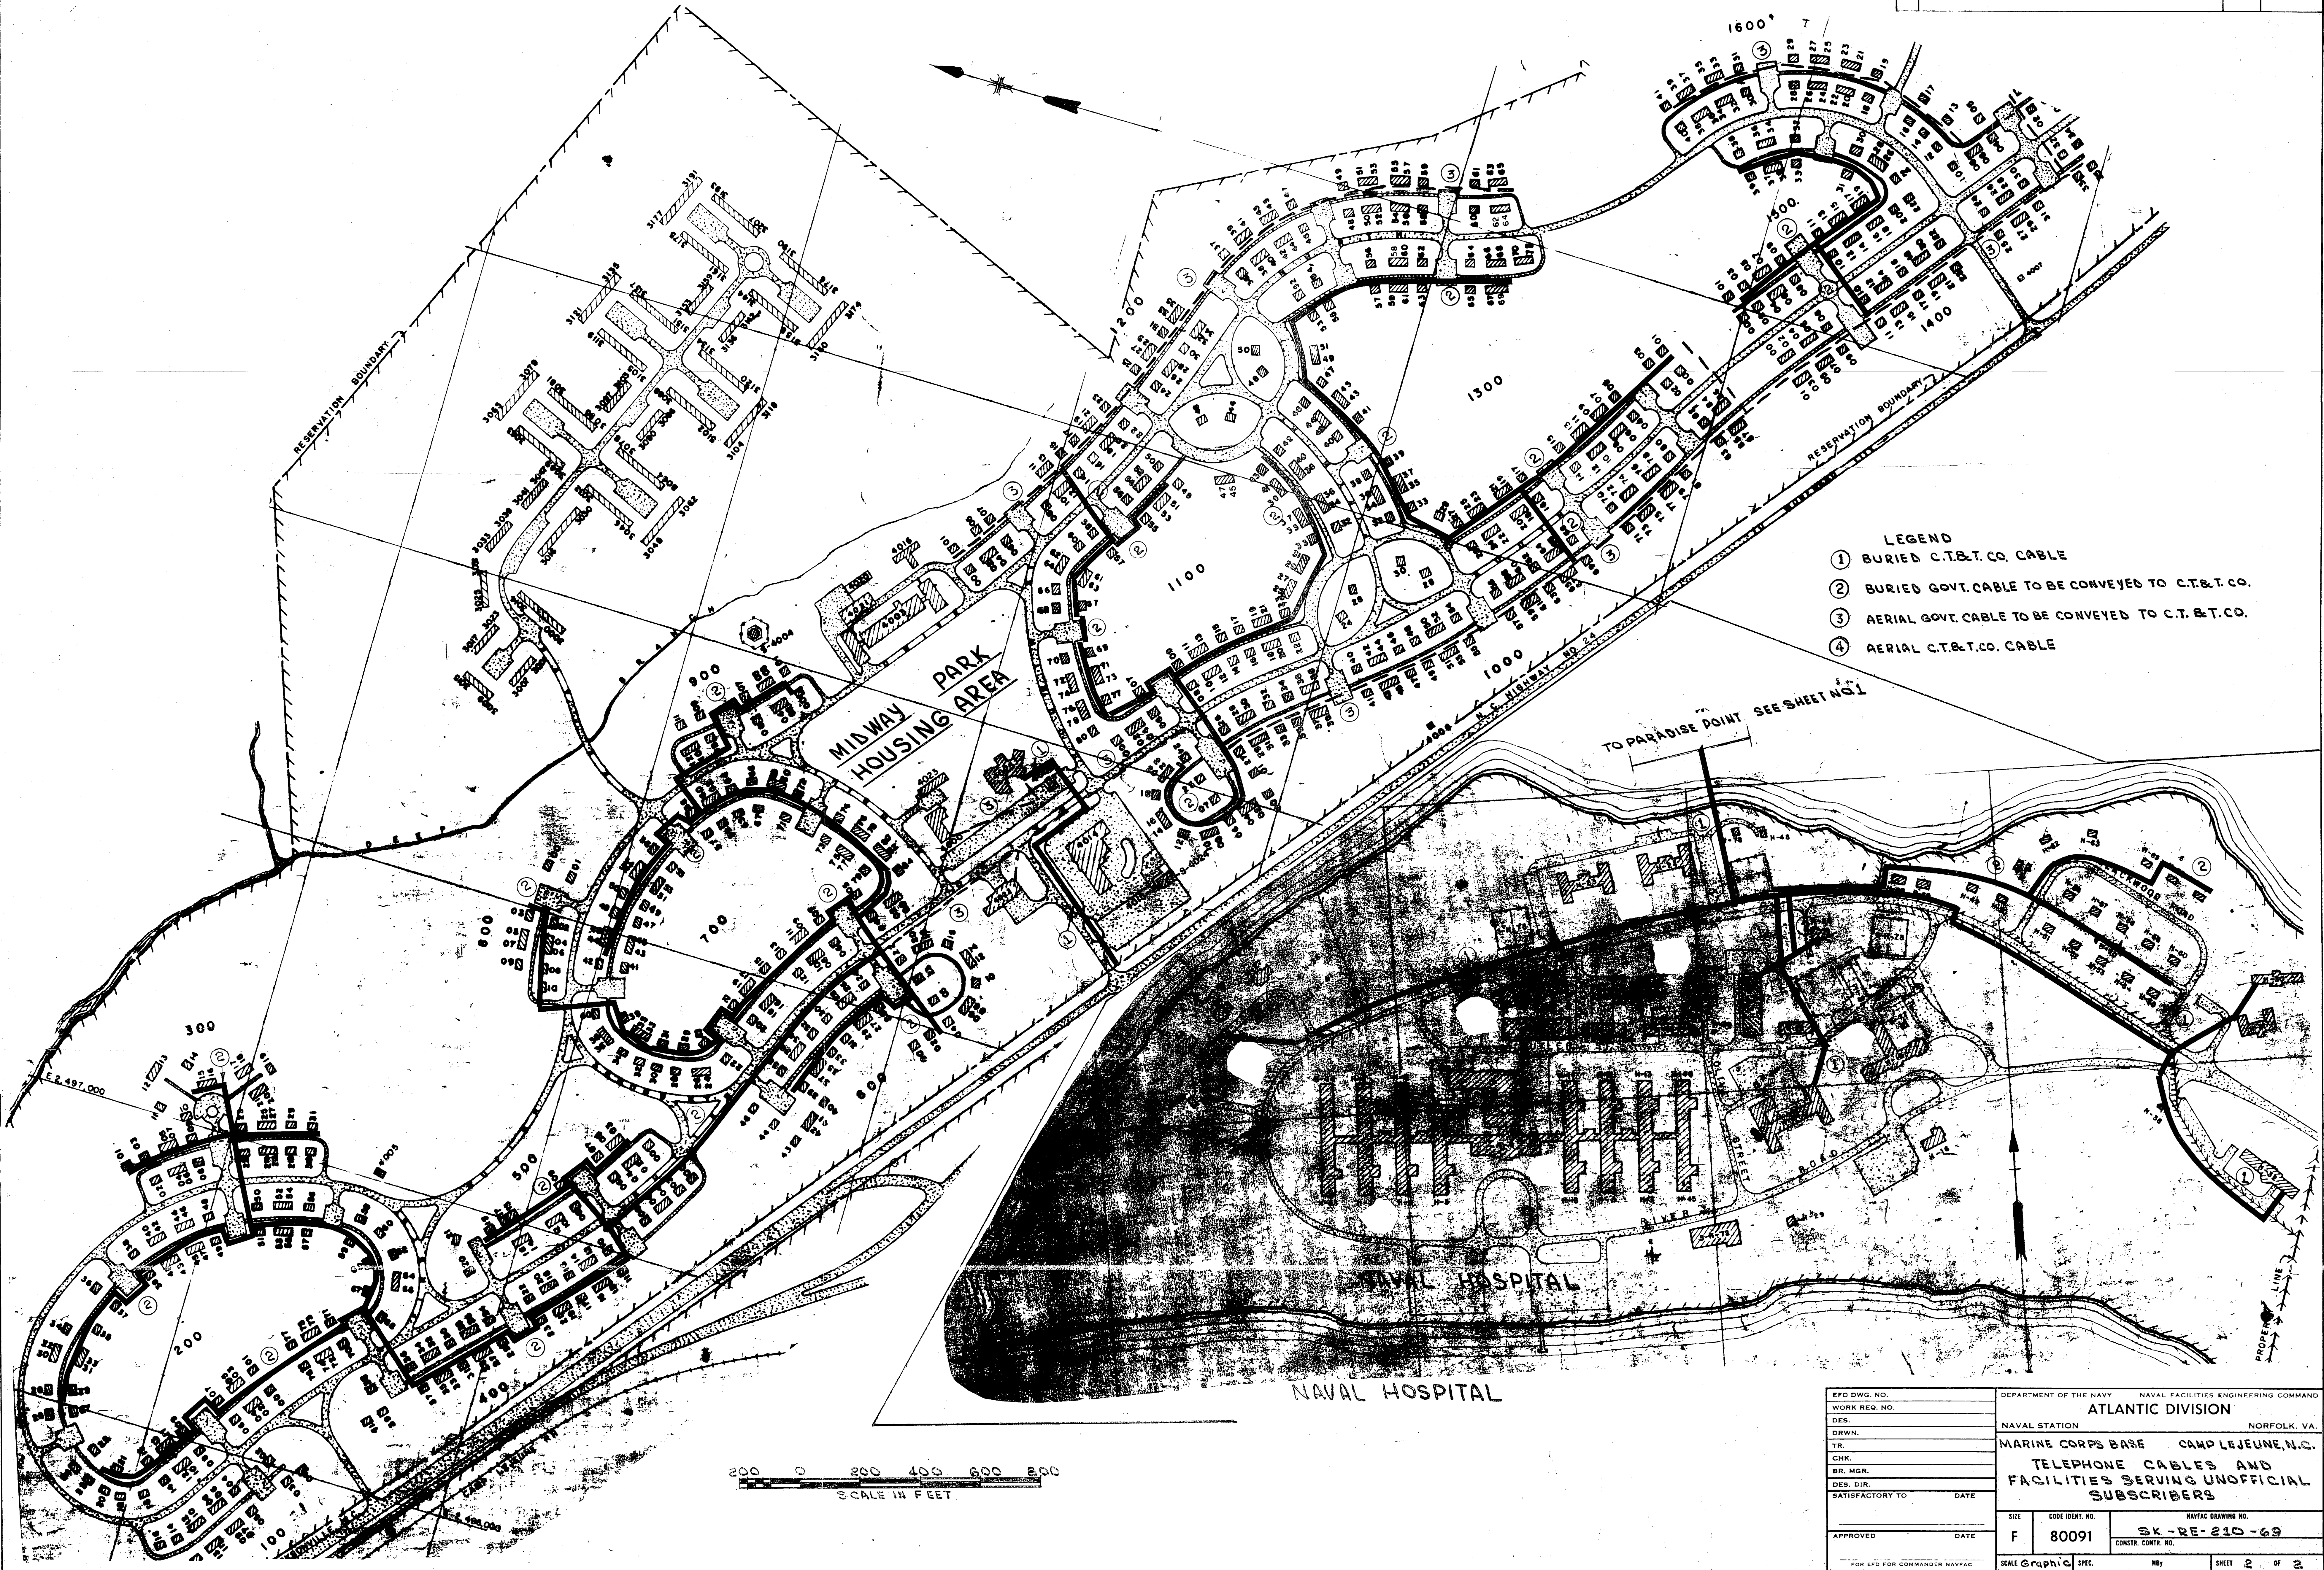

- LEGEND**
- ① BURIED C.T.&T. CO. CABLE
 - ② BURIED GOVT. CABLE TO BE CONVEYED TO C.T.&T. CO.
 - ③ AERIAL GOVT. CABLE TO BE CONVEYED TO C.T.&T. CO.
 - ④ AERIAL C.T.&T. CO. CABLE

200 0 200 400 600 800
SCALE IN FEET

EFD DWS. NO. WORK REQ. NO. DES. DRWN. TR. CHK. BR. MGR. DES. DIR. SATISFACTORY TO _____ DATE _____ APPROVED _____ DATE _____	DEPARTMENT OF THE NAVY ATLANTIC DIVISION NAVAL STATION NORFOLK, VA. MARINE CORPS BASE CAMP LEJEUNE, N.C. TELEPHONE CABLES AND FACILITIES SERVING UNOFFICIAL SUBSCRIBERS SIZE CODE IDENT. NO. NAVFAC DRAWING NO. F 80091 SK-RE-210-69 CONSTR. CONTR. NO. SCALE GRAPHIC SPEC. MBY SHEET 2 OF 2
---	--

