

113
11

HP-632
static
pumping level
Draw Down
air line
PSI
GPM

11-21-83 10-25-84
~~13 12 13~~
~~46 53 40~~
~~33 26~~
~~63 63~~
~~20 19~~
~~185 201~~

used altitude gage

yes
yes

8-26-85

HP 632

AL - 63'

Static 13

P/LI - 46

D/D - 33

PSI - 15


GPM - 205

LAB

632

8-26-85

AL	SL	PL	D/D	PSI	GPM	TIME
						START
63	13	22	9	50	104	920
		24	11	47	111	932
		26	13	45	122	944
		28	15	42	128	957
		31	18	39	140	1007
		31	18	37	146	1013
		33	20	34	151	1023
		38	23	31	162	1033
		38	25	27	170	1049
		40	27	24	183	1100
		43	30	20	192	1111
		46	33	15	205	1120
						1130

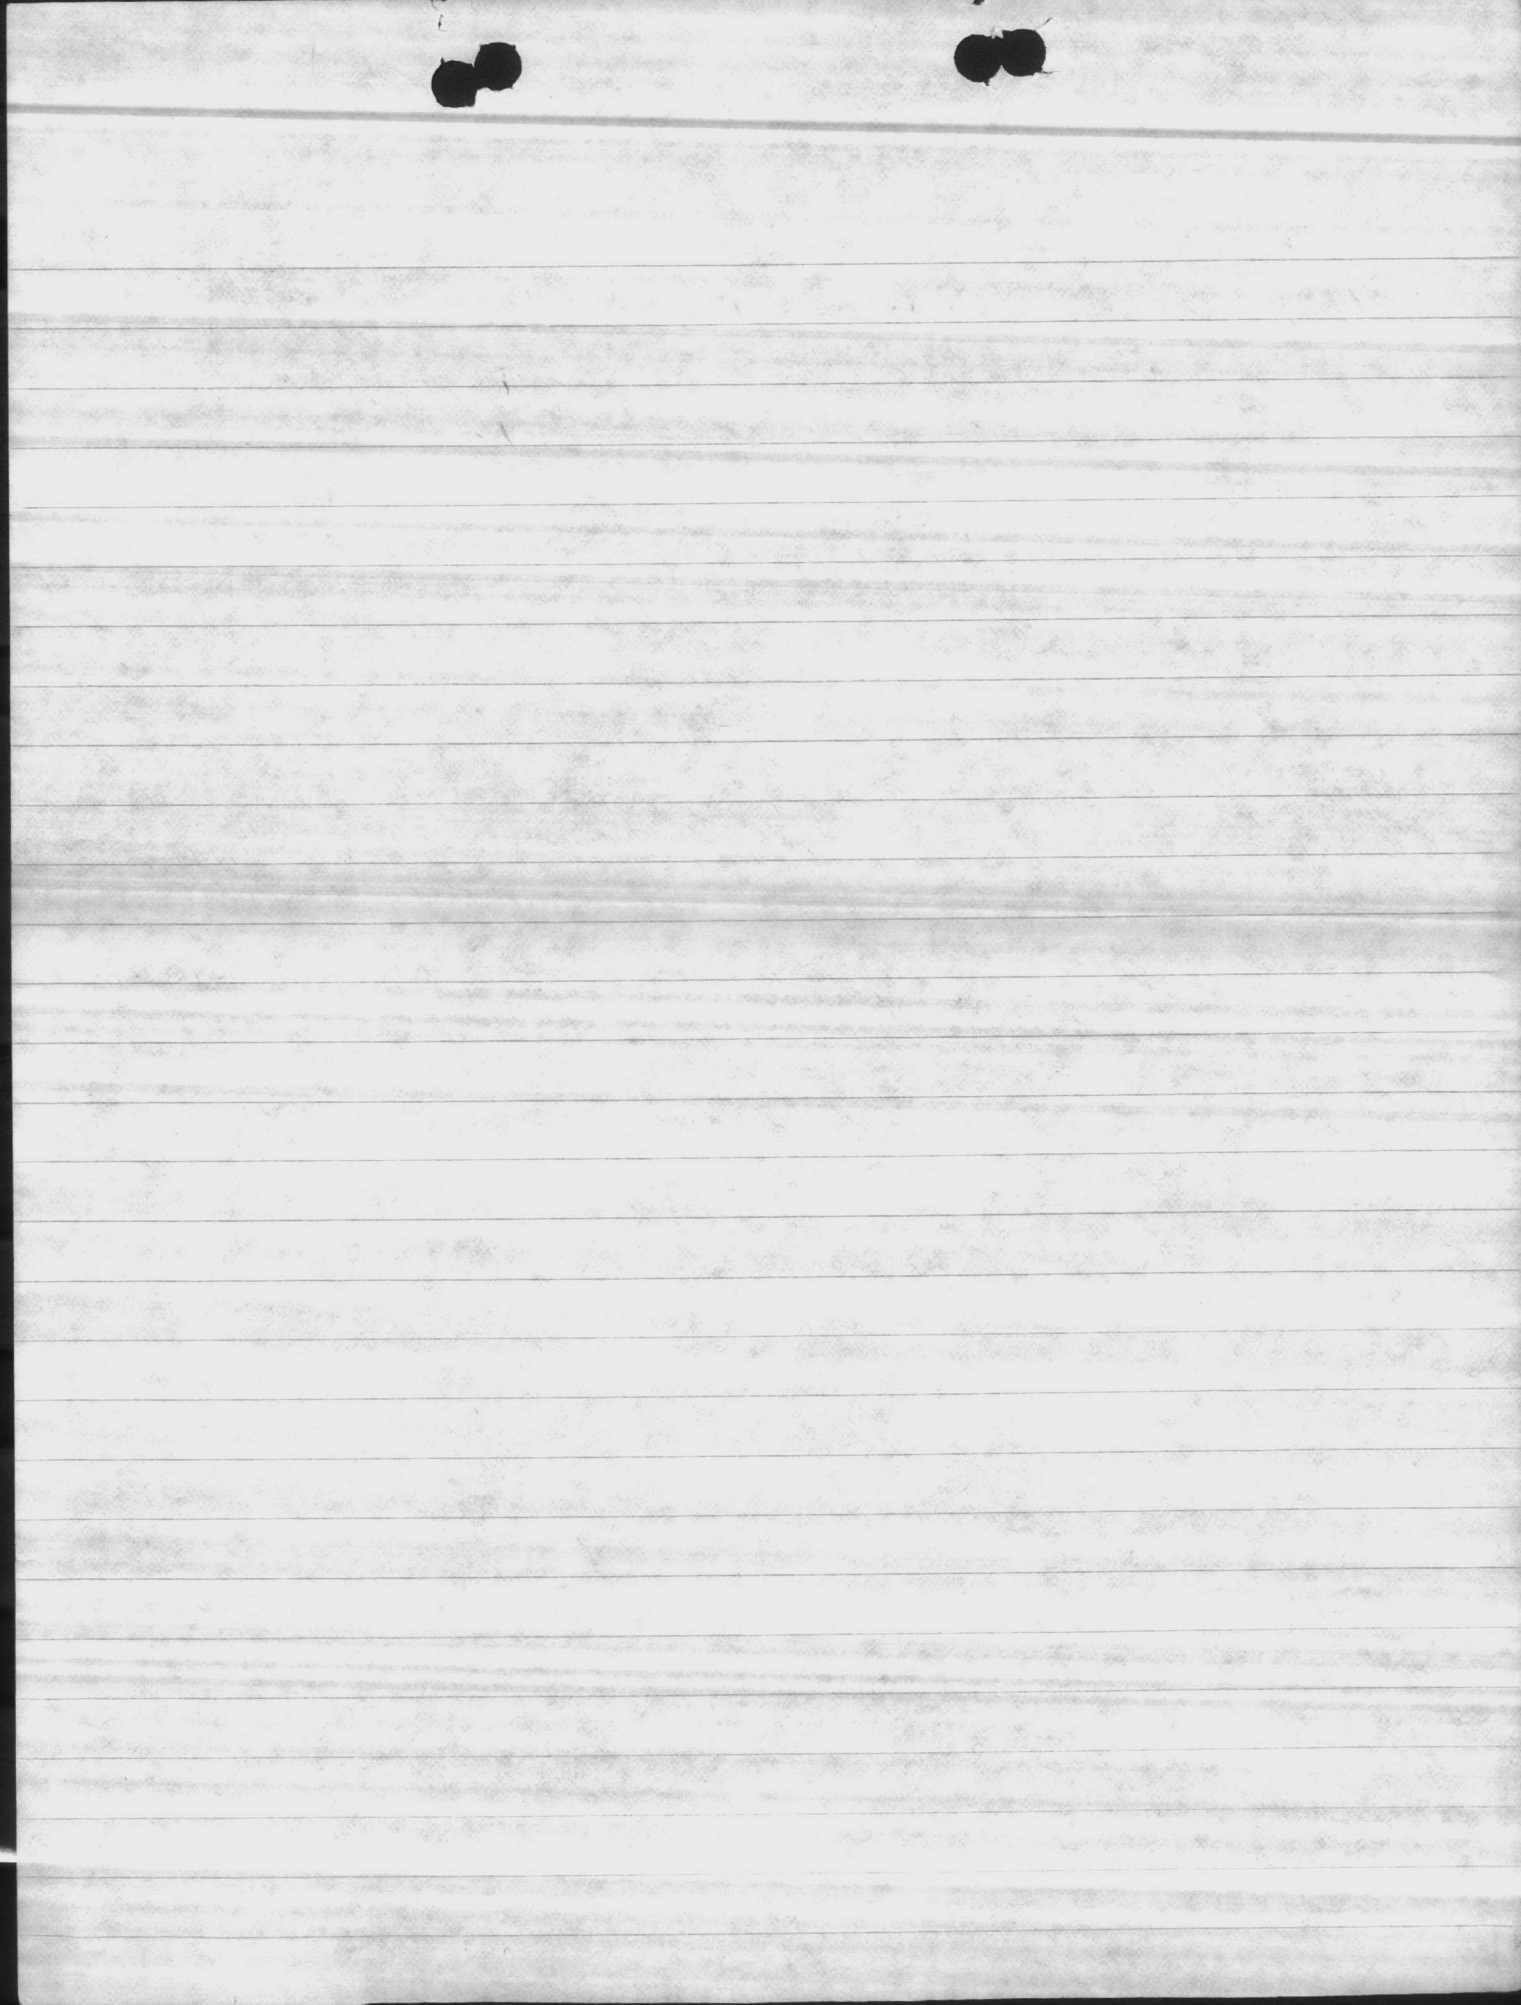

well 632

by Thomas Sardinias

2-13-89

Air line	Static Level	Pumping level	Drawn Down	Discharge Pressure	GPM	Time
63	12'	17	5	50	115	20
		20	8	45	128	30
		22	10	40	140	40
		24	12	35	154	50
		27	15	30	170	60
		29	17	25	185	10
		33	21	20	203	20
		36	24	15	219	30
		38	26	10	235	40
		41	29	6	239	


Dead Head over 60 PSI



WELL NUMBER		BY			DATE	
632		THOMAS BROWN			10-25-84	
AIR LINE	STATIC LEVEL	PUMPING LEVEL	DRAIN DOWN	DISCHARGE PRESSURE	GPM	START TIME
63'	13	18	5	53	104	1100
		20	7	49	105	1110
		22	9	46	115	1120
		24	11	43	125	1130
		26	13	40	133	1143
		28	15	37	146	1157
		31	18	34	154	1210
		32	19	31	162	1224
		33	20	28	170	1235
		36	23	25	180	1245
		38	25	22	190	1255
REMARKS	left out at →	40	26	19	201	1305

MANUFACTURER	STAGE	S.N.	TOTAL HEAD	SIZE




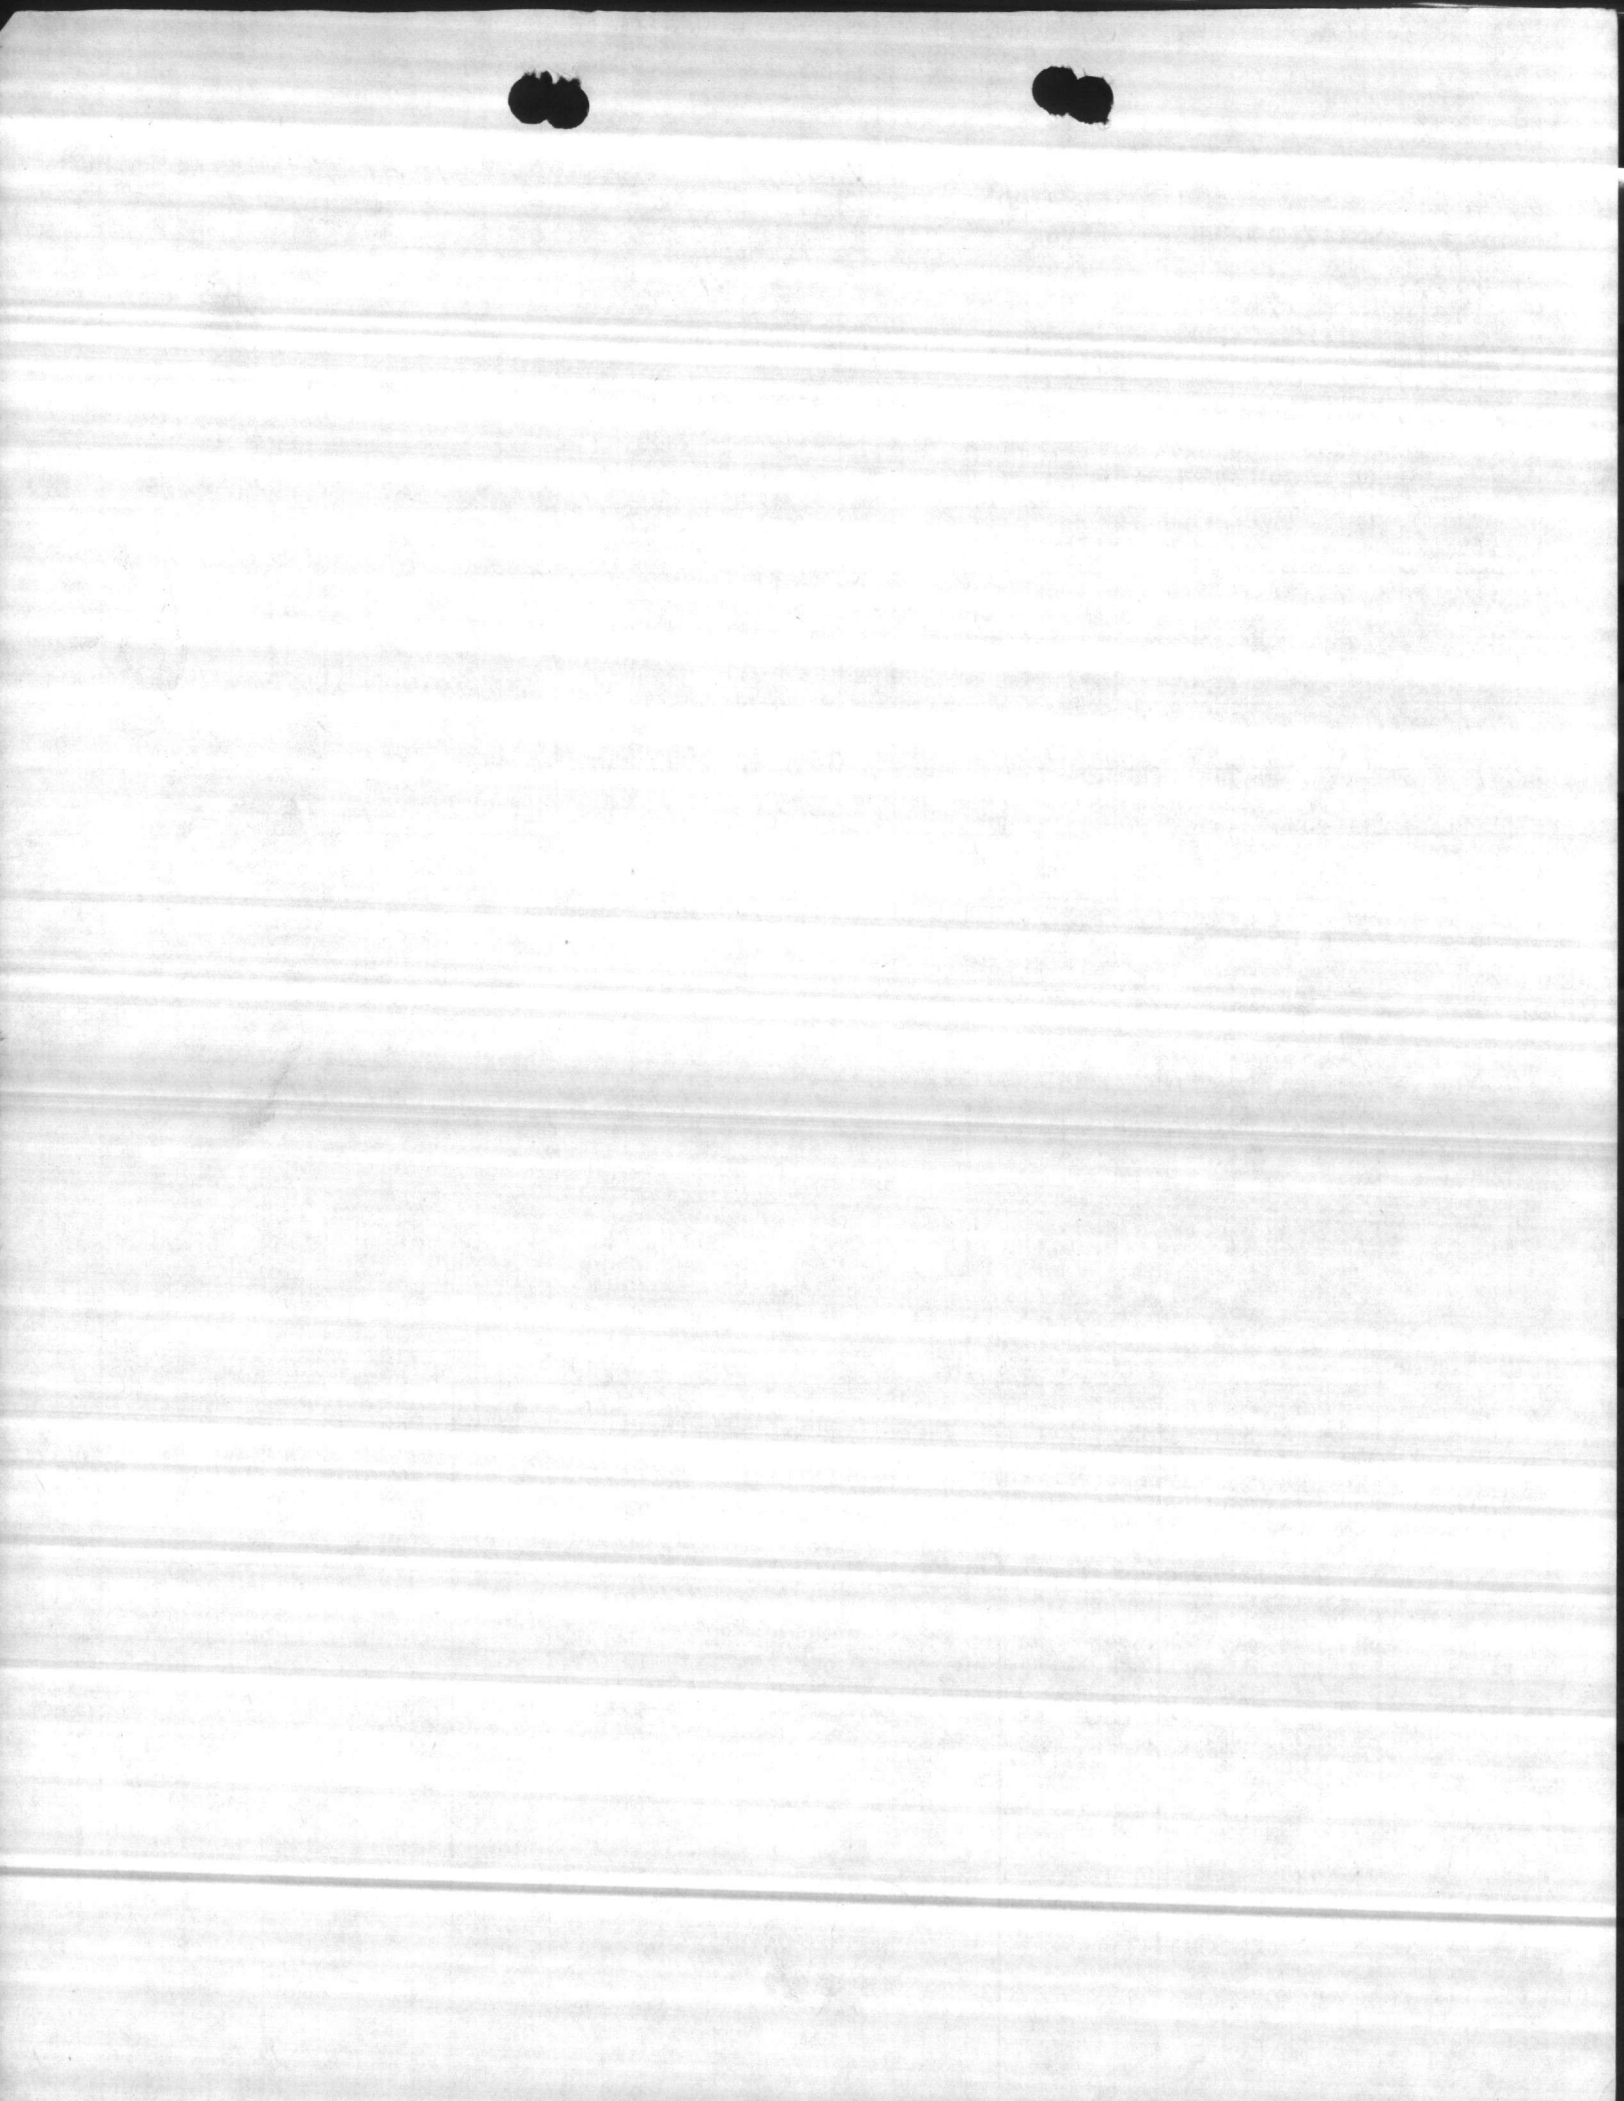

632

DATE	LENGTH OF ATR LINE	STATIC LEVEL	PUMPING LEVEL	DRAW DOWN	DISCHARGE PRESSURE	CAP. PER FOOT OF DRAW	TIME
	63	23			start		0935
7-30-82	63	23	34	11'	46	104	0945
			36	13'	43	111	0955
			39	16'	40	119	1005
			41	18'	37	125	1015
			43	20'	34	133	1025
			46	23'	31	146	1035
			48	25'	28	157	1045
			50	27'	25	159	1055

REMARKS: used direct reading gage
 test set at 28 PSI @ 25' P/L 48' GPM 159

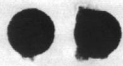

DATE 7-25-00

PWSID 04-67-041

WELL # HP 632

WELL NAME HADNOT POINT HP20

BLDG. HP 632

CODE G.

AVAILABILITY P.

LOCATION SPLEADS FERRY ROAD.

LATITUDE 34.62133

LONGITUDE 77.2935

WELL DIAMETER 8"

WELL DEPTH 200'

SCREEN INTERVAL _____

YIELD 349

STATIC LEVEL 13'

PUMPING LEVEL 43'

PUMP TYPE VERTICAL TURBINE

MOTOR HP 15


INTAKE DEPTH 60'

DESIGN CAPACITY 240

ACTUAL GPM 250

SIZE OF CONCRETE SLAB 10 X 12

HEIGHT OF CASING 10"

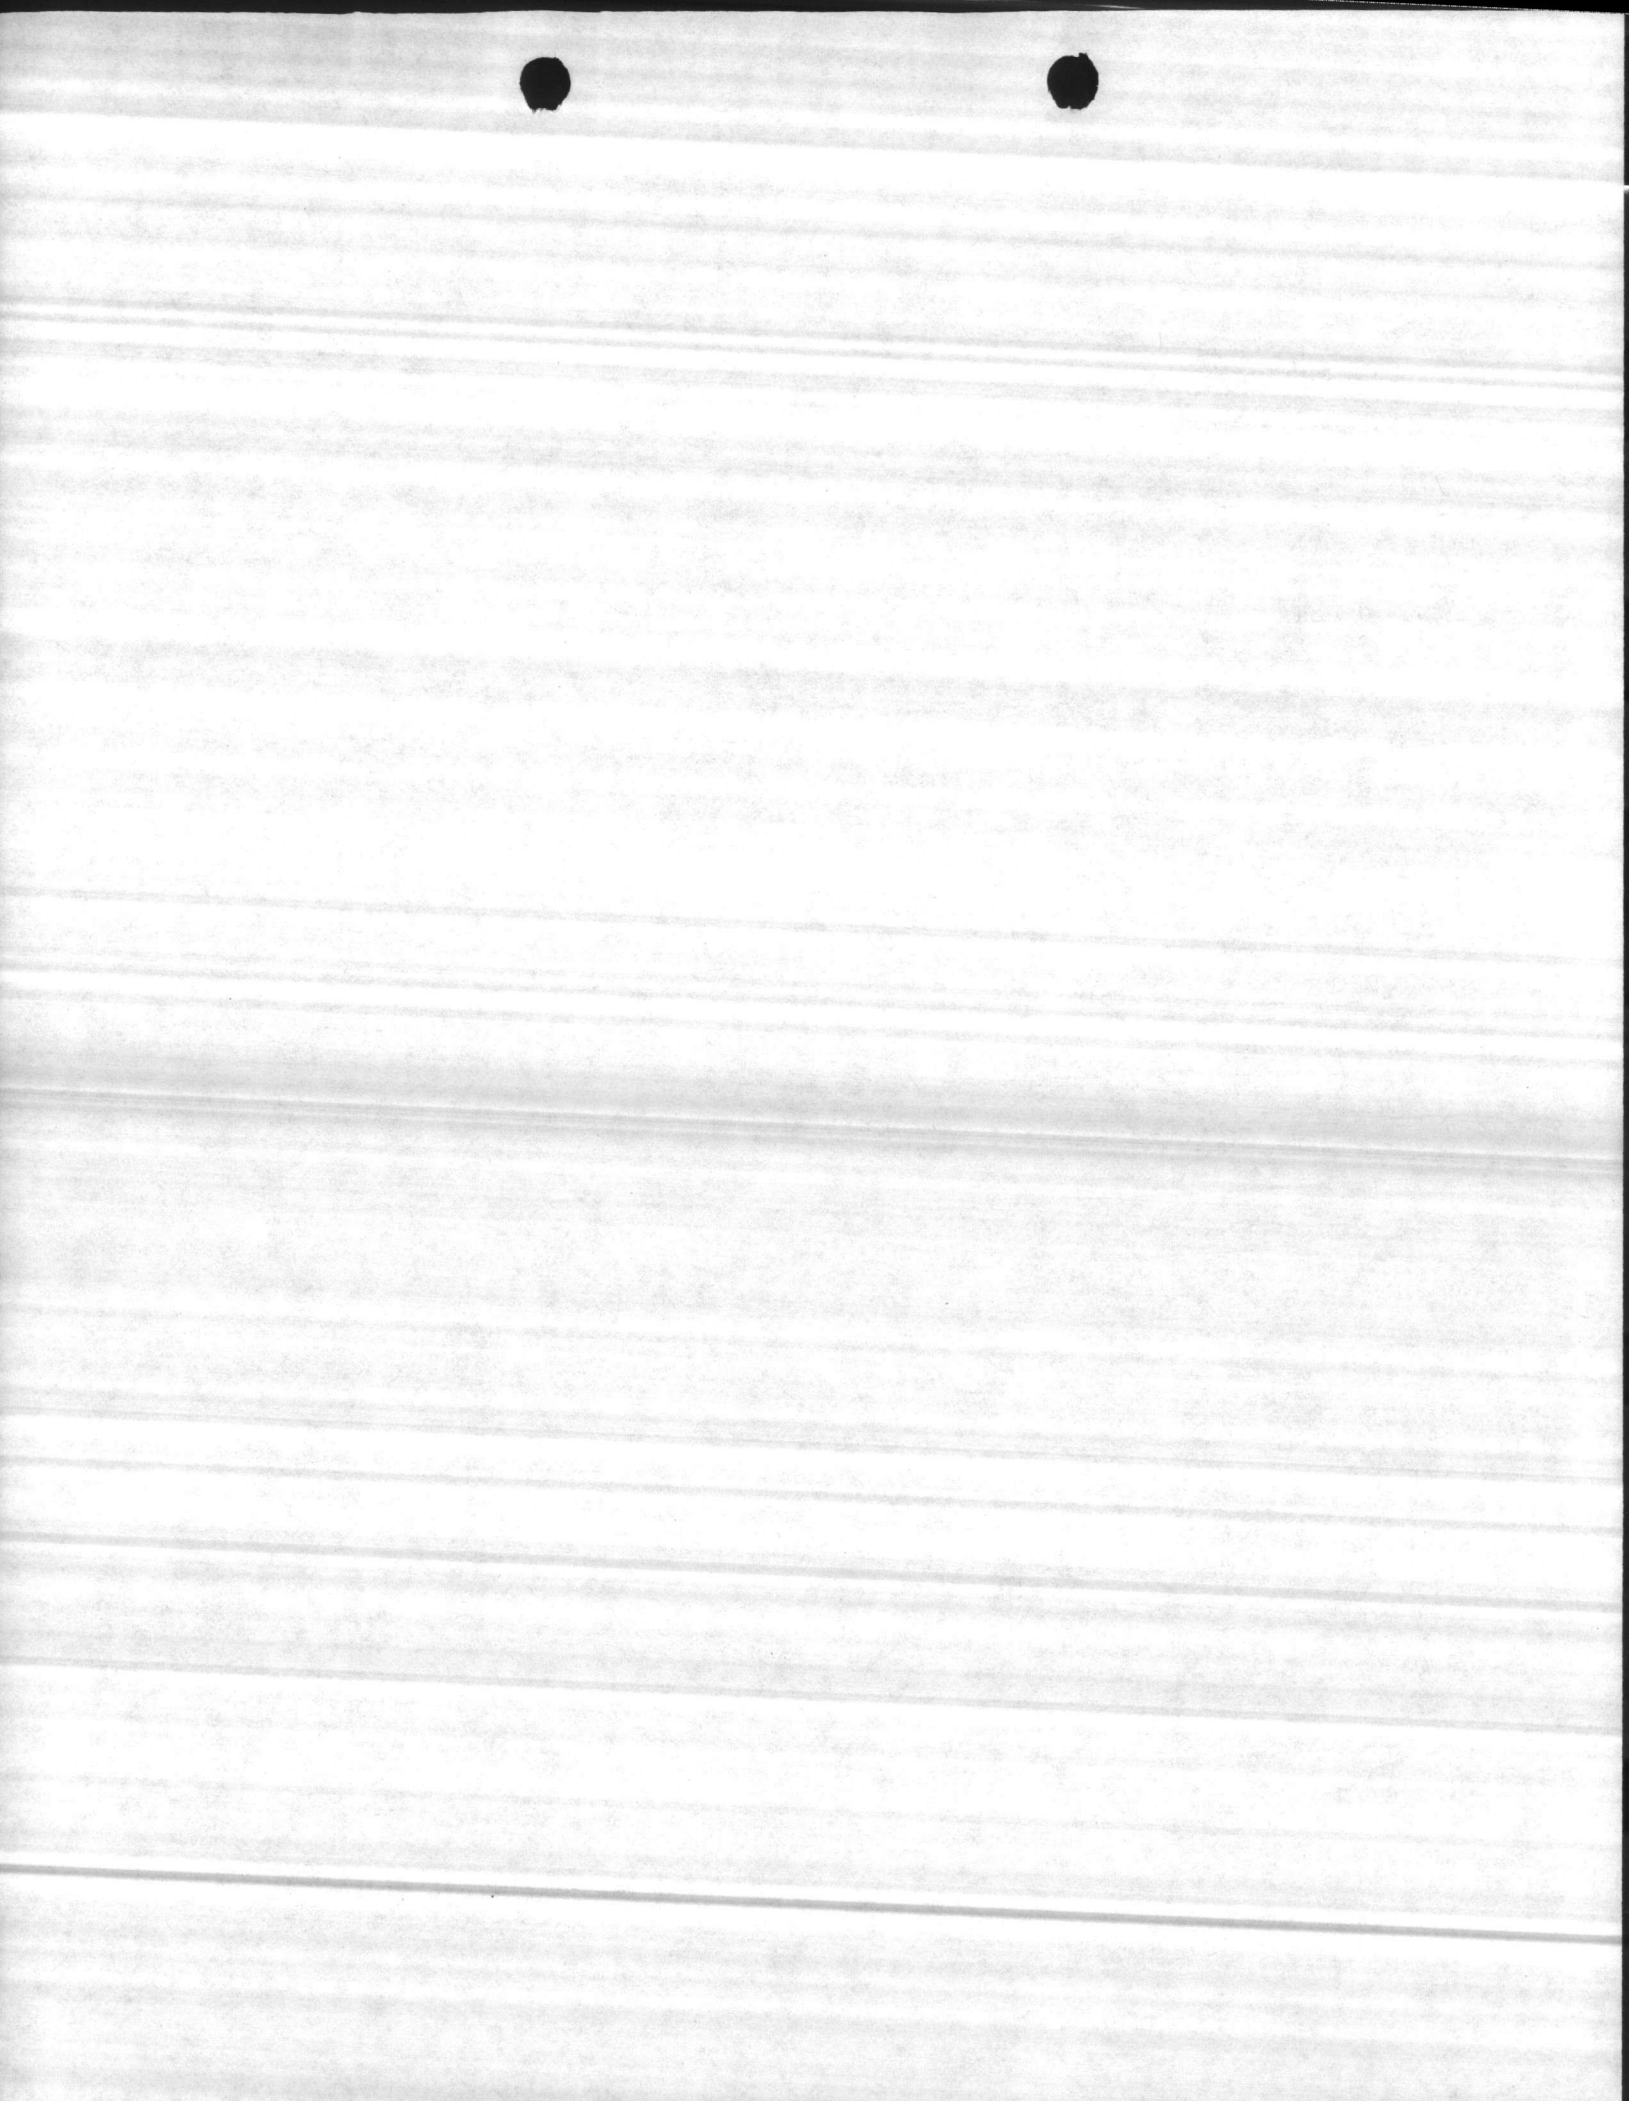

SOURCE INFORMATION GROUND WATER

Date Form Completed

M M D D Y Y
0 1 2 5 9 5

PW/SID
0467041

Owner Assigned
Source Code

Well Name (If purchase, name of system)

632

HADNOT POINT 632

Code

G

G=Ground
W=Purchase/G
Y=G w/direct influence
Z=W w/direct influence

If Purchase, seller ID#

Source Begin Date

Source exempt—
SWTR? Y N

Direct Influence Date

Availability

P=Permanent
E=Emergency
S=Seasonal
I=Interim
O=Other

Location of well within the system (If purchase, location of master meter)

SNEADS FERRY ROAD

Latitude (N)

Longitude (W)

How Determined

GPS Data

No. of Sats. Locked on

3 4 3 7 1 1

0 7 7 1 7 3 6

G=GPS
M=Map
S=Surveyed

Q# or
DOP #

(If purchase, use seller's primary source lat/long)

Vulnerable (VOCs) Y N

Assessment Date

ENTRY POINT INFORMATION

Use Code

Availability

Owner Assigned
Entry Point Code

Entry Point Name

C C=Ground/Permanent
D=Ground/non-permanent

P P=Year-round S=Seasonal
E=Emergency I=Interim O=Other

100

HP 632 MCB HADNOT AT WTP

Location:

Well Site: Owned or controlled? Y (Y,N) Control Area (100' radius)? N (Y,N) If no, explain:

Sources of pollution/distance: Road @ 80'

Surface water within 200'? Y N If yes, actual distance feet If yes, bact. samples collected? (Y,N)

Adequate slope? Y (Y,N) Flooding? N (Y,N) Maintenance: OK

Well House: Free of stored materials? Y (Y,N) Properly drained? Y (Y,N) Locked? Y (Y,N)

Condition of house: OK Type of freeze protection: NONE

Well: Diameter: 8" Type: SCREENED Yield (gpm): 240-250 Properly sealed? Y (Y,N)

Properly vented? Y (Y,N) Casing depth 63 ft. (If unknown, put 'UNK') Well depth: 200 Meter available? N (Y,N)

Concrete slab adequate? Y (Y,N) If no, explain: Size: 10x12

Size of blow-off: 3" (V) Sample tap: Before treatment? Y (Y,N) After treatment? (Y,N)

Pumps: Capacity: GPM: 250-240 HP: 15 Pump intake depth: 60 Auxiliary Power? N (Y,N)

Type pump: VERTICAL TURBINE Height above floor (pump/casing): 10"

Storage at well site: Elev: Hydro: Ground:

If hydroautomatic, air volume control? (Y,N) Safety valves? (Y,N) Coded? (Y,N)

High service pumps: 1. gpm hp 2. gpm hp 3. gpm hp Auxiliary Power? (Y,N)

Is the water treated at this well? Y N If yes, complete back of form.

If other wells are treated here, which ones? If treated elsewhere, where? HP 20 PLANT

If purchase, retreat? Y N If yes, complete back of form.
1 No meter
2 Repair Vent
3 Oil Lube bearings @ pump

WELL NUMBER		BY			DATE	
AIR LINE	STATIC LEVEL	PUMPING LEVEL	DRAIN DOWN	DISCHARGE PRESSURE	GPM	START TIME
60	25	28	3	80	108	20
		31	4	50	287	30
		37	12	30	340	
		39	14	20	500+	
		43	18	15	500+	
		THOMAS	PETERSON		5-6-97	D.H. 86
63	14	19	3	80	128	
		26	10	71	197	
		31	15	60	257	
		36	20	50	283	
		39	23	40	310	
		40	24	32	323	
		43	27	26	349+	
→ 96" @ 20 PSI						

REMARKS

D/H - 86 PSI

MANUFACTURER	STAGE	S.N.	TOTAL HEAD	SIZE

$$\begin{array}{r} 63 \\ 20 \\ \hline 43 \end{array}$$

$$\begin{array}{r} 63 \\ 24 \\ \hline 39 \end{array}$$

$$\begin{array}{r} 63 \\ 27 \\ \hline 34 \end{array}$$

$$\begin{array}{r} 31 \\ 16 \\ \hline 15 \end{array}$$

$$\begin{array}{r} 63 \\ 32 \\ \hline 31 \end{array}$$

$$\begin{array}{r} 36 \\ 19 \\ \hline 15 \end{array}$$

$$\begin{array}{r} 63 \\ 50 \\ \hline 13 \end{array}$$

$$\begin{array}{r} 63 \\ 37 \\ \hline 24 \end{array}$$

C O V E R

FAX

S H E E T

To: Mr. Mack Frazelle
Fax #: 910-451-3350
Subject: Well # 632
Date: September 27, 1995
Pages: Three, including this cover sheet.

COMMENTS:

Hello !!!!!!!!!!!!!!!


Following find quotation for the above application. Hard copy to follow by mail. If any questions, please call me.

Thanks !!!!!!!!!!!!!!! "Pete"

From the desk of...

N. F. "Pete" Lowe
Industrial Sales
Pump & Lighting Company
205-B Hyde Park
Cary, North Carolina 27513

919-460-0051
Fax: 919-460-0051

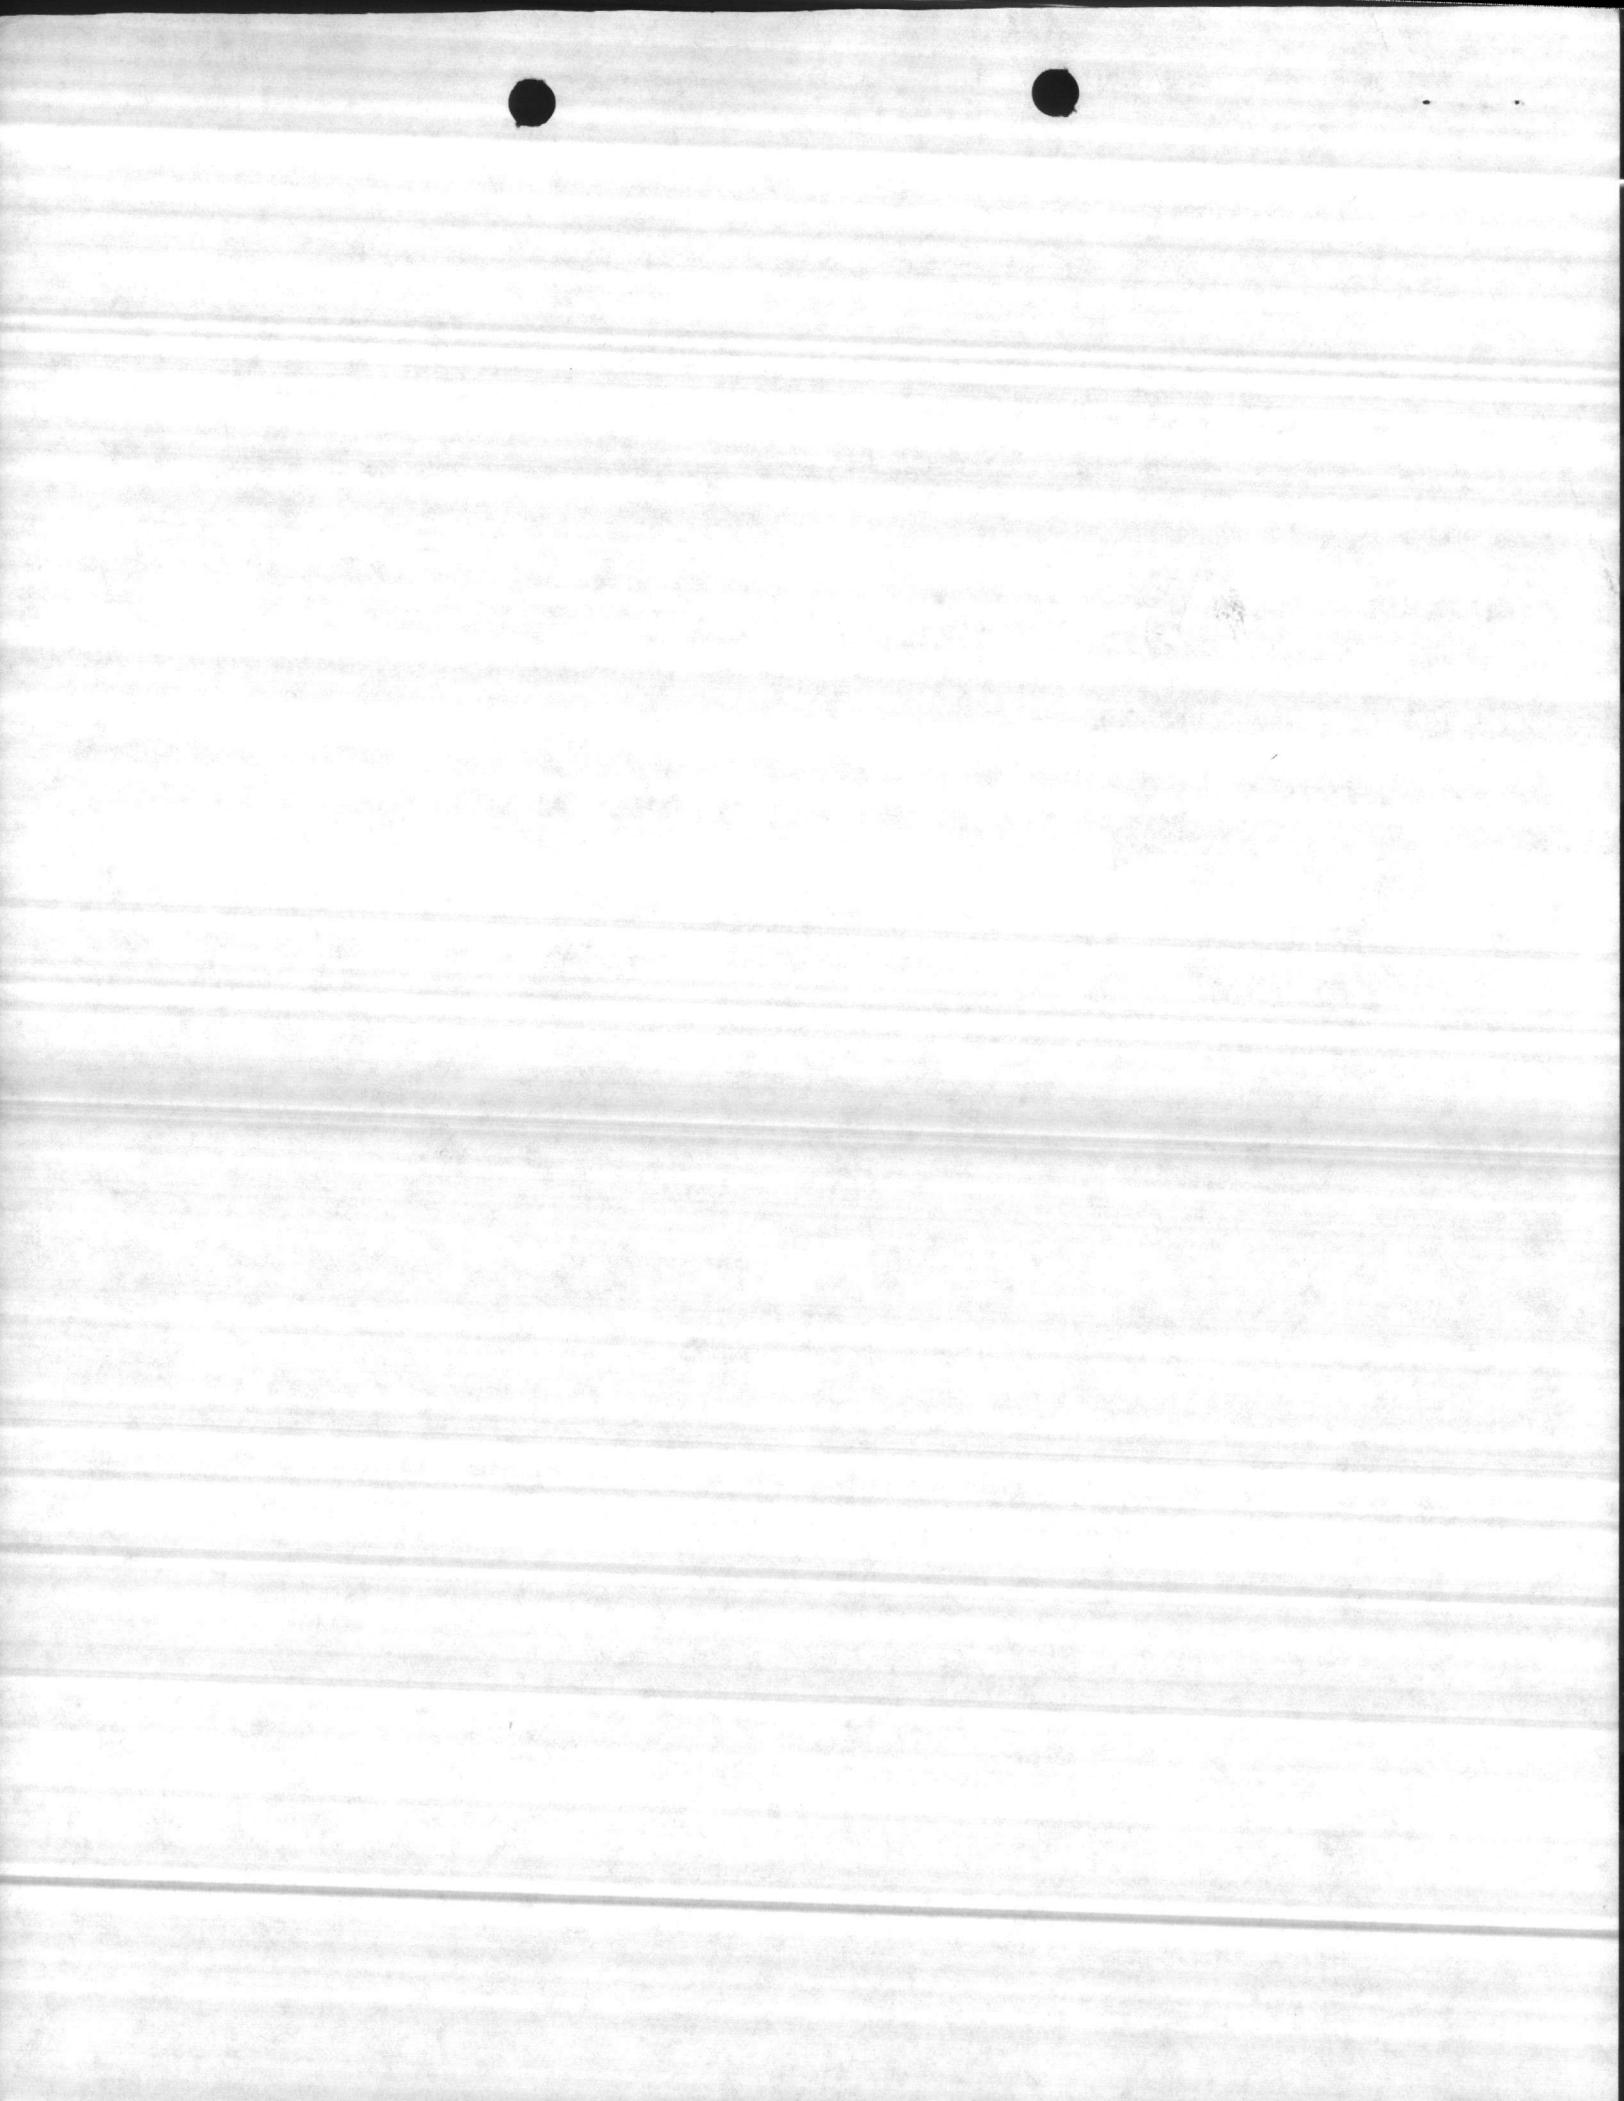



Pump & Lighting

315 9TH STREET, S.E. • P.O. BOX 2504 • HICKORY, NC 28601 • PHONE: (704) 324-9705 • FAX: (704) 324-4365

September 27, 1995

Mr. Mack Frazelle
PSC Box 20004
Base Maintenance Div. Bin #1)
Camp LeJeune, North Carolina
28542

Dear Mack:

Subject: Well 632

We are pleased to offer the following "American Made" equipment for your evaluation on the above application.

Design Conditions: 250 GPM @ 160' TDH

One (1) ea. Fairbanks Morse Figure 7000, Model 8M, Six Stage, Vertical Turbine Bowl Assembly. Product Lubricated, with Impellers Trimmed to Above Conditions.

One (1) ea. 6" X 10' Suction Pipe

Two (2) ea. 6" X 5' Top-Bottom Column Pipe

Five (5) ea. 6" X 10' Intermediate Column Pipe

Two (2) ea. 1" X 6" X 5' Top-Bottom Line Shaft

Five (5) ea. 1" X 6" x 10' Intermediate Line Shaft

One (1) ea. 16 1/2 X 6 Type "CT" Discharge Head

One (1) ea. 1" Packing Box 175 PSI


One (1) ea. 24 X 24 Cast Iron Foundation Plate

One (1) ea. Vertical Hollow Shaft Motor. 15 H.P., 208 Volt, 3 Phase, 1770 RPM, 1" BX, WP-1 Enclosure, Non-Reverse Clutch.

Your Cost

\$6,360.00




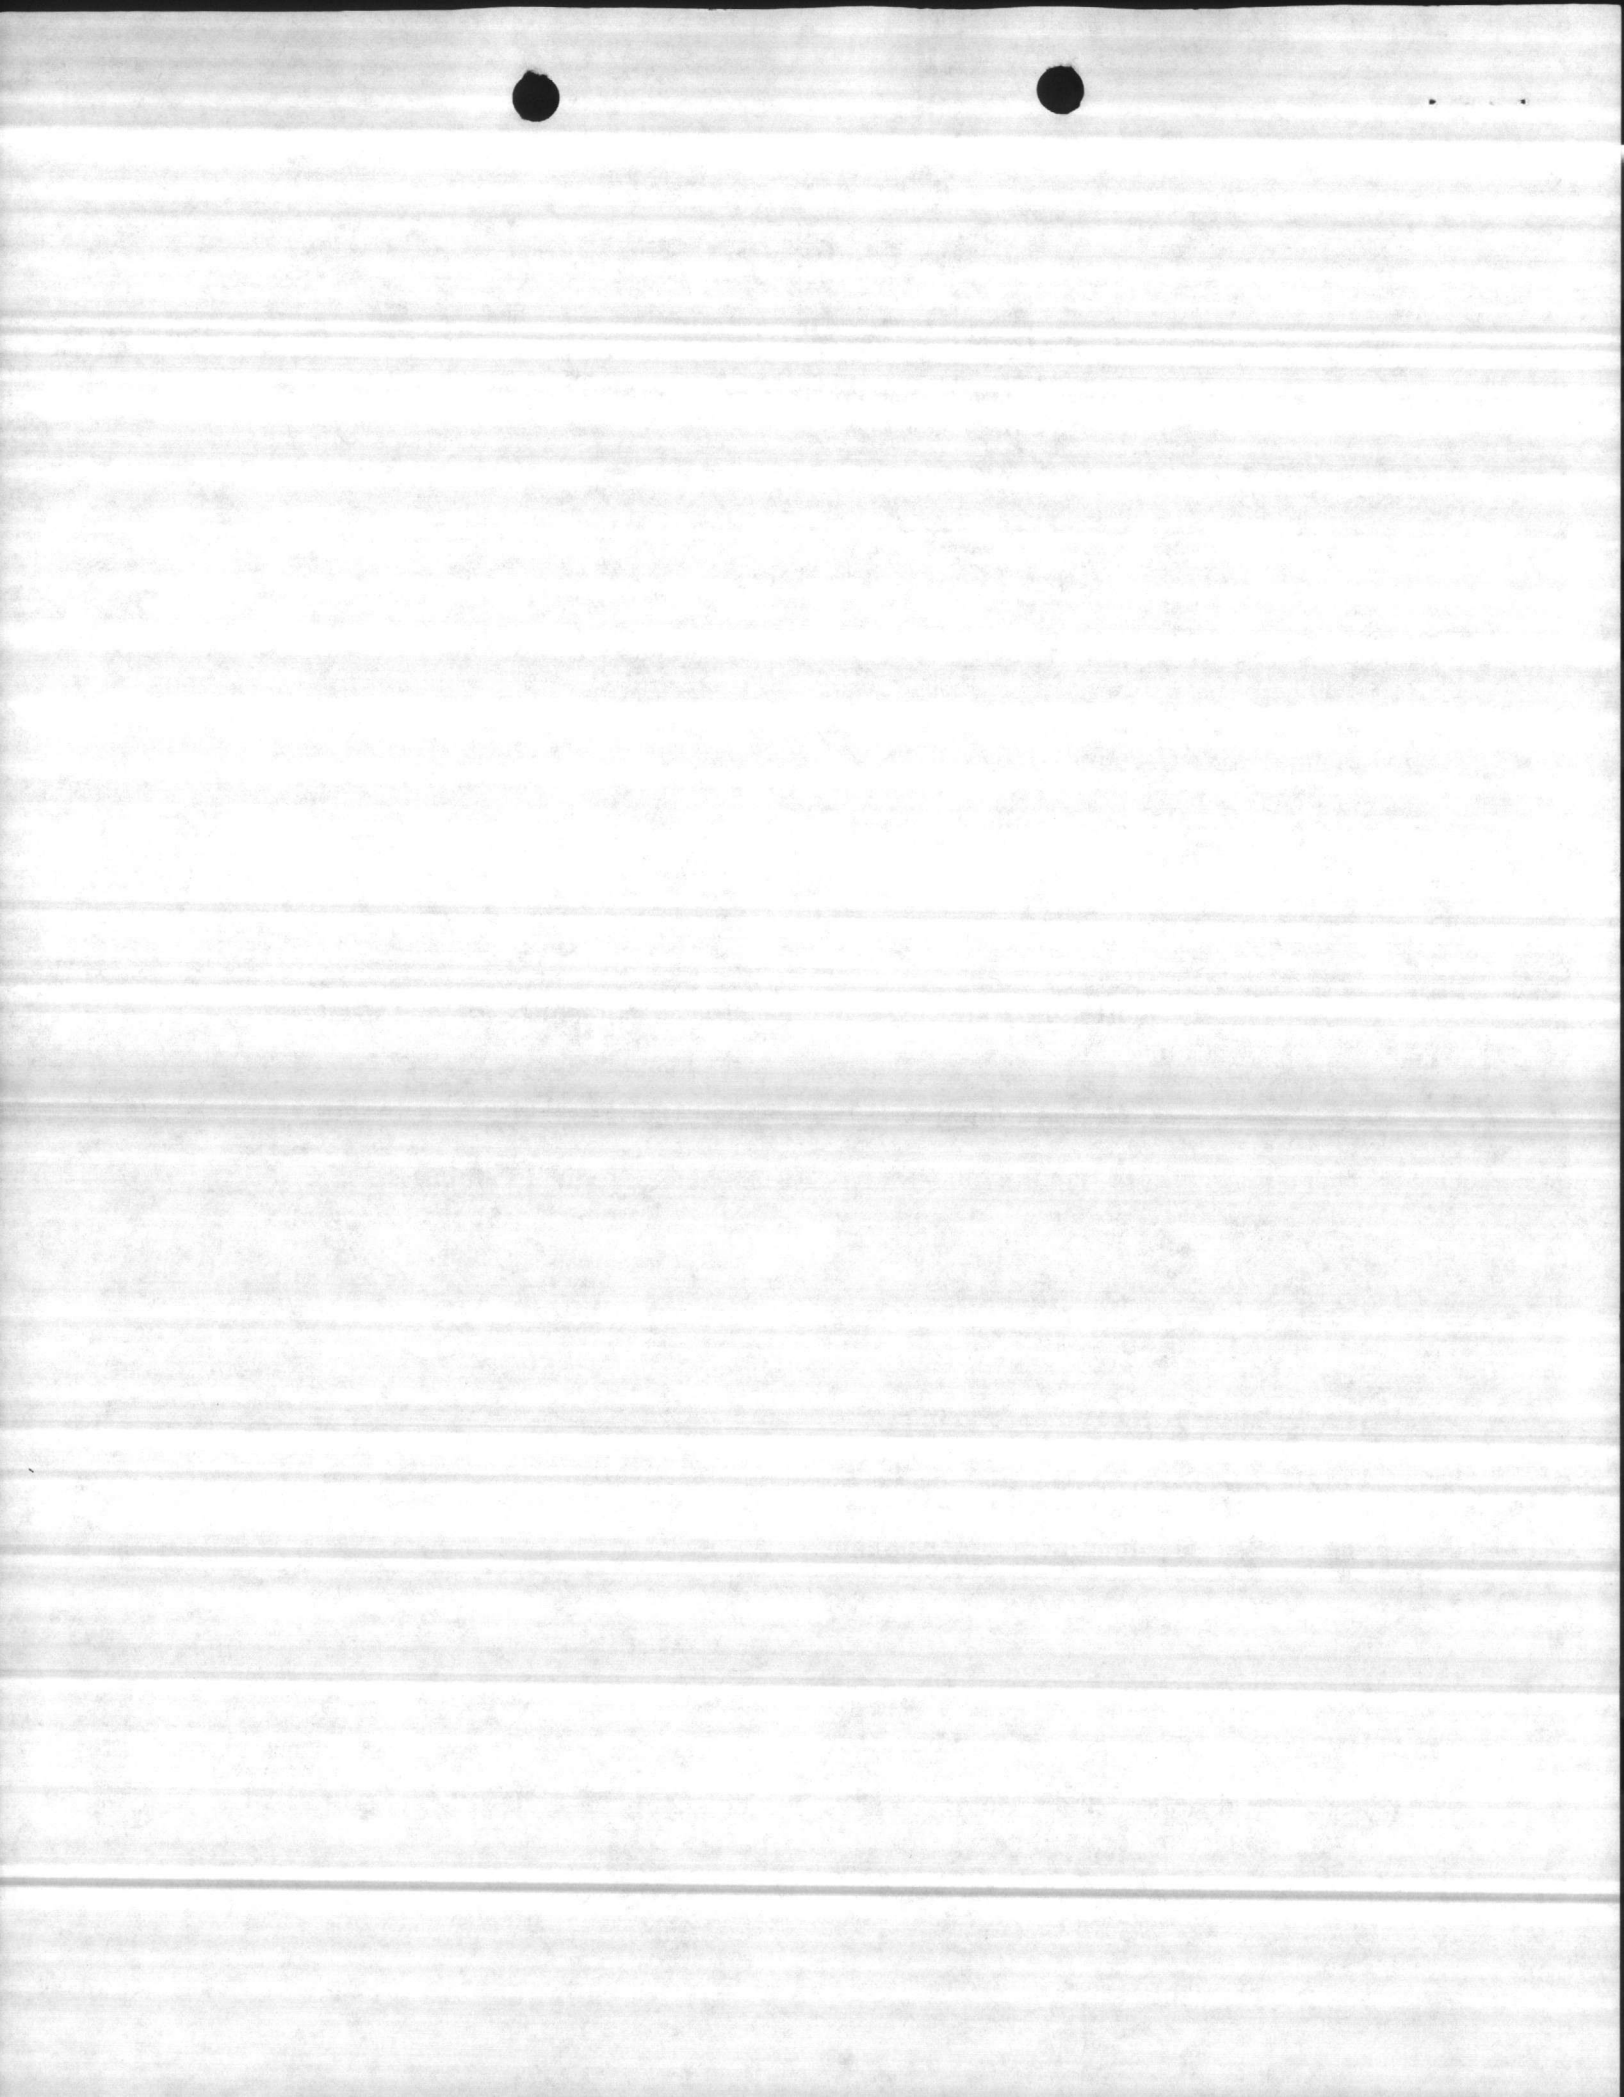

Mr. Mack Frazelle
Page 2
September 27, 1995


Price includes freight to your location and start up service. Price does not include any taxes, anchor bolts, gauges, or other accessories not listed above. Terms are net 30 days. If any questions, or I may be of further service to you, please call me.

Best regards,

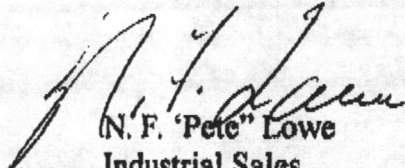
N. F. "Pete" Lowe
Industrial Sales

NFL

cc: Ed White
Cindy Benfield
File

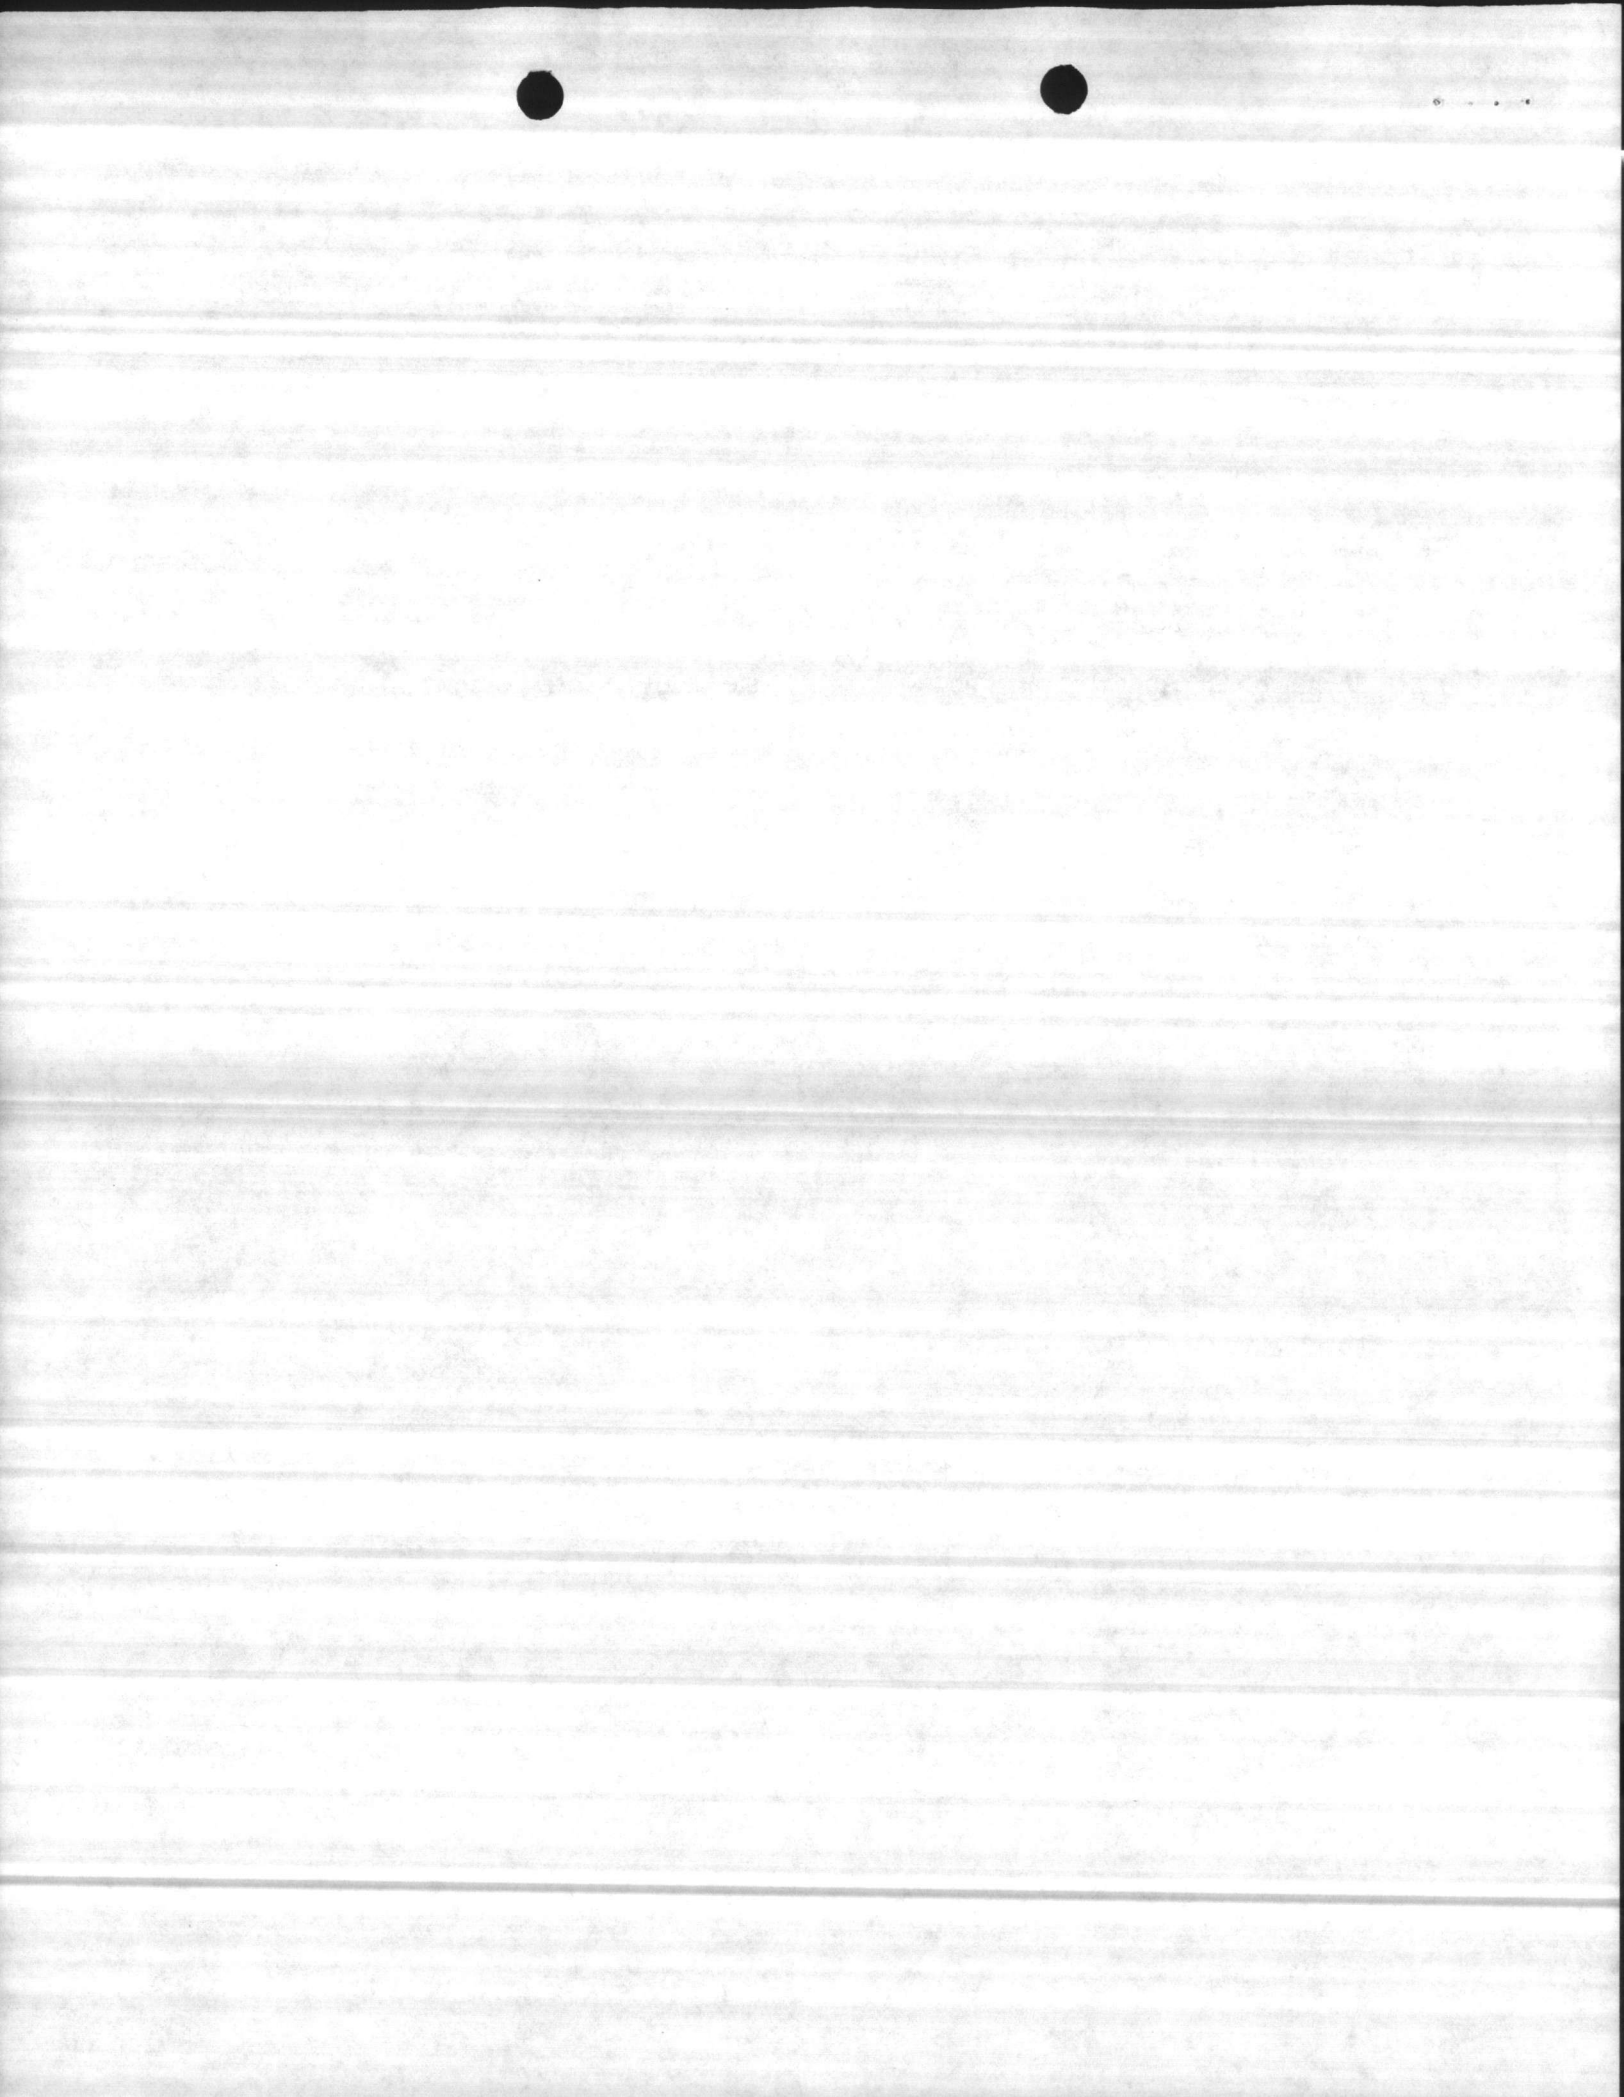



Pump & Lighting

315 9TH STREET, S.E. • P.O. BOX 2504 • HICKORY, NC 28601 • PHONE: (704) 324-9705 • FAX: (704) 324-4365

September 27, 1995

Mr. Mack Frazelle
PSC Box 20004
Base Maintenance Div. Bin *1)
Camp LeJeune, North Carolina
28542

Dear Mack:

Subject: **Well 632**

We are pleased to offer the following "American Made" equipment for your evaluation on the above application.

Design Conditions: 250 GPM @ 160' TDH

One (1) ea. Fairbanks Morse Figure 7000, Model 8M, Six Stage, Vertical Turbine Bowl Assembly. Product Lubricated, with Impellers Trimmed to Above Conditions.

One (1) ea. 6" X 10' Suction Pipe

Two (2) ea. 6" X 5' Top-Bottom Column Pipe

Five (5) ea. 6" X 10' Intermediate Column Pipe

Two (2) ea. 1" X 6" X 5' Top-Bottom Line Shaft

Five (5) ea. 1" X 6" x 10' Intermediate Line Shaft

One (1) ea. 16 1/2 X 6 Type "CT" Discharge Head

One (1) ea. 1" Packing Box 175 PSI

One (1) ea. 24 X 24 Cast Iron Foundation Plate

One (1) ea. Vertical Hollow Shaft Motor. 15 H.P., 208 Volt, 3 Phase, 1770 RPM, 1" BX, WP-1 Enclosure, Non-Reverse Clutch.

Your Cost \$6,360.00



A Hughes Supply Company

INVENTION TITLE

Applicant: [Name]

Base Reference: [Number]

Priority: [Date]

Class: [Code]

Abstract: [Text]

Background: [Text]

Summary: [Text]

Claims: [Text]

Description: [Text]

Drawings: [Text]

References: [Text]

Examination: [Text]

Conclusion: [Text]

Remarks: [Text]


Signature: [Text]

Date: [Text]

Mr. Mack Frazelle
Page 2
September 27, 1995

Price includes freight to your location and start up service. Price does not include any taxes, anchor bolts, gauges, or other accessories not listed above. Terms are net 30 days. If any questions, or I may be of further service to you, please call me.

Best regards,

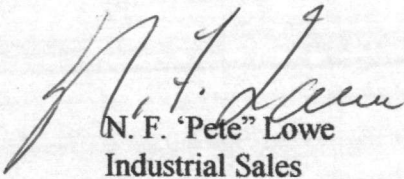
N. F. 'Pete' Lowe
Industrial Sales

NFL


cc: Ed White
Cindy Benfield
File

CLASSIC CREST

CLASSIC CREST

VERTICAL TURBINE PUMPS SINGLE STAGE PERFORMANCE

#632

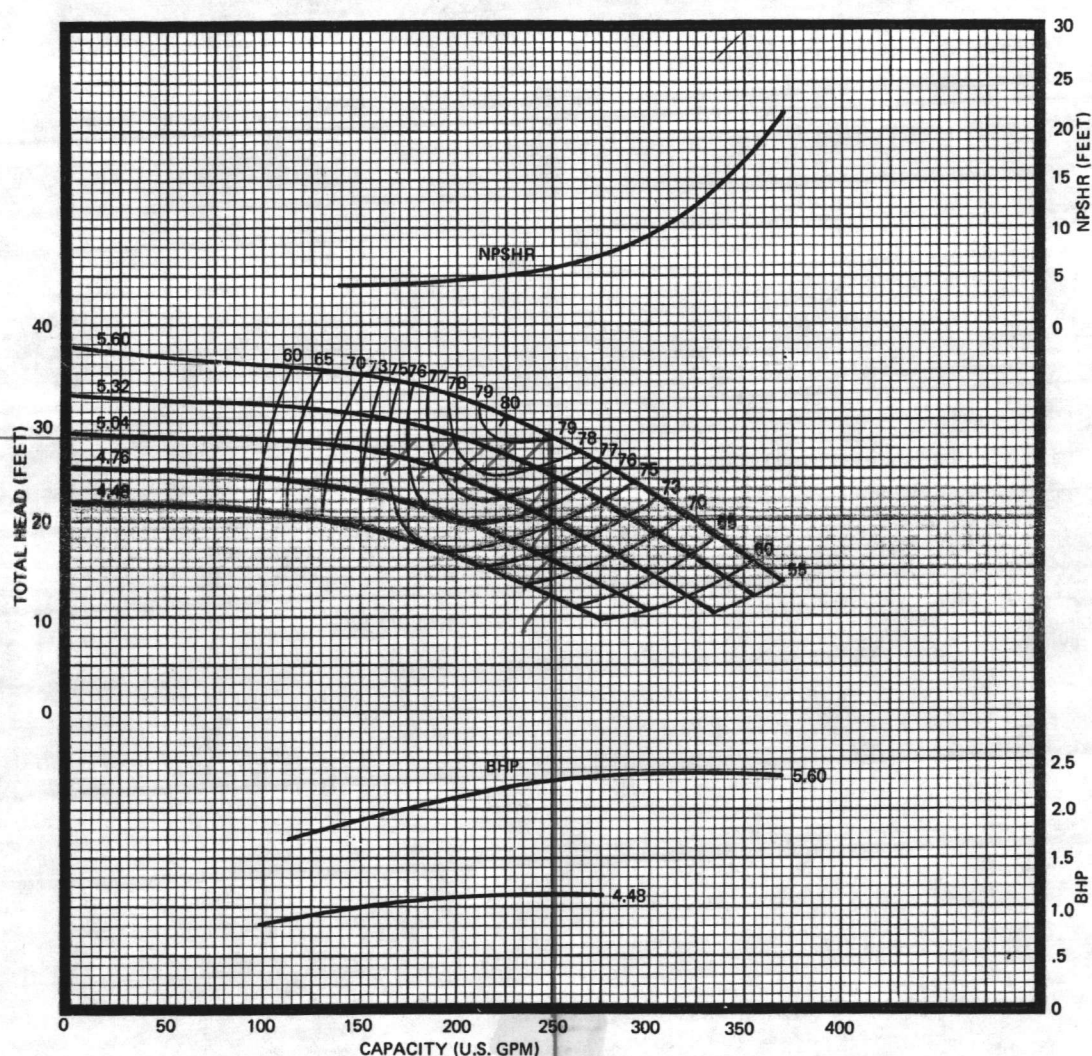

8M
7000
1770
RPM

ENCLOSED
IMPELLER
T7CA92

EFFICIENCY CORRECTIONS⁽¹⁾


NUMBER OF STAGES	EFFICIENCY CHANGE
1	-7.0 POINTS
2	-3.0 POINTS
3	-1.0 POINTS
4	NO CHANGE
5	NO CHANGE
6 OR MORE	NO CHANGE

BOWL MATERIAL	EFFICIENCY CHANGE
CAST IRON	-2.0 POINTS
ENAMELED C.I.	NO CHANGE

IMPELLER MATERIAL	EFFICIENCY CHANGE
CAST IRON	-1.0 POINTS
BRONZE	NO CHANGE
ENAMELED C.I.	NO CHANGE

(1) Refer to "Application and Reference Data" for head correction.

DIMENSIONS (Inches)

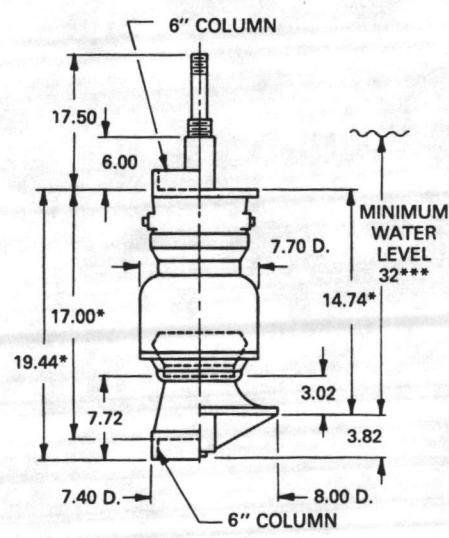


*Add 6.58 for each additional stage.

TECHNICAL DATA

DATA	VALUE
MAXIMUM OPERATING SPEED	3600 RPM
MAXIMUM NUMBER OF STAGES	32**
PUMP SHAFT DIAMETER	1 3/16 IN.
IMPELLER EYE AREA	6.93 SQ. IN.
MAXIMUM SPHERE SIZE	.56 IN.
K _t (THRUST FACTOR)	2.32 LBS./FT.
K _s (ROTOR WT. PER STAGE)	5.25 LBS.
BOWL WT. (FIRST STAGE)	82 LBS.
BOWL WT. (EACH ADD'L. STAGE)	31 LBS.
ALLOWABLE SHAFT STRETCH	.37 IN.**
WK ² (FIRST STAGE)	.17 LBS.-FT. ²
WK ² (EACH ADD'L. STAGE)	.16 LBS.-FT. ²
BOWL RING CLEARANCE	.014/.018 IN.

** These are nominal values. Refer to "Application and Reference Data" for information further limiting or extending these values.

*** This value is the minimum submergence required to prevent vortexing only. This value may need to be increased to provide adequate NPSHA.

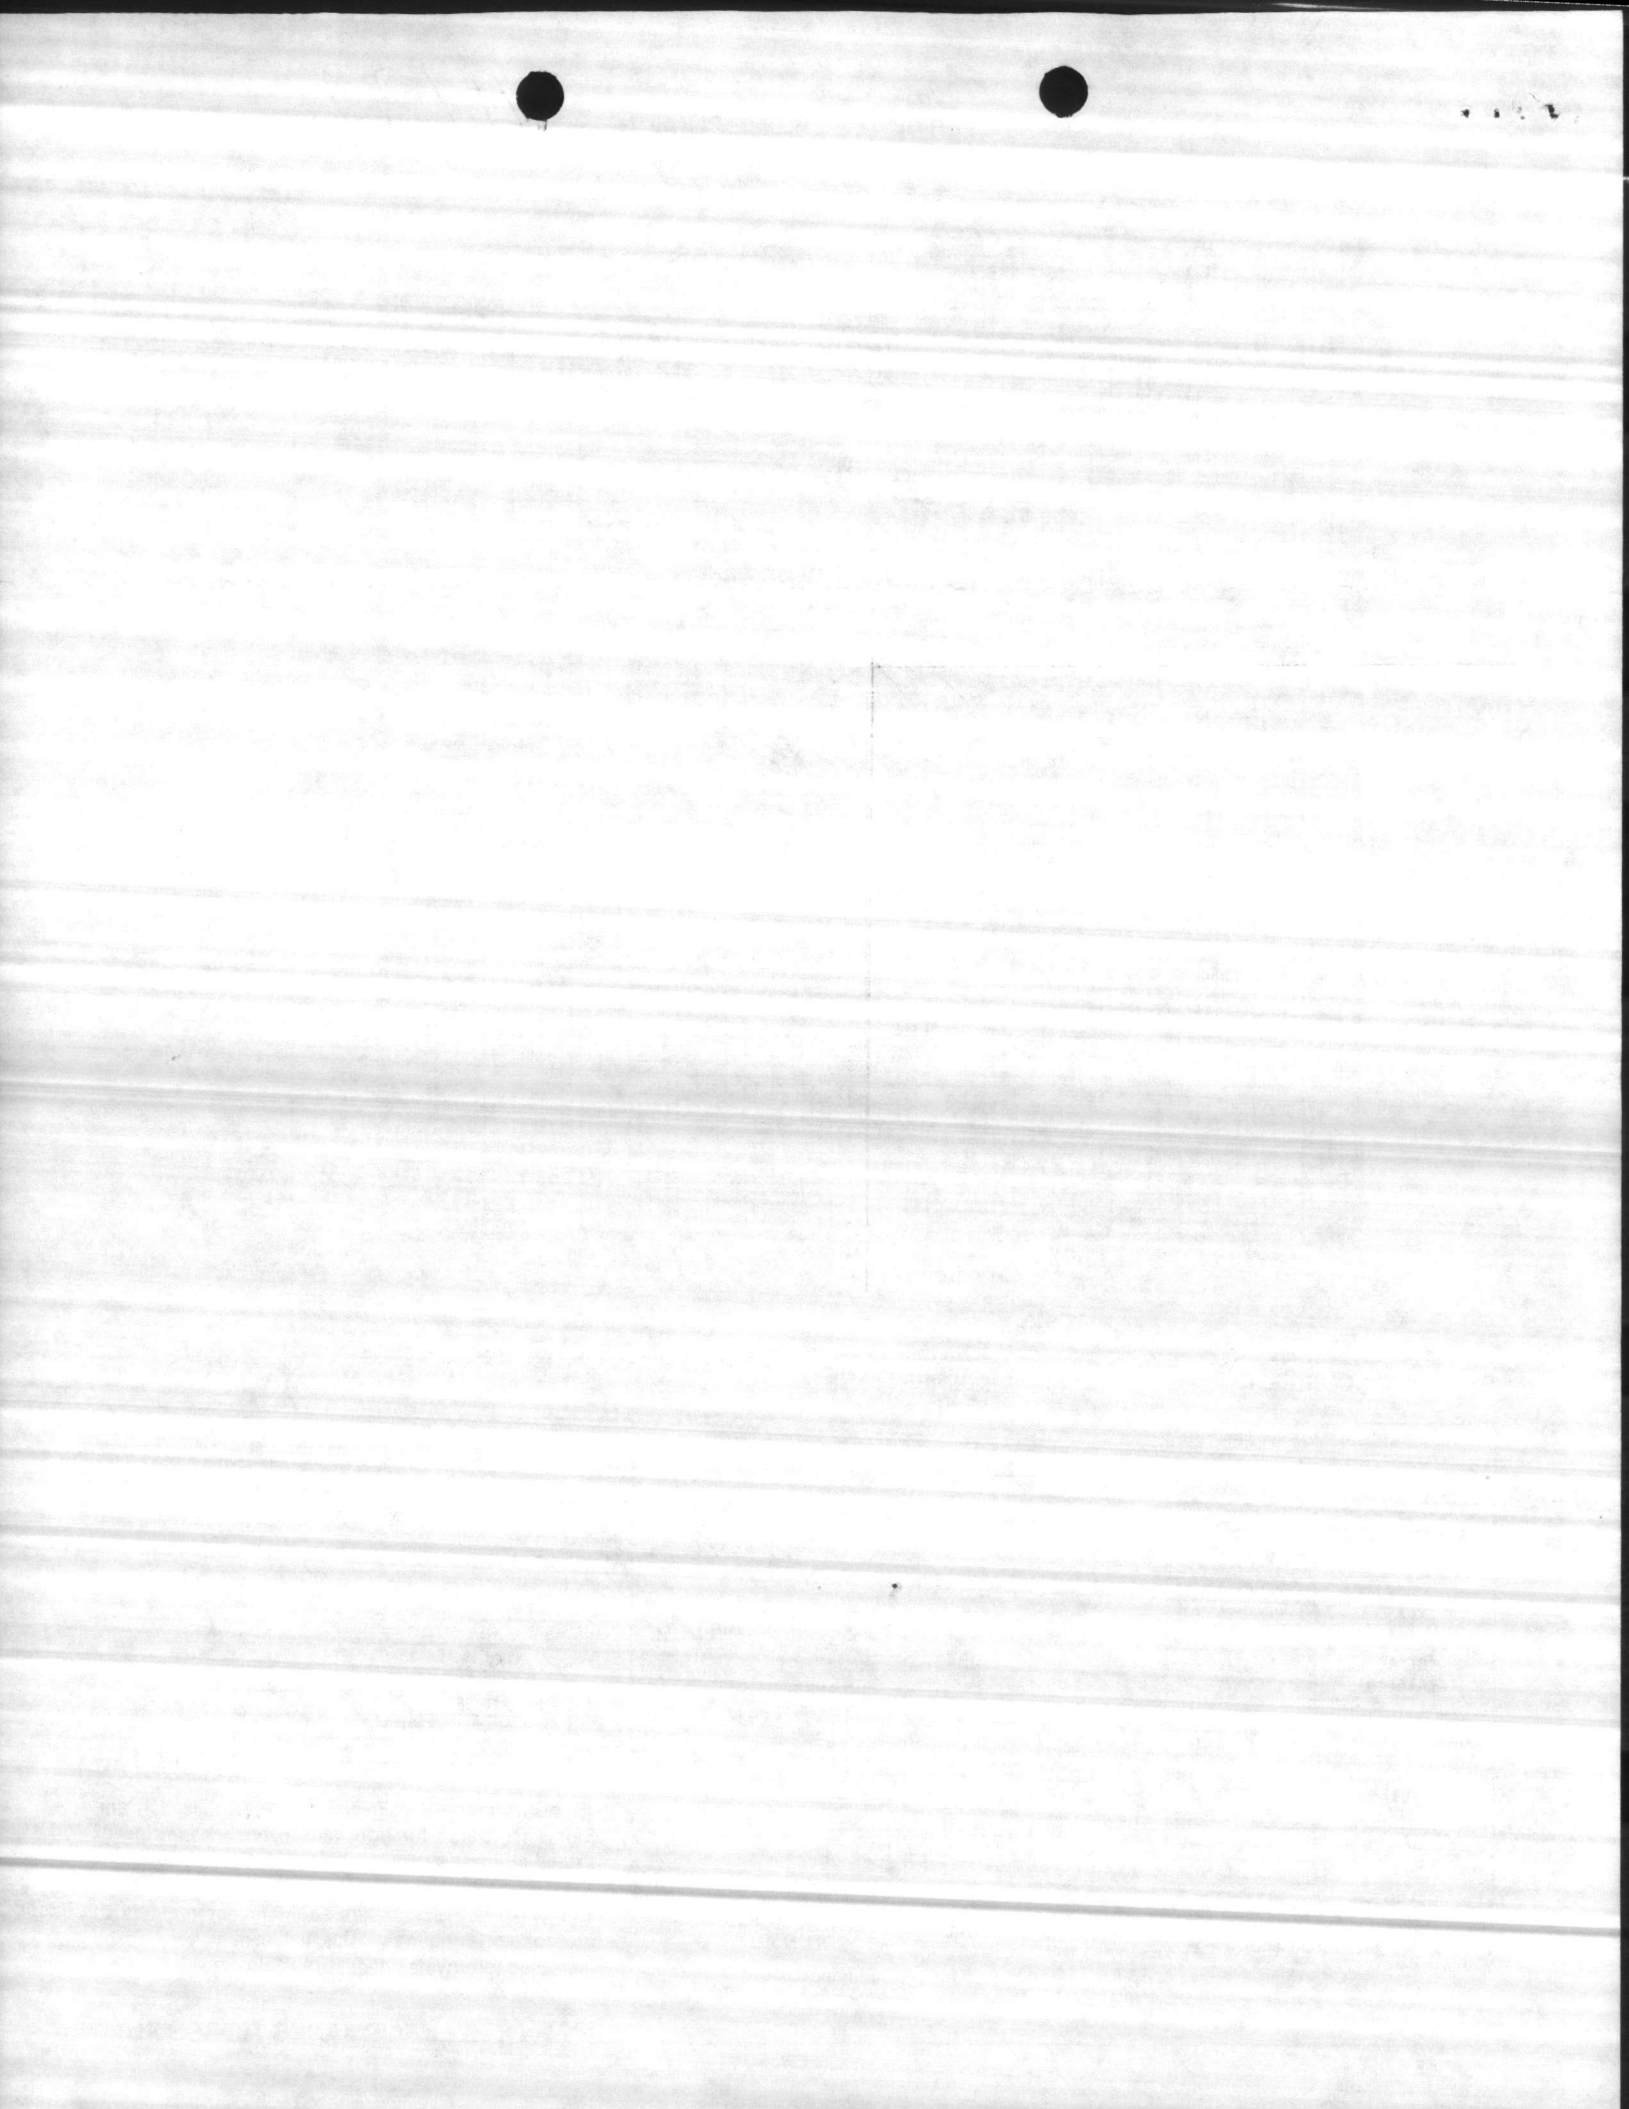

WELL #

632

DATE	LENGTH OF AIR LINE	STATIC LEVEL	PUMPING LEVEL	DRAW DOWN	DISCHARGE PRESSURE	CAP. PER FOOT OF DRAW DOWN	TOTAL CAP.
3/28/77	63		37		35		185
			38		33		192
			39		31		201
			40		(29)		205
			42		27		214
			43		25		222
			47		20		246
			50		16		
			51		14		
			54		10		
REMARKS:	1-11-79	used ALT. Gage					
1-11-79			26'		30		170
			23'		25		187
			20'		20		201
			28'		35		146
2-13-80	65'		53'		20 ⁵⁰⁷		205
			57'		15		221
			50'		25		187
DEPTH OF WELL:							
AIRLINE ELEVATION:	+						
DATE INSTALLED:							




WELL NUMBER		BY			DATE	
AIR LINE	STATIC LEVEL	PUMPING LEVEL	DRAIN DOWN	DISCHARGE PRESSURE	GPM	START TIME
632	11	16	5	57	105	1030
		18	7	50	128	
		21	10	40	154	
		25	14	30	185	
		31	20	20	224	
		32	21	15	240	

*Prosser
St*

REMARKS

MANUFACTURER	STAGE	S.N.	TOTAL HEAD	SIZE

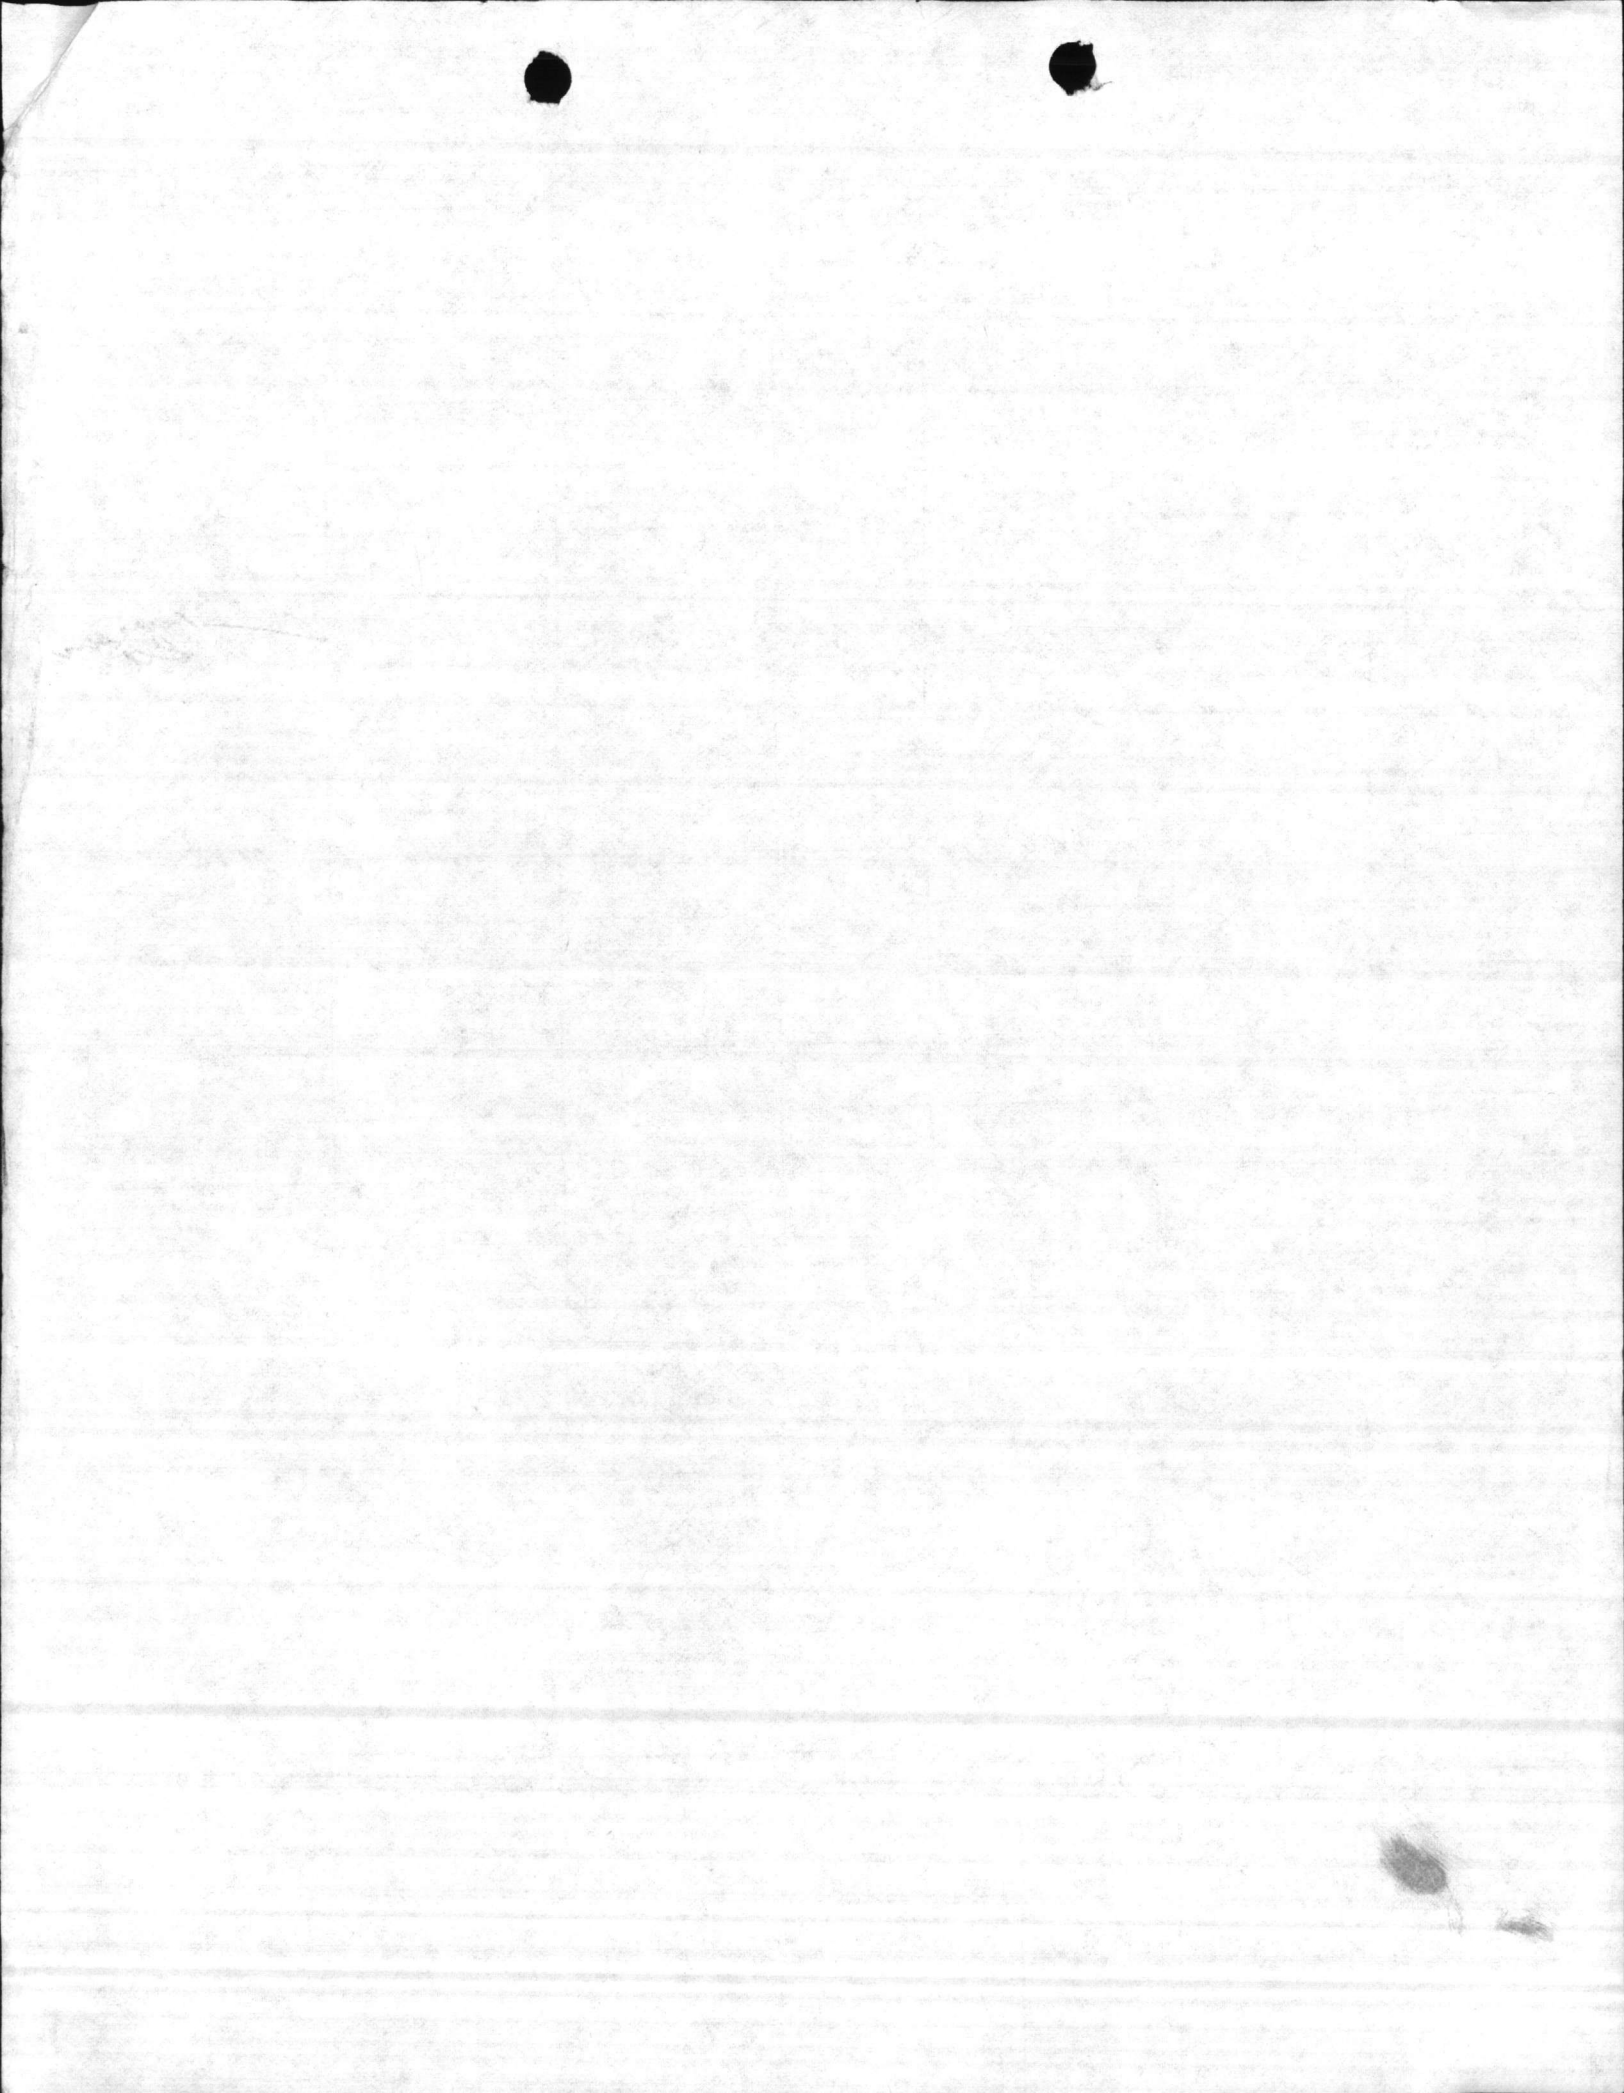

WELL NUMBER 632

Thomas - Brown


DATE 4 30 90

AIR LINE	STATIC LEVEL	PUMPING LEVEL	DRAIN DOWN	DISCHARGE PRESSURE	GPM	START TIME
43	12	18	16	55	108	05
		21	9	45	130	15
		25	13	35	159	25
		30	18	25	195	35
		31	19	20	205	45
		33	21	15	224	55
		38	26	10	242	65
		39	27	5	256	75

REMARKS

dead head @ 70 PSI
 set @ 15 PSI

MANUFACTURER	STAGE	S.N.	TOTAL HEAD	SIZE

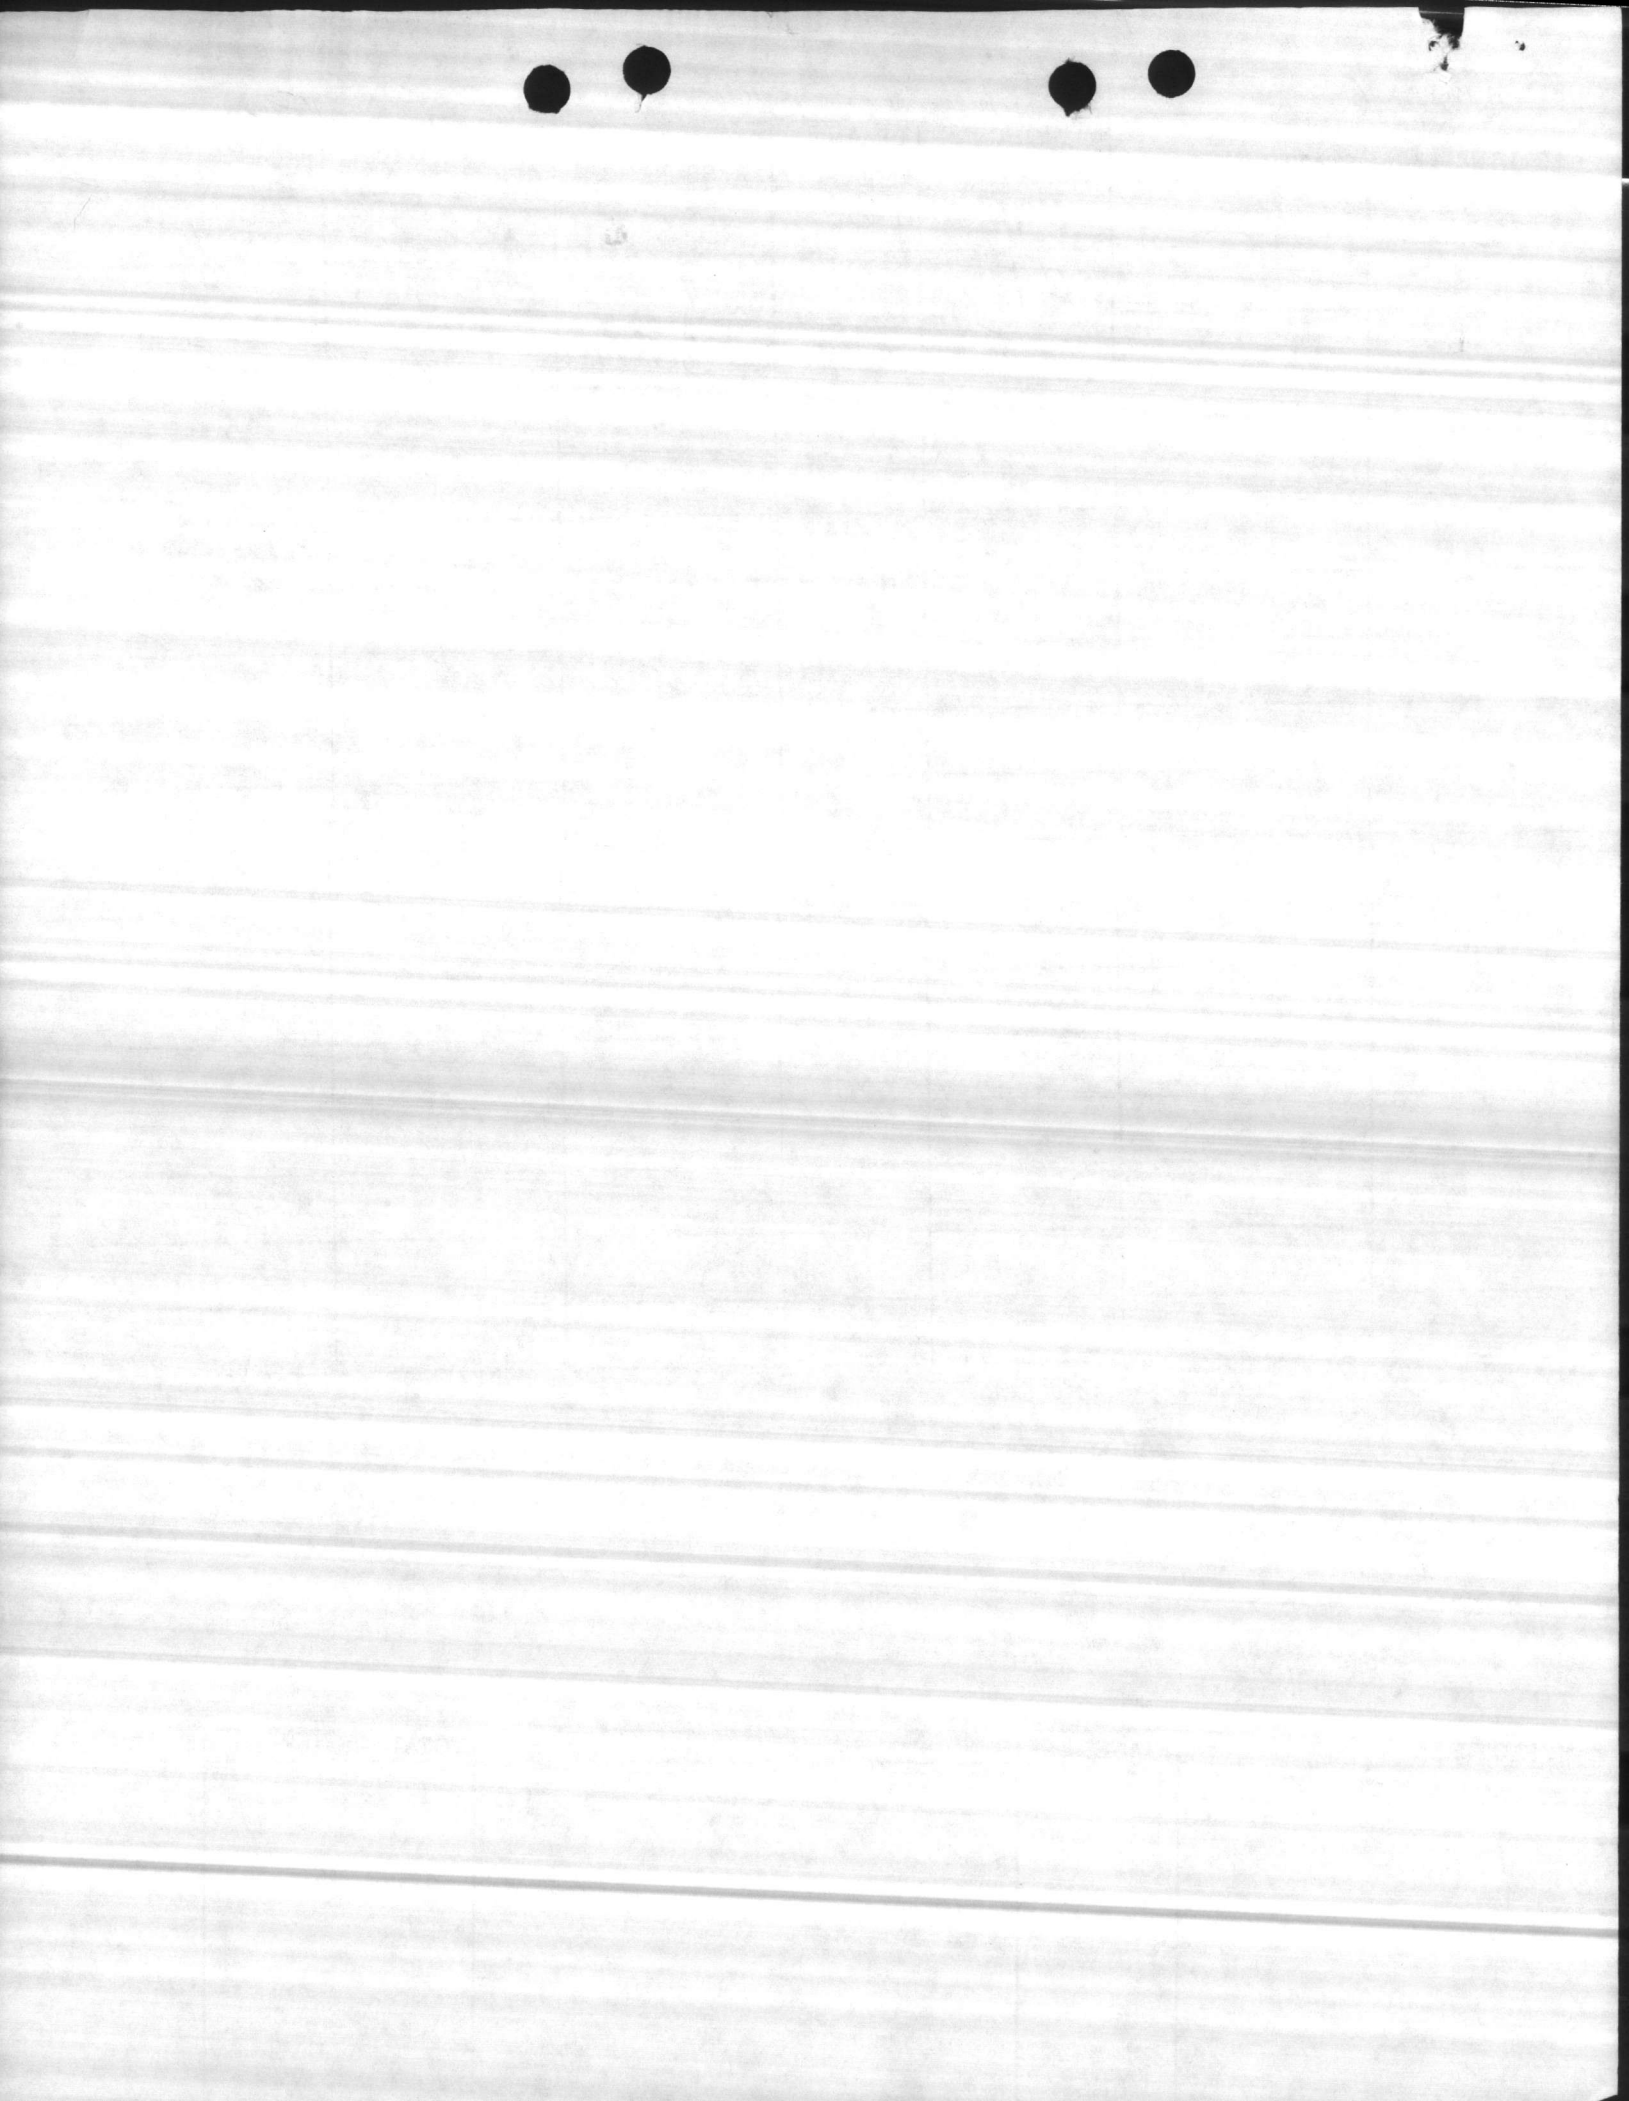

WELL #

632

9,10,81

DATE

LENGTH OF AIR LINE

STATIC LEVEL

PUMPING LEVEL

DRAW DOWN

DISCHARGE PRESSURE

CAP. PER FOOT OF DRAW DOWN
GPM

TOTAL CAP.

63'

23'

39'

16'

38^{LB}

128

42'

19'

35^{LB}

137

45'

22'

32^{LB}

143

47'

24'

29^{LB}

154

REMARKS:

set at 29^{LB} pressure

23' static

47' pumping level

24' draw down

154 GPM

63' air line

DEPTH OF WELL:

AIRLINE ELEVATION:

DATE

INSTALLED:



DEPARTMENT OF THE INTERIOR
GEOLOGICAL SURVEY
OFFICE OF WATER DATA COORDINATION
INVENTORY OF HYDROLOGIC DATA STATIONS
QUALITY OF WATER


APPROVED.
Budget Bureau No. 42-R1485
Approval Expires June 30, 1968

1. AGENCY CODE MC	2. TYPE Q	3. LATITUDE 34 37 14 " N	4. LONGITUDE 77 17 36 " W	5.
6. AGENCY STATION NO. 632		7. STATION NAME HP20-632		
8. DRAINAGE BASIN CODE No. 06 Letter N		9. STATE CODE 32	10. COUNTY CODE 133	11. COUNTY NAME ONSLAW
12. PERIOD OF RECORD Began 1957 Discontinued		Y <input type="checkbox"/> Continuous <input type="checkbox"/> Interruption Exceeds 1 Year		13.
15. SITE				
<input type="checkbox"/> 101 Stream		<input type="checkbox"/> 103 Lake		<input type="checkbox"/> 106 Spring
<input type="checkbox"/> 102 Canal		<input type="checkbox"/> 104 Reservoir		<input checked="" type="checkbox"/> 107 Well
		<input type="checkbox"/> 105 Estuary		<input type="checkbox"/> 110 Other
16. FREQUENCY OF MEASUREMENT				
<input type="checkbox"/> 201 Continuous Recorder		<input type="checkbox"/> 203 Daily		<input type="checkbox"/> 207 Seasonal
<input type="checkbox"/> 202 Telemetered		<input type="checkbox"/> 204 Weekly		<input type="checkbox"/> 208 Annual
		<input type="checkbox"/> 205 Monthly		<input type="checkbox"/> 209 Other Periodic
		<input type="checkbox"/> 206 Quarterly		<input checked="" type="checkbox"/> 210 Occasional
17. TYPES OF DATA AVAILABLE				
<i>Physical</i>		<i>Chemical</i>		<i>Organic</i>
<input type="checkbox"/> 311 Temperature		<input type="checkbox"/> 331 Dissolved solids		<input type="checkbox"/> 351 Pesticides (insecticides, herbicides, etc.)
<input type="checkbox"/> 312 Specific Conductance		<input checked="" type="checkbox"/> 332 Chlorides Only		<input type="checkbox"/> 352 Synthetic detergents
<input type="checkbox"/> 313 Turbidity		<input type="checkbox"/> 333 Nutrients (Nitrogen and phosphorus compounds)		<input type="checkbox"/> 353 Other
<input type="checkbox"/> 314 Color		<input type="checkbox"/> 334 Common ions		<i>Biologic</i>
<input type="checkbox"/> 315 Odor		<input checked="" type="checkbox"/> 335 Hardness		<input type="checkbox"/> 361 Coliforms
<input type="checkbox"/> 316 Radioactivity		<input type="checkbox"/> 336 Radiochemical		<input type="checkbox"/> 362 Other Micro-organisms
<input type="checkbox"/> 317 pH (field)		<input type="checkbox"/> 337 Dissolved oxygen		<input type="checkbox"/> 363 BOD
<input checked="" type="checkbox"/> 318 pH (lab)		<input type="checkbox"/> 338 Other Gases		<input type="checkbox"/> 364 Other
<input type="checkbox"/> 319 Eh		<input type="checkbox"/> 339 Other		<i>Sediment</i>
<input type="checkbox"/> 320 Other				<input type="checkbox"/> 371 Concentration
				<input type="checkbox"/> 372 Particle size
				<input type="checkbox"/> 373 Other
18. SUPPLEMENTARY DATA FOR SITE				
<input type="checkbox"/> 421 Surface Water Station		<input type="checkbox"/> 423 Water Stage or Level		<input type="checkbox"/> 425 Time of Travel
<input type="checkbox"/> 422 Ground Water Station		<input checked="" type="checkbox"/> 424 Water discharge		<input type="checkbox"/> 426 Drainage Area
19. STORAGE OF DATA				
<input type="checkbox"/> 501 Periodic Report		<input checked="" type="checkbox"/> 503 Not Published		<input type="checkbox"/> 505 Data on Magnetic Tape
<input type="checkbox"/> 502 Areal Report		<input type="checkbox"/> 504 Data on Punched Card		<input type="checkbox"/> 506 Other
20. OFFICE AT WHICH DATA AVAILABLE				
Office <u>BASE MAINTENANCE DEPARTMENT, UTILITIES DIVISION</u>				
Street No. <u>MARINE CORPS BASE</u>				City Code
City, State, Zip <u>CAMP LEJEUNE, N. C. 28542</u>				<u>0735</u>
21. OFFICE COMPLETING FORM				
<u>BASE MAINTENANCE DEPARTMENT</u>				
22. COMPILER'S NAME				23. DATE
<u>F. E. LEW, JR.</u>				Month Year
				<u>09</u> <u>66</u>





JOHNSTON VERTICAL TURBINE PUMP

#32 -
AIR LINE - 60'

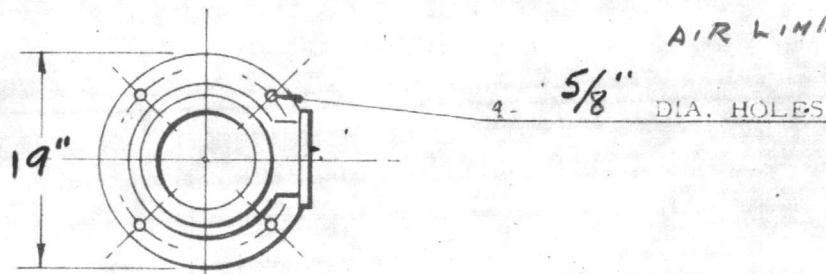

US Electric
VERTICAL HOLLOW SHAFT MOTOR
15 HP 3 PHASE 60 CYCLE
208 VOLT 1760 RPM
Drip-proof ENCLOSURE

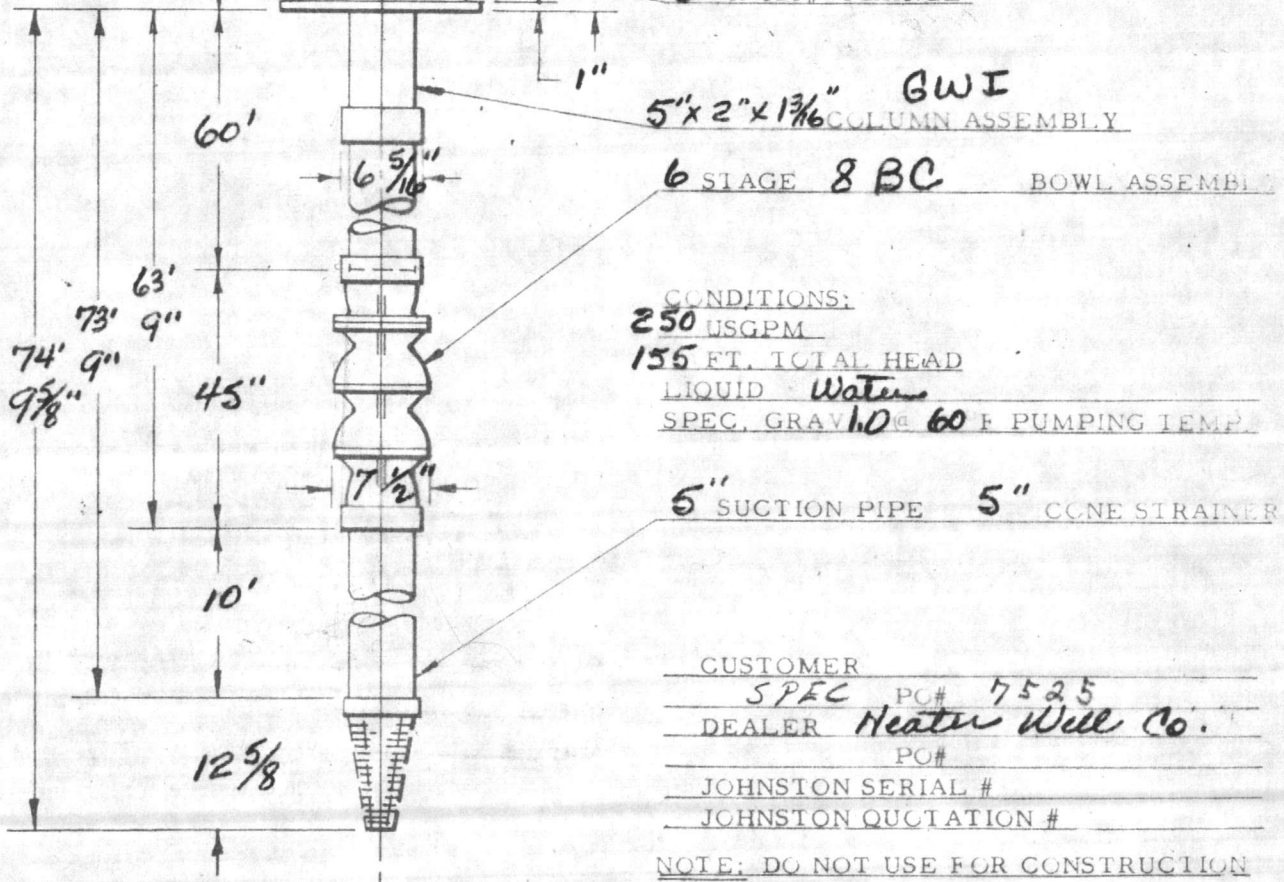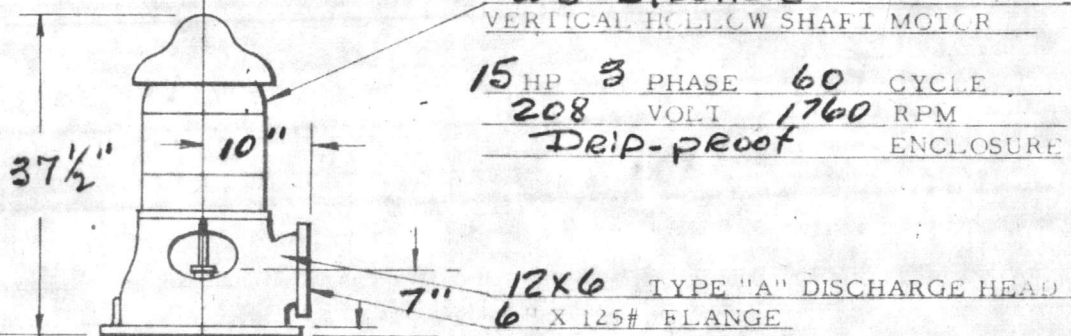

CONDITIONS:
250 USGPM
155 FT. TOTAL HEAD
LIQUID Water
SPEC. GRAV. 1.0 @ 60 F PUMPING TEMP.

CUSTOMER
SPEC PG# 7525
DEALER Heater Well Co.
PO#
JOHNSTON SERIAL #
JOHNSTON QUOTATION #

NOTE: DO NOT USE FOR CONSTRUCTION
UNLESS CERTIFIED

PUBLIC WORKS DEPARTMENT
CAMP LEJEUNE, NORTH CAROLINA

APPROVED

SUBJECT TO CONTRACT REQUIREMENTS

CONTRACT NO. 7520 SPEC. NO. 7520/66
TITLE New Pump Water Well
DATE: 17 Feb 1957 *[Signature]*
BY DIRECTION OF OFFICER
IN CHARGE OF CONSTRUCTION

HYDRAULIC PERFORMANCE IS CONTINGENT ON WELL FINISHING PUMP WITH CLEAR, FRESH NON-AERATED OR NON-GASEOUS WATER FREE FROM DETRITUS WITH NO SUCTION LIFT AND TEMPERATURE NOT TO EXCEED 85 DEGREES FAHRENHEIT

NOTE: ALL COLUMN LOSSES ARE INCLUDED

CUSTOMER: _____
 P.O.# _____
 DEALER: HEATER WELL Co.
 P.O.# _____
 JOHNSTON SERIAL: _____

TOTAL HEAD IN FEET

175
155
135
115
95

Head / Capacity
 155 TDH at 250 GPM
 Pumping water SpGr. 1.0

CHANGE EFFICIENCY AS FOLLOWS	NUMBER OF POINTS	FOR NUMBER OF STAGES

NOTE: ANY CHANGE IN EFFICIENCY CHANGES EITHER THE HEAD OR HORSEPOWER IN PROPORTION

75
70
65
* EFFICIENCY

Boat Efficiency

Boat H.P. Req'd.

210 250 290 330 340

U. S. GALLONS PER MINUTE

HORSE POWER

IMPELLER Bez.
6 3/16" DIA.

JOHNSTON PUMP CO.

PERFORMANCE 6 STAGE



VERTICAL PUMPS

8 BC DEEP WELL TURBINE PUMP

1800 R. P. M.

DATE: 1-18-57 BY: J.D.M.

PASADENA • CALIFORNIA • USA

CURVE SHEET No. _____

PUBLIC WORKS DEPARTMENT
CAMP LEJEUNE, NORTH CAROLINA

APPROVED

SUBJECT TO CONTRACT REQUIREMENTS


CONTRACT NO. 7525 SPEC. NO. 7525/56

TITLE 11-10 Recharge Water Well

DATE: 17 Feb 1967 *[Signature]*

BY DIRECTION OF OFFICER
IN CHARGE OF CONSTRUCTION

WATER LEVEL

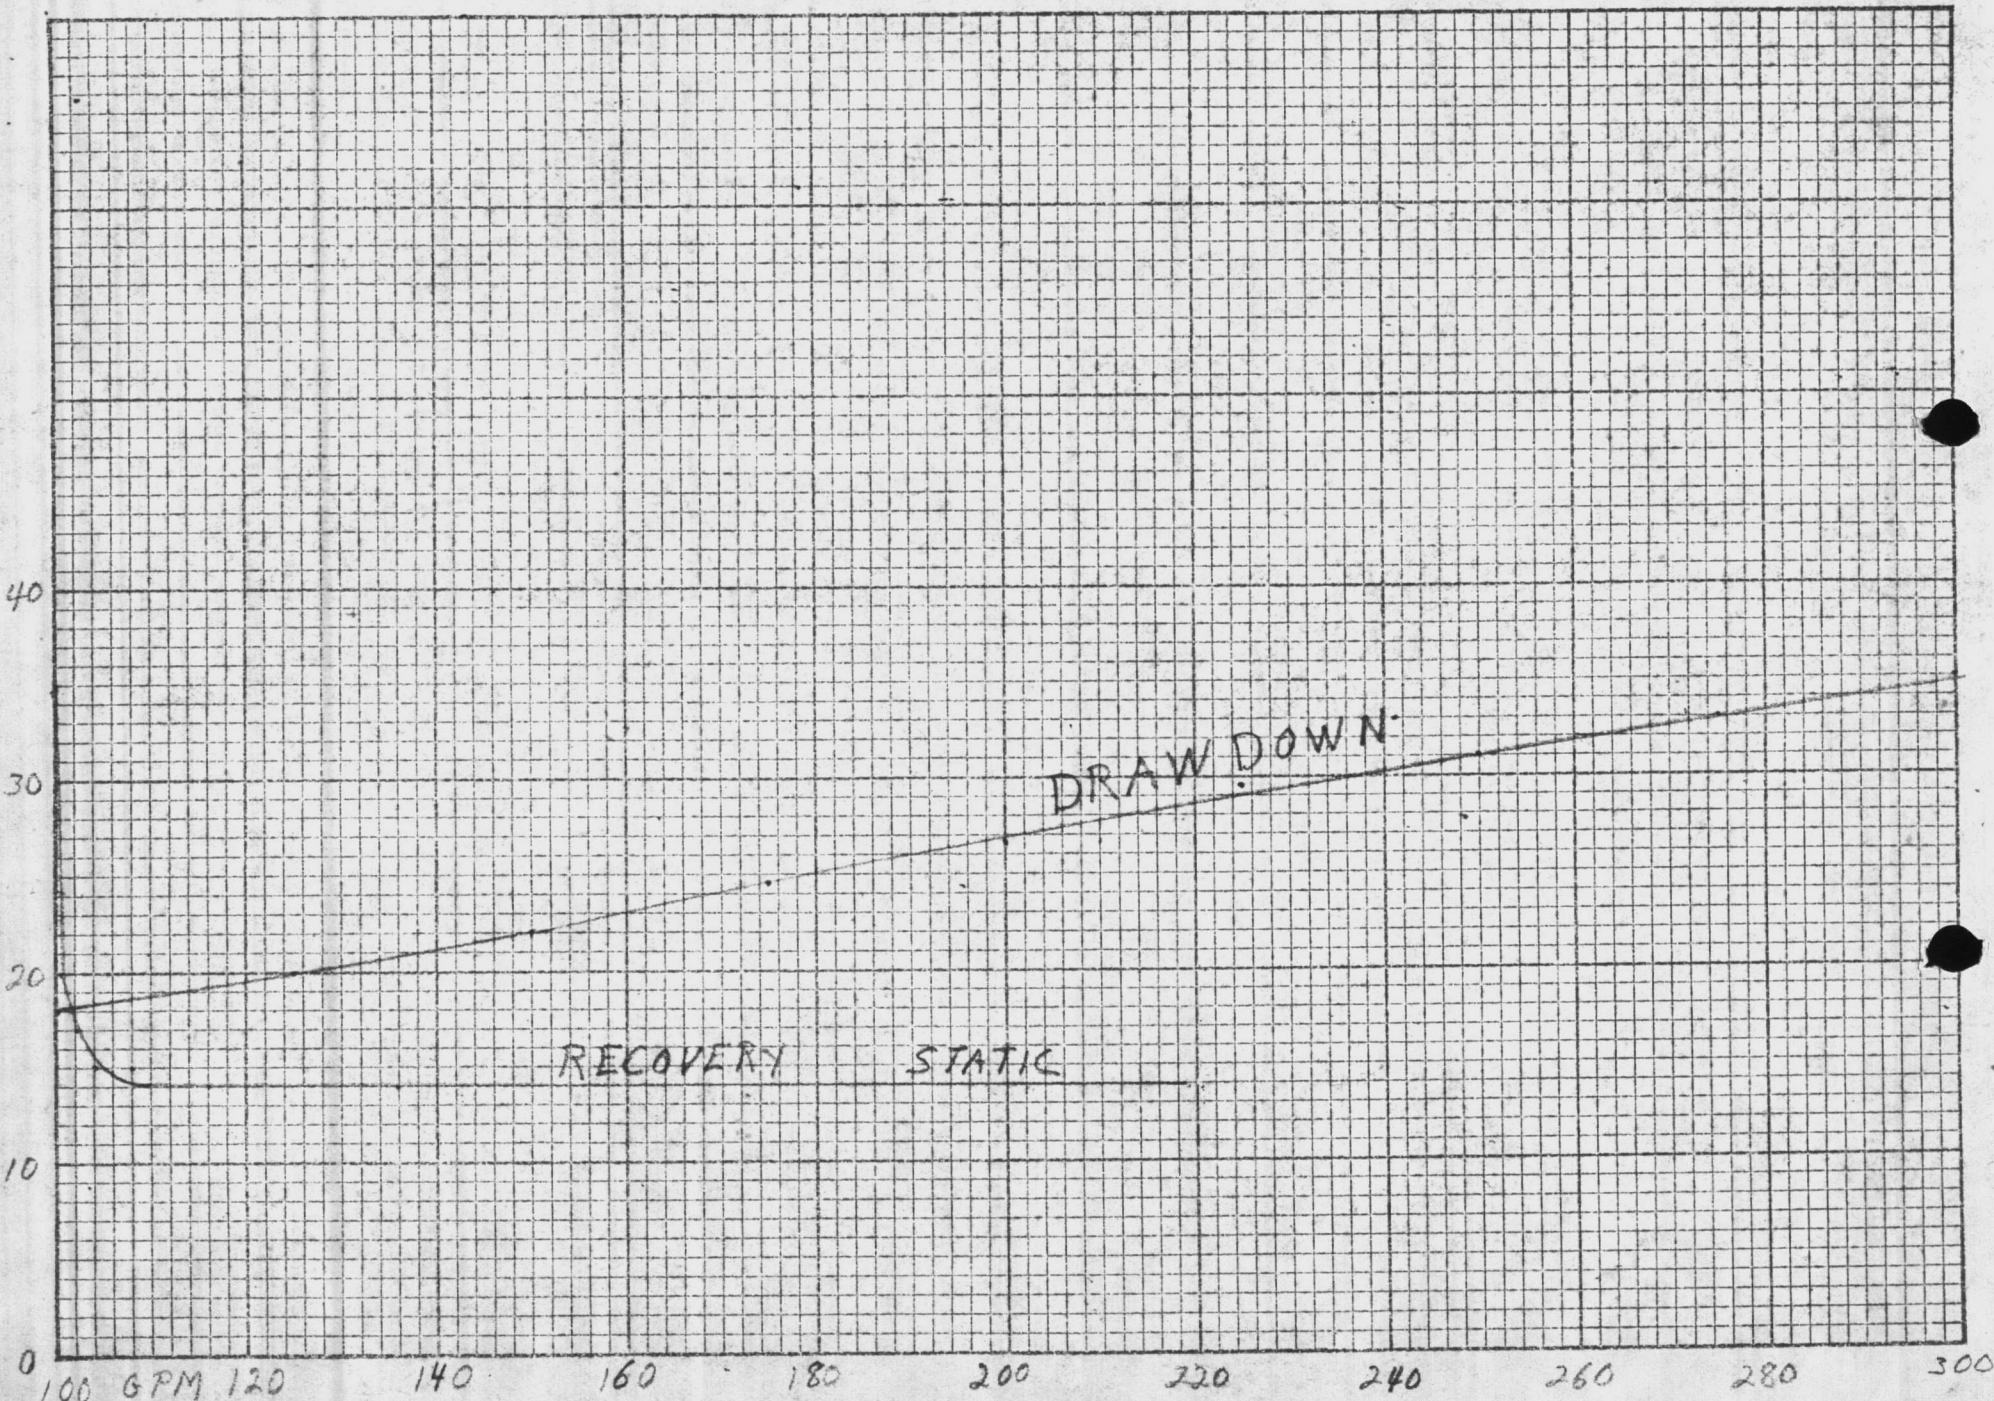

0 MINUTES

10

15

20

25

30

35

FEB 13, 1957

DATA SHEETS

CAMP LEJEUNE
SPEC 7525

NO. 700-10

CHARLES BRUNING COMPANY, INC.
10 x 10 to the Inch.
PRINTED IN U. S. A.

PUBLIC WORKS DEPARTMENT
CAMP LEJEUNE, NORTH CAROLINA

APPROVED

SUBJECT TO CONTRACT REQUIREMENTS

CONTRACT NO. 7525 SPEC. NO. 7525/56
TITLE New Water Well
DATE: 17mch 1957

[Signature]
BY DIRECTION OF OFFICER
IN CHARGE OF CONSTRUCTION

PHYSICAL AND CHEMICAL ANALYSIS OF WATER

SAMPLE NO.

FROM: (Station or unit)

Well 32

DATE

8-1-57

TO: (Name and location of laboratory)

SAMPLE FROM (Location of sampling point)

COLLECTED BY

Chadwick

DATE

8-1-57

HOUR

SOURCE (Designate ground, surface, raw, treated)

Raw

REASON FOR EXAMINATION

EXAMINATION REQUESTED BY

NOTE: All results reported in parts per million unless otherwise noted except for pH, temperature, and specific conductance. One liter of potable water is assumed to weigh one kilogram.

I. FIELD ANALYSIS			III. ROUTINE LABORATORY ANALYSIS	
1. pH	TEMPERATURE		(CHECK ONE)	
	°F	°C	REQUESTED	NOT REQUESTED
ITEM				
	PPM			
2. CARBON DIOXIDE (CO ₂)			1. COLOR	
3. DISSOLVED OXYGEN (O ₂)			2. TURBIDITY	
4. HYDROGEN SULFIDE (H ₂ S)			3. ALKALINITY (CaCO ₃)	
5. CHLORINE DEMAND (Cl ₂)			P	MO
FIELD ANALYSIS BY			0	131
DATE OF ANALYSIS			4. TOTAL HARDNESS (CaCO ₃)	
			134	
			5. NON-CARBONATE HARDNESS (CaCO ₃) (By Computation)	
			6. CARBONATE HARDNESS (CaCO ₃) (By Computation)	
			7. TOTAL DISSOLVED SOLIDS	
			8. SPECIFIC CONDUCTANCE (Micromhos)	
(X)	ITEM	PPM	ITEM	PPM
	1. As		9. CALCIUM (Ca)	
	2. Se		10. MAGNESIUM (Mg)	
	3. Pb		11. SODIUM (Na) AND POTASSIUM (K)	
	4. B		12. HYDROXIDE (OH) <i>CaCO₃</i>	0
	5. Cu		13. BICARBONATE (HCO ₃) <i>CaCO₃</i>	131
	6. Zn		14. CARBONATE (CO ₃) <i>CaCO₃</i>	0
	7. Cr (Hexavalent)		15. SULFATE (SO ₄)	
	8. PO		16. CHLORIDE (Cl)	10
	9. Cd		17. NITRATE (NO ₃)	
	10. CN		18. IRON (Fe) TOTAL	0.2
	11. Phenolic Compounds (PPB)		19. MAGANESE (Mn)	
	12. Others (Specify)		20. SILICA (SiO ₂)	
	13.		21. FLUORIDE (F)	
	14.		*State whether determined or computed from P and MO alkalinity.	
	15.			
	16.			

REMARKS (Such as unusual appearance, taste, odor, etc.)

LABORATORY ANALYSIS BY

Justice

DATE OF ANALYSIS

8-1-57



RECEIVED

1950

TO: [Illegible]

FROM: [Illegible]

[Illegible text]

[Illegible text]

well # 32³ Beach Road.

~~well~~ Put in operation.

5-27-57

Static... 50 ft by gage

DD... 37 ft " " (DD in ft - 13)

Air line ft. ? 60 ft.

11-2-61


well delivered 349 G.P.M. - DIS-PRESS-28 LBS.

DD - Gage - 14 ft.

13
10
23
37
60

DATE	G. P. M.	STATIC	AIRLINE
11/16/66	235	50 ²	63.5 ³
8/5/69	207	50'	63'
9-4 69	207	STATIC + 28	PUMPING LEVEL - 9 DD. FT. 37.0

as of March 1/67 32 well has Johnston pump

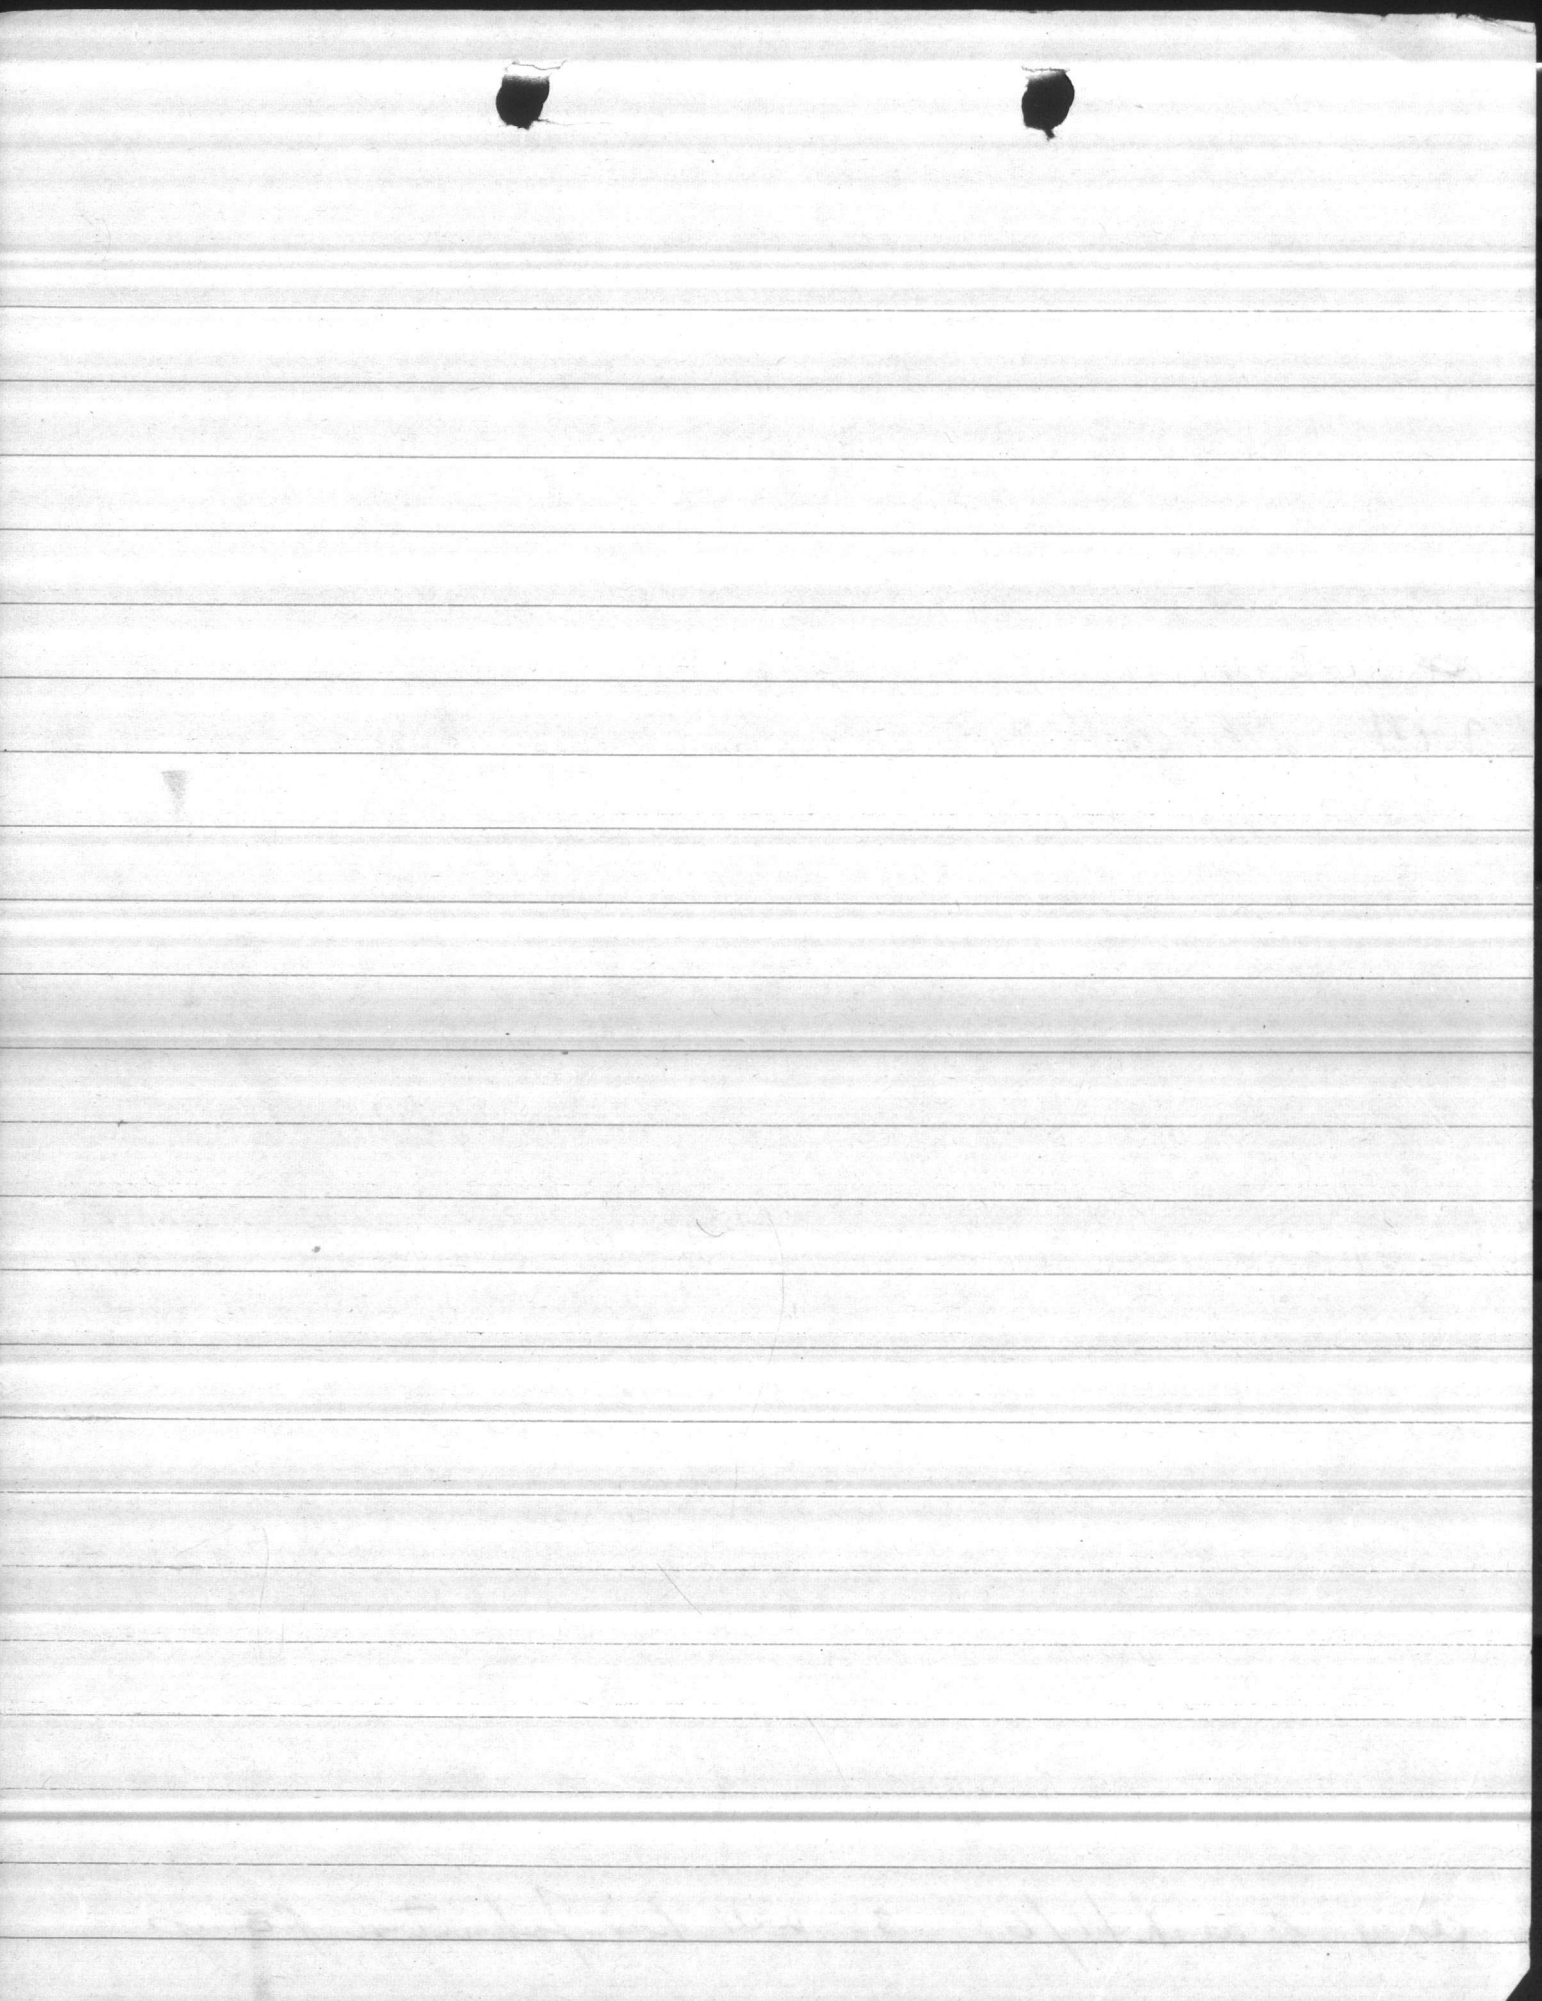

February 18, 1957

WELL # # " 32 SNEADS FERRY ROAD

(Contract NBy 7525)

36 hour test (all readings from ground level) 60' air line

Feb. 14, 1957

time	G.P.M.	P.L.	D.D.
10:00	300	29'	19'
11	300	29	19
12	300	29	19
1	300	29	19
2	300	29	19
3	300	29	19
4	300	29	19
5	300	29	19
6	300	29	19
7	300	29	19
8	300	29	19
9	300	29	19
10	300	29	19
11	300	29	19
12	300	29	19
1	300	29	19
2	300	29	19
3	300	29	19
4	300	29	19
5	300	29	19
6	300	29	19
7	300	29	19
8	300	29	19
9	300	29	19
10	300	29	19
11	300	29	19
12	300	29	19
1	300	29	19
2	300	29	19
3	300	29	19
4	300	29	19
5	300	29	19
6	300	29	19
7	300	29	19
8	300	29	19
9	300	29	19
10	300	29	19


recovery after 36 hour test

time	water level
10seconds	20'
20 "	20
30 "	20
40 "	20
50 "	20
60 "	19
2 minutes	18
4 "	17.5
8 "	17
16 "	17
32 "	17
60 "	15

WATER ANALYSIS ON COMPLETED WELL

p. alk.	0.0 ppm.
total alk.	146.0 "
chlorides	15.0 "
carbon dioxide	8.0 "
carbonates	0.0 "
bicarbonates	146.0 "
turbidity	0.0 "
odor	0.0 "
iron	0.1 "
hardness	132.0 "
p.h.	7.5 "

static level 10'

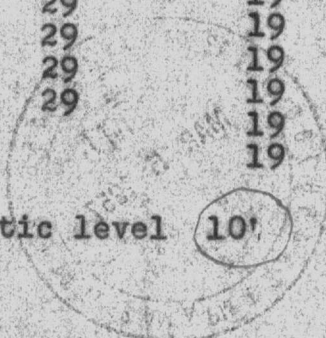

6469003-4

February 16, 1957

CONTRACT NO. 1557

36 hour test (all readings from ground level) 601 air fans

Feb. 14, 1957

Recovery after 36 hour test

Time	Temp	Humidity	CO ₂	CO	SO ₂	NO _x	PM ₁₀	PM _{2.5}
00:00	70	45	0.1	0.0	0.0	0.0	0.0	0.0
01:00	70	45	0.1	0.0	0.0	0.0	0.0	0.0
ANALYSIS OF AIR SAMPLES

Sample No.	Total PM ₁₀	Total PM _{2.5}	CO ₂	CO	SO ₂	NO _x	Temp	Humidity
1	0.1	0.0	0.1	0.0	0.0	0.0	70	45
2	0.1	0.0	0.1	0.0	0.0	0.0	70	45
3	0.1	0.0	0.1	0.0	0.0	0.0	70	45
1557

Westinghouse
ELECTRIC SUPPLY COMPANY



319 W. MARTIN STREET
RALEIGH, N. C.

February 8, 1957

647003-13
A. J. Jenkins & Son, Inc.
Warsaw, North Carolina

Reference: New Well Hadnot Point - Camp Lajeune - Contract NBy-7525

Gentlemen:

In reference to the Polyphase Meter and Socket, which we propose to furnish on the subject job, we would like to point out that the GS-3 Meter as shown in our descriptive bulletin h2-100 is a 3-element 50 ampere self-contained Meter for use on 3 phase, 4 wire WYE system as called for in specifications.

We are incorrect in showing the ST-3 Socket for this Meter and it should be a type ST-8 as shown in our descriptive bulletin h2-800.

This ST-8 Socket is rated at 100 amperes and is quite sufficient for the 50 ampere meter.

In view of this explanation and correction of the socket we believe that we can expect approval on same.

Very truly yours,

WESTINGHOUSE ELECTRIC SUPPLY COMPANY

A. C. Dange
A. C. Dange
SALES ENGINEER, ASS

AGR:MM

Westinghouse

ELECTRIC SUPPLY COMPANY



319 W. MARTIN STREET
RALPHIGH, N. C.

Contract No. 1252

Raleigh, North Carolina

January 21, 1957

A. J. Jenkins and Son, Inc.
Warsaw, North Carolina

Gentlemen:

Below is a list of standard parts and the material of which they are made which are being furnished by Johnston Pump Company for the Camp Lejeune, North Carolina contract #7525.

<u>Description</u>	<u>Material</u>	<u>Standard</u>
Bowl	Cast Iron (Vit.*)	ASTM - A-48, Cl. 30
Impellers	Bronze	ASTM - B-62-52
Collet, Impeller Lock	Mild Steel	AISI - C-1018/Eq.
Shaft	Stainless Steel	AISI - No. 416
Coupling, Shaft	Mild Steel	AISI - C-1018/Eq.
Bearings, Bowl **	High Lead Bronze	ASTM - B-144-52, 3B
Bearings, Bowl	Dura #	
Discharge Case	Cast Iron (Vit.*)	ASTM - A-48, Cl. 30
Bearing, Discharge Case	High Lead Bronze	ASTM - B-144-52, 3B
Bearing, Discharge Case Screw	Bronze	ASTM - B-62-52
Suction Case (Bell)	Cast Iron (Vit.*)	ASTM - A-48-Cl. 30
Bearing, Suction Case	High Lead Bronze	ASTM - B-144-52, 3B
Tubing Adapter	Cast Iron	ASTM - A-48, Cl. 40
Bearing, Tubing Adapter Screw	Bronze	ASTM - B-62-52
Seal Ring, Impeller	Aluminum Bronze	ASTM - B-148-52, 90
Thrust Ring	Stainless Steel	AISI - No. 416
Thrust Ring Plat e	Cast Iron	ASTM - A-48, Cl. 30
Impeller Key	Mild Steel	Key Stock
Cap Screws	Mild Steel	AISI - C-1018/Eq.
Bolting	Mild Steel	AISI - C-1018/Eq.
Suction Pipe	Steel	ASTM - A-53, Grade B
Strainer	Galvanized Steel	

[Faint, illegible text, likely bleed-through from the reverse side of the page]

PUBLIC WORKS DEPARTMENT
CAMP LEJEUNE, NORTH CAROLINA

APPROVED

SUBJECT TO CONTRACT REQUIREMENTS

CONTRACT NO. 2525 SPEC. NO. 2020/56

TITLE Water Treatment Well

DATE: 17th. 1957 *[Signature]*

BY DIRECTOR OF OFFICE
IN CHARGE OF CONSTRUCTION

January 21, 1957

*Vitriform enameled lining on interior vanes and surfaces of bowls, suction case and discharge case up to and including 16" bowl assemblies, and on 18" bowls only. Above 18" no vitriform enamel is used. All cast iron closed impellers are vitriform enameled. Semi-open impellers are not coated.

**Dual bronze and rubber bearings on 7" through 16" bowl assemblies - all other bowls bronze only.

COLUMN ASSEMBLY

Oil and Water Lubricated Construction

<u>Description</u>	<u>Material</u>	<u>Standard</u>
Column (std. threaded)	OWI	WSP-441b
Shaft	Steel	AISI - C-1018/Sq.
Shaft Coupling	Steel	AISI - C-1018/Sq.

Oil Lubricated Only

Bearing, Lineshaft Enclosing Tube	Bronze	ASTM - B-62-52
Shaft Stabiliser, Enclosing Tube	Steel	ASTM - A-53, Grade B
	Rubber-Reinforced	

Very truly yours,

R. D. Ferguson, Warehouse Manager
JOHNSTON PUMP COMPANY

APPROVED

Faint, illegible text at the top of the page, possibly bleed-through from the reverse side.

Multiple lines of faint, illegible text in the middle section of the page.

Faint, illegible text at the bottom left of the page.

PUBLIC WORKS DEPARTMENT
CAMP LEJEUNE, NORTH CAROLINA

APPROVED

SUBJECT TO CONTRACT REQUIREMENTS

CONTRACT NO. 7525 SPEC. NO. 7825/56

TITLE Water Treatment Plant

DATE: 1 March 1957

BY: [Signature]
BY DIRECTION OF OFFICER
IN CHARGE OF CONSTRUCTION

H.P. Well 632


WELL DRAWING & MATERIALS LIST

HARTSFIELD WATER COMPANY, INC.
 P. O. DRAWER 3109 - PH. 523-2154
 KINSTON, NORTH CAROLINA 28501

CUSTOMER: U.S. Marine Corp Base WELL No. 639

ADDRESS: Camp Lejeune, N.C.

WELL LOCATION: Sneads Ferry Road E.F. = 18.7
Gauge Connection = 19.8

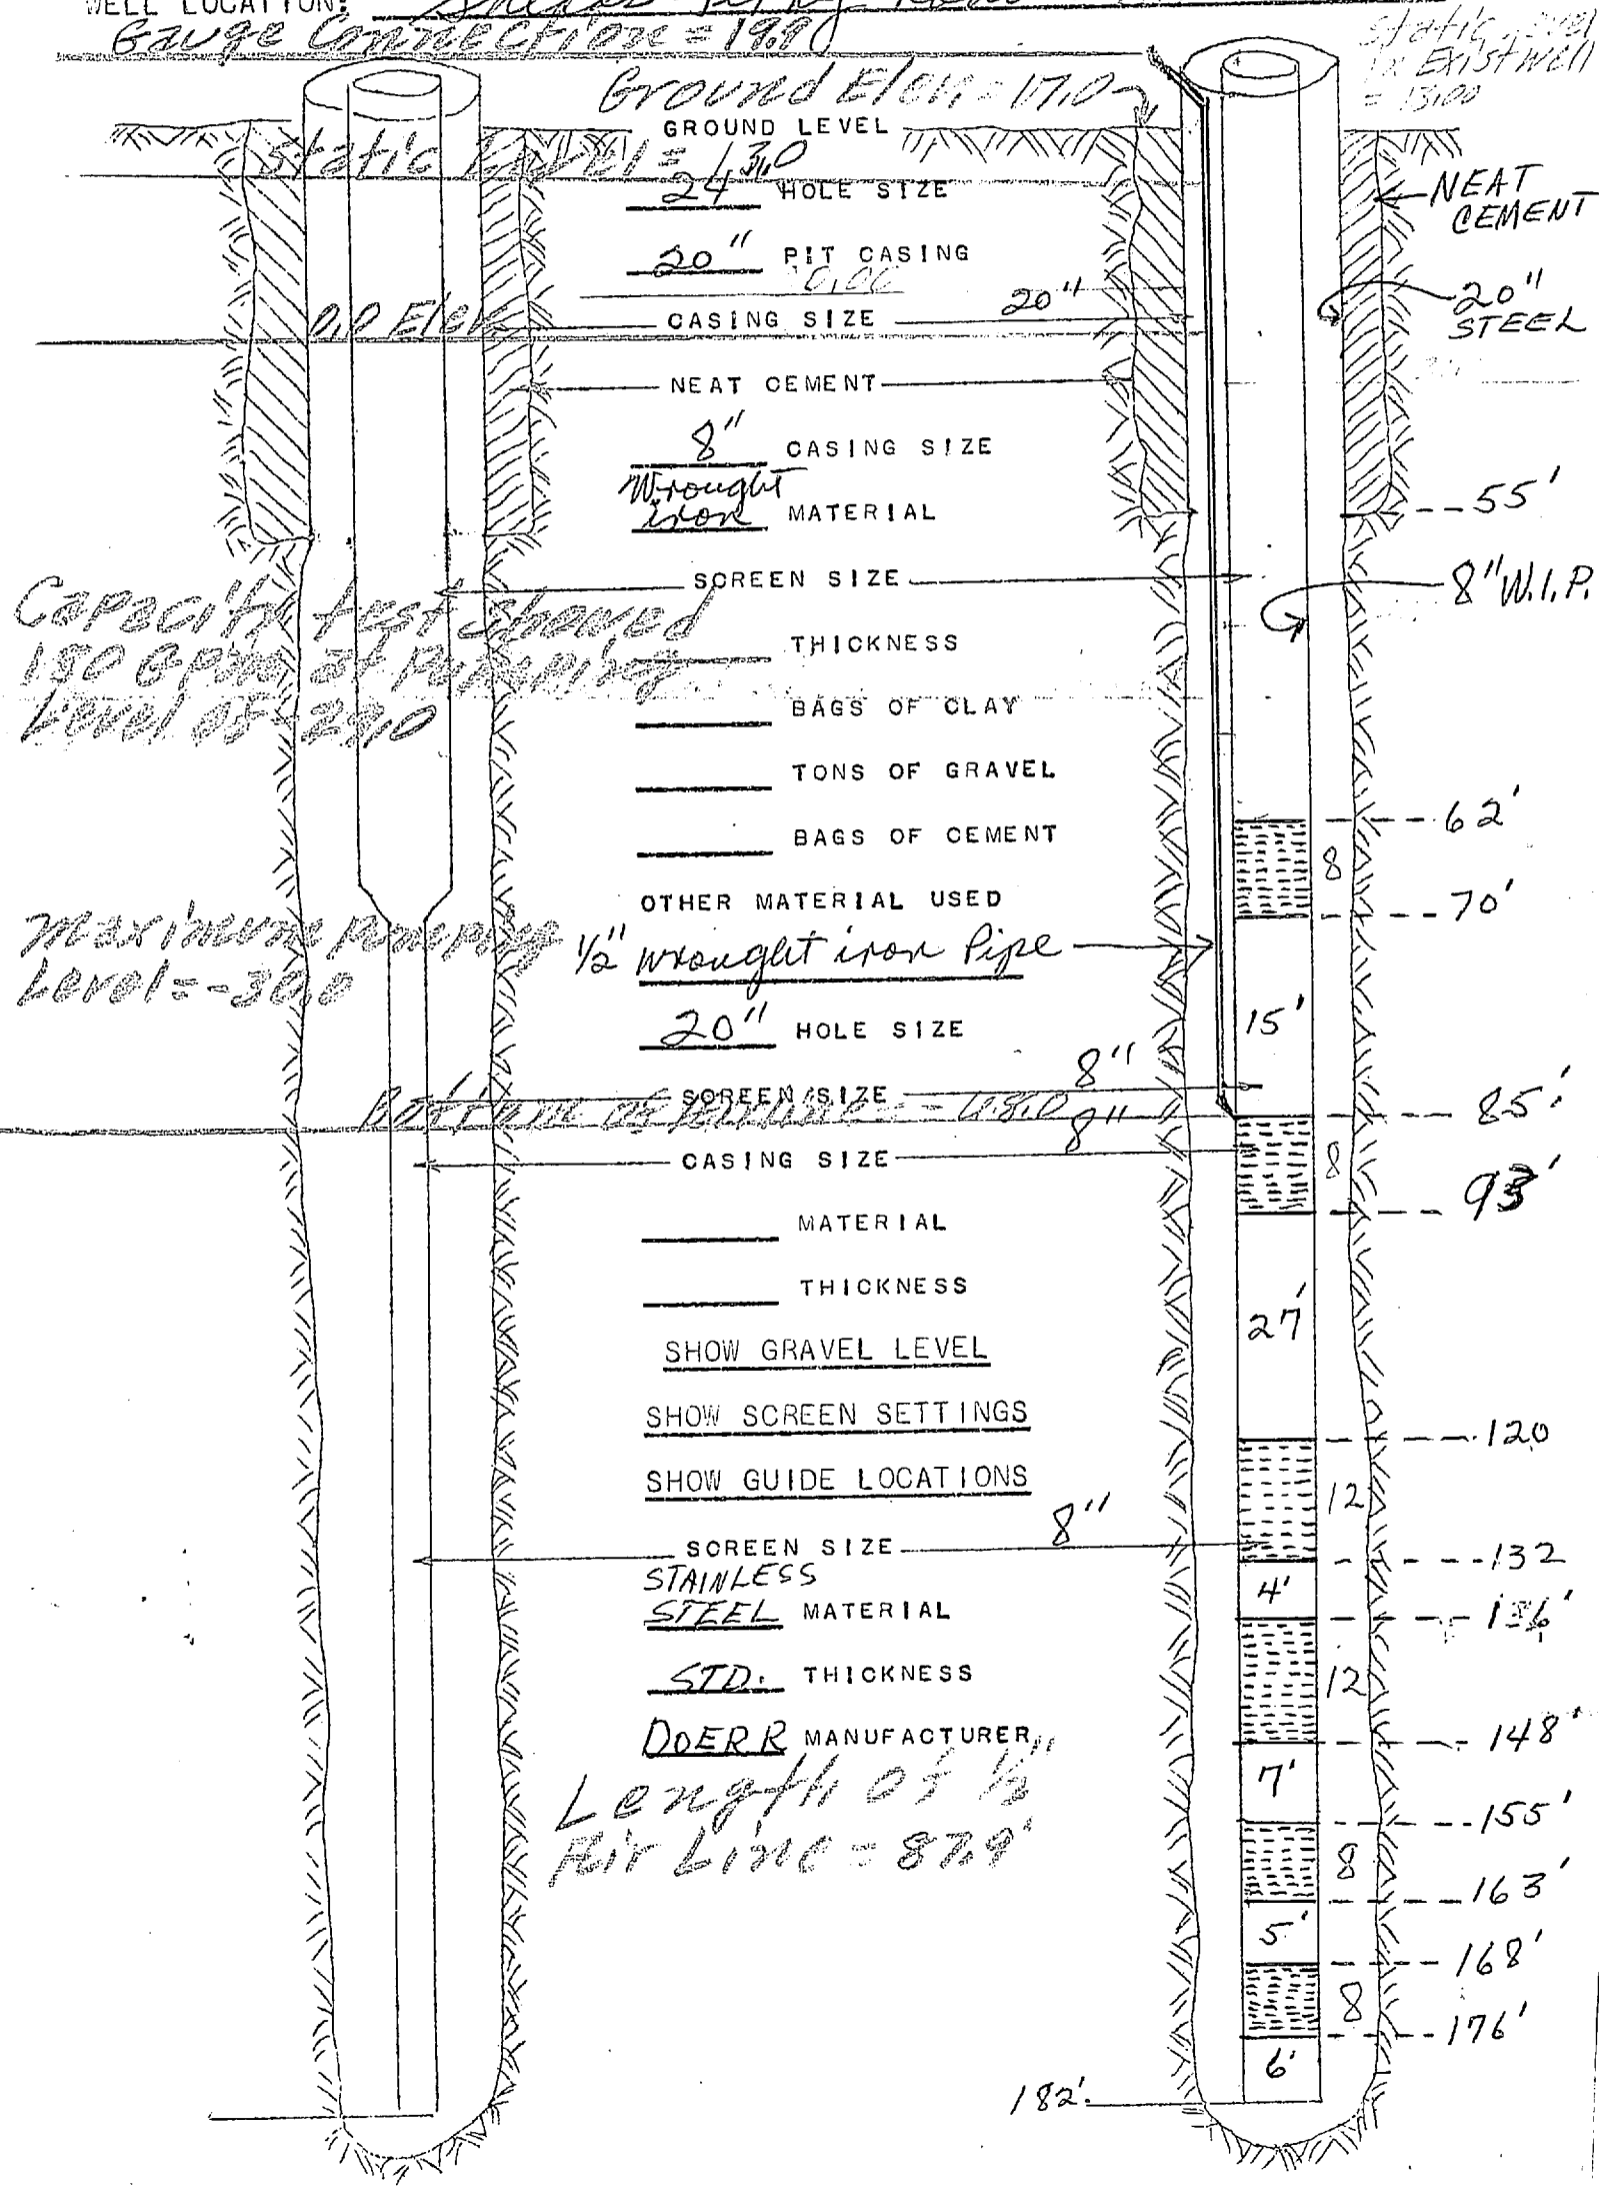

OFFICER IN CHARGE OF THE CONSTRUCTION
CAMP LEJEUNE, NORTH CAROLINA

APPROVED

SUBJECT TO CONTRACT REQUIREMENTS
CONTRACT NBY 19-0-0792
DATE: 15 Oct 69

J. W. UPDEGROVE
CAPT. CEC, USN
Officer in Charge
of Construction

JWU

~~New 639~~

662

8-26-85

Static - 10'

Air Line - 81'

P/L - 73

D/D - 63

PSI - 45

GPM - 168

SET

AT

~~5-11-86~~

~~94 LB~~

~~60 LB~~
~~in hand~~


103




639 (OLD)

8-26-85

A/L	SL	PL	D/D	PST	GPM	START Time
63	4	54	52	49	105	1330 1345

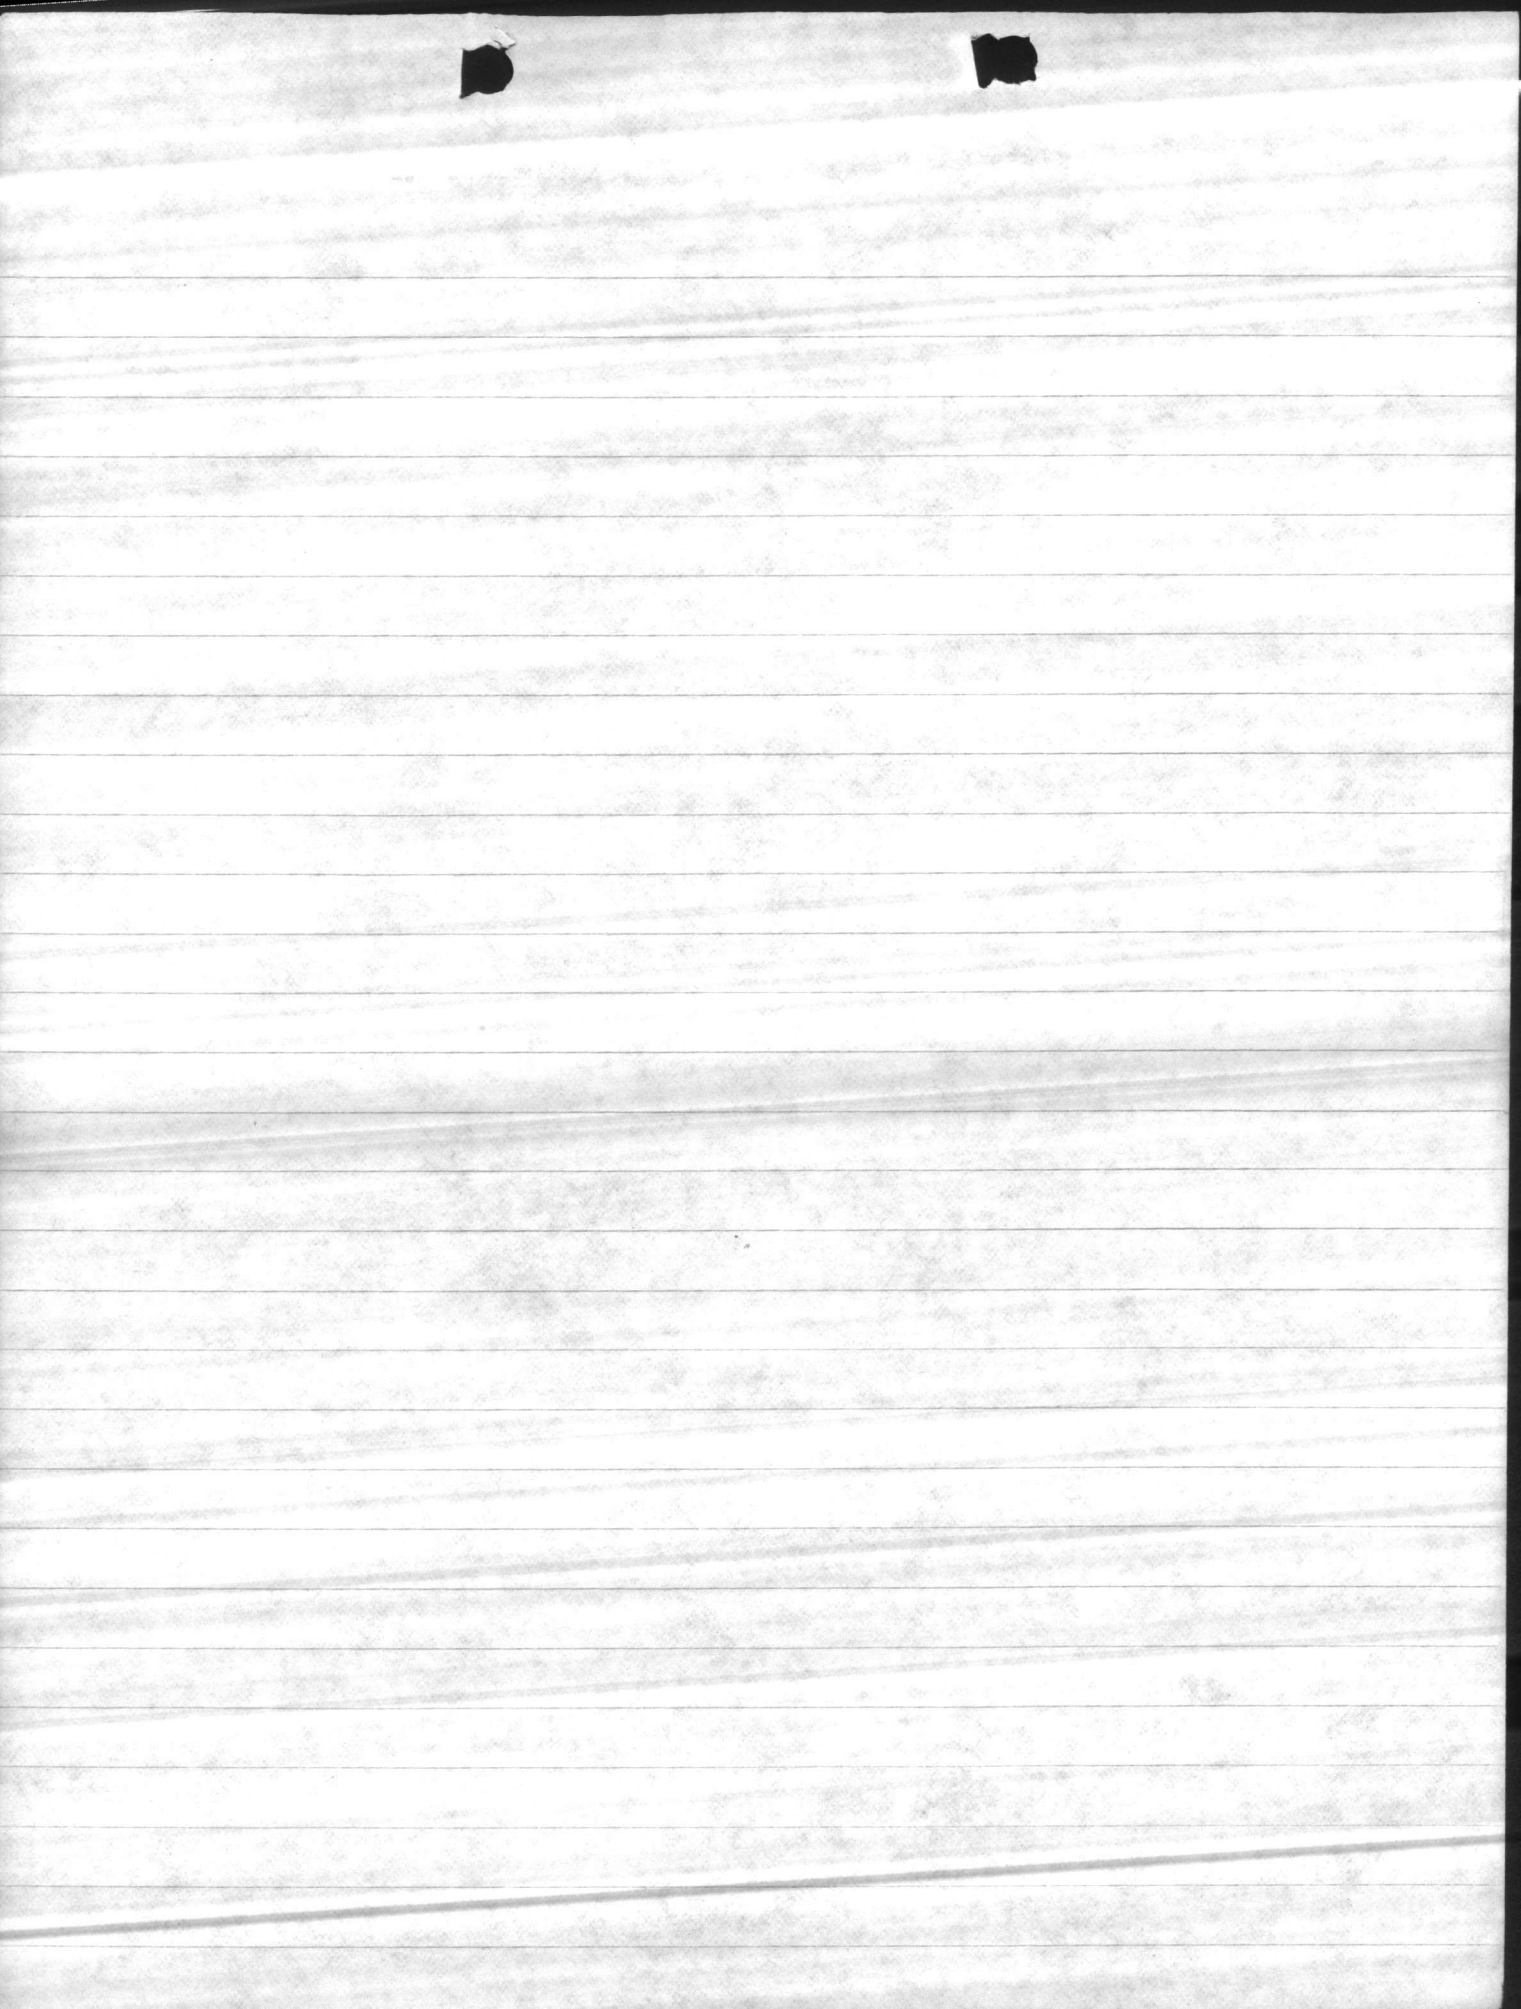

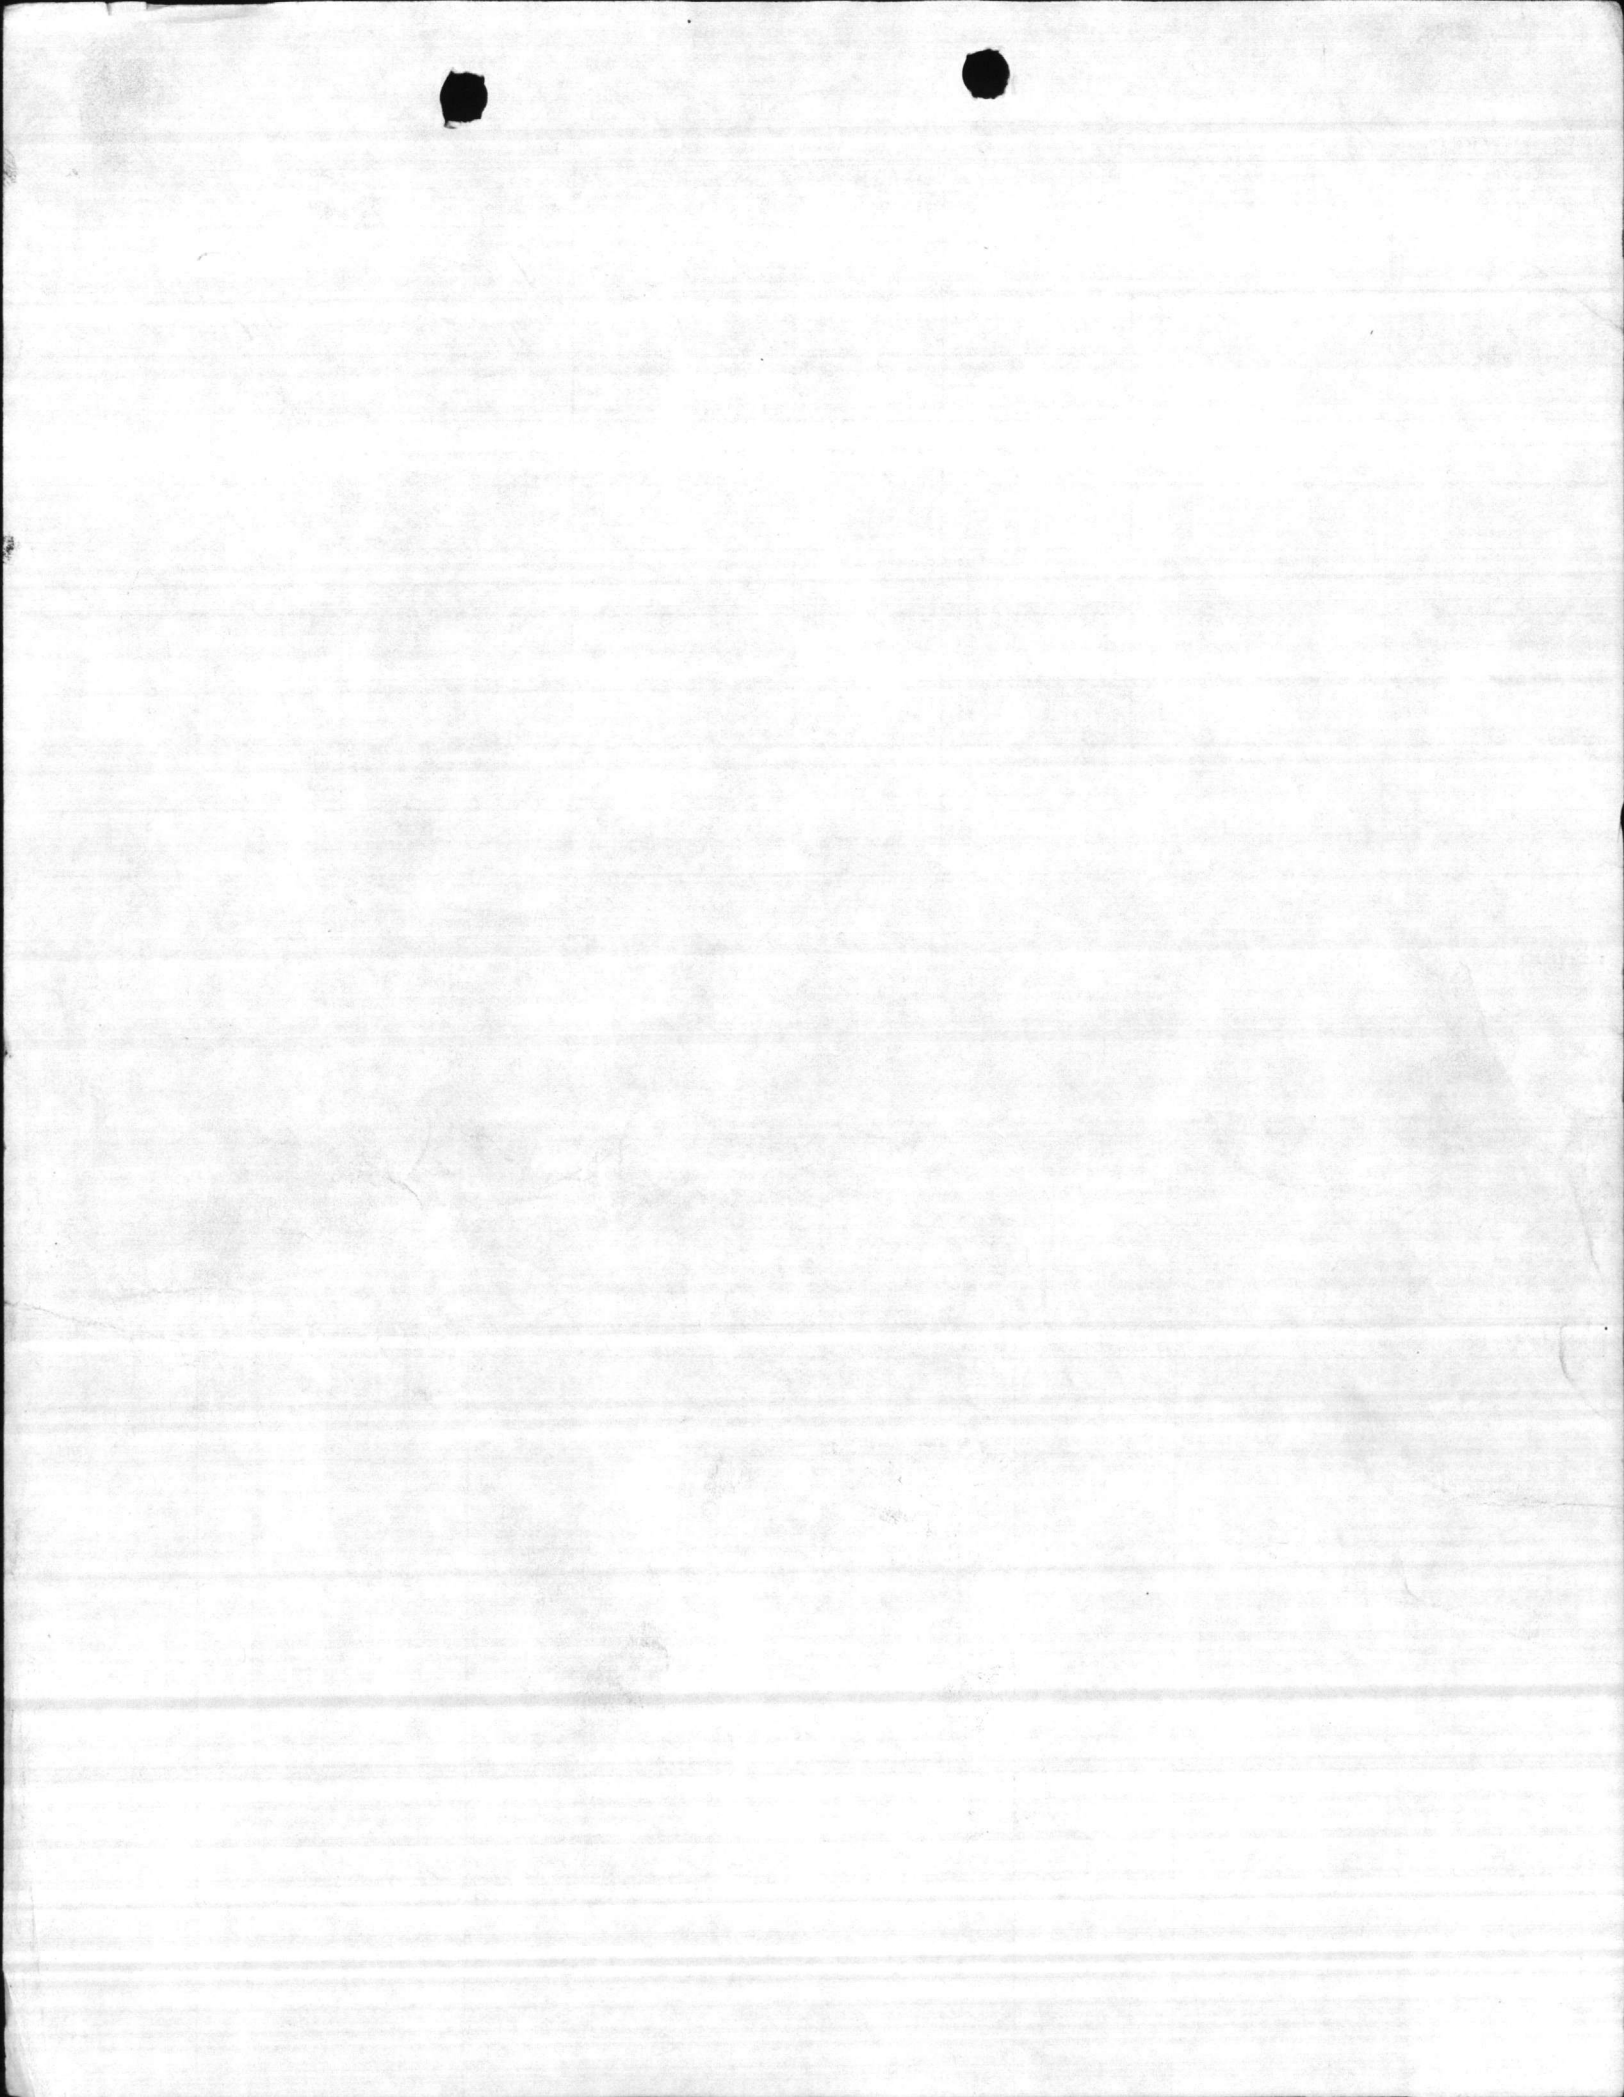

639

LENGTH
OF
AIR LINE

STATIC
LEVEL

PUMPING
LEVEL

DRAW
DOWN

DISCHARGE
PRESSURE

CAP. PER
FOOT OF
DRAW DOWN

TOTAL
CAP.

DATE

7-30-82

88'

20'

72

57'

48

100

1405

78

56

45

104

1425


Time

1350

REMARKS:

*used direct reading gage
set at 45 PSI 58' P/D 78' P/L 104 GPM*

NO OF
LINE
METERS

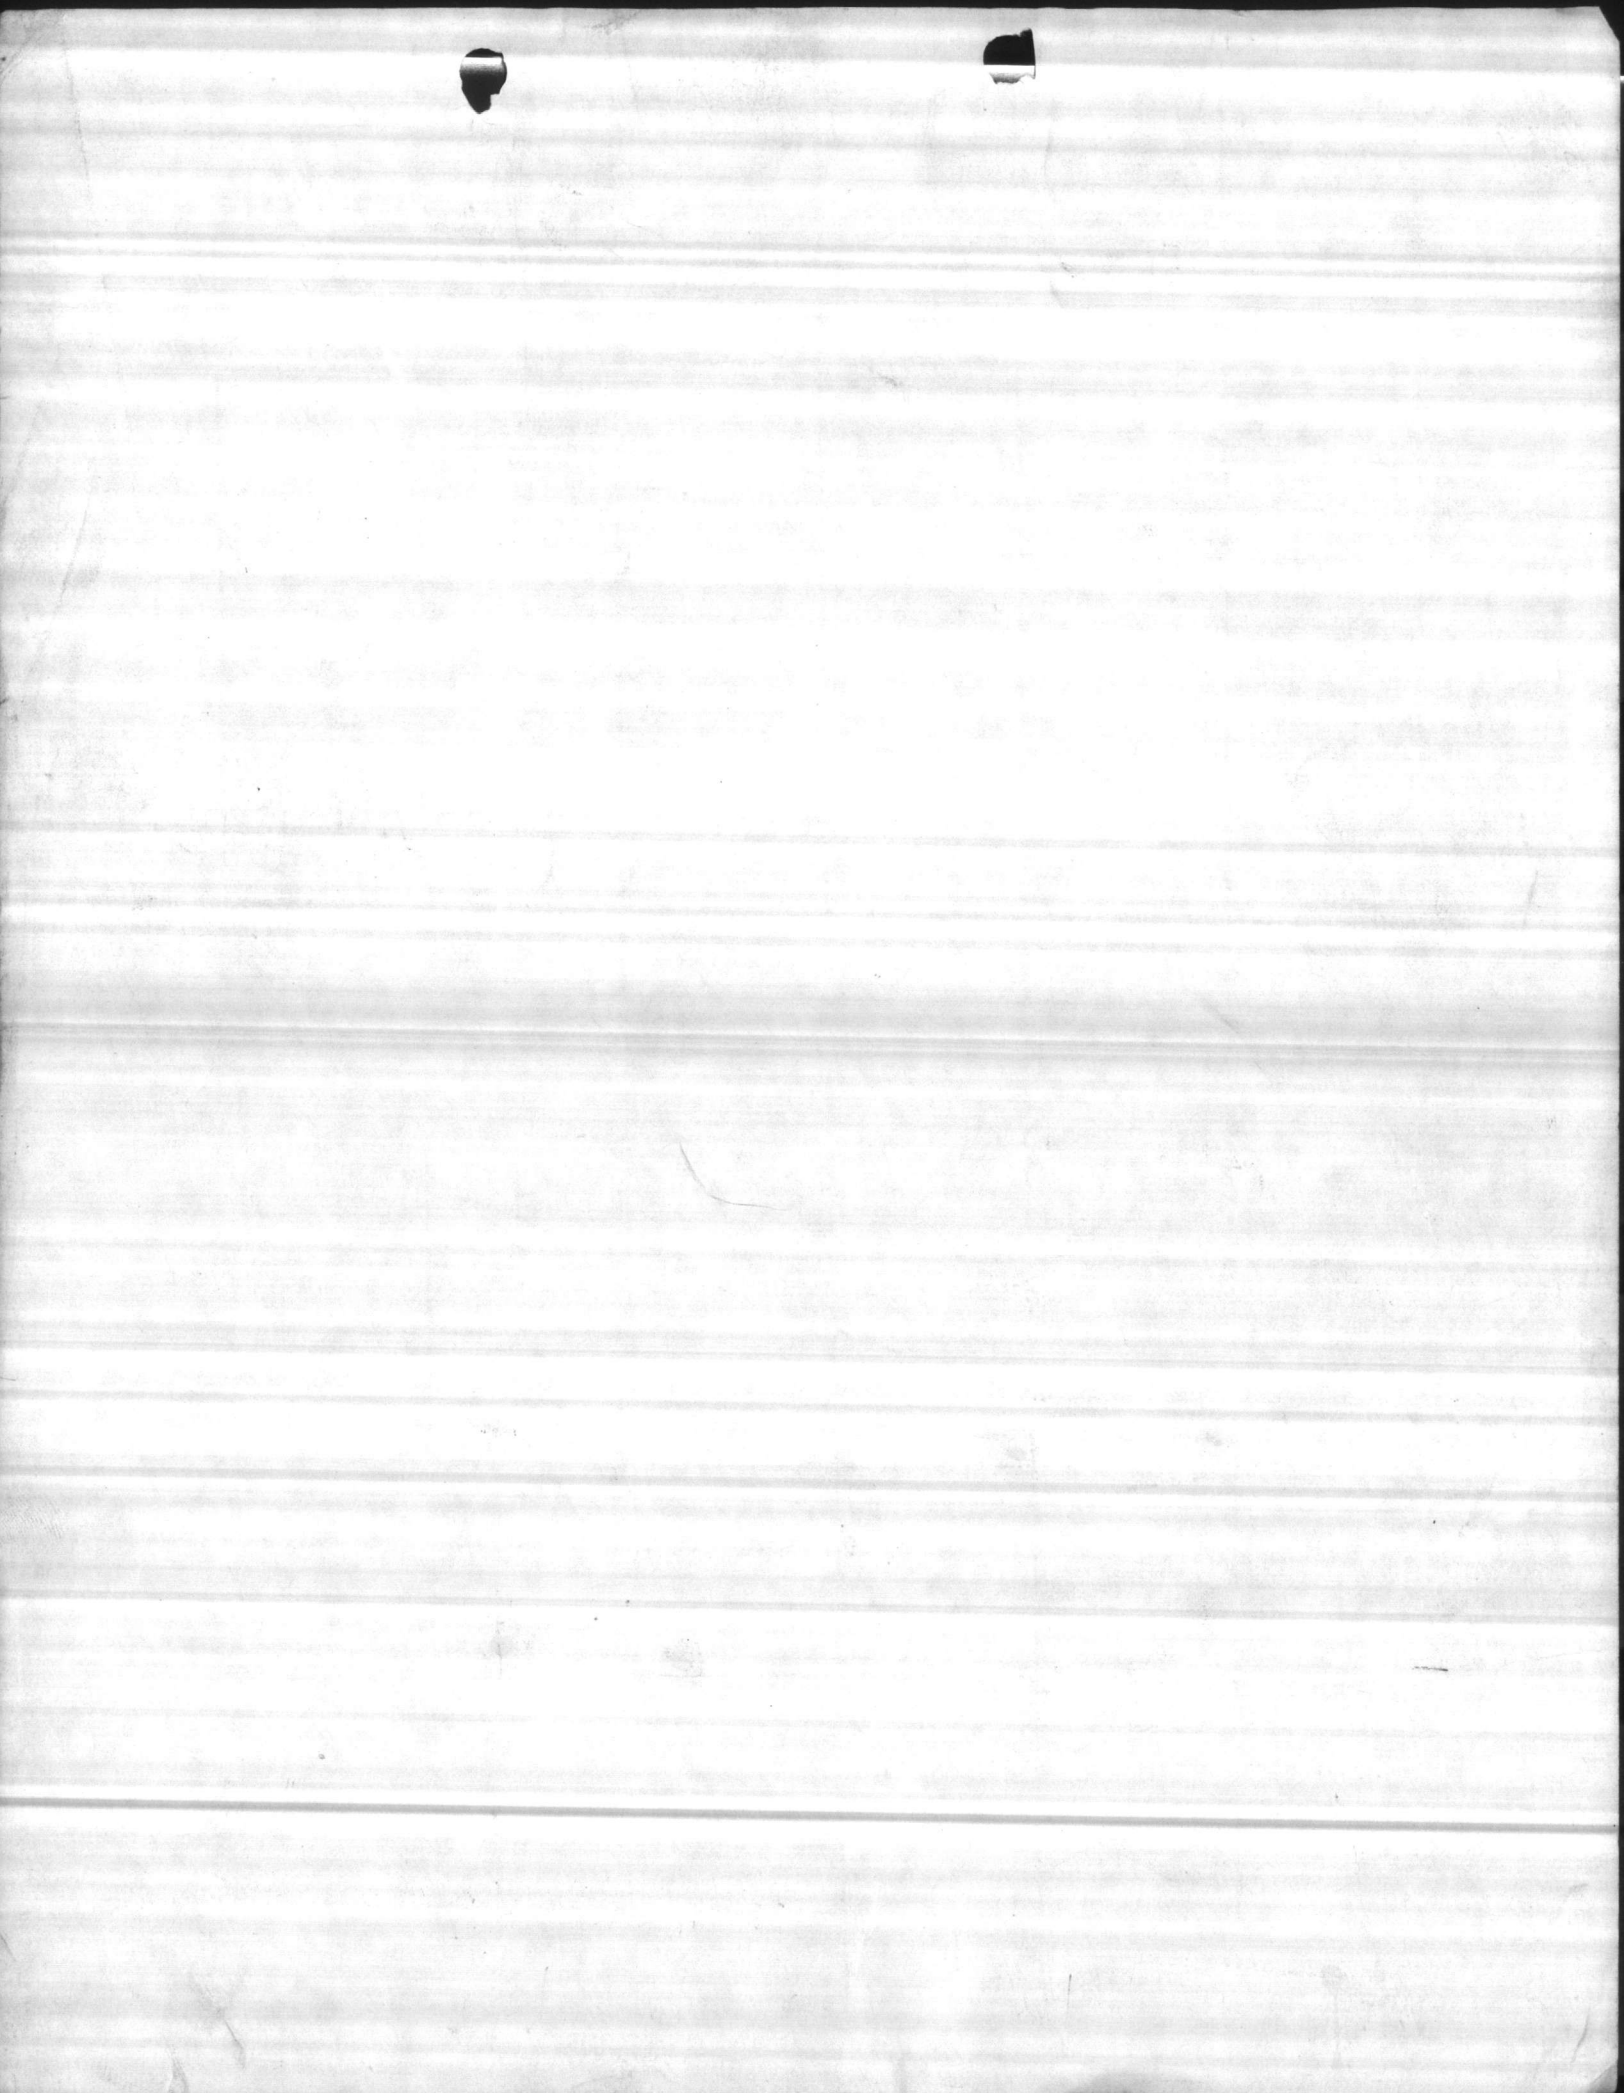

WELL #

639

9, 10, 81
DATE

LENGTH
OF
AIR LINE

STATIC
LEVEL

PUMPING
LEVEL

DRAW
DOWN

DISCHARGE
PRESSURE

CAP. PER
FOOT OF
DRAW DOWN

TOTAL
CAP.

88'

23'

61

38'

59.

3.0"

~~65~~

42"

56

3.0"

71'

48

53

4"

75

52

50

100

77

54

47

104

REMARKS:

set at 50 LB pressure

23' static


75' Pumping level

52' draw down

100 GPM's


88' air line

DEPTH OF
WELL:
AIRLINE
ELEVATION:
DATE
INSTALLED:

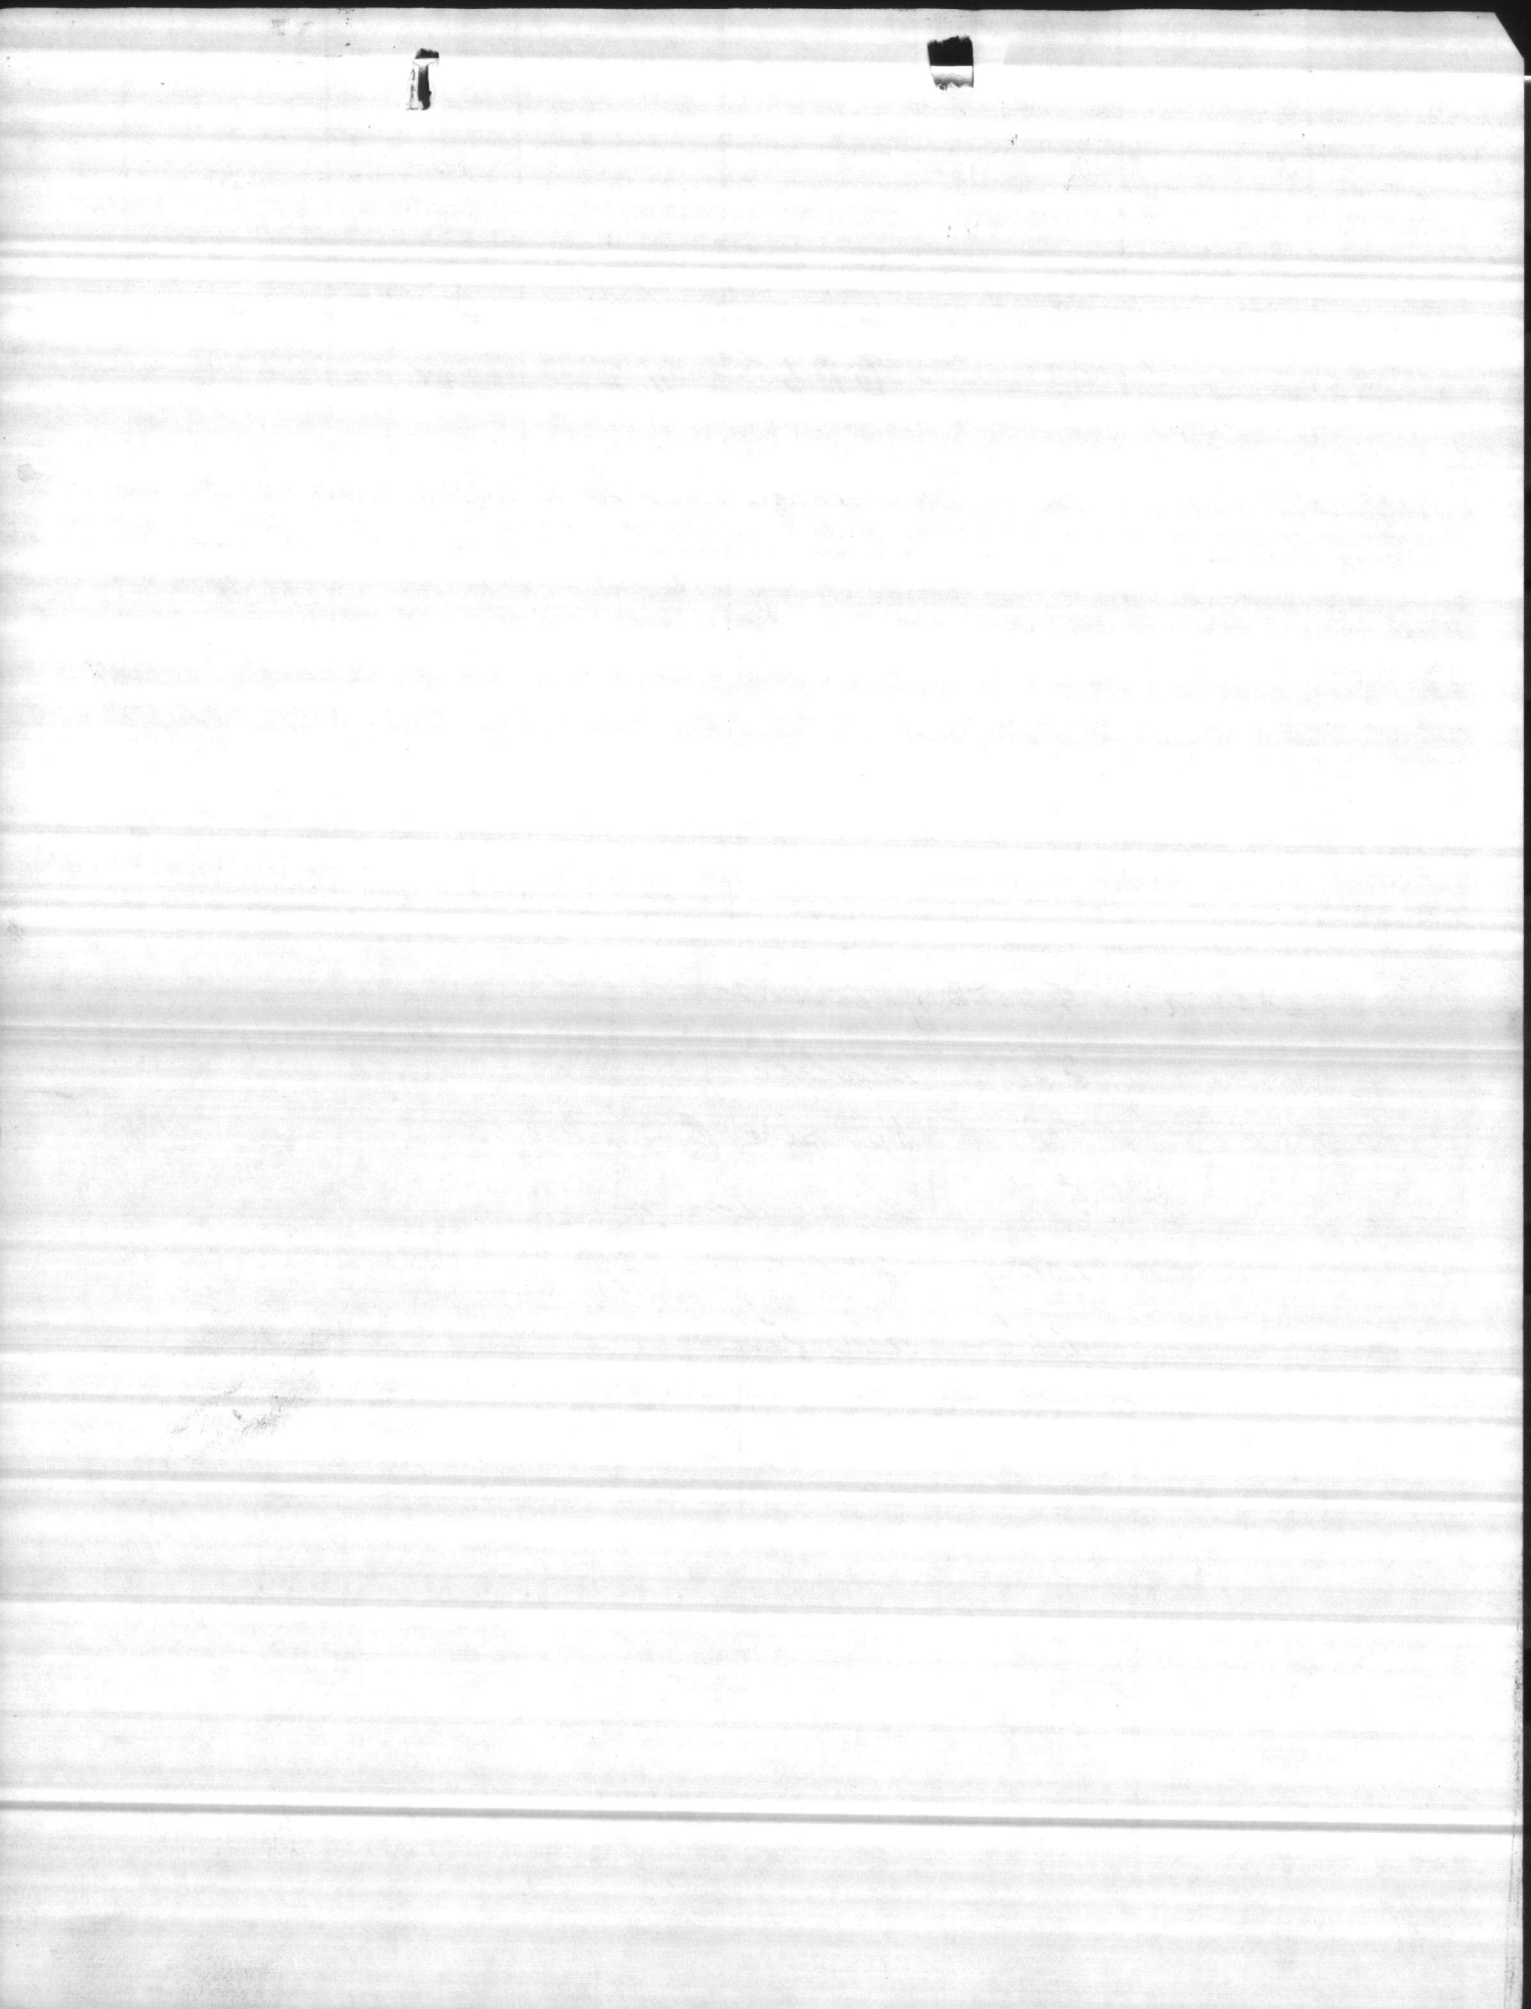

WELL # 639

DATE	LENGTH OF AIR LINE	STATIC LEVEL	PUMPING LEVEL	DRAW DOWN	DISCHARGE PRESSURE	CAP. PER FOOT OF DRAW DOWN	TOTAL CAP.
1-10-79	879 ?		20'		50		100
			Lose suction		40		
			27'		55		60 est
3/15/79			26'		50		100
2-13-80	88'		75'		50 ^{set}		80
			79'		45		108
			65'		55		60
REMARKS:							
DEPTH OF WELL: AIRLINE ELEVATION: + DATE INSTALLED:							

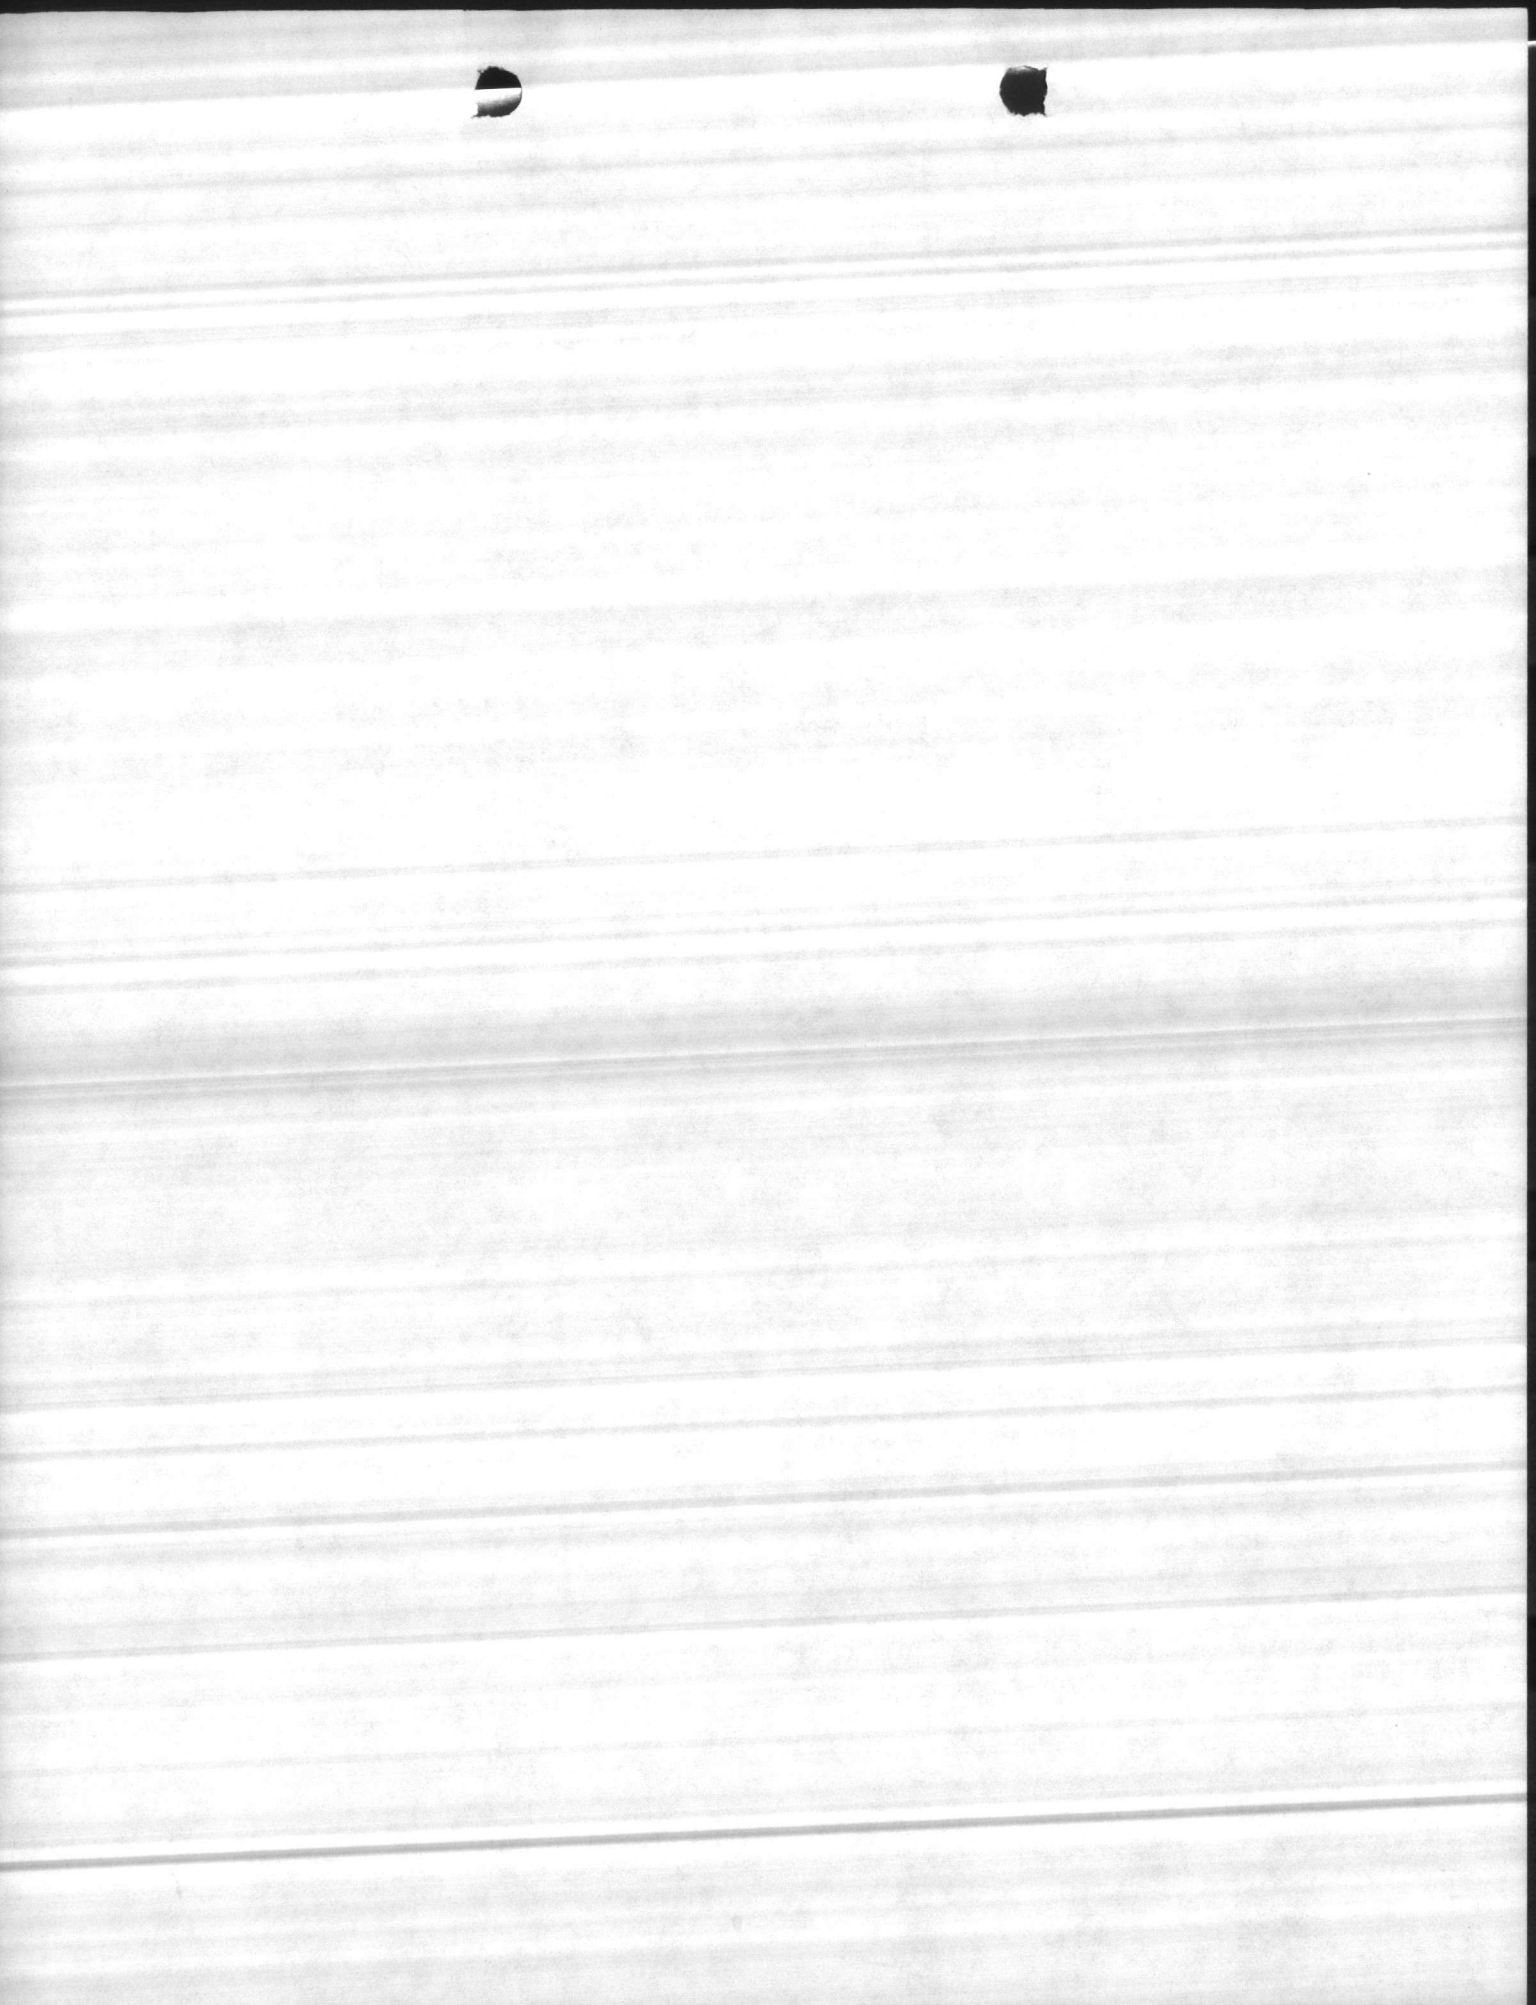

FORM A-4
(MAY '70)

U.S. DEPARTMENT OF THE INTERIOR
GEOLOGICAL SURVEY
OFFICE OF WATER DATA COORDINATION
INVENTORY OF HYDROLOGIC DATA STATIONS
QUALITY OF WATER

APPROVED.
Budget Bureau No. 42-R1485
Approval Expires June 30, 1976

1. AGENCY CODE MC		2. TYPE Q	3. LATITUDE 34 38 07 N		4. LONGITUDE 77 18 00 W	
6. AGENCY STATION NO. HP-639		7. STATION NAME HP-20-639				
8. DRAINAGE BASIN CODE No. Letter 06 N		9. STATE CODE 32	10. COUNTY CODE 133	11. COUNTY NAME Onslow		
12. PERIOD OF RECORD Began 1969 Discontinued		Y <input type="checkbox"/> Continuous Interruption Exceeds 1 Year		13.		
15. SITE <input type="checkbox"/> 101 Stream <input type="checkbox"/> 102 Canal <input type="checkbox"/> 103 Lake <input type="checkbox"/> 104 Reservoir <input type="checkbox"/> 105 Estuarine zone <input type="checkbox"/> 106 Spring <input checked="" type="checkbox"/> 107 Well <input type="checkbox"/> 108 Drain <input type="checkbox"/> 109 Other						
16. TYPES OF DATA AVAILABLE AND FREQUENCY OF MEASUREMENT (Enter appropriate number (1-8) beside each parameter to indicate frequency of measurement. For parameters telemetered, enter "T".)						
1 Continuous 2 Seasonal 3 Daily 4 Weekly 5 Monthly 6 Quarterly 7 Annual 8 Other Periodic						
<i>Physical</i> 311 Temperature 312 Specific conductance 313 Turbidity 314 Color 315 Odor 316 p _i (field) 317 8 p _i (lab) 318 Eh 319 Suspended solids 320 Other		<i>Chemical</i> 331 Dissolved solids 332 8 Chloride 333 Nutrients (nitrogen) 334 Nutrients (phosphorus) 335 Common ions 336 8 Hardness 337 Radiochemical 338 Dissolved oxygen 339 Other gases 340 Minor elements 341 Pesticides (insecticides, herbicides, etc.) 342 Detergents - MBS 343 Biochemical oxygen demand 344 Carbon (total, dissolved, etc.)		<i>Biologic</i> 361 Coliforms 362 Other micro-organisms (Benthic organism, phytoplankton, etc.) 363 Other <i>Sediment</i> 371 Concentration (suspended) 372 Particle size (suspended) 373 Particle size (bed load material) 374 Other		
17. SUPPLEMENTARY DATA AVAILABLE FOR STATION <input type="checkbox"/> 421 Surface water station <input type="checkbox"/> 422 Ground water station <input type="checkbox"/> 423 Water stage or level <input checked="" type="checkbox"/> 424 Water discharge <input type="checkbox"/> 425 Time of travel <input type="checkbox"/> 426 Drainage area						
18. STORAGE OF DATA <input type="checkbox"/> 501 Published <input checked="" type="checkbox"/> 502 Not published <input type="checkbox"/> 503 Data on punchcard <input type="checkbox"/> 504 Data on magnetic tape, disc, data cell, etc. <input type="checkbox"/> 505 Other						
19. INQUIRIES ABOUT DATA SHOULD BE SENT TO: Office <u>Base Maintenance Department, Utilities Division</u> Street No. <u>Marine Corps Base</u> City, State, Zip <u>Camp Lejeune, North Carolina 28542</u> City Code <u>0735</u>						
20. DATA ARE AVAILABLE TO PUBLIC ON REQUEST <input checked="" type="checkbox"/> Yes <input type="checkbox"/> No						
21. OFFICE COMPLETING FORM BASE MAINTENANCE DEPARTMENT						
22. COMPILER'S NAME BOB WILSON				23. DATE Month 12 Year 1976		



NOTE: All COLUMN LOSSES ARE INCLUDED

JOHNSTON: REF. NO. 688-B-106N


GB-1703

DEALER: Hartseild Water Co

REF. NO. _____

CUSTOMER: Camp Lejeune, N.C.

REF. NO. N-62470-69-C-0792

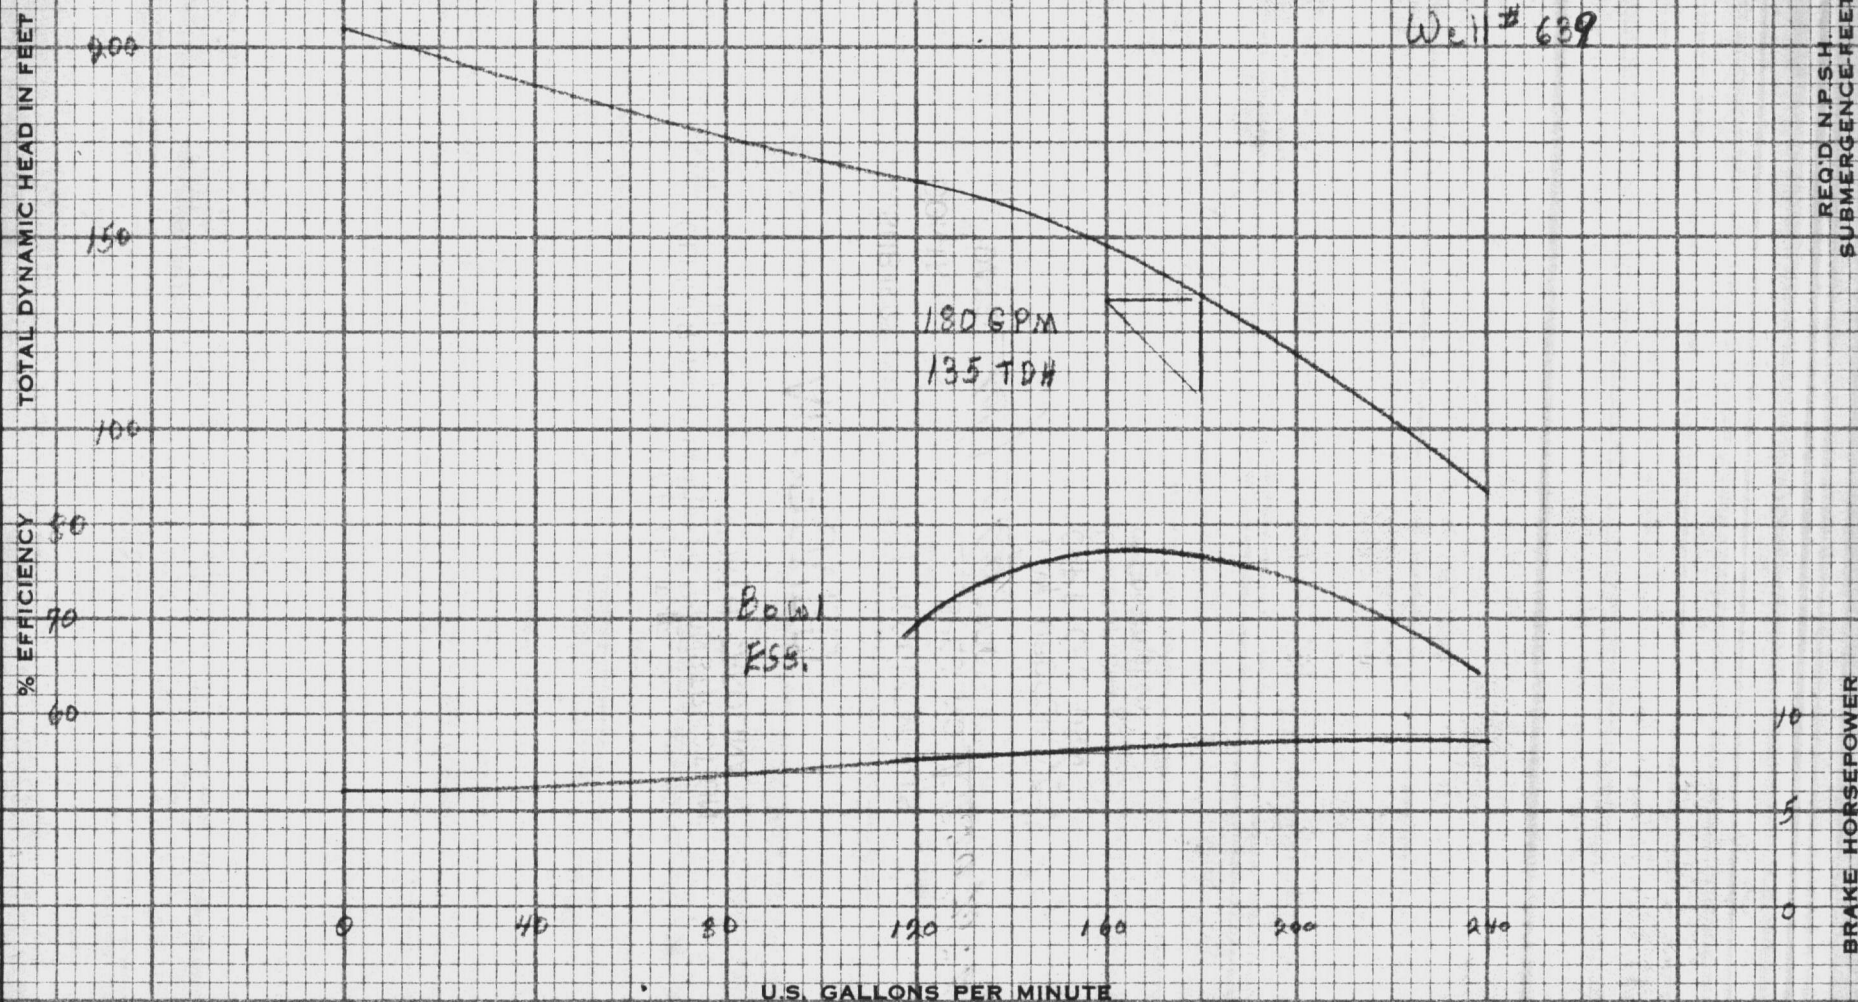

THE CAPACITY, HEAD AND EFFICIENCY GUARANTEE IS FOR THE DESIGNATED POINT ONLY: IT IS BASED ON SHOP TESTS, WHEN HANDLING CLEAR, FRESH WATER AT A TEMPERATURE OF NOT OVER 85° F. AND UNDER SUCTION CONDITIONS AS SPECIFIED IN THE CONTRACT.

IMPELLER CF-Vit. DIA. ES
 BOWLS Cast Iron-Vit.
 LIQUID Water
 SP. GR. 1.0
 DATE 6-30-69 BY 71200

JOHNSTON PUMP CO.



VERTICAL PUMPS

GLENDORA • CALIFORNIA • U. S. A.

Turbine

PERFORMANCE

8 STAGE 7CC

PUMP

1760 R.P.M.

OFFICE OF THE
OFFICER IN CHARGE OF CONSTRUCTION
CAMP LEJEUNE, NORTH CAROLINA

APPROVED

SUBJECT TO CONTRACT REQUIREMENTS

CONTRACT NBy _____ SPEC. NO. NA 2070-69-C-0795

DATE: 10 July 69

Alm
J. W. UPDEGROVE
CAPT. CEC, USN
Officer in Charge
of Construction

AMARILLO RIGHT ANGLE PUMP DRIVE


DIMENSION PRINT OF COMBINATION DRIVE MANUAL OPERATION—SLIDING CLUTCH

Drive No. JRL-20 Ratio 1:1
 Flexible Drive Shaft No. _____ Length _____
 Drive Flange Bored 1 1/4 Keyway 5/16 x 5/32
 Engine Flange Bored _____ Keyway _____
 Customer Johnston Pump Co.
 Customer's Order No. 21959 9B1702-04
 Date 8-18-69 Drive Serial No. _____

AMARILLO GEAR COMPANY
AMARILLO, TEXAS

By: W. Robbins

Camp Lejeune Well Nos. 638, 639, 640

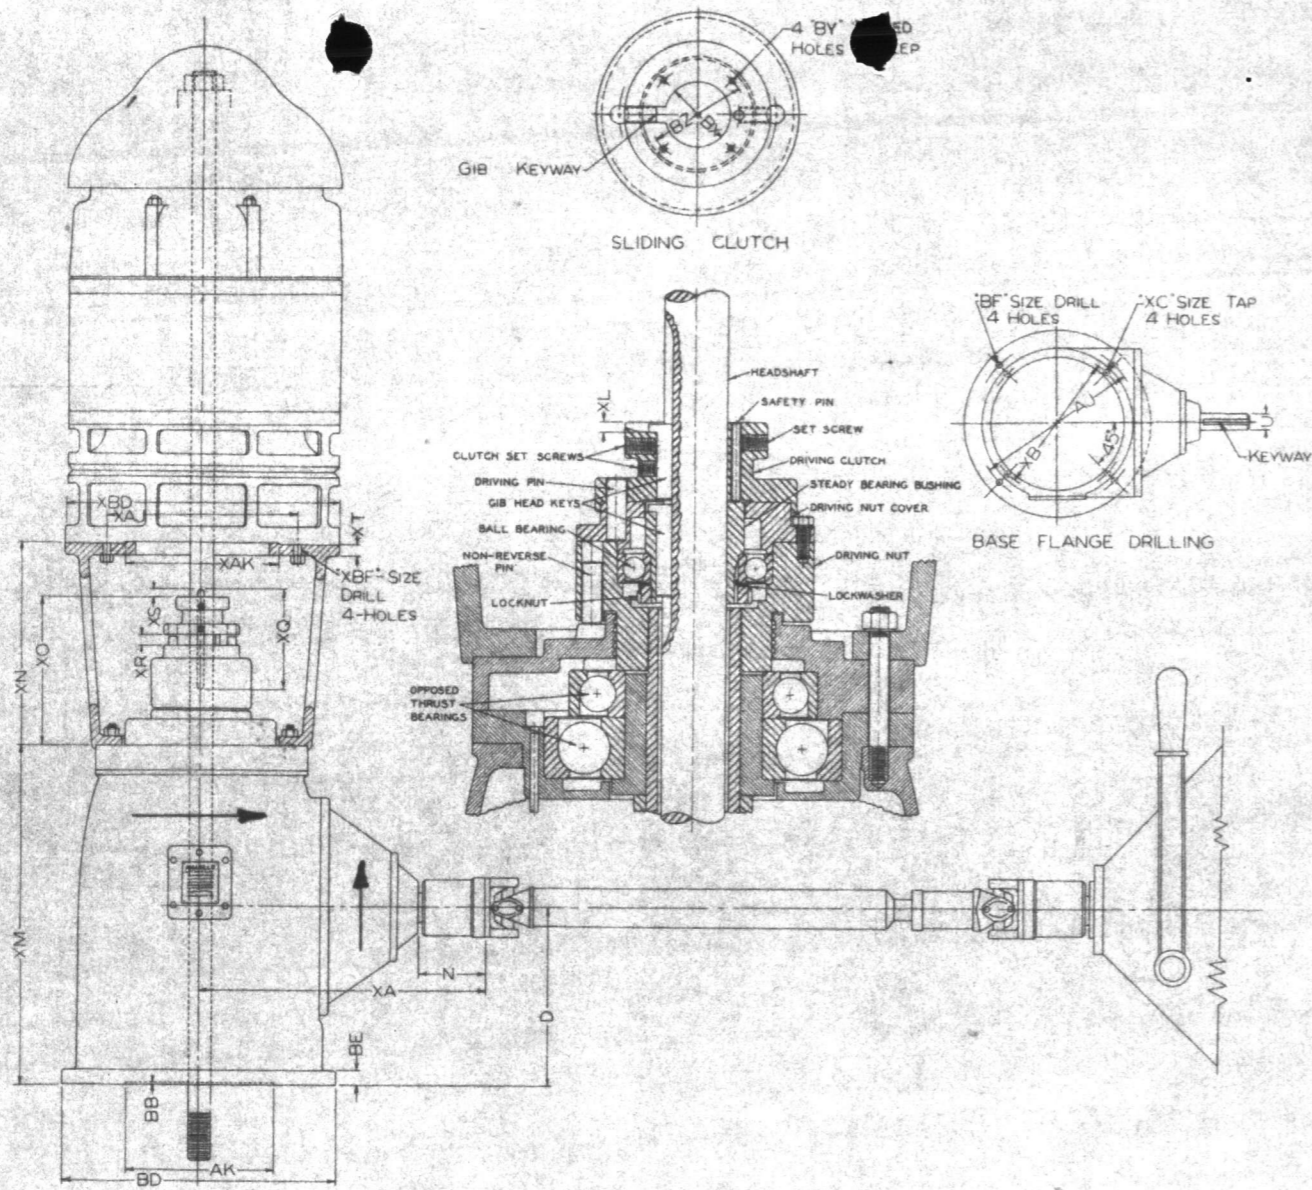


MODEL	D	N	HORIZONTAL SHAFT U			AJ	AK*	BB	BD	BE	BF	XA	XB	XC	XL	XM	XN	XO	XQ	XR	XS	XT	XAJ	XAK	XBD	XBF
			NOM-INAL	ACTUAL	KEYWAY																					
JRL-20	6 3/4	2 5/8	1 1/4	1.249	5/16 x 5/32	9 1/8	8.250	3/16	10	5/8	7/16	10 7/8			9/32	12 1/4	12 1/2	5 1/2	5 1/4	1/2	1/2	7/16	9 1/8	8 1/4	10	7/16
OL	8 1/2	4 1/4	1 1/2	1.499	3/8 x 3/16	14 3/4	13.500	1/4	16 1/2	3/4	11/16	15 5/8			9/32	15 7/16	16	6 1/2	7	5/8	2	5/8				
IBL	11 1/2	4 1/4	1 1/2	1.499	3/8 x 3/16	14 3/4	13.500	1/4	16 1/2	7/8	11/16	16 3/4			9/32	20 3/8	18	7 13/16	7 3/4	3/4	2 1/4	3/4				
2BL	11 1/2	4 1/4	1 7/8	1.874	3/8 x 3/16	14 3/4	13.500	1/4	16 1/2	7/8	11/16	16 3/4			9/32	19 3/4	18	8 3/8	7 3/4	3/4	2 1/4	3/4				
2BL-90	11 1/2	4 1/4	1 7/8	1.874	3/8 x 3/16	14 3/4	13.500	1/4	16 1/2	7/8	11/16	16 3/4			9/32	19 3/4	18	8 3/8	7 3/4	3/4	2 1/4	3/4				
3BC	13 3/4	5 1/4	2 7/16	2.436	5/8 x 5/16	18 1/4	13.500	1/4	20	1 1/8	11/16	20 3/4	14 3/4	5/8-11-NC	9/32	25	20	9 3/8	10	7/8	2 3/4	7/8				
4BC	13 3/4	5 1/4	2 7/16	2.436	5/8 x 5/16	18 1/4	13.500	1/4	20	1 1/8	11/16	20 3/4	14 3/4	5/8-11-NC	9/32	25	20	9 3/8	10	7/8	2 3/4	7/8				
4BC-200	13 3/4	5 1/4	2 7/16	2.436	5/8 x 5/16	18 1/4	13.500	1/4	20	1 1/8	11/16	20 3/4	14 3/4	5/8-11-NC	9/32	26 1/4	20	9 3/8	10	7/8	2 3/4	7/8				
6BL	16	6	2 15/16	2.936	3/4 x 3/8	23	13.500	1/4	24 1/2	1 1/8	13/16		14 3/4	5/8-11-NC	9/32	30 3/4	27	12 1/2	11 1/2	1 1/8	3 1/2	1				
6BL-350	16	6	2 15/16	2.936	3/4 x 3/8	23	13.500	1/4	24 1/2	1 1/8	13/16		14 3/4	5/8-11-NC	9/32	30 1/2	27	12 3/8	11 1/2	1 1/8	3 1/2	1				
6BL-425	16	6				23	13.500	1/4	24 1/2	1 1/8	13/16		14 3/4	5/8-11-NC	9/32		27	12 3/8	11 1/2	1 1/8	3 1/2	1				
6BC-500	18	6	3 3/4	3.749	7/8 x 7/16	23	13.500	1/4	24 1/2	1 1/8	13/16	26 3/4	14 3/4	5/8-11-NC	9/32											
7BL	21	8	4	3.998	1 x 1/2	28 3/4	22.000	1/4	30 1/2	1 1/4	13/16	36 7/8	26 3/4	10-NC	7/16	42	30	16 1/4	15	1 3/16	4	1 1/4				


COUPLING DIMENSIONS

BX	BORE	GIB KEYWAY	BY	BZ
3/4	.751	3/16 x 3/32	10-32	1 3/8
7/8	.876	1/4 x 1/8	10-32	1 3/8
1	1.001	1/4 x 1/8	10-32	1 3/8
1 3/16	1.188	1/4 x 1/8	1/4 - 20	1 3/4
1 1/4	1.251	1/4 x 1/8	1/4 - 20	1 3/4
1 7/16	1.438	3/8 x 3/16	1/4 - 20	2 1/8
1 1/2	1.501	3/8 x 3/16	1/4 - 20	2 1/8
1 11/16	1.688	3/8 x 3/16	1/4 - 20	2 1/2
1 3/4	1.751	3/8 x 3/16	1/4 - 20	2 1/2
1 15/16	1.938	1/2 x 1/4	1/4 - 20	2 1/2
2 3/16	2.188	1/2 x 1/4	3/8 - 16	3 1/4
2 7/16	2.438	5/8 x 5/16	3/8 - 16	3 1/4
2 11/16	2.688	5/8 x 5/16	3/8 - 16	3 3/4

*Tolerance on AK dimension + .003 inch, - .000 inch for 8.250 dimension and + .005 inch, - .000 inch for 13.500 and 22.000 inch dimension.
 †Tolerances on BX dimension: up to and including 1 1/2 inch diameter, + 0.001, - 0.000 inch; larger than 1 1/2 inch diameter, + 0.0015, - 0.000 inch.

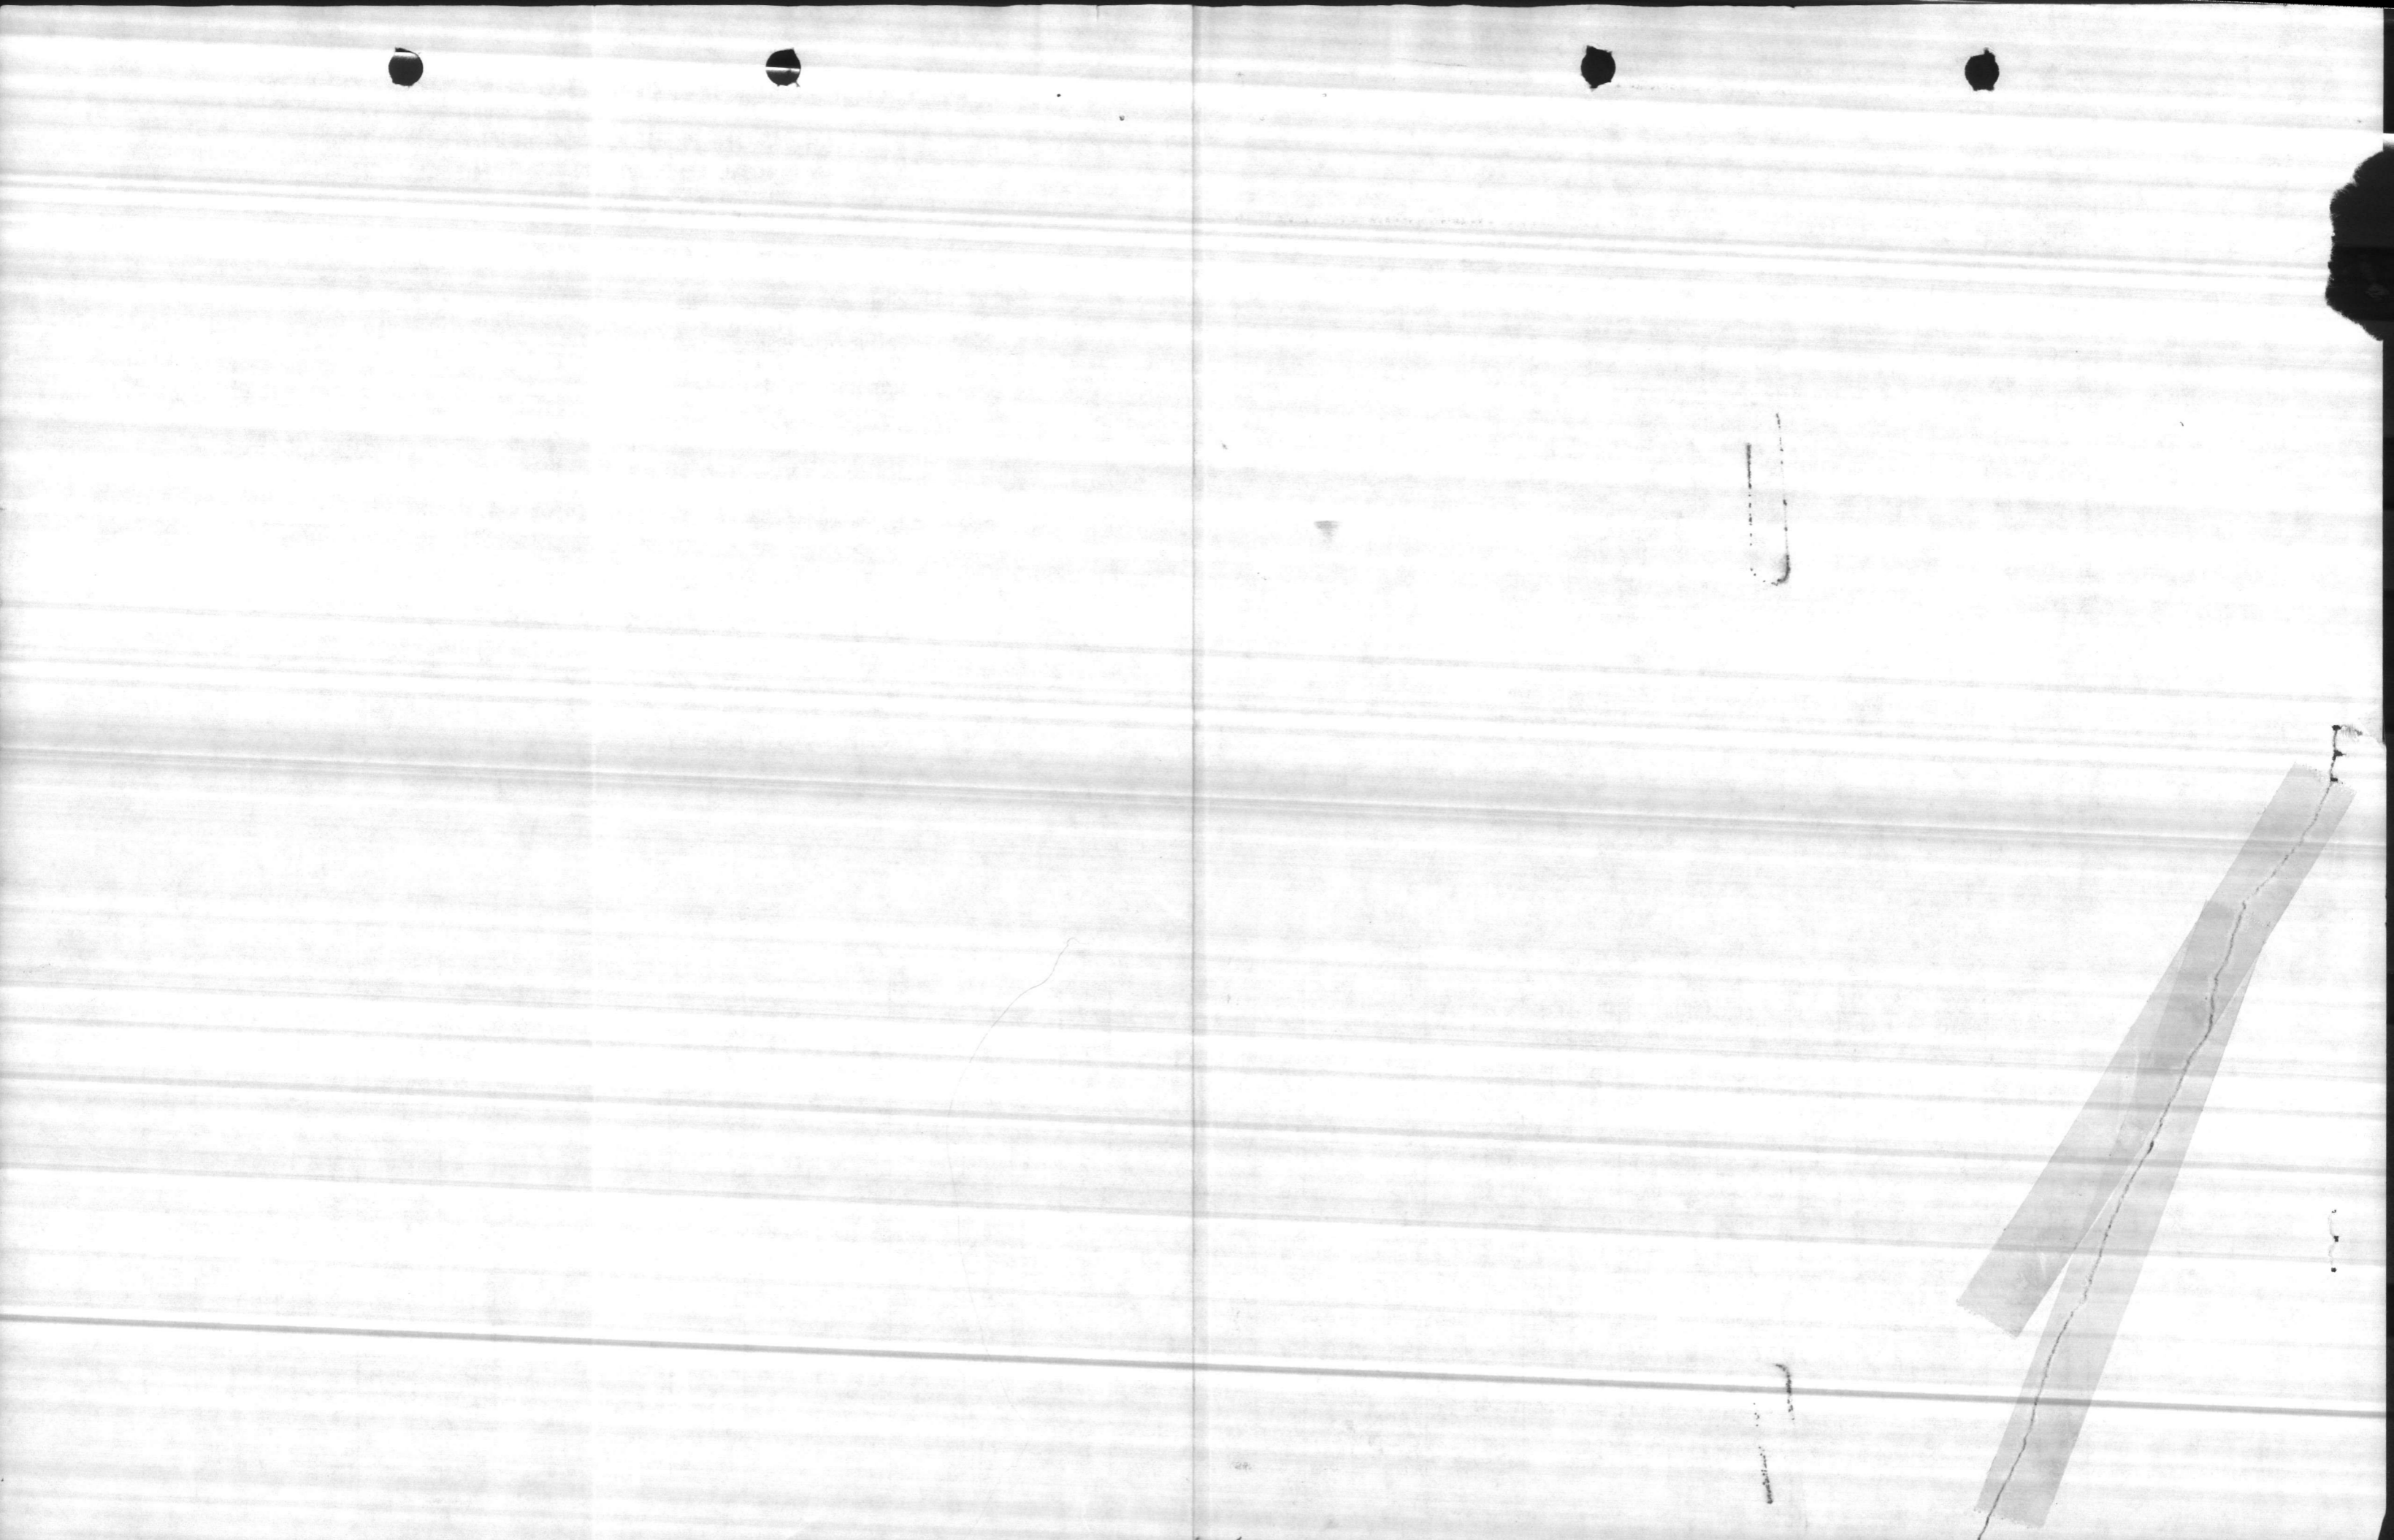

JOHNSTON VERTICAL TURBINE PUMP *Well no. 639*

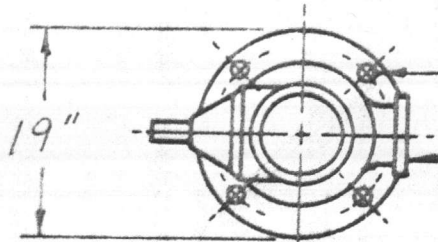


← $\frac{5}{8}$ " DIA. HOLES ON $7\frac{3}{4}$ " B.C.

5" x 125 ASA DISCHARGE FLANGE

CONDITIONS:

U.S. GALLONS PER MINUTE	- 180
TOTAL DYNAMIC HEAD IN FT.	- 135
LIQUID	- WATER
SPEC. GRAV.	1.0 @ °F. TEMP.

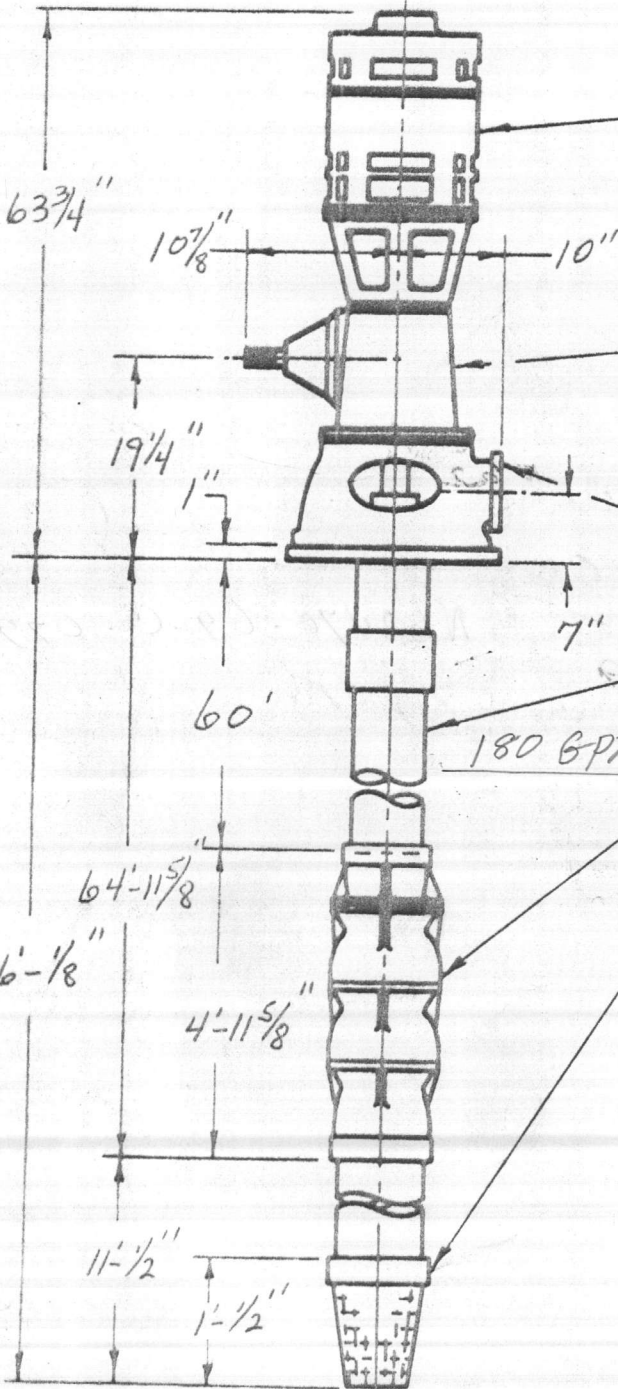

G.E.

VERTICAL HOLLOW SHAFT MOTOR					
HP	- 10	PHASE	- 3	CYCLE	- 60
VOLTAGE	- 208	RPM	- 1760		
ENCLOSURE			- W.P.I		

AMARILLO RIGHT ANGLE COMBINATION
 GEAR DRIVE MODEL - JRI-20 RATIO - 1:1
 DRIVER RPM - 1760 PUMP RPM - 1760
 SHAFT DIA. - $1\frac{1}{4}$ " KEYWAY $\frac{5}{16}$ "
 (GEAR MAY BE ROTATED 90°)

TYPE "A" DISCHARGE HEAD - 10 x 6
 COL TO BE G.W.I
 COLUMN ASSEMBLY - 5 x 2 x $1\frac{3}{16}$ "

BOWL ASSEMBLY - 7 STAGE 7CC
 180 GPM at - 29.0 D.D. Elev.
 SUCTION PIPE & CONE STRAINER - 5

CUSTOMER *CAMP LEJEUNE, N.C.*
 PO# *N 62470-69-C-079Z*
 DEALER *HARTSFIELD WATER CO*
 PO#

JOHNSTON SERIAL NO. *GB-1703 V*
 JOHNSTON QUOTATION NO. *688-B-106N*
 WELL #639

NOTE: DO NOT USE FOR CONSTRUCTION
 UNLESS CERTIFIED

JOHNSTON PUMP CO.
 GLENDORA, CALIFORNIA

H-1868-A

OFFICE OF THE
OFFICER IN CHARGE OF CONSTRUCTION
CAMP LEJEUNE, NORTH CAROLINA

APPROVED

SUBJECT TO CONTRACT REQUIREMENTS

CONTRACT NO. _____ SPEC. NO. *N 62470-69-C-0792*

DATE: *10 Jul 69* *Alm.*

J. W. UPDEGROVE
CAPT. CEC, USN
Officer in Charge
of Construction

H.P. Well 639