




**ELEVATION OF TANK NO. 310**  
SCALE: 1" = 10'-0"

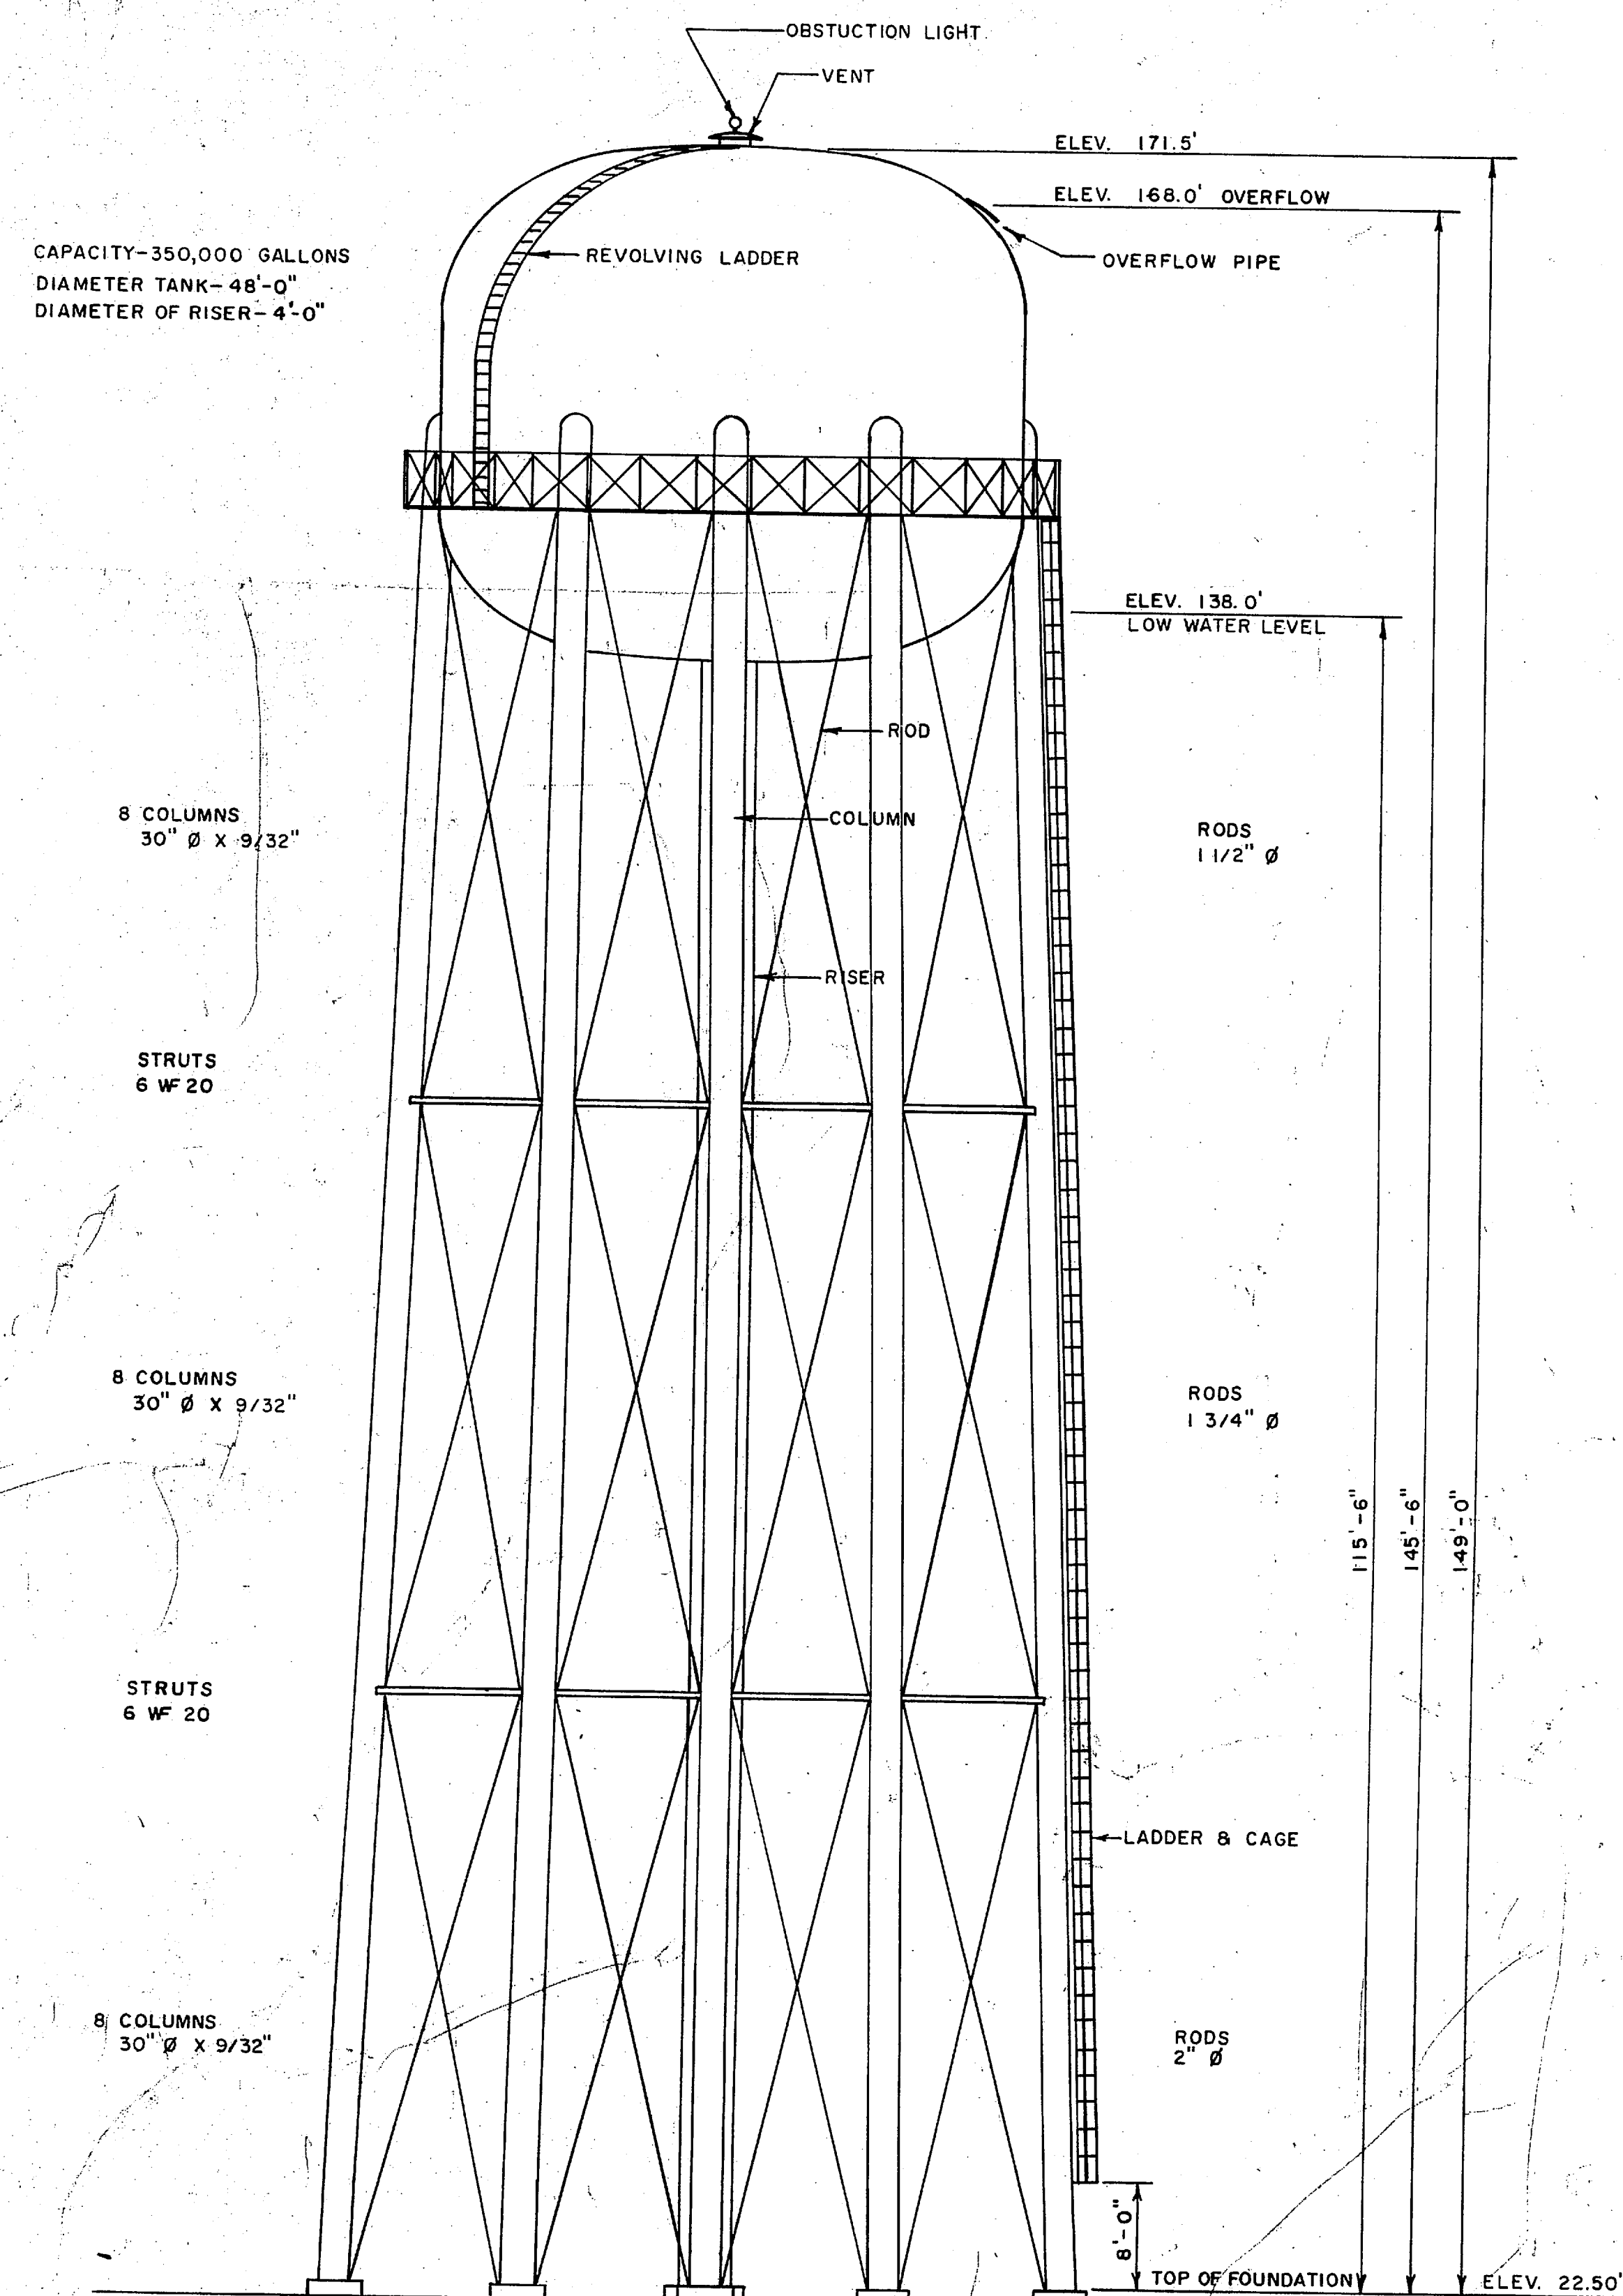


**ELEVATION OF TANK NO. 4130**  
SCALE: 1" = 10'-0"

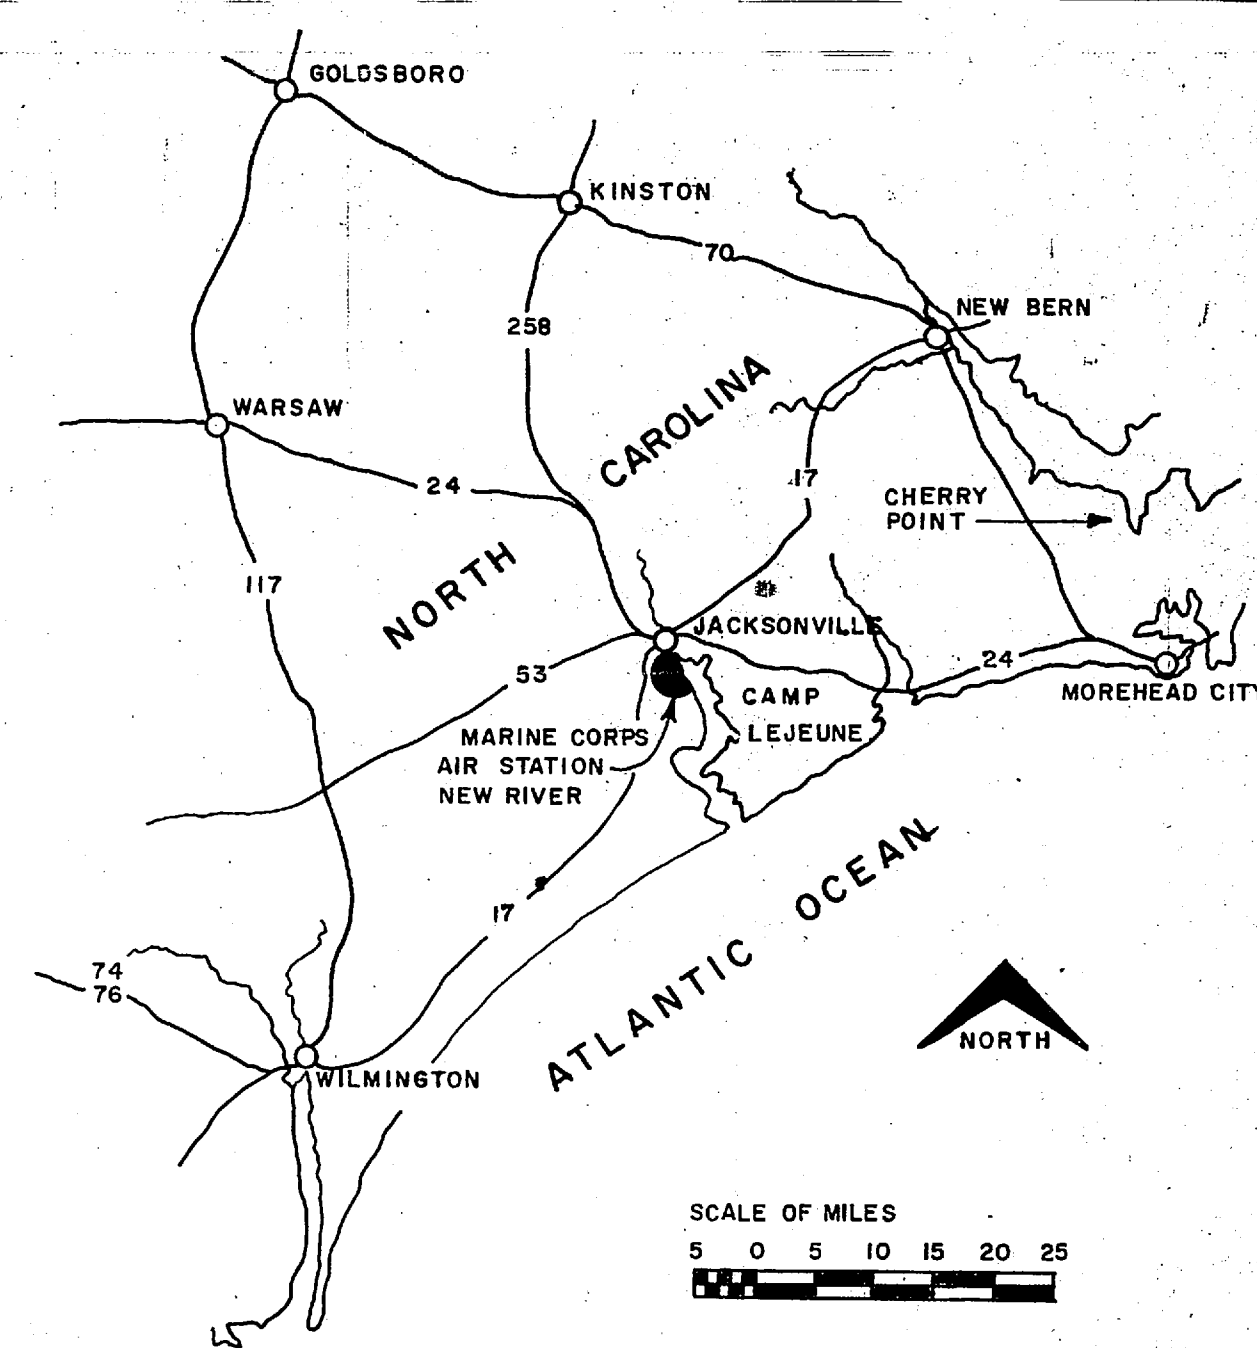

**LOCATION MAP**

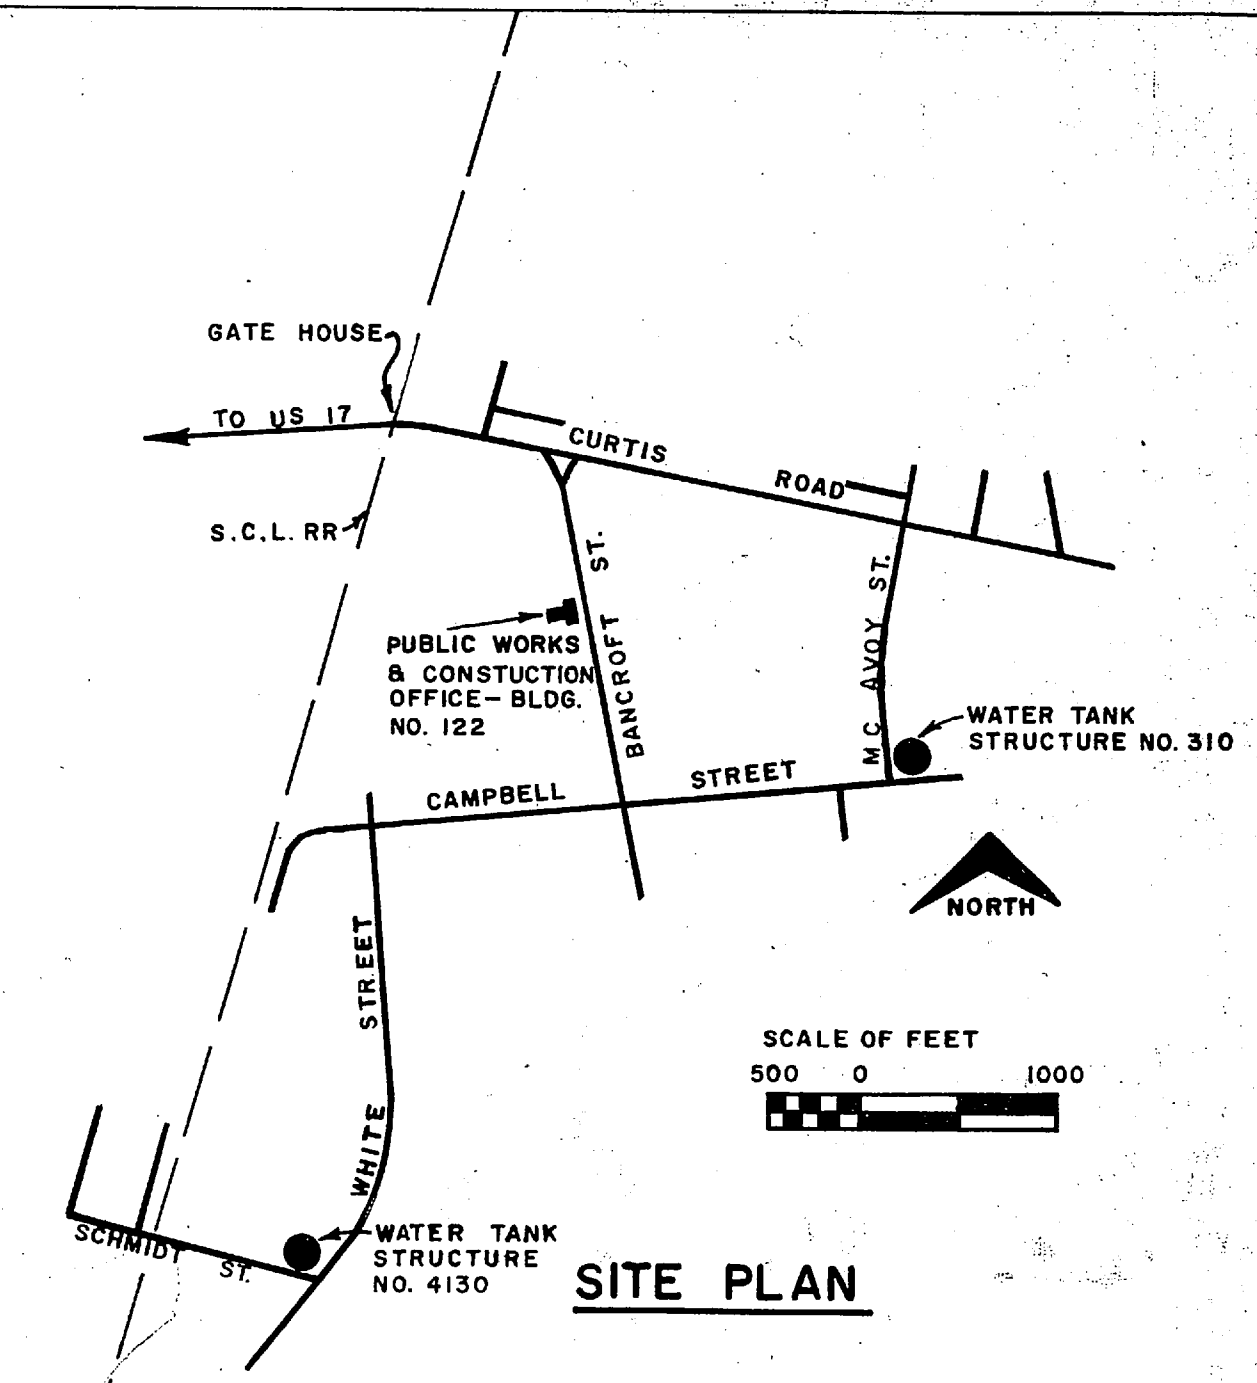

**SITE PLAN**

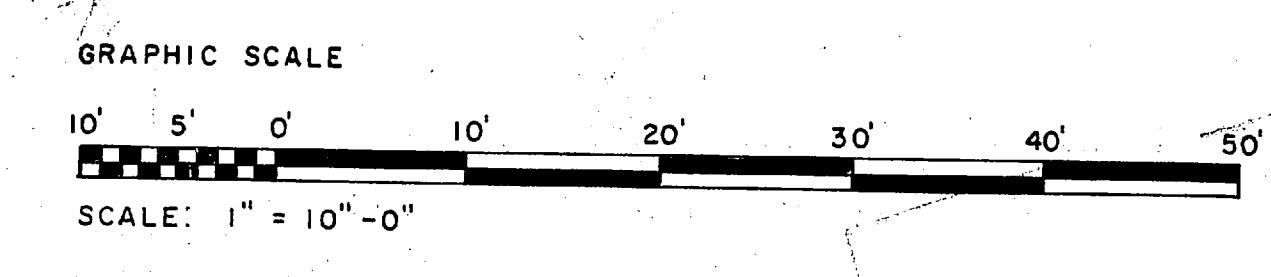

**AS310 - AS 4130**

REVISIONS			
SYM	DESCRIPTION	DATE	APPROVED
AS BUILT		8-21-73	

CFD DWG REF.	3-105	DEPARTMENT OF THE NAVY	NAVAL FACILITIES ENGINEERING COMMAND
DES.	E. G. JONES	12 OCT 73	<b>MARINE CORPS AIR STATION (HELICOPTER)</b>
DWN.	E. G. JONES	12 OCT 73	JACKSONVILLE, NORTH CAROLINA
CHK.			
<b>ELEVATED STORAGE TANKS</b>			
<b>REPAINTING</b>			
APPROVED	DATE	CODE IDENT NO.	SIZE NAVFAC DWG. NO.
	11/1/73	D	F 4011700
PUBLIC WORKS OFFICER	DATE	CONTR. CONSTR. NO.	N 62470-74-B-0633
	11/1/73		
DIE FOR COMMANDER NTC		SCALE GRAPHIC SPEC.	05-74-0633
		SHEET 1 OF 1	

1231-12 1130