

VALUABLE

SUBJECT

Range #365
I.T.R.

RETURN TO
PUBLIC WORKS
OFFICE
CAMP LEJEUNE
NORTH CAROLINA

FIELD PARTY

____ IN CHARGE
____ INSTRUMENT
____ NOTES
____ TAPE READ
____ TAPE OR ROD
____ TAPE OR ROD
____ INSTRUMENT NO.
____ TAPE NO.



WEATHER

____ CLEAR
____ CLOUDY
____ WINDY
____ RAIN
____ FAIR
____ SNOW
____ HOT
____ MODERATE
____ COLD
____ FOG
FIGURED BY _____
NOTES CHECKED BY _____
PLOTTED BY _____

FILE No. 179-D
FLDR. No. _____
SHEET # 2 of 2
DATE 6/9/1961

Quad. No. _____

STATION	DIST.	ANGLE ° ' "	H. I. BEARING	VER. ANG. DIFF.	ELEVATION
---------	-------	----------------	------------------	--------------------	-----------

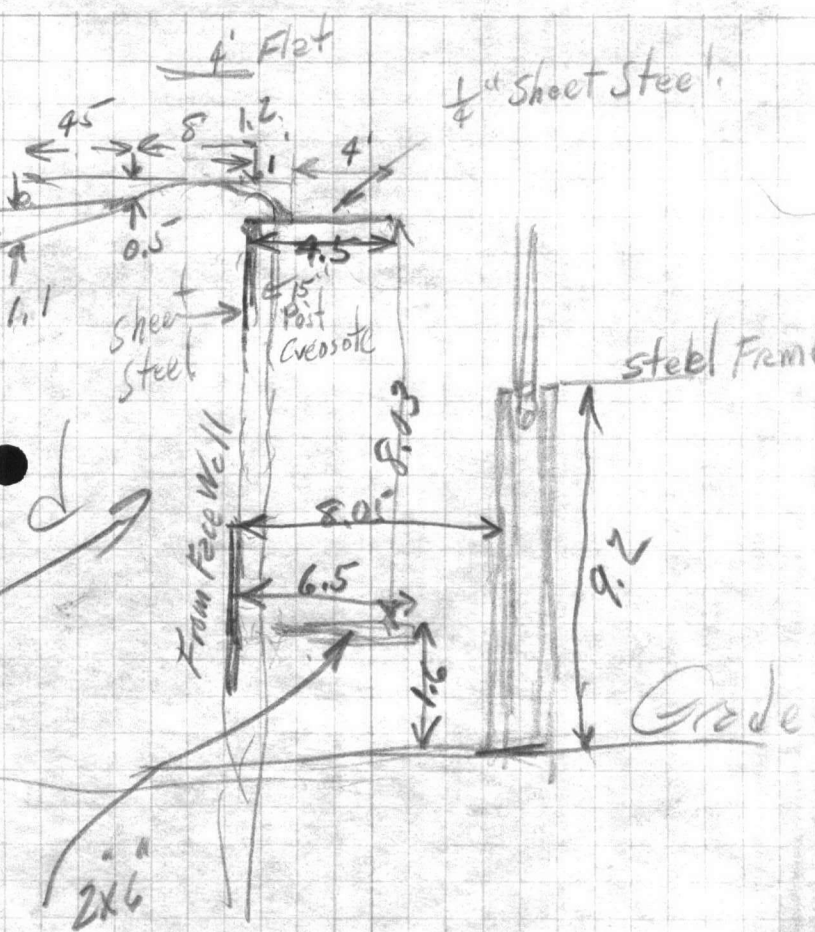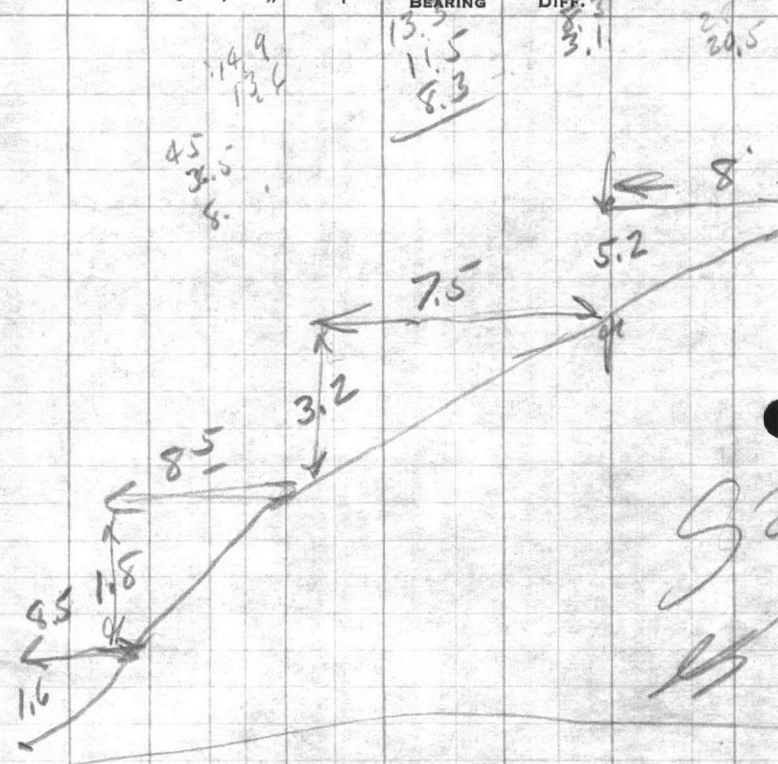

Sand

2x6

