

**VALUABLE**

SUBJECT Bldg. Locations  
Stockade

RETURN TO  
PUBLIC WORKS  
OFFICE  
CAMP LEJEUNE  
NORTH CAROLINA

FIELD PARTY

\_\_\_\_ IN CHARGE  
\_\_\_\_ INSTRUMENT  
\_\_\_\_ NOTES  
\_\_\_\_ TAPE READ  
\_\_\_\_ TAPE OR ROD  
\_\_\_\_ TAPE OR ROD  
\_\_\_\_ INSTRUMENT No.  
\_\_\_\_ TAPE No.

WEATHER

CLEAR SNOW  
CLOUDY HOT  
WINDY MODERATE  
RAIN COLD  
FAIR FOG


FILE No. \_\_\_\_\_

FLDR. No. \_\_\_\_\_

SHEET \_\_\_\_\_

NOTES CHECKED BY \_\_\_\_\_  
PLOTTED BY \_\_\_\_\_ DATE 9-29 1956

Quad. No. \_\_\_\_\_

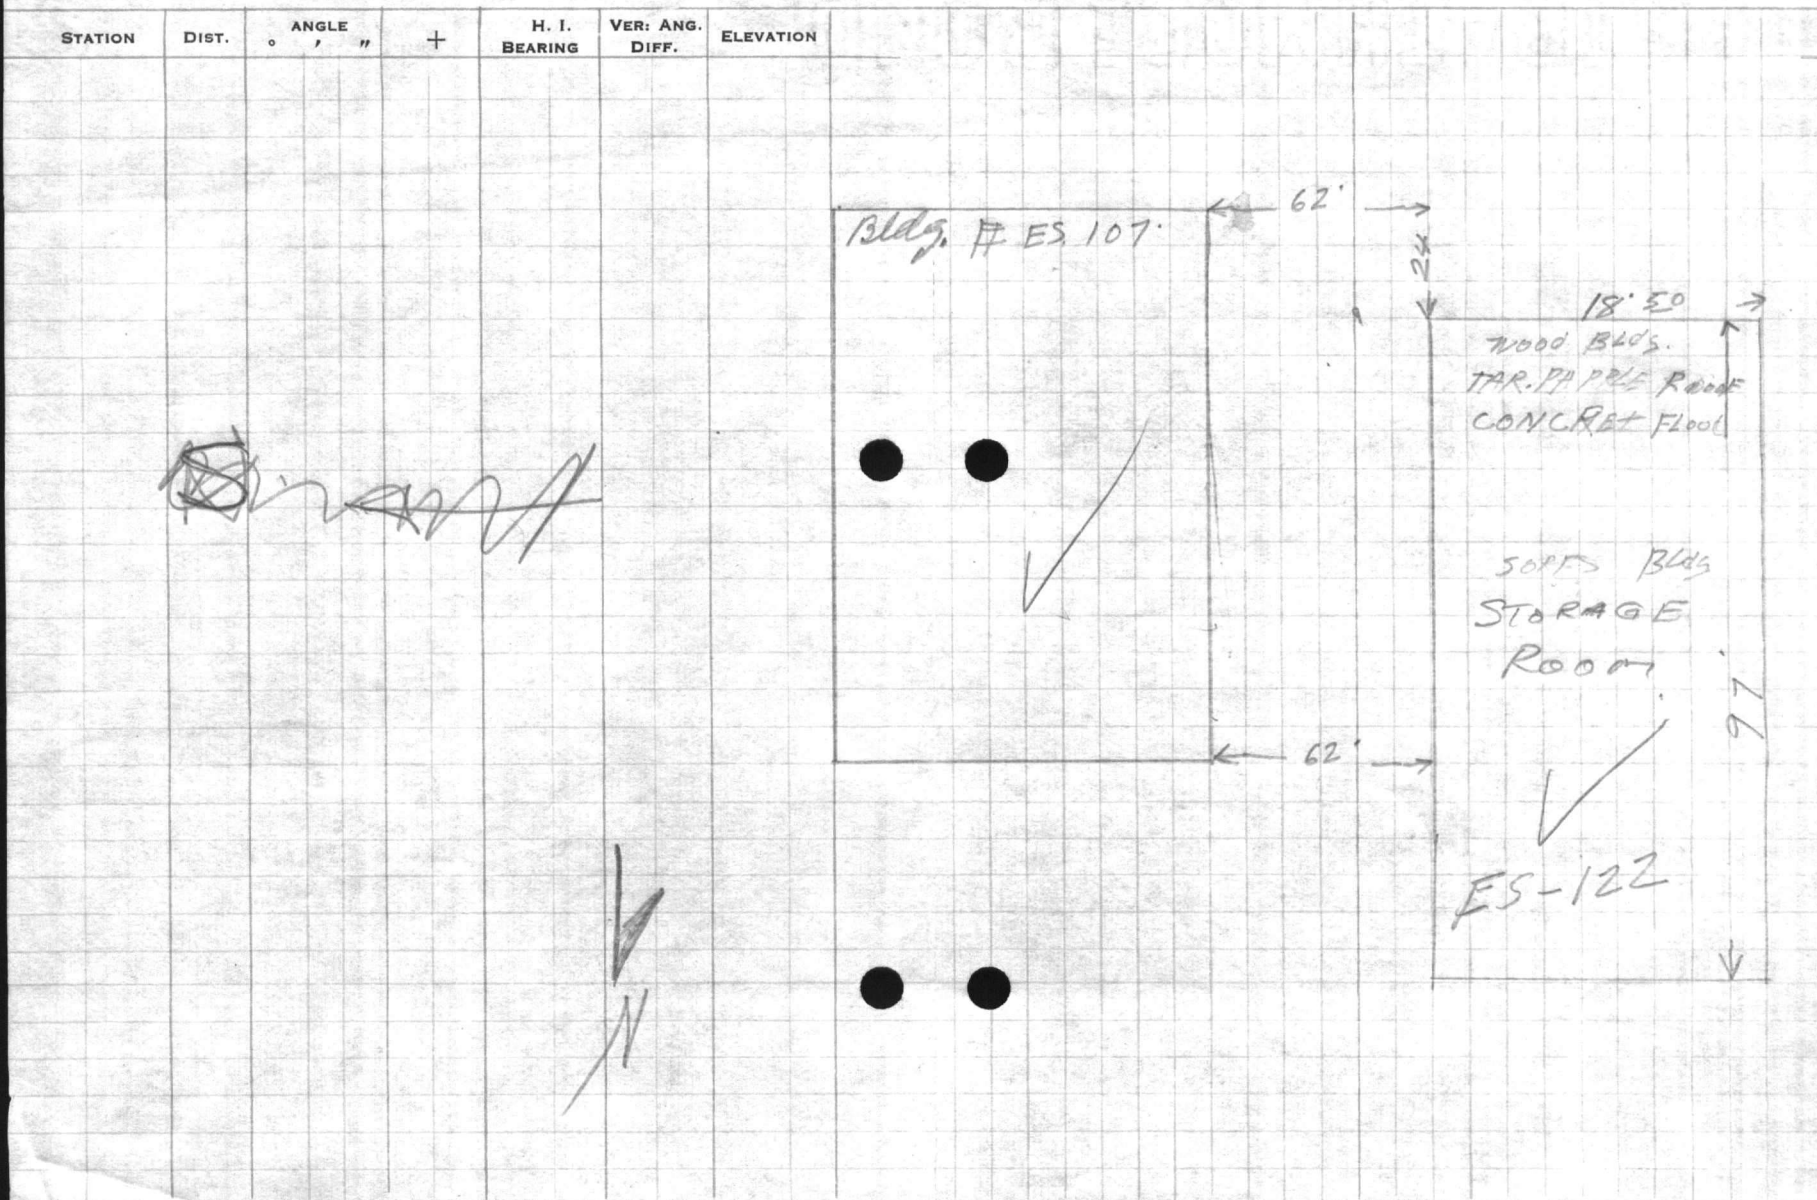


MAILABLE

RETURN TO  
POSTAL SERVICE  
OFFICE  
SANDY SPRING  
NORTH CAROLINA

STATION

WEATHER  
CLEAR  
HOT  
WINDY  
COLD  
THUNDERSTORM  
ICE  
FOG  
HAIL  
SUNNY  
PARTLY CLOUDY  
PARTLY SUNNY  
BREEZY  
CALM  
MISTY  
DRIZZLY  
RAINY  
SNOWY  
ICEY  
WINDY  
CLOUDY  
PARTLY CLOUDY  
PARTLY SUNNY  
BREEZY  
CALM  
MISTY  
DRIZZLY  
RAINY  
SNOWY  
ICEY

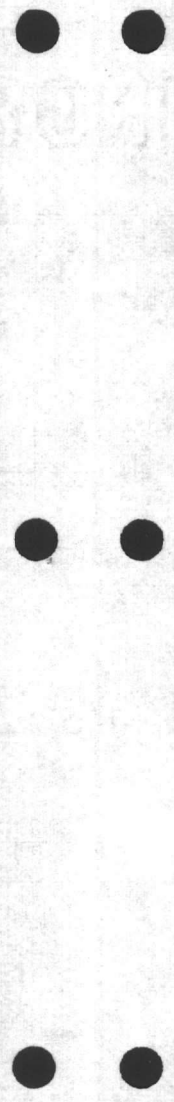

**VALUABLE**

SUBJECT \_\_\_\_\_

RETURN TO  
PUBLIC WORKS  
OFFICE  
CAMP LEJEUNE  
NORTH CAROLINA

STOCKADE

**FIELD PARTY**

\_\_\_\_\_  
IN CHARGE  
\_\_\_\_\_  
INSTRUMENT  
\_\_\_\_\_  
NOTES  
\_\_\_\_\_  
TAPE READ  
\_\_\_\_\_  
TAPE OR ROD  
\_\_\_\_\_  
TAPE OR ROD  
\_\_\_\_\_  
INSTRUMENT NO.  
\_\_\_\_\_  
TAPE NO.

**WEATHER**

CLEAR  
CLOUDY  
WINDY  
RAIN  
FAIR  
SNOW  
HOT  
MODERATE  
COLD  
FOG

FILE No. \_\_\_\_\_

FLDR. No. \_\_\_\_\_


SHEET \_\_\_\_\_

NOTES CHECKED BY \_\_\_\_\_

PLOTTED BY \_\_\_\_\_ DATE \_\_\_\_\_ 19\_\_

Quad. No. \_\_\_\_\_

STATION    DIST.    ANGLE  
                 °   '   "    +    H. I.    VER: ANG.    ELEVATION  
                                                    BEARING    DIFF.

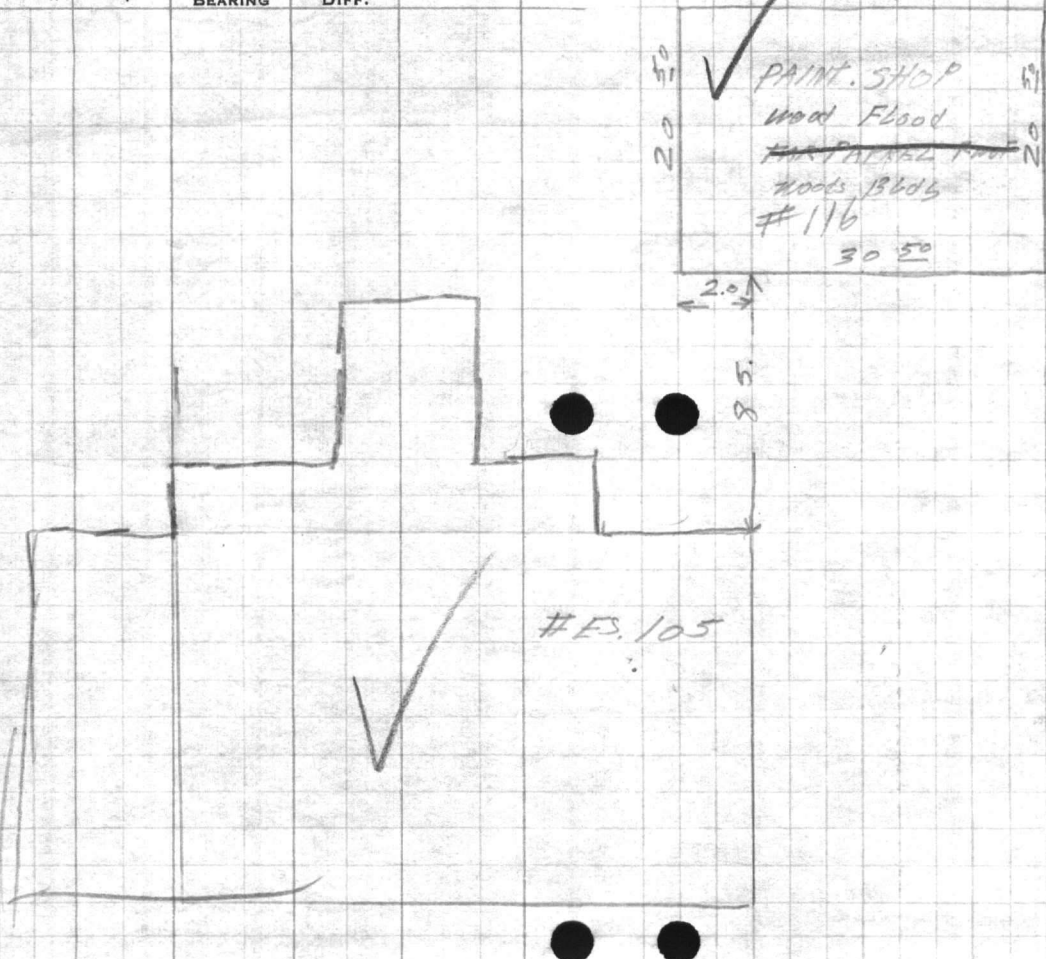

✓  
PAINT. SHOP  
Wood Floor  
~~PAINTED~~  
WOOD BLDG  
#116  
30 50

ASPHALT SHINGLE  
ROOF  
EAVE = 7.8'  
PEAK = 11.3'

#ES. 105

RECEIVED

U.S. DEPARTMENT OF THE ARMY  
HEADQUARTERS  
WASHINGTON, D.C.

STATION OFF

FIELD BATTERY  
1ST SIGNAL BATTALION  
1ST SIGNAL BRIGADE  
1ST SIGNAL DIVISION  
1ST SIGNAL CORPS  
1ST SIGNAL CENTER  
1ST SIGNAL GROUP  
1ST SIGNAL BATTALION

1ST SIGNAL BATTALION  
1ST SIGNAL BRIGADE  
1ST SIGNAL DIVISION  
1ST SIGNAL CORPS  
1ST SIGNAL CENTER  
1ST SIGNAL GROUP  
1ST SIGNAL BATTALION



**VALUABLE**

SUBJECT \_\_\_\_\_  
 \_\_\_\_\_  
 \_\_\_\_\_  
 \_\_\_\_\_

RETURN TO  
 PUBLIC WORKS  
 OFFICE  
 CAMP LEJEUNE  
 NORTH CAROLINA

**FIELD PARTY**

\_\_\_\_\_  
 IN CHARGE  
 \_\_\_\_\_  
 INSTRUMENT  
 \_\_\_\_\_  
 NOTES  
 \_\_\_\_\_  
 TAPE READ  
 \_\_\_\_\_  
 TAPE OR ROD  
 \_\_\_\_\_  
 TAPE OR ROD  
 \_\_\_\_\_  
 INSTRUMENT NO. \_\_\_\_\_  
 TAPE NO. \_\_\_\_\_

**WEATHER**

CLEAR  
 CLOUDY  
 WINDY  
 RAIN  
 FAIR

SNOW  
 HOT  
 MODERATE  
 COLD  
 FOG

FILE No. \_\_\_\_\_  
 FLDR. No. \_\_\_\_\_  
 SHEET \_\_\_\_\_  
 DATE \_\_\_\_\_ 19\_\_

Quad. No. \_\_\_\_\_

STATION	DIST.	ANGLE ° ' "	+	H. I. BEARING	VER: ANG. DIFF.	ELEVATION
---------	-------	----------------	---	------------------	--------------------	-----------

7.4805 gal. in 1 cu. ft.

Cir. Dia. 15.4'  
 R 2x11

7.7  
 47.7  
 539  
 539  
 59.29


15.4' Dia.

3.1496 | 48.4  
 31416  
 169840  
 157080  
 127600  
 125664  
 19360

3.1416  
 59.29  
 282744  
 62832  
 282744  
 157080  
 186265464

186.3  
 7.48  
 14904  
 7952  
 13041  
 1393524  
 8.1  
 1393524  
 1148192  
 112875444

1400  
 8  
 11200

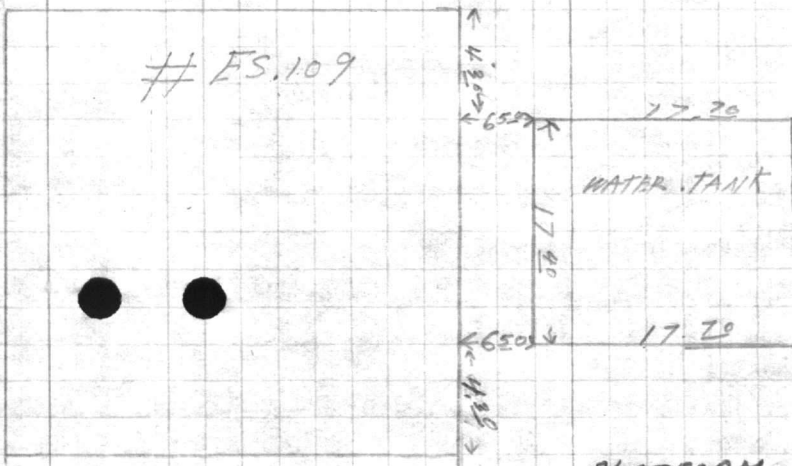

PLATFORM OF WATER  
 TANK.  
 HEIGHT: 21.2'  
 TANK: 8.1' High  
 CIR. OF TANK: 48.4'

PLATFORM OF TANK  
 IS CONSTRUCTED OF  
 2 1/2" GALV. PIPE ON  
 APPROX. 5' CENTERS  
 SIZE OF PLATFORM  
 17.4' X 17.4' DECK  
 OF PLATFORM IS OF  
 2" O" LUMBER  
 PLATFORM ON 8"  
 WOOD SILLS.


AVAILABLE

SUB SET

STATION  
DISTRICT

STATION DISTRICT

STATION DISTRICT

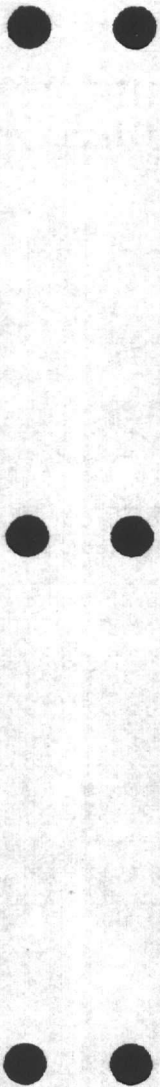

TO: PARTY  
FROM: PARTY  
DATE: 1/1/19

TO: PARTY  
FROM: PARTY  
DATE: 1/1/19

**VALUABLE**

SUBJECT \_\_\_\_\_  
\_\_\_\_\_  
\_\_\_\_\_  
\_\_\_\_\_  
\_\_\_\_\_

RETURN TO  
PUBLIC WORKS  
OFFICE  
CAMP LEJEUNE  
NORTH CAROLINA

FIELD PARTY

\_\_\_\_\_  
IN CHARGE  
\_\_\_\_\_  
INSTRUMENT  
\_\_\_\_\_  
NOTES  
\_\_\_\_\_  
TAPE READ  
\_\_\_\_\_  
TAPE OR ROD  
\_\_\_\_\_  
TAPE OR ROD  
\_\_\_\_\_  
STRUMENT NO.  
\_\_\_\_\_  
TAPE NO.

WEATHER

CLEAR  
CLOUDY  
WINDY  
RAIN  
FAIR  
SNOW  
HOT  
MODERATE  
COLD  
FOG

FILE No. \_\_\_\_\_

FLDR. No. \_\_\_\_\_



SHEET \_\_\_\_\_

NOTES CHECKED BY \_\_\_\_\_

PLOTTED BY \_\_\_\_\_ DATE \_\_\_\_\_ 19\_\_

Quad. No. \_\_\_\_\_

STATION	DIST.	ANGLE			H. I. BEARING	VER. ANG. DIFF.	ELEVATION
		°	'	"			

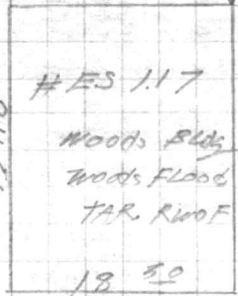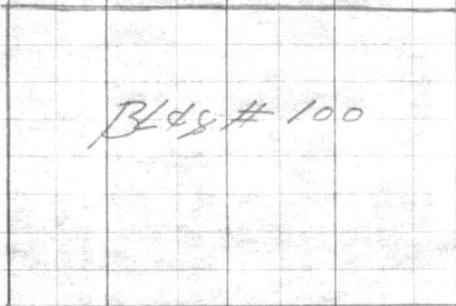

AVAILABLE

RETURN TO  
PUBLIC WORKS  
OFFICE  
CAMP CATONS  
NORTH CAROLINA

STATION TIME ANGLE

SCAN

DATE TIME

TABLE NO.

STATE ON ROAD

TABLE NO.

TABLE NO.

WINDY

CLOUDY

CLEAR

FIELD PARTY

NO. 1