




**ELEVATION OF TANK NO. 310**  
SCALE: 1" = 10'-0"

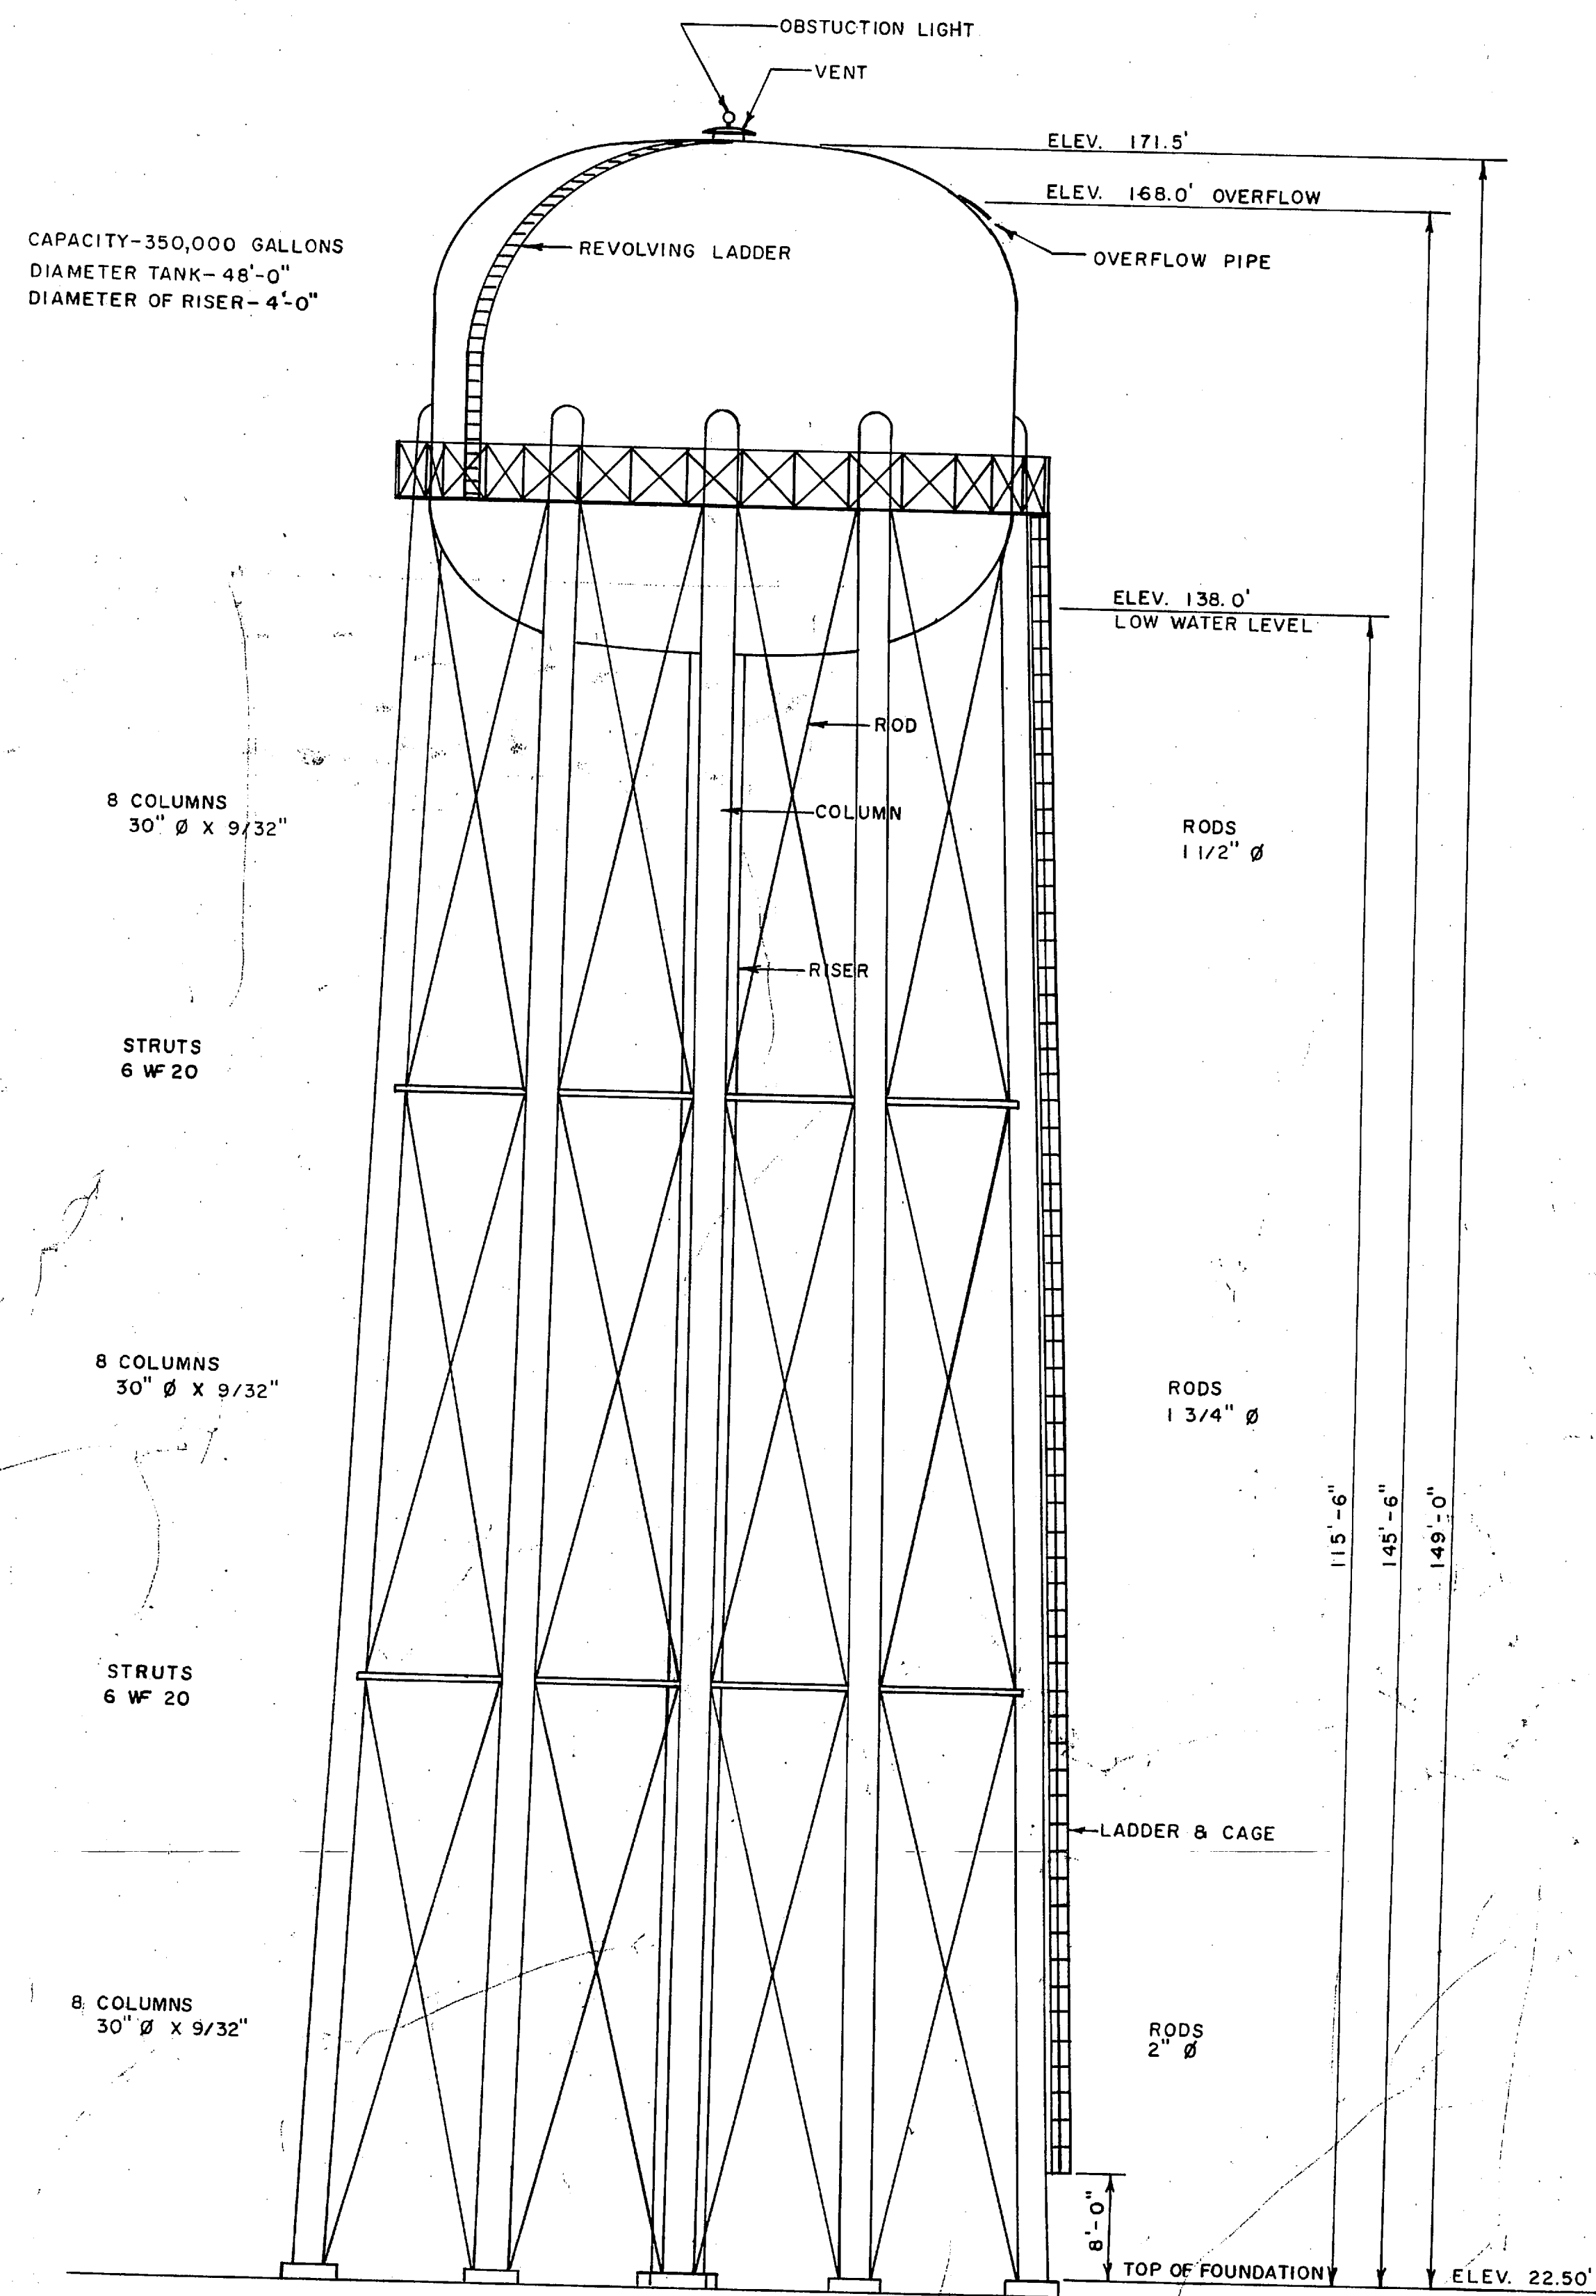


**ELEVATION OF TANK NO. 4130**  
SCALE: 1" = 10'-0"

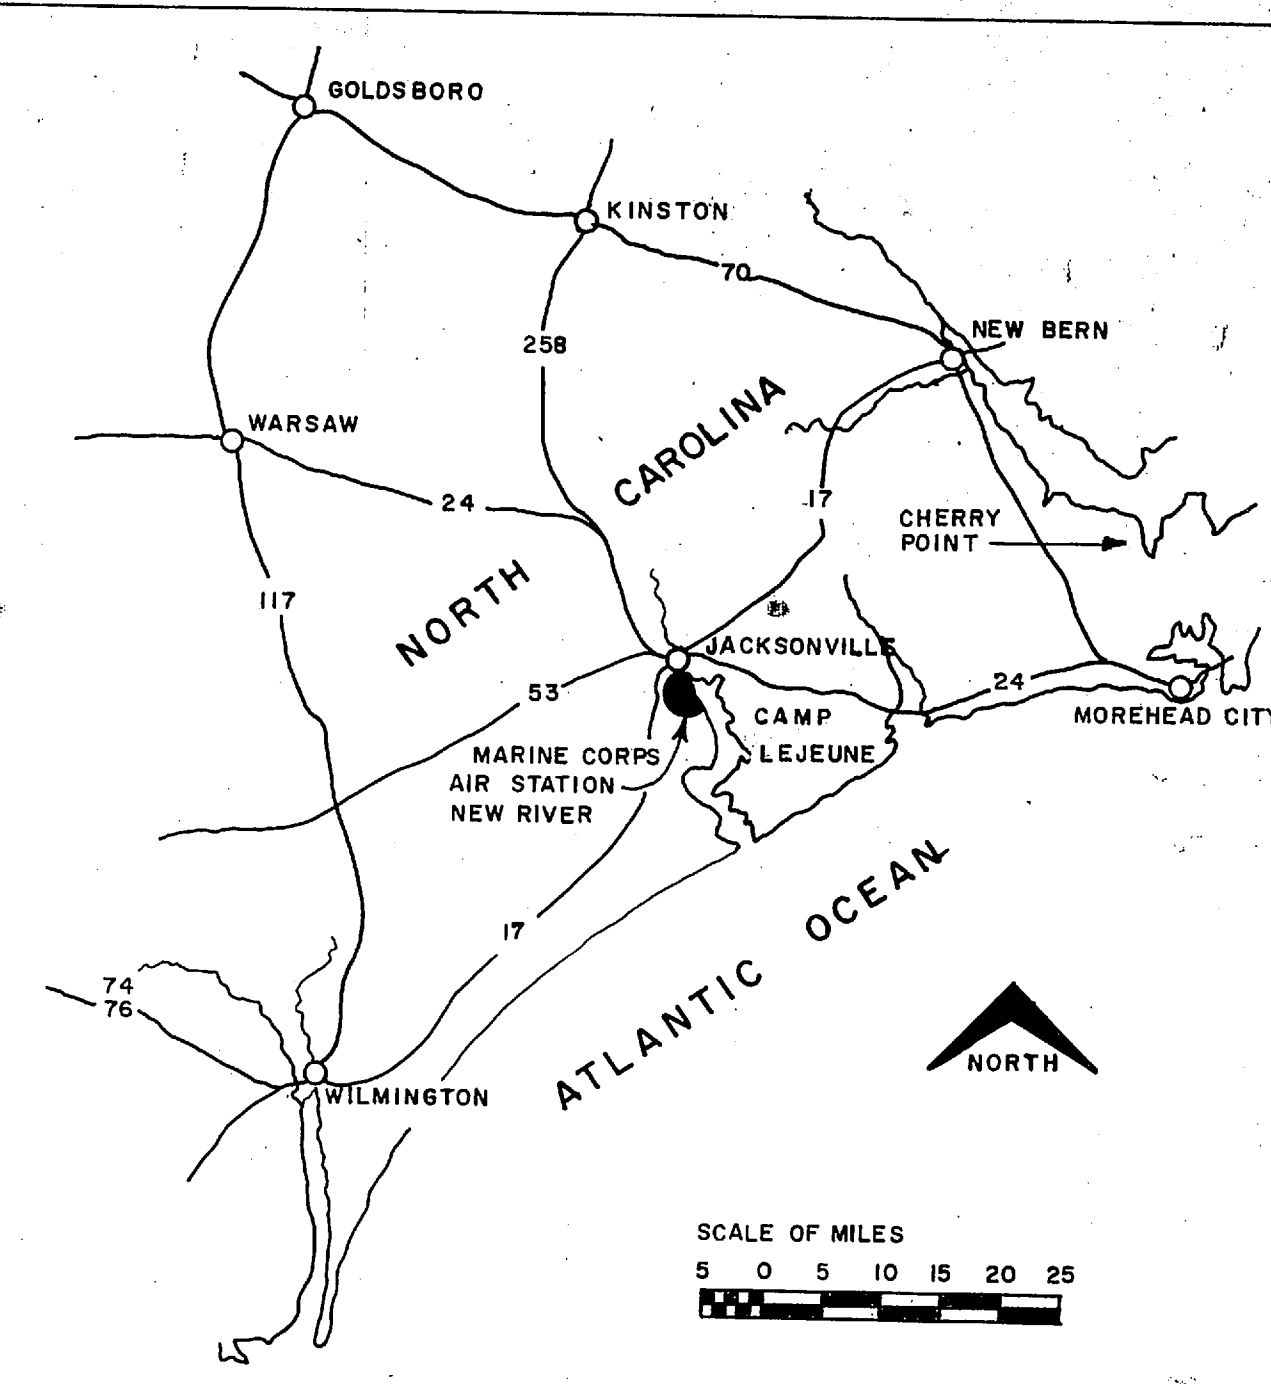

**LOCATION MAP**

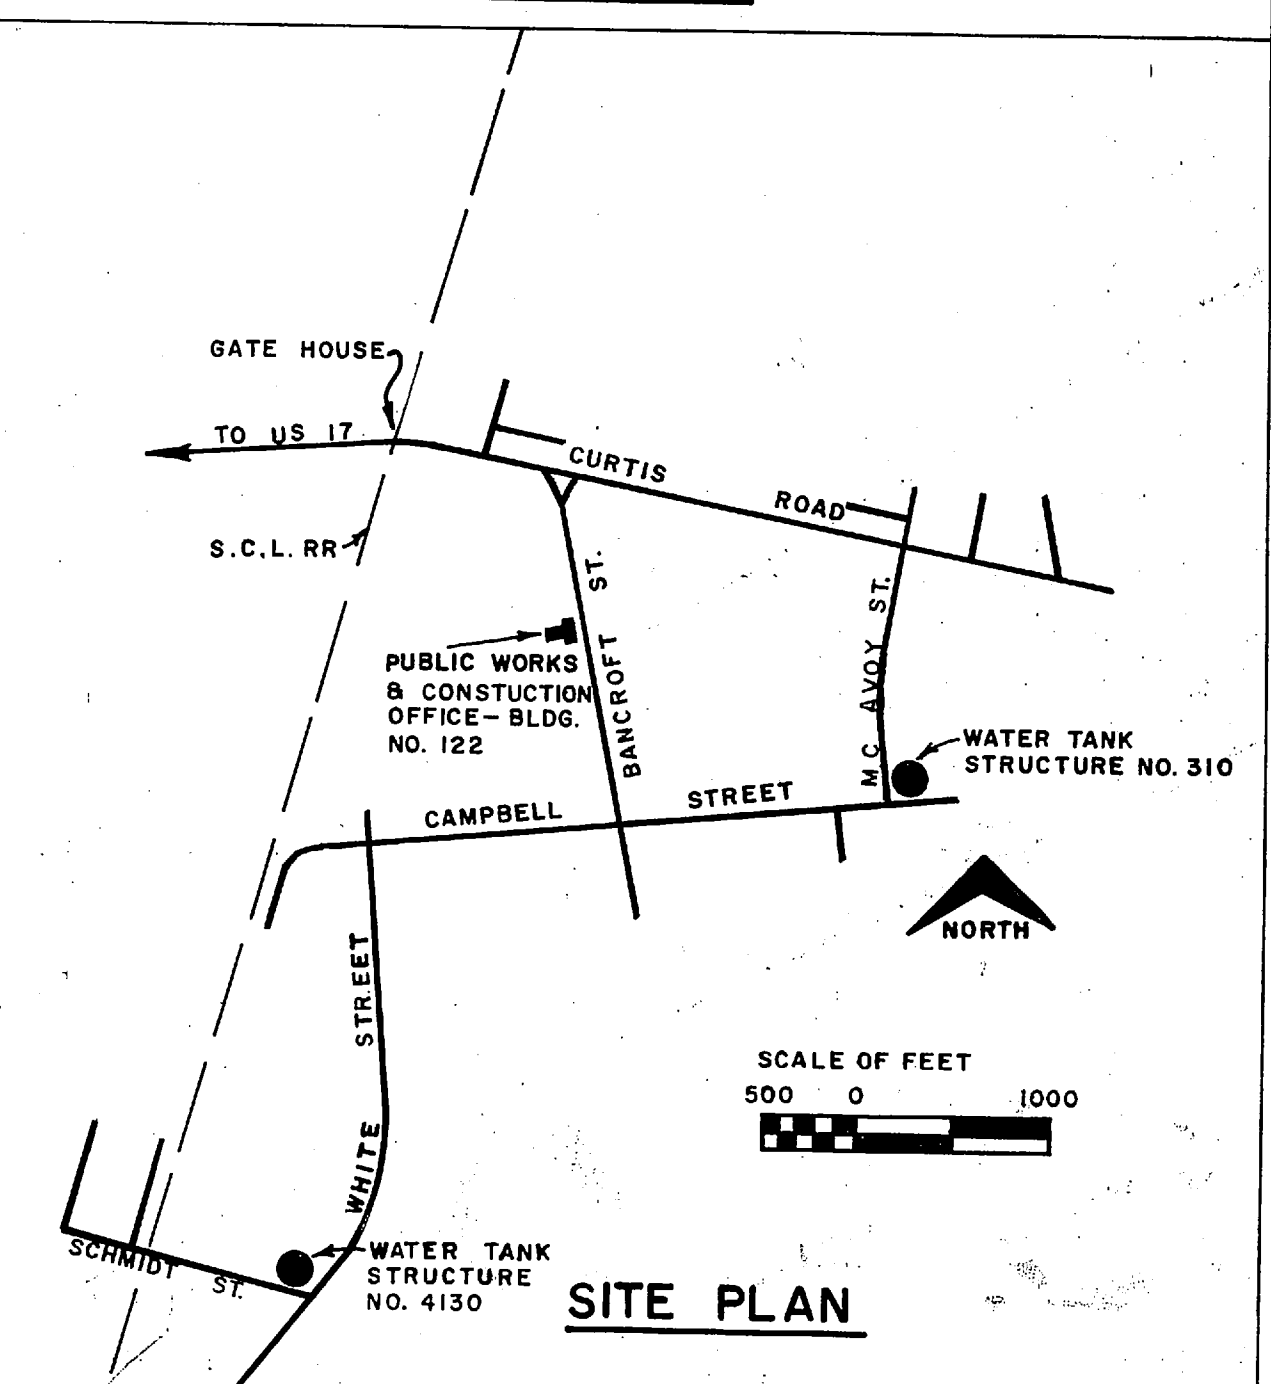

**SITE PLAN**

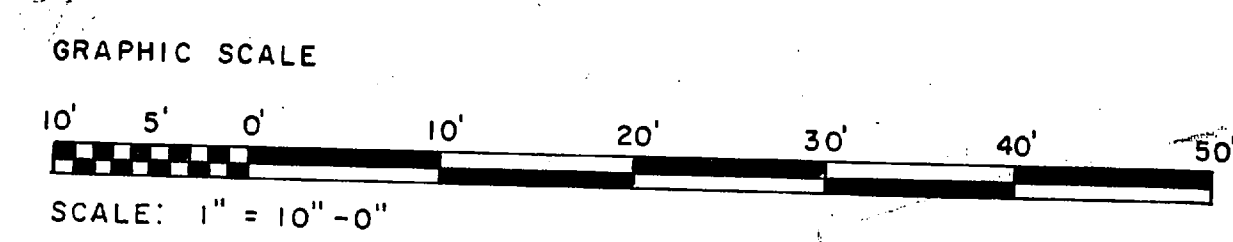

REVISIONS			
SYM	DESCRIPTION	DATE	APPROVED
AS BUILT			

CFD DWG REF. <b>3-105</b>	DEPARTMENT OF THE NAVY NAVAL FACILITIES ENGINEERING COMMAND
DES. E.G. JONES 12 OCT 73	<b>MARINE CORPS AIR STATION (HELICOPTER), NEW RIVER</b> JACKSONVILLE, NORTH CAROLINA
DWN. E.G. JONES 12 OCT 73	<b>ELEVATED STORAGE TANKS</b>
CHK. [Signature]	<b>REPAINTING</b>
APPROVED [Signature] DATE [Date]	CODE IDENT NO. SIZE NAVFAC DWG. NO.
PUBLIC WORKS OFFICER [Signature]	<b>D F 4011700</b>
APPROVED [Signature] DATE [Date]	CONTR. CONSTR. NO. N 62470-74-B-0633
DICC FOR COMMANDER NPEC	SCALE: GRAPHIC SPEC. 05-74-0633 SHEET 1 OF 1

M  
Catholic Protection  
11 2000 10/20/2000

WATER TANKS