


ROOM FINISH SCHEDULE						
NO	SPACE	FLOOR	BASE	WALLS	CEILING	REMARKS
100	Lobby & Stair	Carpet	Vinyl	Gypsum board	Acoustical panels	Ceiling height 9'-8"
101	Reception	Carpet	Vinyl	Gypsum board	Acoustical panels	9'-8"
102	Admin. Asst.	Carpet	Vinyl	Gypsum board	Acoustical panels	9'-8"
103	Exchange Off.	Carpet	Vinyl	Gypsum board	Acoustical panels	9'-8"
104	Vestibule	Carpet	Vinyl	Gypsum board	Gypsum board	Ceiling height 8'-0"
105	Toilet	Ceramic tile	Ceramic tile	Gypsum board	Gypsum board	Ceiling height 8'-0"
106	Alcove	Carpet	Vinyl	Gypsum board	Acoustical panels	9'-2"
107	Secretary	Carpet	Vinyl	Gypsum board	Acoustical panels	9'-2"
108	Personnel	Carpet	Vinyl	Gypsum board	Acoustical panels	9'-2"
109	Office	Carpet	Vinyl	Gypsum board	Acoustical panels	9'-2"
110	Interview	Carpet	Vinyl	Gypsum board	Acoustical panels	9'-2"
111	Concession	Carpet & Ceramic tile	Vinyl & Ceramic tile	Gypsum board	Acoustical panels	9'-8"
112	Gear	Ceramic tile	Ceramic tile	Gypsum board & masonry	Gypsum board	Ceiling height 8'-0"
113	Waiting	Carpet	Vinyl	Gypsum board	Acoustical panels	9'-8"
114	Secretary	Carpet	Vinyl	Gypsum board	Acoustical panels	9'-8"
115	Buyers	Carpet	Vinyl	Gypsum board	Acoustical panels	9'-6"
116	Invoice	Carpet	Vinyl	Gypsum board	Acoustical panels	9'-2"
117	Stock Control	Carpet	Vinyl	Gypsum board	Acoustical panels	9'-8"
118	Stair	Concrete	None	Masonry		
119	Merchandise Display	Carpet	Vinyl	Masonry	Exposed framing	
120	Corridor	Carpet	Vinyl	Masonry	Acoustical panels	9'-2"
121	Men's Toilet	Ceramic tile	Ceramic tile	Ceramic tile & plaster	Plaster	Ceiling height 8'-8"
122	Women's Toilet	Ceramic tile	Ceramic tile	Ceramic tile & plaster	Plaster	Ceiling height 8'-8"
123	Women's Lounge	Carpet	Vinyl	Gypsum board	Acoustical panels	Ceiling height 8'-8"
124	Property	Carpet	Vinyl	Masonry	Acoustical panels	Ceiling height 8'-8"
125	Child Care Center	Carpet	Vinyl	Masonry	Acoustical panels	12'-0"
126	Gear	Ceramic tile	Ceramic tile	Masonry	Gypsum board	Ceiling height 8'-8"
127	Toilet	Ceramic tile	Ceramic tile	Ceramic tile & plaster	Plaster	Ceiling height 8'-8"
128	Men's Toilet	Ceramic tile	Ceramic tile	Ceramic tile & plaster	Plaster	Ceiling height 8'-8"
129	Women's Toilet	Ceramic tile	Ceramic tile	Ceramic tile & plaster	Plaster	Ceiling height 8'-8"
130	Machine Rm.	Concrete	None	Masonry	F.S. gypsum board	Ceiling 2 layers 5/8" F.S. gyp. bd.
107A	Conference Rm.	Carpet	Vinyl	Gypsum board	Acoustical panels	Ceiling height 9'-2"
200	Hall	Carpet	Vinyl	Gypsum board	Acoustical panels	Ceiling height 9'-2"
201	Women's Toilet	Ceramic tile	Ceramic	Ceramic tile & plaster	Plaster	Cer. tile on walls 7'-0" high.
202	Men's Toilet	Ceramic tile	Ceramic	Ceramic tile & plaster	Plaster	Ceiling height 8'-8"
203	Operations	Carpet	Vinyl	Gypsum board	Acoustical panels	9'-2"
204	Accounting	Carpet	Vinyl	Gypsum board	Acoustical panels	9'-6"
205	Stair	Concrete	None	Masonry	Gypsum board	Ceiling height 8'-0"

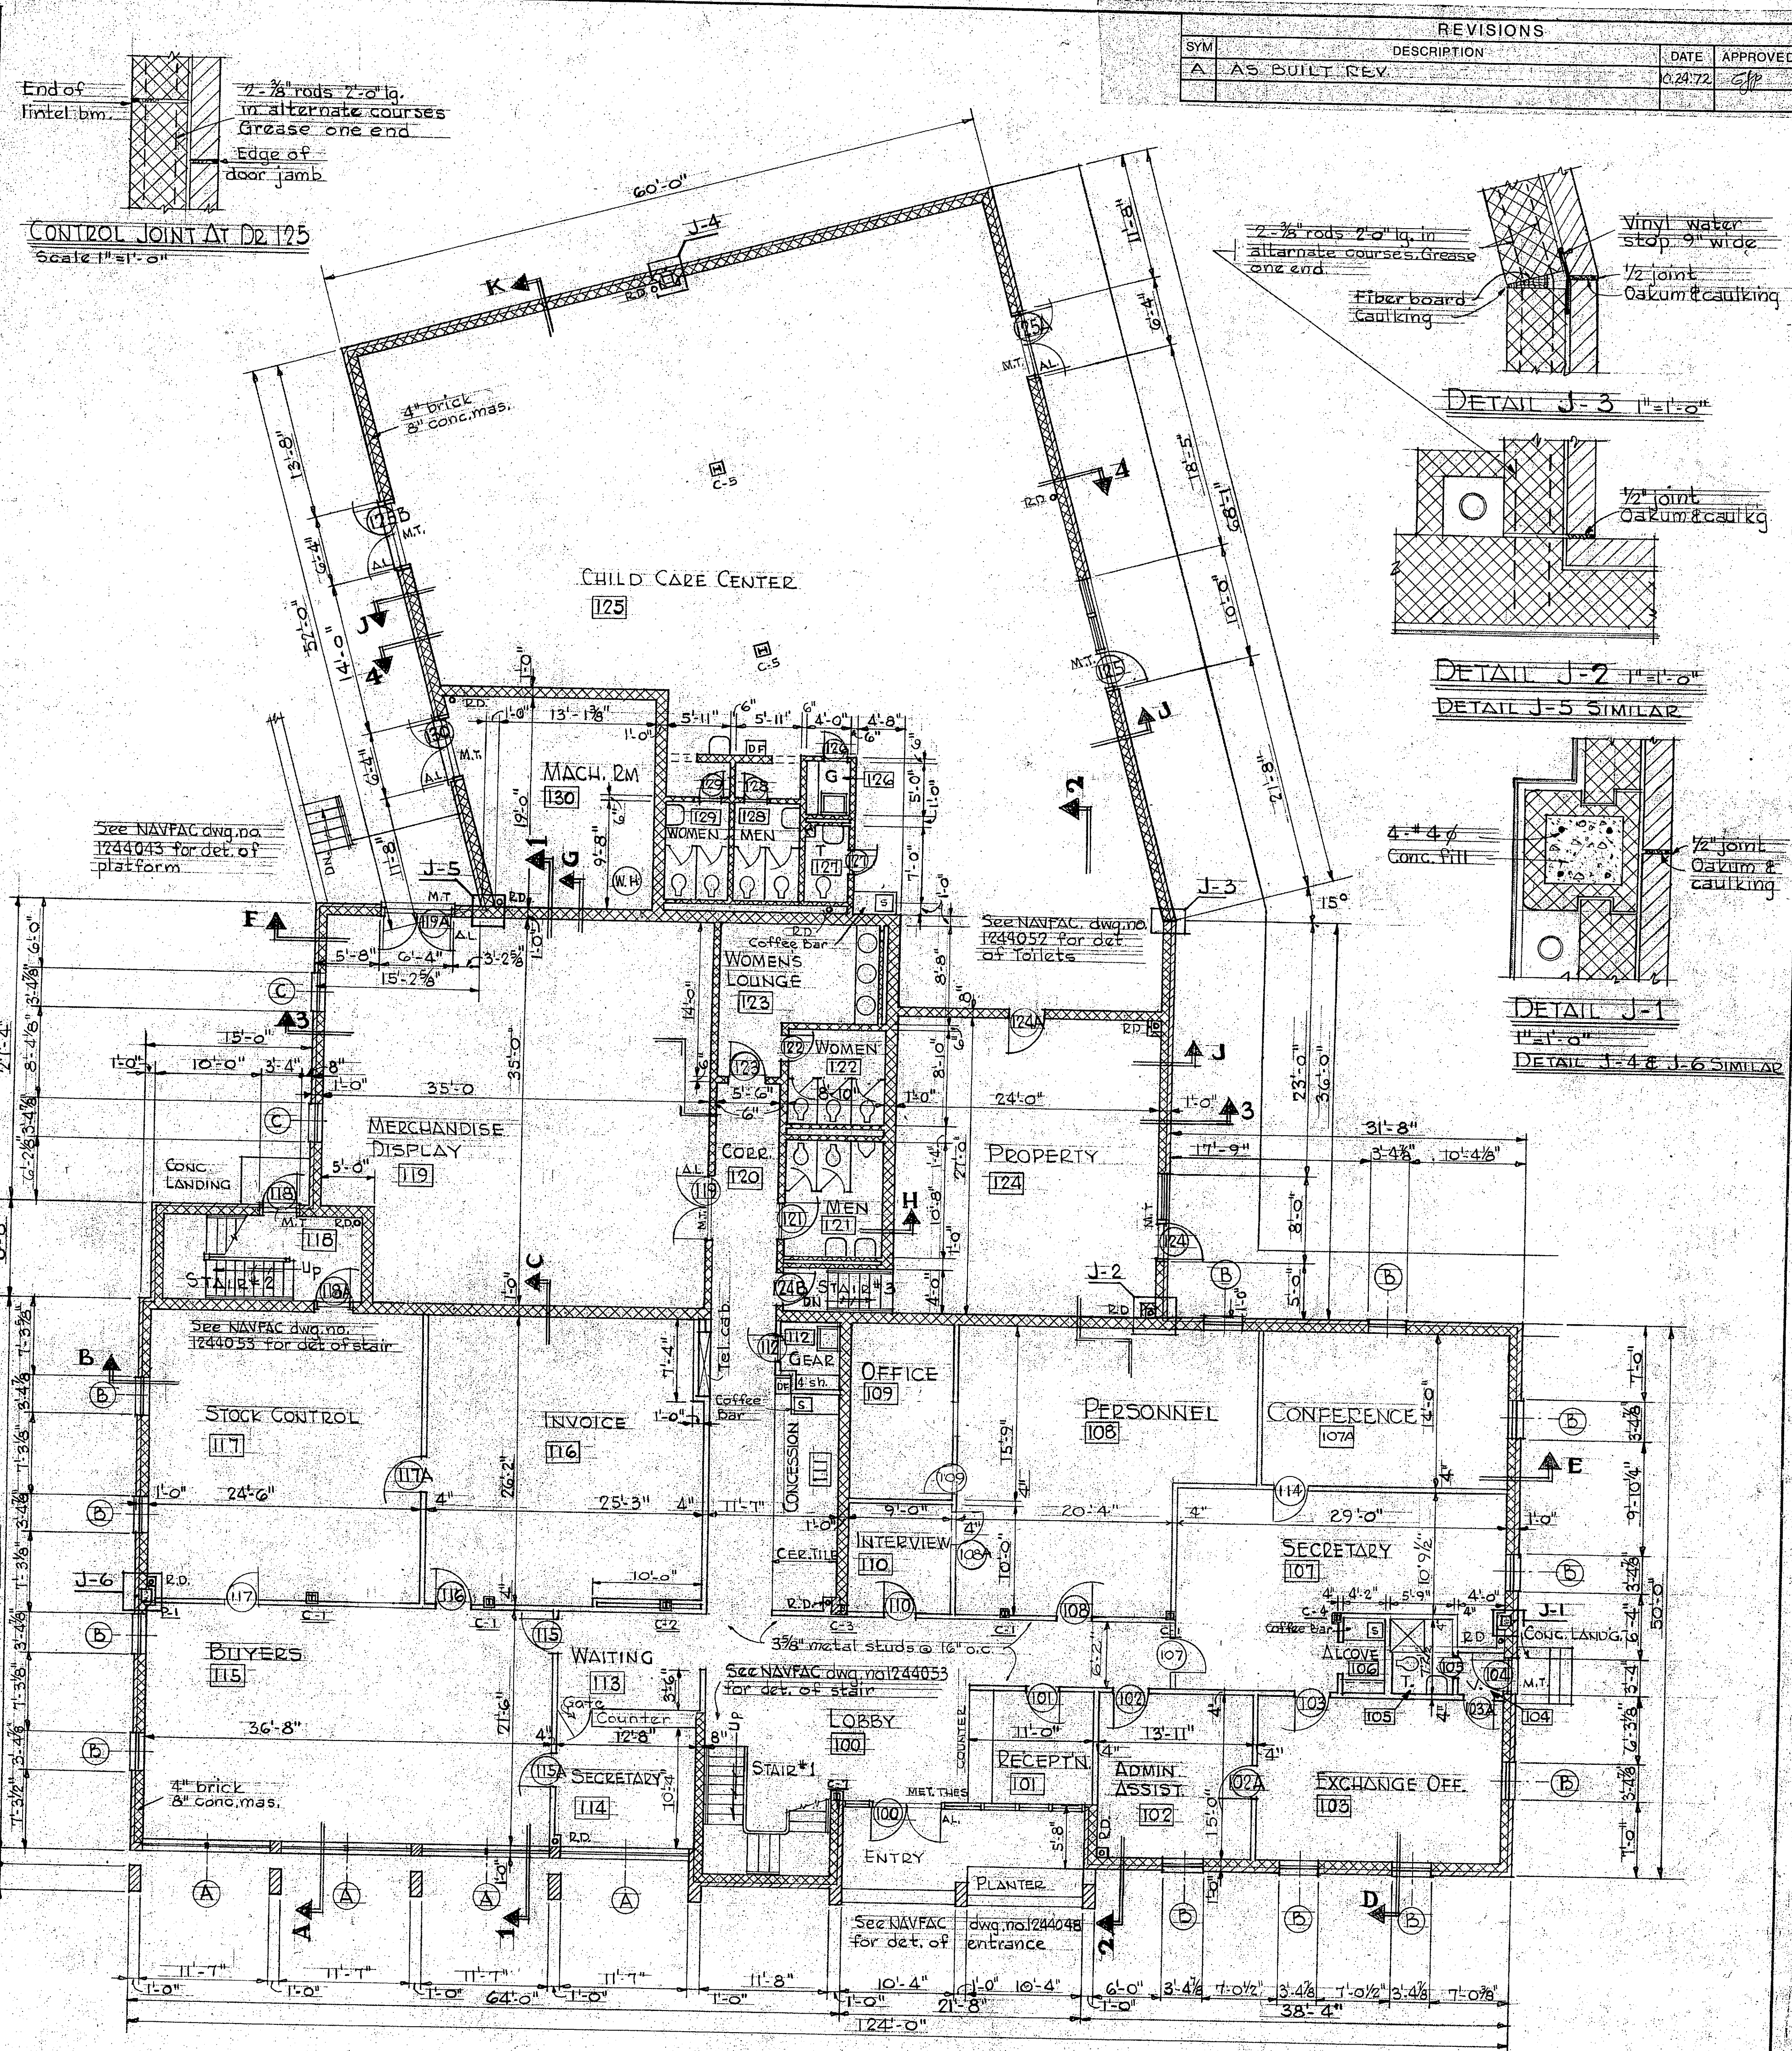

**FIRST FLOOR PLAN**  
Scale 1/8" = 1'-0"

**GRAPHIC SCALES**  
1/8" = 1'-0"  
1/4" = 2'-0"  
1/2" = 4'-0"  
3/4" = 6'-0"  
1" = 8'-0"

**REVISIONS**

SYM	DESCRIPTION	DATE	APPROVED
A	AS BUILT REV.	3-24-72	G.P.

**DETAILS:**  
 CONTROL JOINT AT D2 125 Scale 1" = 1'-0"  
 DETAIL J-3 1" = 1'-0"  
 DETAIL J-2 1" = 1'-0"  
 DETAIL J-5 SIMILAR  
 DETAIL J-1 1" = 1'-0"  
 DETAIL J-4 & J-6 SIMILAR

**DETAILS OF COLUMN FIREPROOFING:**  
 COL. C-1, COL. C-2, COL. C-3, COL. 4, COL. 5, COL. 6, COL. 7  
 NOTES APPLICABLE TO ALL COLUMNS EXCEPT C-3  
 Scale 1/2" = 1'-0"

**DETAILS OF PILASTERS:**  
 P-1, P-2  
 Scale 1/2" = 1'-0"

**Public Works Dept. Marine Corps Base Camp Lejeune, N.C.**  
 PROJECT: MARINE CORPS EXCHANGE SERVICE BUILDING  
 DRAWING NO: 1244046  
 CONTRACTOR: N62470-71-B-0520  
 DATE: 11-23-71

