


**FLOOR PLAN**  
SCALE: 1/8" = 1'-0"

**COLOR SCHEDULE**

- ALL CMU & PLASTER WALLS - # 26492 (EXCEPT INTERIOR OF LOOKOUT GALLERIES)
- ALL DOORS - # 37038
- LOOKOUT GALLERY (INTERIOR) - # 37038
- PAINT COLOR SELECTION FROM FEDERAL STANDARD 595
- VINYL ASBESTOS FLOOR - # 234, AMTICO
- RUBBER BASE - BLACK, AMTICO
- CERAMIC TILE FLOOR - # 472, ROMANY-SPARTAN
- PREFACED CMU - # 723 - SPECTRA-GLAZE
- TERRAZZO - PLATE 422 - NATIONAL TERRAZZO & MOSAIC ASSOCIATION, INC.
- LAMINATED PLASTIC - SUGAR MARLE # 23 (64) - PERMICA
- MANUFACTURER'S NAMES ARE FOR COLOR SELECTION ONLY

**GRAPHIC SCALES**

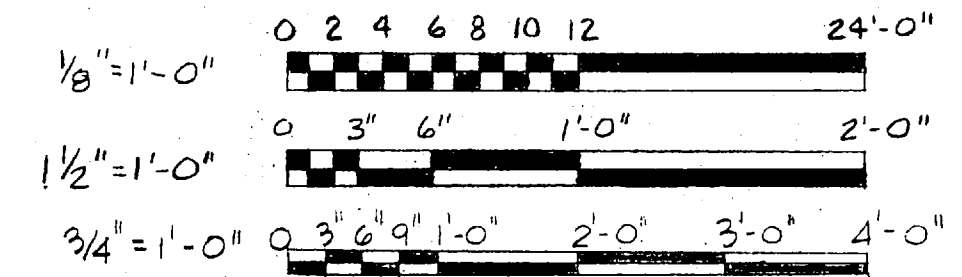

REVISIONS		
NO.	DESCRIPTION	DATE
1	AS BUILT	4-2-78

**NOTE:** EXTEND ALL 8" CMU WALLS TO UNDERSIDE OF ROOF STRUCTURE EXCEPT THOSE SEPARATING CLOSETS FROM TOILETS. SEE NAVFAC DWG. NO. 1337953 FOR RETURN AIR OPENINGS IN CMU WALLS.

**4A** DETAIL - COL. B-5  
SCALE: 1/2" = 1'-0"

**5A** DETAIL CONTROL JOINT  
SCALE: 1/2" = 1'-0"

**6A** DETAIL CONTROL JOINT  
SCALE: 1/2" = 1'-0"

**7A** DETAIL CONTROL JOINT  
SCALE: 1/2" = 1'-0"

**8A** SECTION THRU STEAM PIT  
SCALE: 3/4" = 1'-0"

**9A** DETAIL @ STEEL COLUMN  
SCALE: 1/2" = 1'-0"

**10A** SECTION @ ELECTRICAL DUCT  
SCALE: HALF FULL SIZE

FIN. NO.	FLOOR	WALLS	CEILING	BASE	WAINSCOT	REMARKS
F1	VINYL ASBESTOS	PAINTED CMU	ACoust. TILE	4" RUBBER	NONE	
F2	BRICK	PAINTED CMU	ACoust. TILE	TERRAZZO	NONE	GYPSUM PLASTER WALL AS SHOWN
F3	CONC.	PAINTED CMU	NONE	NONE	NONE	
F4	VINYL ASBESTOS	BODY PAINT	GYPSUM	4" RUBBER	NONE	
F5	CERAMIC TILE	PREFACED CMU	GYPSUM	PREFACED CMU	NONE	
F6	VINYL ASBESTOS	CONC.	CONC.	NONE	NONE	
F7	ASPHALT PLANK	PAINTED CMU	ACoust. TILE	NONE	BRICK 4'-0" HIGH	
F8	CONC.	PAINTED CMU	ACoust. TILE	NONE	NONE	
F9	VINYL ASBESTOS	PAINTED CMU	GYPSUM PLASTER	NONE	NONE	
F10	CONC.	PAINTED CMU	GYPSUM PLASTER	NONE	NONE	
F11	CORK CARPET	GYPSUM PLASTER	GYPSUM PLASTER	NONE	NONE	
F12	VINYL ASBESTOS	PAINTED CMU	ACoust. TILE	4" RUBBER	NONE	GYPSUM PLASTER CLG @ LOOKOUT

**11A** DETAIL - PILASTER @ EAST ENTRANCE  
SCALE: 1/2" = 1'-0"

**VALAND, BENZING & ASSOC.**  
ARCHITECTS  
RALEIGH, NORTH CAROLINA

**DEPARTMENT OF THE NAVY**  
NAVAL FACILITIES ENGINEERING COMMAND  
ATLANTIC DIVISION  
NORFOLK, VIRGINIA

NAVAL STATION  
MARINE CORPS BASE  
CAMP LEJEUNE, N.C.

**BASE POST OFFICE**

**FLOOR PLAN** ARCHITECTURAL

NAVAC DRAWING NO. **1337952**

CONSTR. CONTR. NO. N62470-70-B-0808

SHEET **4** OF **26**

FILED **83952**

