


scale EATON PAR	K, FLO	RIDA			TL-751	
checked P. O. DR	AWER M			drawing r		
drawn by R Cutter - Fee	dera	ul, In	ıc.	10010110		
The second secon			- Contrac	revisions		
title LINEN 24" Ø TRASH CHUTE (3 FLRS) architect	project 205 BED HOSPITAL NAVAL REGIONAL MEDICAL CENTER MARINE CORP. BASE CAMP LEJEUNE, N.C. general contractor					
	РНО	ONE NUMBER			· · · · · · · · · · · · · · · · · · ·	
FOR OFFICER IN CHARGE OF CONSTRUCTION		RINTENDENT	SNAME 6	78		
	INFO	DETTER SE		ASE PROVID	ACK FOLLOWING	
ANSPERIORS & COCREMATION OF DATE 4/15/80					MAR 2 1 1980	
ROMES A MARIE BE RE-					Lockwood Greene Engineers, Inc.	
PROVIDE THE CON-	*	No. 4	finish p	er As	FILE IV	
THE TO THE HE SEATON OF HES2470-77-C-75		All exposed stainless steel to have				
PROVED AS NOVES	[9]					
AVAL FACILITIES ENGINEERING COMMAND NORFOLK, VIRGINIA 23511		Chute	to have at all floo	or supports is	solator type:	
ATLANTIC DIVISION	Chute to have sound deadening type:					
		Allow	ing the opening	of no more	rovided by Cutler-Federal, Inc. than one door at a time with ectrical connections by others.	
	8				rovided by CUTLER-FEDERAL, designated on drawings.	
bythis contractor	Pass Thru door(s) Wide x high, hinge, self-closing, stainless steel door and frame assembly, bearing Underwriters' Laboratories, Inc., 1½ Hr (B) Temp. rise 30 min. under 250° f. label, for masonry opening, installed by others.					
Access dear to be fornished by this					His high, side hinged for plinder lock FUL B Label e x high,	
	6	steel a	to attach to struingles.	ctural frame	pach 3" x 2" clips welded to fabricated of 11/2" x 11/2" x1/8"	
		floors	d above top intak , ready for plumbi	ing connection		

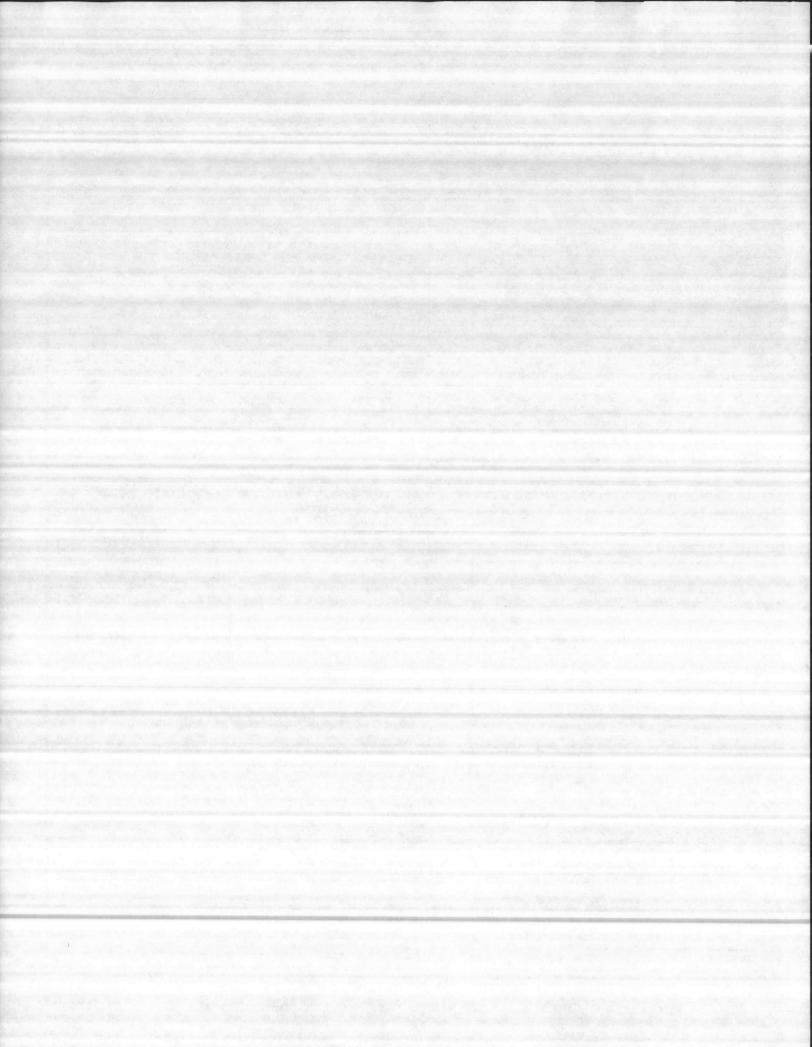


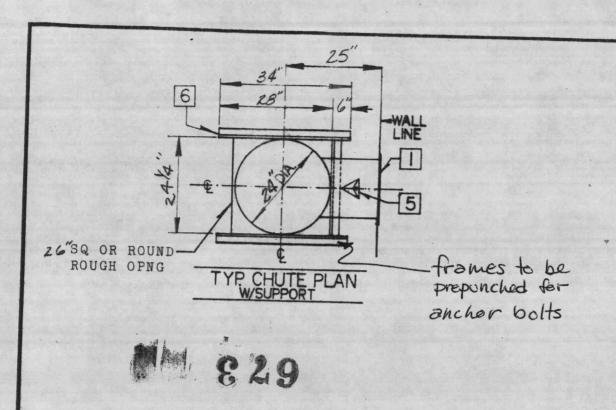



marked in this incorporated into the contract draw the allocated spacetory.

Authorized Reviews Signature CQC Rep

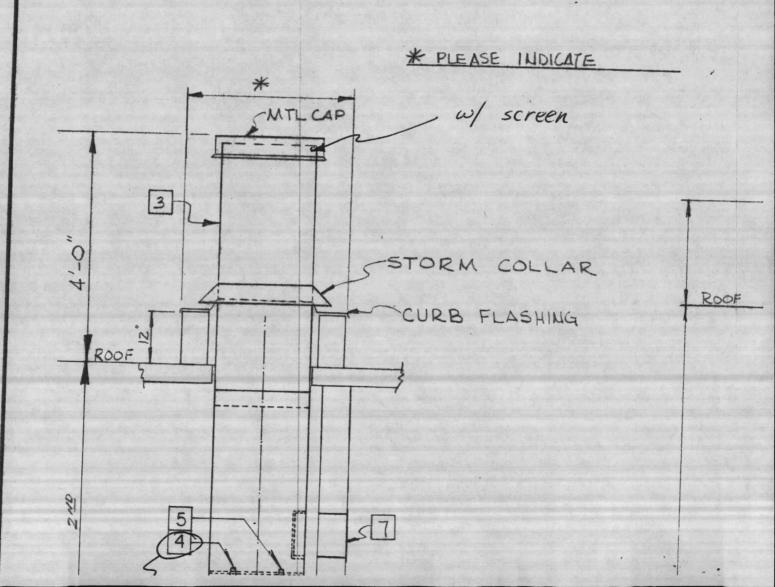

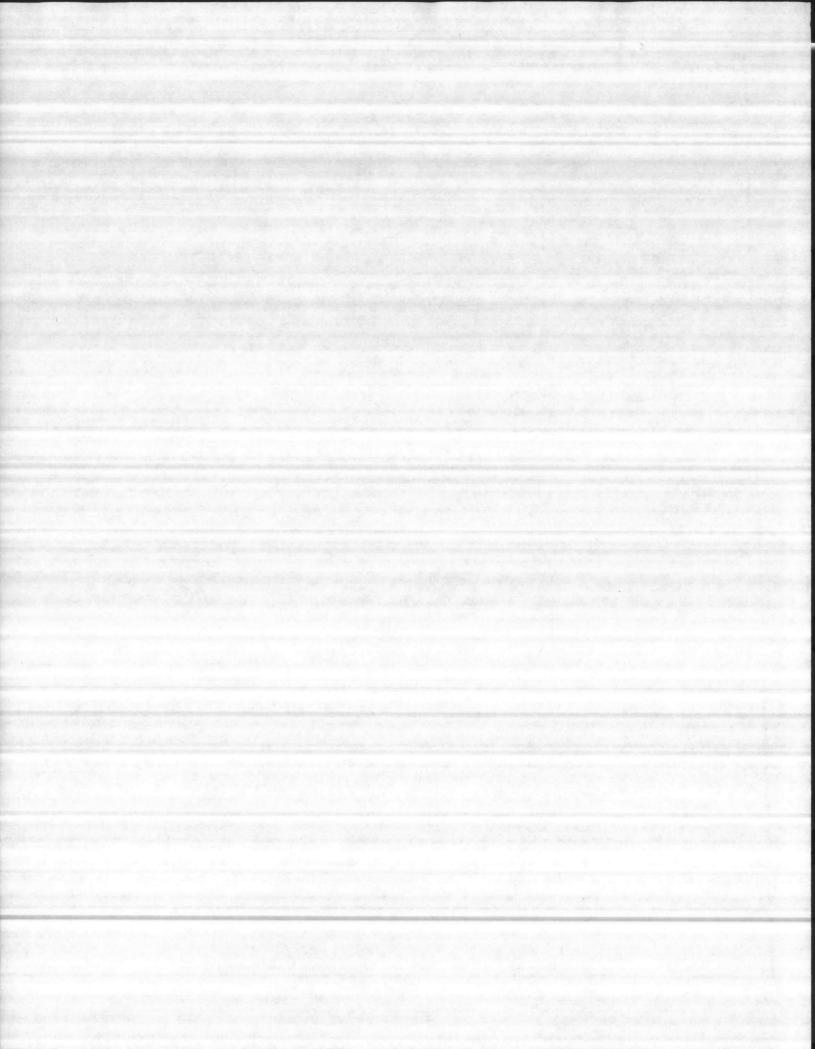

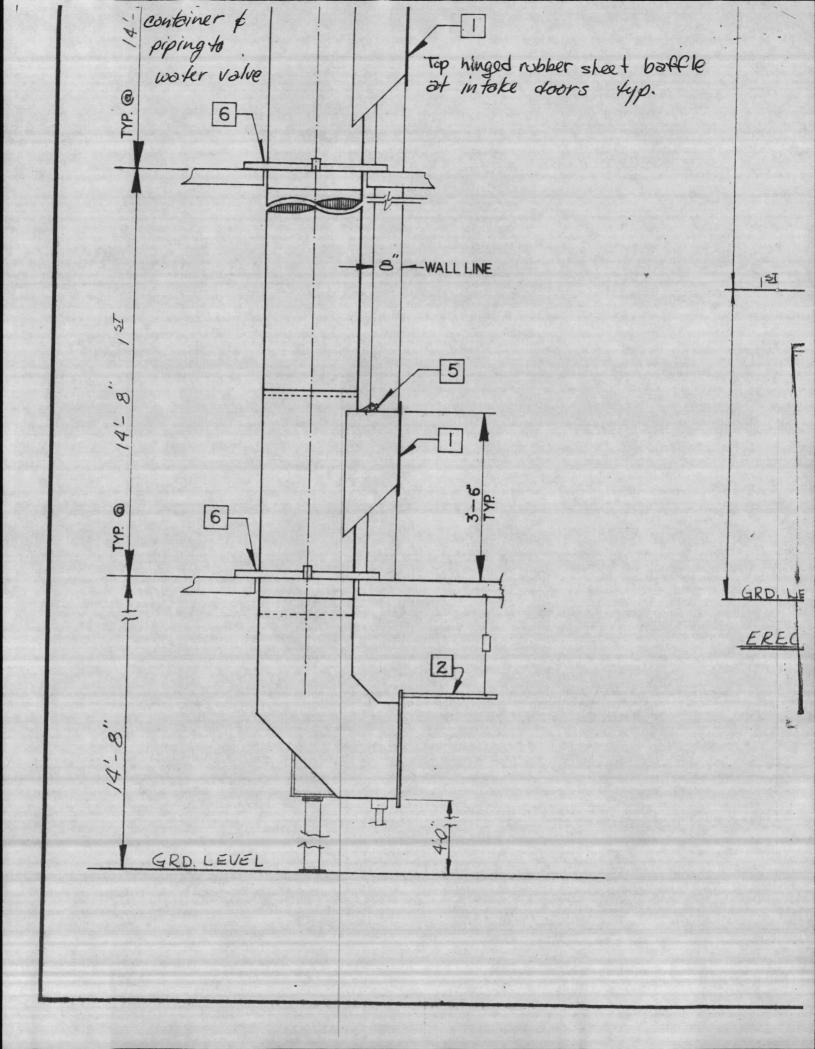

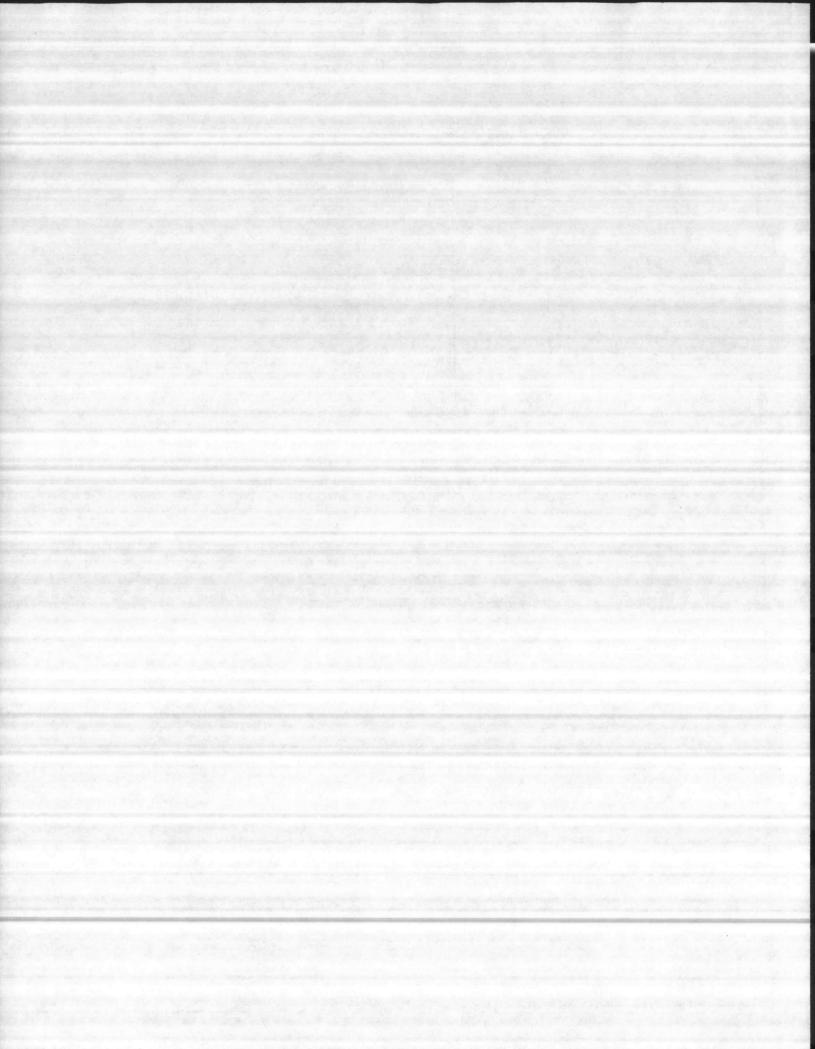

ed that the (material) (equipment) shown and sittal is that approved/proposed to be ract Number, is in compliance with and specifications, and can be installed in and is (approved for use) (submitted for	NOTE: LABELED DOORS CANNOT BE ALTERED TO ACCOMMODATE NON-STANDARD LOCKS WITHOUT
ARDINAL CONTRACTING CO. Date 11/20/19 LUJHDate 3/18/80."	GENERAL NOTES: All chutes to have Cutler Federal type vertical lockseams and inside lap joints. PARTITIONS AROUND CHUTES TO BE ERECTED AFTER CHUTES ARE INSTALLED. All floor openings and all items
cylinder locks to I be keydd w/ master beying system	of general cutting, patching and repairing provided by others. Miscellaneous steel to have shop coat of aluminum paint. Chute sections to be shop assembled. Chute to be fabricated of Column Colu
hopper to have 2 reinforced bottom sloped to 2" drain	DISCHARGE, CUTLER FEDERAL TYPE 'G' SLIDING 12 gauge, spring loaded with 165° fusible safety link closure assembly. DISCHARGE, CUTLER-FEDERAL HOPPER TYPE "H" 20 Wide x 30 high, TOP hinged, self closing stainless steel door and frame assembly, bearing Underwriters' Laboratories, Inc., 1½ Hr. (B) Temp. rise 30 min. under 250° F. label, with 165° fusible safety link closure assembly.
bottom sloped to 2" drain	VENT: Top cap with diameter vent extension, flange and roof jack, flushing and sprinkler heads ready for plumbing connections by others. VENT: Full 24 diameter with MTL flashing and storm collar.
4	34" I P.S. flushing spray head located above top intake ready for plumbing connection by others.

Automatic 165° fusible linked sprinkler heads located above top

intake and at NO OTHER FLE, floors, ready for plumbing connection by others.

