

ATLANTIC DESIGN CO.  
 NAVAL FACILITIES ENGINEERING COMMAND  
 NORFOLK, VIRGINIA 23511

APPROVED \_\_\_\_\_  
 APPROVED AS NOTED \_\_\_\_\_  
 DISAPPROVED \_\_\_\_\_

SUBJECT TO THE REQUIREMENTS OF  
 CONTRACT NO. NA 240-61-C-1766

APPROVAL OF A SUBMITTAL DOES NOT INCLUDE  
 APPROVAL OF ANY DEVIATION FROM THE CON-  
 TRACT REQUIREMENTS UNLESS THE CONTRACTOR  
 CALLS ATTENTION TO AND SUPPORTS THE DEVI-  
 ATION. THE CONTRACTOR SHALL BE RESPONSIBLE  
 FOR PROVIDING PROPER PHYSICAL DIMENSIONS  
 & WEIGHTS, COORDINATION OF TRADES, ETC., AS  
 REQUIRED.

REVIEWER \_\_\_\_\_ DATE \_\_\_\_\_  
 FOR OFFICE IN CHARGE OF CONSTRUCTION

 
"It is hereby certified that the (equipment  
 material) shown and marked in this submittal  
 is that proposed to be incorporated into  
 the contract. It is the contractor's responsibility  
 to ensure that the equipment and material  
 conforms with the Contract drawings and  
 specifications, and is submitted for Government  
 approval."  
 Certified by \_\_\_\_\_  
 Date: 12 Oct 83

DATE	7.7.83
CHECKED	DATE
APPROVED	DATE
PRINTS ISSUED FOR	DATE
ORIG. SUBMITTAL	DATE
REVISION	DATE
PRODUCTION	DATE
APPROVAL	DATE
ERECTION	DATE
REF. FIELD USE	DATE
NO.	NO.
REVISION	DATE
BY	DATE


PROJECT  
**Public Works Bldg**  
**CAMP PHELPS, NC**

ARCHITECT  
**CHIVERS GLASS, INC.**

DETAILS: FULL SCALE  
 SHEET NO. 2 OF 3



47-23120

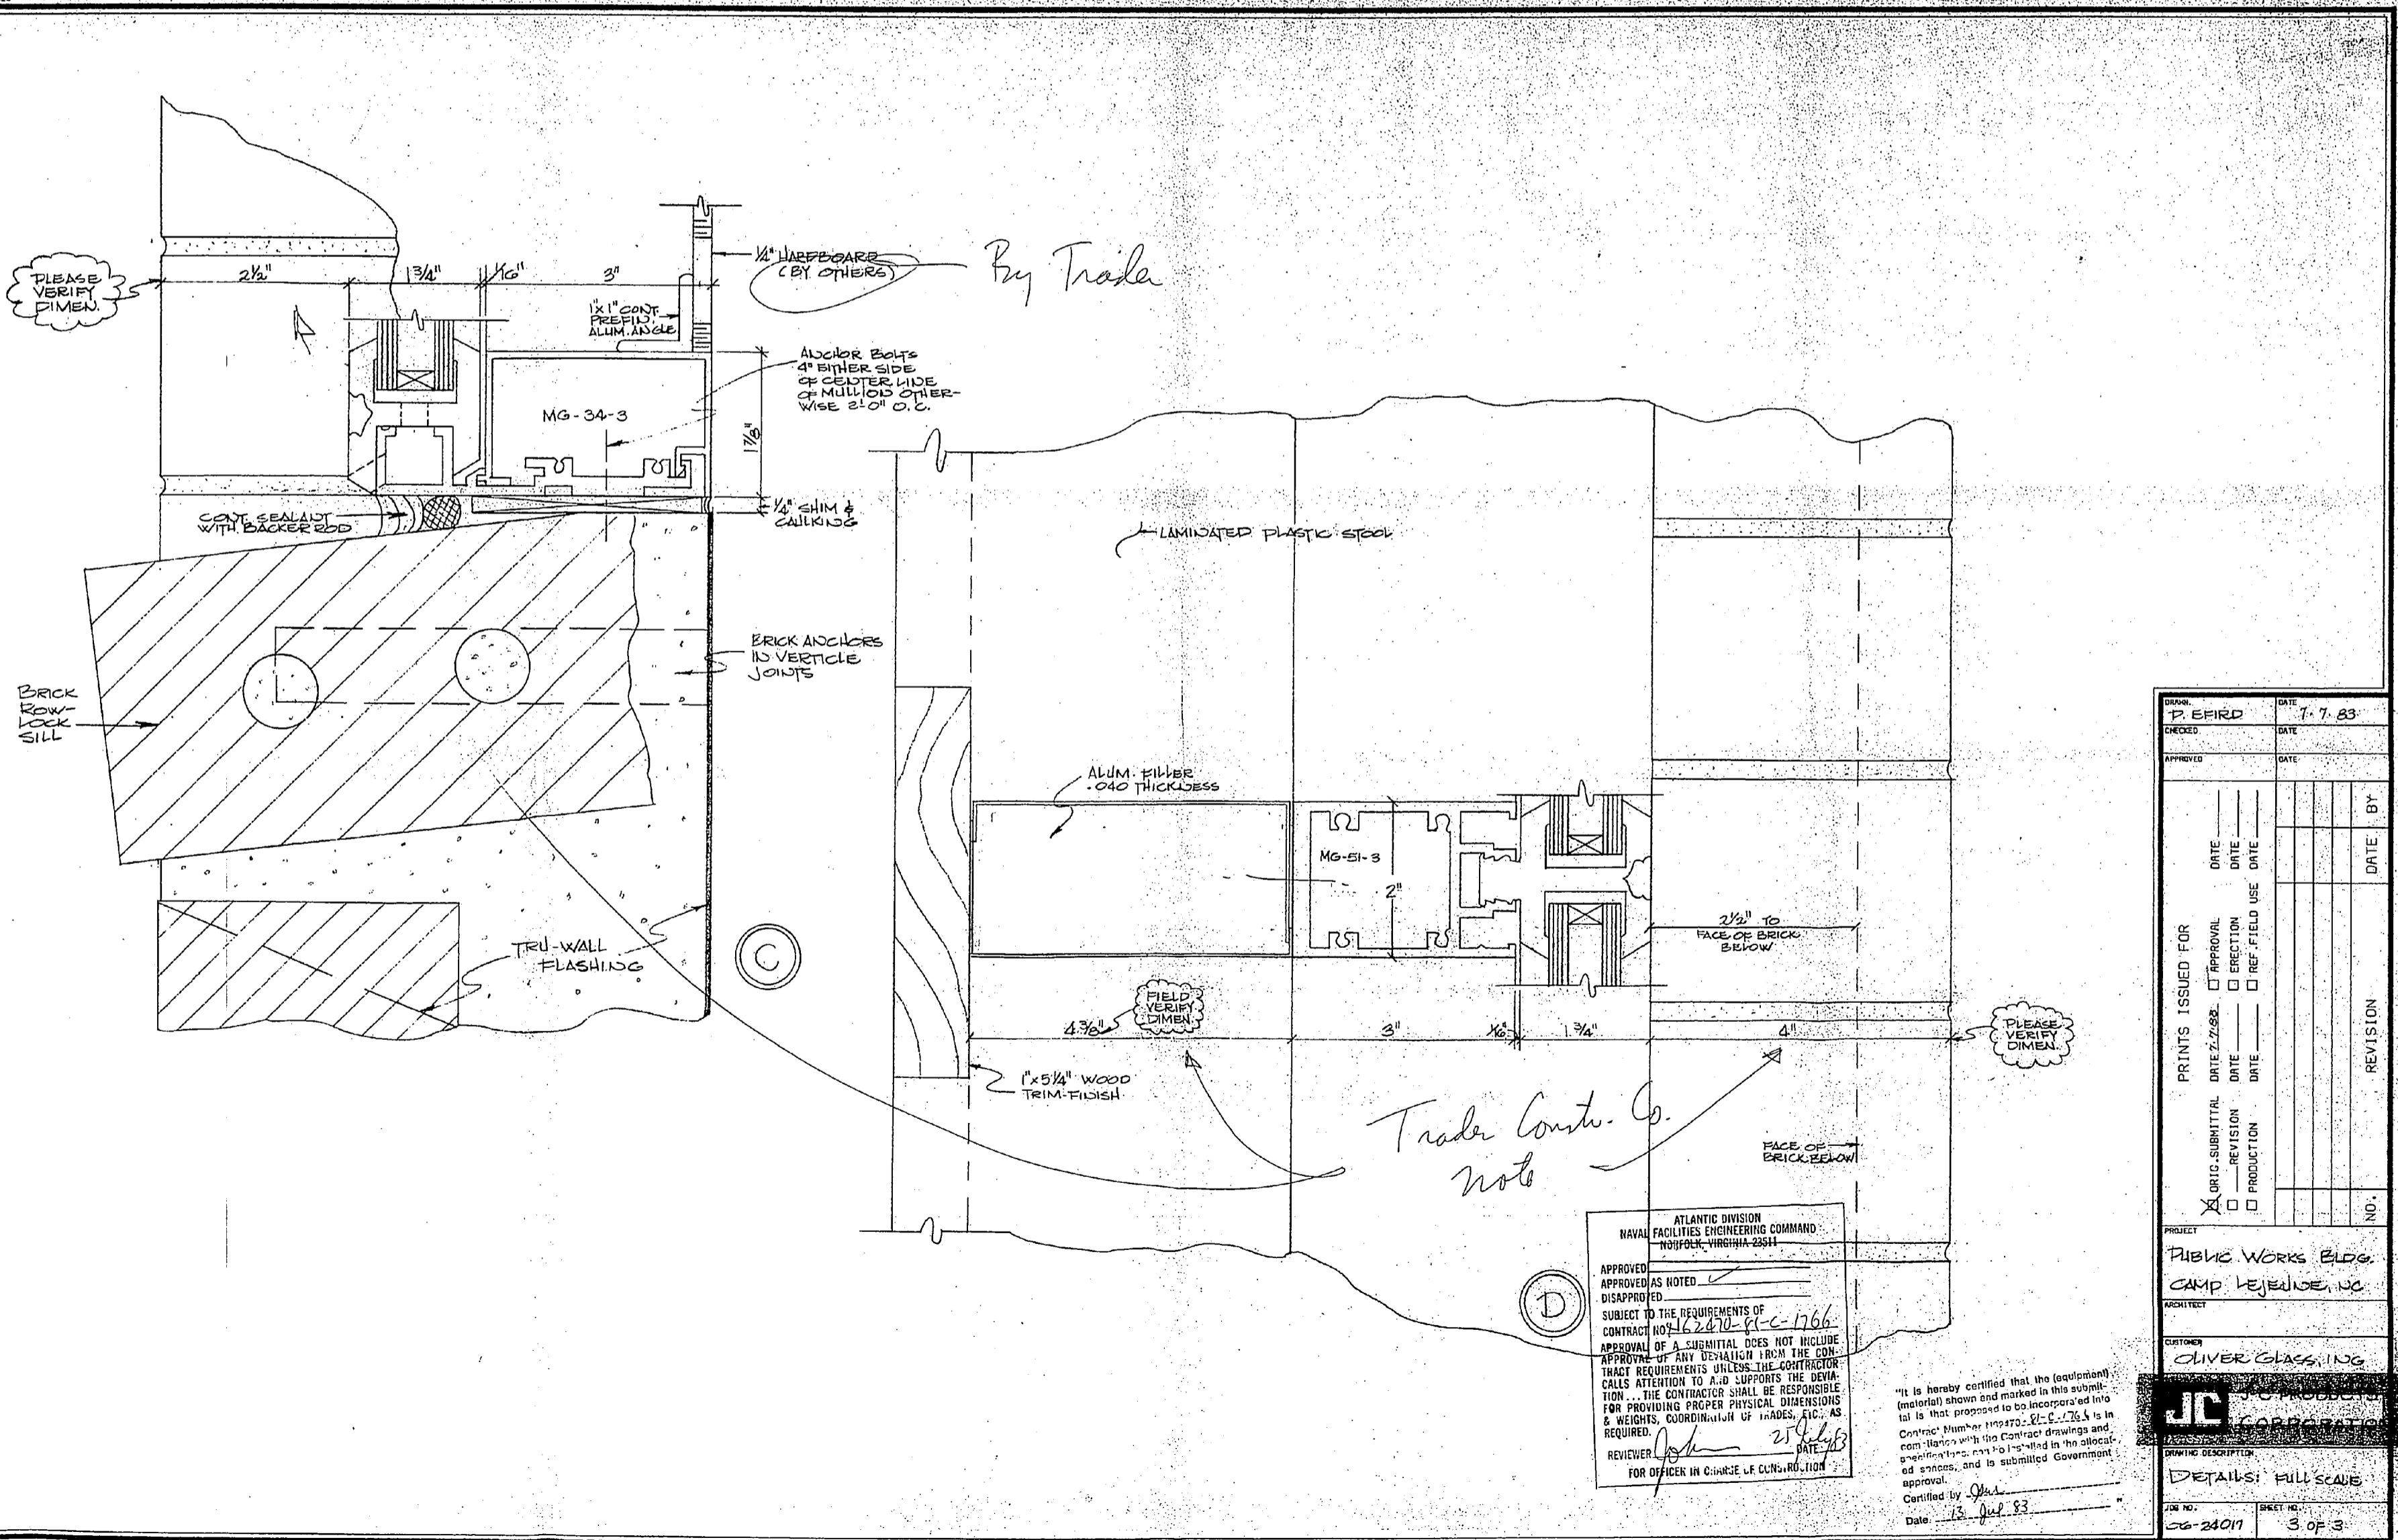

ATLANTIC DIVISION  
NAVAL FACILITIES ENGINEERING COMMAND  
NOFAC-VA VIRGINIA 23541

APPROVED: [Signature]  
DISAPPROVED: [Signature]

SUBJECT TO THE REQUIREMENTS OF CONTRACT NO. 162470-91-C-1766

APPROVAL OF A SUBMITTAL DOES NOT INCLUDE APPROVAL OF ANY DEVIATION FROM THE CONTRACT REQUIREMENTS UNLESS THE CONTRACTOR CALLS ATTENTION TO A.D. SUPPORTS THE CONTRACTOR'S RESPONSIBILITY FOR PROVIDING PROPER PHYSICAL DIMENSIONS & WEIGHTS, COORDINATION OF TRADES, ETC. AS REQUIRED.

REVIEWER: [Signature] DATE: 2/1/83

FOR OFFICER IN CHARGE OF CONSTRUCTION

"It is hereby certified that the (specimens) (materials) shown and marked in this submittal is in accordance with the contract drawings and specifications and is to be used in the proposed work, and is submitted Government approval.

Certified by: [Signature]  
Date: 13 Feb 83

DESIGNED	DATE	1-7-83
APPROVED	DATE	
PRINTS ISSUED FOR	DATE	BY
ORIG. SUBMITTAL	DATE	
REVISION	DATE	
PRODUCTION	DATE	
NO.	REVISION	DATE

PROJECT: PUBLIC WORKS BLDG. CAMP LEJEUNE, NC

ARCHITECT: COVER CLASSING

DATE: 1-7-83

DETAILS: FULL SCALE

SHEET NO.: 3 OF 3

