




FIRST FLOOR PLAN
1/2" = 1'-0"

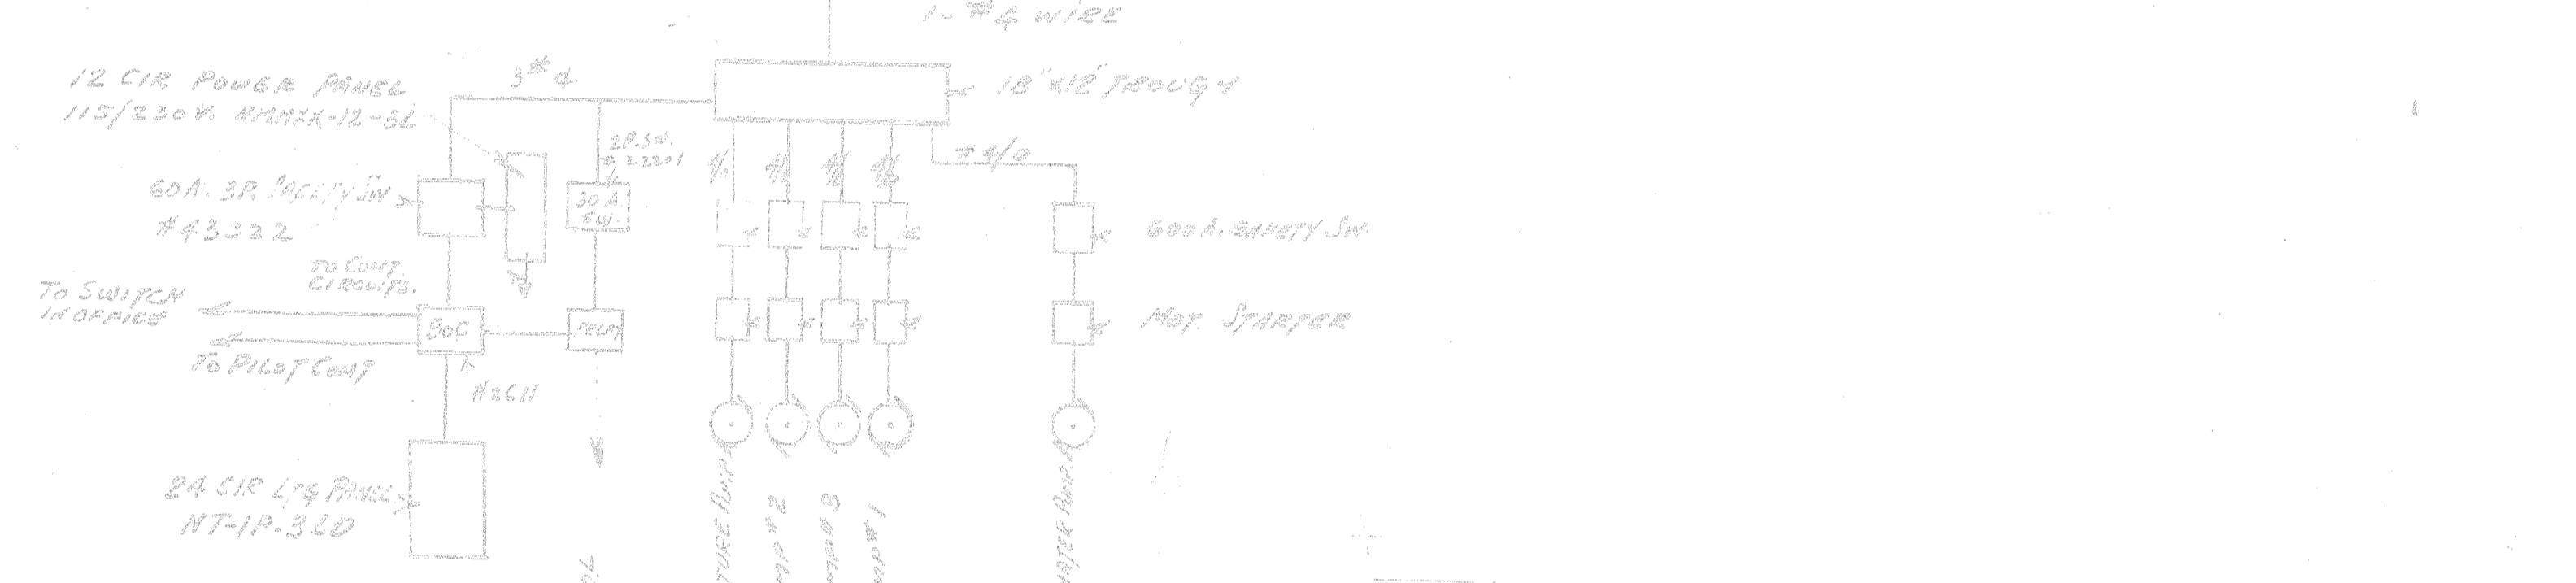

SCHEME OF CONNECTIONS

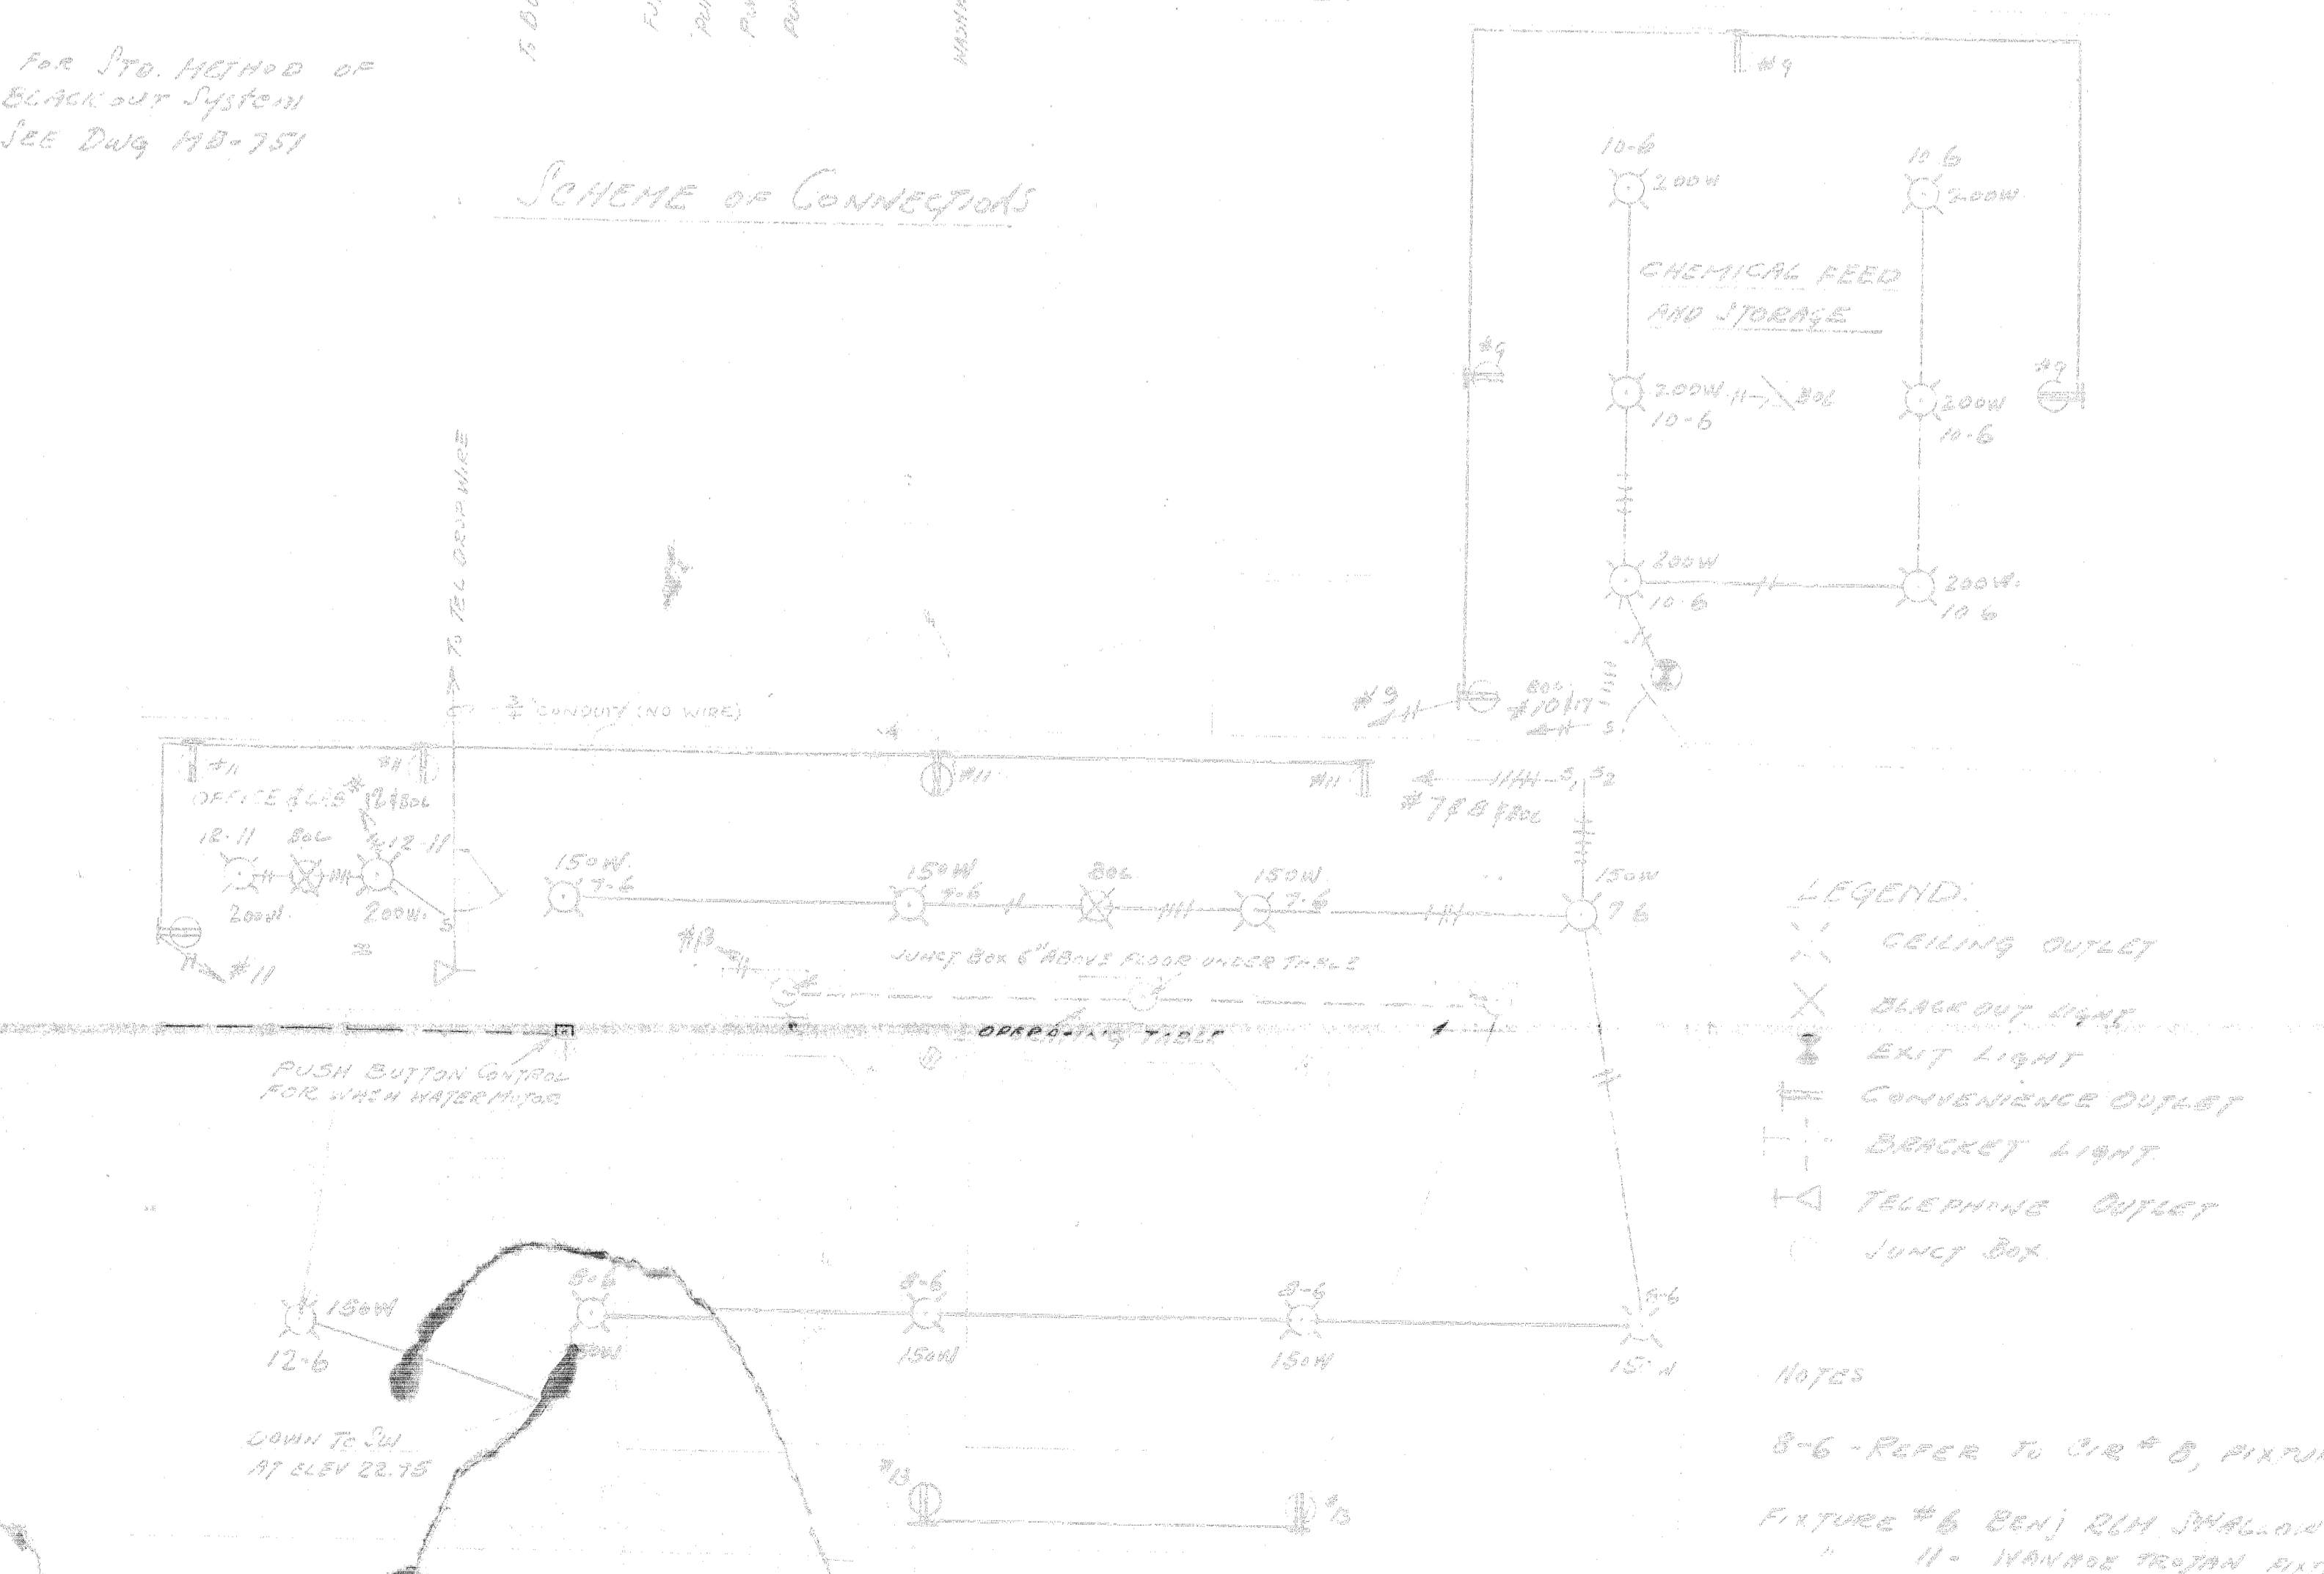

SECOND FLOOR PLAN
1/2" = 1'-0"

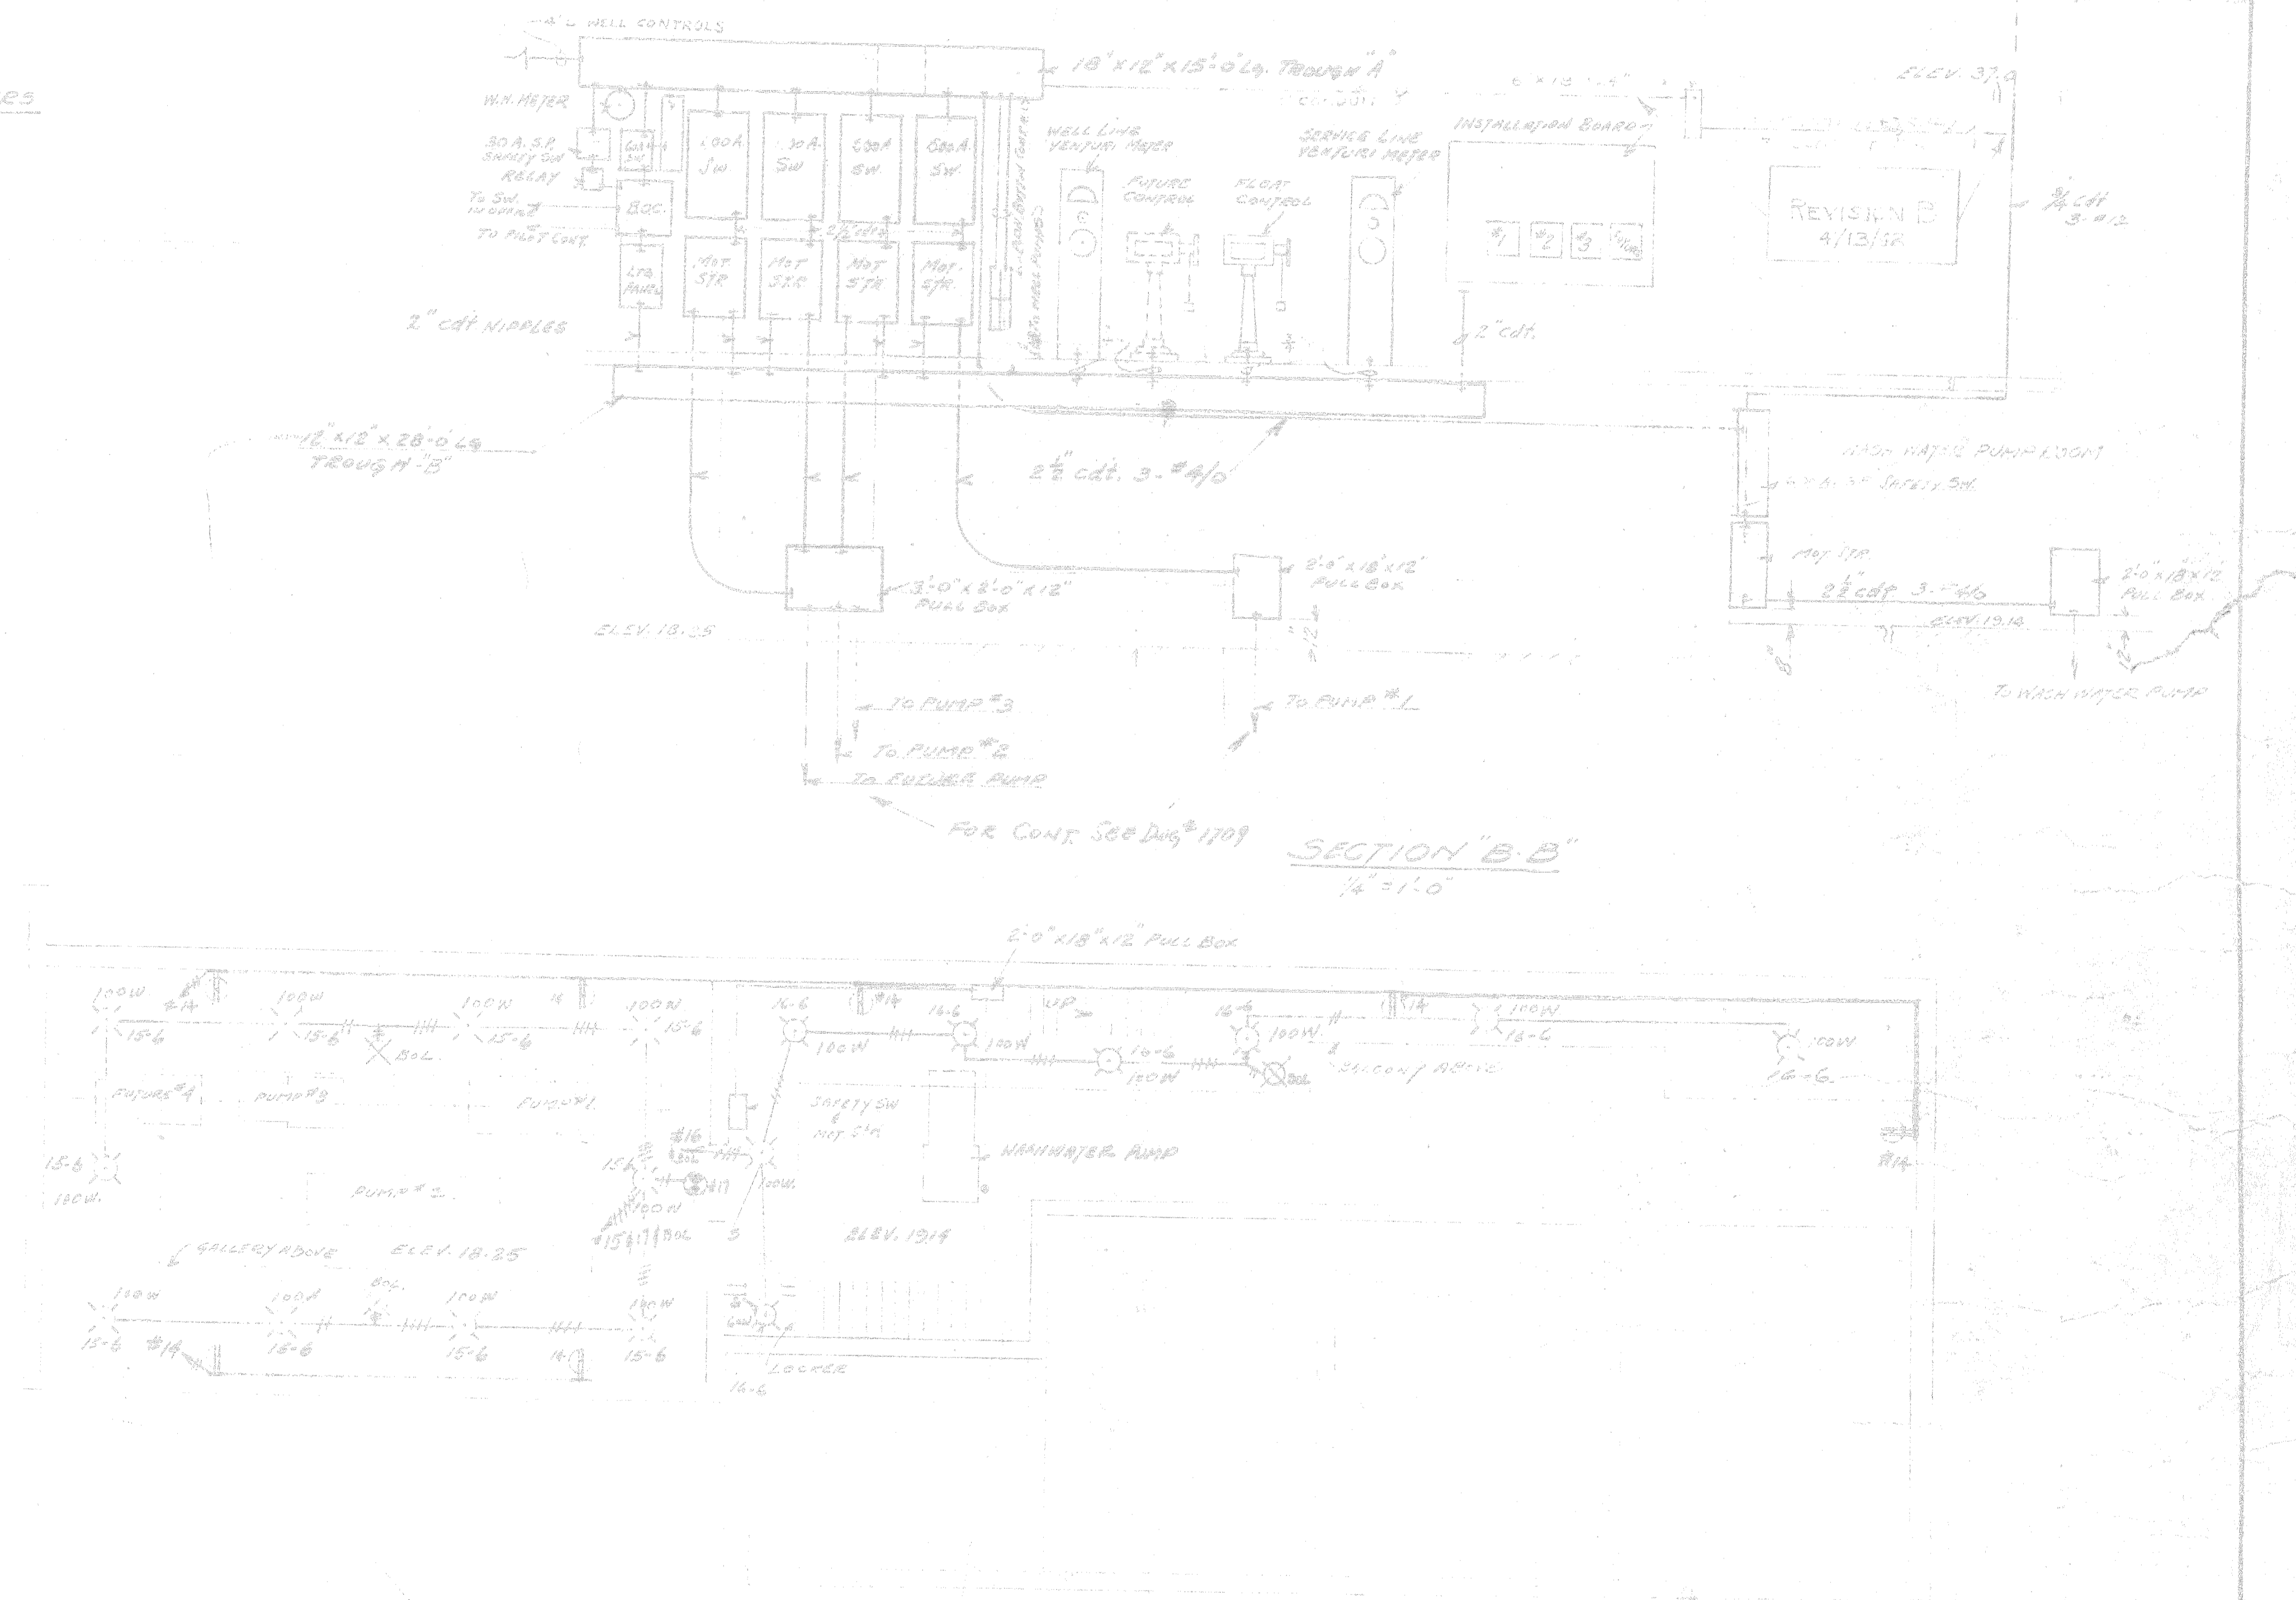

PLAN OF PUMP ROOM
1/2" = 1'-0"

- LEGEND:
- CEILING OUTLET
 - ✕ BRICK OUT GATE
 - EXIT LIGHT
 - ▭ CONVENIENCE OUTLET
 - ▭ BRACKET LIGHT
 - △ TELEPHONE OUTLET
 - JUMP BOX

- NOTES:
- 8-6 REFER TO 3R^d FLOOR, FIXTURE # 6
 - FIXTURE # 6 BENCH REM. SHALL BE DONE - ROW # 2123
 - 11 - HANGING TRAYON FIXTURE # 4822
 - 18 - OUTSIDE BRACKET BENCH # 4822
 - 20 - WALL FIXTURE # 1-20, 150W
 - 6 - BENCH SHALLOW DOME - 200W # 4822

DRAWN BY: SA		CARR & J. E. GREINER CO. - ARCHITECT-ENGINEERS DURHAM, N. C.	
CHECKED BY: SA		Baltimore, Md.	
CHIEF ENGINEER: [Signature]		MARINE BARRACKS - NEW RIVER, N. C.	
IN CHARGE: [Signature]		BUREAU OF YARDS AND DOCKS - U. S. NAVY	
DATE: 3-2-42		MAIN PUMPING PLANT	
SCALE: As Shown		ELECTRICAL LAYOUT	
T. & D. DRAWING NO.		APPROVED: [Signature]	
NO. IN CHARGE BY: 502		BY: [Signature]	
REVISION DATE CHIEF		NO. IN CHARGE BY	
1	4/10/42	TO SOFTENING PLANT REROUTER	KCJ/VA STAFF
2	4/13/42	CONFORM REVISED SECTION A-A & B-B	KCJ/VA STAFF
NO. IN CHARGE BY: 502		APPROVED: [Signature]	
NO. IN CHARGE BY: 502		BY: [Signature]	
NO. IN CHARGE BY: 502		BY: [Signature]	

