


Subject TREE LOCATION - WATER TR PLANT DTA

Computed by: WR COOK

Checked by: T.J. DILLON

Date: 11-15-43

20101.53 (F"ST.)			337,586.32	2,495,722.11
72" OAK	.82610	-341.59		
	S 34° 18' E	- 413.5	337,244.73	2,495,955.13
	.56353	+233.02		

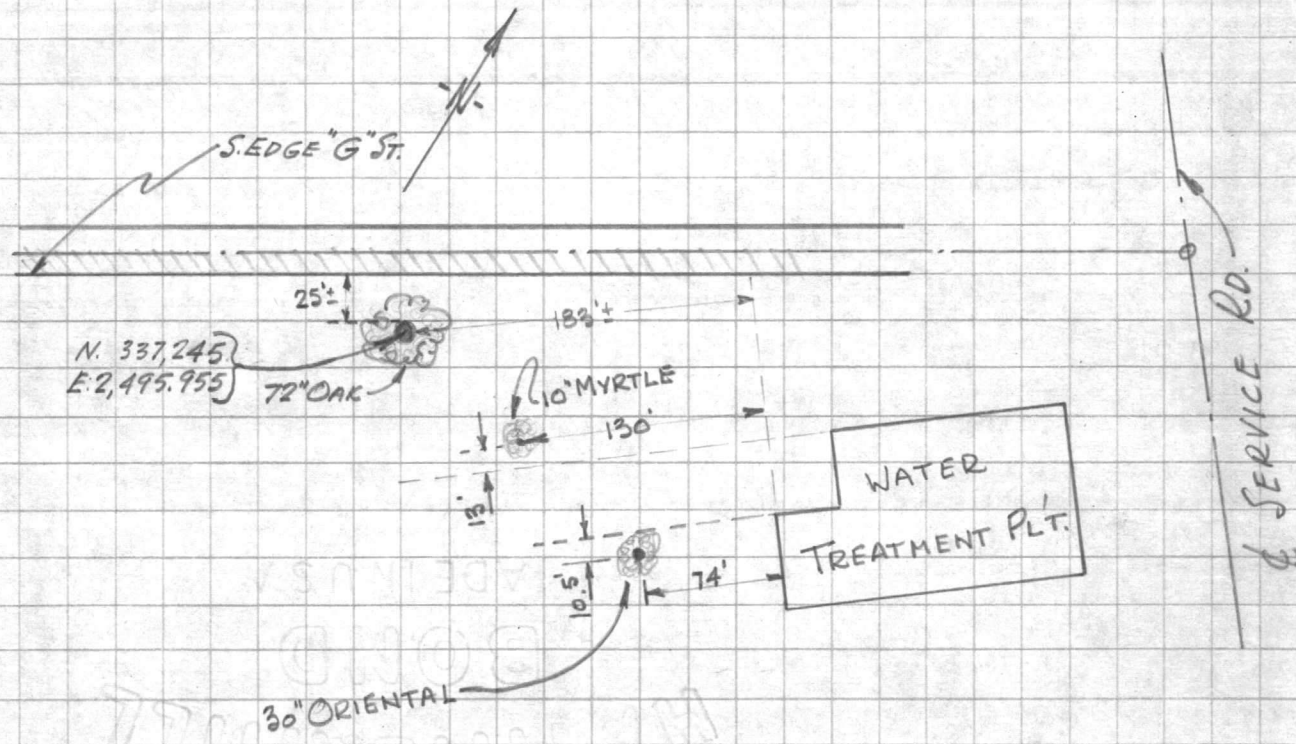

CARR & J. E. GREINER  
ARCHITECTS-ENGINEERS

CAMP LEIBUNE  
NEW RIVER, N. C.

Project No.

The No.

Sheet No.

Date

Checked by

Checked by

INDEXED

BOND

W. W. WESTGOTT