

**VALUABLE**
 RETURN TO  
 CARR & J. E.  
 GREINER CO.  
 JACKSONVILLE,  
 N. C.

 SUBJECT B.M. & Overflow  
Elevations on Elevated Water  
Tanks Reg. Area #1  
 " " #5

## FIELD PARTY

 Wheeler IN CHARGE  
 Sandlin INSTRUMENT  
 W.G.W. NOTES  
 Godwin TAPE READ  
 TAPE OR ROD  
 INSTRUMENT NO.  
 TAPE NO.

## WEATHER

 CLEAR  
 CLOUDY  
 WINDY  
 RAIN  
 FAIR  
 SNOW  
 HOT  
 MODERATE  
 COLD  
 FOG  
 FIGURED BY  
 NOTES CHECKED BY  
 PLOTTED BY

FILE No. \_\_\_\_\_

FLDR. No. 160-Gen.SHEET 1 of 1DATE 10-8 1942

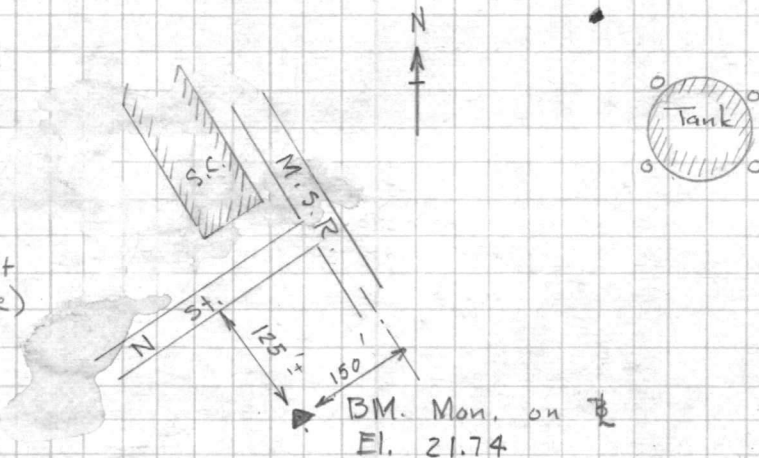
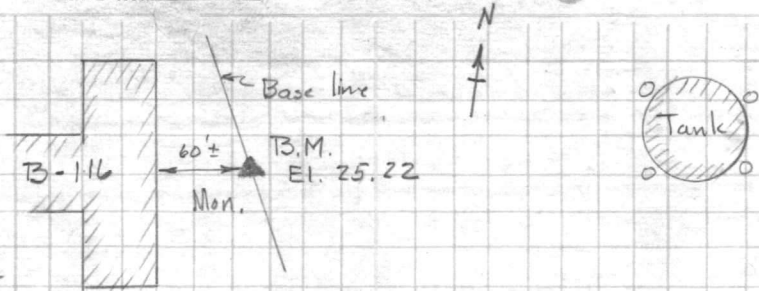
STATION	DIST.	ANGLE " ' "	+ H. I.	- VER. ANG. DIFF.	ELEVATION
Water Tank Reg. Area #1					
B.M. Mon.	486		30.08		25.22
T.P.	4.89		30.17	4.80	25.28
B.M.			1.37		28.80 Anchor Bolt
T.P.	4.43		29.76	4.84	25.33 (See Note)
B.M.			4.54		25.22 Monument

161.5' - J.W.S. 9/22/42

 Overflow elev. on Water Tanks in Areas 2-5 & Supply Areas  
 are 161.5 - J.W.S. 9/22/42

Water Tank Reg. Area #5

B.M. Mon.	4.38		26.12		21.74
T.P.	8.34		31.49	3.01	23.11
B.M.			2.60		28.85 (See Note)
T.P.	1.68		25.59	7.54	23.91
			3.855		21.735

 MUMFORD POINT  
 TOWER  
 OVERFLOW  
 EL. - 109.3


Note: Establish B.M. on north most pier of both towers. North anchor bolt.

Establish elevation of overflow pipe with chain.

Record Mapping  
160-Gen.