

VALUABLE

RETURN TO
CARR & J. E.
GREINER CO.
JACKSONVILLE,
N. C.

SUBJECT Electrical Distribution
Water Tank Area #5
Water Gunning Bldg Area #4
Division Headquarters Area #3


FIELD PARTY
Dillon IN CHARGE
INSTRUMENT
NOTES
TAPE READ
TAPE OR ROD
TAPE OR ROD
INSTRUMENT NO.
TAPE NO.

WEATHER
CLEAR
CLOUDY
WINDY
RAIN
FAIR
SNOW
HOT
MODERATE
COLD
FOG
FIGURED BY _____
NOTES CHECKED BY _____
PLOTTED BY _____

FILE No. 160
FLDR. No. _____
SHEET # 1 of 1
DATE 11/16 19 92

Plotted S. P. Wick

STATION	DIST.	ANGLE		H. I.	VER. ANG. DIFF.	ELEVATION
		°	'"			

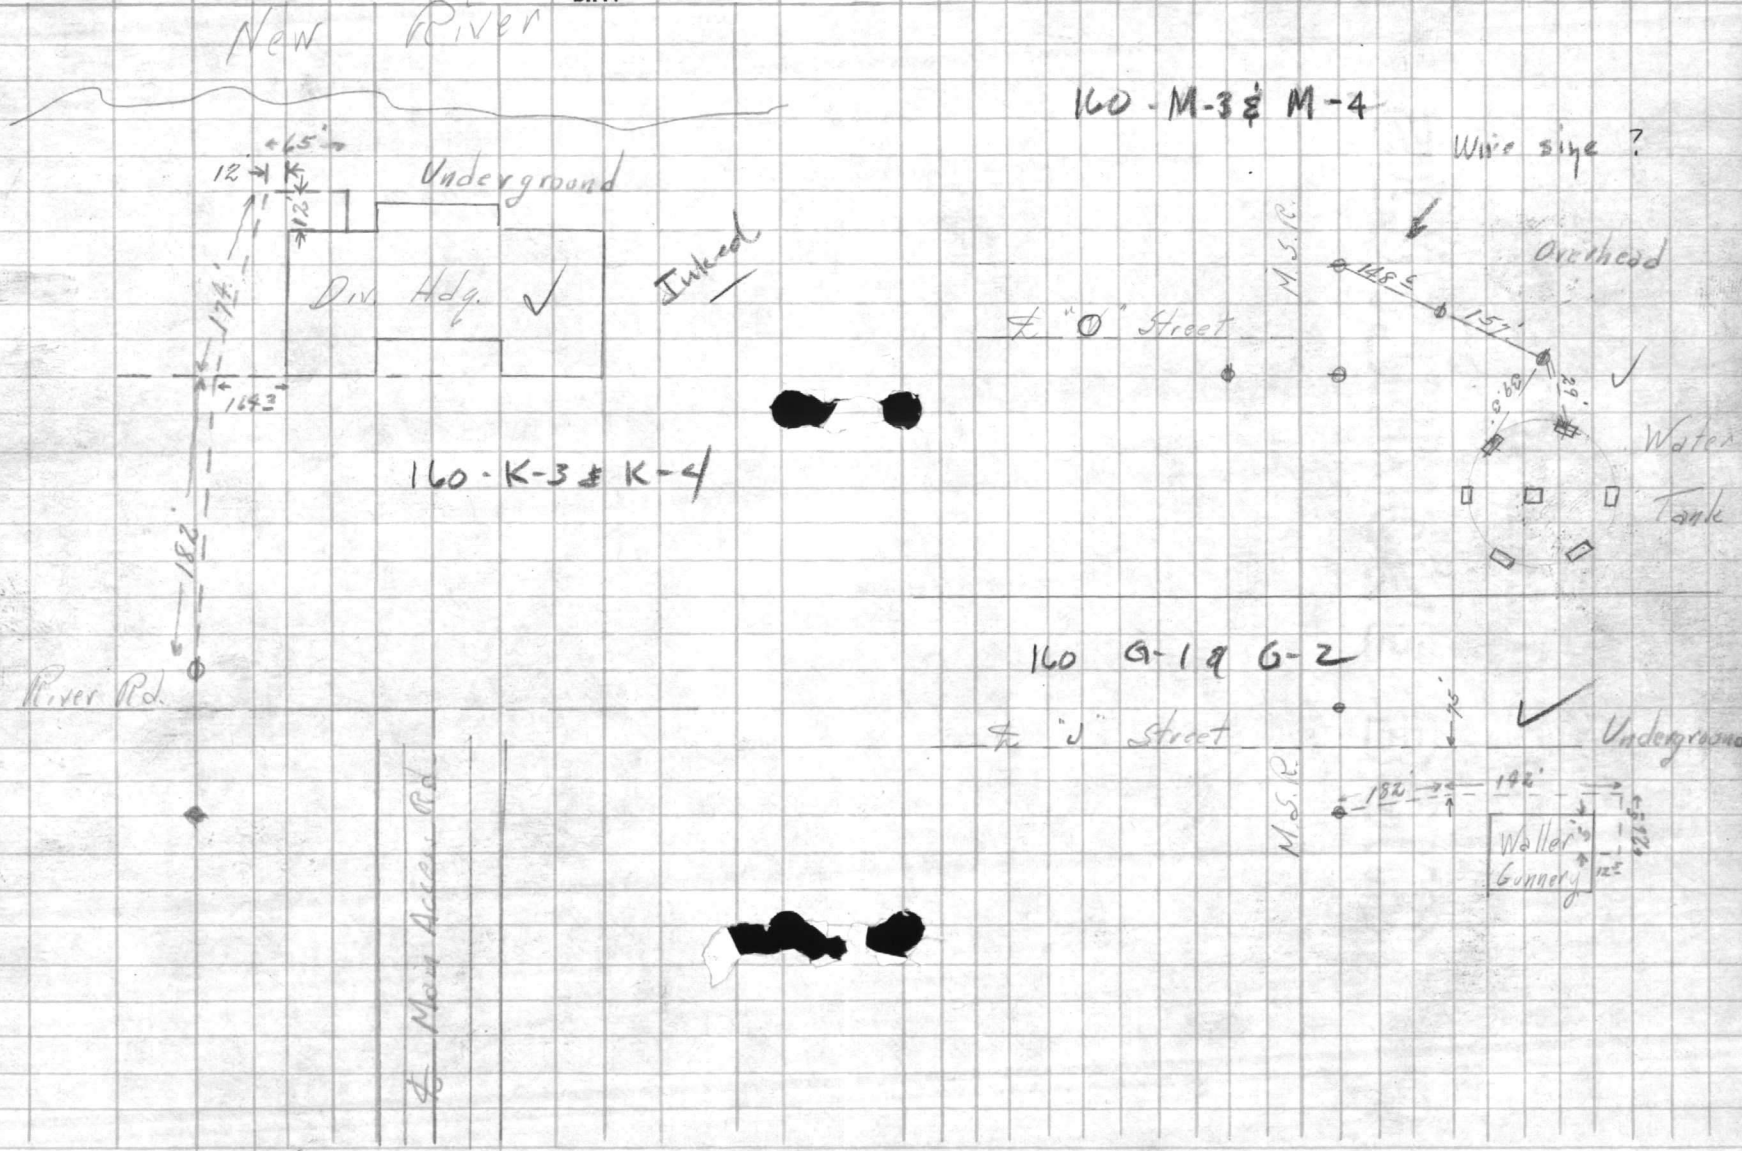

VALIANT

SUBJECT

STATION
DATE
OFFICER
SERIAL

209

Plotted T.P.W.
12/20/42

RECORDED
INDEXED
DEC 21 1942