

VALUABLE

RETURN TO
PUBLIC WORKS
OFFICE
CAMP LEJEUNE
NORTH CAROLINA

SUBJECT Alignment notes for proposed
Water line to new well site on
~~Robinson Road~~
Lyman Road

FIELD PARTY
Horton IN CHARGE
INSTRUMENT _____
NOTES _____
TAPE READ _____
TAPE OR ROD _____
TAPE OR ROD _____
STRUMENT NO. _____
TAPE NO. _____

WEATHER
CLEAR _____ SNOW _____
CLOUDY _____ HOT _____
WINDY _____ MODERATE _____
RAIN _____ COLD _____
FAIR _____ FOG _____
FIGURED BY _____
NOTES CHECKED BY _____
PLOTTED BY _____

FILE No. 160 E
FLDR. No. _____
SHEET 1 of 2
DATE 1-21-1953

Quad. No. _____

STATION	DIST.	ANGLE ° ' "	+	H. I. BEARING	VER: ANG. DIFF.	ELEVATION
---------	-------	----------------	---	------------------	--------------------	-----------


$$\frac{1040'}{12}$$

$$12^\circ 45' = 20'$$

$$40'$$

Δ 40°
 D 3° 20'
 R 1718.87
 T 625.68
 L 1200'
 $P.C.$ 17+00
 D 7° 40' Per 100'
 L 1200'
 END WATER LINE 29+00

$P.I. 20+00$ 1. $197^\circ 48' 00''$
 3. $233^\circ 23' 15''$
 Mean $197^\circ 47' 45''$

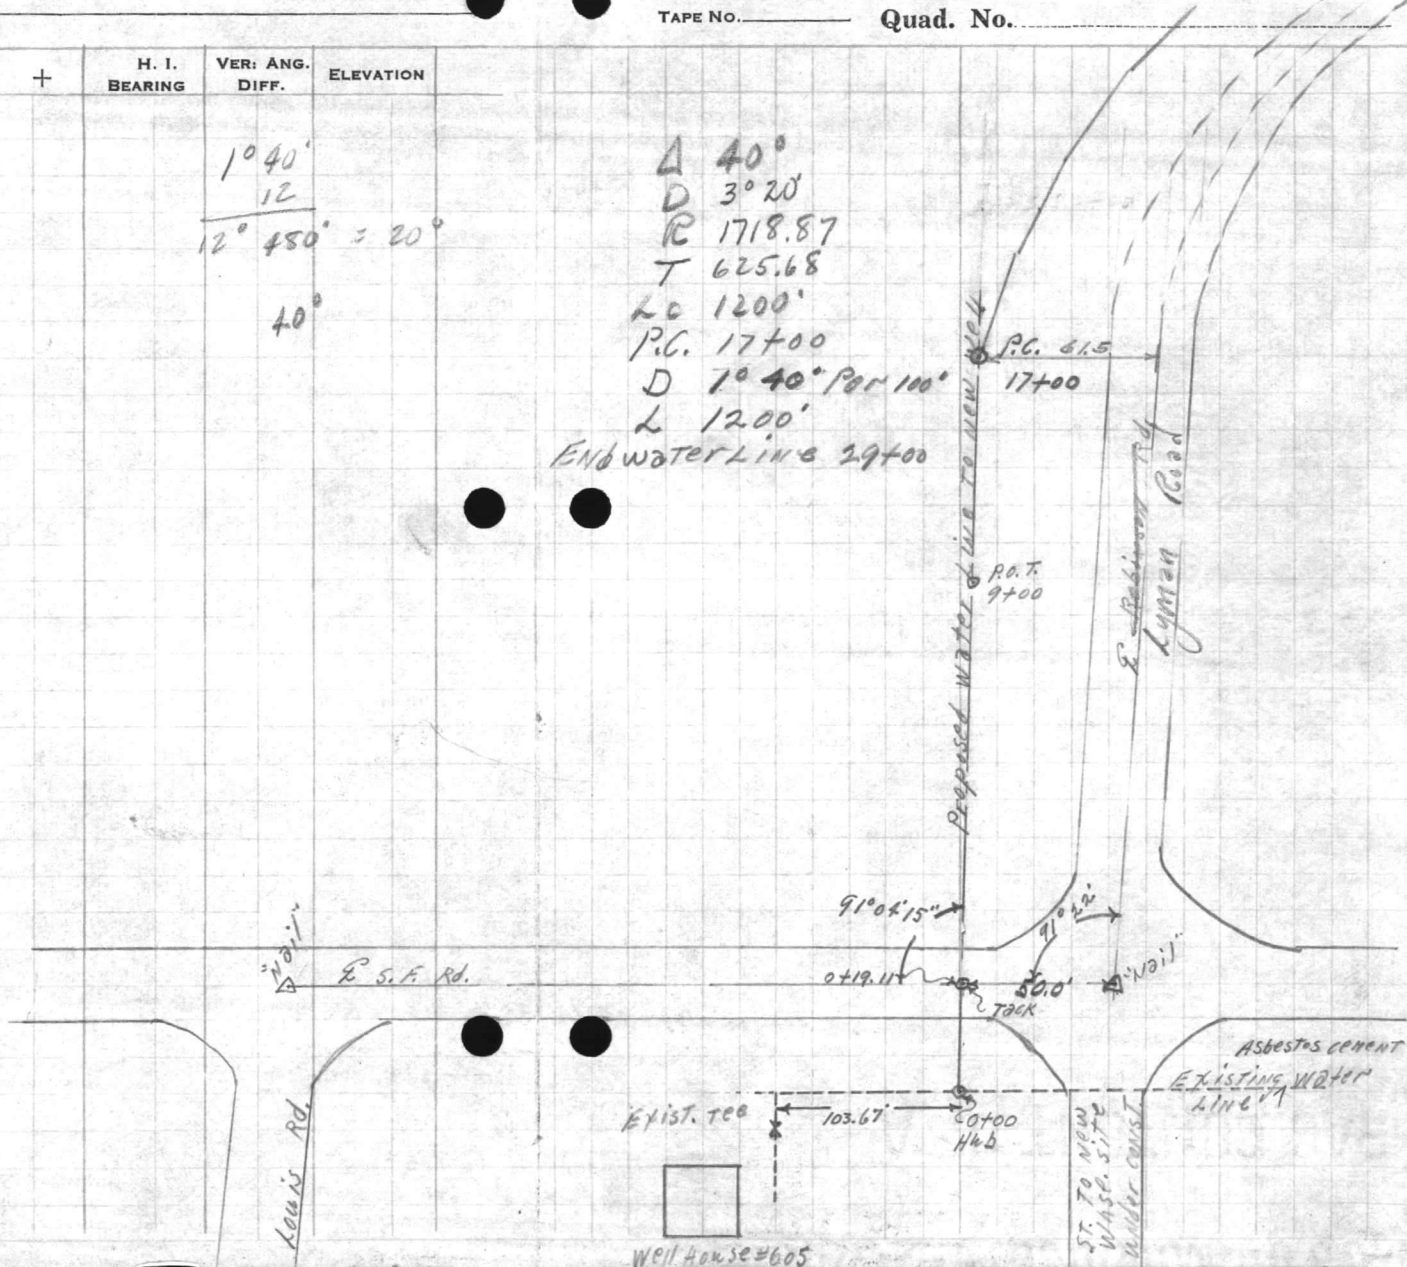

VALENTINE

VALENTINE
HARRIS WOODS
E. RICE
LARRY BISHOP
NORTH CAROLINA

STATION

DATE

PL

SEARCHED

INDEXED

FILED



VALUABLE

SUBJECT ALIGNMENT NOTES for proposed
Water Line contd.

RETURN TO
PUBLIC WORKS
OFFICE
CAMP LEJEUNE
NORTH CAROLINA

FIELD PARTY

IN CHARGE _____
INSTRUMENT _____
NOTES _____
TAPE READ _____
TAPE OR ROD _____
TAPE OR ROD _____

CLEAR
CLOUDY
WINDY
RAIN
FAIR

WEATHER

SNOW
HOT
MODERATE
COLD
FOG

FILE No. _____

FLDR. No. _____

FIGURED BY _____

SHEET 2-0 of 2

NOTES CHECKED BY _____

PLOTTED BY _____


DATE 1-21- 1953

INSTRUMENT NO. _____

TAPE No. _____

Quad. No. _____

STATION	DIST.	ANGLE ° ' "	+	H. I. BEARING	VER. ANG. DIFF.	ELEVATION
P.T. 29+03.74 TO TANGENT Pt.		1-130°24'15" 3-31°13'00" MEAN-130°24'20"				
P.T. 29+00 on water Line P.T. ON ROBINSON RD. 29+03.74		1-248°49'45" 3-26°29'30" MEAN-248°49'50"				
P.C. 17+00 TO 29+00		200°00'00"				

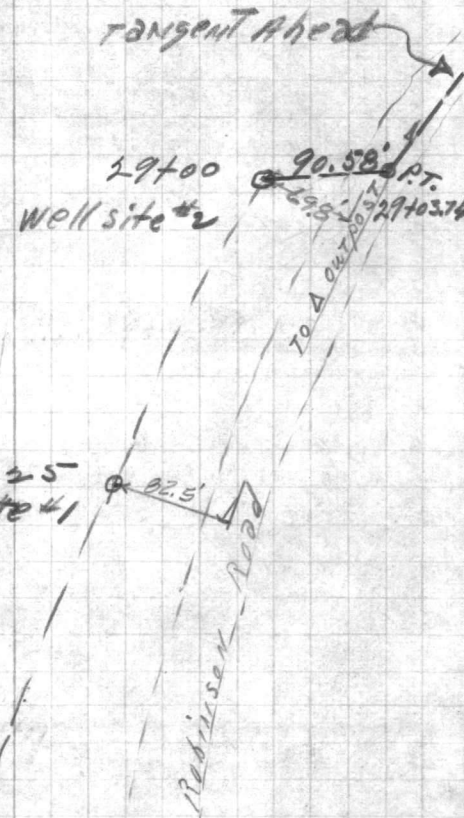

B.M. Elev. 30.98

Nail in power pole on Sneed's Ferry Road. 8
135' N of Duncan St.

3

130-24-15	
<u>3</u>	
391-12-45	3 20
31-13-00	<u>1.90</u>
3) 391-13-00	
130-24-20	

17	0° 00'
18	1° 40'
19	3° 20'
20	5° 00'
21	6° 40'
22	8° 20'

VALUABLE

SUBJECT take out of well House
LYMAN RD.

RETURN TO
PUBLIC WORKS
OFFICE
CAMP LEJEUNE
NORTH CAROLINA


FIELD PARTY
Autrive IN CHARGE
Cherry INSTRUMENT
NOTES
TAPE READ
TAPE OR ROD
TAPE OR ROD
INSTRUMENT NO.
TAPE NO.

WEATHER
CLEAR SNOW
CLOUDY HOT
WINDY MODERATE
RAIN COLD
FAIR FOG
FIGURED BY _____ SHEET 10/1
NOTES CHECKED BY _____
PLOTTED BY _____ DATE 2/1 19 54

FILE No. 160E

FLDR. No. _____

Quad. No. _____

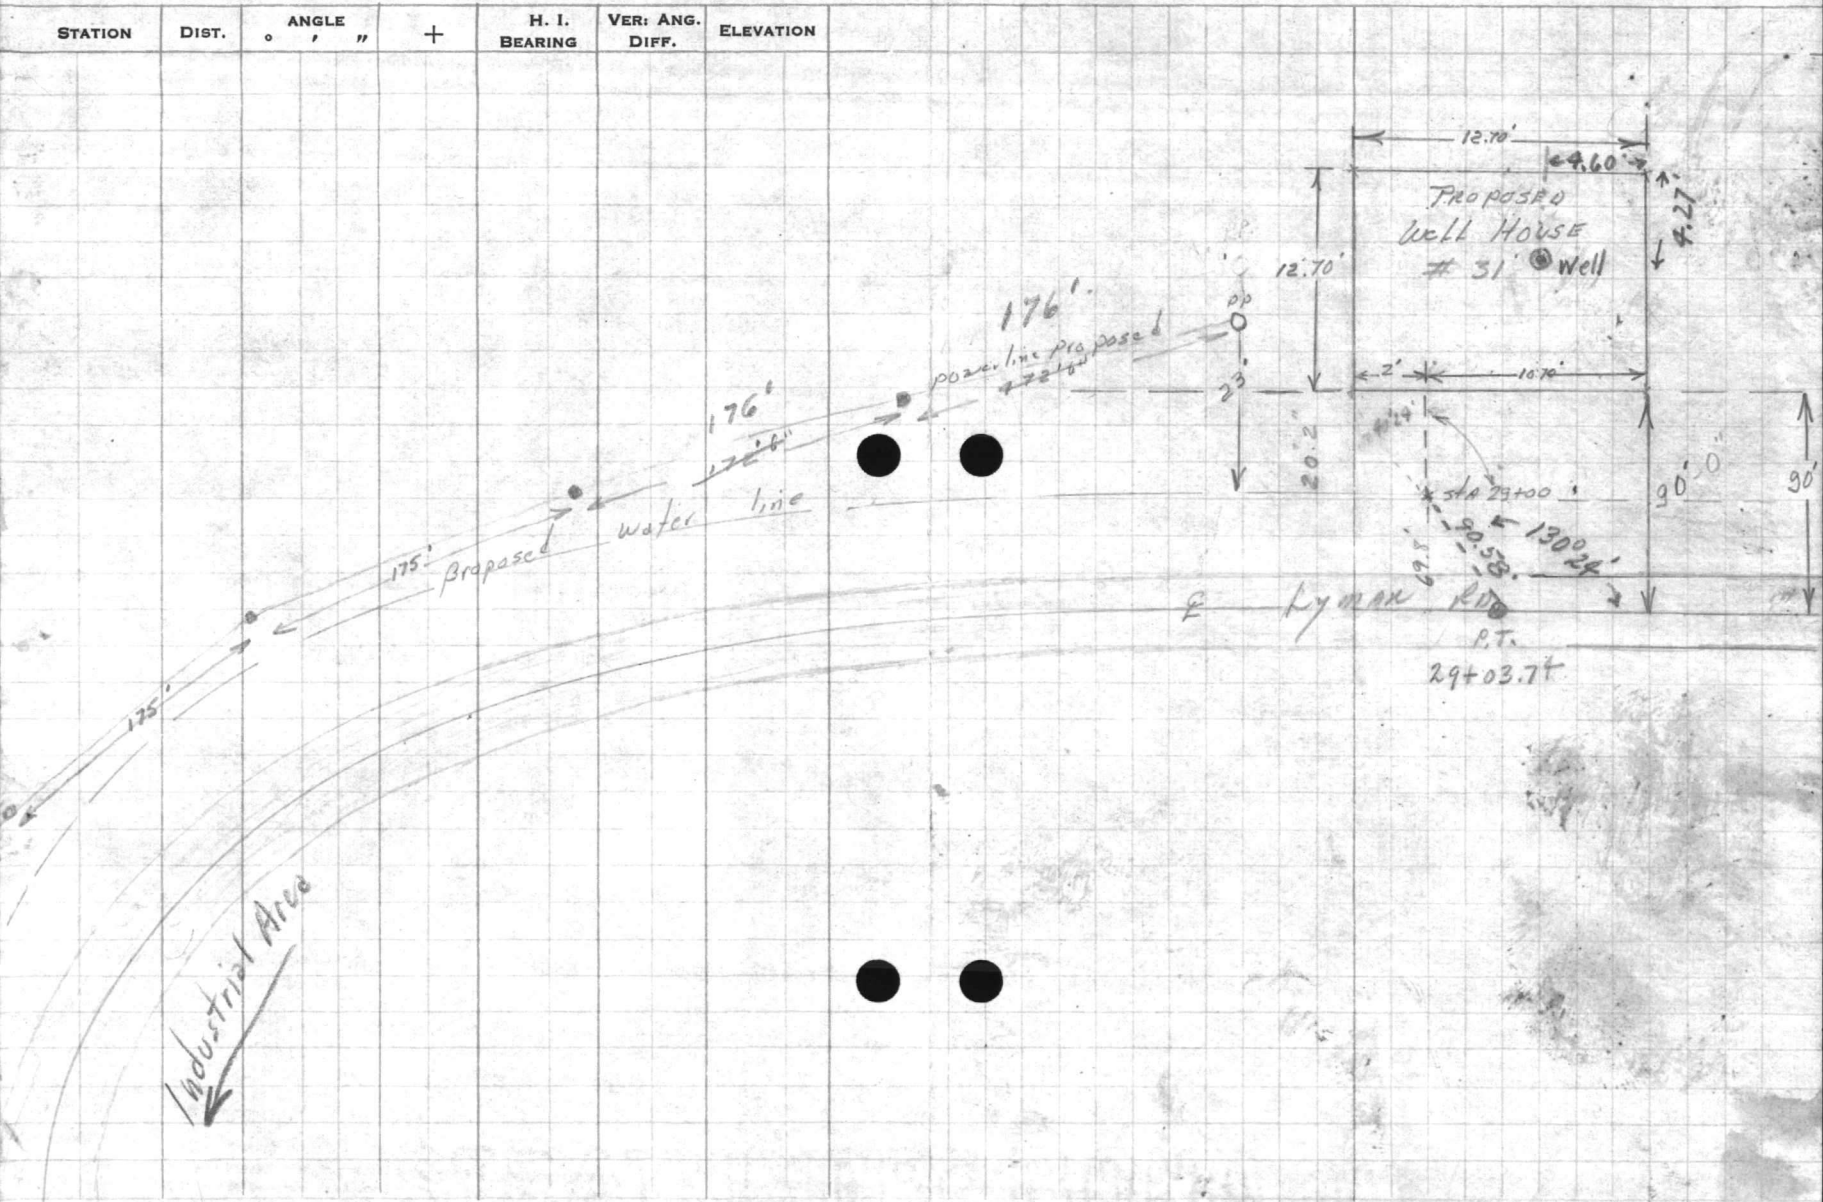

STATION	DIST.	ANGLE ° ' "	+	H. I. BEARING	VER: ANG. DIFF.	ELEVATION
---------	-------	----------------	---	------------------	--------------------	-----------

STATION
DISTRICT
COUNTY
OFFICE
STATE

STATION DISTRICT COUNTY OFFICE STATE

✓
4/24

FIELD PARTY
IN CHARGE
WEATHER
CLEAR
CLOUDY
WINDY
RAIN
FOG
THUNDER
LIGHTNING
HAIL
SNEOW
ICE
MIST
SMOG
DUST
SMOKE
VOLCANIC
AURORA
ECLIPSE
METEOR
COMET
SUNSPOTS
PLANETS
MOON
STARS
PLANETS
MOON
STARS

FIELD PARTY IN CHARGE WEATHER CLEAR CLOUDY WINDY RAIN FOG THUNDER LIGHTNING HAIL SNEOW ICE MIST SMOG DUST SMOKE VOLCANIC AURORA ECLIPSE METEOR COMET SUNSPOTS PLANETS MOON STARS PLANETS MOON STARS

VALUABLE

SUBJECT

*Const. B.M. on Well site**Lyman Road*RETURN TO
PUBLIC WORKS
OFFICE
CAMP LEJEUNE
NORTH CAROLINA

FIELD PARTY

Horton
IN CHARGE
INSTRUMENT
NOTES
TAPE READ
TAPE OR ROD
TAPE OR ROD
INSTRUMENT NO.
TAPE NO.

WEATHER

CLEAR
CLOUDY
WINDY
RAIN
FAIR
SNOW
HOT
MODERATE
COLD
FOGFILE No. *100 E*

FLDR. No. _____

SHEET. *1 of 1*DATE *3/1* 19 *54*

FIGURED BY _____

NOTES CHECKED BY _____

PLOTTED BY _____

Quad. No. _____

STATION	DIST.	ANGLE			H. I. BEARING	VER: ANG. DIFF.	ELEVATION
		°	'	"			
B.M.							
B.M.							
B.M.							

*2.28 36.36 34.08**2.22 34.14**2.24 36.38**2.30 34.08**75' Pt. of end 1st Curve on
Lyman Rd.
14" pine 50' Lt Well**37**34.19**3.08**37.22**31.79*

