

VALUABLE

SUBJECT

Race Course Area
Verona

RETURN TO
PUBLIC WORKS
OFFICE
CAMP LEJEUNE
NORTH CAROLINA

VL-104

FIELD PARTY

____ IN CHARGE
____ INSTRUMENT
____ NOTES
____ TAPE READ
____ TAPE OR ROD
____ TAPE OR ROD
____ INSTRUMENT NO.
____ TAPE NO.

WEATHER

CLEAR
CLOUDY
WINDY
RAIN
FAIR
SNOW
HOT
MODERATE
COLD
FOG

FILE No. 137-T

FLDR. No. _____





FIGURED BY _____ SHEET _____

NOTES CHECKED BY _____

PLOTTED BY _____ DATE 8/12/1965

Quad. No. _____

STATION	DIST.	ANGLE " "	H. I. BEARING	VER: ANG. DIFF.	ELEVATION
PI "X"					Sight on Mon. st Circle
Cor.	160'	205° 40'	Well House		
"	169'	202° 52'	"		
Cor.	153'	241° 12'	Men. Hall		
"	157'	251° 34'	VL-104		
Cor.	168'	231° 28'	VL-105		
Cor.	300'	237° 35'			

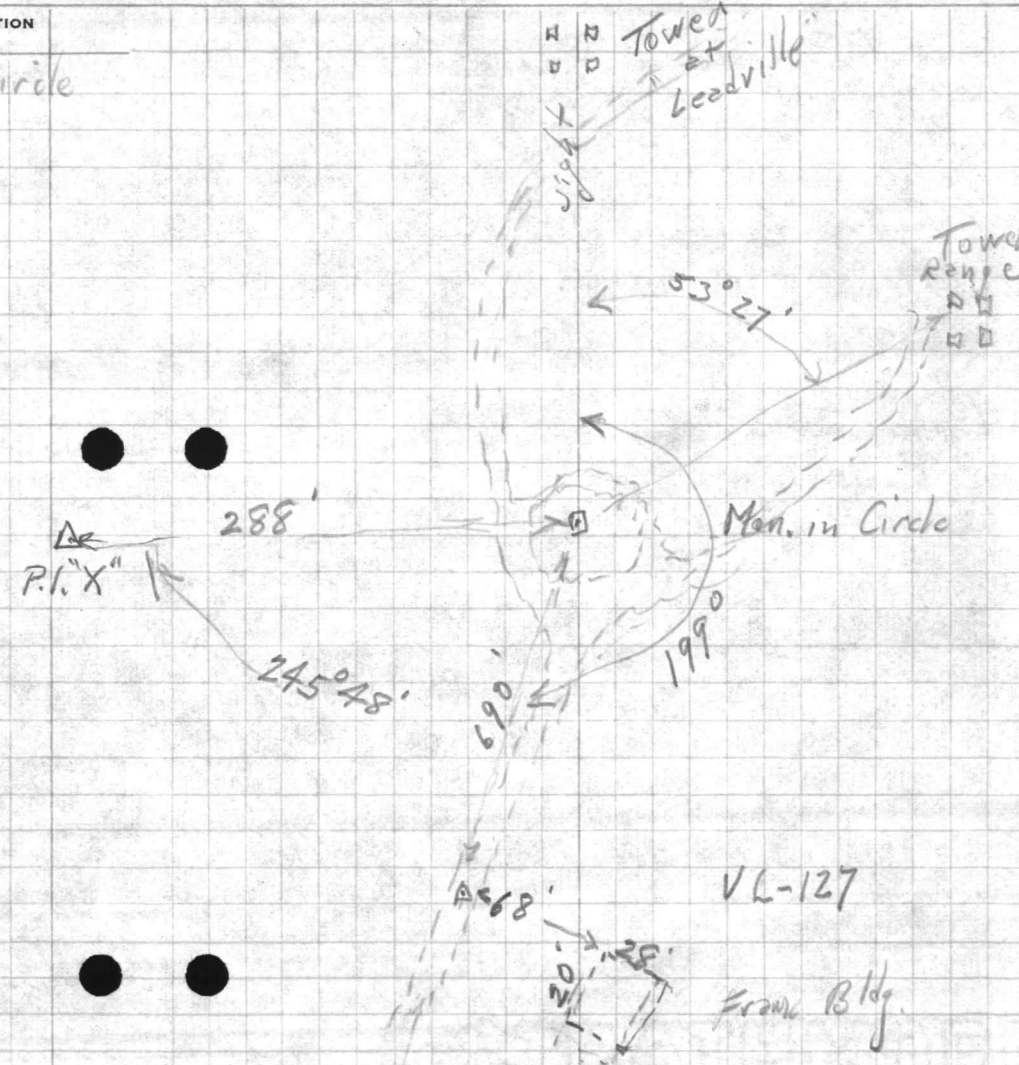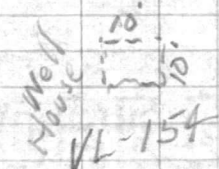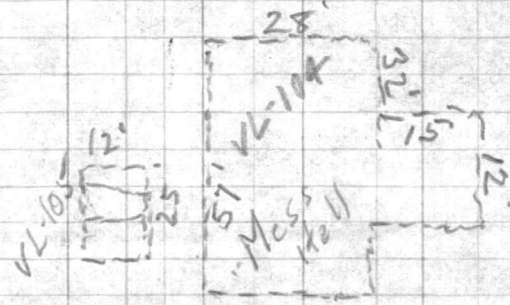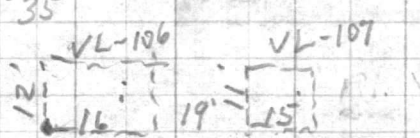

Faint, mirrored text from the reverse side of the page, including names like "W. ALTHOR" and "J. W. ALTHOR".

