


File 139-J

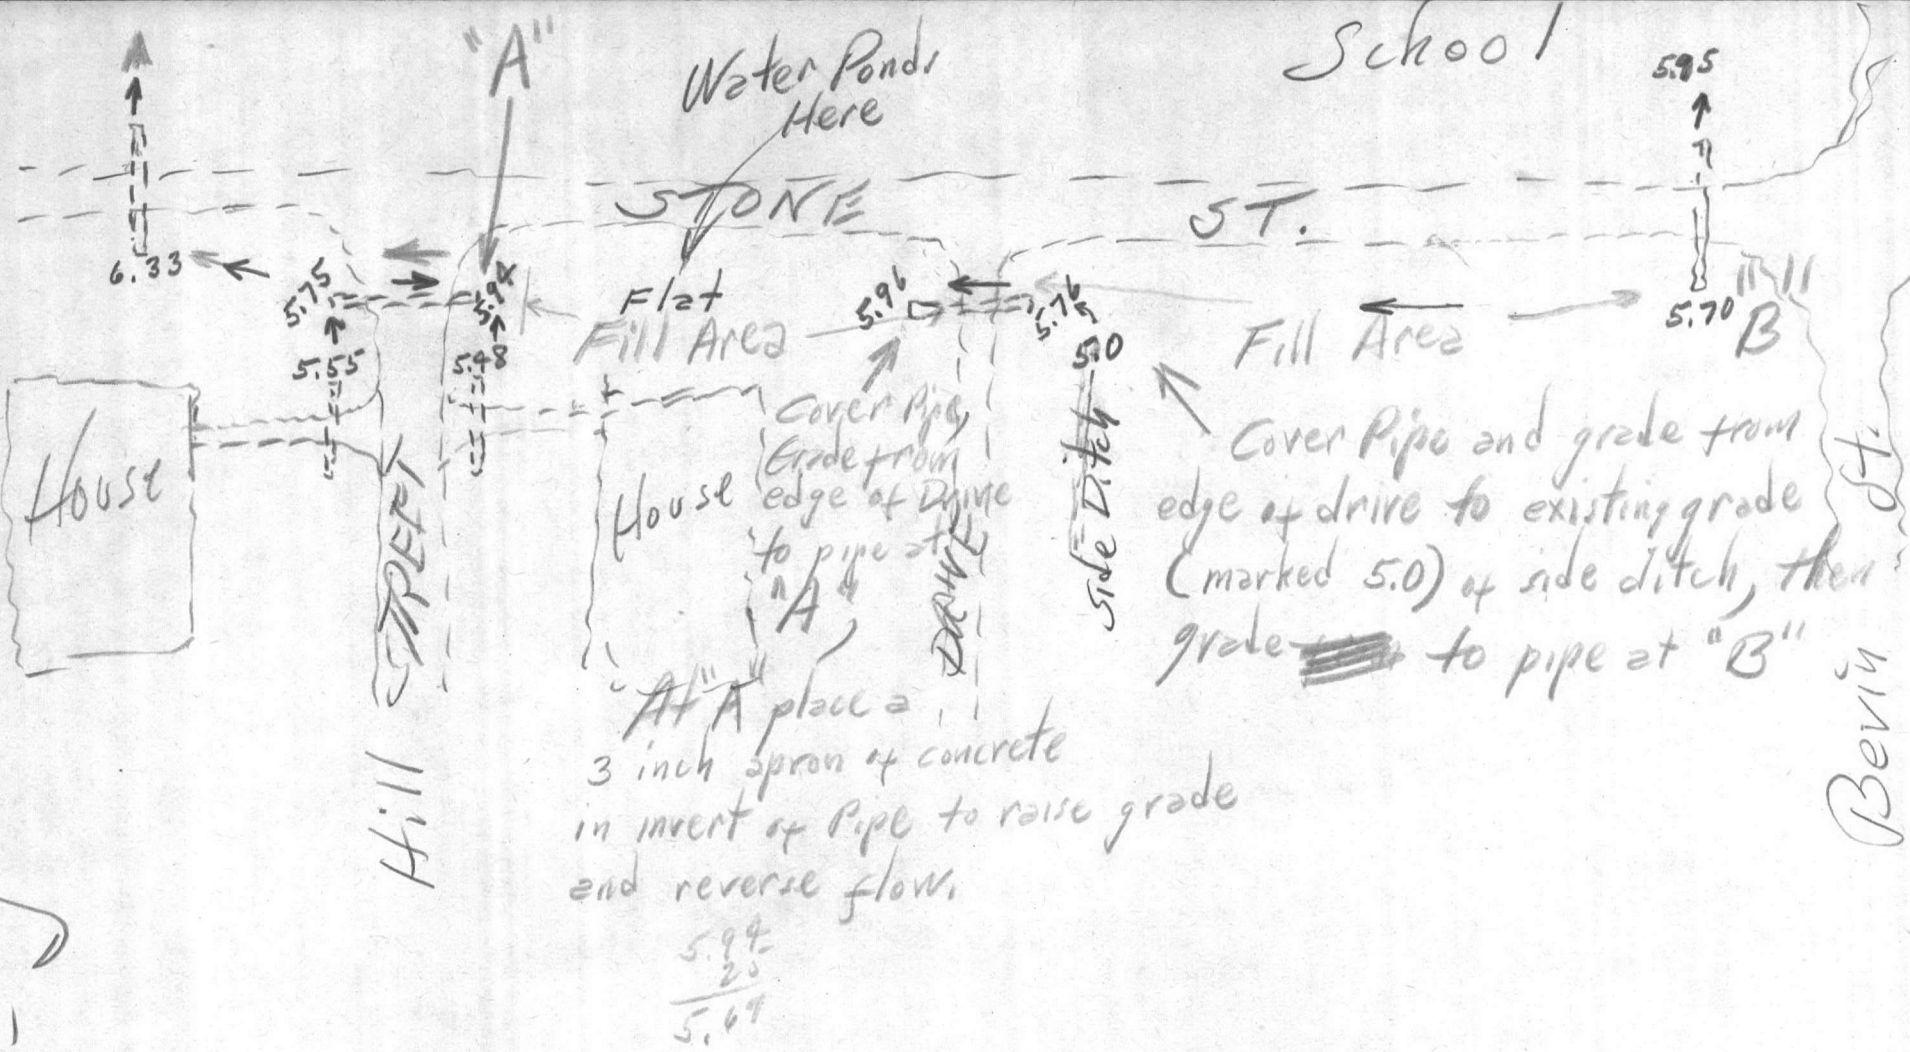

At "A" place a  
3 inch apron of concrete  
in invert of pipe to raise grade  
and reverse flow.

5.94  
20  
5.64

6.33 - - - Numbers shown are Rod Readings - not elevations.

5/10/63

Bevin St.

