


DIAGRAM OF PROPOSED  
CONSTRUCTION SPECIFICATIONS

Straight-Screened  
OR  
Gravel-Packed Well

(Constructed in unconsolidated formations)

Open-End Well

(Constructed in consolidated formations)

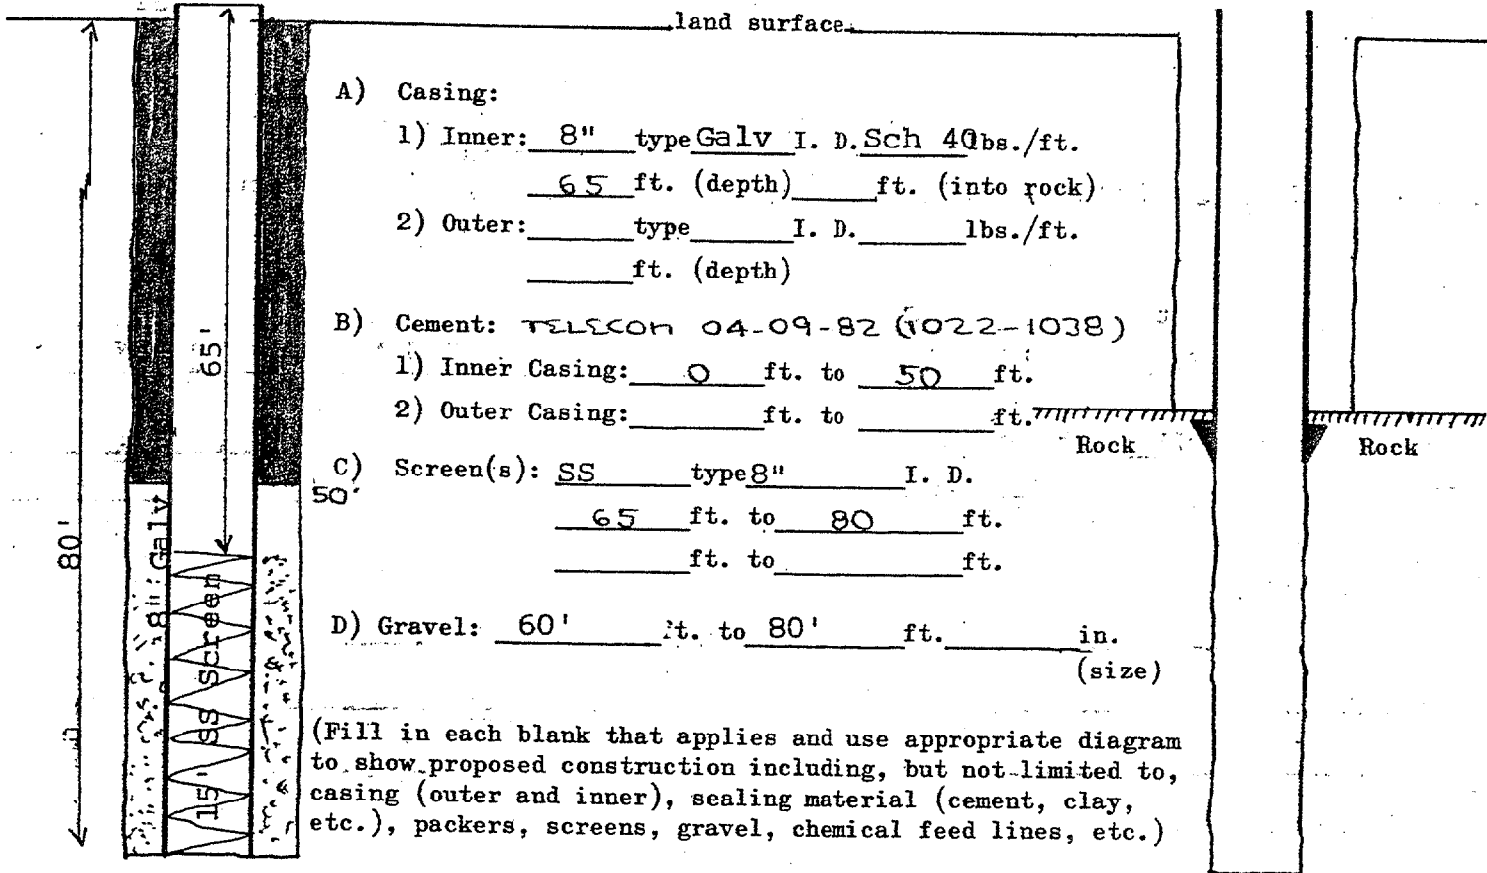

Location Diagram: (Previously prepared maps may be submitted provided they contain information required in item (g) of the application).

LOCATION DIAGRAM ON FILE WITH WIRO

RECEIVED


MAR 31 1982

WILMINGTON REGIONAL OFFICE

DEM

CLW

000000520

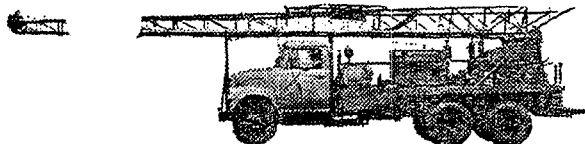

# CRAVEN WELL DRILLING SERVICE

P.O. BOX 248  
BRIDGETON, NORTH CAROLINA 28519

4 - 9 - 1982

N.C. Water and Ground Resources  
7225 Wrightsville Ave.  
Wilmington, N.C. 28401

Re: Conversation with Rick Shiver  
concerning Camp Le Jeune Rifle Range Wells

Dear Sir:

The two wells for rifle range at Camp Le Jeune shall both be  
grouted from 0 - 50 feet.

Sincerely,

*Raymond E. Benton*  
Raymond E. Benton



APR 13 1982  
WILMINGTON REGIONAL OFFICE  
DEM

CLW

0000000521


DIAGRAM OF PROPOSED  
CONSTRUCTION SPECIFICATIONS

Straight-Screened  
or  
Gravel-Packed Well

(Constructed in unconsolidated formations)

Open-End Well

(Constructed in consolidated formations)

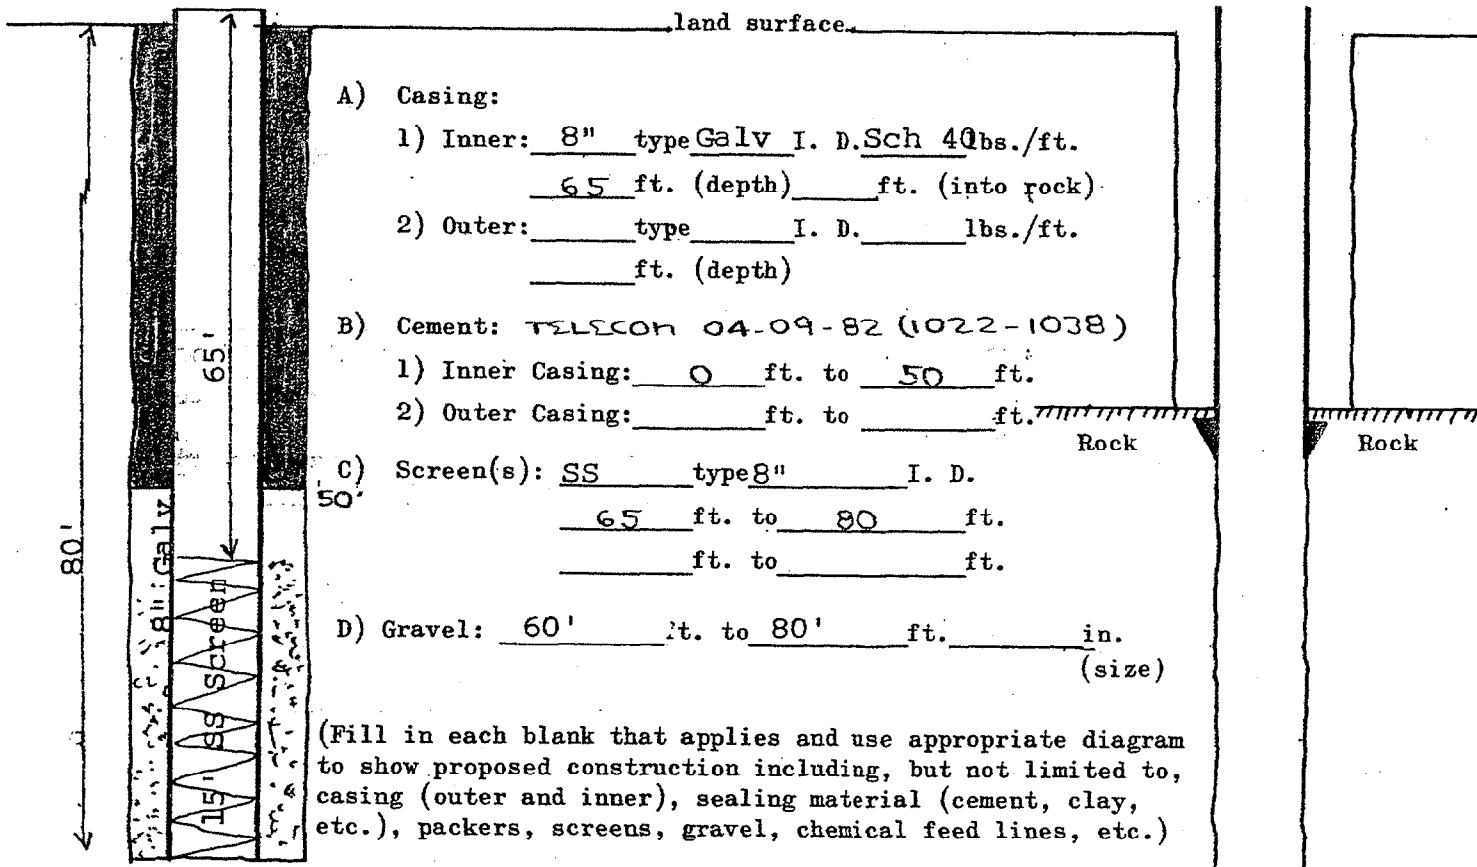

(Fill in each blank that applies and use appropriate diagram to show proposed construction including, but not limited to, casing (outer and inner), sealing material (cement, clay, etc.), packers, screens, gravel, chemical feed lines, etc.)

Location Diagram: (Previously prepared maps may be submitted provided they contain information required in item (g) of the application).

LOCATION DIAGRAM ON FILE WITH W120

RECEIVED


MAR 31 1982

WILMINGTON REGIONAL OFFICE

DEM

CLW

000000525

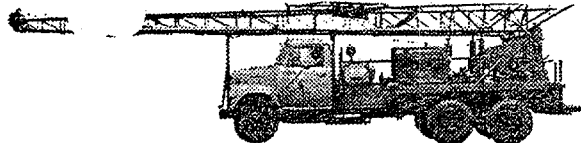

# CRAVEN WELL DRILLING SERVICE

P.O. BOX 248  
BRIDGETON, NORTH CAROLINA 28519  
4 - 9 - 1982

N.C. Water and Ground Resources  
7225 Wrightsville Ave.  
Wilmington, N.C. 28401


Re: Conversation with Rick Shiver  
concerning Camp Le Jeune Rifle Range Wells

Dear Sir:

The two wells for rifle range at Camp Le Jeune shall both be grouted from 0 - 50 feet.

Sincerely,

*Raymond E. Benton*  
Raymond E. Benton

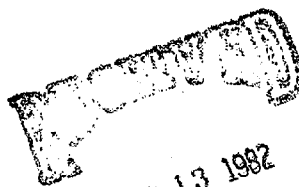

APR 13 1982  
WILMINGTON REGIONAL OFFICE  
DEM

CLW

000000526