

# ADDITIONAL WATER

## COURTHOUSE BAY

### CAMP LEJEUNE

### NORTH

12891

FIRE DEPT.

Backwash & Regeneration


Filter

- 1-4853
- 2-9706
- 3-14559
- 4-19412
- 5-24265
- 6-29118

Softeners

- 1-2450
- 2-4900
- 3-7350
- 4-9800

NA

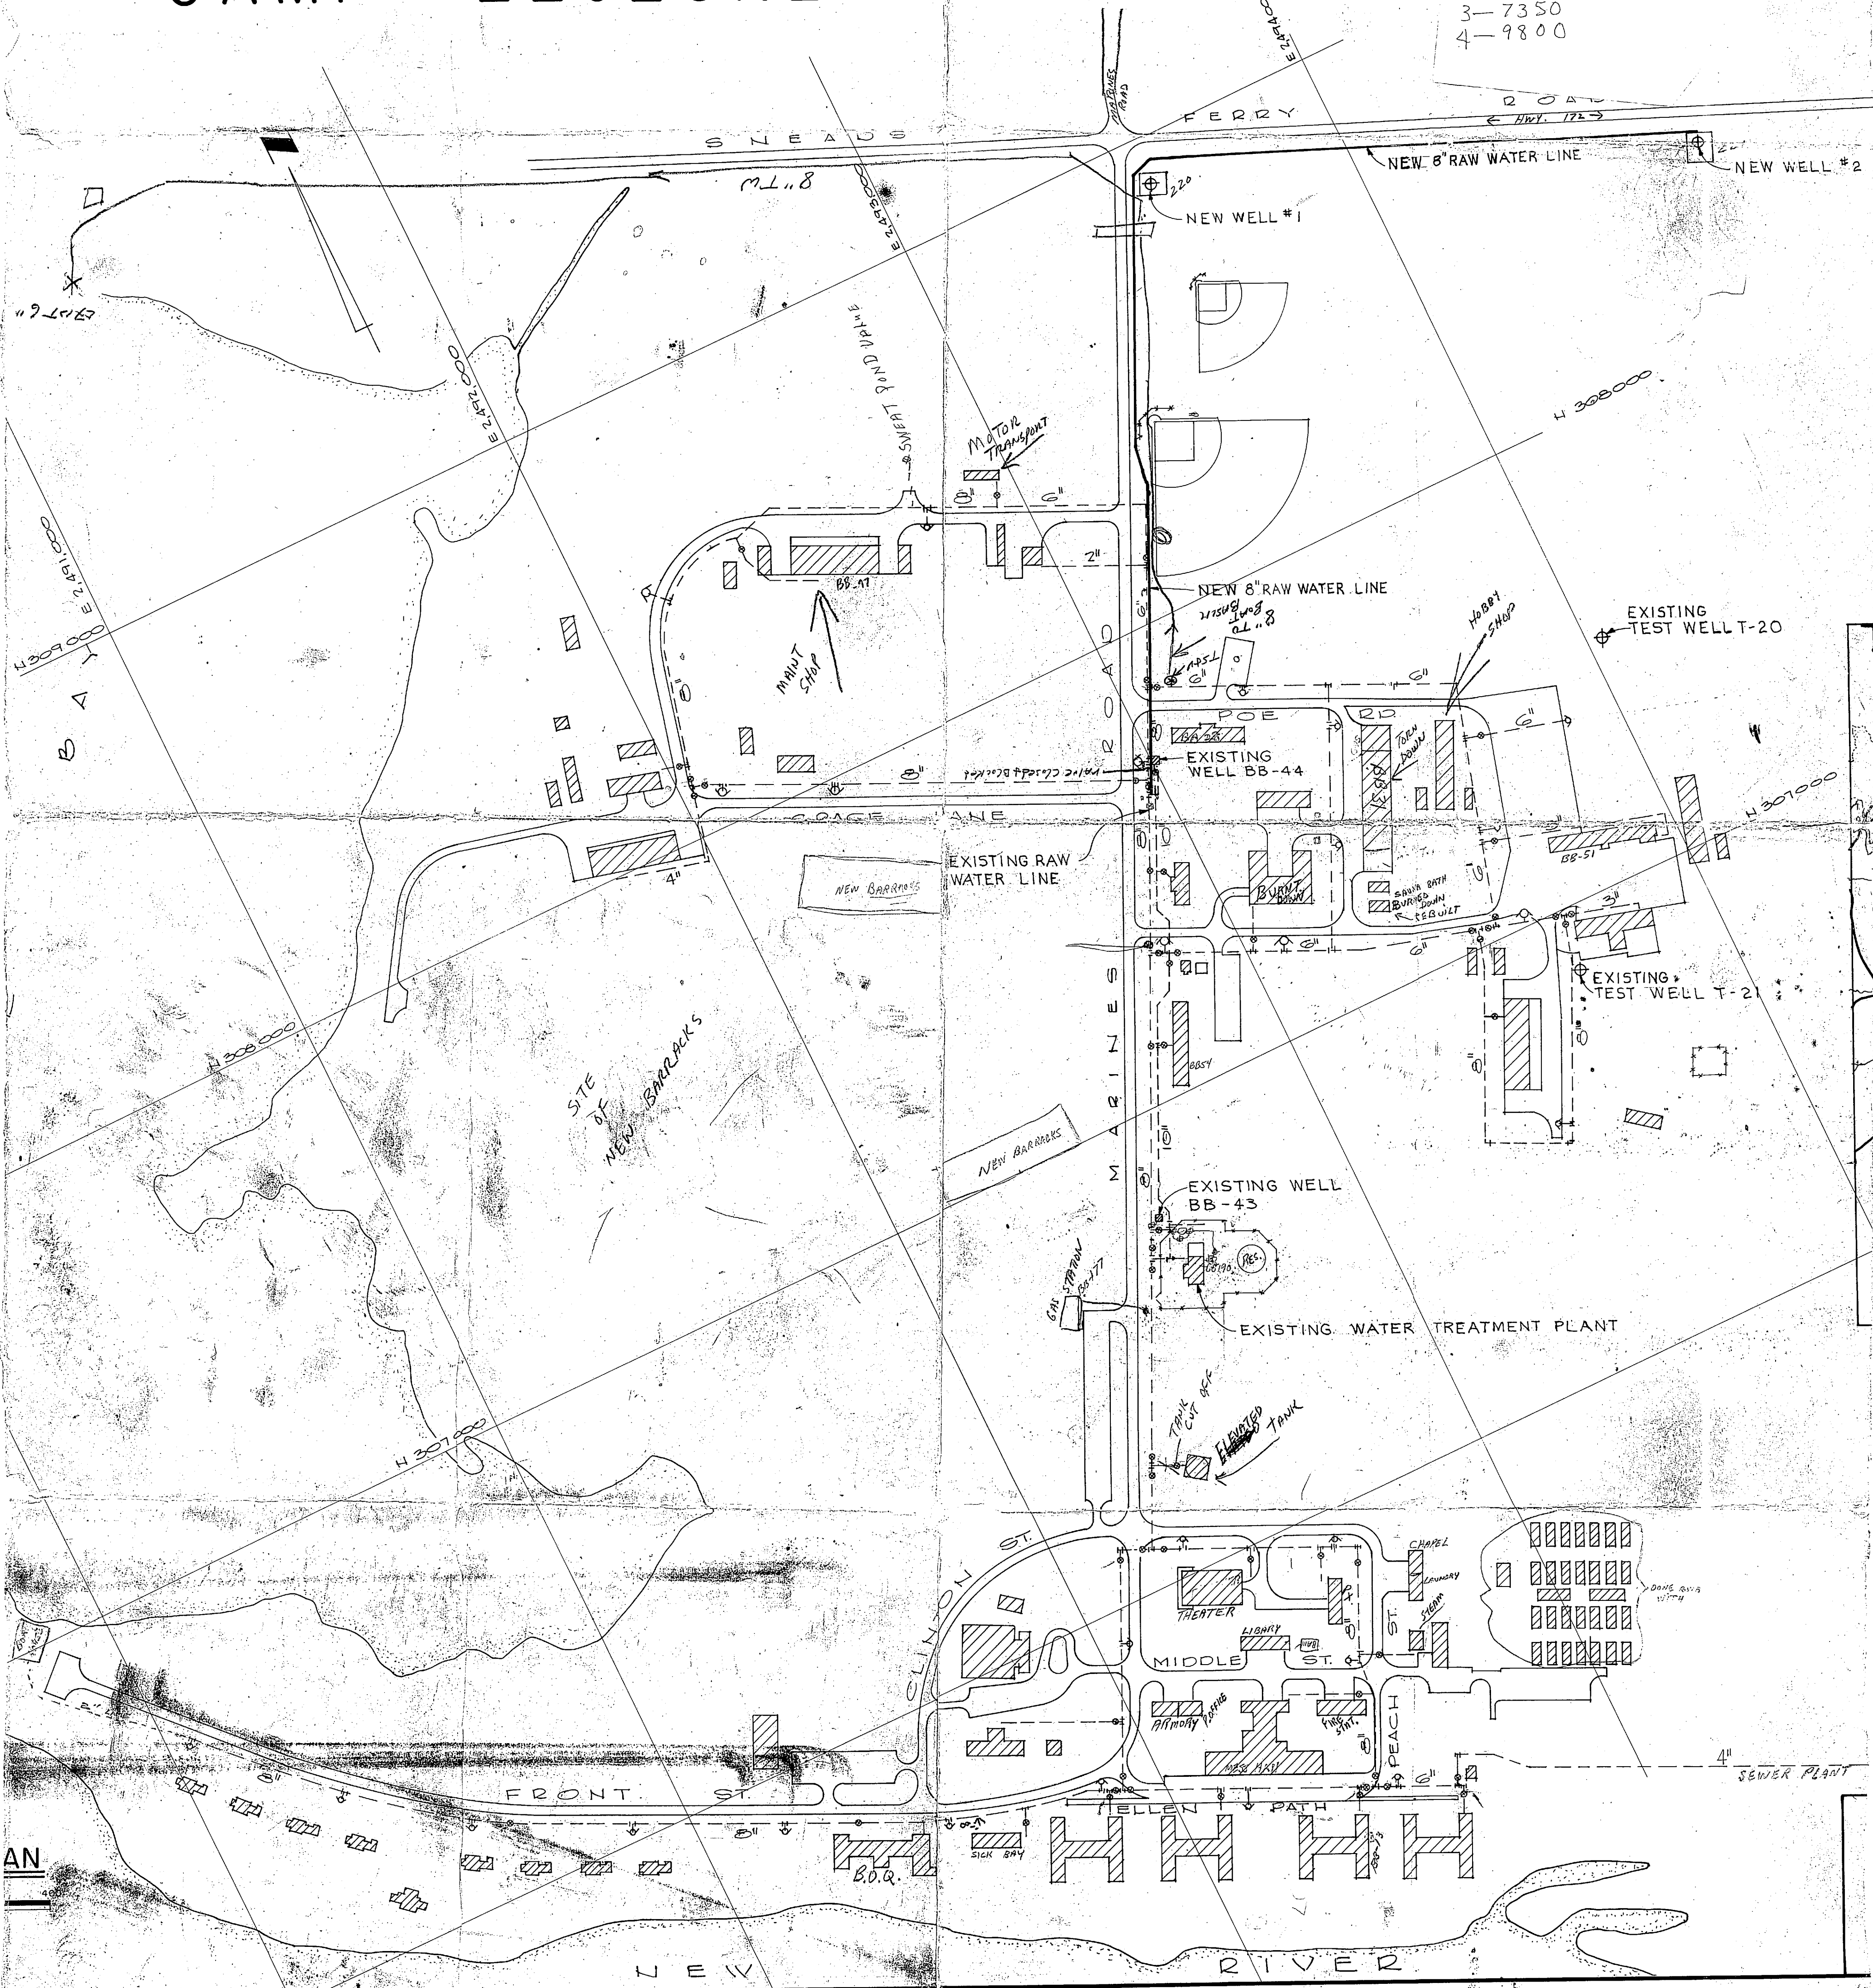

AN

(↓ FIRE HYDRANT)

⊗ GATED VALVE

SAVE MAP FOR REFERENCE




12891  
FIRE DEPT.  
MAP

# ADDITIONAL WATER WELL

## COURTHOUSE BAY

### CAMP LEJEUNE NORTH CAROLINA

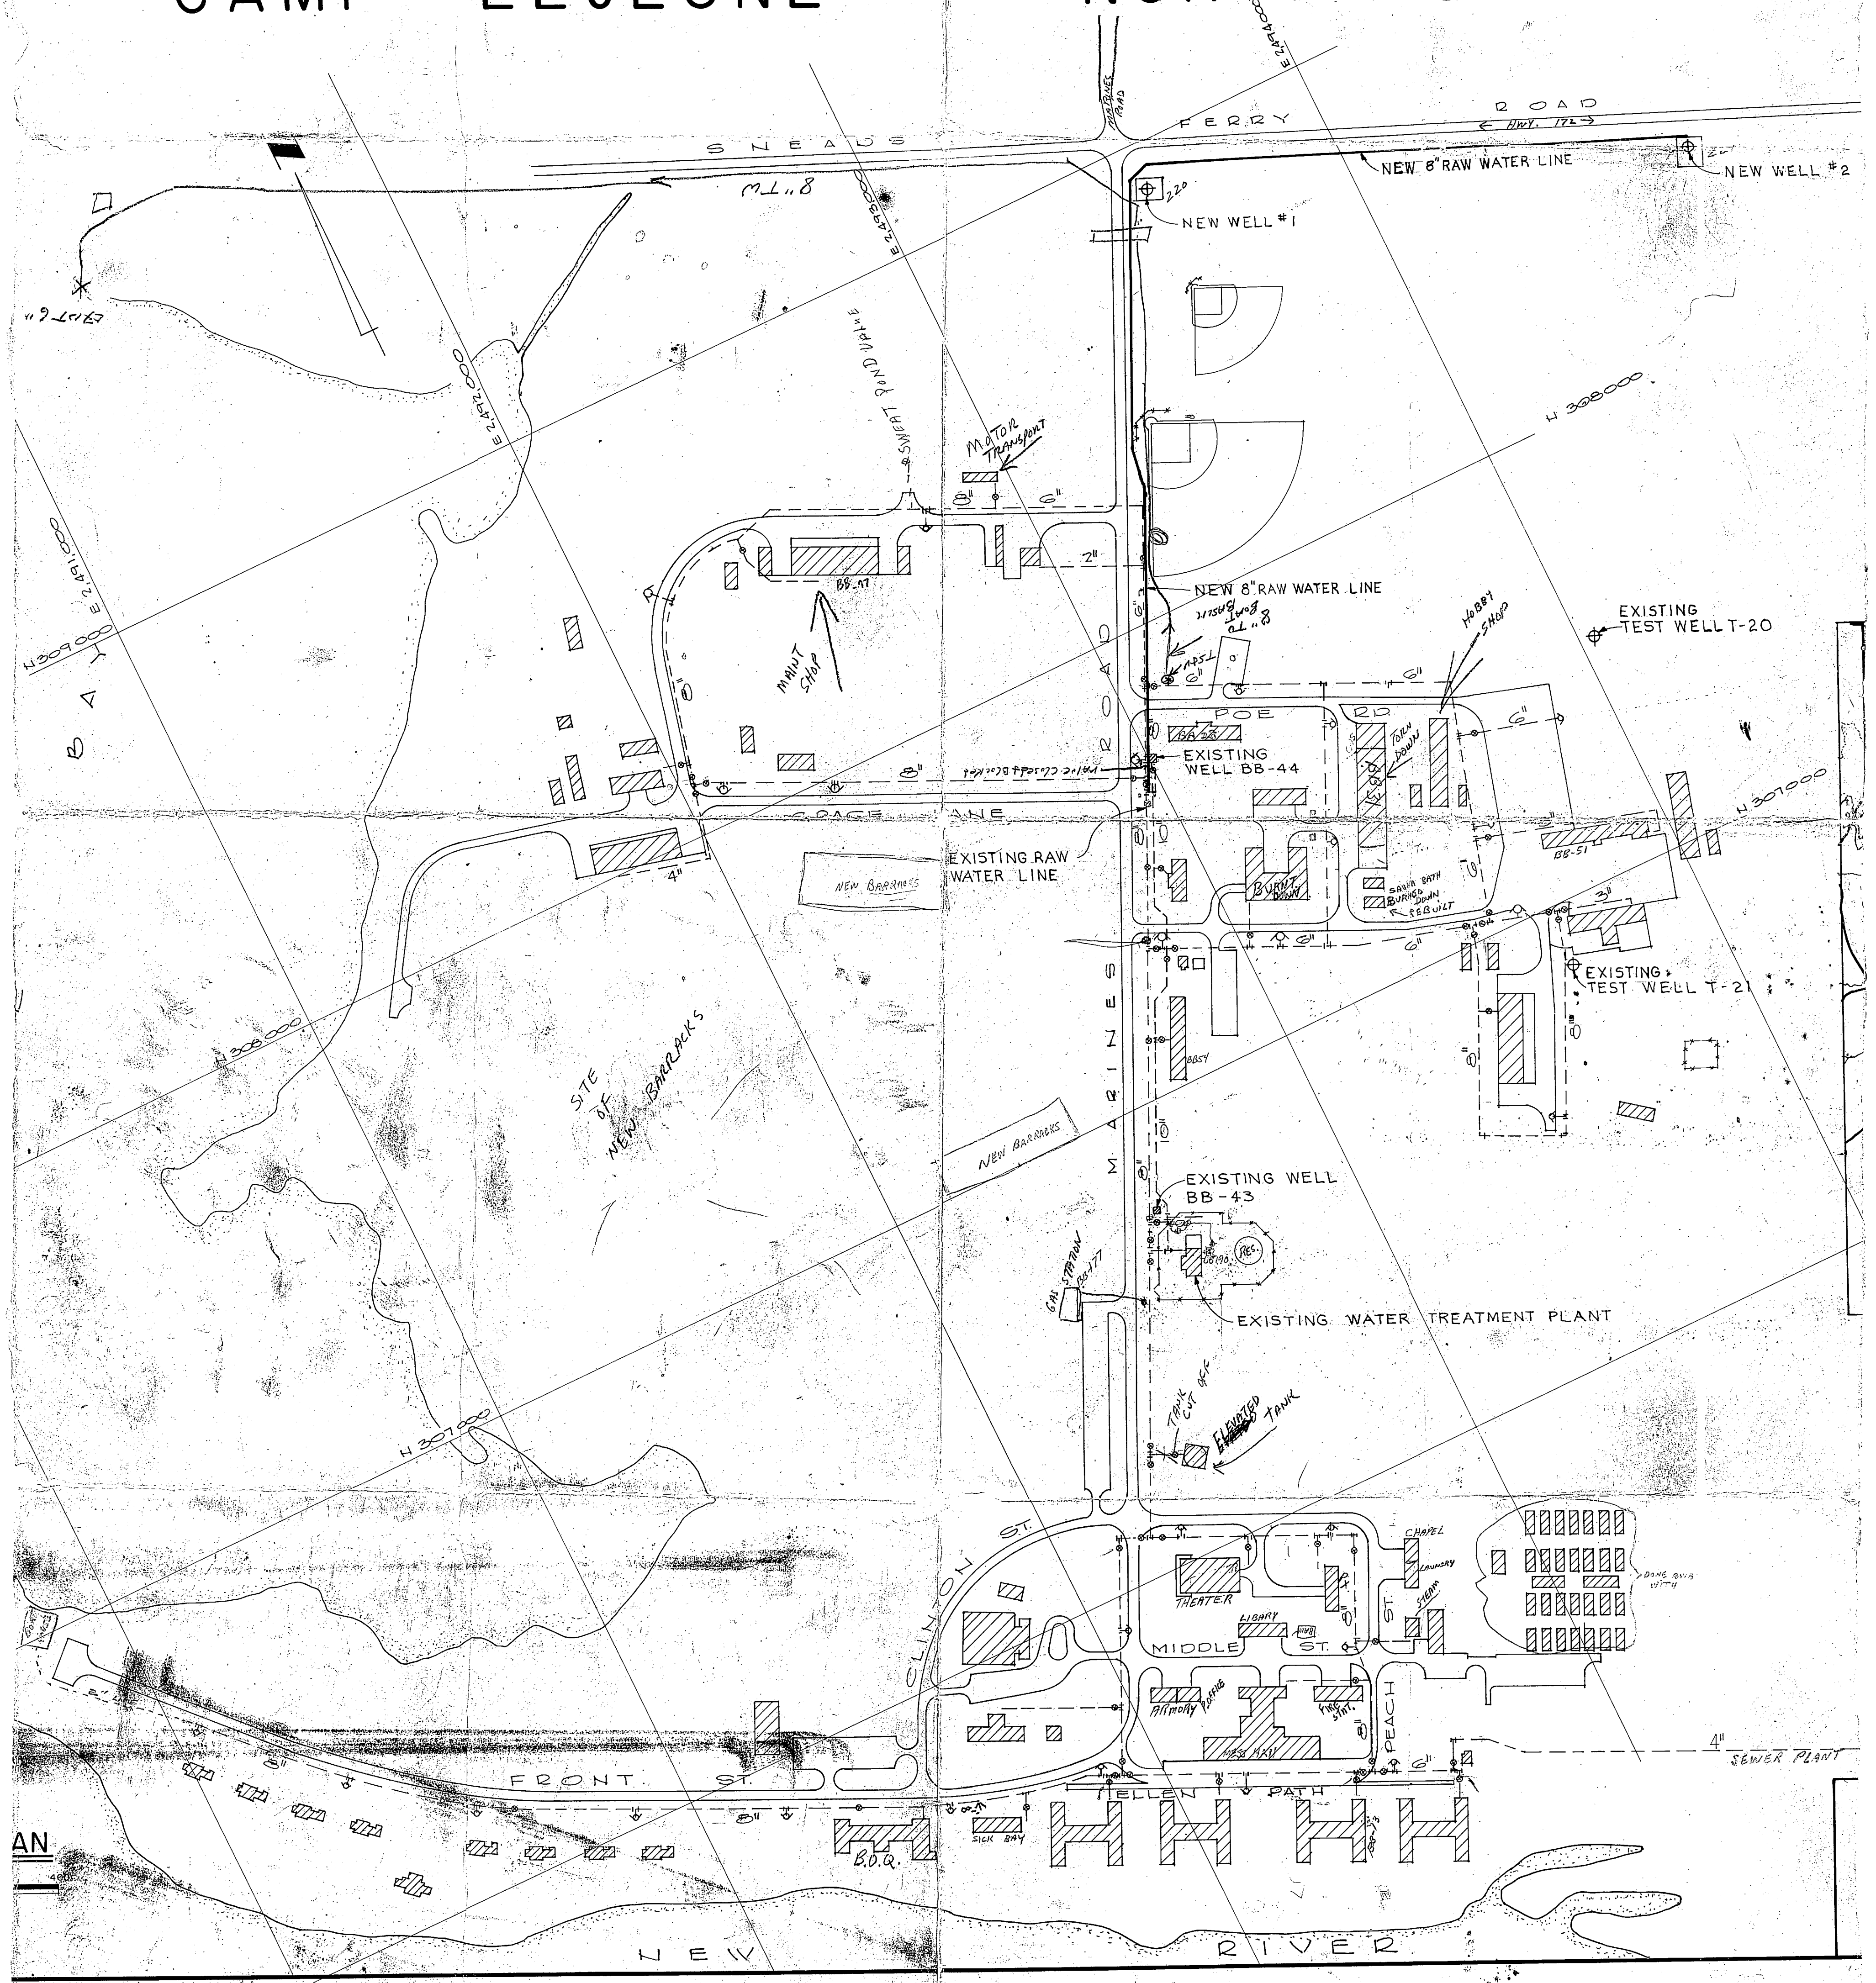

(↓ FIRE HYDRANT)      ⊗ GATED VALVE

SAVE MAP FOR REFERENCE