

UNITED STATES MARINE CORPS

CAMP LEJEUNE, NORTH) CAROLINA 28542

3 10 4 04 5 405 / 986 INT

IN REPLY REFER TO

FAC/ACA/hf LE315M 2 JUN 1982

From: Commanding General

0

To: Commander, Atlantic Division, Naval Facilities Engineering

Command, Norfolk, VA 23511 (Code 241)

Subj: Lease and Use Agreement NOm-71659, succeeding trackage

agreement

Ref: (a) LANTNAVFACENGCOM 1tr 241:RHA, LO-6 of 6 Nov 81

Encl: (1) Map of Camp Lejeune-Cherry Point Railroad Connection,


Sheet 22 of 24, dtd 30 Jun 79

(2) Midway Park Housing Area, Sheet 5 of 24, dtd 30 Jun 79

(3) Open Storage Area Map, Sheet 6 of 24, dtd 30 Jun 79

(4) Map of Hadnot Point Area, Sheet 10 of 24, dtd 30 Jun 79

- 1. The reference pointed out that the subject lease expires on 31 August 1984 and that Southern Railway advised they will not extend the lease but will continue rail service to the Base provided the Government assumes responsibility for rail maintenance. Pursuant to this matter, the reference provided a proposed trackage agreement between Southern and the Base for review and concurrence.
- 2. This is to concur in the proposed agreement with one addition. The agreement should include trackage from the Wye at the Main Gate to the connection in Havelock, North Carolina, and additionally from the Wye to and including trackage in the Industrial Area of the Base These areas are shown in enclosures (1) through (4) and are the same areas for which Southern has responsibility for maintenance in the current agreements. The vertical clearance requirement is 22 feet and the side clearance requirement is 8 feet on either side of the center line.
- 3. Preparations for repair to these tracks are on-going. Headquarters Marine Corps has approved Repair Project LE315M for FY-83 funding. The repair contract will probably be awarded in the last half of FY-83. Milestones will be promulgated as events become firm. In the event that the subject proposed agreement does not become effective in a timely manner, some sort of working agreement must be made with the railroad before the repair contract is advertised. Assistance is requested concerning this matter.

 


Subj: Lease and Use Agreement NOm-71659, succeeding trackage agreement


4. Even though this agreement deals only with Southern Railway, the above repair project, LE315M, also includes the repair of the Government-owned tracks from the Wye to Jacksonville, North Carolina (colored in blue in enclosure (1)), which is under the purview of Seabcard Coast Line vice Southern. Seabcard has previously announced that they are studying the possibility of abandoning the New Bern-Wilmington line which passes through Jacksonville where this Government line connects to Seabcard. As of this date, Seabcard has not rescinded their intention to abandon that line. Similarly, an agreement with Seabcard is required before the contract for LE315M is advertised. Assistance is requested in this matter also.

K. P. MILLICE, Jr. By direction


Copy to: (w/encl)
CMC (Code LFF-1)
CMC (Code LFT)
MTMC (MT-SA) (MT-IN)
NAVFACENGON (Code 0643)


Blind Copy.to: (w/encl) AC/S, Log (TMO) FWO

 


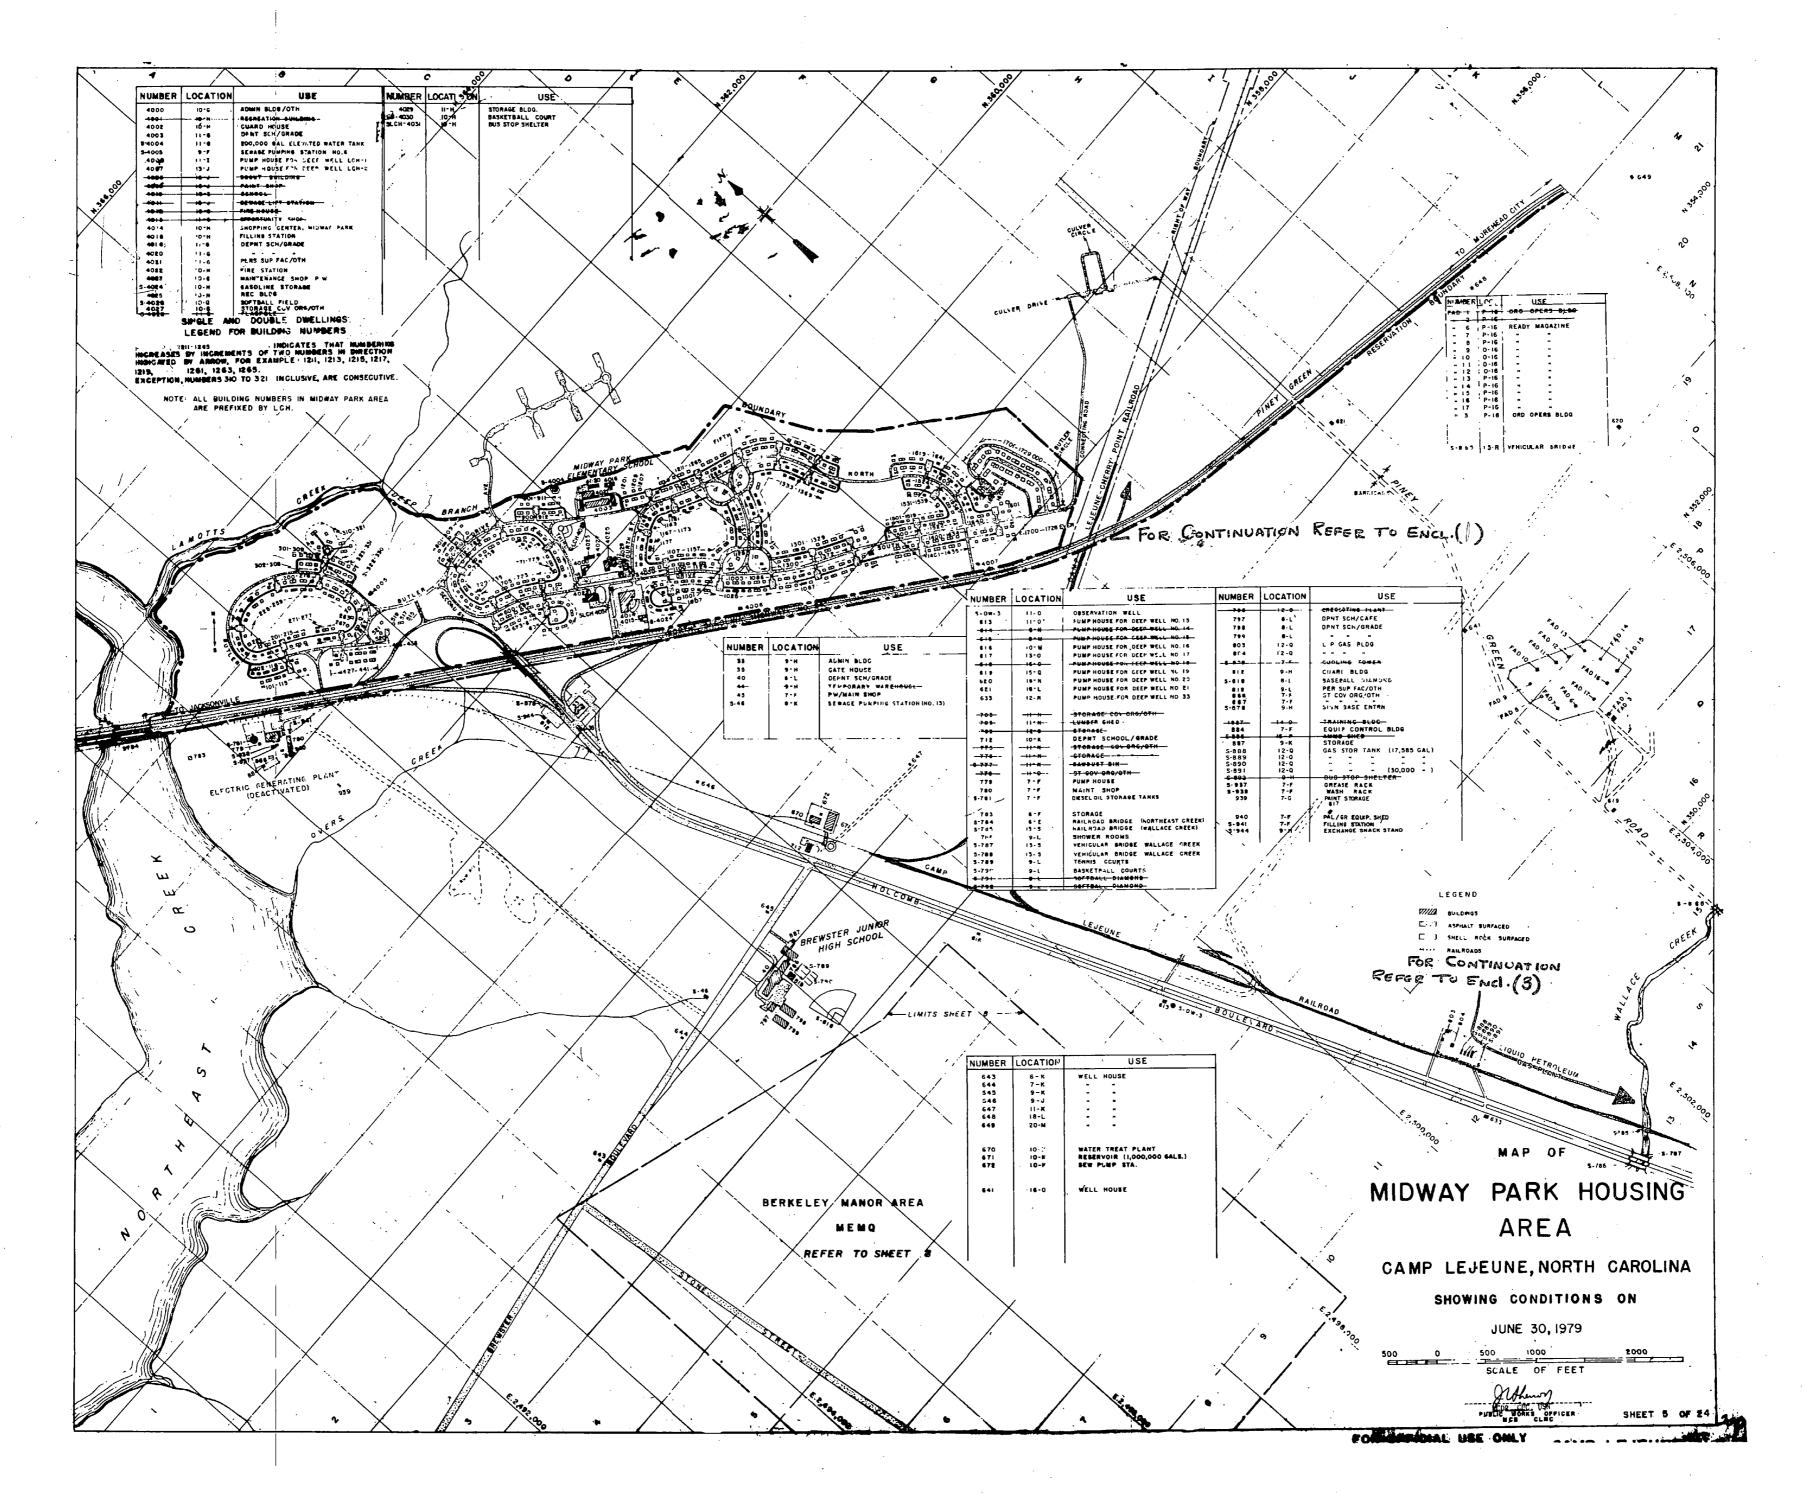


. . 

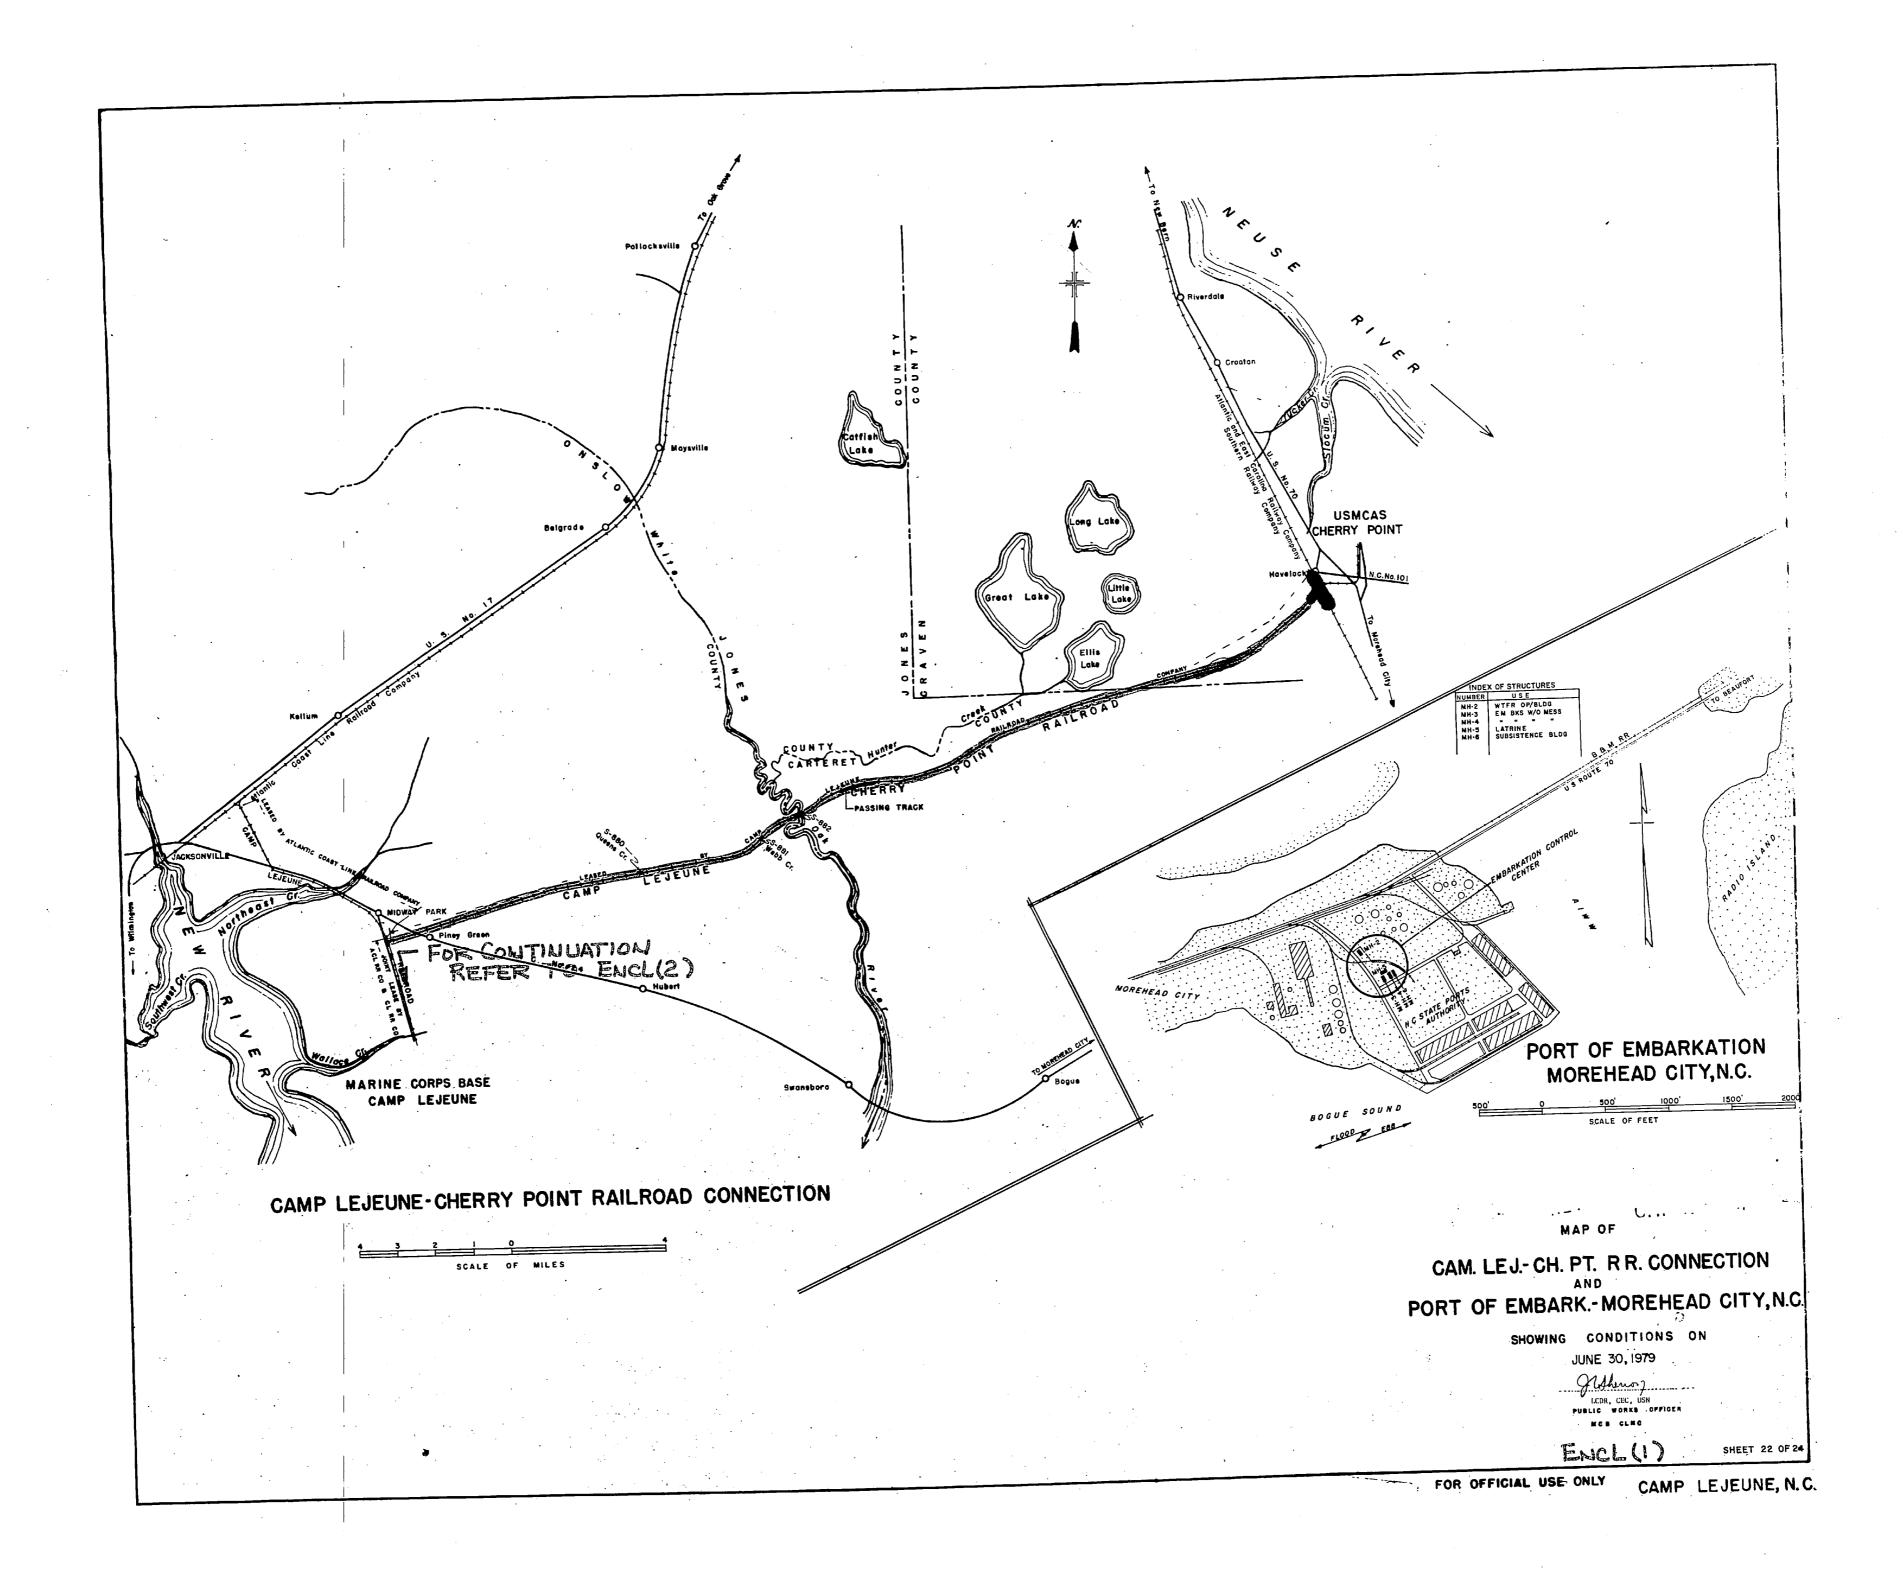

 

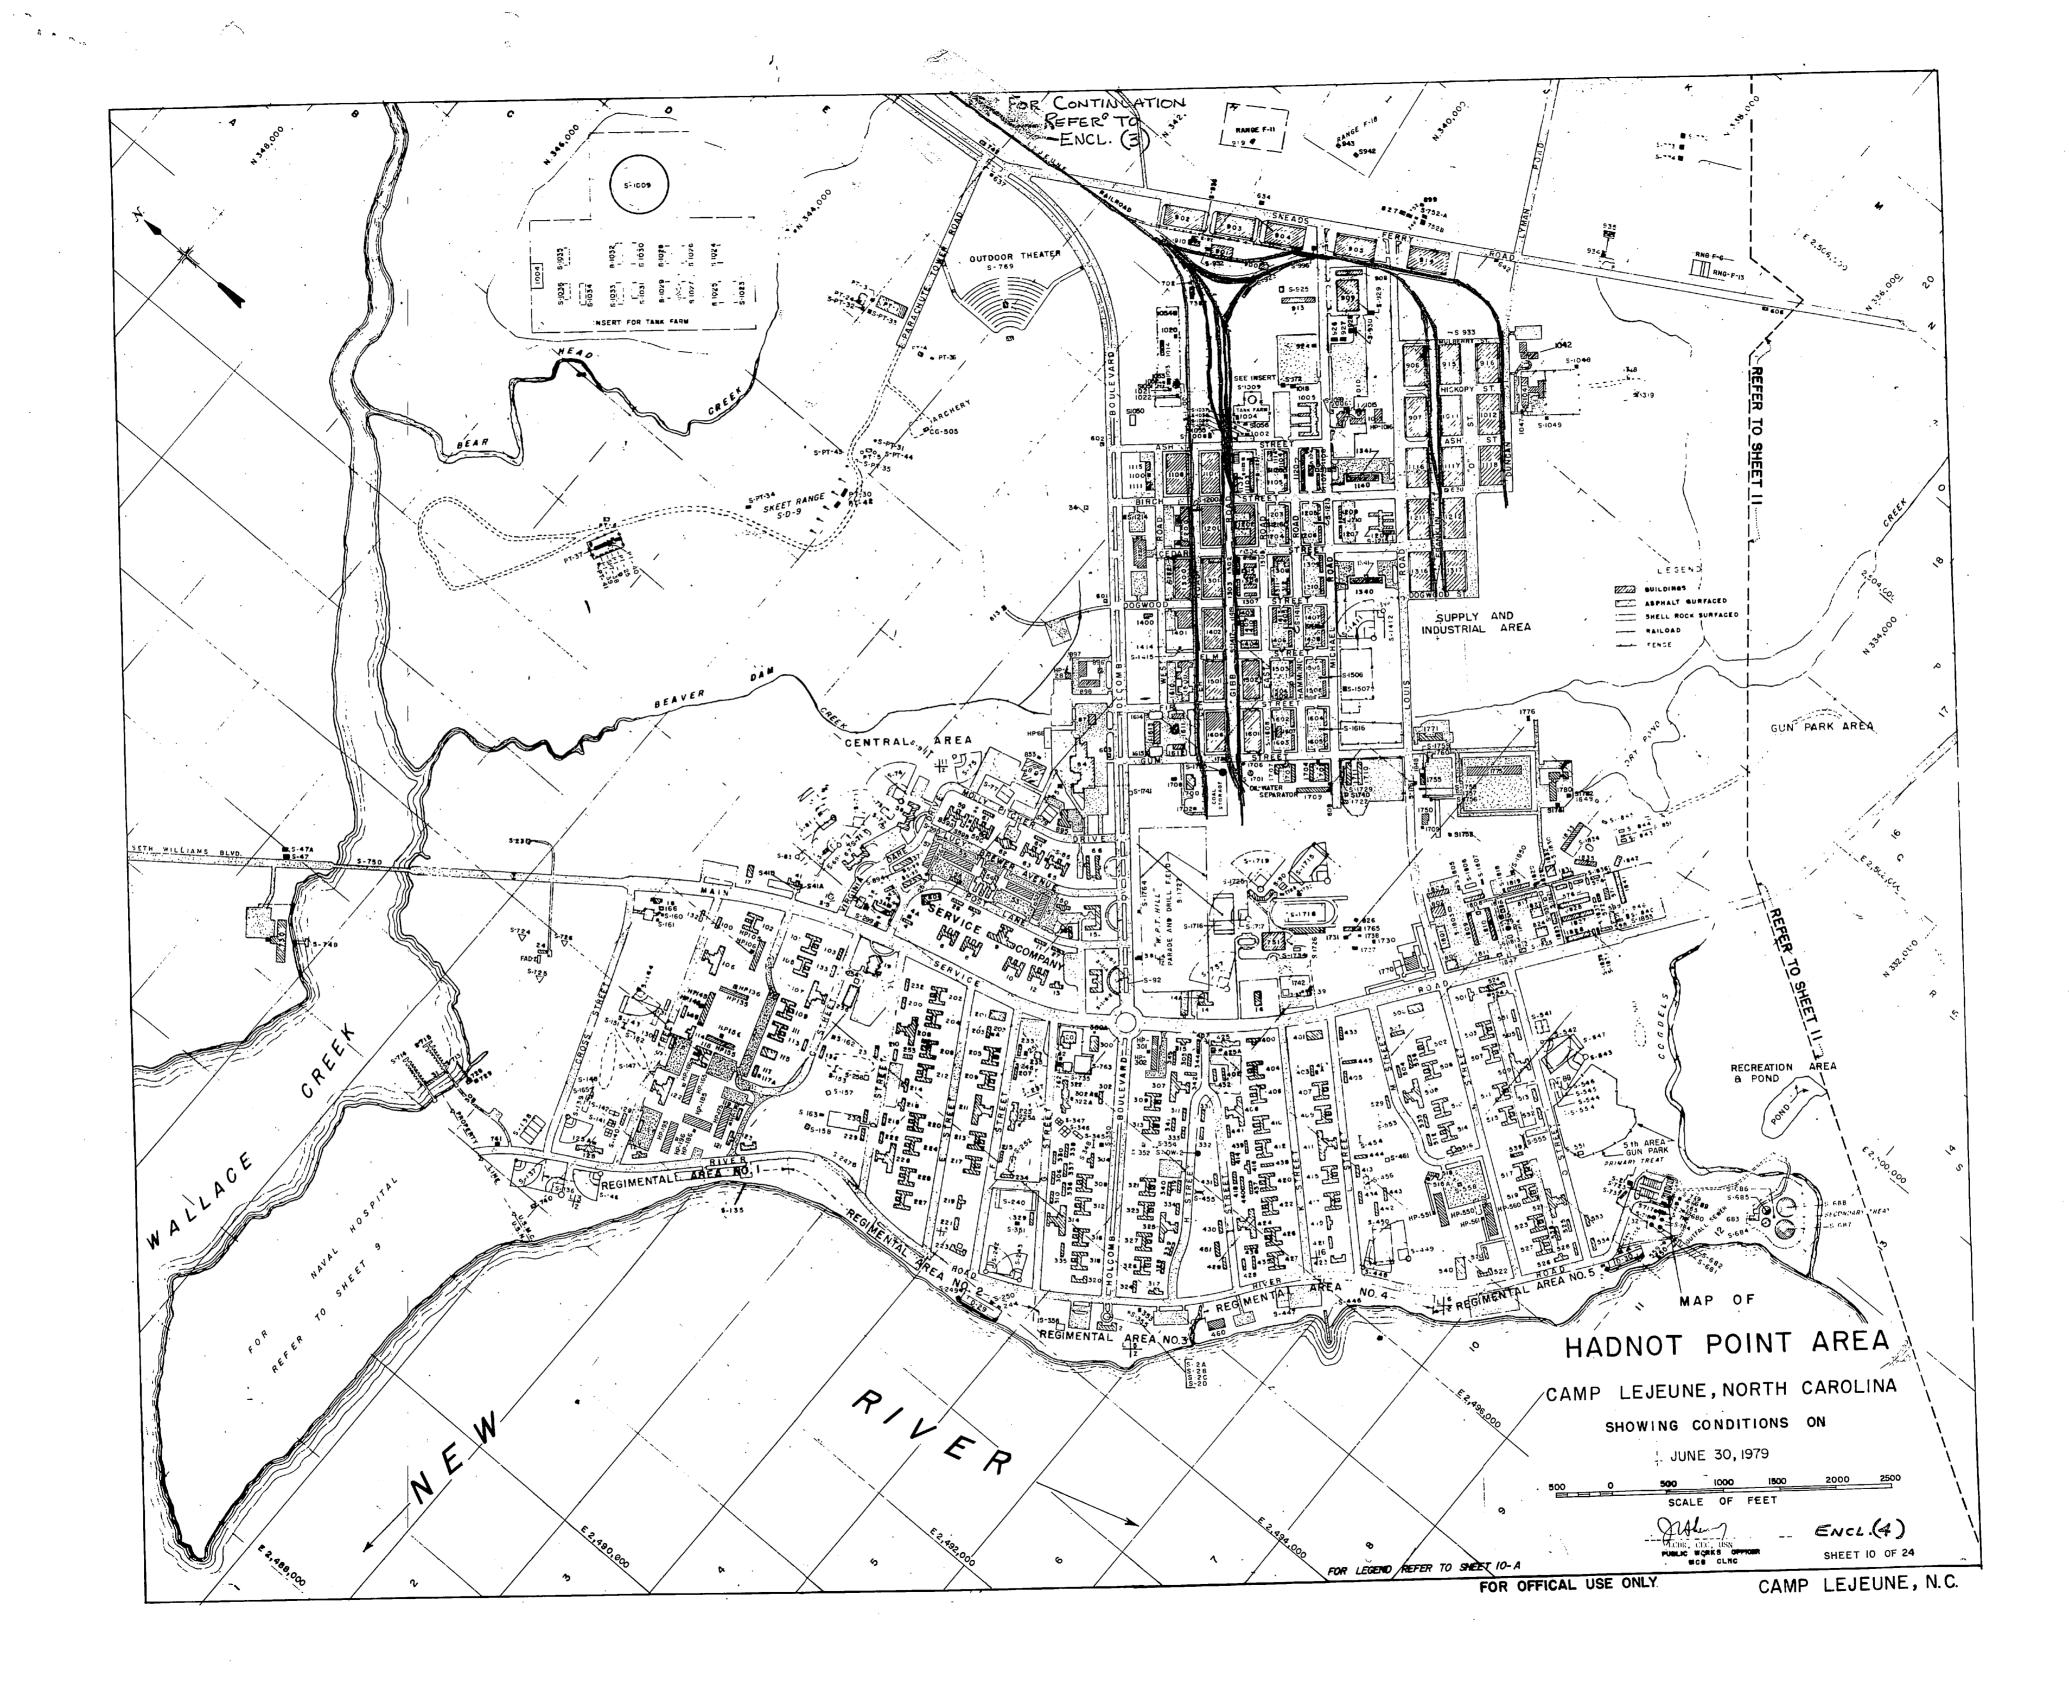

• . • 

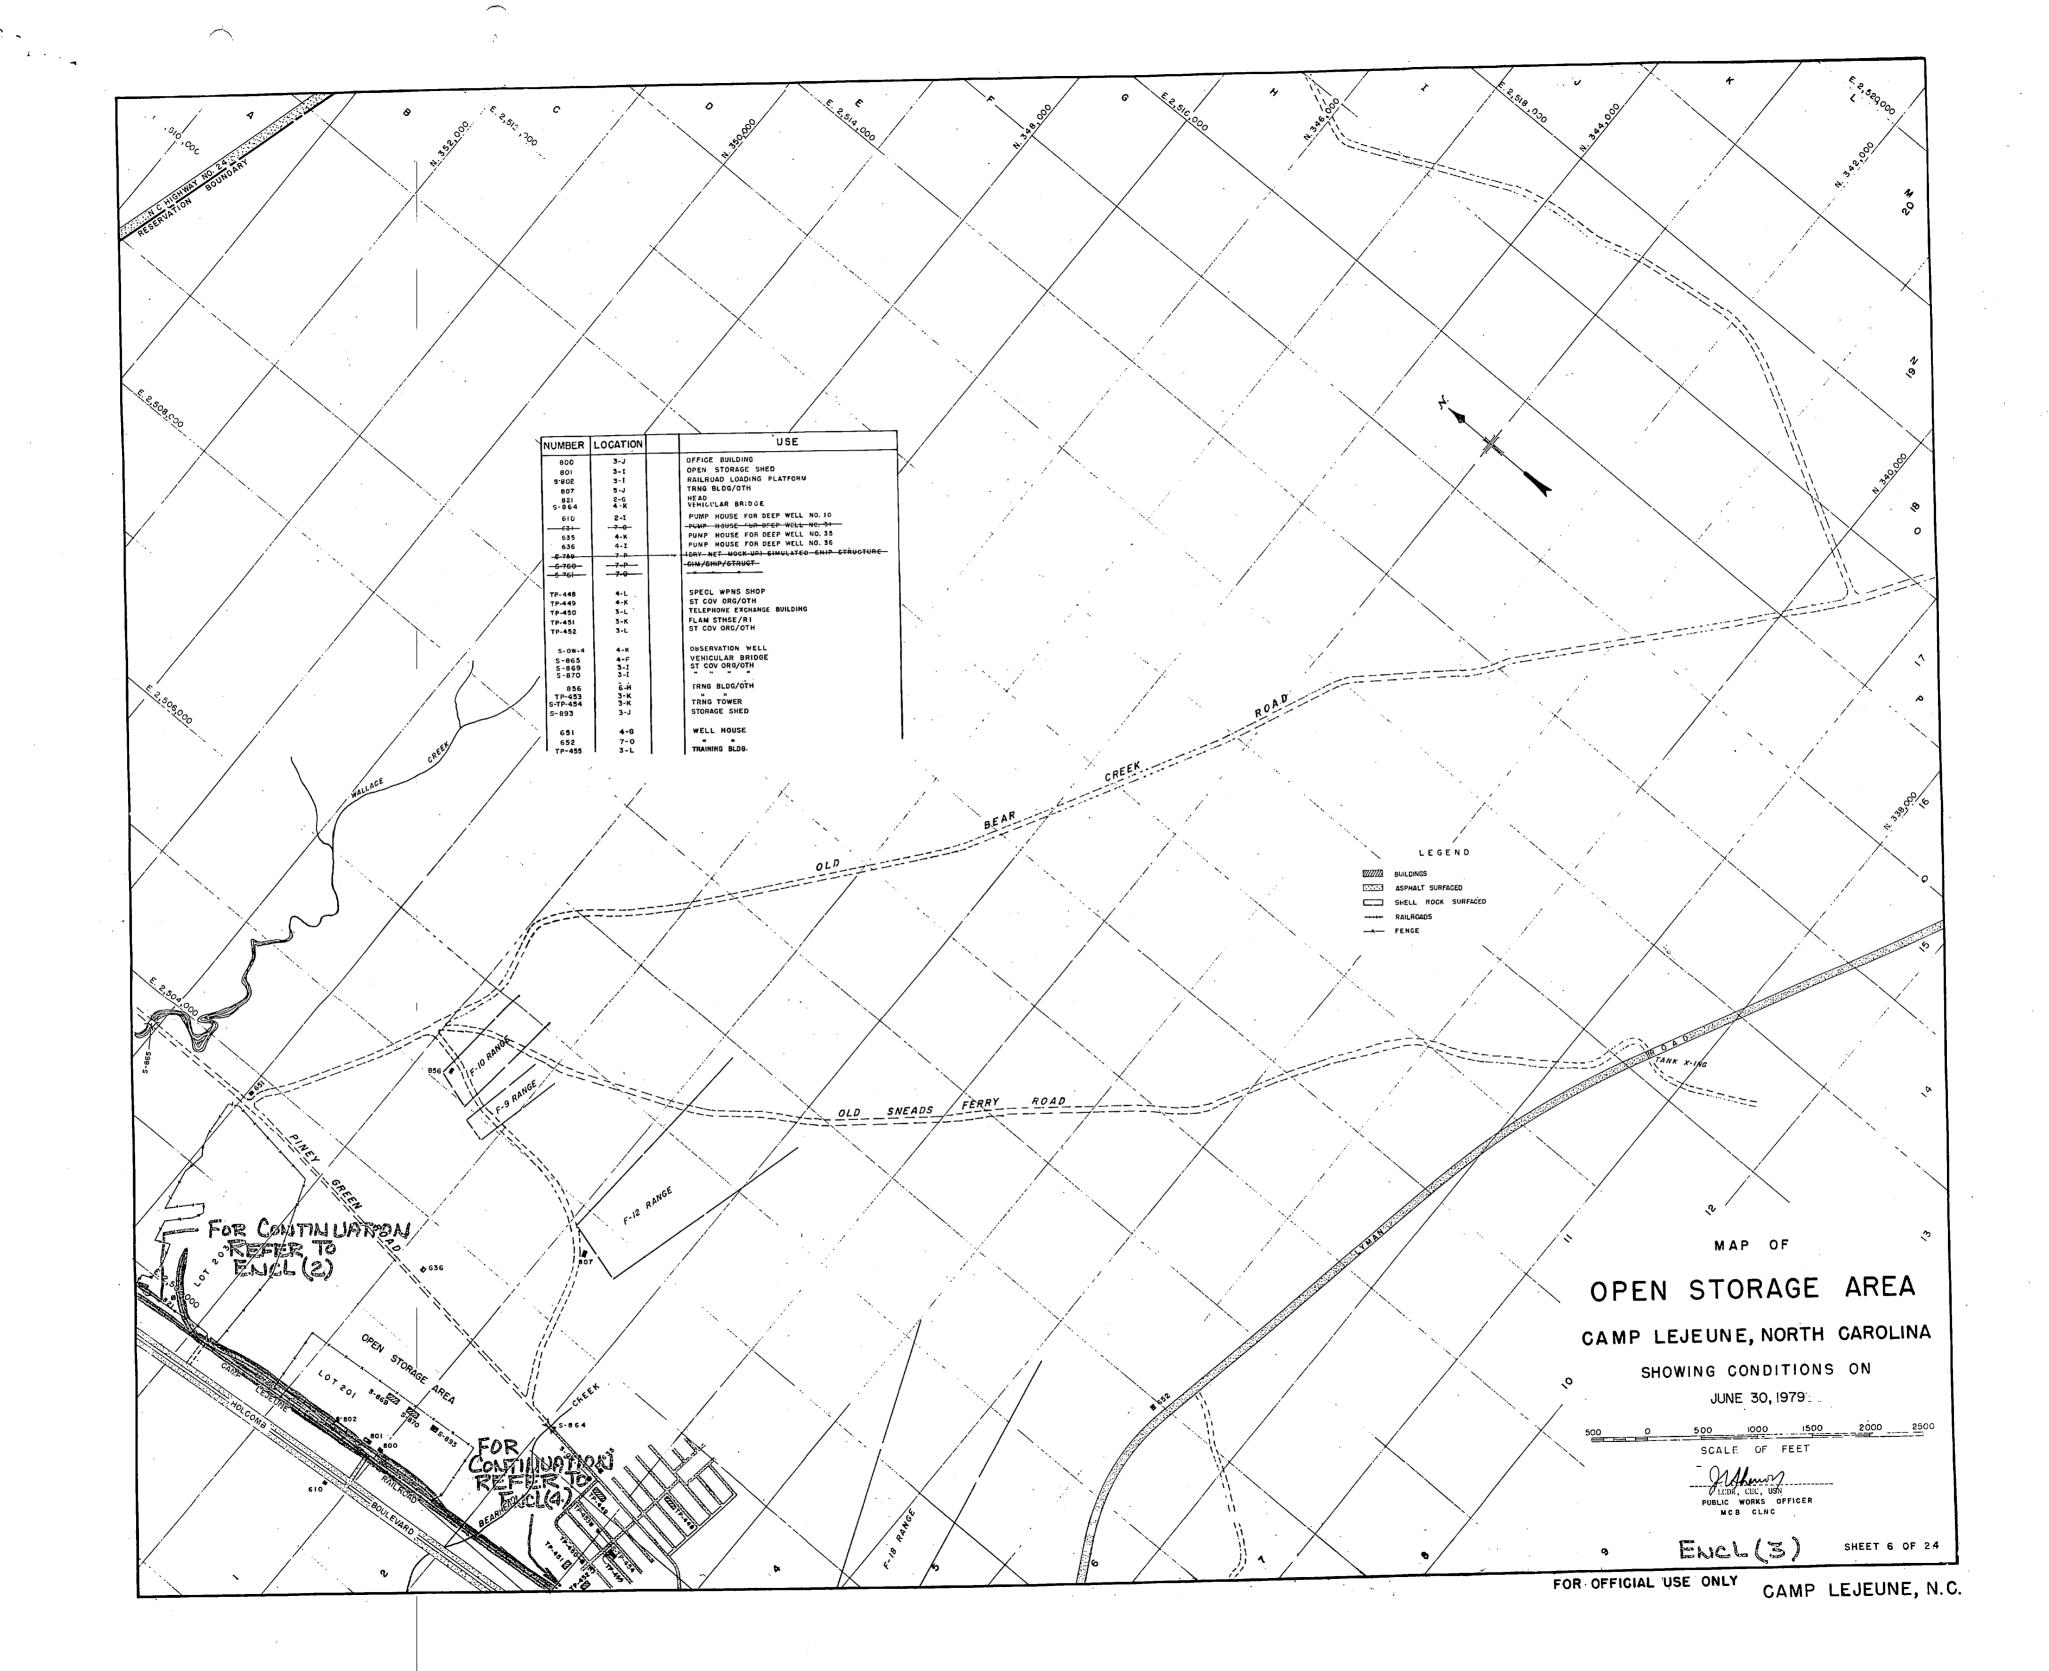

/ \ 4 ļ