

VALUABLE

SUBJECT L.P.G. Area.

Return To  
Public Works  
Office  
Camp Lejeune  
North Carolina

FIELD PARTY

Garner In Charge  
Instrument \_\_\_\_\_  
Notes \_\_\_\_\_  
Tape Read \_\_\_\_\_  
Tape or Rod \_\_\_\_\_  
Tape or Rod \_\_\_\_\_  
Instrument No. \_\_\_\_\_  
Tape No. \_\_\_\_\_

WEATHER

Clear  
Cloudy  
Windy  
Rain  
Fair  
Snow  
Hot  
Moderate  
Cold  
Fog

FILE No. 120-W

Fldr. No. \_\_\_\_\_

Figured By \_\_\_\_\_ Sheet 182

Notes Checked By \_\_\_\_\_

Plotted By \_\_\_\_\_ Date 4-17 1952

Quad. No. \_\_\_\_\_

Station    Dist.    Angle "    +    H. I. Bearing    Ver: Ang. Diff.    Elevation

⊕ Hal. Blvd

Earth Rd.

⊕ P.R.

ele. lower cross arm 40.4  
" top pole 45.4

33'

Proposed  
gas lines

⊕ ← ele. lower cross arm 37.2  
" top pole 41.9

⊕ ← ele. lower cross arm = 35.7  
" top pole = 40.3

⊕ Proposed Rd

⊕ ← ele. lower cross arm = 34.5  
" top pole = 38.8  
3 cross arms

Proposed Gas Line  
P.I.E. ↑

⊕ Hal. Blvd.

Existing tel. Cable  
cable ele. = 23.24

Water line  
H.I. ele. = 23.54

Min. 478  
ele. = 23.59

32.4'

Min. ele. = 18.83







5 + 00  
3 50  

---

8 50

9 31.25  
5  

---

9 26.25  
8 50.00  

---

76.25

raw water from  
E hole.

VALUABLE

SUBJECT Proposed prepare gas Line  
of set distances from Edge of  
Holcomb Blvd.

Return To  
 Public Works  
 Office  
 Camp Lejeune  
 North Carolina

FIELD PARTY

Kellum In Charge  
 \_\_\_\_\_ Instrument  
 \_\_\_\_\_ Notes  
 \_\_\_\_\_ Tape Read  
 \_\_\_\_\_ Tape or Rod  
 \_\_\_\_\_ Instrument No.  
 \_\_\_\_\_ Tape No.

WEATHER


Clear  
 Cloudy  
 Windy  
 Rain  
 Fair

Snow  
 Hot  
 Moderate  
 Cold  
 Fog

FILE No. \_\_\_\_\_  
 Fldr. No. \_\_\_\_\_  
 Sheet 1-67  
 Date 5-18-1951

Quad. No. \_\_\_\_\_

Station	Dist.	Angle "	+	H. I. Bearing	Ver: Ang. Diff.	Elevation
---------	-------	---------	---	---------------	-----------------	-----------

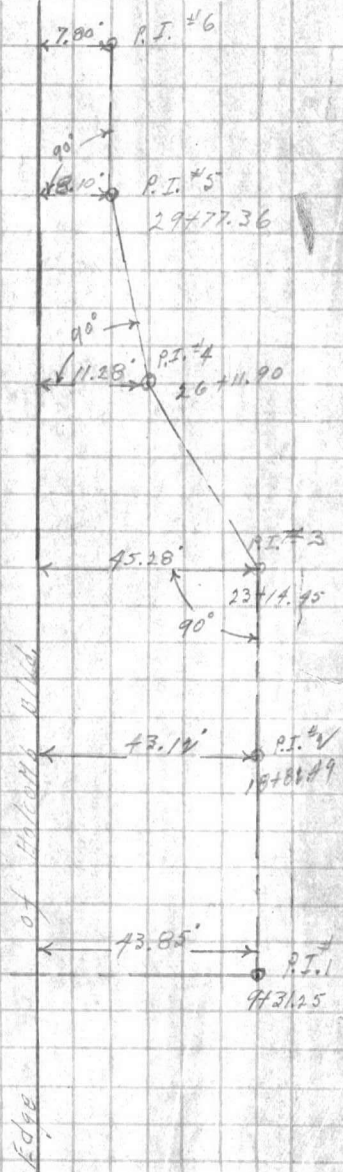



VALUABLE

SUBJECT

Station  
Date  
Time  
Place  
Remarks

Station  
Date  
Time  
Place  
Remarks

H.  
Reading

Bar. and  
Therm.

Time  
of day

Wind  
direction

WEATHER

FIELD PARTY

FIELD NO.

Clear  
Snow  
Hot  
Cloudy  
Rain  
Mist  
Fog  
Thunder  
Storm

in charge  
Instrument  
Notes  
Remarks

Checked by  
Checked by  
Checked by

Time of day  
Time of day  
Time of day

Grade No.

Time of day





**VALUABLE**

SUBJECT *Gas Line offset cont'd.*

Return To  
Public Works  
Office  
Camp Lejeune  
North Carolina

FIELD PARTY


In Charge \_\_\_\_\_  
Instrument \_\_\_\_\_  
Notes \_\_\_\_\_  
Tape Read \_\_\_\_\_  
Tape or Rod \_\_\_\_\_  
Tape or Rod \_\_\_\_\_  
Instrument No. \_\_\_\_\_  
Tape No. \_\_\_\_\_

WEATHER

Clear \_\_\_\_\_  
Cloudy \_\_\_\_\_  
Windy \_\_\_\_\_  
Rain \_\_\_\_\_  
Fair \_\_\_\_\_  
Snow \_\_\_\_\_  
Hot \_\_\_\_\_  
Moderate \_\_\_\_\_  
Cold \_\_\_\_\_  
Fog \_\_\_\_\_

FILE No. \_\_\_\_\_  
Fldr. No. \_\_\_\_\_  
Sheet *8-07*  
Date *5-18-19 51*

Quad. No. \_\_\_\_\_

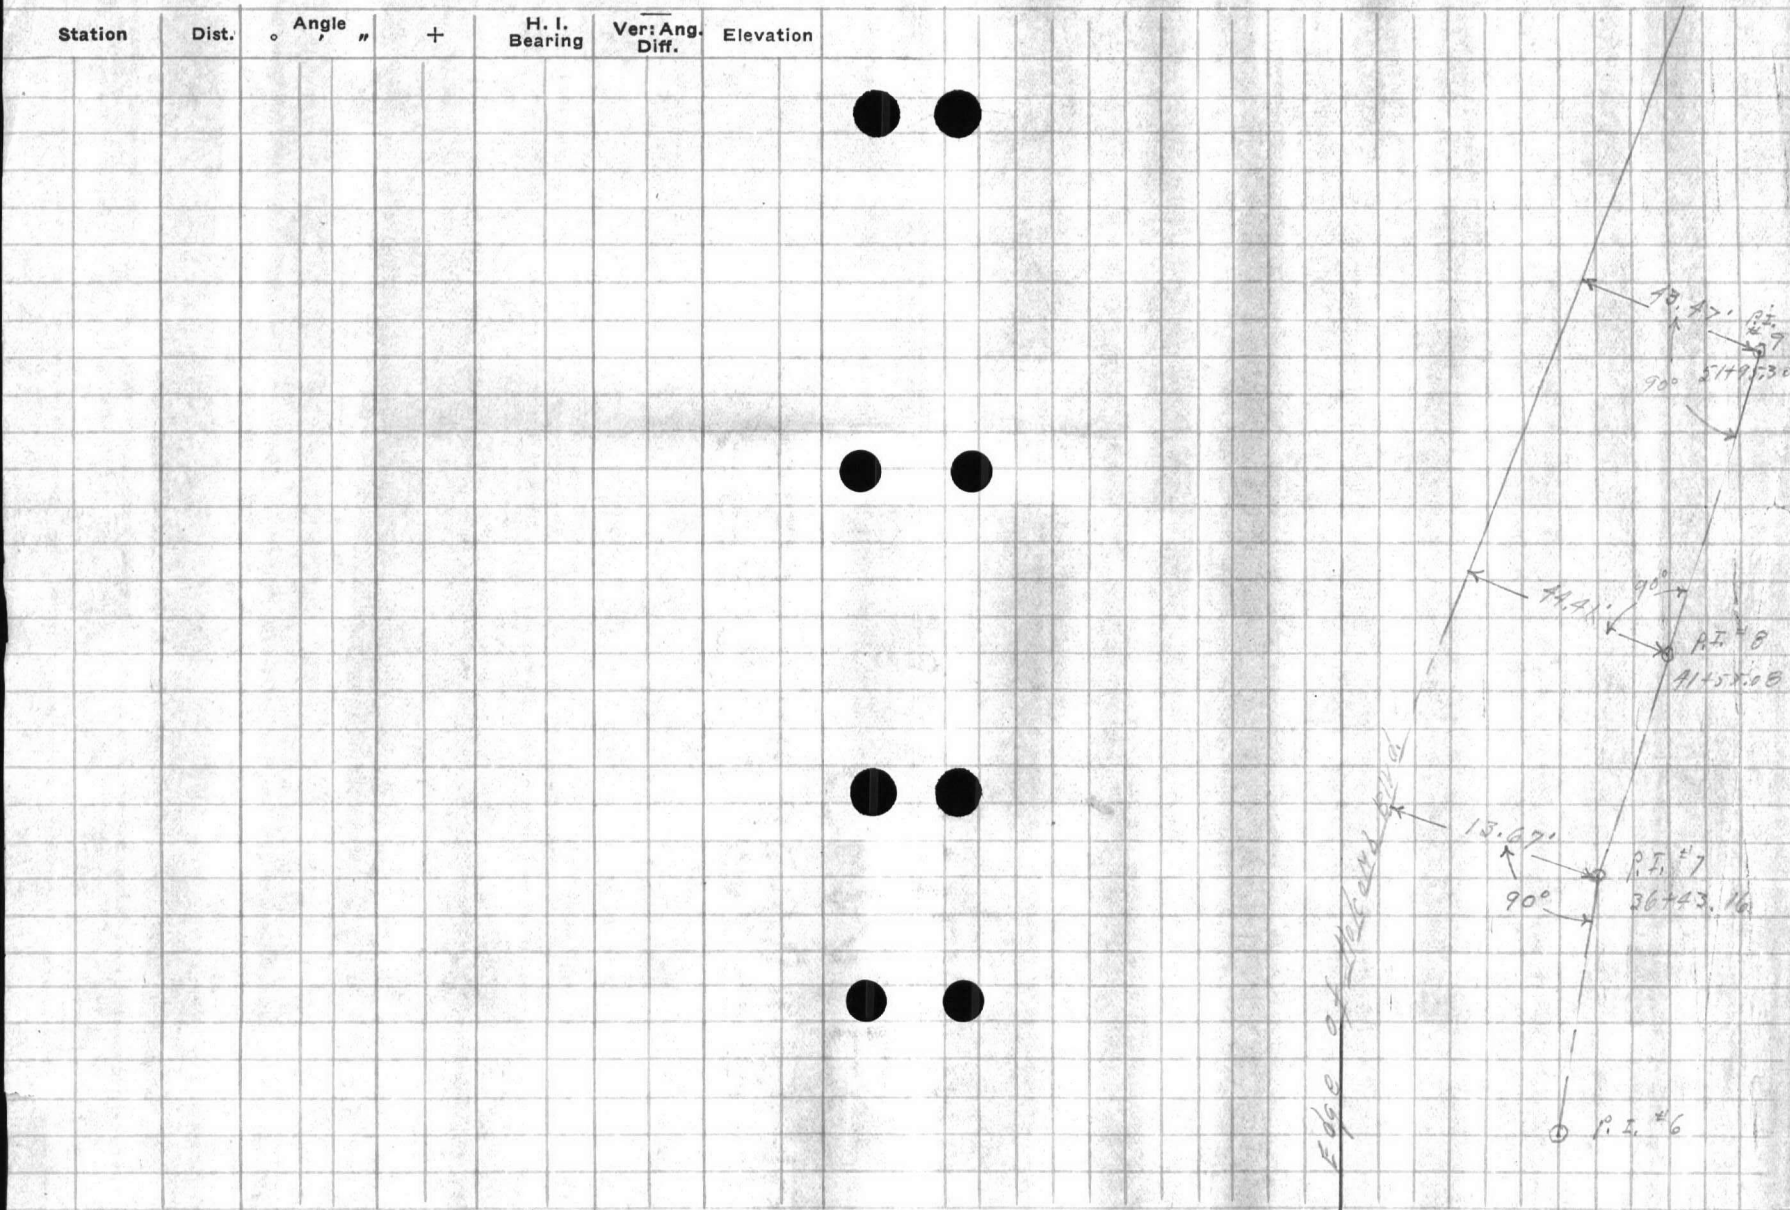

ATTACHED

Return To  
Public Works  
Office  
Camp Lejeune  
North Carolina

SUBJECT

\_\_\_\_\_  
\_\_\_\_\_  
\_\_\_\_\_

Station

Dist

Air

+

Barometric

Vertical

Elevation

FIELD PARTY

in Charge \_\_\_\_\_  
Instrument \_\_\_\_\_  
Notes \_\_\_\_\_  
Type Read \_\_\_\_\_  
Taken on Read \_\_\_\_\_  
Taken on Rod \_\_\_\_\_  
Type No. \_\_\_\_\_  
Treatment No. \_\_\_\_\_


WEATHER

Clear \_\_\_\_\_  
Cloudy \_\_\_\_\_  
Windy \_\_\_\_\_  
Moderate \_\_\_\_\_  
Cold \_\_\_\_\_  
Rain \_\_\_\_\_  
Fog \_\_\_\_\_

FILE NO.

Plotted By \_\_\_\_\_  
Checked By \_\_\_\_\_  
Signed By \_\_\_\_\_  
Date \_\_\_\_\_

Grid No.

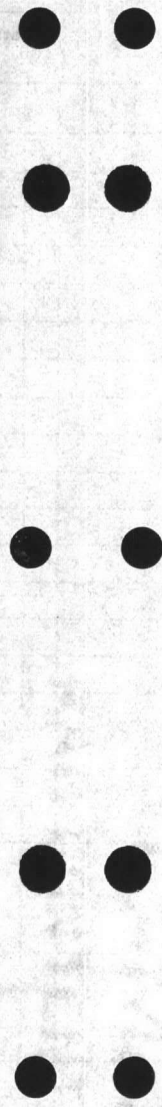

**VALUABLE**

SUBJECT Pos line offset with  
 \_\_\_\_\_  
 \_\_\_\_\_  
 \_\_\_\_\_  
 \_\_\_\_\_

Return To  
 Public Works  
 Office  
 Camp Lejeune  
 North Carolina


FIELD PARTY  
 \_\_\_\_\_ In Charge  
 \_\_\_\_\_ Instrument  
 \_\_\_\_\_ Notes  
 \_\_\_\_\_ Tape Read  
 \_\_\_\_\_ Tape or Rod  
 \_\_\_\_\_ Instrument No.  
 \_\_\_\_\_ Tape No.

WEATHER  
 Clear \_\_\_\_\_  
 Cloudy \_\_\_\_\_  
 Windy \_\_\_\_\_  
 Rain \_\_\_\_\_  
 Fair \_\_\_\_\_  
 Snow \_\_\_\_\_  
 Hot \_\_\_\_\_  
 Moderate \_\_\_\_\_  
 Cold \_\_\_\_\_  
 Fog \_\_\_\_\_  
 Figured By \_\_\_\_\_  
 Notes Checked By \_\_\_\_\_  
 Plotted By \_\_\_\_\_

FILE No. \_\_\_\_\_  
 Fldr. No. \_\_\_\_\_  
 Sheet 3 of  
 Date 5-18-1951

Quad. No. \_\_\_\_\_

Station	Dist.	Angle	"	+	H. I. Bearing	Ver: Ang. Diff.	Elevation
---------	-------	-------	---	---	------------------	--------------------	-----------

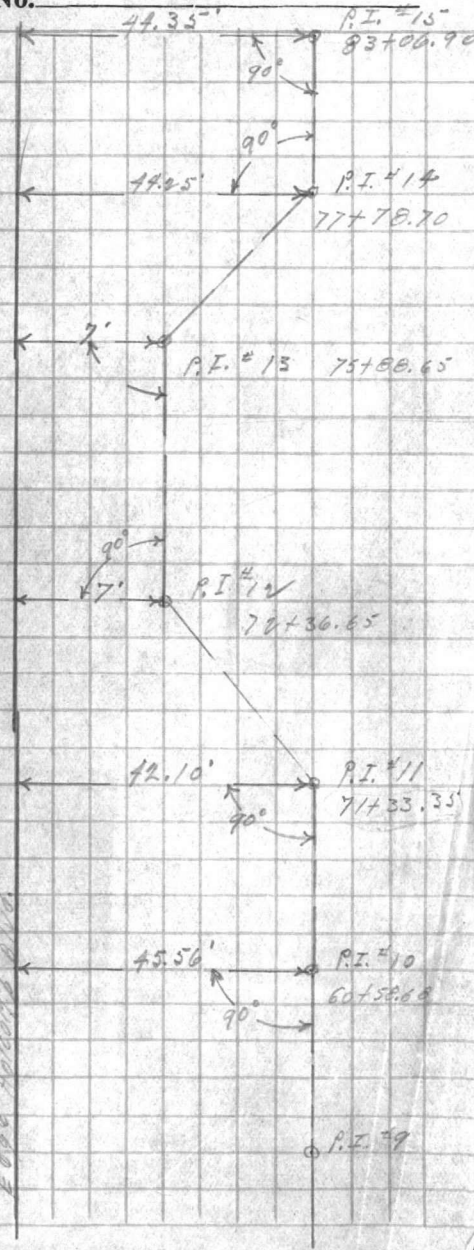



VALUABLE

SUBJECT






Snow \_\_\_\_\_  
 Fog \_\_\_\_\_  
 Rain \_\_\_\_\_  
 Cloud \_\_\_\_\_  
 Windy \_\_\_\_\_  
 Hazy \_\_\_\_\_  
 Clear \_\_\_\_\_

FILE No. \_\_\_\_\_  
 Plot No. \_\_\_\_\_  
 Sheet \_\_\_\_\_  
 Pinned By \_\_\_\_\_  
 Date Checked By \_\_\_\_\_  
 Pinned By \_\_\_\_\_  
 Date \_\_\_\_\_

Quadr. No. \_\_\_\_\_

Station \_\_\_\_\_  
 Dist. \_\_\_\_\_  
 Angle \_\_\_\_\_  
 + \_\_\_\_\_  
 H. Sighting \_\_\_\_\_  
 V. Sighting \_\_\_\_\_  
 Elev. \_\_\_\_\_  
 Dip \_\_\_\_\_

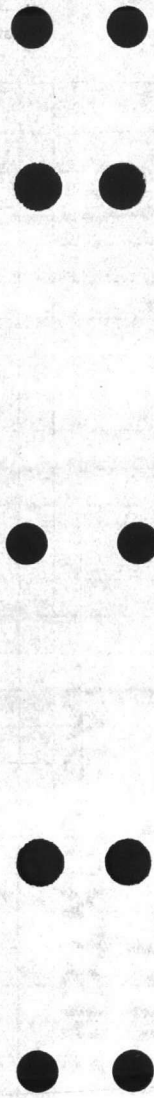

VALUABLE

SUBJECT Gas Line offset cont.

Return To  
Public Works  
Office  
Camp Lejeune  
North Carolina

FIELD PARTY

\_\_\_\_ In Charge  
\_\_\_\_ Instrument  
\_\_\_\_ Notes  
\_\_\_\_ Tape Read  
\_\_\_\_ Tape or Rod  
\_\_\_\_ Tape or Rod  
\_\_\_\_ Instrument No.  
\_\_\_\_ Tape No.

WEATHER

Clear  
Cloudy  
Windy  
Rain  
Fair  
Snow  
Hot  
Moderate  
Cold  
Fog

FILE No. \_\_\_\_\_

Fldr. No. \_\_\_\_\_


Figured By \_\_\_\_\_ Sheet 4 of

Notes Checked By \_\_\_\_\_

Plotted By \_\_\_\_\_ Date 5-18-1951

Quad. No. \_\_\_\_\_

Station	Dist.	Angle	"	+	H. I. Bearing	Ver: Ang. Diff.	Elevation
---------	-------	-------	---	---	------------------	--------------------	-----------

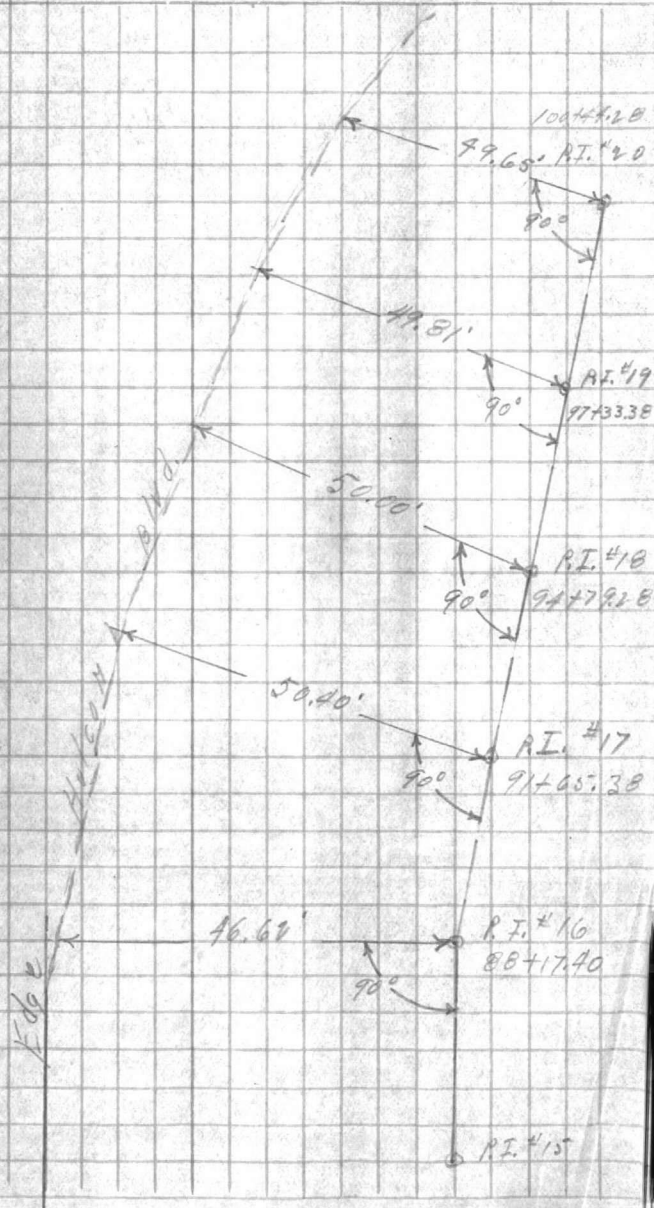




FIELD PARTY

In Charge  
Assignment  
Notes  
Type Road  
Type or Rod  
Type or Rod  
Tape No.


WEATHER

Clear  
Snow  
Mist  
Windy  
Mist  
Cold  
Fog  
Faint  
Signed By  
Notes Checked By  
Plotted By

FIELD NO.

Sheet  
Date

Grid No.

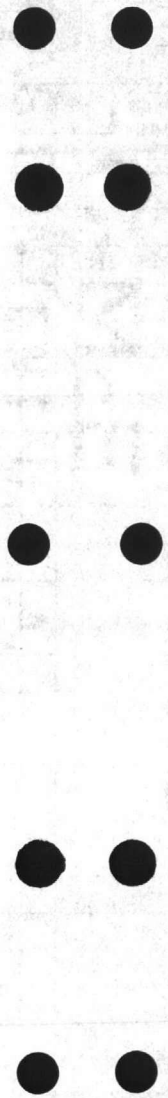



VALUABLE

SUBJECT *Gas Line offset contd.*

Return To  
Public Works  
Office  
Camp Lejeune  
North Carolina

FIELD PARTY

           In Charge  
           Instrument  
           Notes  
           Tape Read  
           Tape or Rod  
           Instrument No.  
           Tape No.

WEATHER

           Clear  
           Cloudy  
           Windy  
           Rain  
           Fair  
           Snow  
           Hot  
           Moderate  
           Cold  
           Fog  
Figured By             
Notes Checked By             
Plotted By           

FILE No.           

Fldr. No.           

Sheet 50f

Date 5-18-1951

Quad. No.           

Station	Dist.	o Angle "	+	H. I. Bearing	Ver: Ang. Diff.	Elevation
---------	-------	-----------------	---	------------------	--------------------	-----------



*Holcomb Blvd.*

← 40.90' → P.I. # 24  
1394 37.45

← 42.87' → P.I. # 23  
126409 86

← 41.12' → P.I. # 22  
111478.30

← 42.22' → P.I. # 21  
104488.44

○ P.I. # 20

90°

*Edge*



SUBJECT

Station Date Angle Bearing Vert. Ang. Elevation

FIELD PART

In Charge  
Instrument  
Notes  
Tape Head  
Type of Rod  
Type of Rod  
Instrument No.  
Tape No.

WEATHER


Clear  
Snow  
Hot  
Cloudy  
Windy  
Mossy  
Rain  
Cold  
Fog  
Faded By  
Notes Checked By  
Plotted By  
Date

FILE NO

Plot No

Sheet

Class No

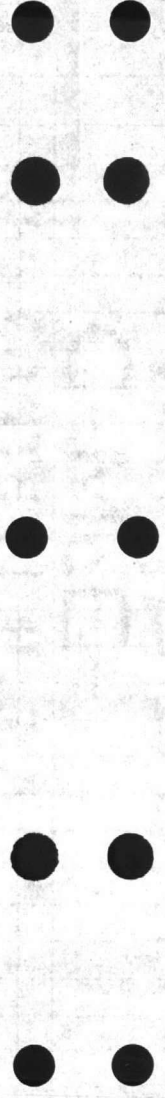

**VALUABLE**

SUBJECT \_\_\_\_\_  
 \_\_\_\_\_  
 \_\_\_\_\_  
 \_\_\_\_\_

Return To  
 Public Works  
 Office  
 Camp Lejeune  
 North Carolina

**FIELD PARTY**

\_\_\_\_\_ In Charge  
 \_\_\_\_\_ Instrument  
 \_\_\_\_\_ Notes  
 \_\_\_\_\_ Tape Read  
 \_\_\_\_\_ Tape or Rod  
 \_\_\_\_\_ Tape or Rod  
 \_\_\_\_\_ Instrument No.  
 \_\_\_\_\_ Tape No.

**WEATHER**

Clear  
 Cloudy  
 Windy  
 Rain  
 Fair

Snow  
 Hot  
 Moderate  
 Cold  
 Fog

FILE No. \_\_\_\_\_

Fldr. No. \_\_\_\_\_


Figured By \_\_\_\_\_ Sheet \_\_\_\_\_

Notes Checked By \_\_\_\_\_

Plotted By \_\_\_\_\_ Date \_\_\_\_\_ 19\_\_

Quad. No. \_\_\_\_\_

Station	Dist.	Angle	"	+	H. I. Bearing	Ver: Ang. Diff.	Elevation
---------	-------	-------	---	---	------------------	--------------------	-----------

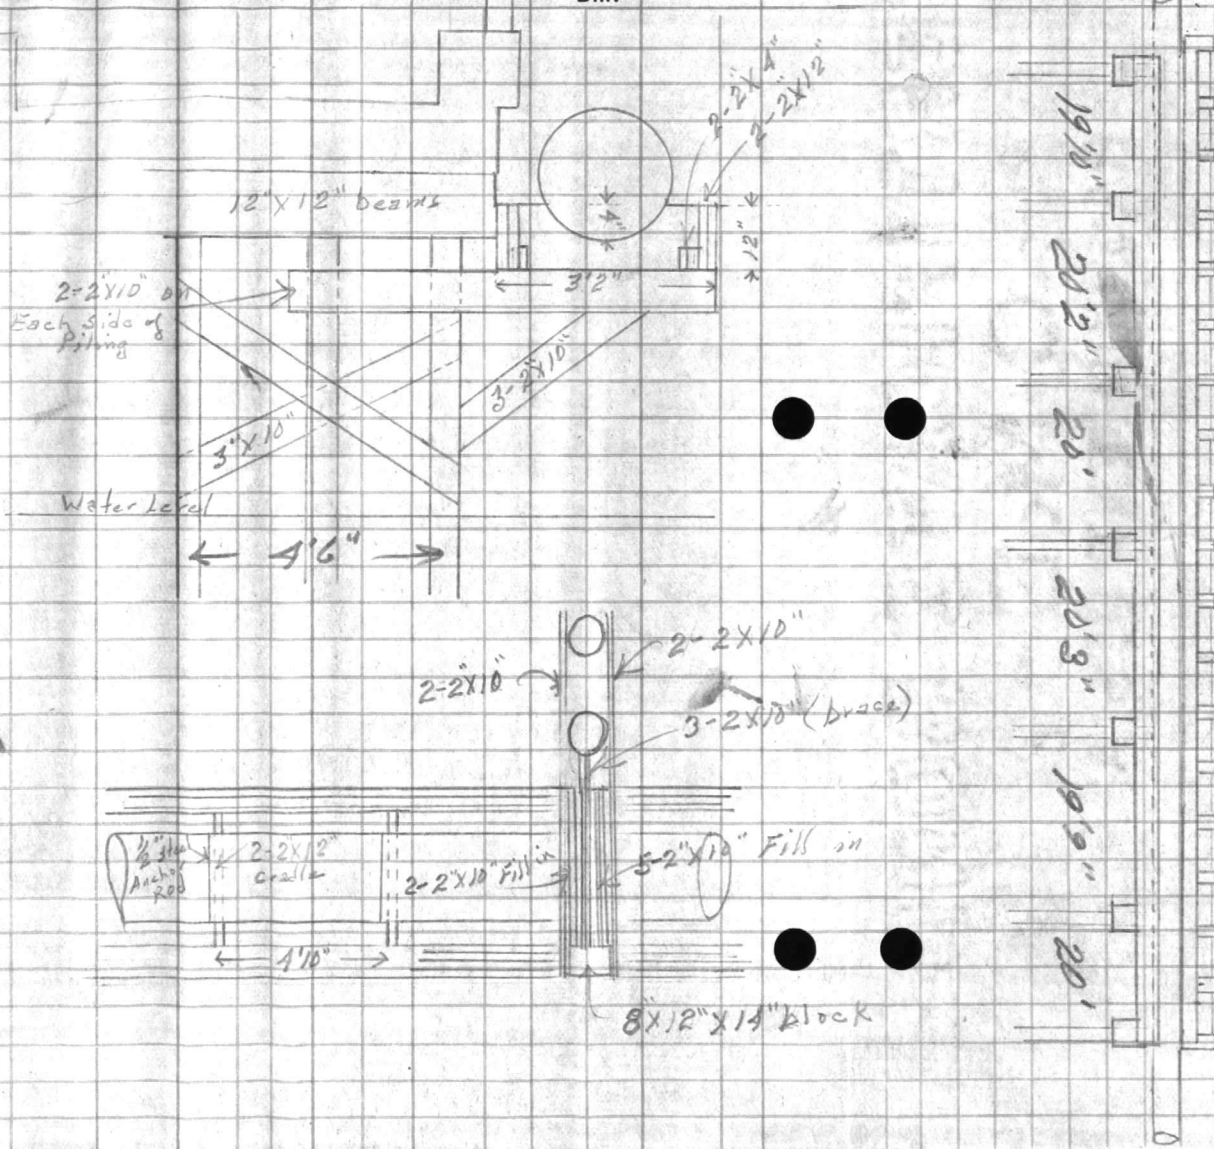






Subject

\_\_\_\_\_

\_\_\_\_\_

Station

Dist.

Mile

+

Meaning

Vertical

Elevation

FIELD PARTY

In Charge \_\_\_\_\_

Instrument \_\_\_\_\_

Notes \_\_\_\_\_

Tapo Road \_\_\_\_\_

Tapo or Red \_\_\_\_\_

Tapo or Red \_\_\_\_\_

Instrument No. \_\_\_\_\_

Tapo No. \_\_\_\_\_

WEATHER

Cloud \_\_\_\_\_

Wind \_\_\_\_\_

Temp \_\_\_\_\_

Humidity \_\_\_\_\_

Notes \_\_\_\_\_

Notes \_\_\_\_\_

Notes \_\_\_\_\_

Notes \_\_\_\_\_

LINE No.

Station No.

Date

Date

Date

Vertical  
Elevation

VALUABLE

SUBJECT

Topog. Gas Line

Continued

Return To  
Public Works  
Office  
Camp Lejeune  
North Carolina

## FIELD PARTY

Hamilton In Charge

Instrument

Notes

Tape Read

Tape or Rod

Tape or Rod

Instrument No.

Tape No.

## WEATHER

Clear  
Cloudy  
Windy  
Rain  
Fair

Snow  
Hot  
Moderate  
Cold  
Fog

FILE No. \_\_\_\_\_

Fldr. No. \_\_\_\_\_

Sheet 101Date 3-2 1951

Figured By \_\_\_\_\_

Notes Checked By \_\_\_\_\_

Plotted By \_\_\_\_\_

Quad. No. \_\_\_\_\_

Station	Dist.	Angle " +	H. I. Bearing	Ver: Ang. Diff.	Elevation
7+80					3.5 below ground - Top Water Line to Midway PK
14+34					PP 13.5 Lt Rt
16+01					PP 13' Lt Rt
16+01					Woods Line 9' Rt
16+01					Edge Pavement 13.3 Lt
17+88					PP 13.5 Lt
19+62					PP 13.5
21+41					PP 13.5 Lt
21+41					Woods 8 Rt
22+70					Guy wire 13.5 Lt
23+04					PP 15' Lt
24+45	PI				Edge Pavement 15.5 Lt
+38					Guy wire 15' Lt
24+88					PP 5' Rt
26+1190	PI				Edge Pavement 11.8 Lt
26+79					PP 20' Rt





FIELD PARTY

In Charge \_\_\_\_\_  
Assistant \_\_\_\_\_  
Notes \_\_\_\_\_  
Time Used \_\_\_\_\_  
Type of Rod \_\_\_\_\_  
Notes Checked BY \_\_\_\_\_  
Plotted BY \_\_\_\_\_

WEATHER

Clear \_\_\_\_\_  
Cloudy \_\_\_\_\_  
Light \_\_\_\_\_  
Moderate \_\_\_\_\_  
Rain \_\_\_\_\_  
Cold \_\_\_\_\_  
Fog \_\_\_\_\_

FILE NO.

Date \_\_\_\_\_  
Sheet \_\_\_\_\_

Quadr. No.






**VALUABLE**

SUBJECT

*topog on Gas Line  
cont'd.*

Return To  
Public Works  
Office  
Camp Lejeune  
North Carolina.

**FIELD PARTY**

In Charge \_\_\_\_\_  
Instrument \_\_\_\_\_  
Notes \_\_\_\_\_  
Tape Read \_\_\_\_\_  
Tape or Rod \_\_\_\_\_  
Tape or Rod \_\_\_\_\_  
Instrument No. \_\_\_\_\_  
Tape No. \_\_\_\_\_

**WEATHER**

Clear \_\_\_\_\_  
Cloudy \_\_\_\_\_  
Windy \_\_\_\_\_  
Rain \_\_\_\_\_  
Fair \_\_\_\_\_  
Snow \_\_\_\_\_  
Hot \_\_\_\_\_  
Moderate \_\_\_\_\_  
Cold \_\_\_\_\_  
Fog \_\_\_\_\_  
Figured By \_\_\_\_\_  
Notes Checked By \_\_\_\_\_  
Plotted By \_\_\_\_\_

FILE No. \_\_\_\_\_

Fldr. No. \_\_\_\_\_

Sheet *29*

Date *3-2-1951*

Quad. No. \_\_\_\_\_

Station	Dist.	Angle " "	+	H. I. Bearing	Ver: Ang. Diff.	Elevation	
28+39							PP 22' RT
29+77	33	PL					Edge Pavement 8.4 Lt
30+25							PP 22' RT
+65							5.3 below ground - Tap 18" R.C.P.
31+97							PP 22' RT
32+06							3.8 below ground - Tap 18" R.C.P.
33+69							PP 18' RT
35+00							Edge Holcomb Blvd 16.5 Left
35+46							PP 8' RT
37+10							PP 8' RT
38+00							Brush Line 9' RT.
38+33							" " 4' RT.
38+87							PP 16' Left
39+00							Brush Line 5' RT.
39+30							12" Pine tree 7' RT.
39+87							Brush Line 5' RT.
40+46							PP 15' Left
44+16							90° wire anchor on line

FIELD NO.

SUBJECT

Return to  
Public Works  
Office  
Camp Station  
North Carolina

WEATHER

FIELD PARTY

FILE NO.

Clear  
Snow  
Cloudy  
Fog  
Mist  
Moderate  
Cold  
Fog  
Fog

in Charge  
Assistant  
Notes

FILE NO.

Plotted by  
Notes Checked by  
Plotted by

Notes  
Type of

Sheet

Date

Plotted by

Type of

Station  
Elevation

Base

Angle

Station





AVAILABLE

Return To  
Public Works  
Office  

















**VALUABLE**

Return To  
Public Works  
Office  
Camp Lejeune  
North Carolina

SUBJECT

*topog on eas line  
contd.*

**FIELD PARTY**

\_\_\_\_\_ In Charge  
\_\_\_\_\_ Instrument  
\_\_\_\_\_ Notes  
\_\_\_\_\_ Tape Read  
\_\_\_\_\_ Tape or Rod  
\_\_\_\_\_ Tape or Rod  
\_\_\_\_\_ Instrument No.  
\_\_\_\_\_ Tape No.

**WEATHER**

Clear \_\_\_\_\_  
Cloudy \_\_\_\_\_  
Windy \_\_\_\_\_  
Rain \_\_\_\_\_  
Fair \_\_\_\_\_  
Snow \_\_\_\_\_  
Hot \_\_\_\_\_  
Moderate \_\_\_\_\_  
Cold \_\_\_\_\_  
Fog \_\_\_\_\_  
Figured By \_\_\_\_\_  
Notes Checked By \_\_\_\_\_  
Plotted By \_\_\_\_\_

FILE No. \_\_\_\_\_

Fldr. No. \_\_\_\_\_

Sheet

*40f*

Date

*3-2-1951*

Quad. No. \_\_\_\_\_

Station	Dist.	Angle "	+	H. I. Bearing	Ver: Ang. Diff.	Elevation	
<i>56+23</i>							<i>PP 14' Left</i>
<i>58+94</i>							<i>PP 14' Left</i>
<i>59+72</i>							<i>PP 14' Left</i>
<i>59+75</i>							<i>woods line 2' Rt.</i>
<i>60+00</i>							<i>woods line 8' Rt.</i>
<i>61+45</i>							<i>PP 14' Left</i>
<i>61+45</i>							<i>Guy wire anchor 12' Rt.</i>
<i>62+00</i>							<i>woods line 16' Rt.</i>
<i>63+19</i>							<i>PP 14' Left</i>
<i>63+19</i>							<i>Guy wire anchor 7' Rt.</i>
<i>64+33</i>							<i>wood line 6' Rt.</i>
<i>64+95</i>							<i>PP 14' Left</i>
<i>66+00</i>							<i>wood line 8' Rt.</i>
<i>66+53</i>							<i>PP 14' Left</i>
<i>67+00</i>							<i>wood line 2' Rt.</i>
<i>68+00</i>							<i>" " 9' Rt.</i>

AVAILABLE

Region  
Public Works  
Office  
Geographical  
North Carolina

Project

Station

Dist

Angle

H. I.  
Sounding

Van. And  
Elevation

FIELD PARTY

In Charge

Instrument

Notes

Tape Read

Face of Rod

Face of Rod

Instrument

Tape No.

WEATHER

Clear

Cloudy

Wet

Moderate

Wind

Rain

Fair

Snow

Ice

Fog

Thunder

Lightning

Other

FIELD No.

Field Notes

Sheet

Date

Sheet No.




**VALUABLE**

SUBJECT topog on gas lines  
cont'd.

Return To  
 Public Works  
 Office  
 Camp Lejeune  
 North Carolina

**FIELD PARTY**

\_\_\_\_\_ In Charge  
 \_\_\_\_\_ Instrument  
 \_\_\_\_\_ Notes  
 \_\_\_\_\_ Tape Read  
 \_\_\_\_\_ Tape or Rod  
 \_\_\_\_\_ Tape or Rod  
 \_\_\_\_\_ Instrument No.  
 \_\_\_\_\_ Tape No.

**WEATHER**

Clear \_\_\_\_\_  
 Cloudy \_\_\_\_\_  
 Windy \_\_\_\_\_  
 Rain \_\_\_\_\_  
 Fair \_\_\_\_\_  
 Snow \_\_\_\_\_  
 Hot \_\_\_\_\_  
 Moderate \_\_\_\_\_  
 Cold \_\_\_\_\_  
 Fog \_\_\_\_\_

FILE No. \_\_\_\_\_

Fldr. No. \_\_\_\_\_

Figured By \_\_\_\_\_  
 Notes Checked By \_\_\_\_\_  
 Plotted By \_\_\_\_\_

Sheet 5-0f

Date 3-2- 1951

Quad. No. \_\_\_\_\_

Station	Dist.	Angle	"	+	H. I. Bearing	Ver: Ang. Diff.	Elevation	
68+16								PP 12' left
70+02								PP 12' left
70+02								Guy wire anchor 10.5" rt.
70+02								Wood Line 11' rt.
71+33								" " 11' rt.
71+74								" " 5' rt.
71+93								PP 8' rt.
72+36.65								Holcomb rd. 7' left
73+81								PP 23' rt.
74+10								End of 36" RCP 73' rt.
75+50								PP 22' rt.
77+34								PP 6' left
78+70								Edge Pavement 41.4 left
78+70								Wood Line 12' rt.
79+11								PP 15' left
762								Guy wire 14.5 left

VALUABLE  
Return To  
Public Works  
Office  
Camp Lejeune  
North Carolina

SUBJECT

Section      Dist.      Angle      Bearing      Lev. Ang.      Elevation

FIELD PARTY  
In Charge  
Instrument  
Notes  
Time  
Checked by  
Checked by  
Checked by  
Checked by

WEATHER  
Clear  
Snow  
Cloudy  
Mist  
Moderate  
Rain  
Cold  
Fog  
Faint  
By  
Checked by  
Checked by  
Checked by  
Checked by

FILE NO.  
FIELD NO.  
Sheet  
Date

**VALUABLE**

SUBJECT \_\_\_\_\_  
 \_\_\_\_\_  
 \_\_\_\_\_  
 \_\_\_\_\_  
 \_\_\_\_\_

Return To  
 Public Works  
 Office  
 Camp Lejeune  
 North Carolina

**FIELD PARTY**

\_\_\_\_\_ In Charge  
 \_\_\_\_\_ Instrument  
 \_\_\_\_\_ Notes  
 \_\_\_\_\_ Tape Read  
 \_\_\_\_\_ Tape or Rod  
 \_\_\_\_\_ Tape or Rod  
 \_\_\_\_\_ Instrument No.  
 \_\_\_\_\_ Tape No.

**WEATHER**

Clear  
 Cloudy  
 Windy  
 Rain  
 Fair  
 Snow  
 Hot  
 Moderate  
 Cold  
 Fog  
 Figured By \_\_\_\_\_  
 Notes Checked By \_\_\_\_\_  
 Plotted By \_\_\_\_\_

FILE No. \_\_\_\_\_  
 Fldr. No. \_\_\_\_\_  
 Sheet 6 of \_\_\_\_\_  
 Date \_\_\_\_\_ 19\_\_

Quad. No. \_\_\_\_\_

Station	Dist.	Angle "	+	H. I. Bearing	Ver: Ang. Diff.	Elevation	
80+77							guy wire 17' Rt
+85							PP 14.5'
82+76							PP 14' Lt
84+37							PP 17' Lt
84+37							Woods Line 11' Rt
84+57							guy wire 17' Lt
86+13							PP 21' Lt
87+85							PP 23' Lt
88+17 40							Edge Pavement 46.7' Lt
88+17 40							Woods Line 12' Rt
89+59							PP 22' Lt
89+59							Woods Line 2' Rt
91+06							guy wire 29' Lt
91+31							PP 25' Lt
91+60							guy wire 25' Lt



TABLE

SUBJECT

Return T.  
Public Works  
Dist.  
Camp Lejeune  
North Carolina

Station

Date

Region

Serial

Vol. and  
Dist. Elevation



























































VALUABLE

SUBJECT \_\_\_\_\_

 Return To  
 Public Works  
 Office  
 Camp Lejeune  
 North Carolina

## FIELD PARTY

 \_\_\_\_\_ In Charge  
 \_\_\_\_\_ Instrument  
 \_\_\_\_\_ Notes  
 \_\_\_\_\_ Tape Read  
 \_\_\_\_\_ Tape or Rod  
 \_\_\_\_\_ Tape or Rod  
 \_\_\_\_\_ Instrument No.  
 \_\_\_\_\_ Tape No.

## WEATHER

 Clear  
 Cloudy  
 Windy  
 Rain  
 Fair  
 Snow  
 Hot  
 Moderate  
 Cold  
 Fog

FILE No. \_\_\_\_\_

Fldr. No. \_\_\_\_\_

Sheet 2 of

Date \_\_\_\_\_ 19\_\_

 Figured By \_\_\_\_\_  
 Notes Checked By \_\_\_\_\_  
 Plotted By \_\_\_\_\_

Quad. No. \_\_\_\_\_

Station	Dist.	°	Angle	"	+	H. I. Bearing	Ver: Ang Diff.	Elevation
<u>91+65 38</u>								
<u>91+65 38</u>								
93+05								
93+05								
94+56								
94+77								
<u>94+79 28</u>								
<u>94+79 28</u>								
95+0								
96+57								
96+57								
<u>97+33 38</u>								
97+98								
98+25								
98+53								

Edge of Pavement 30.5 Lt

Woods Line 6' Rt

PP 20' Lt

Woods Line 4' Rt

guy wire 20' Lt

PP 20' Lt

Edge Pavement 50' Lt

Woods Line 10' Rt

guy wire 19' Lt

PP 15' Lt

Woods Line 18' Rt

Edge Pavement 50' Lt

guy wire 27' Lt

PP 25' Lt

guy wire 29' Lt

VALUABLE























VALUABLE

SUBJECT \_\_\_\_\_

 Return To  
 Public Works  
 Office  
 Camp Lejeune  
 North Carolina

## FIELD PARTY

 \_\_\_\_\_ In Charge  
 \_\_\_\_\_ Instrument  
 \_\_\_\_\_ Notes  
 \_\_\_\_\_ Tape Read  
 \_\_\_\_\_ Tape or Rod  
 \_\_\_\_\_ Instrument No.  
 \_\_\_\_\_ Tape No.

## WEATHER

 Clear  
 Cloudy  
 Windy  
 Rain  
 Fair

 Snow  
 Hot  
 Moderate  
 Cold  
 Fog

FILE No. \_\_\_\_\_

Fldr. No. \_\_\_\_\_

Sheet 5 of

Date \_\_\_\_\_ 19\_\_

Figured By \_\_\_\_\_

Notes Checked By \_\_\_\_\_

Plotted By \_\_\_\_\_

Quad. No. \_\_\_\_\_

Station	Dist.	Angle " "	+	H. I. Bearing	Ver: Ang. Diff.	Elevation
99+0						
99+96						
100+44 <sup>28</sup>						
100+44 <sup>28</sup>						
101+44						
101+70						
101+70						
102+0						
103+42						
103+42						
104+89 <sup>44</sup>						
105+19						
105+22						
106+93						
108+62						

Woods Line 0.0

PP 15' Lt

Edge Pavement 49.7

Woods Line 11' Rt

guy wire 27' Lt

PP 25' Lt

Woods Line 0.0

guy wire 29' Lt

PP 18' Lt

Woods Line 12' Rt

Edge Pavement 42.4 Lt

PP 12.4 Lt

guy wire 6' Rt

PP 12' Lt

PP 12' Lt

VALUABLE

SUBJECT

Return To  












VALUABLE

SUBJECT \_\_\_\_\_

 Return To  
 Public Works  
 Office  
 Camp Lejeune  
 North Carolina

## FIELD PARTY

 \_\_\_\_\_ In Charge  
 \_\_\_\_\_ Instrument  
 \_\_\_\_\_ Notes  
 \_\_\_\_\_ Tape Read  
 \_\_\_\_\_ Tape or Rod  
 \_\_\_\_\_ Tape or Rod  
 \_\_\_\_\_ Instrument No.  
 \_\_\_\_\_ Tape No.

## WEATHER

 Clear  
 Cloudy  
 Windy  
 Rain  
 Fair  
 Snow  
 Hot  
 Moderate  
 Cold  
 Fog

FILE No. \_\_\_\_\_

Fldr. No. \_\_\_\_\_

Sheet 90

Date \_\_\_\_\_ 19\_\_

 Figured By \_\_\_\_\_  
 Notes Checked By \_\_\_\_\_  
 Plotted By \_\_\_\_\_

Quad. No. \_\_\_\_\_

Station	Dist.	Angle ' "	+	H. I. Bearing	Ver: Ang. Diff.	Elevation	
110+11							guy wire 12' Lt
110+29							PP 12' Lt Woods Line 14' Rt
111+78 <sup>30</sup>							Edge Perament 11.4 Lt
111+83							guy wire 12' Lt
112+0							guy wire 7' Rt
112+10							PP 11' Lt
112+49							guy wire 11' Lt
113+47							PP 11' Lt
114+84							PP 12' Lt
116+13							PP 12' Lt
117+56							PP 12' Lt
117+58							Elec. Cable 2.2 below ground
117+75							guy wire 12' Lt
118+10							PP 13' Lt
120+67							PP 12' Lt

Note: Beginning at sta 120  
Row of small oaks planted  
6' 0" Right of Line



VARIABLE

SUBJECT

North Carolina

FIELD PARTY

Name of Party  
to Charge  
Instrument  
Notes  
Type Read  
Time of Day  
Notes Checked By  
Type of Rod

WEATHER

Clear  
Snow  
Fog  
Windy  
Rain  
Fog  
Other  
Notes

Pipe No

Pipe No

Sheet

Date

Sheet No

Station  
Dist  
Angle  
Bearing  
Vertical  
Elevation

10  
11  
































VALUABLE

SUBJECT \_\_\_\_\_

Return To  
Public Works  
Office  
Camp Lejeune  
North Carolina

## FIELD PARTY

\_\_\_\_\_ In Charge  
\_\_\_\_\_ Instrument  
\_\_\_\_\_ Notes  
\_\_\_\_\_ Tape Read  
\_\_\_\_\_ Tape or Rod  
\_\_\_\_\_ Tape or Rod  
\_\_\_\_\_ Instrument No.  
\_\_\_\_\_ Tape No.

## WEATHER

Clear  
Cloudy  
Windy  
Rain  
Fair

Snow  
Hot  
Moderate  
Cold  
Fog

FILE No. \_\_\_\_\_

Fldr. No. \_\_\_\_\_

Sheet 11911

Date \_\_\_\_\_ 19\_\_

Figured By \_\_\_\_\_  
Notes Checked By \_\_\_\_\_  
Plotted By \_\_\_\_\_

Quad. No. \_\_\_\_\_

Station	Dist.	Angle " "	+	H. I. Bearing	Ver: Ang Diff.	Elevation
137+90						
139+37 <i>PI</i>						
139+48						

PP 12' LT

PP 8' RT

YALU 311

Return To  
Public Works  
Office  
Camp Lejeune  
North Carolina

FIELD PARTY

In Charge \_\_\_\_\_  
 Instrument \_\_\_\_\_  
 Notes \_\_\_\_\_  
 Tape Head \_\_\_\_\_  
 Type of Rod \_\_\_\_\_  
 Type of Rod \_\_\_\_\_  
 Instrument No. \_\_\_\_\_  
 Tape No. \_\_\_\_\_

WEATHER

Clear \_\_\_\_\_  
 Cloudy \_\_\_\_\_  
 Hazy \_\_\_\_\_  
 Misty \_\_\_\_\_  
 Rain \_\_\_\_\_  
 Snow \_\_\_\_\_  
 Windy \_\_\_\_\_  
 Cold \_\_\_\_\_  
 Fog \_\_\_\_\_

Figured By \_\_\_\_\_  
 Notes Checked By \_\_\_\_\_  
 Plotted By \_\_\_\_\_

Field No. \_\_\_\_\_

Station \_\_\_\_\_ Dist. \_\_\_\_\_ Angle \_\_\_\_\_ + \_\_\_\_\_  
 H.I. \_\_\_\_\_ V. Angle \_\_\_\_\_  
 Sighting \_\_\_\_\_ Elev. \_\_\_\_\_  
 Dist. \_\_\_\_\_

107  
 174  
 281

---

20 60  
 49 02

MI 725 52 N

**VALUABLE**

SUBJECT Location of proposed  
Gas line WALLACE CREEK

Return To  
Public Works  
Office  
Camp Lejeune  
North Carolina

**FIELD PARTY**

\_\_\_\_\_ In Charge  
\_\_\_\_\_ Instrument  
\_\_\_\_\_ Notes  
\_\_\_\_\_ Tape Read  
\_\_\_\_\_ Tape or Rod  
\_\_\_\_\_ Tape or Rod  
\_\_\_\_\_ Instrument No.  
\_\_\_\_\_ Tape No.



**WEATHER**

Clear \_\_\_\_\_  
Cloudy \_\_\_\_\_  
Windy \_\_\_\_\_  
Rain \_\_\_\_\_  
Fair \_\_\_\_\_  
Snow \_\_\_\_\_  
Hot \_\_\_\_\_  
Moderate \_\_\_\_\_  
Cold \_\_\_\_\_  
Fog \_\_\_\_\_  
Figured By \_\_\_\_\_  
Notes Checked By \_\_\_\_\_  
Plotted By \_\_\_\_\_

FILE No. \_\_\_\_\_  
Fldr. No. \_\_\_\_\_  
Sheet 1 of 4  
Date 4/7/ 19 52

Quad. No. \_\_\_\_\_

Station	Dist.	Angle ' "	+	H. I. Bearing	Ver: Ang. Diff.	Elevation
PI# 5		186 22' 25" (1)				
		199 06' 15" (3)				
		186 22' 25" (11)				

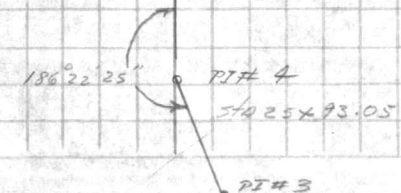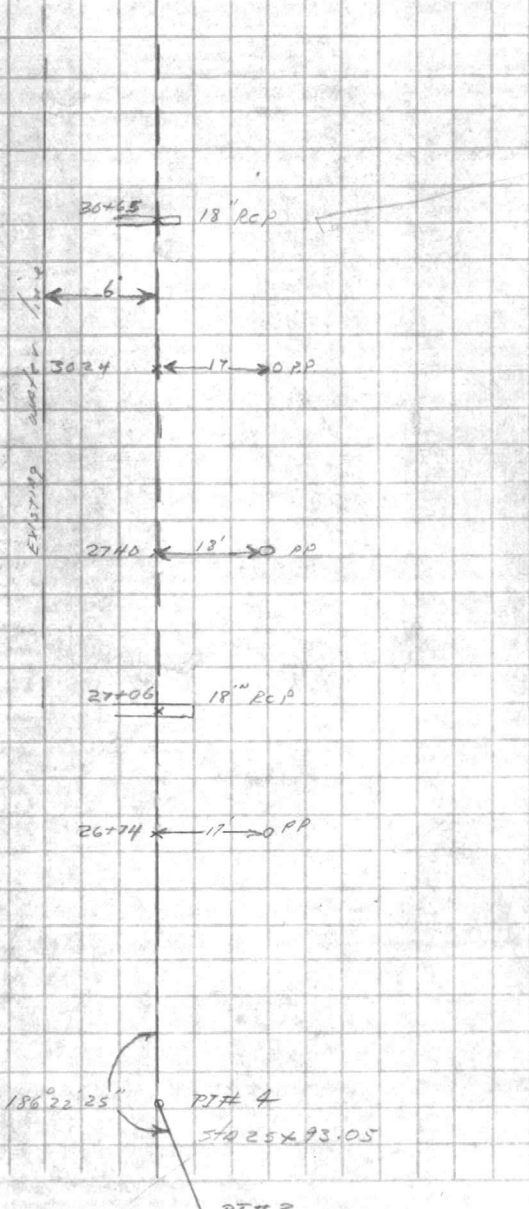




**VALUABLE**

SUBJECT \_\_\_\_\_  
 \_\_\_\_\_  
 \_\_\_\_\_  
 \_\_\_\_\_

Return To  
 Public Works  
 Office  
 Camp Lejeune  
 North Carolina

**FIELD PARTY**

\_\_\_\_\_ In Charge  
 \_\_\_\_\_ Instrument  
 \_\_\_\_\_ Notes  
 \_\_\_\_\_ Tape Read  
 \_\_\_\_\_ Tape or Rod  
 \_\_\_\_\_ Tape or Rod  
 \_\_\_\_\_ Instrument No.  
 \_\_\_\_\_ Tape No.


**WEATHER**

Clear \_\_\_\_\_  
 Cloudy \_\_\_\_\_  
 Windy \_\_\_\_\_  
 Rain \_\_\_\_\_  
 Fair \_\_\_\_\_  
 Snow \_\_\_\_\_  
 Hot \_\_\_\_\_  
 Moderate \_\_\_\_\_  
 Cold \_\_\_\_\_  
 Fog \_\_\_\_\_  
 Figured By \_\_\_\_\_  
 Notes Checked By \_\_\_\_\_  
 Plotted By \_\_\_\_\_

FILE No. \_\_\_\_\_  
 Fldr. No. \_\_\_\_\_  
 Sheet \_\_\_\_\_  
 Date \_\_\_\_\_ 19\_\_

Quad. No. \_\_\_\_\_

Station	Dist.	Angle ' "	+	H. I. Bearing	Ver: Ang. Diff.	Elevation
---------	-------	--------------	---	------------------	--------------------	-----------

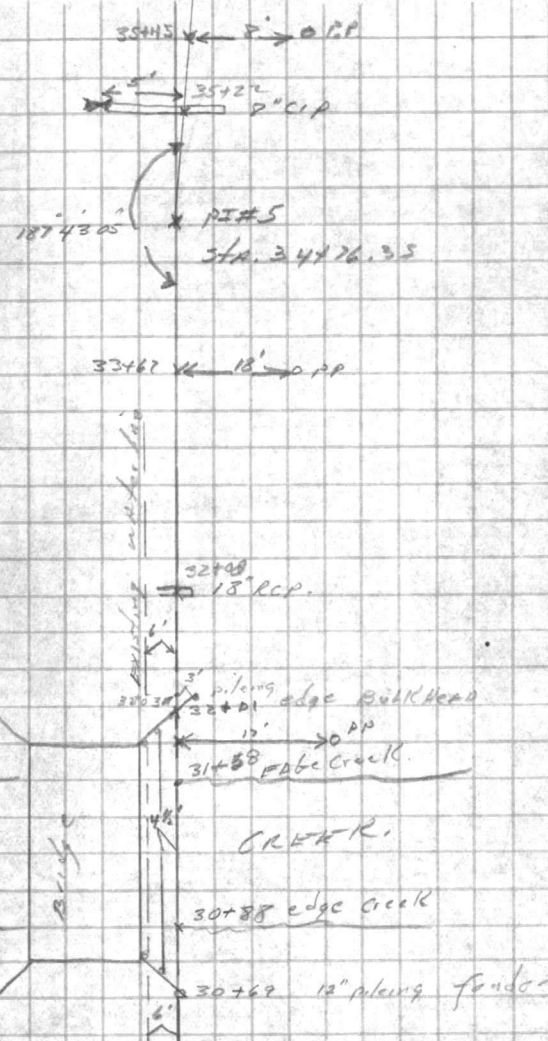

PI#6  
 187 43 15 (1)  
 203 09 15 (3)  
 187 43 05 (11)

PI#5

BS PI#4







































**VALUABLE**

SUBJECT Gas Line  
Holcomb Blvd.

Return To  
 Public Works  
 Office  
 Camp Lejeune  
 North Carolina

**FIELD PARTY**

\_\_\_\_\_ In Charge  
 \_\_\_\_\_ Instrument  
 \_\_\_\_\_ Notes  
 \_\_\_\_\_ Tape Read  
 \_\_\_\_\_ Tape or Rod  
 \_\_\_\_\_ Tape or Rod  
 \_\_\_\_\_ Instrument No.  
 \_\_\_\_\_ Tape No.

**WEATHER**

Clear \_\_\_\_\_  
 Cloudy \_\_\_\_\_  
 Windy \_\_\_\_\_  
 Rain \_\_\_\_\_  
 Fair \_\_\_\_\_  
 Snow \_\_\_\_\_  
 Hot \_\_\_\_\_  
 Moderate \_\_\_\_\_  
 Cold \_\_\_\_\_  
 Fog \_\_\_\_\_  
 Figured By \_\_\_\_\_  
 Notes Checked By \_\_\_\_\_  
 Plotted By \_\_\_\_\_

FILE No. \_\_\_\_\_  
 Fldr. No. \_\_\_\_\_  
 Sheet \_\_\_\_\_  
 Date \_\_\_\_\_ 19\_\_

Quad. No. PI# 9

Station	Dist.	Angle " "	+	H. I. Bearing	Ver: Ang. Diff.	Elevation
---------	-------	--------------	---	------------------	--------------------	-----------

180° 45' 30" = PI# 8 sta 41+55.08  
 41+54.59

PP  
 OK 17' → 40+45

40+00 edge brush.

8' pine  
 OK 4' → 39+27

39+55 ← 4' → 5' pine

38+86 ← 1' → 5' pine

PP  
 OK 30' → 38+84

37+30 edge thin brush.

PP  
 OK 13' → 37+10

PI# 9  
 180° 45' 30" 0)  
 182° 16' 30" 3)  
 180° 45' 30" medn

PI# 8

PI# 6

PI# 6


































 

**VALUABLE**

SUBJECT \_\_\_\_\_  
 \_\_\_\_\_  
 \_\_\_\_\_  
 \_\_\_\_\_

Return To  
 Public Works  
 Office  
 Camp Lejeune  
 North Carolina

**FIELD PARTY**

\_\_\_\_\_ In Charge  
 \_\_\_\_\_ Instrument  
 \_\_\_\_\_ Notes  
 \_\_\_\_\_ Tape Read  
 \_\_\_\_\_ Tape or Rod  
 \_\_\_\_\_ Instrument No.  
 \_\_\_\_\_ Tape No.

**WEATHER**

Clear  
 Cloudy  
 Windy  
 Rain  
 Fair

Snow  
 Hot  
 Moderate  
 Cold  
 Fog

FILE No. \_\_\_\_\_  
 Fldr. No. \_\_\_\_\_  
 Sheet \_\_\_\_\_  
 Date \_\_\_\_\_ 19\_\_

Figured By \_\_\_\_\_  
 Notes Checked By \_\_\_\_\_  
 Plotted By \_\_\_\_\_  
 Quad. No. \_\_\_\_\_

Station	Dist.	Angle " "	+	H. I. Bearing	Ver: Ang. Diff.	Elevation
PI#8	(1)	188 40 30				
	(3)	206 01 30				
	(m)	188 40 30				
PI#6						
PI#5						

PI#8 41+55.08 old  
 41+54.59 new

X X 58' 41"

PI#6 STA 36+96.18 B.H.V.P.  
 36+96.67 B.K.

188 40 30

PI#5











VALUABLE

SUBJECT WALLACE CREEKReturn To  
Public Works  
Office  
Camp Lejeune  
North Carolina

## FIELD PARTY

\_\_\_\_\_ In Charge  
 \_\_\_\_\_ Instrument  
 \_\_\_\_\_ Notes  
 \_\_\_\_\_ Tape Read  
 \_\_\_\_\_ Tape or Rod  
 \_\_\_\_\_ Tape or Rod  
 \_\_\_\_\_ Instrument No.  
 \_\_\_\_\_ Tape No.

## WEATHER

Clear  
 Cloudy  
 Windy  
 Rain  
 Fair

Snow  
 Hot  
 Moderate  
 Cold  
 Fog

FILE No. \_\_\_\_\_

Fldr. No. \_\_\_\_\_

Sheet 105

Date \_\_\_\_\_ 19\_\_

Figured By \_\_\_\_\_

Notes Checked By \_\_\_\_\_

Plotted By \_\_\_\_\_

Quad. No. \_\_\_\_\_

Station	Dist.	Angle	+	H. I. Bearing	Ver: Ang. Diff.	Elevation
B.M. MON. #128				1.17 24.76	✓	23.59
TP #1						7.67 17.09 ✓
				0.78 17.87	✓	
P.I. #4. 25+93 <sup>05</sup>						11.16 6.71 ✓
				5.52 12.23	✓	
STA. 25+93 <sup>05</sup>						5.5 6.73
26+00						5.6 6.6
26+50						5.2 7.0
27+00						5.5 6.7
27+06						8.3 3.9 18" R.C.P.
27+50						5.5 6.7
28+00						5.8 6.4
28+50						5.6 6.6
29+00						5.5 6.7
29+00						6.6 5.6
30+00						6.4 5.8





























570  
**VALUABLE**

SUBJECT \_\_\_\_\_  
 \_\_\_\_\_  
 \_\_\_\_\_  
 \_\_\_\_\_  
 \_\_\_\_\_

Return To  
 Public Works  
 Office  
 Camp Lejeune  
 North Carolina

**FIELD PARTY**

\_\_\_\_\_ In Charge  
 \_\_\_\_\_ Instrument  
 \_\_\_\_\_ Notes  
 \_\_\_\_\_ Tape Read  
 \_\_\_\_\_ Tape or Rod  
 \_\_\_\_\_ Tape or Rod  
 \_\_\_\_\_ Instrument No.  
 \_\_\_\_\_ Tape No.

**WEATHER**

Clear  
 Cloudy  
 Windy  
 Rain  
 Fair  
 Snow  
 Hot  
 Moderate  
 Cold  
 Fog

FILE No. \_\_\_\_\_  
 Fldr. No. \_\_\_\_\_  
 Sheet 20F  
 Date \_\_\_\_\_ 19\_\_

Figured By \_\_\_\_\_  
 Notes Checked By \_\_\_\_\_  
 Plotted By \_\_\_\_\_  
 Quad. No. \_\_\_\_\_

Station	Dist.	Angle	"	+	H. I. Bearing	Ver: Ang. Diff.	Elevation	
					12 23 ✓			
30+50					6.3	5.9		
30+63					6.6	5.6		
30+65					7.9	4.3		
30+65					10.00	2.2	18" R.C.P.	
30+69					6.2	6.0	ON FENDER	
30+73					11.0	1.2		
30+80					11.5	0.7		
30+88					12.2	0.03	EDGE WATER	
31+00					17.1	-4.9		
31+15					23.4	-11.2	WALLACE CREEK	
31+30					19.0	-6.8		
31+58					12.3	-0.1	EDGE WATER.	
31+60					10.8	1.4		
32+00					8.2	4.0		
T.P.					3.72	8.51 ✓		

4.97 13.48 ✓














**VALUABLE**

SUBJECT \_\_\_\_\_

Return To  
Public Works  
Office  
Camp Lejeune  
North Carolina

**FIELD PARTY**

\_\_\_\_\_ In Charge  
\_\_\_\_\_ Instrument  
\_\_\_\_\_ Notes  
\_\_\_\_\_ Tape Read  
\_\_\_\_\_ Tape or Rod  
\_\_\_\_\_ Tape or Rod  
\_\_\_\_\_ Instrument No.  
\_\_\_\_\_ Tape No.

**WEATHER**

Clear \_\_\_\_\_  
Cloudy \_\_\_\_\_  
Windy \_\_\_\_\_  
Rain \_\_\_\_\_  
Fair \_\_\_\_\_  
Snow \_\_\_\_\_  
Hot \_\_\_\_\_  
Moderate \_\_\_\_\_  
Cold \_\_\_\_\_  
Fog \_\_\_\_\_

FILE No. \_\_\_\_\_

Fldr. No. \_\_\_\_\_

Figured By \_\_\_\_\_ Sheet 30F

Notes Checked By \_\_\_\_\_

Plotted By \_\_\_\_\_ Date \_\_\_\_\_ 19\_\_

Quad. No. \_\_\_\_\_

Station	Dist.	Angle	"	+	H. I. Bearing	Ver: Ang. Diff.	Elevation	
					13.48			
32+01					9.4	4.1		
32+01 <sup>52</sup>					7.0	6.5		
32+08					7.4	6.1		
32+08					8.9	4.6		DN 18" R.C.P.
32+50					6.4	7.1		
33+00					6.0	7.5		
33+50					5.5	8.0		
34+00					5.4	8.1		
34+50					5.0	8.5		
P.I.#5 34+76 <sup>35</sup>					5.0	8.5		
35+0					5.4	8.1		
35+22					5.6	7.9		
35+22					8.28	5.2		8" C.I. WATER PIPE.
35+50					5.2	8.3		
36+00					3.9	9.6		




































**VALUABLE**

SUBJECT \_\_\_\_\_

Return To \_\_\_\_\_  
 Public Works Office \_\_\_\_\_  
 Camp Lejeune \_\_\_\_\_  
 North Carolina \_\_\_\_\_

**FIELD PARTY**

\_\_\_\_\_ In Charge  
 \_\_\_\_\_ Instrument  
 \_\_\_\_\_ Notes  
 \_\_\_\_\_ Tape Read  
 \_\_\_\_\_ Tape or Rod  
 \_\_\_\_\_ Tape or Rod  
 \_\_\_\_\_ Instrument No.  
 \_\_\_\_\_ Tape No.

**WEATHER**

Clear  
 Cloudy  
 Windy  
 Rain  
 Fair

Snow  
 Hot  
 Moderate  
 Cold  
 Fog

FILE No. \_\_\_\_\_

Fldr. No. \_\_\_\_\_

Sheet 4 D F

Figured By \_\_\_\_\_

Notes Checked By \_\_\_\_\_

Plotted By \_\_\_\_\_

Date \_\_\_\_\_ 19\_\_

Quad. No. \_\_\_\_\_

Station	Dist.	Angle	"	+	H. I. Bearing	Ver: Ang. Diff.	Elevation
					13.48		
36+50						2.8	10.7
P.I.#6	36+96 <sup>18</sup>					1.6	11.9
T.P.#2						0.17	13.31 -
		11.18			24.49 -		
T.P.#3						0.70	23.79 ✓
		7.70			31.49 ✓		
B.M. MON. #127.						3.45	28.04 ✓





































VALUABLE

SUBJECT

Bulane Gas Plant - Relocation  
 Test Borings  
 Approximate location of Gas Tank  
 Storage  
 See Plan Location  
 for Sites

Return To  
 Public Works  
 Office  
 Camp Lejeune  
 North Carolina

FIELD PARTY

Green In Charge  
 \_\_\_\_\_ Instrument  
 \_\_\_\_\_ Notes  
 \_\_\_\_\_ Tape Read  
 \_\_\_\_\_ Tape or Rod  
 \_\_\_\_\_ Tape or Rod  
 \_\_\_\_\_ Instrument No.  
 \_\_\_\_\_ Tape No.

WEATHER

Clear \_\_\_\_\_  
 Cloudy \_\_\_\_\_  
 Windy \_\_\_\_\_  
 Rain \_\_\_\_\_  
 Fair \_\_\_\_\_  
 Snow \_\_\_\_\_  
 Hot \_\_\_\_\_  
 Moderate \_\_\_\_\_  
 Cold \_\_\_\_\_  
 Fog \_\_\_\_\_

FILE No. 120-W

Fldr. No. \_\_\_\_\_

Sheet # 1 of 1

Date 1/4/51 1951

Figured By \_\_\_\_\_  
 Notes Checked By \_\_\_\_\_  
 Plotted By \_\_\_\_\_  
 Quad. No. \_\_\_\_\_

Station	Dist.	Angle "	+	H. I. Bearing	Ver: Ang. Diff.	Elevation
#1						
Location of Gas Tank Storage						
Ground Elev. 2.0						
	-0.3					Top Soil
	-1.0					Brown Fine Sand
	-1.6					Yellow Sand - Fine Grains
	-2.2				50° - 50°	Yellow Sand + Clay
	-3.2				30° Clay	Yellow Sand + Clay
	-3.7				15° Clay	Yellow Sand + Clay
	-4.3				5° Clay	Yellow Sand + Clay
	-5.3					Yellow Sand
	-5.8				5°	Yellow Sand + Clay
	-6.3				15°	Yellow Sand + Clay
	-7.6				80° Clay	Yellow Clay + Sand
End of Boring						
Entire Area Medium Heavy Brush						
Few large Trees						

#2						
Location of Maintenance Bldg.						
Ground Elev. 2.0						
	-0.6					Top Soil
	-1.2					Fine Yellow Sand
	-2.2					Fine Gray Sand
	-4.2				5° Clay	Yellow Sand + Clay
	-7.2				15° Clay	Yellow Sand + Clay
	-7.5				30° Clay	Yellow Sand + Clay
	-8.0				80° Clay	Yellow Clay + Sand
#3						
Location of Boiler House						
Ground Elev. 2.0						
	-0.6					Top Soil
	-1.0					Fine Yellow Sand
	-1.9					Fine Gray Sand
	-2.9				30° Clay	Yellow Sand + Clay
	-4.5				15° Clay	Yellow Sand + Clay
	-5.4				5° Clay	Yellow Sand + Clay
	-6.0				50° - 50°	Yellow Sand + Clay
	-7.0				80° Clay	Yellow Clay + Sand

No Water

No Water




















VALUABLE

SUBJECT Existing water line location  
near well house #602.  
Proposed propane gas line  
Survey.

Return To  
Public Works  
Office  
Camp Lejeune  
North Carolina

FIELD PARTY  
BARNER In Charge  
Instrument \_\_\_\_\_  
Notes \_\_\_\_\_  
Tape Read \_\_\_\_\_  
Tape or Rod \_\_\_\_\_  
Tape or Rod \_\_\_\_\_  
Instrument No. \_\_\_\_\_  
Tape No. \_\_\_\_\_

WEATHER  
Clear \_\_\_\_\_  
Cloudy \_\_\_\_\_  
Windy \_\_\_\_\_  
Rain \_\_\_\_\_  
Fair \_\_\_\_\_  
Snow \_\_\_\_\_  
Hot \_\_\_\_\_  
Moderate \_\_\_\_\_  
Cold \_\_\_\_\_  
Fog \_\_\_\_\_  
Figured By \_\_\_\_\_  
Notes Checked By \_\_\_\_\_  
Plotted By \_\_\_\_\_

FILE No. 120-W


Fldr. No. \_\_\_\_\_

Sheet 1-04-

Date 5-21-1951

Quad. No. \_\_\_\_\_

Station	Dist.	Angle " "	+	H. I. Bearing	Ver: Ang. Diff.	Elevation
---------	-------	--------------	---	------------------	--------------------	-----------

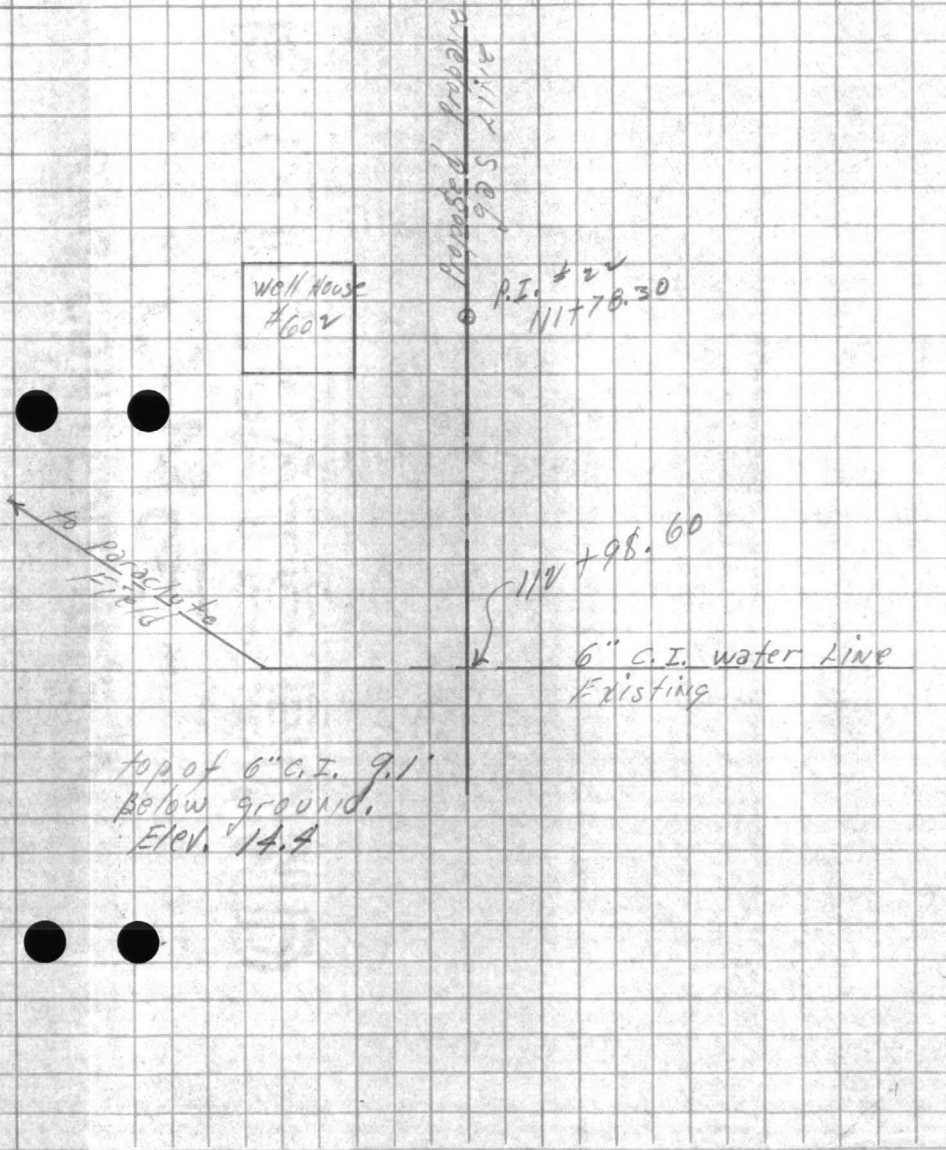







