

VALUABLE

SUBJECT RIFLE RANGE
STAKE-OUT SEWAGE PUMP STA

RETURN TO
CARR & J. E.
GREINER CO.
JACKSONVILLE,
N. C.

FIELD PARTY


BECK IN CHARGE
RANE INSTRUMENT
NOTES
BATSON TAPE READ
TYRANCE TAPE OR ROD
INSTRUMENT NO.
TAPE NO.

WEATHER

CLEAR
CLOUDY
WINDY ✓
RAIN
FAIR
SNOW
HOT
MODERATE ✓
COLD
FOG
FIGURED BY
NOTES CHECKED BY F.W.H.
PLOTTED BY

FILE No. _____
FLDR. No. 0.96
SHEET 1 of 1
DATE 5-11 1943

STATION	DIST.	ANGLE	+ H. I.	- VER. ANG. DIFF.	ELEVATION
		° ' "			
B.M. 739			4.515 23.38		18.865
Cor "A"				4.87	18.51
"B"				2.58	20.80
"C"				4.37	19.01
"D"				6.48	16.90
B.M. 739			4.515	18.865 (18.865)	
			2.91	20.47 (20.46)	

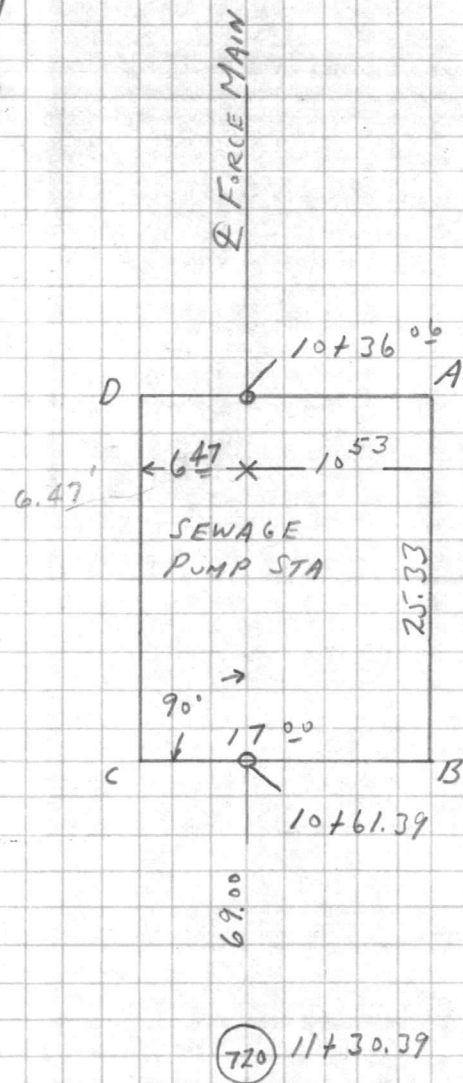


WEATHER
CLEAR
WINDY

FIELD PARTY






