

VALUABLE

RETURN TO
CARR & J. E.
GREINER CO.
JACKSONVILLE,
N. C.

SUBJECT Traverse

Everett Creek Toward Stone Ecc.

FIELD PARTY
BECK IN CHARGE
VAIL INSTRUMENT
NOTES
C. FARNELL TAPE READ
SANDLIN TAPE OR ROD
TAPE OR ROD
INSTRUMENT No. _____
TAPE No. _____

WEATHER
CLEAR SNOW
CLOUDY HOT
WINDY MODERATE
RAIN COLD
FAIR FOG
FIGURED BY _____
NOTES CHECKED BY _____
PLOTTED BY _____


FILE No. _____

FLDR. No. _____

SHEET 1 of 12

DATE 9/21 19____

STATION	DIST.	ANGLE		+	H. I.	-	ELEVATION
		°	' "				

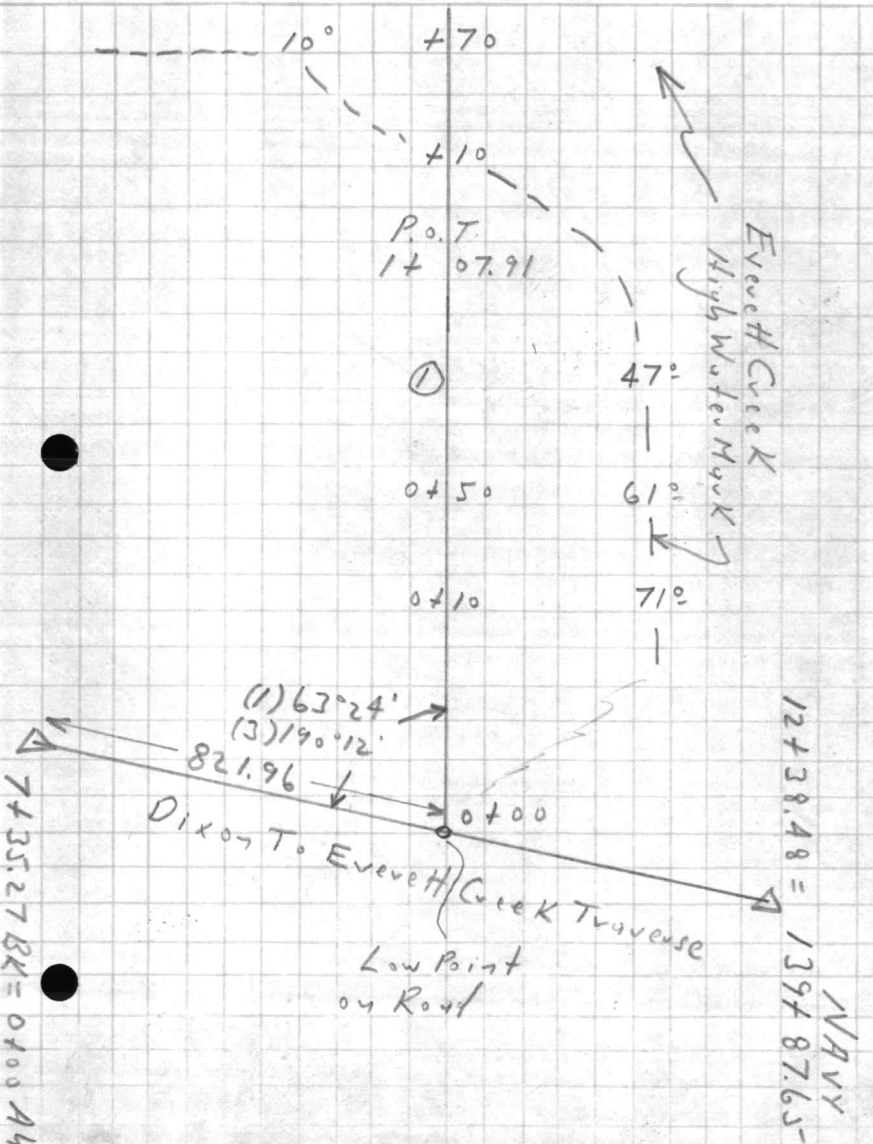

NAVY

REPORT OF INSTALLATION
OF
PERMANENT STATION

COORDINATES

NORTH

EAST

QUADRANGLE NO.

VALUABLE

RETURN TO
CARR & J. E.
GREINER CO.
JACKSONVILLE,
N. C.

SUBJECT Traverse
Everett Creek Toward Stone Ecc.

FIELD PARTY
BECK IN CHARGE
VAIL INSTRUMENT
NOTES
SANDLIN TAPE READ
C. FARNELL TAPE OR ROD
INSTRUMENT NO. _____
TAPE NO. _____

WEATHER
CLEAR _____ SNOW _____
CLOUDY _____ HOT _____
WINDY _____ MODERATE ✓
RAIN _____ COLD _____
FAIR ✓ FOG _____
FIGURED BY _____ SHEET 2 of 12
NOTES CHECKED BY _____ DATE 9/21 19____
PLOTTED BY _____

STATION	DIST.	ANGLE	+	H. I.	VER: ANG. DIFF.	ELEVATION
---------	-------	-------	---	-------	-----------------	-----------

Mag. S 50° 15' E

P.I. 5+46.17 BK= 0+00 Ahd.


< (1) 274° 57'

(3) 104° 51'

(MEAN 94° 57" R) ✓

(94° 56' 50" R)

Temp. 78°

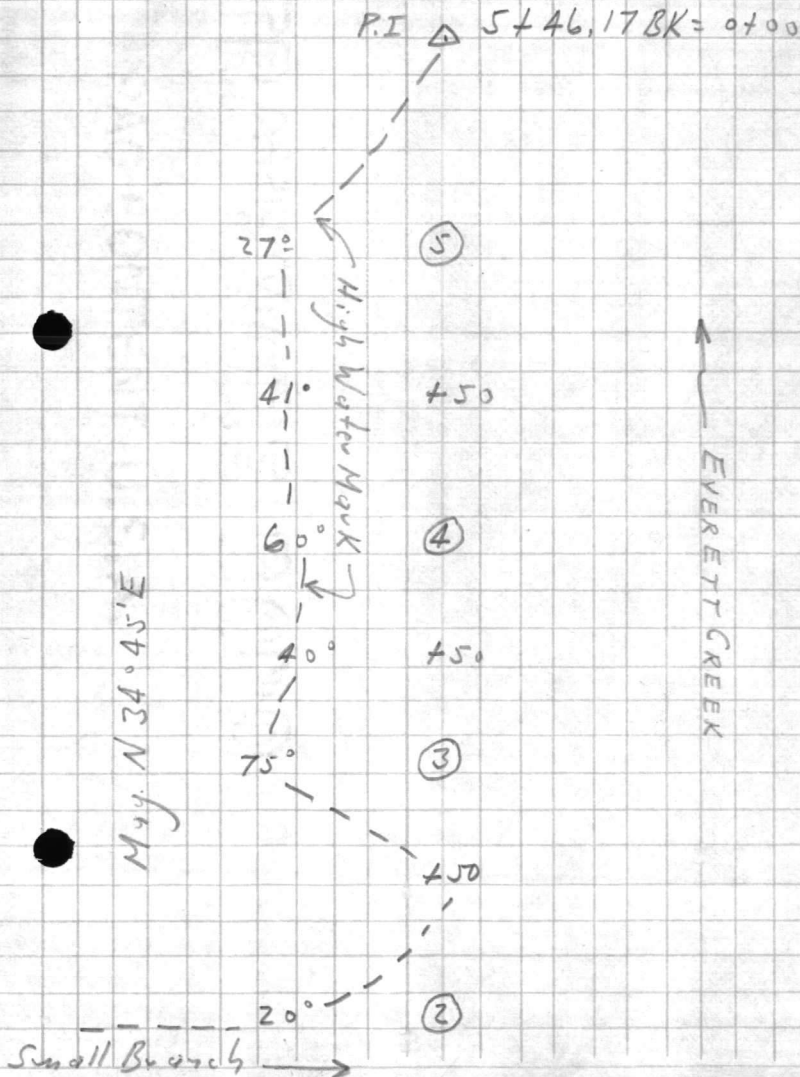









VALUABLE

RETURN TO
CARR & J. E.
GREINER CO.
JACKSONVILLE,
N. C.

SUBJECT Traverse Line
Everett Creek Toward Stone Ecc.

FIELD PARTY
BECK IN CHARGE
YAIL INSTRUMENT
NOTES
SANDLIN TAPE READ
C. FARNELL TAPE OR ROD
INSTRUMENT NO.
TAPE NO.

WEATHER
CLEAR SNOW
CLOUDY HOT
WINDY MODERATE
RAIN COLD
FAIR FOG
FIGURED BY
NOTES CHECKED BY
PLOTTED BY

FILE No. _____
FLDR. No. _____
SHEET 3 of 12
DATE 9/21 1942

STATION	DIST.	ANGLE	+	H. I.	VER. ANG. DIFF.	ELEVATION
		° ' "				

Mag. N35°E

P.I. 1461.70 BK = 0700 Ahd.

∠ (1) 85° 32'
(3) 256° 36'
(MEAN 94° 28' 10" L) ✓
(94° 28' 10" L)

Temp. 78°

P.I. Δ
1461.70 BK = 0700 Ahd.

450
②
450
①
0750
0701
0761
①
0740

11°
20°
29°
9°
19°
14°
7°
3 1/2°
40°

High Water Mark

EVERETT CREEK




VALUABLE

RETURN TO
CARR & J. E.
GREINER CO.
JACKSONVILLE,
N. C.

SUBJECT Traverse

Everett Creek Toward Stone Ecc.

FIELD PARTY

BECK IN CHARGE
VAN INSTRUMENT
NOTES
C. FARNELL TAPE READ
SANDLIN TAPE OR ROD
GARNER TAPE OR ROD
INSTRUMENT NO.
TAPE NO.

WEATHER

CLEAR
CLOUDY
WINDY
RAIN
FAIR
SNOW
HOT
MODERATE
COLD
FOG

FILE No. _____

FLDR. No. _____

SHEET

4 of 12

DATE

9/21 1942

FIGURED BY _____
NOTES CHECKED BY _____
PLOTTED BY _____

STATION	DIST.	ANGLE	+	H. I.	—	ELEVATION
		° ' "			VER: ANG.	

Mag. N 58° 30' E

Temp. 78°


P.I. 4+21.78 BK=0+00 A4/.

∠(1) 203° 30'

(3) 25° 30'

MEAN ~~23° 30' 00" R~~ ✓
(23° 29' 50" R)

4+21.78 BK=0+00 A4/.

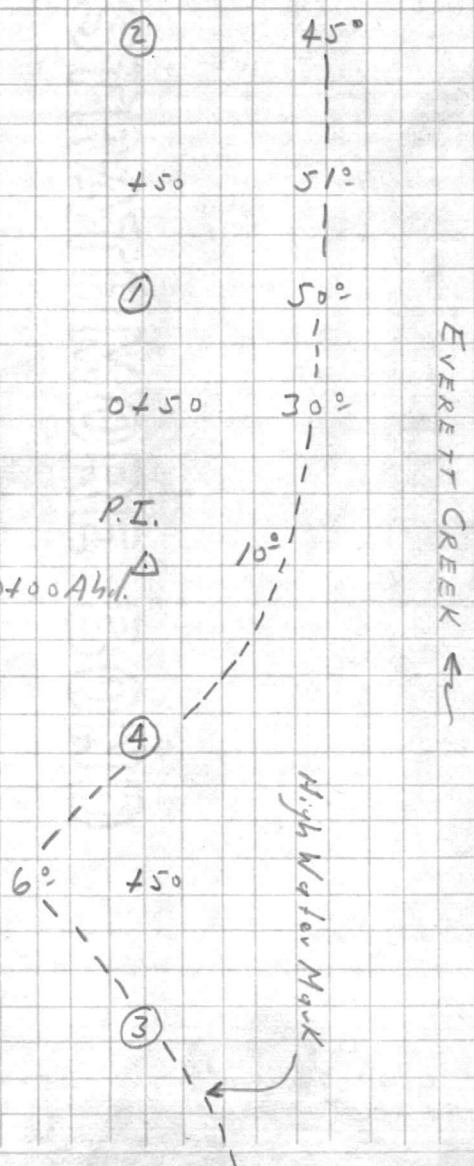










VALUABLE

RETURN TO
CARR & J. E.
GREINER CO.
JACKSONVILLE,
N. C.

SUBJECT Traverse
Everett Creek Toward Stone Ecc.

FIELD PARTY
BECK IN CHARGE
VAIL INSTRUMENT
NOTES
SANDLIN TAPE READ
C. FARNELL TAPE OR ROD
INSTRUMENT NO. _____
TAPE NO. _____

WEATHER
CLEAR SNOW
CLOUDY HOT
WINDY MODERATE
RAIN COLD
FAIR FOG
FIGURED BY _____
NOTES CHECKED BY _____
PLOTTED BY _____

FILE No. _____
FLDR. No. _____
SHEET 5 of 12
DATE 9/21 19__

STATION	DIST.	ANGLE	+	H. I.	—	ELEVATION
		° ' "			VER: ANG. DIFF.	

Mag. N 02° 30' E


P.I. 3+12.25 BK = 0+00 Ahd.

∠ (1) 123° 48'

(3) 11° 24'

(~~MEAN 56° 12' 00" L~~)
(56° 12' 10" L)

P.I. 3+12.25 BK = 0+00 Ahd.

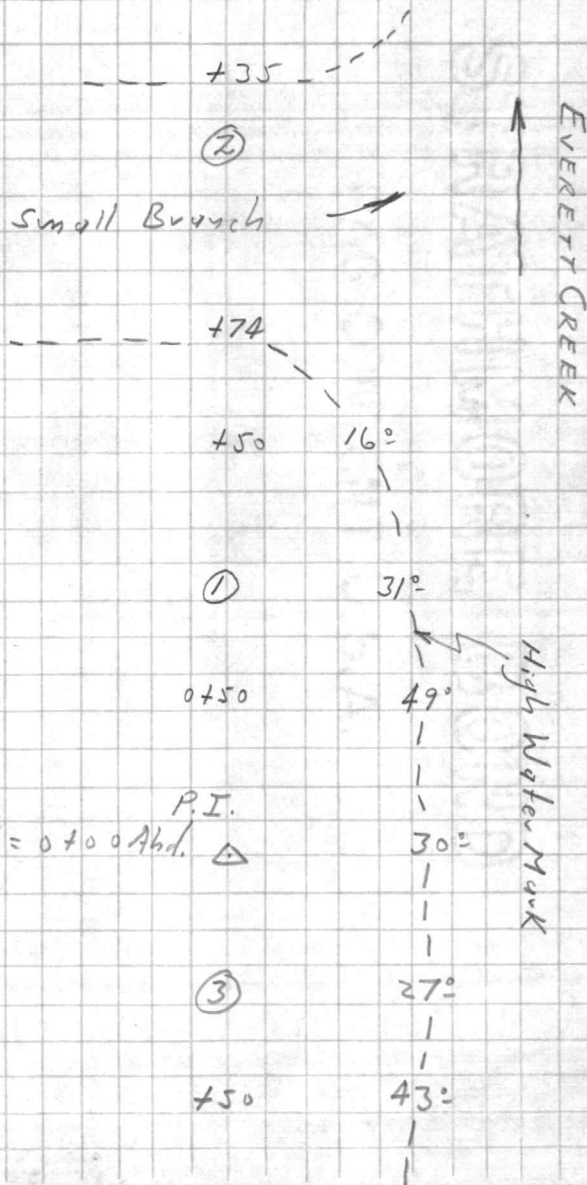







VALUABLE

SUBJECT Traverse

RETURN TO
CARR & J. E.
GREINER CO.
JACKSONVILLE,
N. C.

Everett Creek Toward Stone Ecc.

FIELD PARTY

BECK IN CHARGE
VAIL INSTRUMENT
NOTES
C. FARNELL TAPE READ
GODWIN TAPE OR ROD
GARNER TAPE OR ROD
INSTRUMENT No. _____
TAPE No. _____

WEATHER

CLEAR _____ SNOW _____
CLOUDY _____ HOT _____
WINDY _____ MODERATE ✓
RAIN _____ COLD _____
FAIR ✓ FOG _____
FIGURED BY _____
NOTES CHECKED BY _____
PLOTTED BY _____

FILE No. _____

FLDR. No. _____

SHEET 6 of 12

DATE 9/22 1942

STATION	DIST.	ANGLE	+	H. I.	VER. ANG. DIFF.	ELEVATION
---------	-------	-------	---	-------	-----------------	-----------

Mag. N 61° 45' E


P.I. 3+24.82 BK. = 0+00
∠(1) 239° 33'

(3) 358° 40'
~~(Mag. 57° 35' 20" R)~~ ✓
(59° 33' R)


Temp. 72°

3+24.82 BK. = 0+00

Small Branch

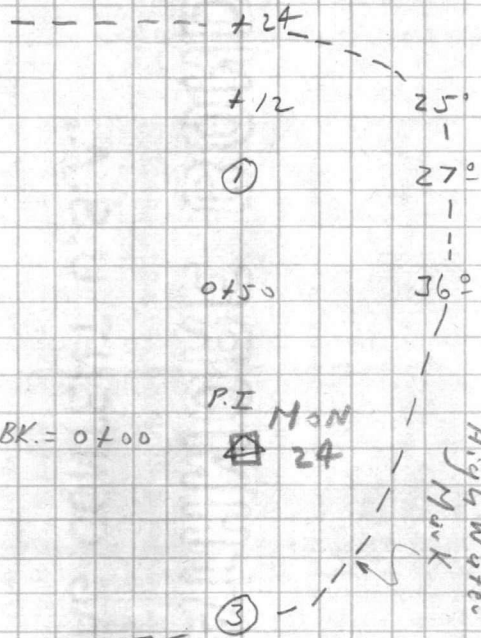

Small Branch →

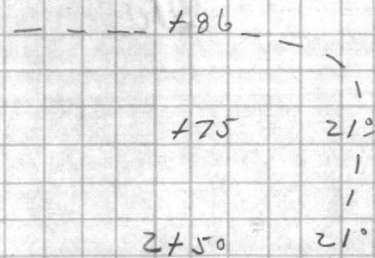

































VALUABLE

RETURN TO
CARR & J. E.
GREINER CO.
JACKSONVILLE,
N. C.


SUBJECT Traverse
Everett Creek Toward Stone Ecc.

FIELD PARTY
BECK IN CHARGE
VAIL INSTRUMENT
NOTES
GARNER TAPE READ
C. FARNELL TAPE OR ROD
GODWIN TAPE OR ROD
INSTRUMENT NO. _____
TAPE NO. _____

WEATHER
CLEAR SNOW
CLOUDY HOT
WINDY MODERATE
RAIN COLD
FAIR FOG
FIGURED BY _____
NOTES CHECKED BY _____
PLOTTED BY _____

FILE No. _____
FLDR. No. _____
SHEET 7 of 12
DATE 9/22 1942

STATION	DIST.	ANGLE		+	H. I.	VER. ANG. DIFF.		ELEVATION
		o	"					

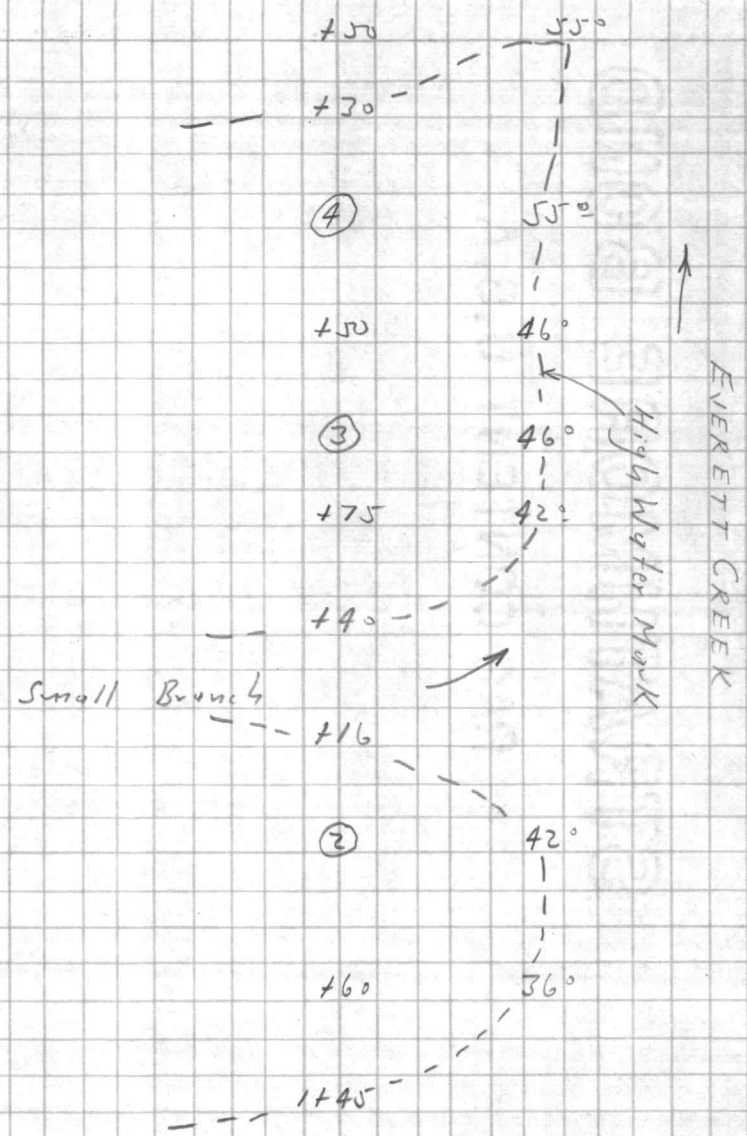








VALUABLE

RETURN TO
CARR & J. E.
GREINER CO.
JACKSONVILLE,
N. C.

SUBJECT Traverse

Everett Creek Toward Stone Ecc.

FIELD PARTY

BECK IN CHARGE
VAIL INSTRUMENT

NOTES

C. FARNELL TAPE READ

GARNER TAPE OR ROD

GODWIN TAPE OR ROD

INSTRUMENT NO. _____

TAPE NO. _____

WEATHER

CLEAR _____ SNOW _____
CLOUDY _____ HOT _____
WINDY _____ MODERATE ✓
RAIN _____ COLD _____
FAIR ✓ FOG _____

FIGURED BY _____

NOTES CHECKED BY _____

PLOTTED BY _____

FILE No. _____

FLDR. No. _____

SHEET 8 of 12

DATE 9/22 1942

STATION DIST. ANGLE + H. I. VER. ANG. ELEVATION

DIFF.

Mag. N 54° E

P.I.

1+85.57 BK = 0+00 Ahd.
∠ (1) 176° 11' 30"

(3) 168° 33'

~~(MEAN 3° 49' 19" L)~~ ✓

(3° 49' 19" L) ✓

Mag. N 57° 45' E

P.I. 6+53.25 BK = 0+00 Ahd.

∠ (1) 176° 07'

(3) 168° 19'

~~(MEAN 3° 53' 30" L)~~ ✓

(3° 53' 30" L) ✓

Temp. 75°

1+85.57 BK = 0+00

P.I.

△

+50

①

0+50

P.I.

□

MON
25

⑥

+50

⑤

4.55

57°

35°

76°

104°

110°

105°

85°

87°

77°

↑
EVERETT CREEK
High Water Mark











VALUABLE

RETURN TO
CARR & J. E.
GREINER CO.
JACKSONVILLE,
N. C.

SUBJECT Traverse

Everett Creek Toward Stone Ecc.

FIELD PARTY

BECK IN CHARGE
VAIL INSTRUMENT
NOTES
GARNER TAPE READ
C. FARNELL TAPE OR ROD
GODWIN TAPE OR ROD
INSTRUMENT NO. _____
TAPE NO. _____

WEATHER

CLEAR _____ SNOW _____
CLOUDY _____ HOT _____
WINDY _____ MODERATE ✓
RAIN _____ COLD _____
FAIR ✓ FOG _____
FIGURED BY _____
NOTES CHECKED BY _____
PLOTTED BY _____

FILE No. _____

FLDR. No. _____

SHEET 9 of 12

DATE 9/22 1942

STATION	DIST.	ANGLE	+	H. I.	VER. ANG. DIFF.	ELEVATION
---------	-------	-------	---	-------	-----------------	-----------

M₉₉ S 55° 00' E

P.I. 1+20.03 BK = 0+00 Ahd.

∠ (1) 179° 42'

(3) 179° 08'

(MEAN 0° 17' 20" L)

(0° 17' 30" L) ✓

Temp. 76°

1+20.03 BK = 0+00 Ahd.

P.I.

△

67°

①

70°

M₉₉ S 54° 45' E

P.I. 2+78.45 BK = 0+00 Ahd.

∠ (1) 251° 04'

(3) 33° 11'

(MEAN 71° 03' 40" R) ✓

(71° 03' 30" R)

Temp. 76°

2+78.45 BK = 0+00 Ahd.

P.I.

△

45°

②

65°

45°

①

47°

↑
EVERETT CREEK
High Water Mark






















VALUABLE


RETURN TO
CARR & J. E.
GREINER CO.
JACKSONVILLE,
N. C.

SUBJECT Traverse
Everett Creek Toward Stone Ecc.

FIELD PARTY
BECK IN CHARGE
VAIL INSTRUMENT
NOTES
GARNER TAPE READ
C. FARNELL TAPE OR ROD
GOODWIN TAPE OR ROD
INSTRUMENT NO. _____
TAPE NO. _____

WEATHER
CLEAR _____
CLOUDY _____
WINDY _____
RAIN _____
FAIR _____
SNOW _____
HOT _____
MODERATE _____
COLD _____
FOG _____
FIGURED BY _____
NOTES CHECKED BY _____
PLOTTED BY _____

FILE No. _____
FLDR. No. _____
SHEET 10 of 12
DATE 9/22 1942

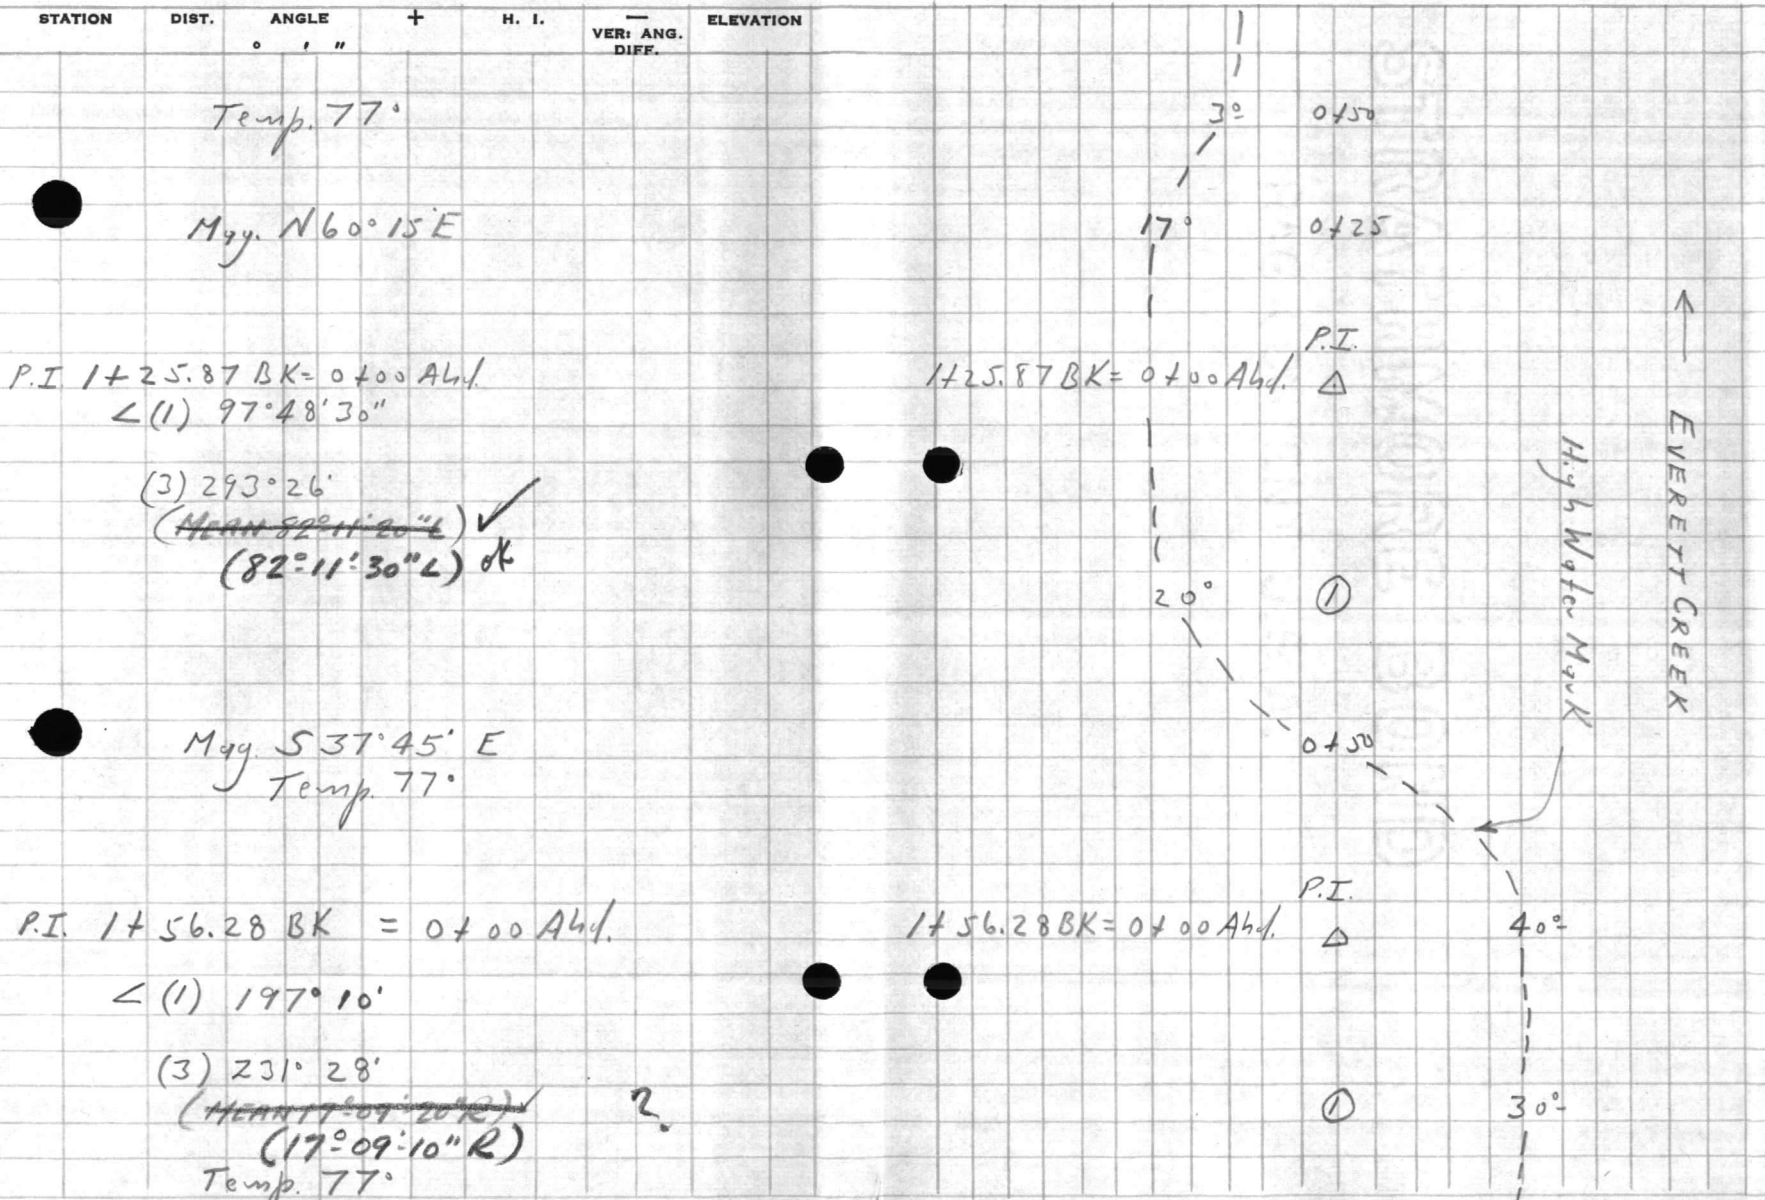







 

VALUABLE

RETURN TO
CARR & J. E.
GREINER CO.
JACKSONVILLE,
N. C.

SUBJECT Traverse

Everett Creek Toward Stone Ecc.

FIELD PARTY

BECK IN CHARGE
VAIL INSTRUMENT
NOTES
GARNER TAPE READ
C. FARNELL TAPE OR ROD
GODWIN TAPE OR ROD
INSTRUMENT NO. _____
TAPE NO. _____

WEATHER

CLEAR _____ SNOW _____
CLOUDY _____ HOT _____
WINDY _____ MODERATE _____
RAIN _____ COLD _____
FAIR _____ FOG _____
FIGURED BY _____
NOTES CHECKED BY _____
PLOTTED BY _____

FILE No. _____

FLDR. No. _____

SHEET 11 of 12

DATE 9/22 19__

STATION	DIST.	ANGLE	+	H. I.	VER. ANG. DIFF.	ELEVATION
		° ' "				


Temp. 78°

Mag. S 84° E

P.I. 1+12.90 BK=0+00 A4/1
∠(1) 215° 57'

(3) 287.51'

(MEAN 35° 57' 00" R) ✓
(35° 56' 50" R)

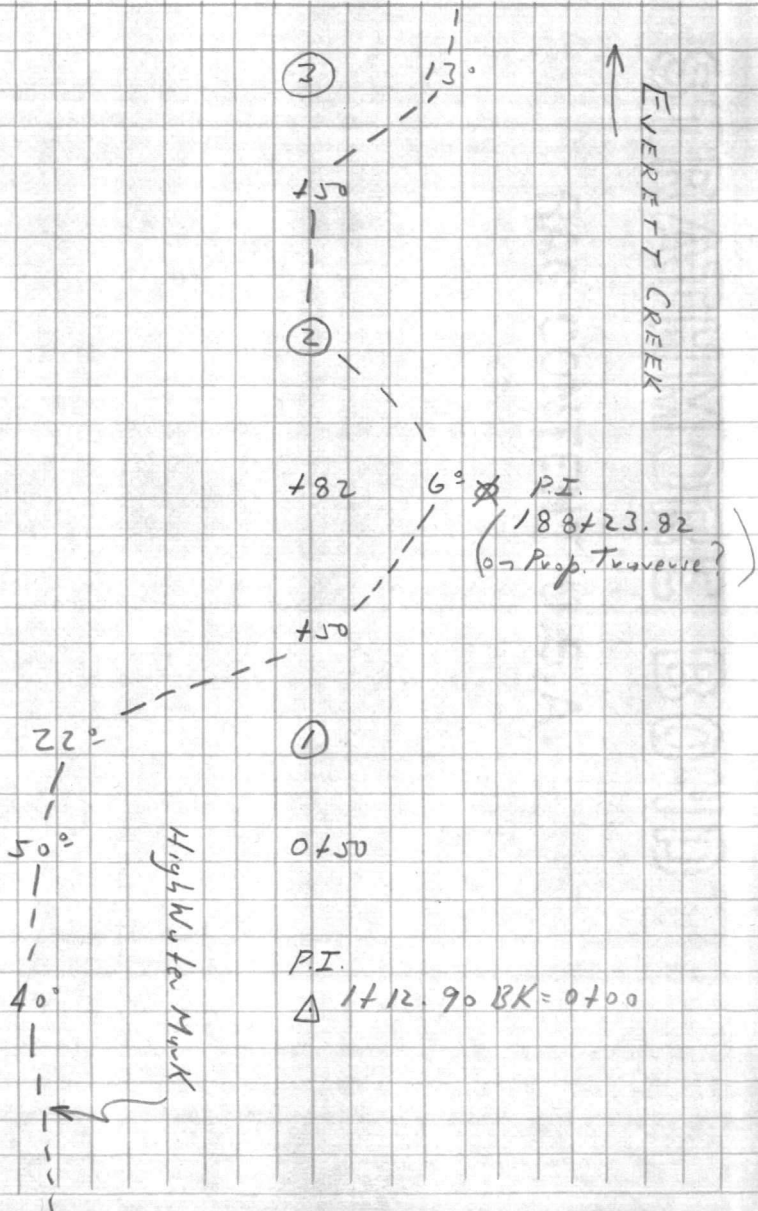

VALUABLE

SUBJECT

FILE NO.

WEIGHTS

FIELD PARTY

CLASS

NO. OF DAYS

NO. OF MILES

NO. OF MILES

 

VALUABLE

RETURN TO
CARR & J. E.
GREINER CO.
JACKSONVILLE,
N. C.

SUBJECT Traverse

Everett Creek Toward Stone Ecc.

FIELD PARTY

BECK IN CHARGE
YAIL INSTRUMENT
NOTES
GARNER TAPE READ
C. FARNELL TAPE OR ROD
GODWIN TAPE OR ROD
INSTRUMENT NO.
TAPE NO.

WEATHER

CLEAR
CLOUDY
WINDY
RAIN
FAIR ✓
SNOW
HOT
MODERATE ✓
COLD
FOG

FILE No. _____

FLDR. No. _____

SHEET 12 of 12

DATE 9/22 19 42

FIGURED BY _____

NOTES CHECKED BY _____

PLOTTED BY _____

STATION	DIST.	ANGLE ° ' "	+	H. I.	— VER. ANG. DIFF.	ELEVATION
---------	-------	----------------	---	-------	-------------------------	-----------

△ "Veil"

Mg. → 589°45'E

232.35

" 3468.15 BK = P.I. "Beck" on
Traverse Up Stream

P.I. △ "Beck" Etc.

∠ (1) 174° 07'

(3) 162° 19'
(MEAN 5°53'40"Z) ✓
(5°53'50"L)

+30

25°

