

VALUABLE

SUBJECT

Water Line to Red Cross Bldg.
Area #1

RETURN TO
PUBLIC WORKS
OFFICE
CAMP LEJEUNE
NEW RIVER, N. C.

FIELD PARTY

Dillon IN CHARGE
INSTRUMENT
NOTES
TAPE READ
TAPE OR ROD
TAPE OR ROD
INSTRUMENT NO.
TAPE NO.

WEATHER

CLEAR SNOW
CLOUDY HOT
WINDY MODERATE
RAIN COLD
FAIR FOG

140-V
FILE No.


FLDR. No.

FIGURED BY SHEET #10/1

NOTES CHECKED BY DATE 4/8 1944

PLOTTED BY QUAD. No. 140-GENERAL

STATION	DIST.	ANGLE "	+	H. I.	VER: ANG. DIFF.	ELEVATION
B.M.			5.08	30 36		25.28
0+00					10.13	20.23
1+0					8.11	22.25
2+0					8.80	21.56
2+92.5	90° Bend				10.00	20.36
3+ 11'	Valve at Bldg.				9.69	20.67
T.B.M.	Fl. Elev. Red Cross Bldg.				3.90	26.46 (26.50)

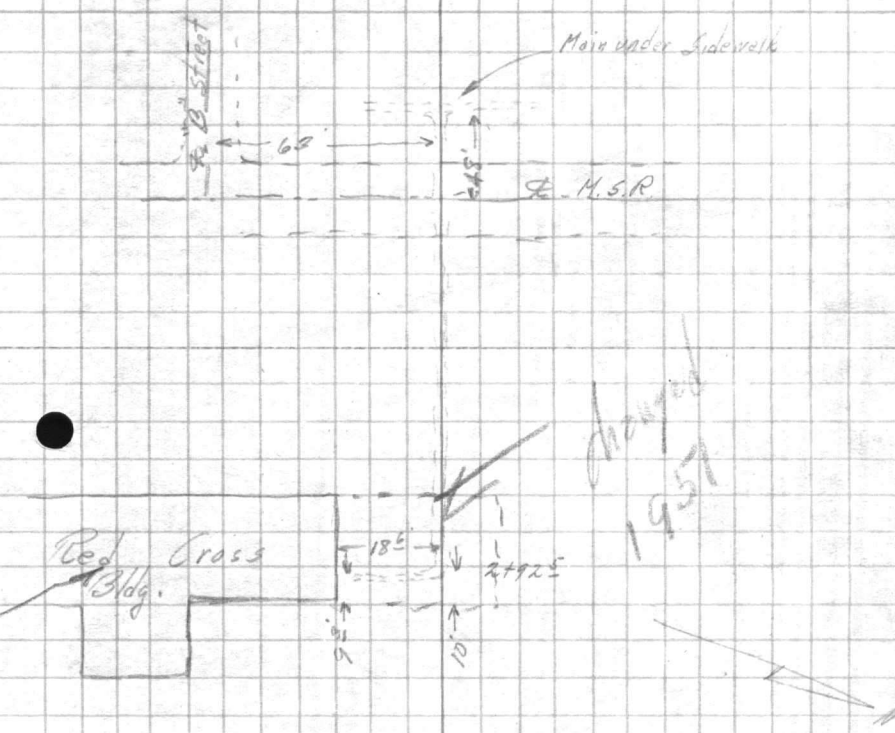

Original Bldg.
Addition lowered 1'

changed
1957



















VALUABLE
 RETURN TO
 PUBLIC WORKS
 OFFICE
 CAMP LEJEUNE
 NORTH CAROLINA


 SUBJECT LINE TO P.D. PROPOSED
UNDERGROUND TEL. CABLE
EXISTING LINE AT STREET
TO RADIO TOWER TO 'D' ST
SOUTH SIDE MAIN SER. RD.

 FIELD PARTY
DENNIS IN CHARGE
 _____ INSTRUMENT
 _____ NOTES
 _____ TAPE READ
 _____ TAPE OR ROD
 _____ TAPE OR ROD
 _____ INSTRUMENT NO.
 _____ TAPE NO.

 WEATHER
 CLEAR CLOUDY
 WINDY RAIN FAIR
 SNOW HOT MODERATE COLD FOG
 FIGURED BY _____
 NOTES CHECKED BY _____
 PLOTTED BY _____

 FILE No. _____
 FLDR. No. _____
 SHEET 1 of 7
 DATE 11-28 1956

Quad. No. _____

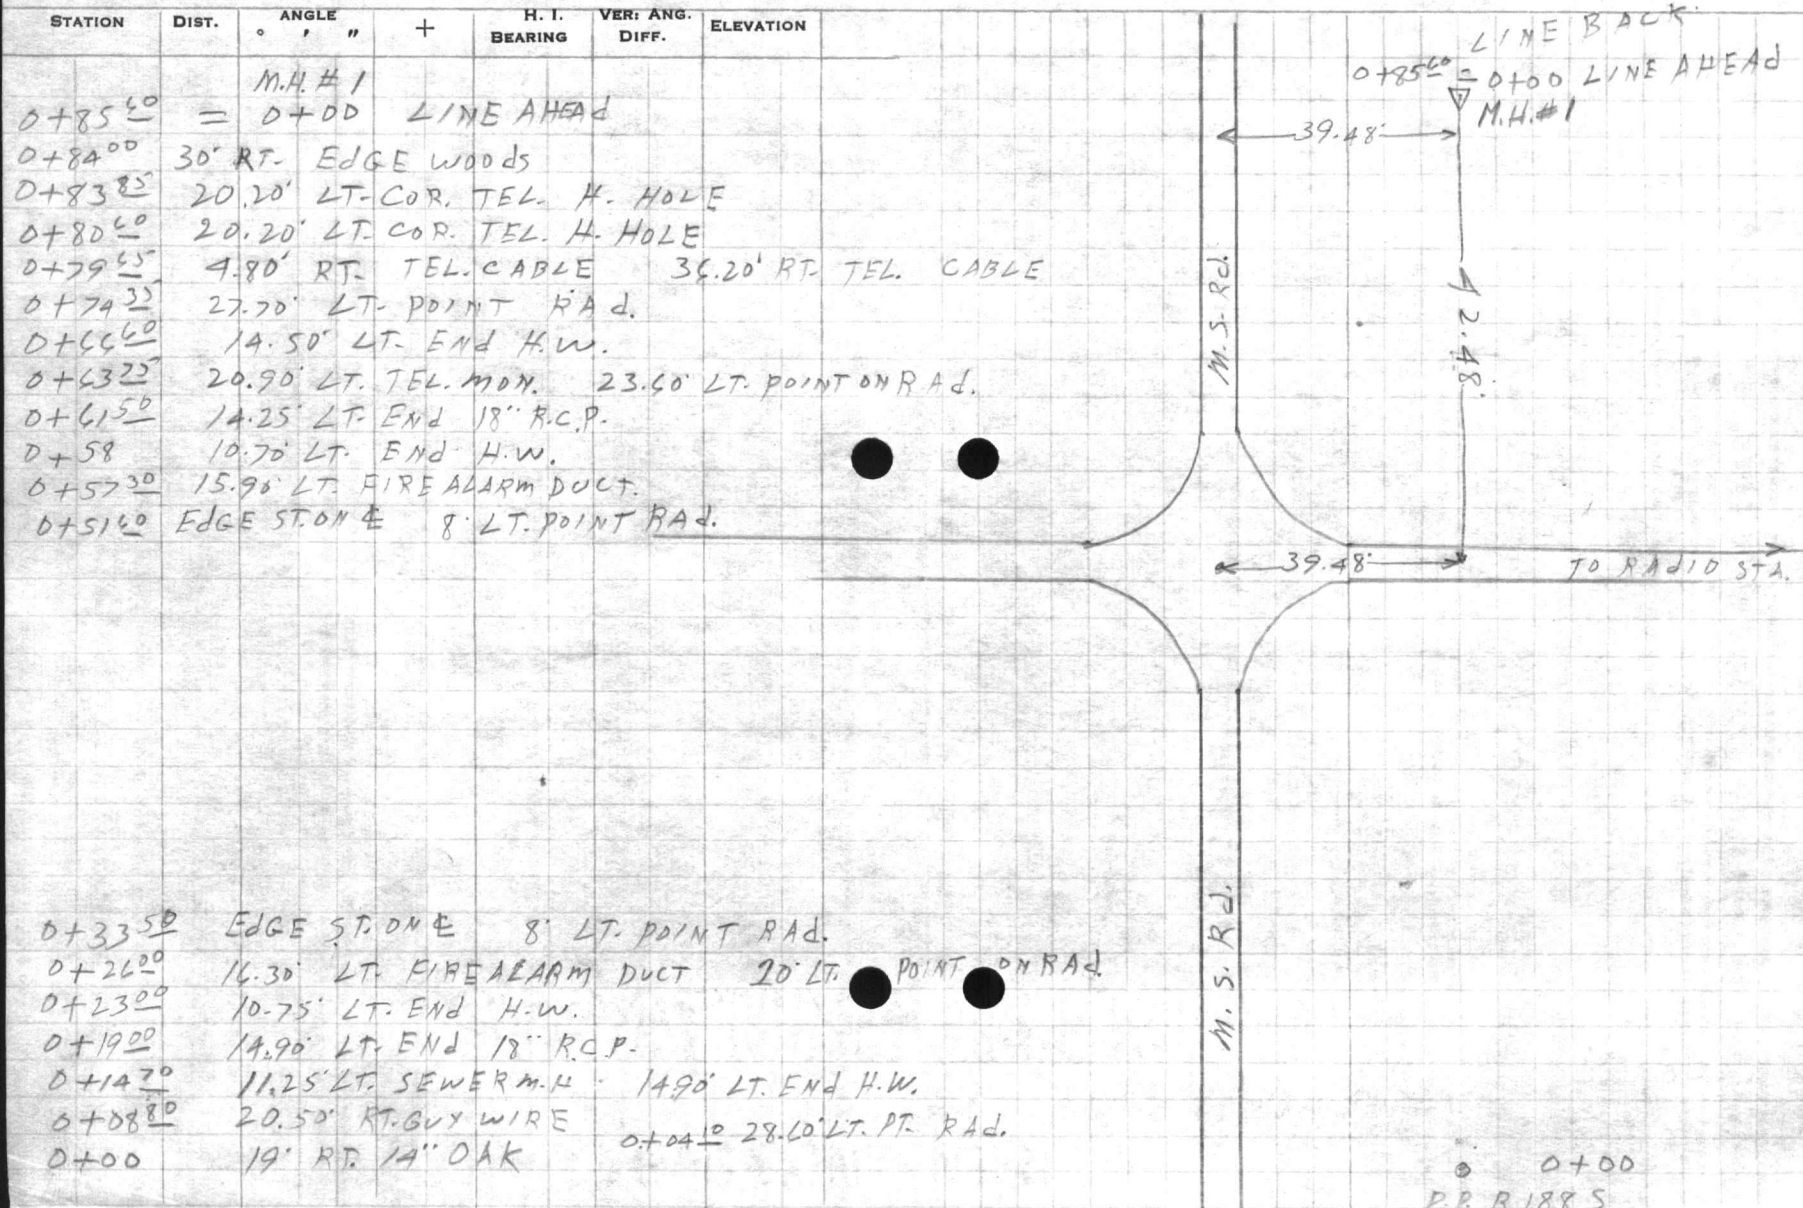
 0+00
 P.R. B 1885

VALUABLE

SUBJECT _____

 RETURN TO
 PUBLIC WORKS
 OFFICE
 CAMP LEJEUNE
 NORTH CAROLINA

FIELD PARTY

IN CHARGE _____
 INSTRUMENT _____
 NOTES _____
 TAPE READ _____
 TAPE OR ROD _____
 TAPE OR ROD _____
 INSTRUMENT No. _____
 TAPE No. _____


WEATHER

CLEAR _____ SNOW _____
 CLOUDY _____ HOT _____
 WINDY _____ MODERATE _____
 RAIN _____ COLD _____
 FAIR _____ FOG _____

FILE No. _____
 FLDR. No. _____
 SHEET 2 of
 FIGURED BY _____
 NOTES CHECKED BY _____
 PLOTTED BY _____ DATE _____ 19__


Quad. No. _____

STATION	DIST.	ANGLE " +	H. I. BEARING	VER. ANG. DIFF.	ELEVATION
5+00		24°	LT. EDGE	M.S. Rd.	
4+95		14"	PINE	DN	
4+33 ⁰⁰		1.20'	LT. 14"	PINE	
4+25 ⁰⁰		2'	RT. 14"	PINE	
4+13 ⁰⁰		13.20'	RT. 6"	PINE	
4+09 ⁰⁰		2.70'	RT. 6"	PINE	
4+00 ⁰⁰		24.50'	LT. EDGE	M.S. Rd.	
3+94		8.50'	RT. 12"	PINE	
3+93		10.50'	RT. 14"	PINE	
3+80 ⁰⁰		8.20'	RT. 16"	PINE	
3+49 ⁶⁰		1.40'	RT. 14"	PINE	
3+46 ⁵⁰		6.50'	RT. 10"	PINE	
3+45 ⁰⁰		15'	RT. 16"	PINE	
3+43 ⁰⁰		8.50'	RT. 6"	PINE	
3+40 ⁰⁰		5'	RT. 10"	PINE	
3+35 ⁰⁰		10'	RT. 14"	PINE	
3+00		27.90'	RT. EDGE	WOODS 25' LT. EDGE M.S. Rd.	
2+61 ³⁰		17.60'	RT. SEWER	M.H.	
2+35 ⁵⁰		5'	RT. 4"	TREE	
2+00		22"	RT. EDGE	WOODS 25.80' LT. EDGE M.S. Rd.	
1+00		19.90'	RT. EDGE	WOODS 27' LT. EDGE M.S. Rd.	
0+58 ²⁰			SEWER LINE	DN	
0+28 ⁰⁰		8'	RT. EDGE	WOODS	
0+03		13'	RT. COR.	WOODS	

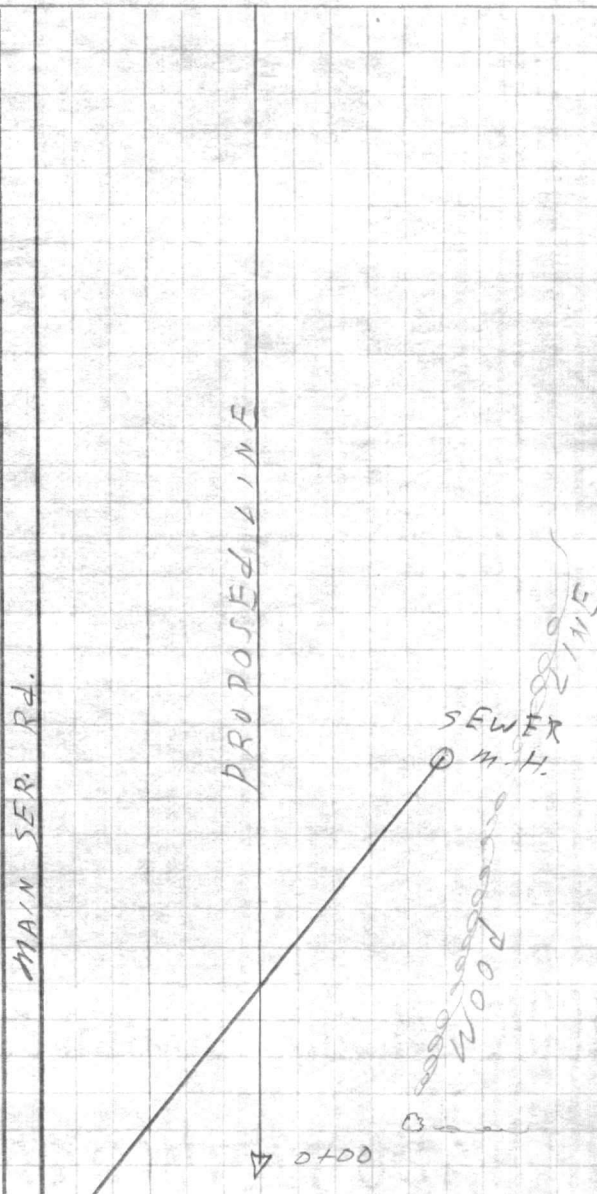



 

VALUABLE

SUBJECT _____

RETURN TO
PUBLIC WORKS
OFFICE
CAMP LEJEUNE
NORTH CAROLINA

FIELD PARTY

IN CHARGE

INSTRUMENT

NOTES

TAPE READ

TAPE OR ROD

TAPE OR ROD

INSTRUMENT No.

TAPE No.

WEATHER

CLEAR
CLOUDY
WINDY
RAIN
FAIR

SNOW
HOT
MODERATE
COLD
FOG

FILE No. _____

FLDR. No. _____

SHEET 4 of


FIGURED BY _____

NOTES CHECKED BY _____

PLOTTED BY _____ DATE _____ 19__

Quad. No. _____

STATION	DIST.	ANGLE " "	+	H. I. BEARING	VER: ANG. DIFF.	ELEVATION
9+55 ⁵⁰	15.20'	LT. END		18" R.C.P.		
9+55 ⁰⁰	30.50'	LT. POINT RAD.		TO DRIVE TO BLDG. #18		
9+55 ⁴⁰	5.60'	LT. SCRUBB		15.20' LT. POINT ON H.W.		
9+51 ³⁰	3'	LT. SCRUBB.				
9+47 ⁰⁰	2'	RT. SCRUBB		18.70' LT. END CURB		
9+44 ²⁰	15.40'	RT. WATER VALVE				
9+44 ⁹⁰	6'	LT. SCRUBB		7.50' RT. CURB & 4" DRAIN		
9+43 ¹⁵		CURB ON Φ				
9+42 ⁴⁵		CURB ON Φ				
9+39 ³⁰	11.50'	LT. POINT ON CURB RAD.				
8+91 ⁸⁰		CURB ON Φ				
8+89 ²⁰		CURB ON Φ				
8+89 ²⁰		CURB Φ 8' RT. SCRUBB.				
8+83 ⁴⁰		4' RT. SCRUBB.				
8+78 ⁵⁰	13'	LT. POINT CURB.				
8+78		SCRUBB ON Φ				
8+73 ⁵⁰	1.40'	LT. END H.W.		17.40' LT. POINT RAD TO DRIVE Bldg. 18.		
8+72 ⁰⁰	6.20'	LT. END 18" R.C.P.				
8+68 ⁰⁰	9.30'	LT. END H.W.				
8+64 ⁵⁰	29.40'	RT. P.P. A 210A				
8+61 ⁵⁰	21.50'	LT. POINT RAD. DRIVE TO BLDG # 18				
8+00	18'	LT. EDGE M.S. Rd.				
7+56 ²⁰	51.40'	RT. P.P. H.I.				
7+44	8'	RT. SCRUBB				
7+33 ⁰⁰	4.30'	RT. SCRUBB,		12.50' LT. POINT RAD.		
7+27	6'	RT. SCRUBB				

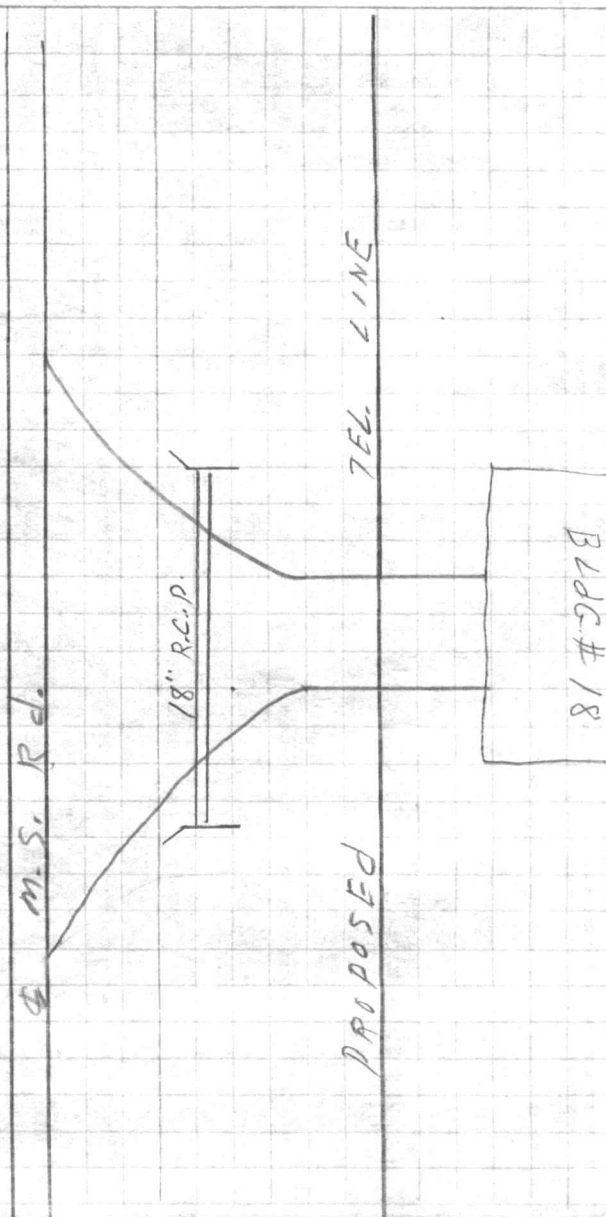

VALUABLE

SUBJECT _____

 RETURN TO
 PUBLIC WORKS
 OFFICE
 CAMP LEJEUNE
 NORTH CAROLINA

FIELD PARTY

 IN CHARGE

 INSTRUMENT

 NOTES

 TAPE READ

 TAPE OR ROD

 TAPE OR ROD

 INSTRUMENT No. _____
 TAPE No. _____

WEATHER

CLEAR
 CLOUDY
 WINDY
 RAIN
 FAIR
 SNOW
 HOT
 MODERATE
 COLD
 FOG
 FIGURED BY _____
 NOTES CHECKED BY _____
 PLOTTED BY _____

FILE No. _____
 FLDR. No. _____
 SHEET 507
 DATE _____ 19__

Quad. No. _____

STATION	DIST.	ANGLE " +	H. I. BEARING	VER. ANG. DIFF.	ELEVATION
12+54	20	5.20'	LT. 6" OAK		
12+34	20	8'	LT. 12" PINE		
12+23	50	10.10'	LT. END 18" R.C.P.		9' H.W.
12+00	00	20'	RT. WOOD LINE	29.60'	LT. EDGE M.S. RD.
11+00	00	20'	RT. WOOD LINE	30.70'	LT. EDGE M.S. RD.
10+59	80	9'	LT. 30" OAK	22'	RT. COR. WOODS
10+22	22	3'	LT. 10'		LT. SCRUBB.
10+16	20	4'	RT. SCRUBB		
10+14	80	9'	LT. SCRUBB		
10+13	25	13.60'	RT. 3" TREE		
10+07	50	30.90'	LT. EDGE M.S. RD.		
10+07	50	3.15'	RT. WATER VALVE	20.00'	LT. FIRE HYD.
9+84	89	7.30'	RT. 12" C.I.		
9+78	39	22.90'	LT. COR. TEL M.H.		
9+76	30		TEL. CABLE ON 15.80'		TEL. CABLE
9+75	49	23'	LT. COR. TEL M.H.		
AT	3	(1)	175 29 45		
BS	2	(3)	166 29 15		
TO	4	(10)	175 29 45		
9+70	39		M.H.# 3	7.35'	RT. 12" C.I.
9+64	29		175 35 30 - New Location		
9+59	20	10.10'	LT. END 4" DRAIN PIPE	17.55'	LT. END H.W.
9+57	00	9.20'	LT. END H.W.		

M.S. RD.
 PROPOSED TEL. LINE

M.H.# 9+70³⁰
 3
 9+64³⁹

VALUABLE

SUBJECT _____

RETURN TO
PUBLIC WORKS
OFFICE
CAMP LEJEUNE
NORTH CAROLINA

FIELD PARTY

IN CHARGE

INSTRUMENT

NOTES

TAPE READ

TAPE OR ROD

TAPE OR ROD

INSTRUMENT No.

TAPE No.

WEATHER

CLEAR
CLOUDY
WINDY
RAIN
FAIR

SNOW
HOT
MODERATE
COLD
FOG

FILE No. _____

FLDR. No. _____


SHEET 60A

FIGURED BY _____ NOTES CHECKED BY _____

PLOTTED BY _____ DATE _____ 19__

Quad. No. _____

STATION	DIST.	ANGLE ° ' "	+	H. I. BEARING	VER: ANG. DIFF.	ELEVATION
14+9A ⁸⁰	1.40'	RT.		COR. BRIDGE		23.90' LT. POINT ON RAD A.S.T.
14+90				CONC. LINED DITCH		(1.00' BOTTOM)
14+82 ⁷⁰	1.60'	RT.		COR. BRIDGE		
14+72 ⁷⁰				POINT RAD ON		A" ST.
14+71 ⁶⁰	3'	RT.		COR. WALK (8')		EDGE A" ST.
14+50 ⁴⁰	12'	RT.		POINT RAD ON		A" ST. FIRE ALARM
14+48 ²⁰				EDGE RAD ON		A" ST.
14+36 ⁰⁰	19.40'	LT.		POINT ON RAD		A" ST.
14+22 ⁵⁰	12'	LT.		14" PINE		
14+14 ⁰⁰	9.8'	LT.		12" PINE		28.70' LT. POINT RAD ON A" ST.
14+09 ³⁰	37'	RT.		COR. WOODS		
13+86	24'	RT.		WOOD LINE		
13+74 ²⁰	9'	LT.		12" PINE		
13+18 ⁵⁰	11'	LT.		TRIPLE. OAK.		
13+12	9.50'	LT.		12" PINE		
13+03 ⁴⁰	5.80'	LT.		8" HICKORY.		

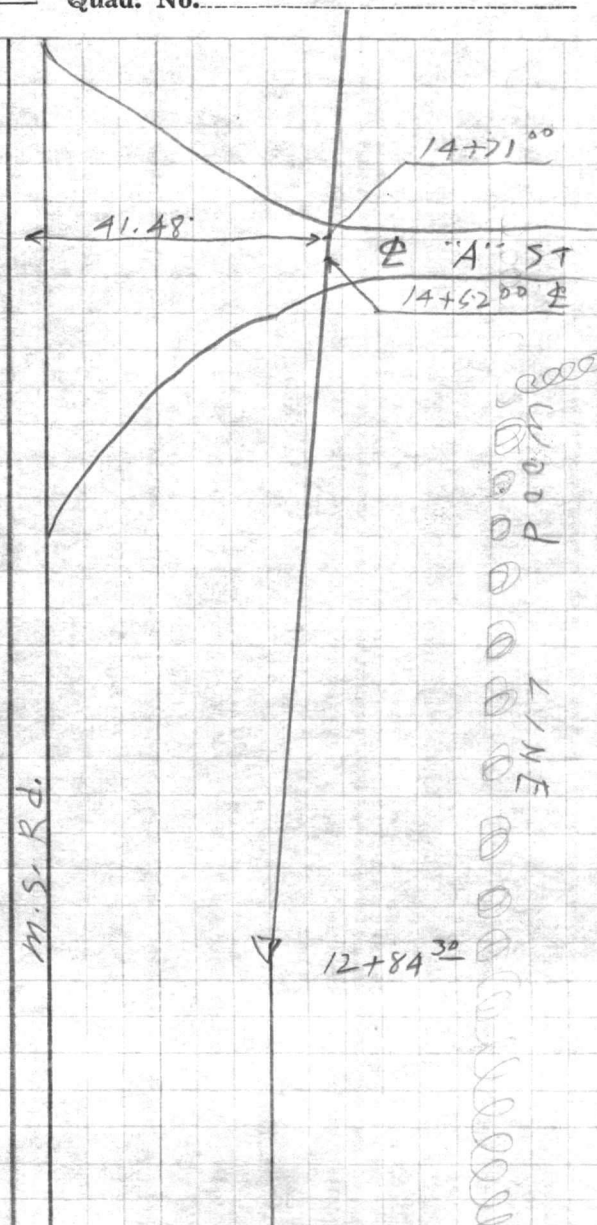

AT 4 (1) 18548 15
 B.S 3 (3) 19424 30
 T.O 5 (M) 18548 10

M.H.#4 11.50' RT. 12" C.I WATER
 12+84³⁰ 18' RT. FIRE ALARM.

12+43⁰⁰ 38.55' LT. & DRIVE FROM PARKING LOT - BLDG # 17

VALUABLE

SUBJECT _____

RETURN TO
 PUBLIC WORKS
 OFFICE
 CAMP LEJEUNE
 NORTH CAROLINA

FIELD PARTY

 IN CHARGE

 INSTRUMENT

 NOTES

 TAPE READ

 TAPE OR ROD

 TAPE OR ROD

 INSTRUMENT No. _____
 TAPE No. _____

WEATHER

CLEAR _____
 CLOUDY _____
 WINDY _____
 RAIN _____
 FAIR _____
 SNOW _____
 HOT _____
 MODERATE _____
 COLD _____
 FOG _____
 FIGURED BY _____
 NOTES CHECKED BY _____
 PLOTTED BY _____

FILE No. _____
 FLDR. No. _____
 SHEET 20f
 DATE _____ 19__

Quad. No. _____

STATION	DIST.	ANGLE ° ' "	+	H. I. BEARING	VER. ANG. DIFF.	ELEVATION
17+40 ⁹²						
17+23						
14+88 ⁶⁰						
14+51 ³⁰						
14+44 ²⁰						
14+43 ²⁰						
14+12						
14+00						
15+92 ⁴⁰						
15+19 ⁵⁰						
15+05 ⁵⁰						
15+01 ⁸⁰						

M.H.#5
 117.5 RT. P.P. - RB-2
 TOP 8" T.C. SEWER
 3' WATER LINE
 8" H. COR. ← CONS. WATER LINE
 6" H. COR. ← STEAM 6.30' RT VALVE
 2.20' RT. WALK 2.40' LT. 10" PINE
 2' RT. RT. EDGE 8' WALK 29.50' LT. EDGE M.S.R.D.
 4.70' LT. 14" PINE
 30' LT. POINT RAD. M.S.R.D. & A.S.T.
 10.60' RT. WATER VALVE
 1.75' RT. EDGE 8' WALK 5.30' RT. WATER VALVE

M.S. Rd.


PROPOSED LINE

3" WATER
 -3.87
 M.H.#5
 -2.25
 -3.90'
 -2.40
 -2.50




 




VALUABLESUBJECT LINE 7 TO PD. PROPOSED
TEL. CABLE M.A.# 5 TO 7RETURN TO
PUBLIC WORKS
OFFICE
CAMP LEJEUNE
NORTH CAROLINA

FIELD PARTY

IN CHARGE

INSTRUMENT

NOTES

TAPE READ

TAPE OR ROD

TAPE OR ROD

INSTRUMENT No.

TAPE No. _____

WEATHER

CLEAR
CLOUDY
WINDY
RAIN
FAIR
SNOW
HOT
MODERATE
COLD
FOG

FILE No. _____

FLDR. No. _____

SHEET 1 of 4DATE 12.3.56

Quad. No. _____

STATION	DIST.	ANGLE ° ' "	+	H. I. BEARING	VER: ANG. DIFF.	ELEVATION
20+75 ⁰⁵						2.70' RT. WATER VALVE
20+74 ⁰⁵						EDGE 8' CONC. WALK ON Φ
20+73 ⁶⁹						3.10' RT. COR. TWO 8' CONC. WALKS
20+65						8' LT. 15" PINE
20+60 ⁰⁰						3' C.I. WATER LINE ON Φ 2.50' RT. WATER VALVE
20+00						1.75' RT. EDGE 8' CONC. WALK 30.30' LT. EDGE M.S. RD.
19+62 ⁵⁰						1.75' RT. EDGE 8' CONC. W. 2' LT. 8" DAK
19+40						5' LT. 5" DAK
19+00 ⁰⁰						2.05' RT. EDGE 8' CONC. WALK 30' LT. EDGE M.S. RD.
18+81						3.50' LT. 10" PINE
18+72 ⁵⁰						3.50' LT. 10" PINE
18+60						5' LT. 10" PINE
18+00						4.06' RT. EDGE 8' CONC. WALK 28' LT. EDGE M.S. RD.
17+60 ⁸²						10' LT. FIRE HYD. 26.50' LT. EDGE M.S. RD.
17+60 ⁸²						5.50' RT. EDGE 8' CONC. WALK 6.90' RT. WATER VALVE
17+55 ⁹²						EDGE 5' CONC. WALK ON Φ
17+50 ⁹²						19.30' LT. COR. TEL. M.H.
17+50 ⁹²						5.75' RT. COR. 5' x 8' CONC. WALK
17+50 ⁹²						EDGE 5' CONC. WALK ON Φ
17+48 ⁴²						3' RT. P.P. # R-B 1
17+47 ⁴²						TEL. CABLE ON Φ

TEL. CABLE

M.S. RD.


PROPOSED

8' CONC. WALK

19+26⁶⁰
16' RT. F.B.

AT 5 1842400
BS. 4 2084745 = 17+40⁹² M.H.#5
TO 6 M1842352

M.H.#5
17+40⁹²

 

WALTER
CLARK
STATION
D.C.

STATION
D.C.



VALUABLE

SUBJECT _____

 RETURN TO
 PUBLIC WORKS
 OFFICE
 CAMP LEJEUNE
 NORTH CAROLINA

FIELD PARTY

 IN CHARGE

 INSTRUMENT

 NOTES

 TAPE READ

 TAPE OR ROD

 TAPE OR ROD

 INSTRUMENT NO.

 TAPE NO.


WEATHER

CLEAR _____
 CLOUDY _____
 WINDY _____
 RAIN _____
 FAIR _____
 SNOW _____
 HOT _____
 MODERATE _____
 COLD _____
 FOG _____
 FIGURED BY _____
 NOTES CHECKED BY _____
 PLOTTED BY _____

FILE No. _____
 FLDR. No. _____
 SHEET 2af
 DATE _____ 19__

Quad. No. _____

STATION	DIST.	ANGLE ° ' "	+	H. I. BEARING	VER. ANG. DIFF.	ELEVATION
AT	C	1 183 17 30				
	5	2 06 35 00				
	7	M 183 17 50				
21+62.45 M.H.#6						
21+62.45				12.75' LT. END H.W.		
21+60.25				13' LT. COR. H.W.		
21+56.30				7.80' LT. END H.W.		
21+53.50				RAD. ON Φ "B" ST.		
21+36.00				4.75' RT. COR. 8' CONCS. WALK POINT RAD. ON "B"		
21+35.20				Φ "B" ST.		
21+25.45				EDGE "B" ST. ON RAD. 4' RT. COR. 8' CONCS. WALK ON "B" ST.		
21+13.50				15.70' RT. FIRE ALARM DUCT ?		
21+08				24' LT. POINT RAD. ON "B" ST.		
21+00				77.50' LT. P.P.# A203A		
21+00				3.60' RT. EDGE 8' CONCS. WALK		
20+95.50				9.50' LT. END H.W.		
20+92.50				14.50' LT. COR. H.W.		
20+87.50				14.50' LT. END H.W.		
20+85.00				12' RT. P.P.# RZ-1		
20+82.02				EDGE 8' CONCS. ON Φ		
20+78.35				12.30' RT. WATER VALVE		
20+78.35				28.80' LT. COR. 8' CONCS. WALK POINT RAD. ON M.S. RD.		

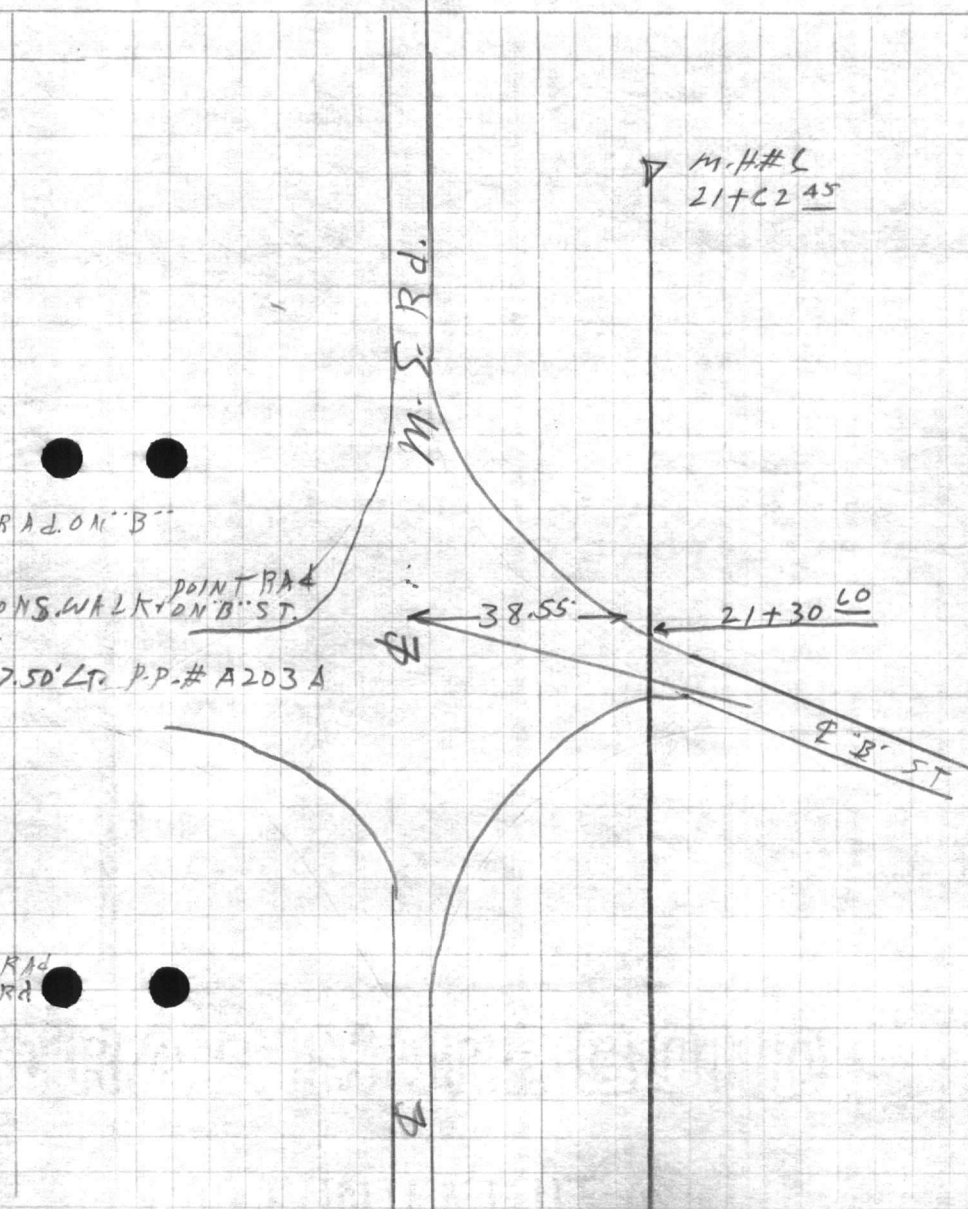

VALUABLE

SUBJECT _____

RETURN TO
 PUBLIC WORKS
 OFFICE
 CAMP LEJEUNE
 NORTH CAROLINA

FIELD PARTY

 IN CHARGE

 INSTRUMENT

 NOTES

 TAPE READ

 TAPE OR ROD

 TAPE OR ROD

 INSTRUMENT NO.

 TAPE NO. _____

WEATHER

CLEAR
 CLOUDY
 WINDY
 RAIN
 FAIR
 SNOW
 HOT
 MODERATE
 COLD
 FOG

FILE No. _____
 FLDR. No. _____
 SHEET 304
 DATE _____ 19__

FIGURED BY _____
 NOTES CHECKED BY _____
 PLOTTED BY _____
 Quad. No. _____

STATION	DIST.	ANGLE ° ' "	+	H. I. BEARING	VER. ANG. DIFF.	ELEVATION
24+98 ⁸⁵						T.E.C. CABLE ON Φ
24+92 ⁴²						EDGE 5' CONC. WALK ON Φ
24+61 ³⁰						4' LT. 12" PINE
24+54 ⁶⁰						9' LT. 14" PINE
24+49 ⁵⁵						11' RT. WATER VALVE
24+44 ⁶⁵						16" C-I. WATER LINE ON Φ
24+39 ⁷⁵						11' RT. WATER VALVE
24+30 ⁶⁰						0.50' LT. 12" PINE
24+25						4' RT. 15" PINE
24+00						5' RT. EDGE 8' CONC. WALK 27.30' LT. EDGE M.S. Rd.
23+92 ⁵⁰						11.30' LT. 20" OAK
23+71 ⁰⁰						9.40' LT. 15" GUM.
23+52 ⁵⁰						FIRE ALARM CABLE ON Φ
23+17 ⁰⁰						15.30' LT. END 18" R.C.P.
23+01 ⁰⁸						39.8' RT. COR. 5' x 8' CONC. WALK 28.30' LT. COR. 5' CONC. WALK + M.S. Rd.
22+00 ⁰⁰						27.80' LT. EDGE M.S. Rd.
21+96 ⁹⁰						17' LT. FIRE HYD.
21+96 ⁹⁰						4.52' RT. EDGE 8' CONC. WALK 6' RT. WATER VALVE
21+76 ⁴⁵						EDGE 8' CONC. WALK ON
21+68 ¹⁵						27.15' LT. COR. 5' CONC. WALK + POINT RAD. DN. M.S. Rd. ✓
21+68 ¹⁵						EDGE 5' CONC. WALK ON Φ 5.05' RT. COR. 5' x 8' CONC. WALK.
21+62 ⁴⁵						22.60' LT. 66' LT. LATERAL TEL. CABLE TO RED CROSS BLDG.


M.S. Rd.

PROPOSED TEL. CABLE

M.H.H.C
 21+62⁴⁵

1952


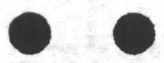


VALUABLE

SUBJECT

LINE & TO DO, PROPOSED
TEL CABLE

RETURN TO
PUBLIC WORKS
OFFICE
CAMP LEJEUNE
NORTH CAROLINA

FIELD PARTY
DENNIS IN CHARGE
INSTRUMENT
NOTES
TAPE READ
TAPE OR ROD
TAPE OR ROD
INSTRUMENT No.
TAPE No.

WEATHER
CLEAR
CLOUDY
WINDY
RAIN
FAIR
SNOW
HOT
MODERATE
COLD
FOG
FIGURED BY
NOTES CHECKED BY
PLOTTED BY

FILE No. _____
FLDR. No. _____
SHEET 1 of 3
DATE 12-4-1956

Quad. No. _____

STATION	DIST.	ANGLE ° ' "	+	H. I. BEARING	VER. ANG. DIFF.	ELEVATION
28+62	25.90'	LT. POINT RAD.				← END CURB.
28+51 ⁹⁰	245.20'	RT. SEWER m.H.				153.50' LT. SEWER m.H.
28+24	27.30'	LT. POINT RAD				"C" ST.
28+05	70 P 18"	R.C.P. ON Φ				11.70' LT. Φ D.I. 19.50' LT. POINT RAD "C" ST.
28+60						
27+91 ⁰⁰		ON RAD				ON Φ
27+98 ⁷⁹	12'	RT. POINT RAD.				ON "C" ST. 4' RT. COR. 8' WALK
27+79 ²⁸		Φ				"C" ST.
27+70 ²⁰	3.85'	RT. COR. 8' CONC. WALK				+ POINT RAD "C" ST.
27+69 ⁹⁰		RAD ON Φ				27+66 F.A. -1.55 Deep
27+60 ⁰⁰	20.20'	LT. POINT RAD				ON "C" ST.
27+51 ⁷⁵	9.20'	LT. END H.W.				
27+52 ⁶⁰	12.70'	LT. END 18" R.C.P.				
27+51 ⁶⁰	14.40'	LT. COR. H.W.				
27+46 ⁵⁰	14.40'	LT. END H.W.				
27+46	26'	LT. F.A. DUCT.				
27+33 ²⁵	28.80'	LT. POINT RAD				ON "C" ST.
27+32	3.60'	RT. 12" GUM.				10.50' RT. WATER VALVE
26+00	27.90'	LT. EDGE M.S. RD.				
25+94 ⁵⁴	7'	RT. WATER VALVE				15.90' LT. FIRE PAVG.
25+94 ⁵⁴	4.20'	RT. EDGE 8' CONC. WALK				
25+14 ³⁰	5.50'	LT. 18" PINE				

M.S. RD.

PROPOSED TEL CABLE

AT	7	1 184 24 30
	6	2 08 53 00
	8	m 184 24 30

M.H. # 7

M.H. # 7
25+04 79






VALUABLE

SUBJECT _____

RETURN TO
PUBLIC WORKS
OFFICE
CAMP LEJEUNE
NORTH CAROLINA

FIELD PARTY

IN CHARGE

INSTRUMENT

NOTES

TAPE READ

TAPE OR ROD

TAPE OR ROD

INSTRUMENT No.

TAPE No.

WEATHER

CLEAR
CLOUDY
WINDY
RAIN
FAIR
SNOW
HOT
MODERATE
COLD
FOG

FILE No. _____

FLDR. No. _____

SHEET 2 of

DATE _____ 19__

Quad. No. _____

STATION	DIST.	ANGLE " "	+	H. I. BEARING	VER. ANG. DIFF.	ELEVATION
31+16	40	0.50'	RT.	BUSH		
31+14	50	7.50'	LT.	BUSH		
31+11	40	13.30'	LT.	BUSH		
31+08	20	1.50'	RT.	BUSH		
31+04	75	2.40'	LT.	BUSH		
30+89	20	25.75'	LT.	POINT RAD		
30+82	60	6'	RT.	WATER VALVE	6.90' RT. EDGE	8' CONC. WALK
30+07	40			F.A. ON Φ		
30+03	65	20.20'	LT.	F.A. DUCT.		
29+89	95	22.80'	RT.	TEL. CABLE		

STAT 9 1 185 27 15
7 2 10 54 30
EXISTING 9 M 185 27 15
M.H.

29+77 45 = M.H. #8

29+58 00 TEL. CABLE ON Φ
29+54 90 16' LT. TEL. CABLE
29+49 18.60' LT. Φ TEL. M.H.
29+26 BUSH ON Φ 7' RT. BUSH
29+20 20 8.50' LT. BUSH
29+17 40 1' LT. BUSH 6' RT. BUSH
29+12 50 CURB ON Φ
28+89 20 CURB ON Φ
28+87 00 9.40' LT. Φ D.I.
28+85 50 3' RT. BUSH
28+83 30 4' LT. BUSH
28+77 3' RT. BUSH

M.S. Rd.

PROPOSED TEL. CABLE

29+40 22.30' LT. POINT RAD





VALUABLE

SUBJECT _____

RETURN TO
 PUBLIC WORKS
 OFFICE
 CAMP LEJEUNE
 NORTH CAROLINA

FIELD PARTY

 IN CHARGE

 INSTRUMENT

 NOTES

 TAPE READ

 TAPE OR ROD

 TAPE OR ROD

 INSTRUMENT No. _____
 TAPE No. _____

WEATHER

CLEAR
 CLOUDY
 WINDY
 RAIN
 FAIR
 SNOW
 HOT
 MODERATE
 COLD
 FOG

FILE No. _____
 FLDR. No. _____
 SHEET 3 of _____
 DATE _____ 19____

Quad. No. _____

STATION	DIST.	ANGLE ° ' "	+	H. I. BEARING	VER. ANG. DIFF.	ELEVATION
35+14 ⁴⁵				EDGE EXISTING M.H. = NEW M.H. 9		
35+00		29.40'		LT. EDGE M.S. RD.		3.70' RT. EDGE 8' CONC. WALK
34+00		29.85'		LT. EDGE M.S. RD.		3.30' RT. EDGE 8' CONC. WALK.
33+49 ⁸⁰		11.60'		LT. END 18" R.C.P.		
33+37 ⁰⁰		2.00'		RT. END 10" T.C.		
32+00		30.25'		LT. EDGE M.S. RD.		
32+70		2.70'		RT. EDGE 8' CONC. WALK		7.45' RT. WATER VALVE
32+61 ⁸⁰		30'		LT. POINT RAD. "D" ST.		M.S. RD.
32+53 ⁸⁰		27.30'		LT. RAD. ON "D" ST.		
32+36 ³⁰		2.50'		RT. COR. 8' CONC. WALK		POINT RAD. "D" ST.
32+25 ⁶⁰				Φ "D" ST.		
32+20 ⁸⁵		22'		RT. POINT RAD. "D" ST.		
32+15 ⁰⁰		2.30'		RT. COR. 8' CONC. WALK		8 "B" ST.
32+1A ¹⁰				RAD ON Φ		
32+00		1.95'		RT. EDGE 8' WALK		22.60' LT. RAD. ON "D" ST.
31+96 ⁵⁰		4.60'		LT. Φ D.I.		
31+78 ⁶⁰		29'		LT. POINT RAD. "D"		
31+69 ⁵⁰		28.60'		LT. POINT RAD. END CURB.		
31+55 ⁵⁰				BUSH ON Φ		
31+48 ⁸⁰				BUSH ON Φ		
31+44 ⁰⁰				CURB ON Φ		
31+21 ³⁰				CURB ON Φ		
31+20 ¹⁰		11.80'		LT. Φ D.I.		













































VALUABLESUBJECT PROFILE ON PROPOSED
TEL. CABLERETURN TO
PUBLIC WORKS
OFFICE
CAMP LEJEUNE
NORTH CAROLINA

FIELD PARTY

DENNIS IN CHARGE

INSTRUMENT

NOTES

TAPE READ

TAPE OR ROD

TAPE OR ROD

INSTRUMENT NO.

TAPE NO.

WEATHER

CLEAR
CLOUDY
WINDY
RAIN
FAIRSNOW
HOT
MODERATE
COLD
FOG

FILE No. _____

FLDR. No. _____

SHEET 1 ofDATE 11-29-55

FIGURED BY _____

NOTES CHECKED BY _____

PLOTTED BY _____

Quad. No. _____

STATION	DIST.	ANGLE " "	+	H. I. BEARING	VER. ANG. DIFF.	ELEVATION
B.M.				3 69 26.38		22.69
T.P.				4 28 26.08	4 58	21.80
0+42 40					4 51	21.33
0+51 60					4 51	21.33
0+54 60					4 9	20.9
0+60					6 5	19.3
0+61 50					8 03	17.81
0+66 60					4 6	21.2
0+85 60 M.H. #1					4 3	21.5
0+50					4 9	20.9
1+00					5 2	20.6
1+50					4 1	21.7
2+00					4 1	21.7
2+50					4 8	21.0
3+00					3 3	22.5
3+03 50					3 Y	22.3
3+06					4 4	21.4
3+10					3 6	22.2
3+50					3 7	22.1
4+00					4 2	21.6
4+50					3 9	21.9
4+57					4 2	21.6
4+66					4 7	21.1
4+65					4 2	21.6
5+00					4 3	21.542
T.P.				74 3 42		22.66
				5.32 27.98		

MON.# 304

Q RD TO RADIO TOWER.
EDGE ST.

14-25 LT. END 18" R.C.P.

= 0+00 LINE
AHEAD.

VALUABLE

SUBJECT _____

RETURN TO
PUBLIC WORKS
OFFICE
CAMP LEJEUNE
NORTH CAROLINA

FIELD PARTY

IN CHARGE

INSTRUMENT

NOTES

TAPE READ

TAPE OR ROD

TAPE OR ROD

INSTRUMENT NO.

TAPE NO.

WEATHER

CLEAR
CLOUDY
WINDY
RAIN
FAIR
SNOW
HOT
MODERATE
COLD
FOG
FIGURED BY _____
NOTES CHECKED BY _____
PLOTTED BY _____

FILE No. _____
FLDR. No. _____
SHEET 1 "A"
DATE _____ 19__

Quad. No. _____


STATION	DIST.	ANGLE ' " +	H. I. BEARING	VER. ANG. DIFF.	ELEVATION
			25.84 26.08		
POINT "A"				12.37	13.71
POINT "B"				13.50	12.58
Invert of 18" T.C. Sewer at Sta. 0+58.20				12.81	13.03

Flow
FLOOR LINE

+0.44

$$\frac{130}{335.5} \times 1.13 = \frac{130}{3390} \times 113 = \frac{14690}{13420} = 1.094$$

(.44)

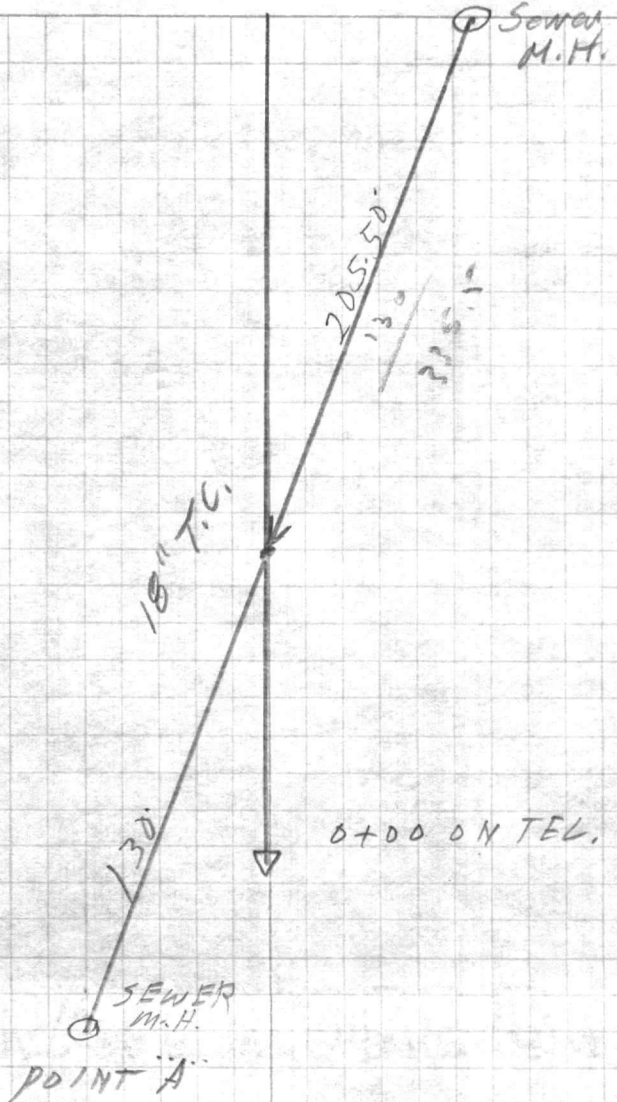

VALUABLE

SUBJECT _____

RETURN TO
PUBLIC WORKS
OFFICE
CAMP LEJEUNE
NORTH CAROLINA

FIELD PARTY

IN CHARGE

INSTRUMENT

NOTES

TAPE READ

TAPE OR ROD

TAPE OR ROD

INSTRUMENT NO.

TAPE NO.

WEATHER

CLEAR
CLOUDY
WINDY
RAIN
FAIR
SNOW
HOT
MODERATE
COLD
FOG

FILE No. _____

FLDR. No. _____

SHEET 15 of

FIGURED BY _____ NOTES CHECKED BY _____

PLOTTED BY _____ DATE _____ 19__

Quad. No. _____

STATION	DIST.	ANGLE " "	+	H. I. BEARING	VER. ANG. DIFF.	ELEVATION
---------	-------	--------------	---	------------------	--------------------	-----------

~~25.08~~
25.84

0+00 PROPOSED LINE = M.H.#1
0+00 LATERAL TO EXISTING TEL. M.H.

0+00						
0+04				49	20.9	
0+12				68	19.0	
0+17				57	20.1	
0+20.50				48	21.0	
				445	21.39	


TO P TEL. M.H.

EDGE M.H.

FLOOR	TEL. M.H.			
A		+	1.00	18.63
B		+	1.30	18.93
C		+	1.60	19.23
D		+	1.20	18.83
E		+	1.50	19.13
F		+	1.20	18.83

TOP.

Radio Tower Road

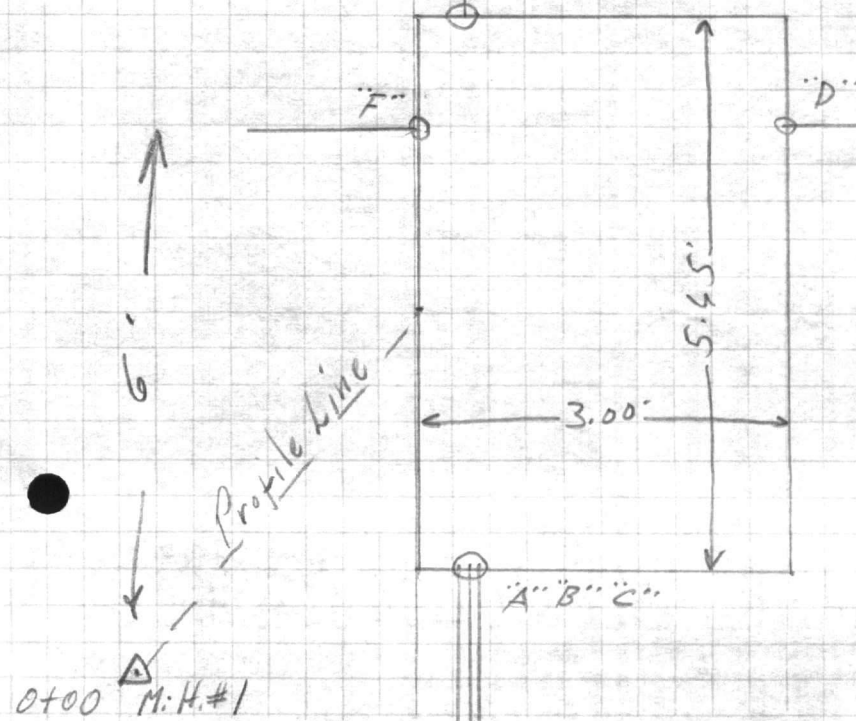









































VALUABLE

SUBJECT _____

RETURN TO
 PUBLIC WORKS
 OFFICE
 CAMP LEJEUNE
 NORTH CAROLINA

FIELD PARTY

 IN CHARGE

 INSTRUMENT

 NOTES

 TAPE READ

 TAPE OR ROD

 TAPE OR ROD

 INSTRUMENT NO. _____
 TAPE NO. _____

WEATHER

CLEAR
 CLOUDY
 WINDY
 RAIN
 FAIR
 SNOW
 HOT
 MODERATE
 COLD
 FOG
 FIGURED BY _____
 NOTES CHECKED BY _____
 PLOTTED BY _____

FILE No. _____
 FLDR. No. _____
 SHEET 2 of _____
 DATE _____ 19__

Quad. No. _____

STATION	DIST.	ANGLE		+	H. I.		VER. ANG.	ELEVATION
		°	"		BEARING	DIFF.		
						74 27 98		
5+21							C 4	21.3
5+27 50							7 0	20.7
5+27 50							11 49	16.25
5+34							C 3	21.4
5+50							C 2	21.5
5+95 39							C 2	21.5
6+00 00							C 2	21.5
6+37							S 8	21.9
6+48							C 5	21.1
6+60 50							S 3	22.4
6+65 20							S 2	22.5
6+65 20							C 85	20.89
6+69 00							S 16	22.58
6+82 25							4 90	22.84
7+00							4 95	22.79
7+06 40							4 96	22.78
7+14							S 5	22.2
7+22							7 2	20.5
7+35							C 8	20.9
7+50							C 5	21.2
8+00							C 1	21.6
8+00							C 9	20.8
8+50							S 5	22.2
8+72 00							S 2	22.5
8+72 00							7 30	20.44
8+73 50							S 2	22.5
8+76 50							S 7	22.0
8+83							4 4	23.3

(27.7)

P.I.

TOP 12" C.I. WATER LINE.

GROUND. F.A.
 TOP TELE. CABLE ADD
 EDGE CROSS ST.
 ♀ CROSS ST.

EDGE CROSS ST.

3' LT.

6.20' LT. END 18" R.C.P.

VALUABLE

RETURN TO





VALUABLE

SUBJECT _____

RETURN TO
PUBLIC WORKS
OFFICE
CAMP LEJEUNE
NORTH CAROLINA

FIELD PARTY

IN CHARGE

INSTRUMENT

NOTES

TAPE READ

TAPE OR ROD

TAPE OR ROD

INSTRUMENT NO.

TAPE NO.

WEATHER

CLEAR SNOW
CLOUDY HOT
WINDY MODERATE
RAIN COLD
FAIR FOG

FILE No. _____

FLDR. No. _____

FIGURED BY _____ SHEET _____

NOTES CHECKED BY _____

PLOTTED BY _____ DATE _____ 19__

Quad. No. _____

STATION	DIST.	ANGLE ° ' "	+	H. I. BEARING	VER: ANG. DIFF.	ELEVATION
---------	-------	----------------	---	------------------	--------------------	-----------

New
946439

175° 35' 30"

$$\begin{array}{r}
 179-59-60 \\
 175-35-30 \\
 \hline
 4^{\circ} 24' 30''
 \end{array}$$

$$\begin{array}{r}
 184 \ 24 \ 30 \\
 \hline
 0.8 \ 53 \ 80
 \end{array}$$

Old Loc 1

M.H.# 3
947039

- 3.10'

VALUABLE

SUBJECT _____

RETURN TO
PUBLIC WORKS
OFFICE
CAMP LEJEUNE
NORTH CAROLINA

FIELD PARTY

IN CHARGE

INSTRUMENT

NOTES

TAPE READ

TAPE OR ROD

TAPE OR ROD

INSTRUMENT No.

TAPE No.

WEATHER

CLEAR _____ SNOW _____
CLOUDY _____ HOT _____
WINDY _____ MODERATE _____
RAIN _____ COLD _____
FAIR _____ FOG _____
FIGURED BY _____
NOTES CHECKED BY _____
PLOTTED BY _____

FILE No. _____

FLDR. No. _____

SHEET 30

DATE _____ 19__

Quad. No. _____

STATION	DIST.	ANGLE ° ' "	+	H. I. BEARING	VERT. ANG. DIFF.	ELEVATION
				27 ³⁴ 58		
8+89 <u>20</u>					4 14	23.60
8+89 <u>20</u>					4 14	23.60
8+89 <u>80</u>					4 57	23.17
8+91 <u>80</u>					4 44	23.30
9+00					4 34	23.40
9+22					9 17	23.57
9+42 <u>50</u>					4 45	23.29
9+42 <u>65</u>					4 02	23.72
9+43 <u>10</u>					4 02	23.72
9+55 <u>50</u>					4 2	23.5
9+55 <u>50</u>					7 05	20.69
9+70 <u>39</u>					4 2	23.5
						24.82
T.P.				252 27 ³⁴ 58	2 72	25.05
9+78 <u>39</u>					3 7	23.6
9+78 <u>39</u>					5 80	21.54
10+00					3 8	23.5
10+07 <u>50</u>					9 02	18.32
10+07 <u>50</u>					4 3	23.0
10+12					3 9	23.4
10+50					4 0	23.3
10+90					4 0	23.3
11+00					4 8	22.5
11+50					6 2	21.1
12+00					6 6	20.7
12+23 <u>50</u>					6 2	21.1

15.20' LT. 18" R.C.D.

GROUND
TOP BOARD OVER TEL. CABLE

6"
TOP. 12" C.I. WATERLINE
GROUND




VALUABLE

SUBJECT _____

 RETURN TO
 PUBLIC WORKS
 OFFICE
 CAMP LEJEUNE
 NORTH CAROLINA

FIELD PARTY

 _____ IN CHARGE
 _____ INSTRUMENT
 _____ NOTES
 _____ TAPE READ
 _____ TAPE OR ROD
 _____ TAPE OR ROD
 _____ INSTRUMENT NO.
 _____ TAPE NO.

WEATHER

 CLEAR
 CLOUDY
 WINDY
 RAIN
 FAIR
 SNOW
 HOT
 MODERATE
 COLD
 FOG

FILE No. _____

FLDR. No. _____

SHEET 2 of

FIGURED BY _____

NOTES CHECKED BY _____

PLOTTED BY _____

DATE _____ 19__

Quad. No. _____

STATION	DIST.	ANGLE ' "	+	H. I. BEARING	VER. ANG. DIFF.	ELEVATION
12+23 ⁵⁰				27.3	6 52	20.82
12+50					6 2	21.1
12+84 ²⁰	P.I.				4 9	22.4
13+00					4 6	22.7
13+50					3 4	23.9
14+00					2 7	24.6
14+24					2 8	24.5
14+33					3 7	23.6
14+42 ⁵⁰					2 3	25.0
14+48 ²⁰					2 18	25.16
14+62					2 03	25.31
14+72 ²⁰					2 17	25.17
14+82					2 5	24.8
14+88 ²⁰					4 53	22.81
14+90					5 1	22.2
14+915 ⁰					4 55	22.79
14+96					3 0	24.3
15+00					2 7	24.6
T-P.				5.39 31.24	1 73	25.61 25.85
15+50					5 8	25.2
16+00					6 0	25.0
16+43 ²⁰					6 4	24.6
16+43 ²⁰					8 79	22.21
16+44 ²⁰					8 62	22.38
16+50					6 2	24.8
16+51 ³⁰					10 12	20.88

10.10' LT. FWD 18" R.C.P.

 EDGE 'A' ST.
 ⊕ 'A' ST.
 EDGE 'A' ST.

 GROUND
 TOP 6" HEL-COR,
 TOP 8" " "
 TOP 3" C.I. WATER









VALUABLE

SUBJECT _____

RETURN TO
PUBLIC WORKS
OFFICE
CAMP LEJEUNE
NORTH CAROLINA

FIELD PARTY

 _____ IN CHARGE
 _____ INSTRUMENT
 _____ NOTES
 _____ TAPE READ
 _____ TAPE OR ROD
 _____ TAPE OR ROD
 _____ INSTRUMENT No.
 _____ TAPE No.

WEATHER

 CLEAR
 CLOUDY
 WINDY
 RAIN
 FAIR
 SNOW
 HOT
 MODERATE
 COLD
 FOG

FILE No. _____

FLDR. No. _____

SHEET _____

DATE _____ 19__

FIGURED BY _____

NOTES CHECKED BY _____

PLOTTED BY _____

Quad. No. _____

STATION	DIST.	ANGLE " "	+	H. I. BEARING	VER: ANG. DIFF.	ELEVATION	
				31 ⁰⁰ 24			
16+88 ⁶⁰					C 4	24.6	G R
16+88 ⁶⁰					8 45	22.35	TOP 8" T.C. SEWER LINE
17+00					C 3	24.7	
17+40 ⁹²					5 7	25.3	
		P.I.				27.92 27.87	
T.P.				2.28	15 3 13 30.39	28.11	BACK BOLT FIRE PLUG. NEAR M.H. #5
T.P.				3.91	28 ⁵⁶ 28	5.50 29.89	
B.m.					4.27	24.33 ²⁹ 24.53	(24.33) ✓ MON. #109

VALUABLE

SUBJECT

RETURN TO
PUBLIC WORKS























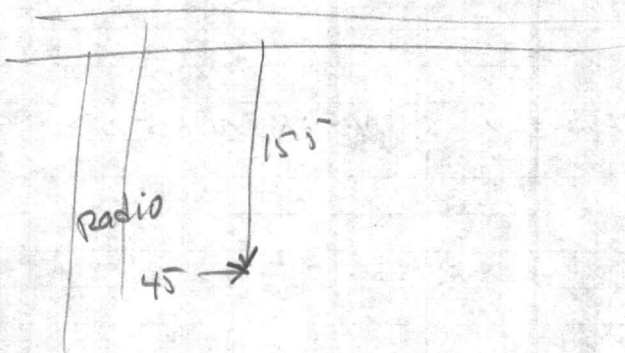

VALUABLE

 SUBJECT PROFILE ON PROPOSED
TEL. CABLE M.H. # 5
TO M.H. # 7

 RETURN TO
 PUBLIC WORKS
 OFFICE
 CAMP LEJEUNE
 NORTH CAROLINA

FIELD PARTY

DENNIS IN CHARGE

INSTRUMENT

NOTES

TAPE READ

TAPE OR ROD

TAPE OR ROD

INSTRUMENT No.

TAPE No.

WEATHER

 CLEAR
 CLOUDY
 WINDY
 RAIN
 FAIR

 SNOW
 HOT
 MODERATE
 COLD
 FOG

FILE No. _____

FLDR. No. _____

SHEET 1 of 3DATE 12-3-56

Quad. No. _____

STATION	DIST.	ANGLE " "	+	H. I. BEARING	VER. ANG. DIFF.	ELEVATION	
B.M.				2 24 30 16		27 92	BACK BOLT FIRE PLUG NEAR M.H. # 5
				(30.2)			
17+47	42				4 6	25 6	GROUND
17+47	42				6 55	23 61	TOP BOARD OVERTEL CABLE
17+50	92				4 53	25 63	EDGE 5' CONC. WALK
17+55	92				4 48	25 68	EDGE 5' CONC. WALK
17+60	82				4 6	25 6	GROUND
17+60	82				8 48	21 68	TOP. 3" C.I. WATER LINE
17+75					4 7	25 5	
18+00					4 6	25 6	
18+50					4 6	25 6	
19+00					4 7	25 5	
19+50					5 2	25 0	
20+00					5 0	25 2	
20+50					4 5	25 7	
20+60 ⁰⁰					4 25	25 91	GROUND
20+60 ⁰⁰					10 11	20.05	TOP 3" C.I. WATER LINE
20+74 ⁰⁵					3 99	26.17	EDGE 8' CONC WALK
20+82 ⁰⁹					4 02	26.14	" 8' " "
21+00					3 8	26.4	
21+13 ⁵⁰					3 71	26.45	EDGE "B" ST.
21+25 ⁴⁵					3 54	26.62	Φ "B" ST.
21+36 ⁴⁰					3 76	26.40	EDGE "B" ST.
21+47					4 0	26.2	
21+55					5 4	24.8	
21+62 ⁴⁵					4 4	25.8	
B.M.				2.00 28.86		3 30 26 86	SPIKE IN D.P.# RZ-1 STA 20+85 ⁰⁰ 12' RT.

 4.41
 3.87
 8.48

 4.25
 5.86
 10.11





















VALUABLE

SUBJECT _____

RETURN TO
PUBLIC WORKS
OFFICE
CAMP LEJEUNE
NORTH CAROLINA

FIELD PARTY

IN CHARGE

INSTRUMENT

NOTES

TAPE READ

TAPE OR ROD

TAPE OR ROD

INSTRUMENT No.

TAPE No.

WEATHER

CLEAR
CLOUDY
WINDY
RAIN
FAIR
SNOW
HOT
MODERATE
COLD
FOG
FIGURED BY _____
NOTES CHECKED BY _____
PLOTTED BY _____

FILE No. _____

FLDR. No. _____

SHEET 2 of

DATE _____ 19__

Quad. No. _____

STATION	DIST.	ANGLE " "	+	H. I. BEARING	VERI ANG. DIFF.	ELEVATION		
				28.86				
21+68 ¹⁵					6 49	22.37	TOP EXISTING TEL. CABLE TO RED CROSS BLDG.	
21+76 ¹⁵					2 94	25.92	EDGE 8' CONC. WALK	
21+96 ⁹⁰					2 95	25.91	" 8' " "	
21+96 ⁹⁰					3 3	25.6	GROUND	
22+00					8 15	20.71	TOP 6" C.I. WATER LINE	
22+50					3.6	25.3		
23+00					4 3	24.6		
23+01 ⁰⁸					4 6	24.3		
23+06 ⁰⁸					4 46	24.4	EDGE 5'	
23+12					4 45	24.41	" 5'	
23+17					4 7	24.2	DITCH	
23+17					5 8	23.1	15.30' LT. END. 18" R.C.P.	
23+21 ⁵⁰					7 09	21.77		
23+50					4 5	24.4		
23+52 ⁵⁰					4 4	24.5	GROUND	
23+52 ⁵⁰					4 2	24.7	TOP FIRE ALARM CABLE	
24+00					5 97	22.89		
24+44 ⁶⁵					4 0	24.9		
24+44 ⁶⁵					3.8	25.1	GROUND	
24+61					9 25	19.61	TOP 16" C.I. WATER LINE	
24+92 ⁴²					3 5	25.4		
24+97 ⁴²					3 88	24.98	EDGE 5' CONC. WALK	
24+98 ⁸⁵					3 95	24.91	" 5' " "	
24+98 ⁸⁵					4 0	24.9	GROUND	
25+00					5 80	23.06	TOP BOARD OVER TEL. CABLE	
25+04 ⁷⁹					4.1	24.8		
B.M.				412	29 62	3 36	25 50	SPIKE IN RP# RC-1 STA. 24+99 ⁵⁰ 17' RT.

3.33
4.82
8.15

1.50
5.59
7.09

5.40 1.77
3.81 4.20
9.25 5.97

4.00
1.80
5.80

VALUABLE

SUBJECT PROFILE ON PROPOSED
TEL. CABLE

RETURN TO
PUBLIC WORKS
OFFICE
CAMP LEJEUNE
NORTH CAROLINA

FIELD PARTY
DENNIS IN CHARGE
INSTRUMENT _____
NOTES _____
TAPE READ _____
TAPE OR ROD _____
TAPE OR ROD _____
INSTRUMENT No. _____
TAPE No. _____

WEATHER
CLEAR CLOUDY
WINDY RAIN FAIR
SNOW HOT MODERATE COLD FOG
FIGURED BY _____
NOTES CHECKED BY _____
PLOTTED BY _____

FILE No. _____
FLDR. No. _____
SHEET 1 of 3
DATE 12 4 19 55

Quad. No. _____

STATION	DIST.	ANGLE " "	+	H. I. BEARING	VER: ANG. DIFF.	ELEVATION	
B.M.				1 61 27 11		25 50	SPIKE IN P.P.# RCI NEAR M.H.# 7
25+09					2 3	24.8	
25+16					3 0	24.1	
25+50					3 4	23.7	
25+94	<u>54</u>				4 0	23.1	GROUND
25+94	<u>54</u>				8 86	18.25	TOP 6" C.I. WATER LINE
26+00					4 2	22.9	
26+50					4 7	22.4	
27+00					4 9	22.2	
27+47					4 7	22.4	
27+53					6 4	20.7	
27+52	<u>40</u>			12.70' LT.	6 81	20.3	18" R.C.P.
27+61					4 1	23.0	
27+69	<u>90</u>				3 75	23.30	EDGE 'C' ST.
27+79	<u>78</u>				3 41	23.50	E 'C' ST.
27+91	<u>00</u>				3 99	23.12	EDGE 'C' ST.
28+00					4 0	23.1	
28+05					3 9	23.2	GROUND
28+05					6 07	21.04	TOP 18" R.C.P.
28+05					4 00	23.1	TOP D.I. 11.70' LT-
28+05					7 27	19.84	BOTTOM D.I. 11.70' LT.
28+51	<u>40</u>			Top El. 15.0	3 5	23.5	GROUND OVER 10" T.C. SEWER.
28+87	<u>00</u>				3 2	23.9	GROUND.
28+87	<u>00</u>				3 95	23.16	TOP D.I. 9.40' LT.
28+87	<u>00</u>				6 54	20.57	BOTTOM D.I. 9.40' LT.
28+89	<u>20</u>				3 36	23.75	TOP CURB
28+89	<u>20</u>				3 87	23.24	BOTTOM CURB.
29+00					3 59	23.52	
29+12	<u>50</u>				3 78	23.33	BOTTOM CURB
29+12	<u>50</u>				3 27	23.84	TOP CURB

4 0 0
+ 8 6
8.8 6

3.54
213
6.07

18" R.C.P.















VALUABLE

SUBJECT _____

RETURN TO
PUBLIC WORKS
OFFICE
CAMP LEJEUNE
NORTH CAROLINA

FIELD PARTY

IN CHARGE

INSTRUMENT

NOTES

TAPE READ

TAPE OR ROD

TAPE OR ROD

INSTRUMENT No.

TAPE No.

WEATHER

CLEAR
CLOUDY
WINDY
RAIN
FAIR
SNOW
HOT
MODERATE
COLD
FOG
FIGURED BY _____
NOTES CHECKED BY _____
PLOTTED BY _____

FILE No. _____

FLDR. No. _____

SHEET 204

DATE _____ 19__

Quad. No. _____

5.45

STATION	DIST.	ANGLE		+	H. I. BEARING	VER. ANG. DIFF.	ELEVATION
		'	"				
T.P.					27.11		
					✓ 195		25.16
				334	2850		
29+50					45		24.0
29+54 ⁹⁰					840		20.1
29+77 ⁴⁵					45		24.0
29+88 ⁹⁵					810		20.4
30+00					46		23.9
30+07 ⁸⁰					46		23.9
30+50 ⁰⁰					47		23.8
30+82					48		23.7
30+82 ⁰⁰					1149		17.0
31+00					49		23.6
31+20 ¹⁰					51		23.4
31+20 ¹⁰					617		22.3
31+20 ¹⁰					852		19.98
B.M.					✓ 625		22.25
				382	2607		
31+21 ³⁰					287		23.2
31+21 ²⁰					337		22.7
31+44 ⁰⁰					345		22.62
31+44 ⁰⁰					292		23.15
31+50					30		23.1
31+75					37		22.4
31+94 ⁵⁰					46		21.5
31+94 ⁵⁰					474		21.3
31+94 ⁵⁰					861		17.5
31+98 ⁰⁰					578		20.29

16' LT. TOP TEL. CABLE

22.85 RT. TOP TEL. CABLE

GROUND AT FIRE ALARM CABLE. EVEN.
CABLE SEE SHEET 2 "A"

GROUND.

TOP- 8" C.I. WATER LINE

GROUND.

TOP D.I. 11.80' LT. 18" R.C.P.

BOTTOM D.I. 11.80' LT.

SPIKE IN RP# A195A

TOP CURB

BOTTOM CURB.

TOP CURB

BOTTOM CURB.

GROUND

TOP D.I. 4.60' LT. 18" R.C.P.

BOTTOM D.I. 4.60' LT.

TOP 18" R.C.P. ONE

VALUABLE









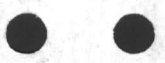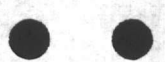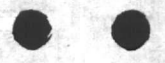

VALUABLE

SUBJECT _____

RETURN TO
PUBLIC WORKS
OFFICE
CAMP LEJEUNE
NORTH CAROLINA

FIELD PARTY

IN CHARGE

INSTRUMENT

NOTES

TAPE READ

TAPE OR ROD

TAPE OR ROD

INSTRUMENT NO.

TAPE NO.

WEATHER

CLEAR
CLOUDY
WINDY
RAIN
FAIR

SNOW
HOT
MODERATE
COLD
FOG

FILE No. _____

F.LDR. No. _____

SHEET 3 of 4

DATE _____ 19__

Quad. No. _____

STATION	DIST.	ANGLE " "	+	H. I. BEARING	VER. ANG. DIFF.	ELEVATION	
				26 07			
32 + 14					4 57	21.5	EDGE 'D' ST.
32 + 25 ⁶⁰					4 35	21.72	⊕ 'D' ST
32 + 36 ³⁰					4 45	21.62	EDGE 'D' ST.
32 + 47					4 4	21.7	GROUND
32 + 48					5 70	20.4	TOP FIRE ALARM.
33 + 00					4 2	21.9	
33 + 34					4 9	21.2	
33 + 37					5 90	21.2	2:00' RT. 10' T.C. PIPE UNDER
33 + 38					6 1	19.97	DITCH WALK
33 + 43					4 8	21.3	
33 + 49 ⁸⁰					4 6	21.5	
33 + 49 ⁸⁰					7 15	18.9	11:40' LT. 18' R.C.D.
34 + 00					4 3	21.8	
34 + 50					3 8	22.3	
34 + 99					2 90	23.2	GROUND
34 + 99					5 42	20.6	TOP ?
35 + 00					2 9	23.2	
35 + 44 ⁴⁵					2 6	23.5	END LINE GROUND
					3 05	23.02	TOP EXISTING TEL. M. H.
					9 13	16.94	BOTTOM EXISTING TEL. M. H.
B.m.				2 75 26 76	2 06	24 01	SPIKE IN P.P. # RE-1 NEAR EXISTING
T.P.				3 33 28 92	1 17	25 59	TEL. M. H.
B.m.					1 53	27 39	FINISH FL. & BACK DOOR BLDG. # 202






























VALUABLE

RETURN TO
PUBLIC WORKS
OFFICE
CAMP LEJEUNE
NORTH CAROLINA

SUBJECT ELEV. EXISTING.
SEWER M.H.

FIELD PARTY

IN CHARGE

INSTRUMENT

NOTES

TAPE READ

TAPE OR ROD

TAPE OR ROD

INSTRUMENT NO.

TAPE NO.


WEATHER

CLEAR
CLOUDY
WINDY
RAIN
FAIR
SNOW
HOT
MODERATE
COLD
FOG

FILE No. _____
FLDR. No. _____
SHEET 2 "A"
DATE _____ 19__

FIGURED BY _____
NOTES CHECKED BY _____
PLOTTED BY _____
Quad. No. _____

STATION	DIST.	ANGLE " "	+	H. I. BEARING	VER. ANG. DIFF.	ELEVATION	
Bm.				C 01 30 24 28 26		22 25	SPIKE IN P.P.# A195 A
A				12 63	17.63 15 03		
"B"				13.74	14.52 11.74		
STA-30+0780				5 45	22.81		TOP FIRE ALARM CABLE

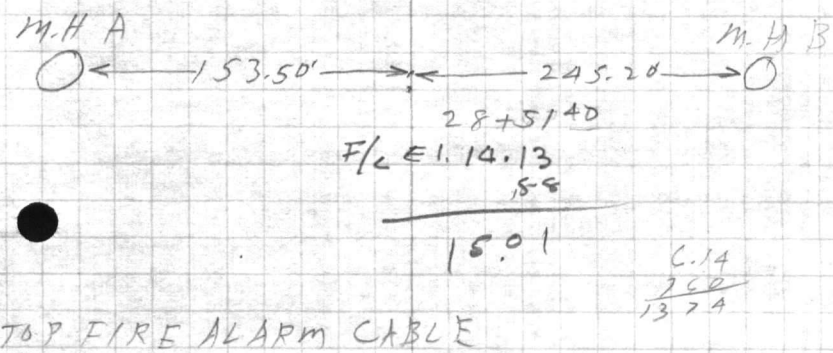

30 26
 5 45
 24.81

28 50
 24.81
 3.69

VALUABLERETURN TO
PUBLIC WORKS
OFFICE
CAMP LEJEUNE
NORTH CAROLINA

SUBJECT

CONST. BENCH MARKS
PROPOSED TEL. CABLE

FIELD PARTY

DENNIS

IN CHARGE

INSTRUMENT

NOTES

TAPE READ

TAPE OR ROD

TAPE OR ROD

INSTRUMENT No.

TAPE No.

WEATHER

CLEAR
CLOUDY
WINDY
RAIN
FAIRSNOW
HOT
MODERATE
COLD
FOG

FIGURED BY

NOTES CHECKED BY

PLOTTED BY

FILE No.

FLDR. No.

SHEET

DATE

Quad. No.

1041

12-5 1956

STATION	DIST.	ANGLE " "	+	H. I. BEARING	VER. ANG. DIFF.	ELEVATION	
B.m.				4.97 29.30		24.33	MON. # 309
B.m.				3.77 29.18	3.89	25.41	SPIKE IN 12" PINE 10' LT. STA. 14+15 ±
B.m.					4.85	24.33	MON. # 309 29.18 24.33 4.78
B.m.				4.43 26.88		22.45	MON. # 304
B.m.				5.07	5.00	21.88	SPIKE IN P.P.# B 1885 SOUTHWEST COR. M.S. Rd. & Rd. TO RADIO STA.
B.m.					4.50		MON. # 304

VALUABLE

RETURN TO
PUBLIC WORKS
OFFICE
CAMP LEJEUNE
NORTH CAROLINA

SUBJECT PRO FILE ON LATERAL
FROM EXISTING TEL.
MAN HOLE SOUTH SIDE
MAIN SER. RD. BETWEEN BLDG'S
102 & 17. TO P.P.# RB-2

FIELD PARTY

IN CHARGE

INSTRUMENT

NOTES

TAPE READ

TAPE OR ROD

TAPE OR ROD

INSTRUMENT NO.

TAPE NO.

WEATHER

CLEAR _____ SNOW _____
CLOUDY _____ HOT _____
WINDY _____ MODERATE _____
RAIN _____ COLD _____
FAIR _____ FOG _____

FIGURED BY _____
NOTES CHECKED BY _____
PLOTTED BY _____

FILE No. _____
FLDR. No. _____
SHEET 1 of
DATE 12-3 19__

Quad. No. _____

STATION	DIST.	ANGLE ° ' "	+	H. I. BEARING	VER: ANG. DIFF.	ELEVATION	
B.M.				252 30 44		27 92	BACK BOLT FIRE PLUG # M-H # 5
0+00					3 65		SOUTH WEST COR. EXISTING TEL. M. H.
0+04 50					4 0		
0+10					5 6		
0+17					4 8		
0+19 50					4 9		ON
0+25 80					5 08		ON 8' CONC-W
0+33 80					4 92		ON 8' " W.
0+43					4 7		
1+00					4 6		
1+19 50							GUY
1+22 80							GUY
1+39					4 4 26.0		P.P.# RB-2








VALUABLERETURN TO
PUBLIC WORKS
OFFICE
CAMP LEJEUNE
NORTH CAROLINASUBJECT PROFILE ON LATERAL
FROM EXISTING TEL. M.H.
STA. 25+00^{SD} 18' LT.FIELD PARTY
DENNIS IN CHARGE
INSTRUMENT _____
NOTES _____
TAPE READ _____
TAPE OR ROD _____
TAPE OR ROD _____
INSTRUMENT NO. _____
TAPE NO. _____WEATHER
CLEAR _____
CLOUDY _____
WINDY _____
RAIN _____
FAIR _____
SNOW _____
HOT _____
MODERATE _____
COLD _____
FOG _____
FIGURED BY _____
NOTES CHECKED BY _____
PLOTTED BY _____FILE No. _____
FLDR. No. _____
SHEET 1 of 1
DATE 12-3-56

Quad. No. _____

STATION	DIST.	ANGLE ° ' "	+	H. I. BEARING	VER. ANG. DIFF.	ELEVATION
B.M.			4 40	29 62 (29.6)		25 22
0+00					4 69	24 98
0+03					4 9	24 7
0+08 ^{SD}					5 5	24 1
0+14					5 0	24 6
0+25					4 56	24 86
0+33					4 64	24 98
0+51					4 4	25 2
0+80					4 1	25 5
1+00					4 2	25 4
1+50					4 1	25 5
1+70						
1+75					3 6	26 0
1+89 ^{SD}					3 6	26 0

MON. # 315

S.W. COR. EXISTING TEL. M.H. STA 25+00^{SD}
18' LT.

EDGE 8' CONC. WALK

EDGE 8' " "

GUY

GUY

P.P. # RC-2













VALUABLE

SUBJECT _____

RETURN TO
PUBLIC WORKS
OFFICE
CAMP LEJEUNE
NORTH CAROLINA

FIELD PARTY

IN CHARGE

INSTRUMENT

NOTES

TAPE READ

TAPE OR ROD

TAPE OR ROD

INSTRUMENT No.

TAPE No.

WEATHER

CLEAR
CLOUDY
WINDY
RAIN
FAIR
SNOW
HOT
MODERATE
COLD
FOG

FILE No. _____

FLDR. No. _____

SHEET 307

FIGURED BY _____ NOTES CHECKED BY _____

PLOTTED BY _____ DATE _____ 19__

Quad. No. _____

STATION	DIST.	ANGLE ° ' "	+	H. I. BEARING	VER: ANG. DIFF.	ELEVATION
Bm.				29.62	440 25 22 (25.22)	MON.# 315




VALUABLE

SUBJECT _____

 RETURN TO
 PUBLIC WORKS
 OFFICE
 CAMP LEJEUNE
 NORTH CAROLINA

FIELD PARTY

IN CHARGE _____
 INSTRUMENT _____
 NOTES _____
 TAPE READ _____
 TAPE OR ROD _____
 TAPE OR ROD _____
 INSTRUMENT No. _____
 TAPE No. _____


WEATHER

CLEAR _____
 CLOUDY _____
 WINDY _____
 RAIN _____
 FAIR _____
 SNOW _____
 HOT _____
 MODERATE _____
 COLD _____
 FOG _____
 FIGURED BY _____
 NOTES CHECKED BY _____
 PLOTTED BY _____

FILE No. _____
 FLDR. No. _____
 SHEET _____
 DATE _____ 19__

Quad. No. _____

STATION	DIST.	ANGLE ° ' "	+	H. I. BEARING	VER. ANG. DIFF.	ELEVATION
---------	-------	----------------	---	------------------	--------------------	-----------

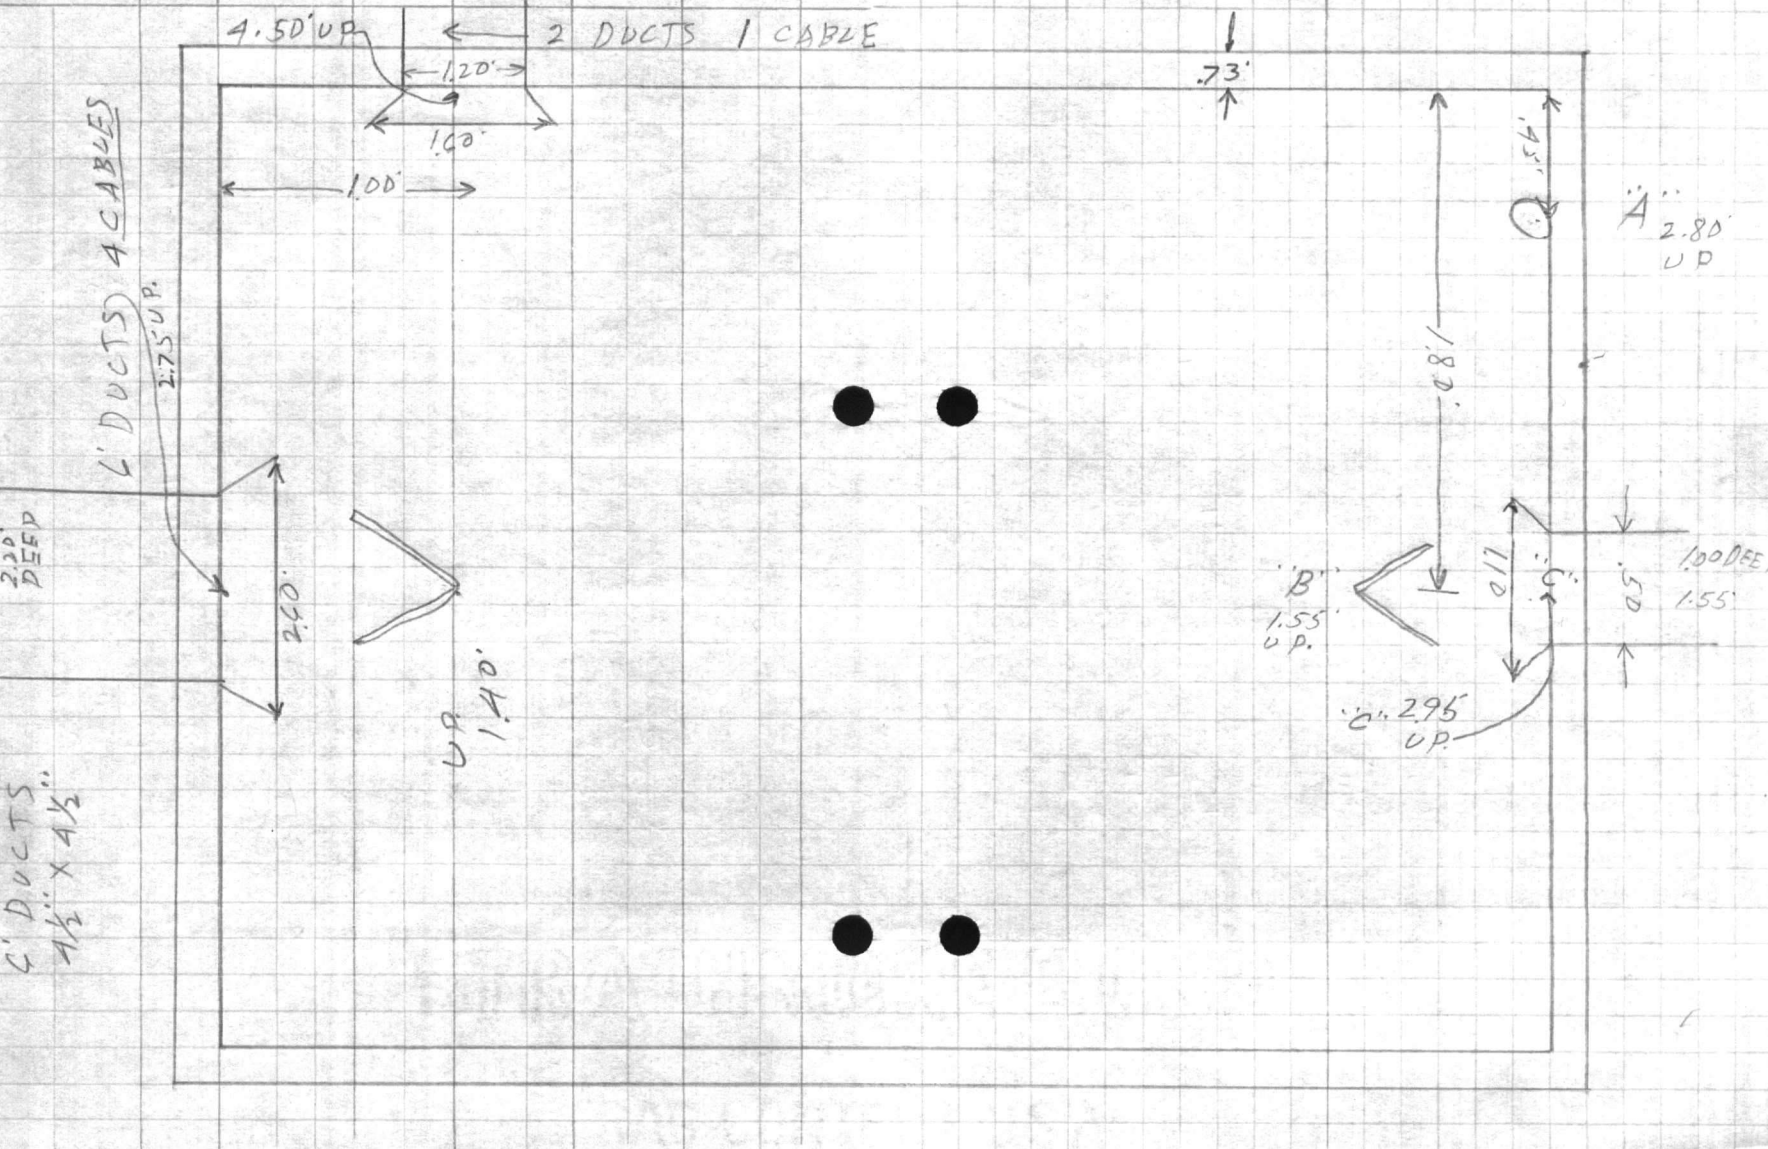

VALUABLERETURN TO
PUBLIC WORKS
OFFICE
CAMP LEJEUNE
NORTH CAROLINASUBJECT LINE & TOPO. ON
PROPOSED TEL. CABLE
"L" ST. TO "N" ST.
AREA # 5FIELD PARTY
DEANIS IN CHARGE

INSTRUMENT

NOTES

TAPE READ

TAPE OR ROD


TAPE OR ROD

INSTRUMENT No.

TAPE No. _____WEATHER
CLEAR _____
CLOUDY _____
WINDY _____
RAIN _____
FAIR _____
SNOW _____
HOT _____
MODERATE _____
COLD _____
FOG _____
FIGURED BY _____
NOTES CHECKED BY _____
PLOTTED BY _____
FILE No. _____
FLDR. No. _____
SHEET 1 of 1
DATE 12-8-56

Quad. No. _____

STATION	DIST.	ANGLE " "	+	H. I. BEARING	VER. ANG. DIFF.	ELEVATION
↑ AT #1	1	179 48 15				
BS. 0+00	2	369 36 45				
TO	2	179 48 22				
2+62.71						
2+54.21 = M.H.#1				4.70' LT. EDGE D.I.		
2+00				19.30' RT. EDGE TUNNEL	25.60' LT. EDGE M.S. RD.	
1+00				19' RT. EDGE TUNNEL	25.70' LT. EDGE M.S. RD.	
0+70.30				26' LT. PT. RAD. "L" ST. & M.S. RD.		
0+54.70				2' RT. TEL. CABLE	20' LT. RAD ON "L" ST.	
0+40.20				RAD	"L" ST.	
0+42.50				19' RT. COR. TUNNEL & "L" ST.		
0+35.20				Φ "L" ST.		
0+23.70				31.70' RT. PT. RAD ON "L" ST.		
0+20.80				RAD	"L" ST.	
0+14.30				L.A. CABLE		
0+00				23.50' LT. ON RAD & L.A.		

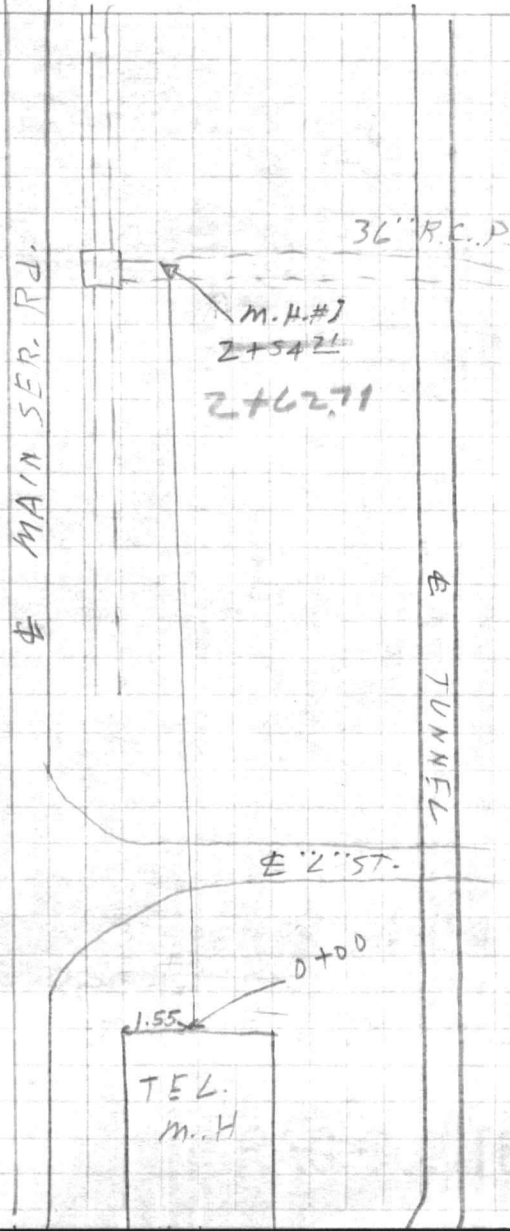25.41' LT. NAIL IN 89°42' 00"
BOTTLE CAP EDGE M.S. RD.0+43.35 NAIL IN
BOTTLE CAP.

VALUABLE

SUBJECT PIT - DETAIL
SOUTHWEST COR.
M.S. RD. & 4th ST.

RETURN TO
PUBLIC WORKS
OFFICE
CAMP LEJEUNE
NORTH CAROLINA

FIELD PARTY

IN CHARGE

INSTRUMENT

NOTES

TAPE READ

TAPE OR ROD

TAPE OR ROD

INSTRUMENT NO.

TAPE NO.


WEATHER

CLEAR
CLOUDY
WINDY
RAIN
FAIR
SNOW
HOT
MODERATE
COLD
FOG
FIGURED BY _____
NOTES CHECKED BY _____
PLOTTED BY _____

FILE No. _____
FLDR. No. _____
SHEET 1 "A"
DATE _____ 19__

Quad. No. _____

STATION	DIST.	ANGLE ° ' "	+	H. I. BEARING	VER. ANG. DIFF.	ELEVATION
---------	-------	----------------	---	------------------	--------------------	-----------

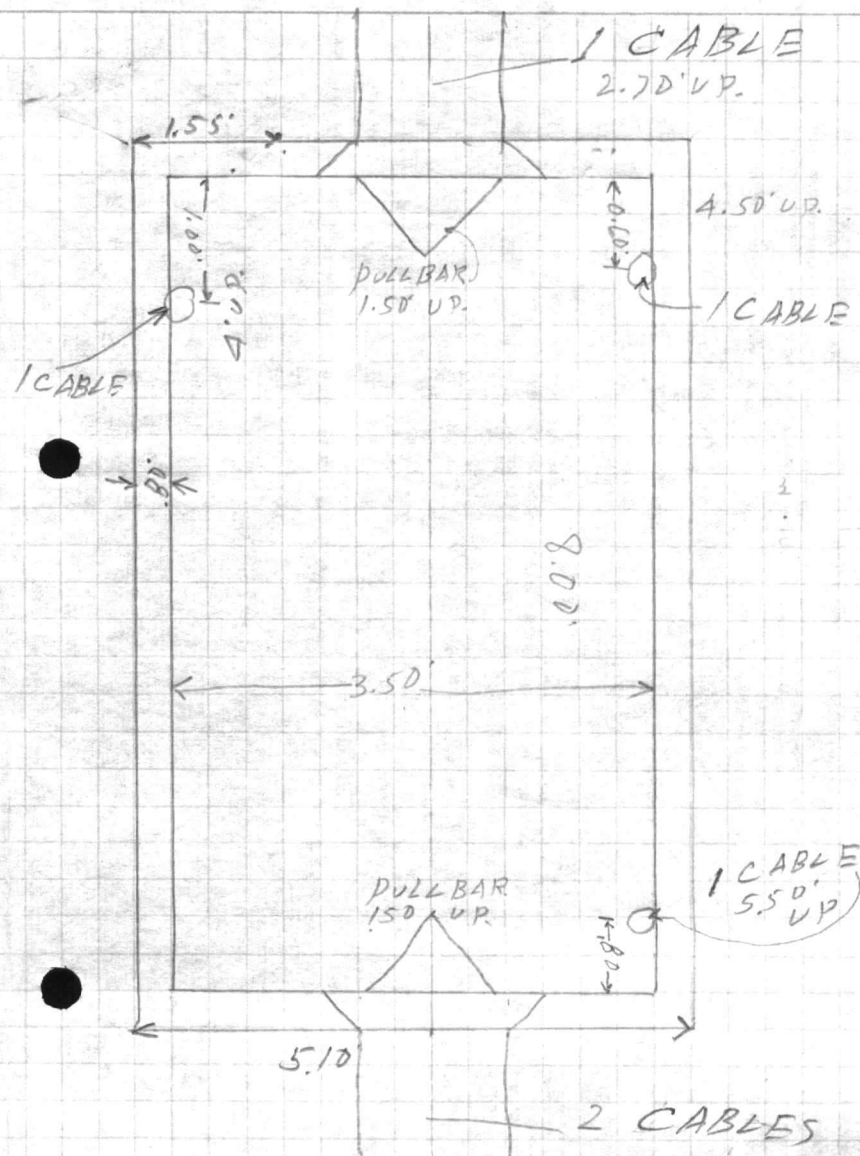






VALUABLE

SUBJECT _____

 RETURN TO
 PUBLIC WORKS
 OFFICE
 CAMP LEJEUNE
 NORTH CAROLINA

FIELD PARTY

 _____ IN CHARGE
 _____ INSTRUMENT
 _____ NOTES
 _____ TAPE READ
 _____ TAPE OR ROD
 _____ TAPE OR ROD
 _____ INSTRUMENT NO.
 _____ TAPE NO.

WEATHER

 CLEAR
 CLOUDY
 WINDY
 RAIN
 FAIR
 SNOW
 HOT
 MODERATE
 COLD
 FOG

FILE No. _____

FLDR. No. _____

SHEET 2 of

NOTES CHECKED BY _____

FIGURED BY _____ DATE _____ 19__

PLOTTED BY _____

Quad. No. _____

STATION	DIST.	ANGLE ° ' "	+	H. I. BEARING	VER. ANG. DIFF.	ELEVATION
C+00		22.55'	RT.	EDGE TUNNEL		23.50' LT-EDGE M.S.Rd.
S+00		20.75'	RT.	EDGE TUNNEL.		24.20' LT-EDGE M.S.Rd.
A+8450		5'	LT.	Ø	DROP INLET	
A+7785		4.20'	RT.	EXISTING	TEL. CABLE	
A+6820		24'	LT.	PT. RAD.	"m" ST. + M.S.Rd.	
A+6380		17.50'	RT.	WATER	VALVE	
A+49		19'	LT.	RAD.	ON "m" ST.	
A+38		6.15'	LT.	FIRE ALARM	DUCT.	
A+3160				RAD.	ON "m" ST.	
A+2950				NAIL IN BOTTLE CAP	NEAR EAST EDGE "m" ST.	
A+2550		21.35'	RT.	PT. RAD.	"m" ST. EDGE TUNNEL.	
A+1630				Ø	"m" ST.	
A+0740		16.50'	RT.	PT. RAD.	ON "m" ST.	
A+0130				RAD.	ON "m" ST. ON Ø	
3+62		24.50'	LT.	PT. RAD.	M.S.Rd. + "m" ST.	
3+5880		6' CI.	WATER	ON Ø	7.60' RT. WATER VALVE	14.30' LT. FIRE PLUG
3+00		24.70'	LT.	EDGE M.S.Rd.	20.30' RT. EDGE TUNNEL	

D.I. □

SEWER

TEL. CABLE

Ø TUNNEL

Ø "m" ST

STORM

PROPOSED









































VALUABLE

SUBJECT _____

RETURN TO
 PUBLIC WORKS
 OFFICE
 CAMP LEJEUNE
 NORTH CAROLINA

FIELD PARTY

 IN CHARGE

 INSTRUMENT

 NOTES

 TAPE READ

 TAPE OR ROD

 TAPE OR ROD

 INSTRUMENT NO.

 TAPE NO. _____


WEATHER

CLEAR _____
 CLOUDY _____
 WINDY _____
 RAIN _____
 FAIR _____
 SNOW _____
 HOT _____
 MODERATE _____
 COLD _____
 FOG _____

FILE No. _____
 FLDR. No. _____
 SHEET 3 of _____
 DATE _____ 19__

Quad. No. _____

STATION	DIST.	ANGLE " +	H. I. BEARING	VER: ANG. DIFF.	ELEVATION
8+00	23.65'	LT. EDGE	M.S. RD.	22.50'	RT. EDGE TUNNEL
7+83 ⁴⁰	10.20'	RT. WATER VALVE		13'	LT. FIRE PLUG.
7+80	19.90'	RT.		14"	C.I. WATER
7+77 ⁴⁰	5.30'	LT. Φ			DROP INLET
7+16 ⁴⁰	23'	LT. RT. RAD.	EDGE M.S. RD.		DR. TO BLDG #500
AT 2	1	180	56	15	
B.S.	1	2	52	30	= M.H. #2
TO END LINE	11	180	56	15	
11+32 ²⁸					
7+05 ³⁵					= M.H. # 2
7+02 ⁶⁰	31.35'	RT. COR.			STEAM PIT. # 27
C+97 ²⁰	20.40'	RT. D.P.			R.N.S
C+96 ⁴⁵	0.70'	LT. COR.			FIRE ALARM CABLE
C+93 ⁰⁰					RAD. # 27
C+90 ³⁰	31.36'	RT. COR.			EXISTING (OLD STEAM PIT) B.M. EL. 26.96.
C+77 ⁸⁵	3.03'	RT. Φ			M.H. COVER
	0.9'	RT.			to outside face of M.H.
C+67 ⁶²					NAIL IN BOTTLE CAP. WEST SIDE DR. TO BLDG. # 500
C+66					RAD. ON Φ DR. TO BLDG. # 500
C+64 ⁰⁰					FIRE ALARM DUCT ON Φ
C+55	15.30'	LT. RAD.			ON DR. TO BLDG. # 500
C+38 ²⁵	23.30'	LT. RT. RAD.			M.S. RD. + DR. TO BLDG. # 500

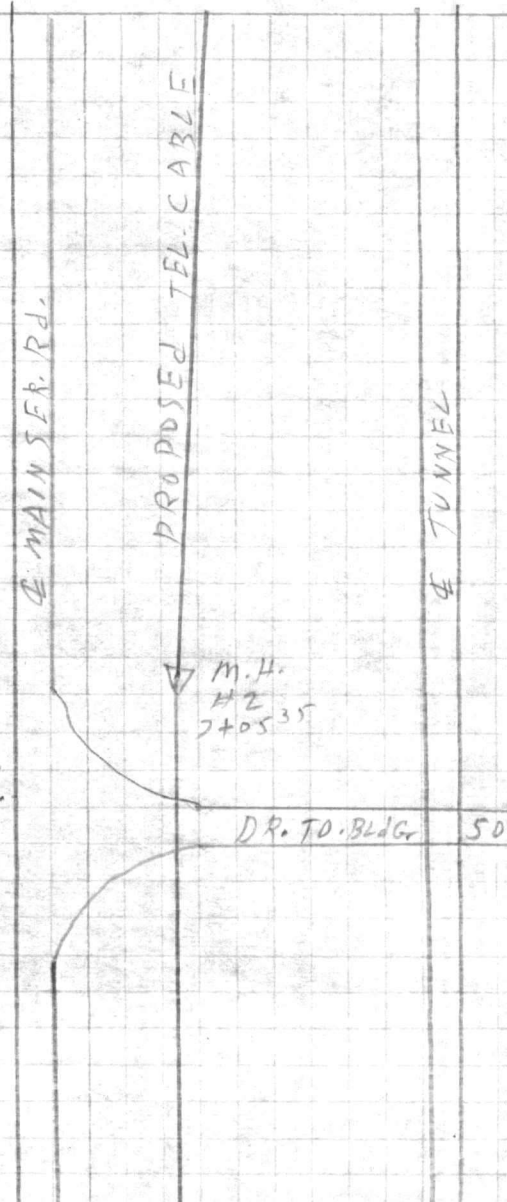






VALUABLE

SUBJECT _____

 RETURN TO
 PUBLIC WORKS
 OFFICE
 CAMP LEJEUNE
 NORTH CAROLINA

FIELD PARTY

 IN CHARGE

 INSTRUMENT

 NOTES

 TAPE READ

 TAPE OR ROD

 TAPE OR ROD

 INSTRUMENT NO.

 TAPE NO. _____

WEATHER

CLEAR _____
 CLOUDY _____
 WINDY _____
 RAIN _____
 FAIR _____
 SNOW _____
 HOT _____
 MODERATE _____
 COLD _____
 FOG _____
 FIGURED BY _____
 NOTES CHECKED BY _____
 PLOTTED BY _____

FILE No. _____

FLDR. No. _____
 SHEET 4 of 4
 DATE _____ 19__

Quad. No. _____

STATION	DIST.	ANGLE " "	+	H. I. BEARING	VER. ANG. DIFF.	ELEVATION	
11+46	39			26.85° RT.		N. E. COR. PIT. # 28	B.M. 25.43
11+32	28			END LINE		EDGE EXISTING TEL. M.H.	1.75' FROM N. E. COR.
11+28	12			27.30° LT.		PT. RAD. M.S. RD. & N" ST.	
11+18	10			EDGE		8' CONC. WALK.	
11+14	85			14° RT.		WATER VALVE	
11+11				10.25° RT.		WATER VALVE	
11+10	10			EDGE		8' CONC. WALK	
10+98	50			5.80° RT.		WATER VALVE ← (ON LINE TO 12 Q. M. W. H. S. E.)	
10+87	40			RAD. ON N" ST.		ON E	
10+83	35			19.65° RT.		EDGE TUNNEL & PT. RAD. ON N" ST	
10+61				26.30° RT.		PT. RAD. ON N" ST. EDGE TUNNEL (SOUTH SIDE)	± N" ST.
10+55	14			NAIL IN BOTTLE CAP.		WEST SIDE N" ST.	
10+53	20			RAD. ON N" ST.		ON E	
10+44				12.50° LT.		RAD. ON N" ST.	
10+44				6.50° LT.		± DROP INLET	
10+32	30			EDGE		8' CONC. WALK.	
10+24	30			EDGE		8' CONC. WALK.	
10+21	20			2° LT.		FIRE ALARM DUCT.	
10+09	20			25.70° LT.		PT. RAD. M.S. RD. & N" ST.	
10+00				25.70° LT.		EDGE M.S. RD. 20.55° RT. EDGE TUNNEL.	
9+67				5.40° LT.		± DROP INLET.	
9+00				24.75° LT.		EDGE M.S. RD. 21.50° RT. EDGE TUNNEL.	
8+87	90			EDGE		5' CONC. WALK.	
8+86	23			CROSS IN EAST SIDE		5' CONC. WALK	± 8+8673
8+82	40			EDGE		5' CONC. WALK.	
8+70	00			FIRE ALARM ON E		3.60° RT. F. A. BOX.	
8+40	50			14" C.I. WATER LINE			

TUNNEL

M.S. RD.

±









VALUABLE

RETURN TO
PUBLIC WORKS
OFFICE
CAMP LEJEUNE
NORTH CAROLINA

SUBJECT PROFILE ON PROPOSED
TEL. CABLE 'L' ST. TO
'O' ST. AREA # 5

FIELD PARTY
DENNIS IN CHARGE
DENNIS INSTRUMENT
NOTES
TAPE READ
TAPE OR ROD
TAPE OR ROD
INSTRUMENT NO.
TAPE NO.

WEATHER
CLEAR CLOUDY
WINDY RAIN FAIR
SNOW HOT
MODERATE COLD
FOG
FIGURED BY
NOTES CHECKED BY
PLOTTED BY

FILE No. 140 U
FLDR. No. _____
SHEET 1 of
DATE 12-10 1956

Quad. No. _____

STATION	DIST.	ANGLE " "	+	H. I. BEARING	VER: ANG. DIFF.	ELEVATION	
B.m.			363	28.51 (28.5)		24.88	N. COR. STEAM PIT # T.L. 25
					12.41	16.10	FLOOR TEL. M. H. 0+00
					6.20	22.31	TOP. TEL. M. H. 0+00
0+00					4.2	24.3	EDGE TEL. M. H.
0+14 ³⁰					4.4	24.1	
0+14 ³⁰					6.52	21.99	TOP F.A. CABLE
0+20 ⁸⁰					4.46	24.05	RAD. ON 'L' ST.
0+35 ²⁰					4.23	24.28	Ø 'L' ST.
0+44 ²⁰					4.43	24.28	RAD. 'L' ST.
0+54 ⁷⁰					4.2	24.3	
0+54 ⁷⁰					7.47	21.04	TOP EXISTING TEL. CABLE 2' RT
0+75					4.5	24.0	
1+00					4.6	23.9	
1+50					5.0	23.5	
2+00					5.3	23.2	
2+50					5.9	22.6	

439
213

6.52

3.20
4.22

7.42

VALUABLE

SUBJECT _____

RETURN TO
PUBLIC WORKS
OFFICE
CAMP LEJEUNE
NORTH CAROLINA

FIELD PARTY

IN CHARGE

INSTRUMENT

NOTES

TAPE READ

TAPE OR ROD

TAPE OR ROD

INSTRUMENT NO.

TAPE NO.

WEATHER

CLEAR
CLOUDY
WINDY
RAIN
FAIR

SNOW
HOT
MODERATE
COLD
FOG

FILE No. _____

FLDR. No. _____

SHEET 204

FIGURED BY _____ NOTES CHECKED BY _____

PLOTTED BY _____ DATE _____ 19__

Quad. No. _____


STATION	DIST.	ANGLE ° ' "	+	H. I. BEARING	VER. ANG. DIFF.	ELEVATION	
				28 51			
				28 5			
2+54	<u>71</u>				5 61	22.90	M. H. # 1
3+00					5 5	23.0	
3+55	<u>80</u>				5.3	23.2	
3+55	<u>80</u>				10 16	18.35	TOP 6" C.I. WATER LINE
3+87					4.7	23.8	
3+94					5 0	23.5	
4+00					4.9	23.6	
T.P.					4 21	24.30	
				5 71	30.01		
					30.0		
4+01	<u>30</u>				6 26	23.75	"M" ST.
4+16	<u>30</u>				5 91	24.10	⊕ "M" ST.
4+31	<u>60</u>				5 98	24.03	"M" ST.
4+57					5.2	24.8	
4+87	<u>85</u>				5 4	24.6	
4+77	<u>85</u>				7 48	22.53	4.10' RT. TOP TEL. CABLE

4.99
5.17
10.16

4.89
2.59
7.48



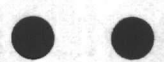



VALUABLE

SUBJECT _____

RETURN TO
PUBLIC WORKS
OFFICE
CAMP LEJEUNE
NORTH CAROLINA

FIELD PARTY

IN CHARGE

INSTRUMENT

NOTES

TAPE READ

TAPE OR ROD

TAPE OR ROD

INSTRUMENT NO.

TAPE NO.

WEATHER

CLEAR
CLOUDY
WINDY
RAIN
FAIR
SNOW
HOT
MODERATE
COLD
FOG
FIGURED BY _____
NOTES CHECKED BY _____
PLOTTED BY _____

FILE No. _____

FLDR. No. _____

SHEET 3 of

DATE _____ 19__

Quad. No. _____

STATION	DIST.	ANGLE " "	+	H. I. BEARING	VER. ANG. DIFF.	ELEVATION	
				30 01			
				30,0			
A+84	50				5 4	24 6	
A+84	50				6.02	23.99	S'LT. TOP D.I.
A+84	50				9 48	20.53	S'LT. BOTTOM D.I.
S+00					5 1	24.9	
S+50					4 4	25 6	
C+00					3 9	26 1	
C+50					3.7	26.3	
C+64					3 5	26 5	
C+64					5 10	24.91	TOP F.A. CABLE
C+66	00				3 62	26.39	RAD. TO BLDG. # 500
C+77	85				3.53	26.48	E DR. BLDG # 500
C+93					3 48	26.53	RAD. TO BLDG. # 500
C+96	45				4 99	25.02	TOP F.A. CABLE
T+00					3 5	26 5	
T.P.				3 22	30.77	2 96	27.05

VALUABLE

SUBJECT _____

RETURN TO
 PUBLIC WORKS
 OFFICE
 CAMP LEJEUNE
 NORTH CAROLINA

FIELD PARTY

 IN CHARGE

 INSTRUMENT

 NOTES

 TAPE READ

 TAPE OR ROD

 TAPE OR ROD

 INSTRUMENT No. _____
 TAPE No. _____

WEATHER

CLEAR _____
 CLOUDY _____
 WINDY _____
 RAIN _____
 FAIR _____
 SNOW _____
 HOT _____
 MODERATE _____
 COLD _____
 FOG _____
 FIGURED BY _____
 NOTES CHECKED BY _____
 PLOTTED BY _____

FILE No. _____
 FLDR. No. _____
 SHEET 46f
 DATE _____ 19__

Quad. No. _____

STATION	DIST.	ANGLE " "	+	H. I. BEARING	VER. ANG. DIFF.	ELEVATION	
				30.77			
7+50				(30.8)	4 4	26.4	
7+77	40				4 7	26.1	
7+77	40				5 24	25.53	5-30' LT. TOP D.I.
7+77	40				8.91	21.86	5-30' LT. BITTOM D.I.
7+83	40				4 6	26.2	
7+83	40				9.79	20.98	TOP. 6" C.I. WATER LINE
8+00					4 6	26.2	
8+40	50				4 2	26.6	
8+40	50				8 54	22.23	TOP 14" C.I. WATER
8+50					4 2	26.6	
8+70					4 1	26.7	
8+70					5 50	25.27	TOP F.A. CABLE
8+82	40				4 08	26.69	EDGE 5' CONC WALK
8+87	40				4.11	26.66	EDGE 5' CONC WALK
9+00					4 2	26.6	








VALUABLE

SUBJECT _____

RETURN TO
PUBLIC WORKS
OFFICE
CAMP LEJEUNE
NORTH CAROLINA

FIELD PARTY

IN CHARGE

INSTRUMENT

NOTES

TAPE READ

TAPE OR ROD

TAPE OR ROD

INSTRUMENT NO.

TAPE NO.

WEATHER

CLEAR
CLOUDY
WINDY
RAIN
FAIR

SNOW
HOT
MODERATE
COLD
FOG

FILE No. _____

FLDR. No. _____

SHEET 5 of

DATE _____ 19__

FIGURED BY _____
NOTES CHECKED BY _____
PLOTTED BY _____
Quad. No. _____

STATION	DIST.	ANGLE " "	+	H. I. BEARING	VER: ANG. DIFF.	ELEVATION	
				30 77			
				30 8			
9+50					4 7	26 1	
9+47					4.9	25 9	
9+67					5 59	25.18	5.40' LT. TOP D.I.
9+67					8 13	22 64	5.40' LT. BOTTOM D.I.
10+00					4 9	25 9	
10+19 ⁷⁰					5 0	25.8	
10+19 ⁷⁰					6.03	24.74	TOP F.A. CABLE
10+24 ³⁰					4 98	25.79	EDGE 8' C W
10+32 ³⁰					5 05	25.72	EDGE 8' C W
10+44					5 3	25 5	
10+44					5.60	25.17	6.50' TOP D-I
10+44					7 95	22.82	6.50' BOTTOM D-I.
10+52					4 97	23.80	1.20' LT. TOP F.A. CABLE
10+53 ⁷⁰					5 14	25 61	RAD. 'N' ST.
10+72					4 97	25.80	Ø 'N' ST.
















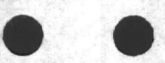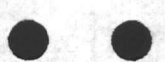

VALUABLE

SUBJECT _____

 RETURN TO
 PUBLIC WORKS
 OFFICE
 CAMP LEJEUNE
 NORTH CAROLINA

FIELD PARTY

 IN CHARGE

 INSTRUMENT

 NOTES

 TAPE READ

 TAPE OR ROD

 TAPE OR ROD

 INSTRUMENT NO. _____
 TAPE NO. _____

WEATHER

CLEAR
 CLOUDY
 WINDY
 RAIN
 FAIR
 SNOW
 HOT
 MODERATE
 COLD
 FOG

FILE No. _____
 FLDR. No. _____
 SHEET 4 of
 DATE _____ 19__

Quad. No. _____

STATION	DIST.	ANGLE ° ' "	+	H. I. BEARING	VER. ANG. DIFF.	ELEVATION	
				30 77 30 8			
10+87 40					5 24	25.53	RAD. ON N'ST.
11+00					5 30	25.47	
11+10 10					5 70	25.07	EDGE 8' CONC. WALK.
11+18 10					5 41	25.16	EDGE 8' " "
11+32 28					5 75	25.02	GROUND AT EDGE TEL M.H. END LINE
					6 50	24.27	TOP TEL M.H. 11+32 28
					12.37	18.40	FLOOR TEL M.H. 11+32 28
B.M.					5 33	25.44	25.43 N. COR. STEAM PIT - T.C. 28
STA. 10+98 50						19.96	12" WATER LINE TO 12 Q.M. W.HSE.


































































































VALUABLE

SUBJECT _____

 RETURN TO
 PUBLIC WORKS
 OFFICE
 CAMP LEJEUNE
 NORTH CAROLINA

FIELD PARTY

 _____ IN CHARGE
 _____ INSTRUMENT
 _____ NOTES
 _____ TAPE READ
 _____ TAPE OR ROD
 _____ TAPE OR ROD
 _____ INSTRUMENT NO.
 _____ TAPE NO.

WEATHER

 CLEAR SNOW
 CLOUDY HOT
 WINDY MODERATE
 RAIN COLD
 FAIR FOG

FILE No. _____

FLDR. No. _____

SHEET 1 of 1DATE 12-11-56

FIGURED BY _____

NOTES CHECKED BY _____

PLOTTED BY _____

Quad. No. _____

STATION	DIST.	ANGLE " "	+	H. I. BEARING	VER. ANG. DIFF.	ELEVATION
B.M.				5 64 31 07		25 43
STA. 10+19 ³⁰				6 75	24.3	
STA. 10+89 ²⁰				7 32	23.8	
STA. 9+67 ?						


T.L.

TOP F.A. CABLE

2' LT. TOP F.A. CABLE

11+32²⁸

"N" ST

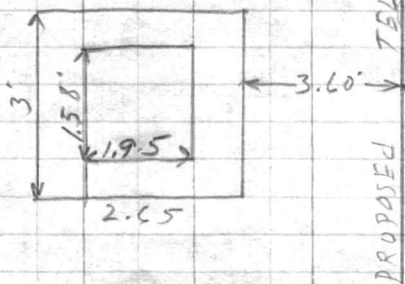


FIRE ALARM

10+19³⁰

18+14.

3'

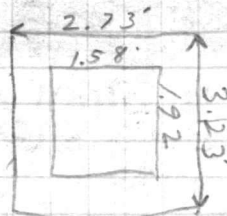M.H.
#1

4.70' M.H. #1

























VALUABLE

SUBJECT TEST BORING BACK
OF BLDG. # 18

RETURN TO
PUBLIC WORKS
OFFICE
CAMP LEJEUNE
NORTH CAROLINA

FIELD PARTY

DENNIS IN CHARGE
INSTRUMENT _____
NOTES _____
TAPE READ _____
TAPE OR ROD _____
TAPE OR ROD _____
INSTRUMENT NO. _____
TAPE NO. _____

WEATHER

CLEAR _____ SNOW _____
CLOUDY _____ HOT _____
WINDY _____ MODERATE _____
RAIN _____ COLD _____
FAIR _____ FOG _____

FILE No. 140U

FLDR. No. _____

FIGURED BY _____ SHEET 107

NOTES CHECKED BY _____ DATE 3-9 19__

PLOTTED BY _____


Quad. No. _____

STATION	DIST.	ANGLE ° ' "	+	H. I. BEARING	VER. ANG. DIFF.	ELEVATION
Hole # 1				430	21.3	
						-7.3
						-9
B.M. MON. #	USM.C.			430	25.59	21.29
	312					

GROUND

GRAY SAND	100%
GRAYSAND	95%
RED CLAY	5%
GRAY SAND	100%

*Dry Hole
No evidence of Water*

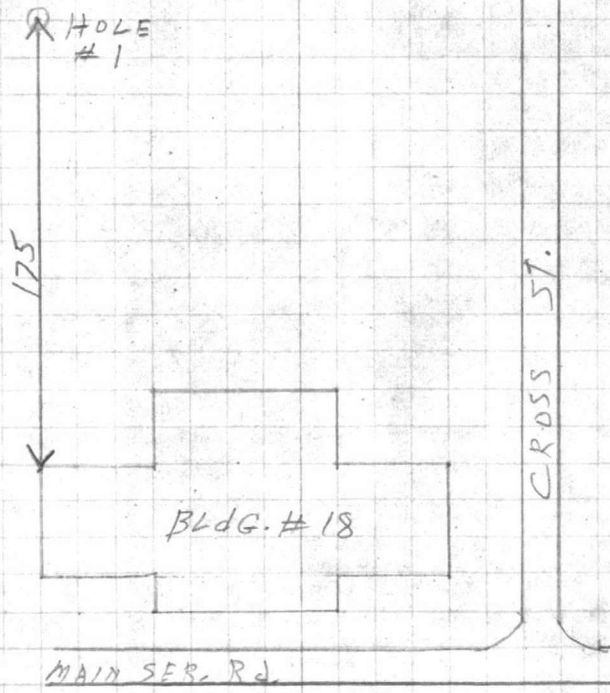

VALUABLE

SUBJECT

Underground Electric Cable
Gen. Plant to Reg. Areas + Return

RETURN TO
 PUBLIC WORKS
 OFFICE
 CAMP LEJEUNE
 NORTH CAROLINA

FIELD PARTY

IN CHARGE _____
 INSTRUMENT _____
 NOTES _____
 TAPE READ _____
 TAPE OR ROD _____
 TAPE OR ROD _____
 INSTRUMENT NO. _____
 TAPE NO. _____

WEATHER

CLEAR _____
 WINDY _____
 RAIN _____
 FAIR _____
 SNOW _____
 MODERATE _____
 COLD _____
 FOG _____
 FIGURED BY _____
 NOTES CHECKED BY _____
 PLOTTED BY _____


FILE No. 100-U

FLDR. No. _____

SHEET 107

DATE _____ 19__

Quad. No. _____

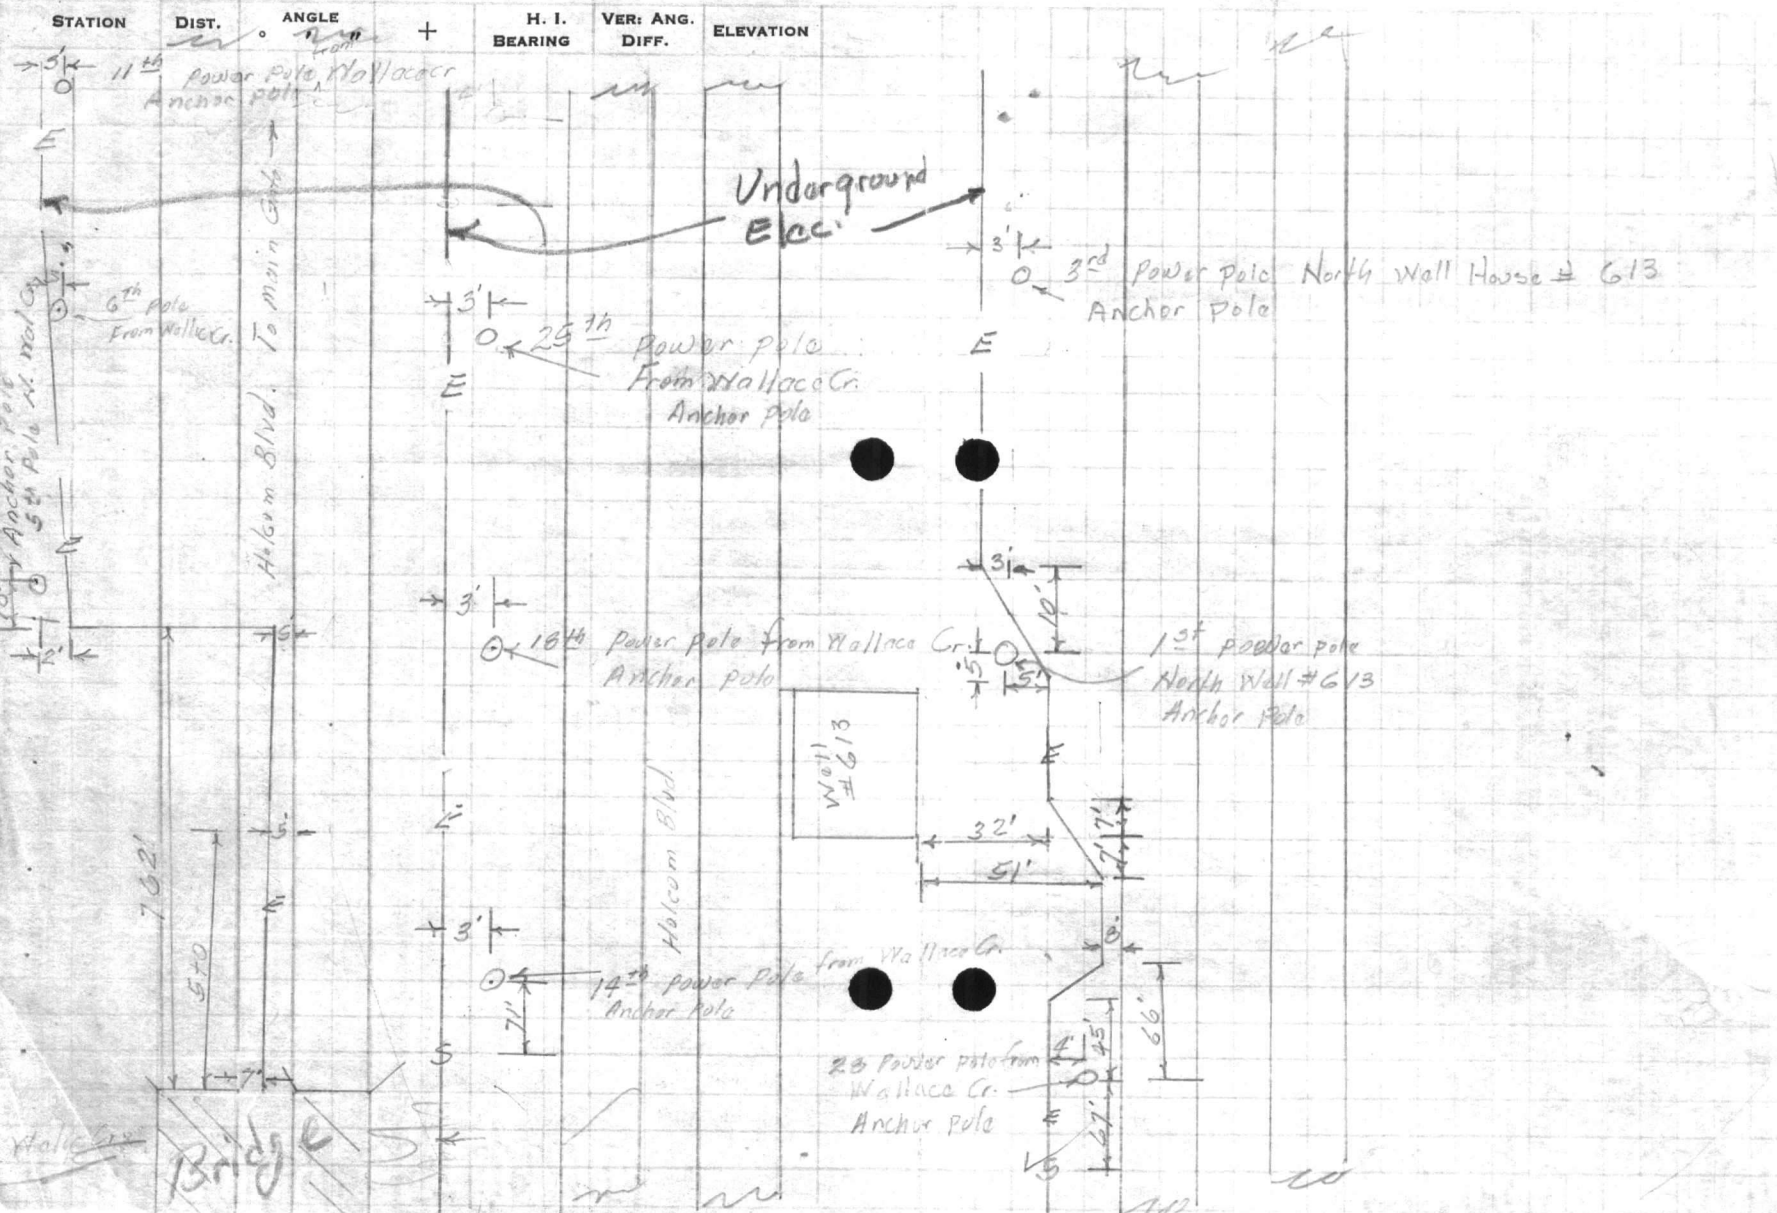

VALUABLE

SUBJECT _____

RETURN TO
PUBLIC WORKS
OFFICE
CAMP LEJEUNE
NORTH CAROLINA

FIELD PARTY

IN CHARGE

INSTRUMENT

NOTES

TAPE READ

TAPE OR ROD

TAPE OR ROD

INSTRUMENT NO.

TAPE NO.


WEATHER

CLEAR
CLOUDY
WINDY
RAIN
FAIR
SNOW
HOT
MODERATE
COLD
FOG
FIGURED BY _____
NOTES CHECKED BY _____
PLOTTED BY _____

FILE No. _____
FLDR. No. _____
SHEET 20f
DATE _____ 19__

Quad. No. _____

STATION	DIST.	ANGLE ° ' "	+	H. I. BEARING	VER. ANG. DIFF.	ELEVATION
---------	-------	----------------	---	------------------	--------------------	-----------

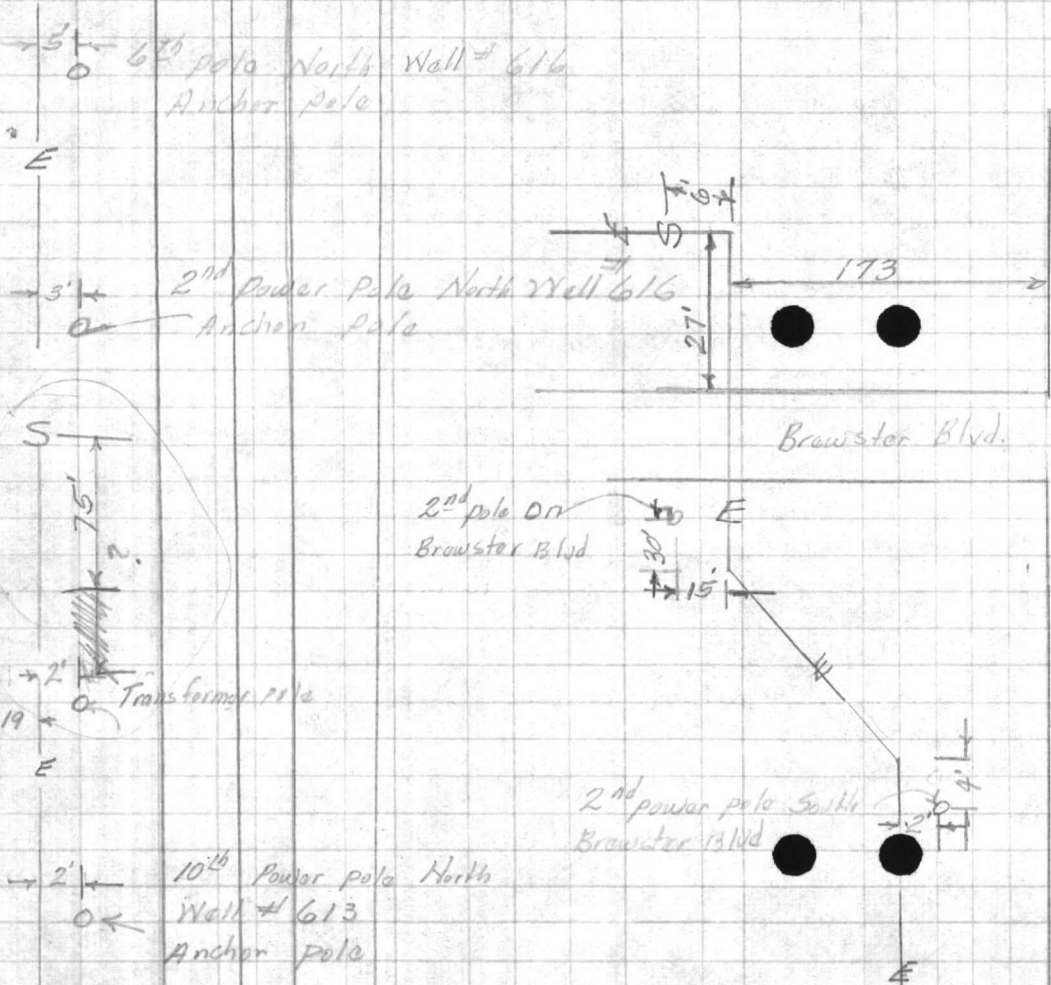












VALUABLE SUBJECT _____

RETURN TO
PUBLIC WORKS
OFFICE
CAMP LEJEUNE
NORTH CAROLINA

FIELD PARTY

IN CHARGE

INSTRUMENT

NOTES

TAPE READ

TAPE OR ROD

TAPE OR ROD

INSTRUMENT NO.

TAPE NO.

WEATHER

CLEAR
CLOUDY
WINDY
RAIN
FAIR
SNOW
HOT
MODERATE
COLD
FOG

FILE No. _____

FLDR. No. _____

FIGURED BY _____

SHEET *30f*


NOTES CHECKED BY _____

PLOTTED BY _____

DATE _____ 19__

Quad. No. _____

STATION	DIST.	ANGLE ° ' "	+	H. I. BEARING	VER: ANG. DIFF.	ELEVATION
---------	-------	----------------	---	------------------	--------------------	-----------

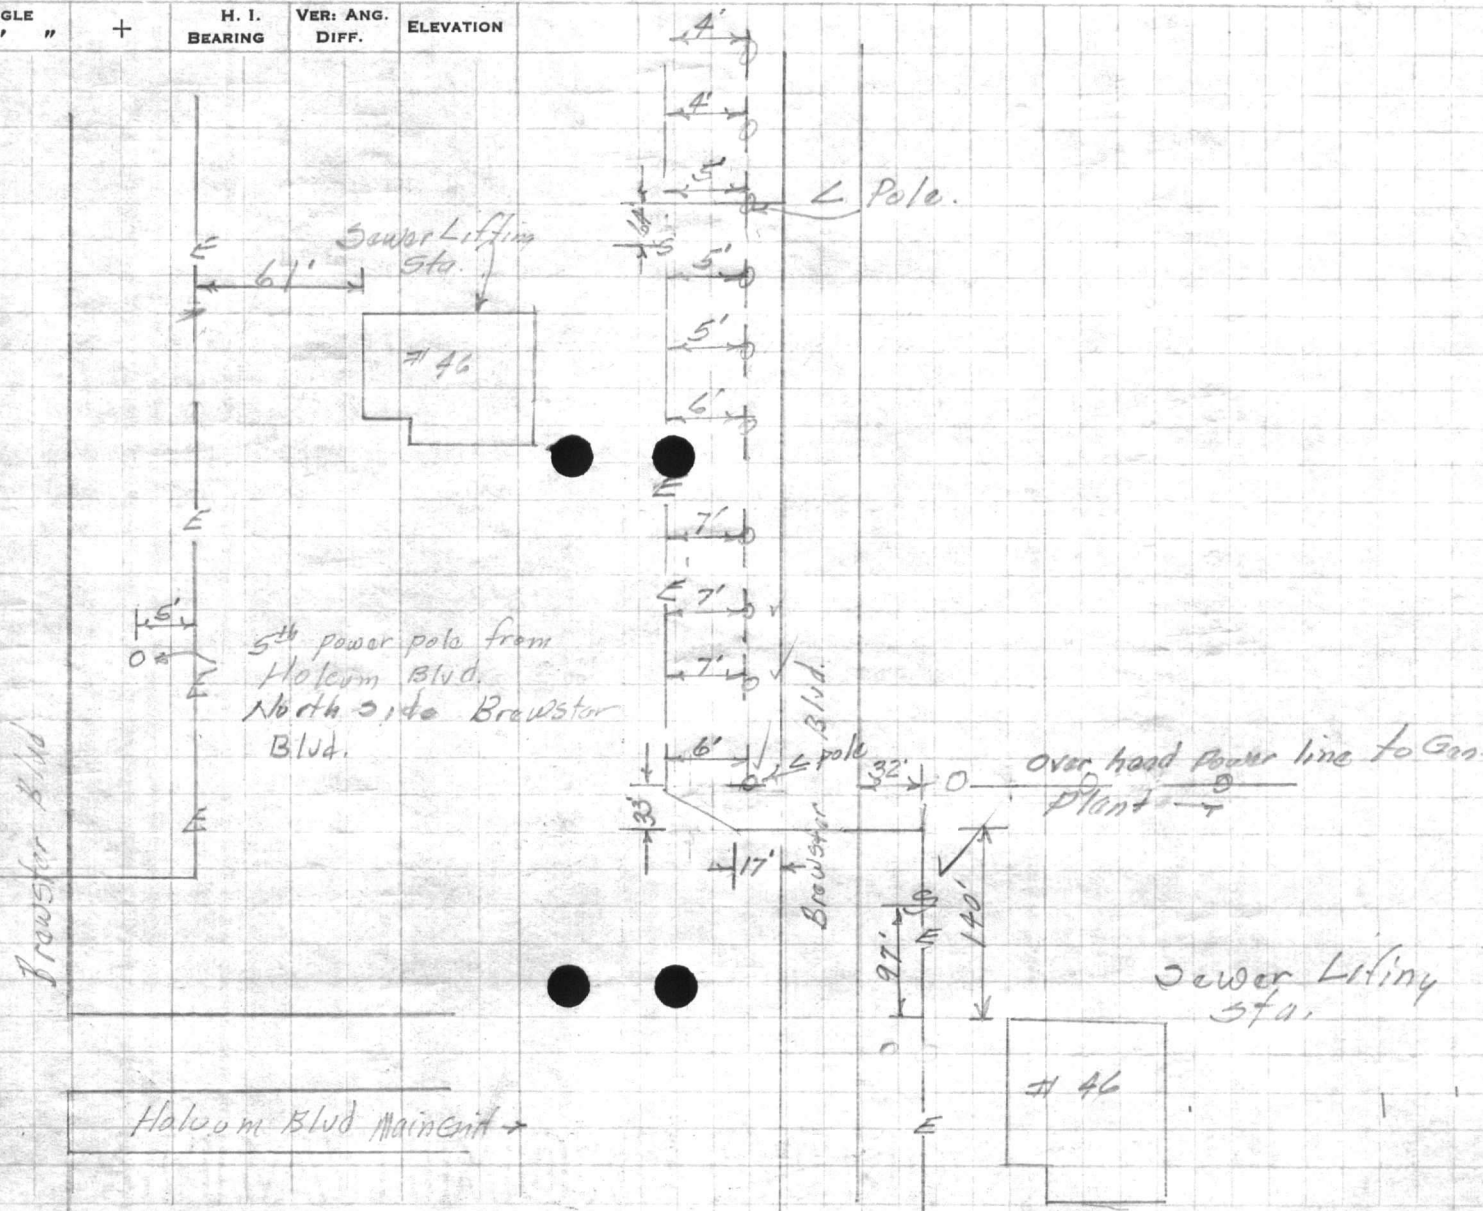





































170



VALUABLE

SUBJECT

*U. S. Elect. Cable
From Plant to Hadnot Point*

RETURN TO
PUBLIC WORKS
OFFICE
CAMP LEJEUNE
NORTH CAROLINA

FIELD PARTY

Murton

IN CHARGE
INSTRUMENT
NOTES
TAPE READ
TAPE OR ROD
TAPE OR ROD
INSTRUMENT No.
TAPE No.

WEATHER

CLEAR
CLOUDY
WINDY
RAIN
FAIR
SNOW
HOT
MODERATE
COLD
FOG


FILE No. _____

FLDR. No. _____

SHEET *6 of 7*

DATE _____ 19__


Quad. No. _____

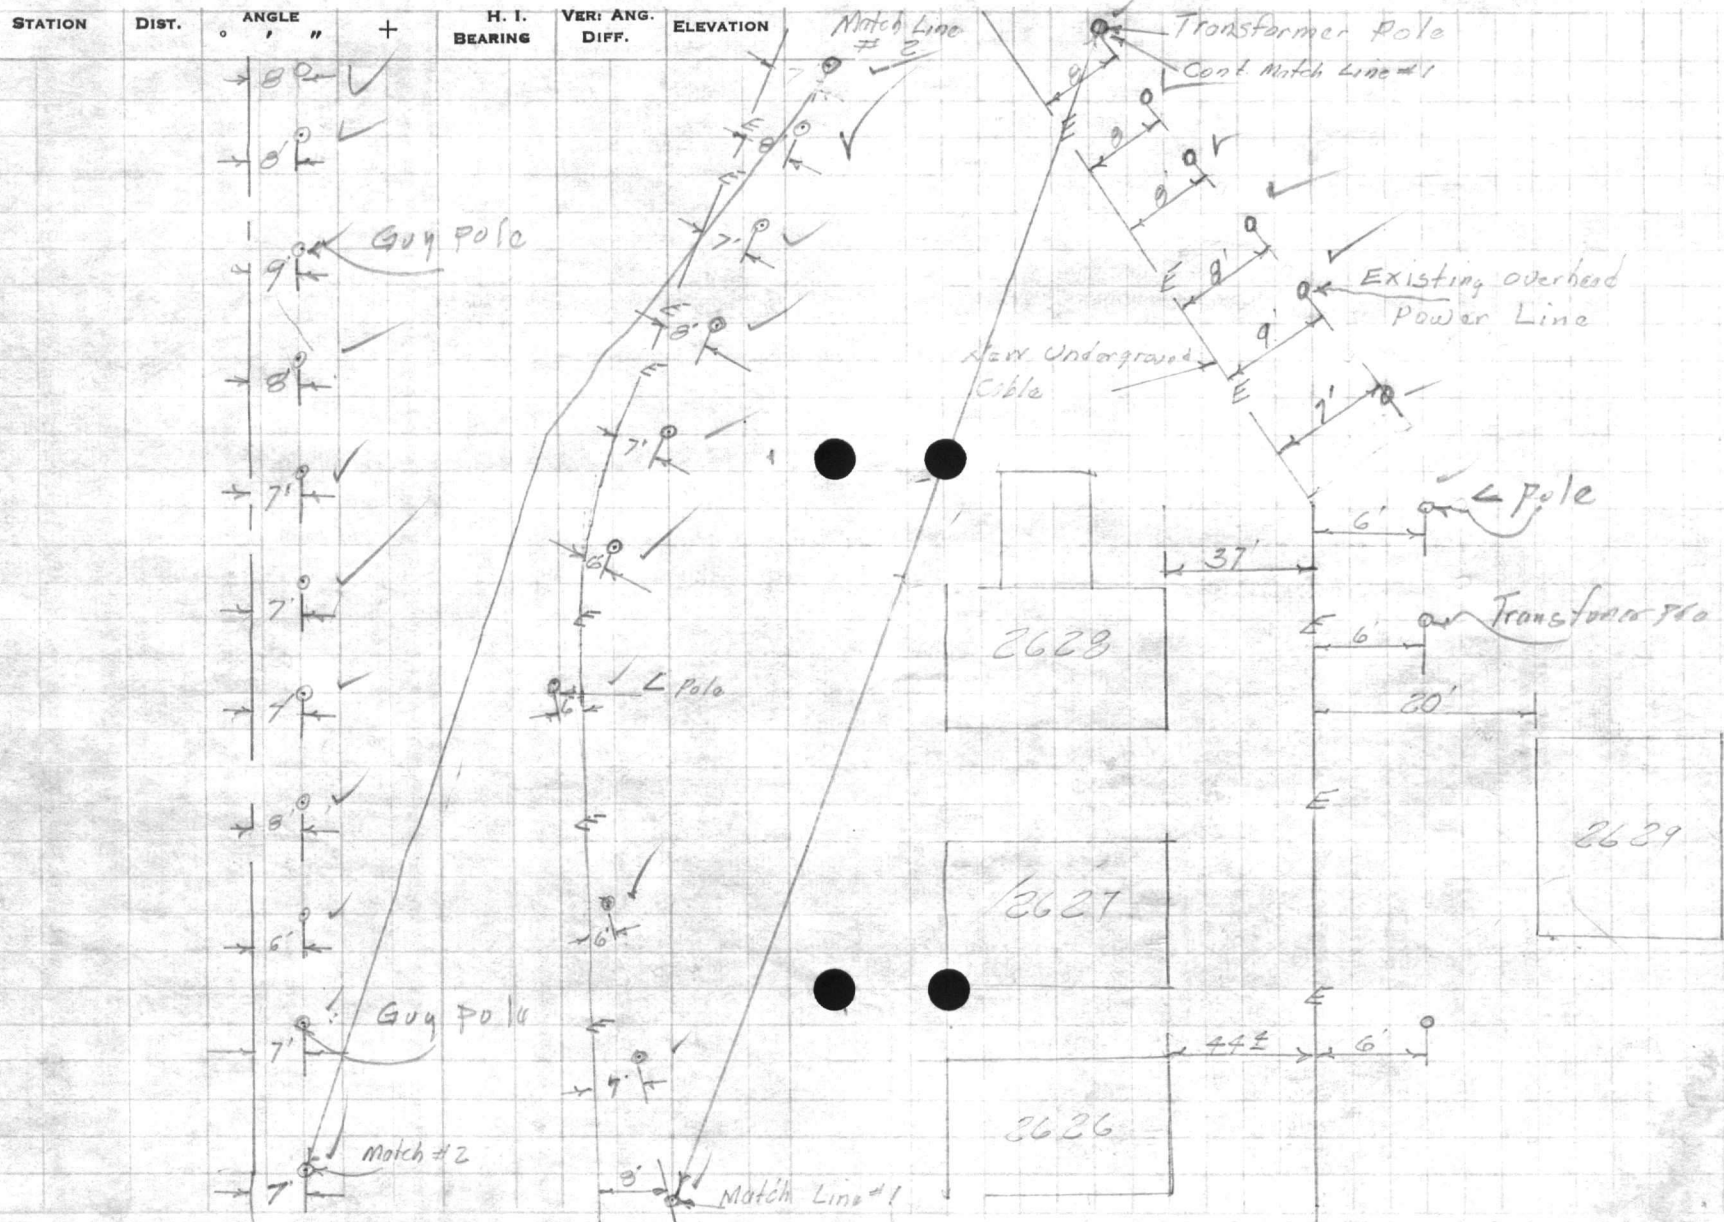




 

VALUABLE

SUBJECT _____

3023

RETURN TO
PUBLIC WORKS
OFFICE
CAMP LEJEUNE
NORTH CAROLINA

FIELD PARTY

IN CHARGE

INSTRUMENT

NOTES

TAPE READ

TAPE OR ROD

TAPE OR ROD

INSTRUMENT NO.

TAPE NO.

WEATHER

CLEAR
CLOUDY
WINDY
RAIN
FAIR
SNOW
HOT
MODERATE
COLD
FOG

FILE No. _____

FLDR. No. _____


SHEET 7 of

NOTES CHECKED BY _____

PLOTTED BY _____ DATE _____ 19__

Quad. No. _____

STATION	DIST.	ANGLE ' "	+	H. I. BEARING	VER: ANG. DIFF.	ELEVATION
---------	-------	--------------	---	------------------	--------------------	-----------

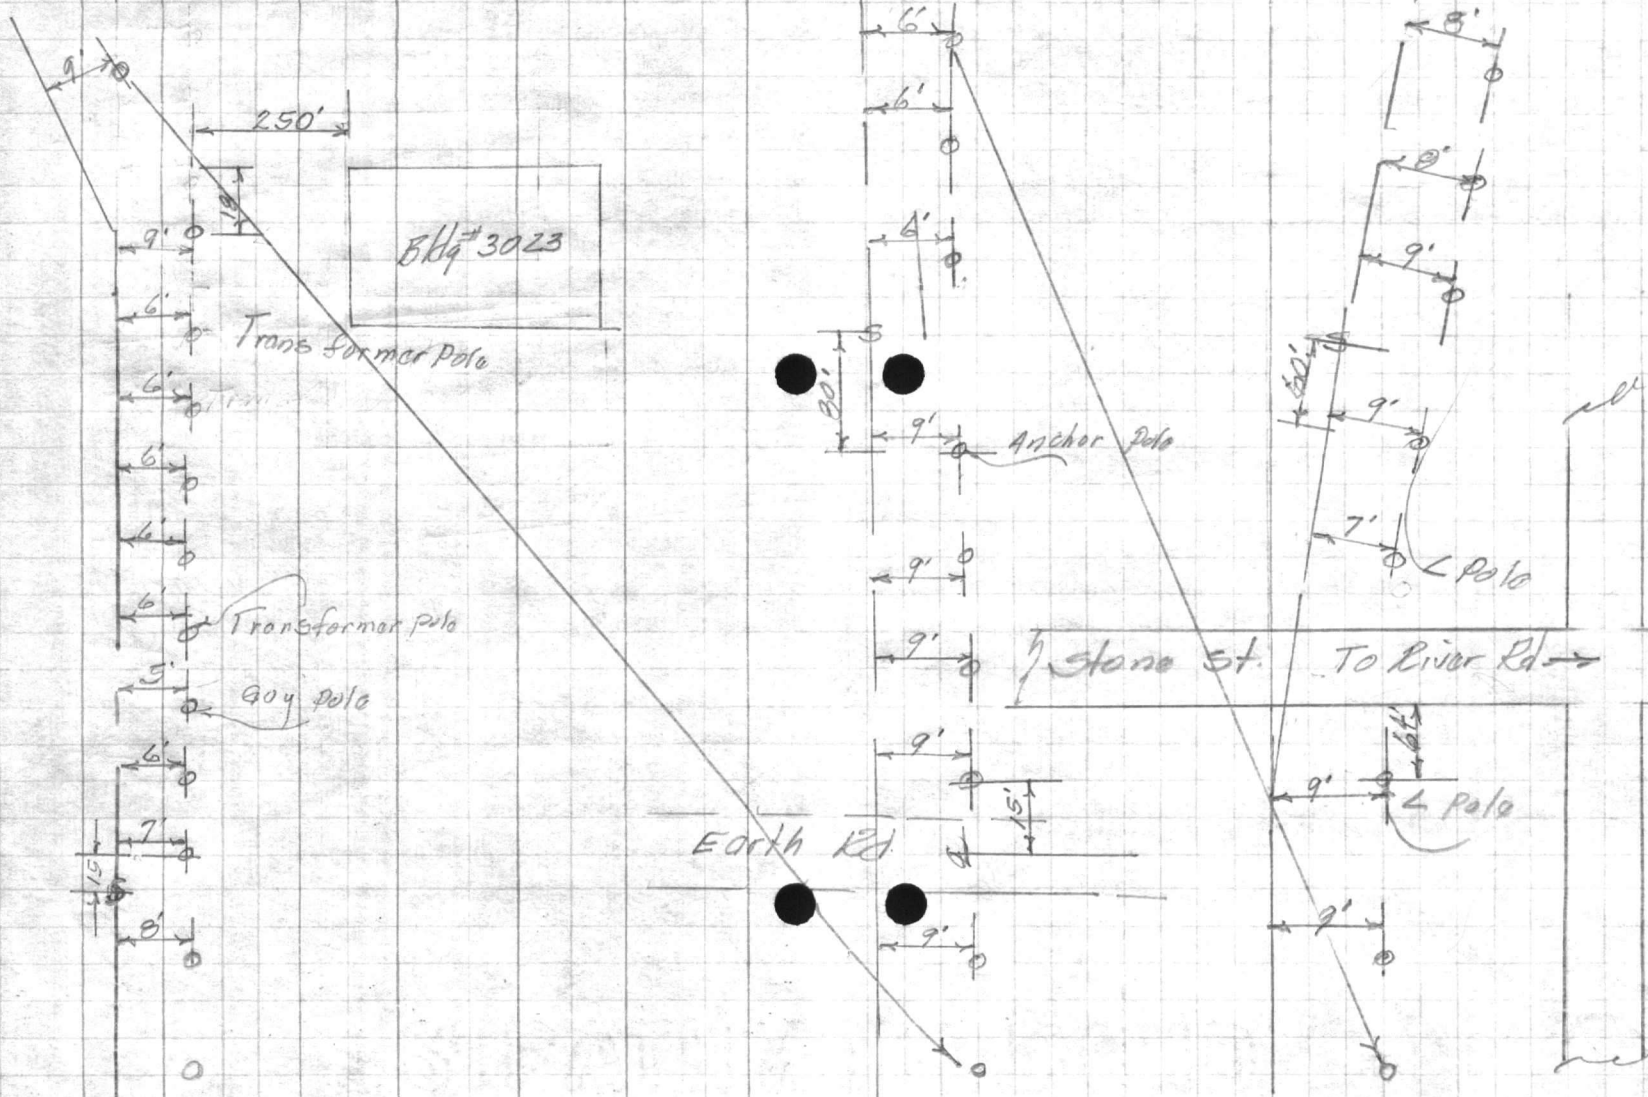

VALUABLE

SUBJECT _____

RETURN TO
PUBLIC WORKS
OFFICE
CAMP LEJEUNE
NORTH CAROLINA

FIELD PARTY

IN CHARGE

INSTRUMENT

NOTES

TAPE READ

TAPE OR ROD

TAPE OR ROD

INSTRUMENT No.

TAPE No.

WEATHER

CLEAR
CLOUDY
WINDY
RAIN
FAIR
SNOW
HOT
MODERATE
COLD
FOG

FILE No. _____

FLDR. No. _____


SHEET *3 of*

FIGURED BY _____
NOTES CHECKED BY _____

PLOTTED BY _____ DATE _____ 19__

Quad. No. _____

STATION	DIST.	ANGLE			+	H. I. BEARING	VER: ANG. DIFF.	ELEVATION
		°	'	"				


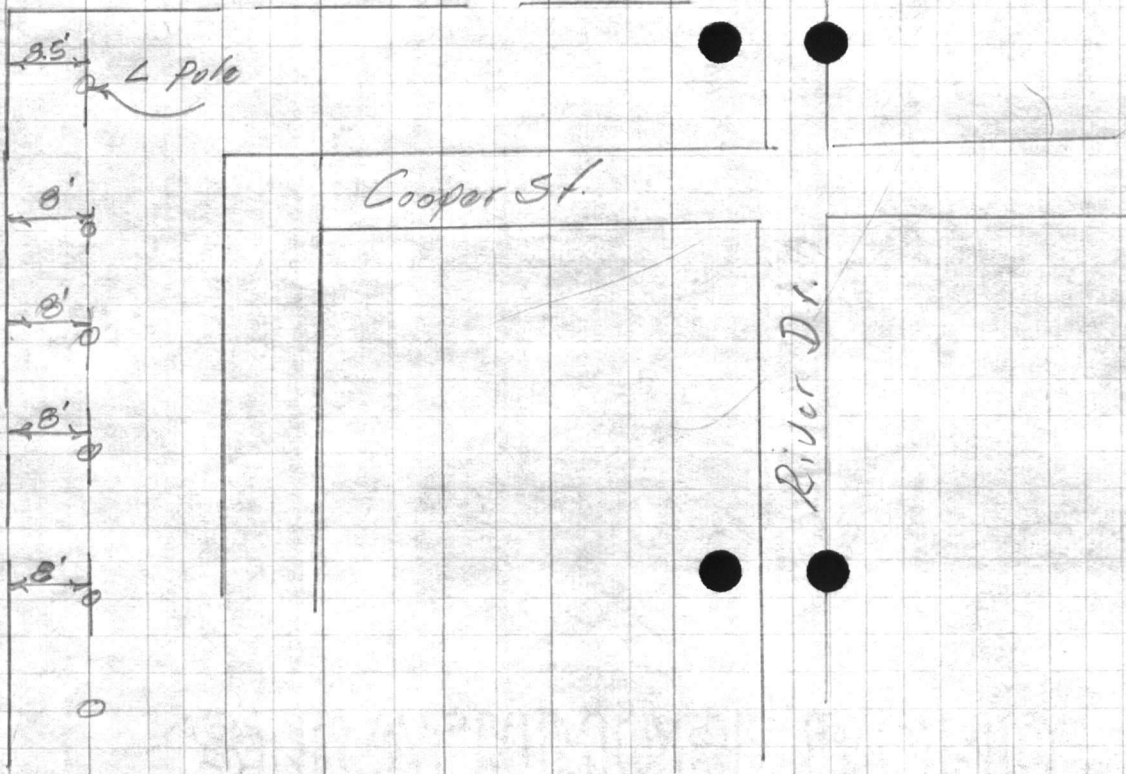






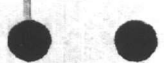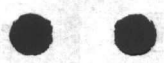









VALUABLE

SUBJECT _____

RETURN TO
PUBLIC WORKS
OFFICE
CAMP LEJEUNE
NORTH CAROLINA

FIELD PARTY

IN CHARGE

INSTRUMENT

NOTES

TAPE READ

TAPE OR ROD

TAPE OR ROD

INSTRUMENT NO.

TAPE NO.

WEATHER

CLEAR
CLOUDY
WINDY
RAIN
FAIR
SNOW
HOT
MODERATE
COLD
FOG


FILE No. _____

FLDR. No. 10

SHEET 2042

DATE _____ 19__

Quad. No. _____

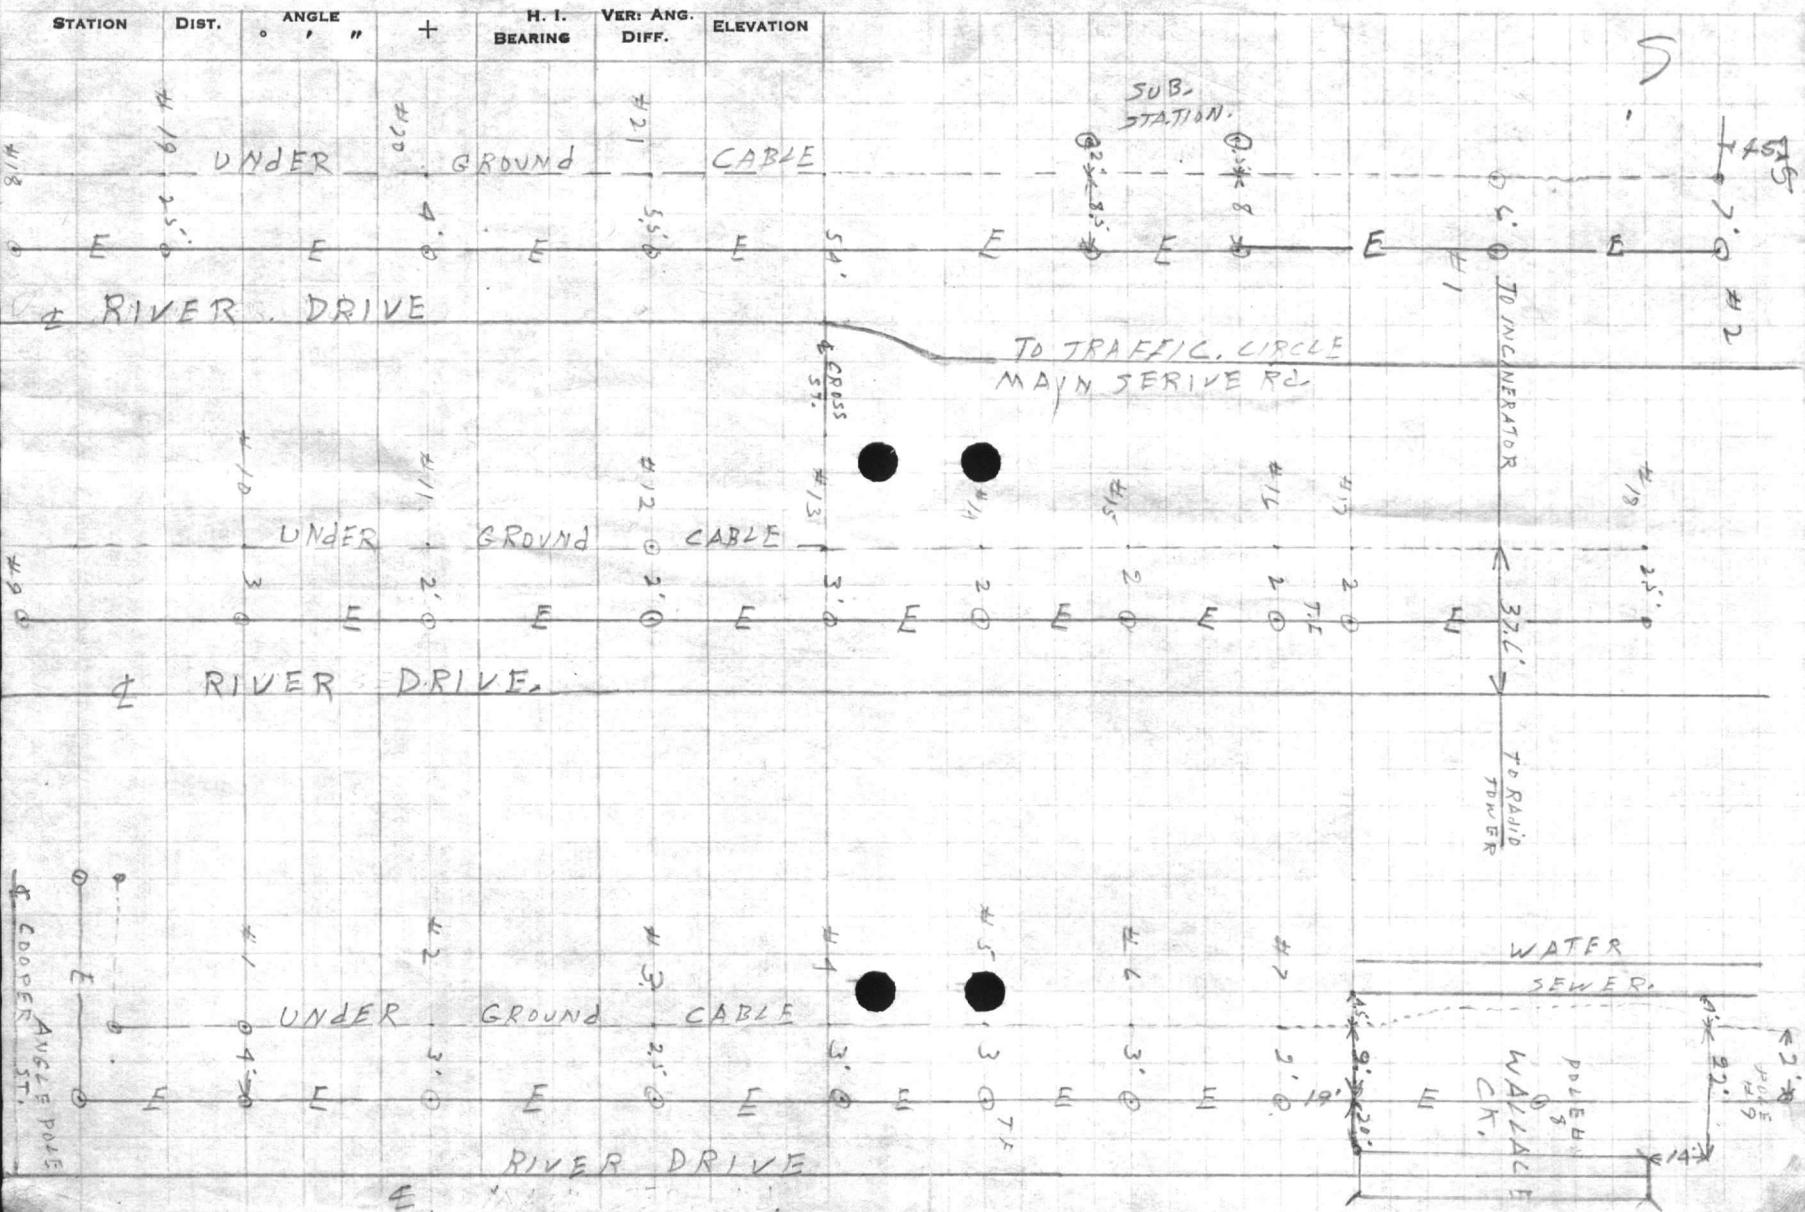












VALUABLE

SUBJECT _____

RETURN TO
PUBLIC WORKS
OFFICE
CAMP LEJEUNE
NORTH CAROLINA

FIELD PARTY

IN CHARGE

INSTRUMENT

NOTES

TAPE READ

TAPE OR ROD

TAPE OR ROD

INSTRUMENT NO.

TAPE NO.

WEATHER

CLEAR
CLOUDY
WINDY
RAIN
FAIR
SNOW
HOT
MODERATE
COLD
FOG

FILE No. _____

FLDR. No. _____


SHEET _____

FIGURED BY _____
NOTES CHECKED BY _____

PLOTTED BY _____ DATE _____ 19__

Quad. No. _____


STATION	DIST.	ANGLE ' "	+	H. I. BEARING	VER. ANG. DIFF.	ELEVATION
---------	-------	--------------	---	------------------	--------------------	-----------

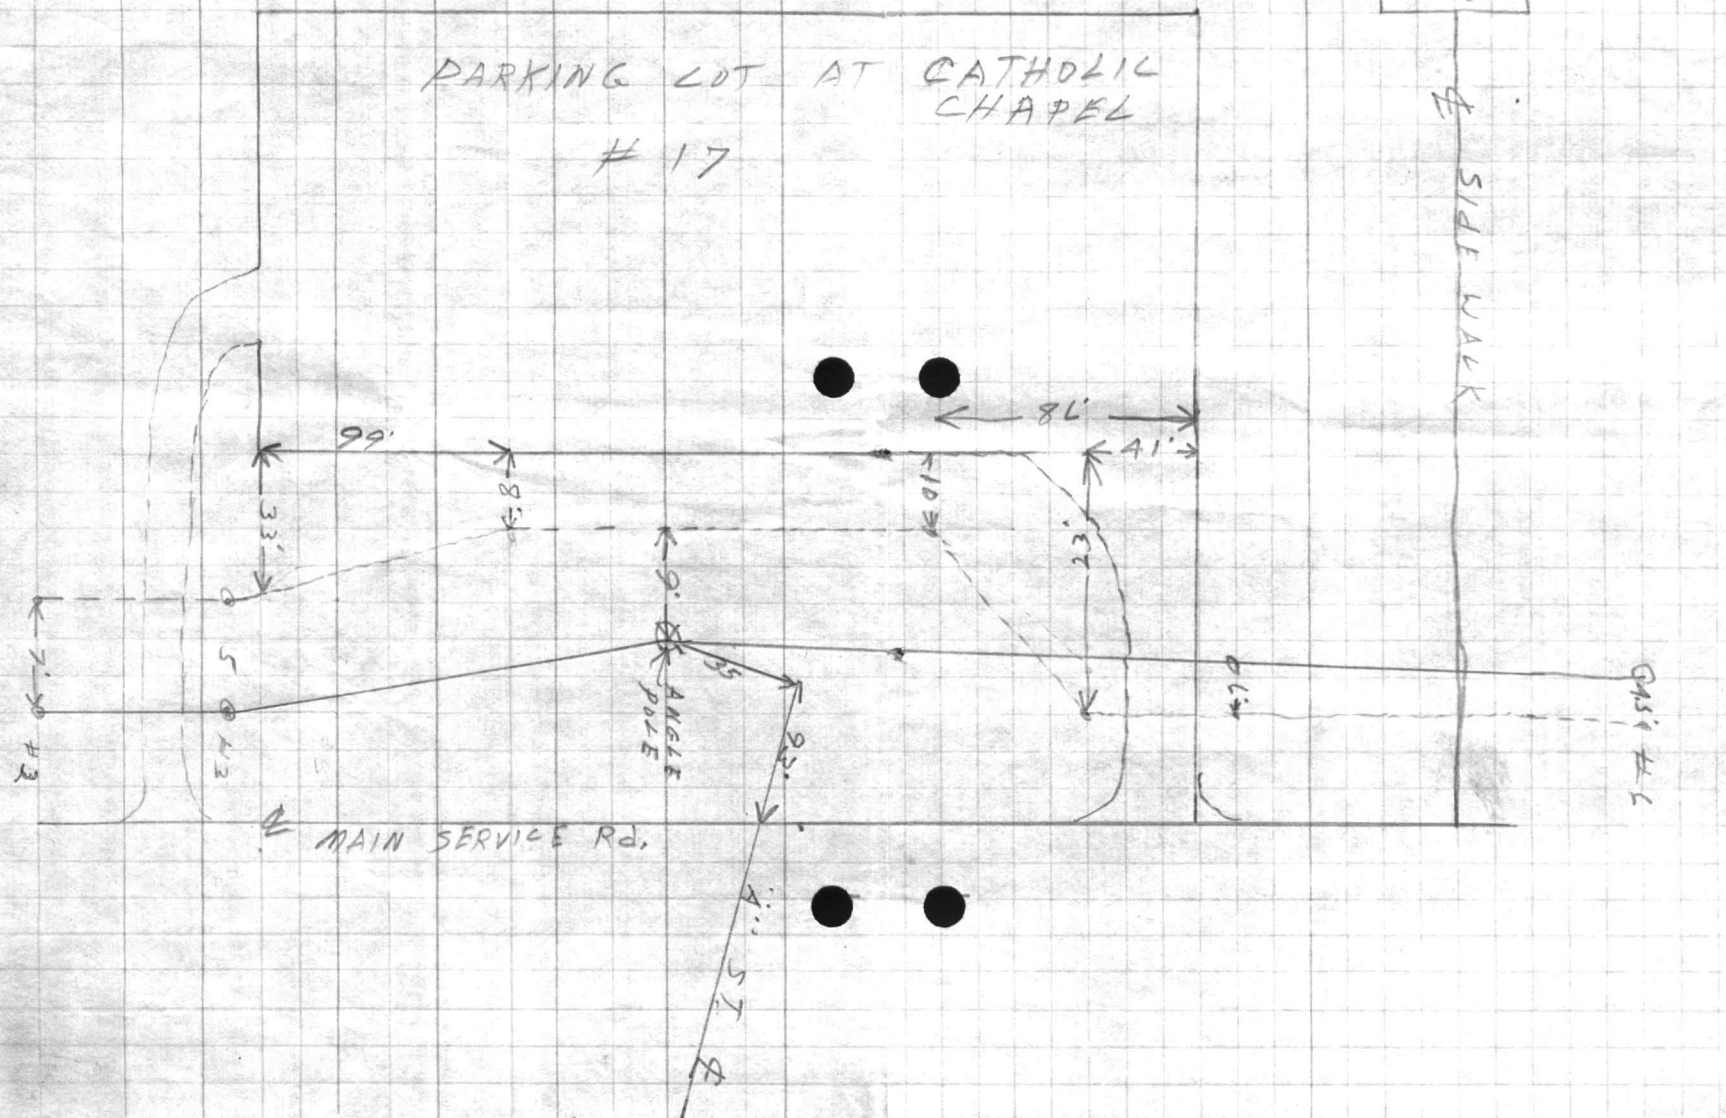

FIELD PARTY
MEMBERS
NAME
RANK
REG'T
COMP
SERIAL NO.
DATE
PLACE


FIELD PARTY
MEMBERS
NAME
RANK
REG'T
COMP
SERIAL NO.
DATE
PLACE




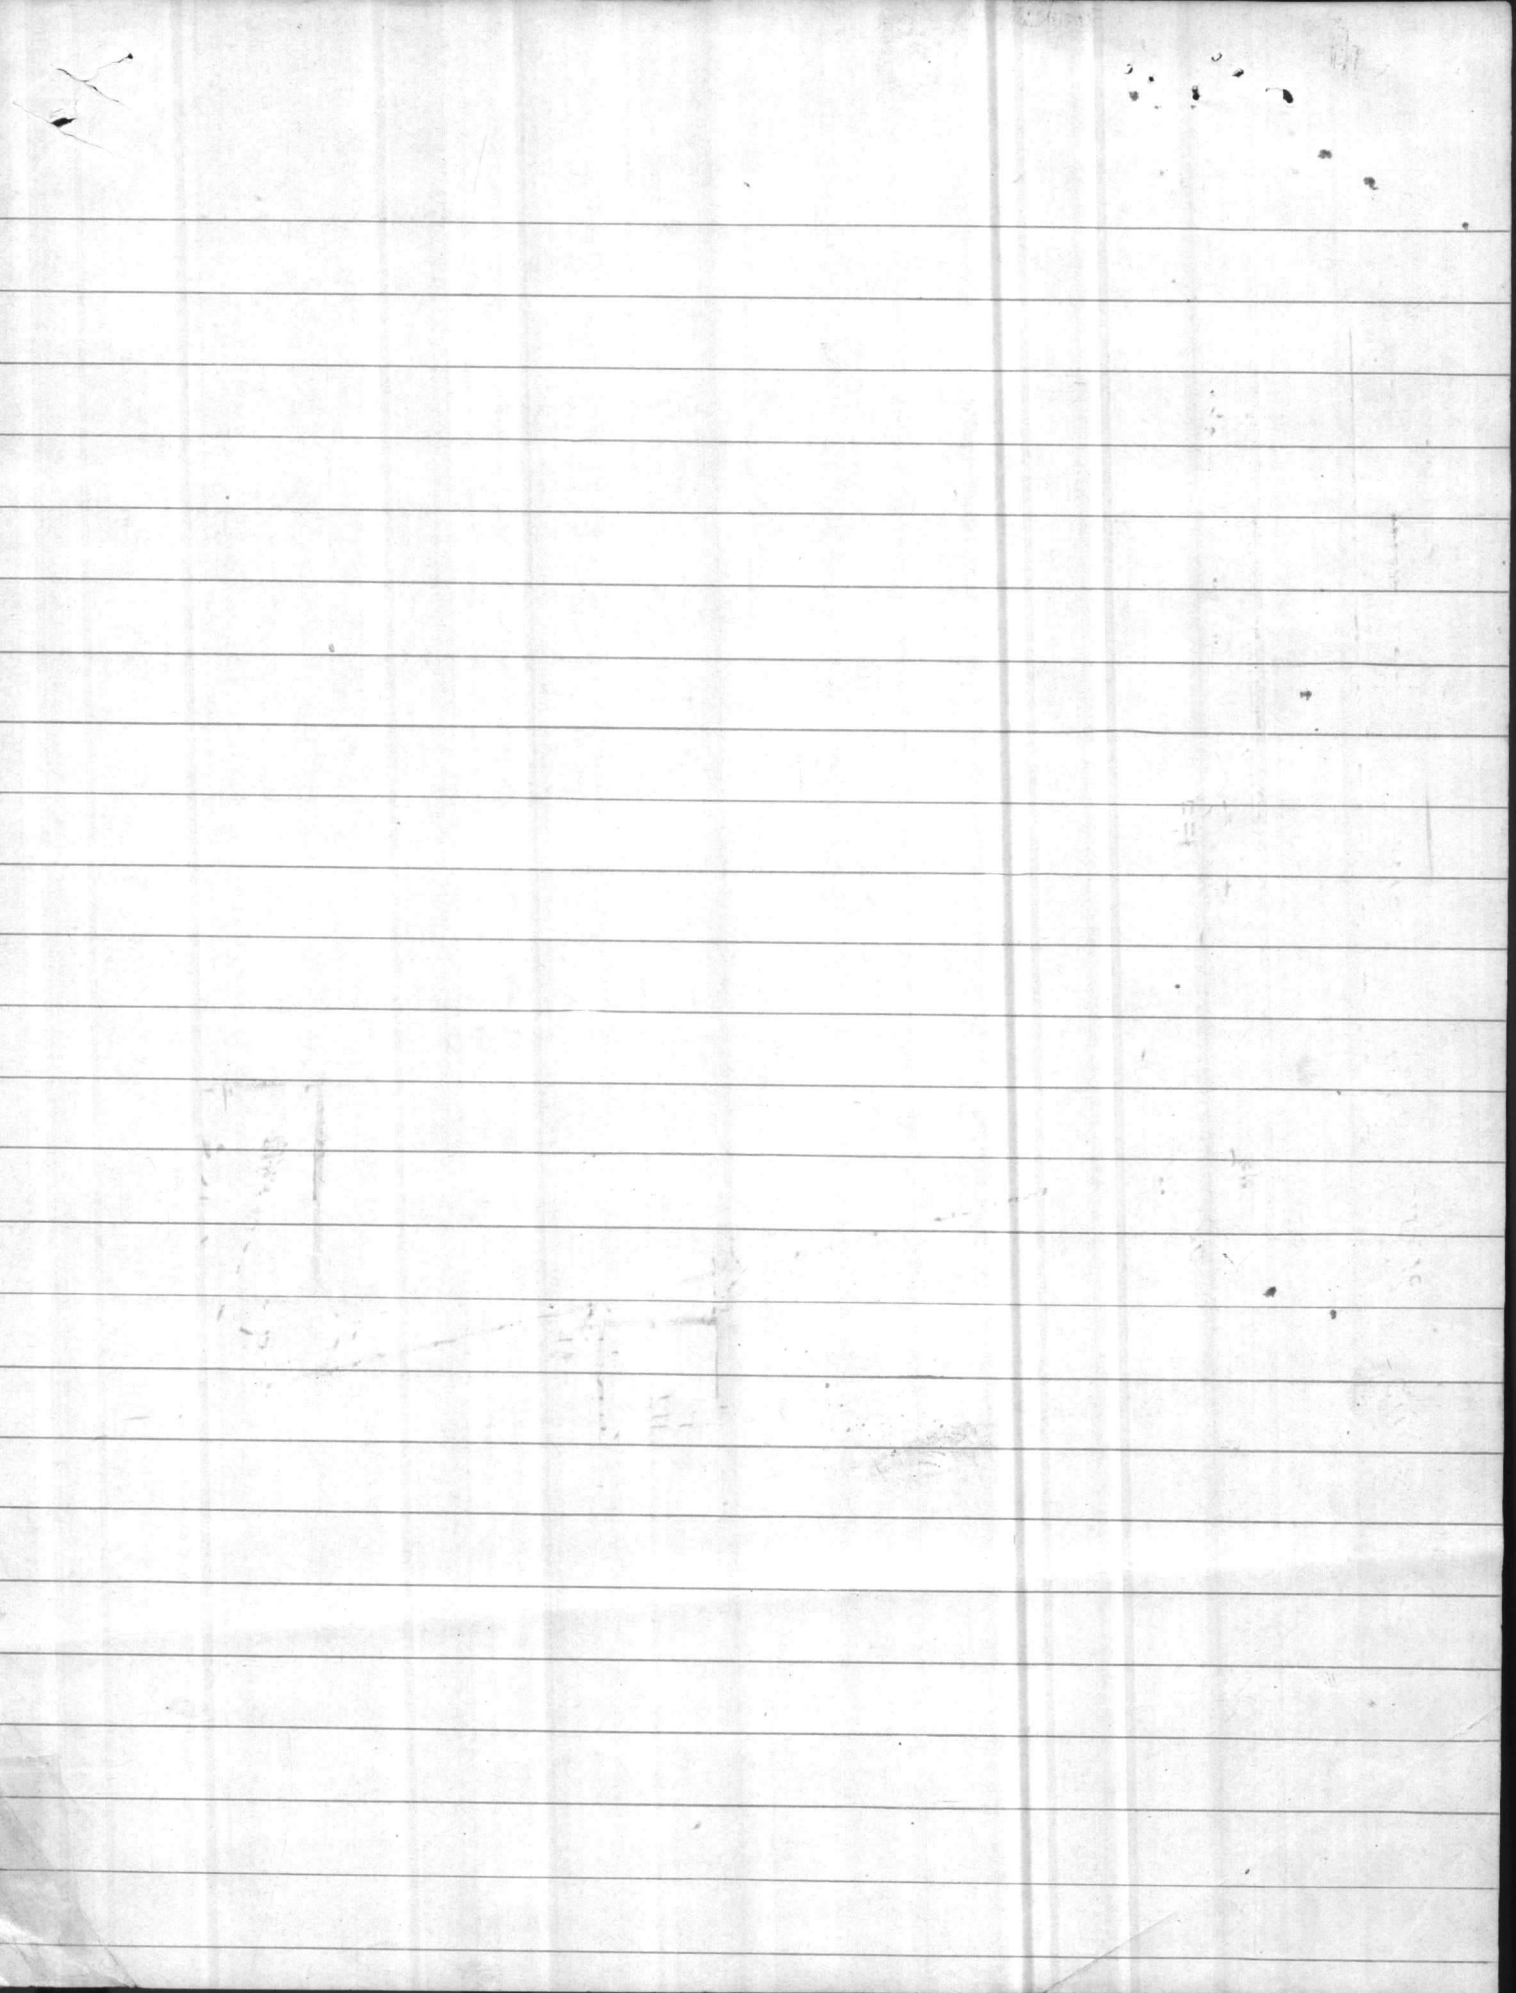


A


Relocated
1957

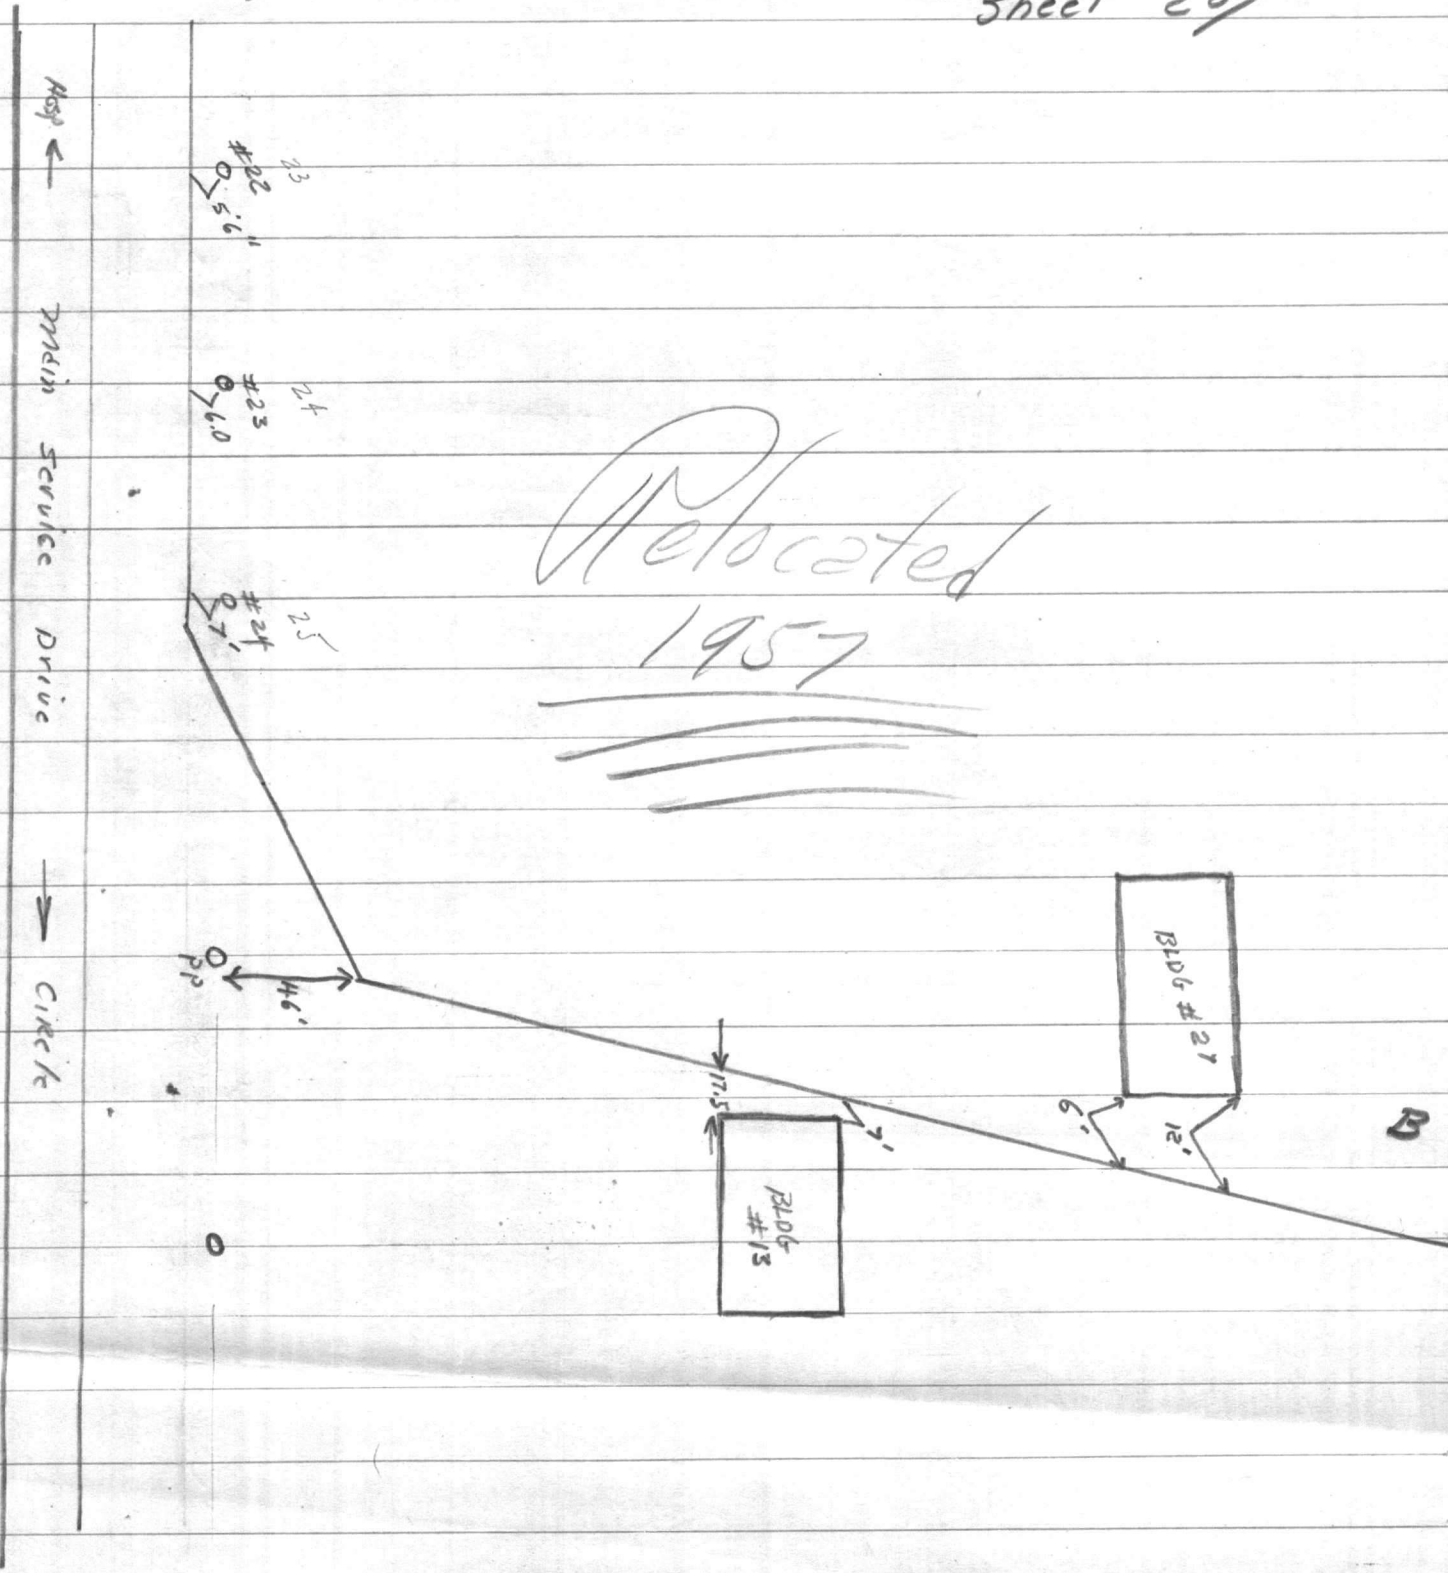


 

 


Relocated
1957

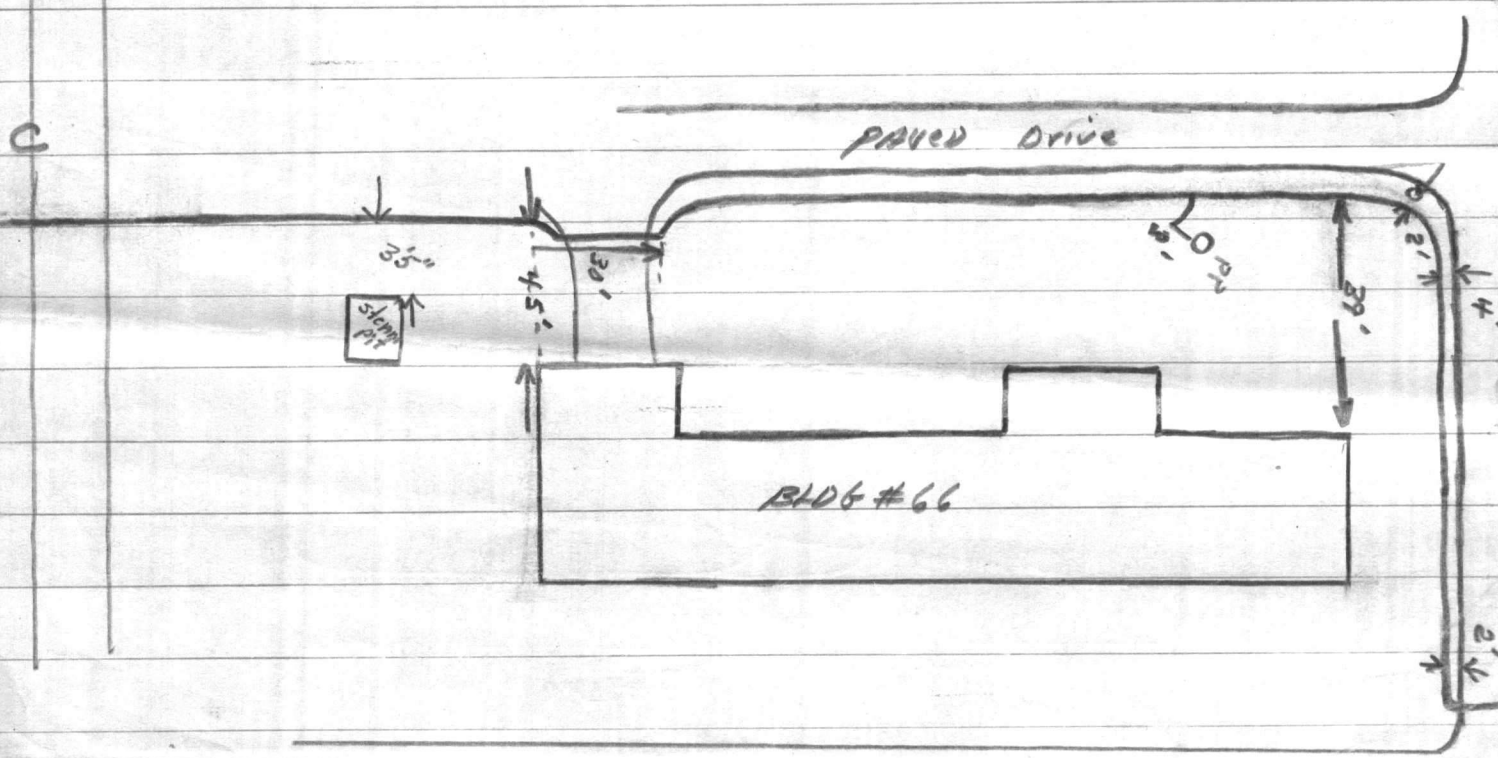

 

17

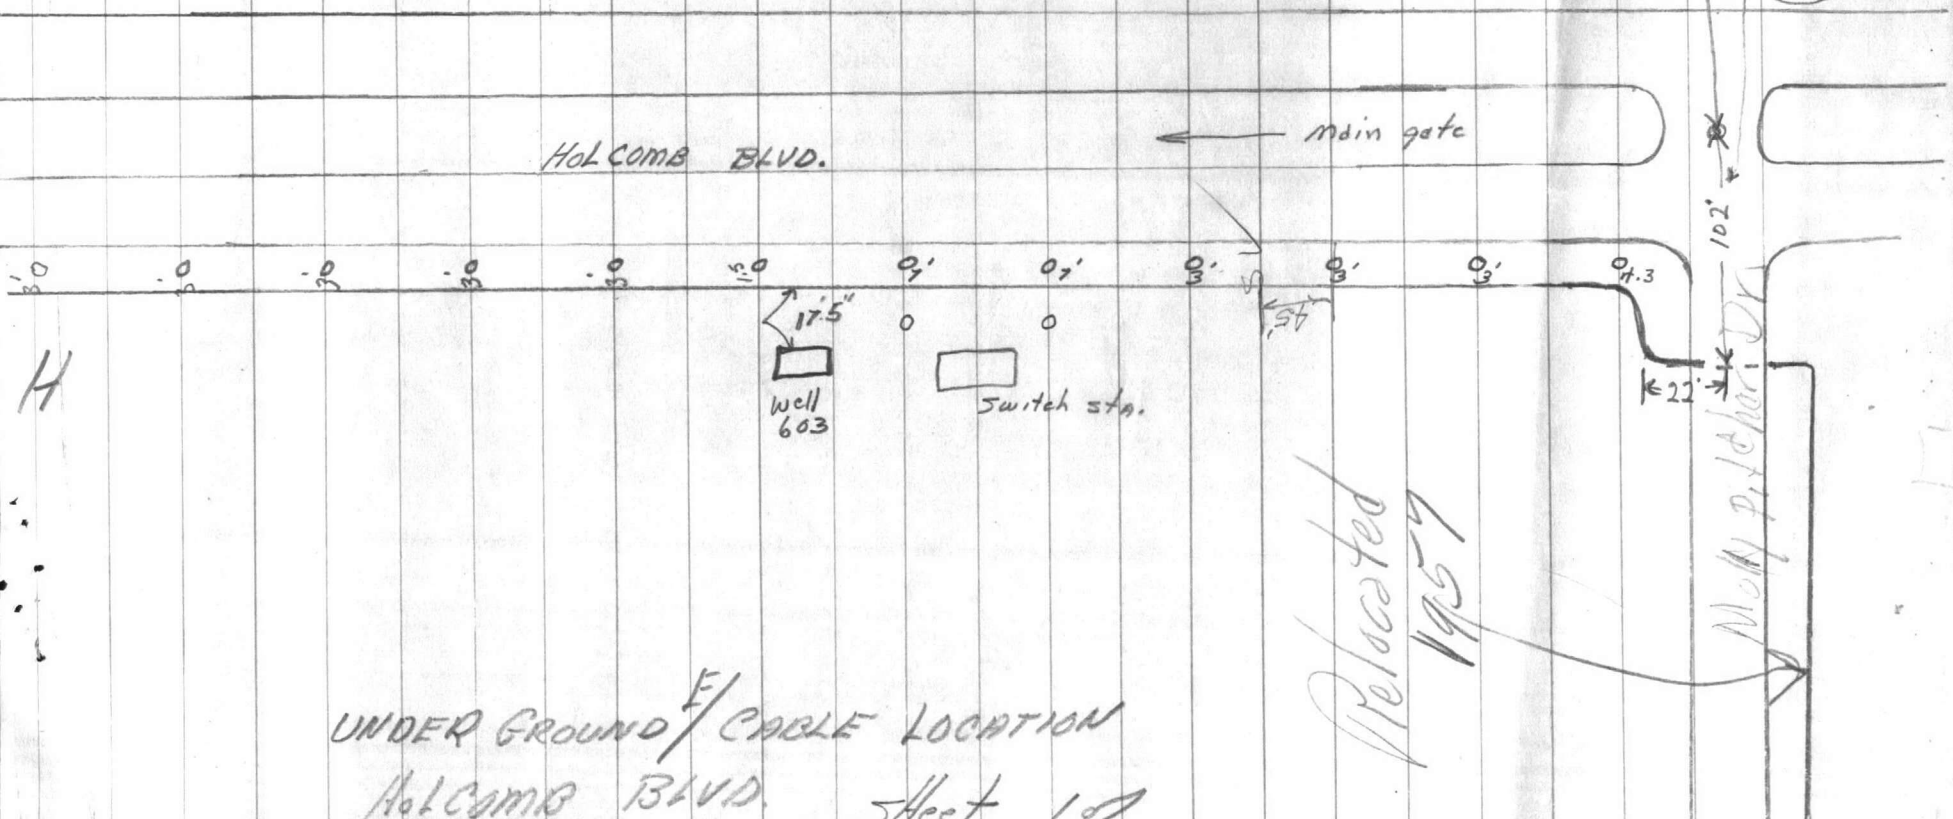

UNDER GROUND ^E/CABLE LOCATION
 HOLCOMB BLVD. Sheet 107

