

**VALUABLE**
 RETURN TO  
 PUBLIC WORKS  
 OFFICE  
 CAMP LEJEUNE  
 NORTH CAROLINA

 SUBJECT Location of "K" Range  
1. T.R. Training Area  
Verona Loop Road  
Rhodes Point Road

## FIELD PARTY

Dillon IN CHARGE  
Kellum INSTRUMENT  
 \_\_\_\_\_ NOTES  
 \_\_\_\_\_ TAPE READ  
 \_\_\_\_\_ TAPE OR ROD  
 \_\_\_\_\_ TAPE OR ROD  
 \_\_\_\_\_ INSTRUMENT NO.  
 \_\_\_\_\_ TAPE NO.

## WEATHER

 CLEAR \_\_\_\_\_ SNOW \_\_\_\_\_  
 CLOUDY \_\_\_\_\_ HOT \_\_\_\_\_  
 WINDY \_\_\_\_\_ MODERATE ✓  
 RAIN \_\_\_\_\_ COLD \_\_\_\_\_  
 FAIR ✓ FOG \_\_\_\_\_

 FILE No. \_\_\_\_\_  
 FLDR. No. \_\_\_\_\_  
 SHEET #1 of 10  

Quad. No. \_\_\_\_\_

| STATION | DIST. | ANGLE<br>" " | + | H. I.<br>BEARING | VER. ANG.<br>DIFF. | ELEVATION |
|---------|-------|--------------|---|------------------|--------------------|-----------|
|---------|-------|--------------|---|------------------|--------------------|-----------|

 P.L. #1 = L/F of Range "K-301"  
 = U.S.M.C. Mon. # 735

578.22' - 0.11

 176.242 ✓ meters  
 Temp 44°

|     |     |              |
|-----|-----|--------------|
| "Y" | ①   | 171° 30' 30" |
|     | ②   | 243° 00' 45" |
|     | (M) | 171° 30' 22" |
| "X" | ①   | 120° 52' 30" |
|     | ②   | 241° 45'     |
|     | (M) | ✓            |
| "W" | ①   | 46° 27' 00"  |
|     | ②   | 92° 54' 15"  |
|     | (M) | 46° 27' 07"  |

|     |     |              |
|-----|-----|--------------|
| "Z" | ①   | 106° 20' 45" |
|     | ②   | 212° 42' 00" |
|     | (M) | 106° 21' 00" |

|     |              |
|-----|--------------|
| ①   | 259° 43' 00" |
| ②   | 59° 07' 30"  |
| ③   | 118° 15' 30" |
| (M) | 259° 42' 35" |


 U.S.M.C. Mon. # 46

For Range Lines  
 See # 1 of 3  
 Dated 6/12/61

Sight on U.S.M.C. # 47


3.280833' = 1 Meter

4/8 Mon. # 735

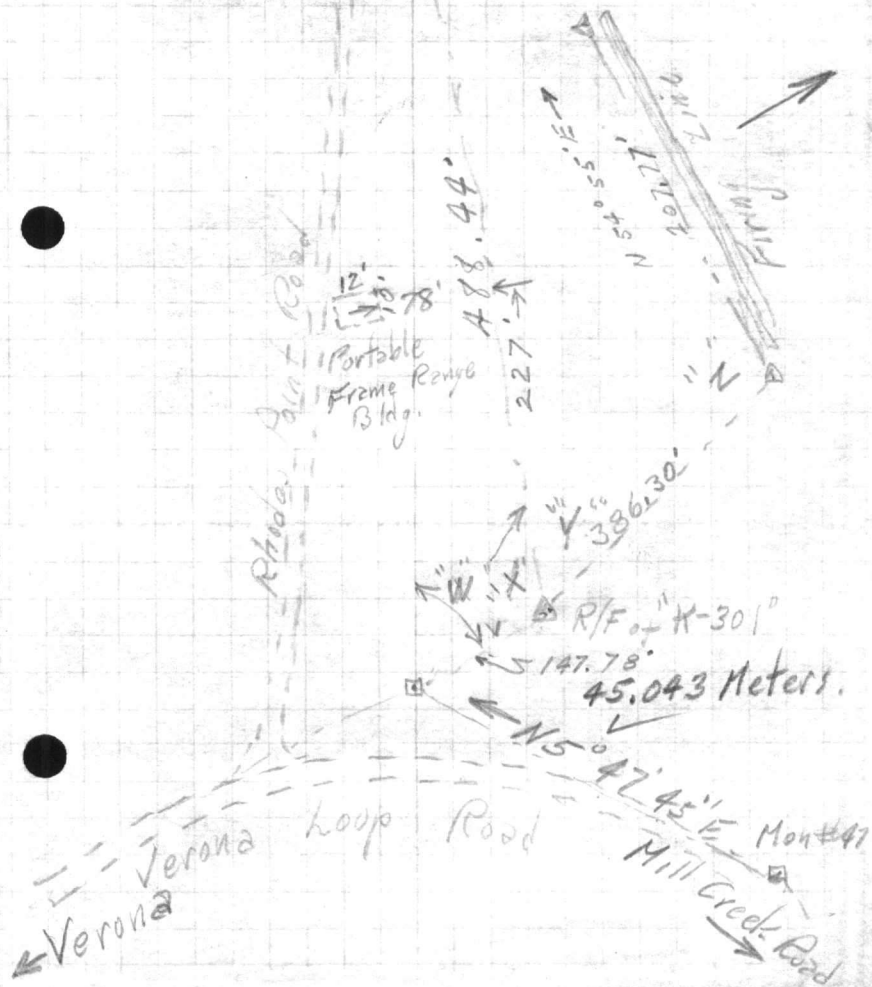

259-43  
22  
779  
220  
59-

3 2 117  
59-07-30  
19-42-30  
6 115-16-30  
19-42-30

 



**VALUABLE**

RETURN TO  
PUBLIC WORKS  
OFFICE  
CAMP LEJEUNE  
NORTH CAROLINA

SUBJECT

Location of "K" Ranges  
I.T.P. Area.  
Rhoder Point Road

FIELD PARTY

\_\_\_\_ IN CHARGE  
\_\_\_\_ INSTRUMENT  
\_\_\_\_ NOTES  
\_\_\_\_ TAPE READ  
\_\_\_\_ TAPE OR ROD  
\_\_\_\_ TAPE OR ROD  
\_\_\_\_ INSTRUMENT NO.  
\_\_\_\_ TAPE NO.

WEATHER

CLEAR SNOW  
CLOUDY HOT  
WINDY MODERATE  
RAIN COLD  
FAIR FOG  
FIGURED BY \_\_\_\_\_  
NOTES CHECKED BY \_\_\_\_\_  
PLOTTED BY \_\_\_\_\_

FILE No. \_\_\_\_\_

FLDR. No. \_\_\_\_\_

SHEET

DATE 4-20 1961

Quad. No. \_\_\_\_\_

| STATION | DIST. | ANGLE<br>° ' " | + | H. I.<br>BEARING | VER: ANG.<br>DIFF. | ELEVATION |
|---------|-------|----------------|---|------------------|--------------------|-----------|
|---------|-------|----------------|---|------------------|--------------------|-----------|

P.I. #4 = R/F of Range "K" - 303"

1009.78

- 0.10

307.782 meters

1-187°07'30"  
3-201°21'45"  
Mean-187°07'15"

P.I. #3

701.48'

- .07

213.812 meters

1-194°13'00"  
3-222°39'00"  
Mean-194°13'00"

P.I. #2

814.30

- 0.12

Temp 48° 248.199 meters

1-183°18'30"  
3-187°55'00"  
Mean-183°18'20"

Magn: 5 85°35'E

P.I. #1

1001.735

147-07-30

201-21-45

360

3 561  
187-07-15

151-07-00  
360  
20-15  
151-06-45


**VALUABLE**

RETURN TO  
PUBLIC WORKS  
OFFICE  
CAMP LEJEUNE  
NORTH CAROLINA

SUBJECT

Location of "K" Ranges  
I. T. R. Area

Rhodes Point Area

FIELD PARTY

IN CHARGE \_\_\_\_\_  
INSTRUMENT \_\_\_\_\_  
NOTES \_\_\_\_\_  
TAPE READ \_\_\_\_\_  
TAPE OR ROD \_\_\_\_\_  
TAPE OR ROD \_\_\_\_\_  
INSTRUMENT No. \_\_\_\_\_  
TAPE No. \_\_\_\_\_

WEATHER

CLEAR \_\_\_\_\_ SNOW \_\_\_\_\_  
CLOUDY \_\_\_\_\_ HOT \_\_\_\_\_  
WINDY \_\_\_\_\_ MODERATE \_\_\_\_\_  
RAIN \_\_\_\_\_ COLD \_\_\_\_\_  
FAIR \_\_\_\_\_ FOG \_\_\_\_\_

FILE No. \_\_\_\_\_

FLDR. No. \_\_\_\_\_

SHEET


#3 of 10

DATE


4-20 1961

Quad. No. \_\_\_\_\_

| STATION                      | DIST.    | ANGLE<br>" +      | H. I.<br>BEARING | VER. ANG.<br>DIFF. | ELEVATION |
|------------------------------|----------|-------------------|------------------|--------------------|-----------|
| P.I. #7 = R/F of Range K-305 | 1048.92' | -08               | 319.711 meters   |                    |           |
|                              |          | 1-192°32'15"      |                  |                    |           |
|                              |          | 3-187°36'30"      |                  |                    |           |
|                              |          | H.P.M. 182°32'10" |                  |                    |           |
| P.I. #6 = R/F of Range K-305 | 429.20'  | 04                | 130.820 meters   |                    |           |
|                              |          | 1-182°40'30"      |                  |                    |           |
|                              |          | 3-188°01'00"      |                  |                    |           |
|                              |          | H.P.M. 182°40'20" |                  |                    |           |
| P.I. #5 = R/F of K-303       | 406.68'  | 04                | 123.956 meters   | 56°                |           |
|                              |          | 1-151°07'00"      |                  |                    |           |
|                              |          | 3-93°20'15"       |                  |                    |           |
|                              |          | H.P.M. 151°06'45" |                  |                    |           |
| P.I. #4 R/F of "K-303"       |          |                   |                  |                    |           |

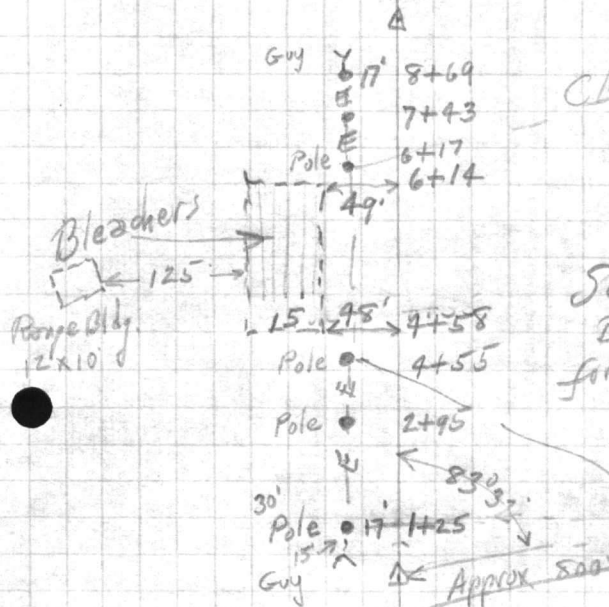

970  
39  
1009  
Clearing Line  
See Sheet 3 of 3  
Dated 6/4/61  
for Range Lines  
List of 4+55  
Clearing  
Range  
Line  
Markers

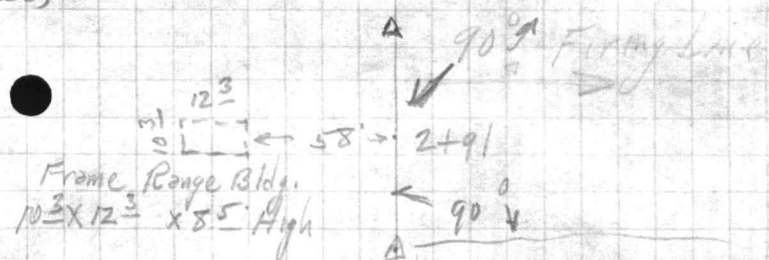

187-36-30  
182-32-10  
370-08-40  
10°08-40  
98-40  
83 82



**VALUABLE**

RETURN TO  
PUBLIC WORKS  
OFFICE  
CAMP LEJEUNE  
NORTH CAROLINA

SUBJECT

Location of "K" Ranges  
I. T. R. Area

Rhodes Point Road

**FIELD PARTY**

\_\_\_\_ IN CHARGE  
\_\_\_\_ INSTRUMENT  
\_\_\_\_ NOTES  
\_\_\_\_ TAPE READ  
\_\_\_\_ TAPE OR ROD  
\_\_\_\_ TAPE OR ROD  
\_\_\_\_ INSTRUMENT NO.  
\_\_\_\_ TAPE NO.

**WEATHER**

CLEAR  
CLOUDY  
WINDY  
RAIN  
FAIR  
SNOW  
HOT  
MODERATE  
COLD  
FOG

FILE No. \_\_\_\_\_

FLDR. No. \_\_\_\_\_

SHEET

#4 of 10

DATE

4-20 1961

Quad. No. \_\_\_\_\_

| STATION | DIST. | ANGLE<br>" " | + | H. I.<br>BEARING | VER: ANG.<br>DIFF. | ELEVATION |
|---------|-------|--------------|---|------------------|--------------------|-----------|
|---------|-------|--------------|---|------------------|--------------------|-----------|

P.I. #10 = R/F of Range K-309  
= U.S.M.C. Mon. # 727

513.09

-.03

156.390 meters ✓

1- 231° 14' 30"

3- 333° 42' 00"

MEAN 231° 14' 30"

P.I. #9

842.47

-.05

256.785 meters ✓

1- 273° 58' 00"

3- 101° 54' 00"

MEAN 273° 58' 00"

P.I. #8

477.38

-.03

N 9° 45' W Magnetic

145 x 506 meters ✓

① 78° 32' 15"

② 235° 36' 30"

③ 78° 32' 10"

P.I. #7 = L/F Range K-305

78-32-15  
235-36-45





**VALUABLE**
 RETURN TO  
 PUBLIC WORKS  
 OFFICE  
 CAMP LEJEUNE  
 NORTH CAROLINA

SUBJECT

 Location of "K" Ranges  
 I. T. R. Area

Rhodes Point Road

## FIELD PARTY

 \_\_\_\_\_ IN CHARGE  
 \_\_\_\_\_ INSTRUMENT  
 \_\_\_\_\_ NOTES  
 \_\_\_\_\_ TAPE READ  
 \_\_\_\_\_ TAPE OR ROD  
 \_\_\_\_\_ TAPE OR ROD  
 \_\_\_\_\_ INSTRUMENT NO.  
 \_\_\_\_\_ TAPE NO.

## WEATHER

 CLEAR SNOW  
 CLOUDY HOT  
 WINDY MODERATE  
 RAIN COLD  
 FAIR FOG

FILE No. \_\_\_\_\_

FLDR. No. \_\_\_\_\_

SHEET

#5 of 10

FIGURED BY \_\_\_\_\_

NOTES CHECKED BY \_\_\_\_\_

PLOTTED BY \_\_\_\_\_

DATE 4-20 1961

Quad. No. \_\_\_\_\_

| STATION | DIST. | ANGLE | H. I.   | VER. ANG. | ELEVATION |
|---------|-------|-------|---------|-----------|-----------|
|         |       | ° ' " | BEARING | DIFF.     |           |

P.I. #12 = L/F of Range "K-311" ✓  
 566.00' 172.517 meters

1-180°44'15"  
 3-182°12'30"  
 MPBN-180°44'10"

P.I. #11 = L/F of Range K-309 and R/F of Range "K-311" ✓

334.01' 101.806 meters

1-145°40'00"  
 3-76°59'30"  
 MPBN-145°39'50"


P.I. #10 = R/F of Range K-309  
 Mon. #727

Portable  
 Frame Range Bldg.  
 5' High

U.S.M.C. Mon. #728

portable  
 Frame Range Bldg.  
 123'

6' x 6' Top  
 Wood Obs. Tower  
 30' High  
 S-K-5-A

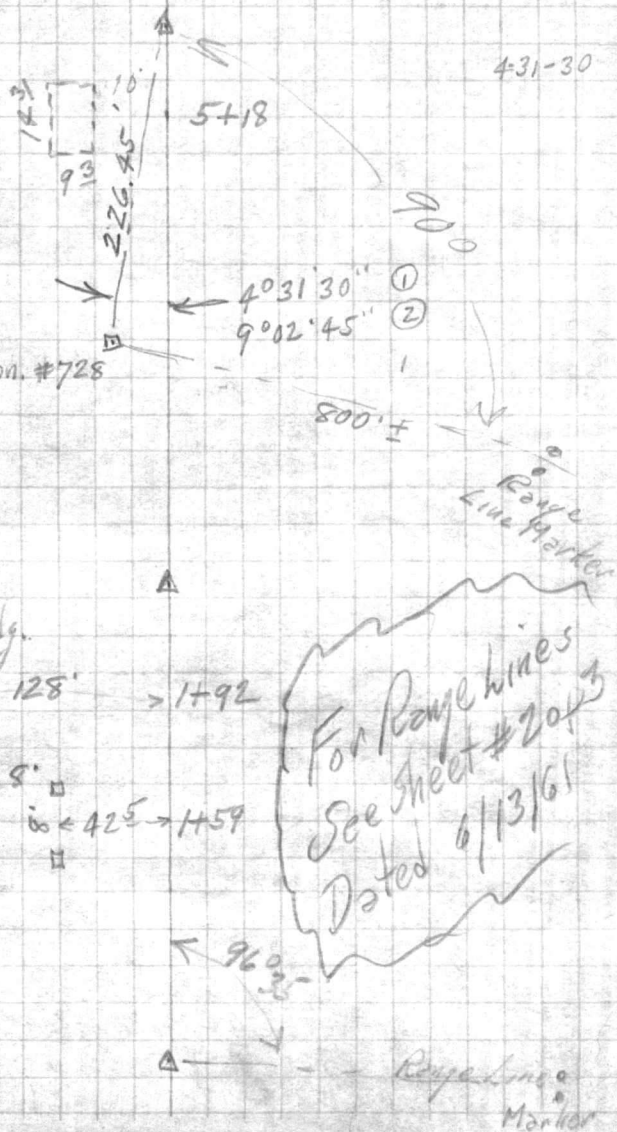

77°  
145° 40  
222° 40'  
319° 15  
96 35












**VALUABLE**

SUBJECT

Location of "K" Ranges

RETURN TO  
PUBLIC WORKS  
OFFICE  
CAMP LEJEUNE  
NORTH CAROLINA

L. T. R. Area

Rhodes Point Road

FIELD PARTY

IN CHARGE  
INSTRUMENT  
NOTES  
TAPE READ  
TAPE OR ROD  
TAPE OR ROD  
INSTRUMENT NO.  
TAPE NO.

WEATHER

CLEAR  
CLOUDY  
WINDY  
RAIN  
FAIR  
SNOW  
HOT  
MODERATE  
COLD  
FOG

FILE No.

FLDR. No.

SHEET #6 of 10

DATE 4-21 1961

Quad. No.

| STATION | DIST. | ANGLE | H. I.   | VER. ANG. | ELEVATION |
|---------|-------|-------|---------|-----------|-----------|
|         |       | " + " | BEARING | DIFF.     |           |

P.I. #16 L/F of Range "K-317" ✓  
492.31 150.056 meters

1-208°56'00"  
3-266°47'15"  
MEAN-208°55'40"

P.I. #15 R/F of Range "K-317" ✓  
303.22 92.422 meters

1-180°39'00"  
3-181°56'30"  
MEAN-180°38'50"  
S 80°10' E



P.I. #14 L/F K-315 ✓  
445.92 135.917 meters

1-162°31'00"  
3-127°33'00"  
MEAN-162°31'00"

P.I. #13 = R/F of Range "K-315" ✓  
275.15' 83.866 meters

1-195°02'15"  
3-225°06'30"  
MEAN-195°02'10"

P.I. #12 = L/F of Range "K-311"

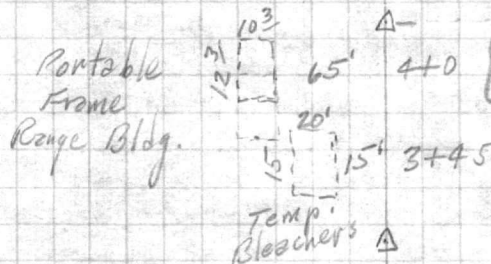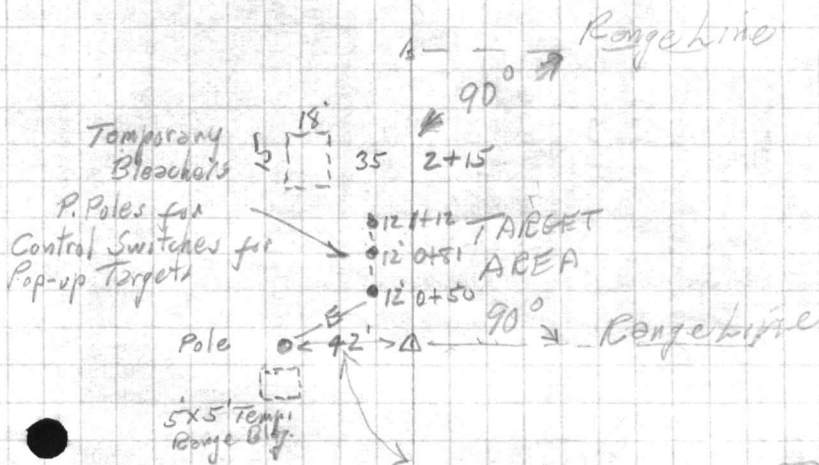

For Range Lines  
See Sheet #20 of 3  
Dated 6/13/61

195-02-15  
3

585-06-45

360

225-06-30

02-10

VALUABLE

SUBJECT

Location of "K" Ranges

RETURN TO  
PUBLIC WORKS  
OFFICE  
CAMP LEJEUNE  
NORTH CAROLINA

L. T. R. Areas

Rhodes Point Road

## FIELD PARTY

\_\_\_\_ IN CHARGE  
 \_\_\_\_ INSTRUMENT  
 \_\_\_\_ NOTES  
 \_\_\_\_ TAPE READ  
 \_\_\_\_ TAPE OR ROD  
 \_\_\_\_ TAPE OR ROD  
 \_\_\_\_ INSTRUMENT NO.  
 \_\_\_\_ TAPE NO.

## WEATHER

CLEAR  
 CLOUDY  
 WINDY  
 RAIN  
 FAIR

SNOW  
 HOT  
 MODERATE  
 COLD  
 FOG

FILE No. \_\_\_\_\_

FLDR. No. \_\_\_\_\_

SHEET

#7 of 10

DATE

9-21-1961

Quad. No. \_\_\_\_\_

| STATION | DIST. | ANGLE<br>" " | + | H. I.<br>BEARING | VER. ANG.<br>DIFF. | ELEVATION |
|---------|-------|--------------|---|------------------|--------------------|-----------|
|---------|-------|--------------|---|------------------|--------------------|-----------|

555.26'

169.244 meters

1-247°54'30"

3-23°42'45"

MEAN-247°54'15"

P.I. #9

698.72'

212.970 meters

1-121°52'15"

3-5°36'30"

MEAN-121°52'10"

P.I. #18 W/F of Range K-319

284.18

86.618 meters

1-189°09'45"

3-207°28'30"

MEAN-189°09'30"

P.I. #17 W/F Range K-319

491.52

149.816 meters

① 134°45'00"

② 44°15'00"

P.I. #16 W/F of Range "K-317"







SK6A

VALUABLE

SUBJECT Location of "K" Ranges  
I. T. R. Area  
Rhodes Point Road

RETURN TO  
PUBLIC WORKS  
OFFICE  
CAMP LEJEUNE  
NORTH CAROLINA


FIELD PARTY  
 \_\_\_\_\_ IN CHARGE  
 \_\_\_\_\_ INSTRUMENT  
 \_\_\_\_\_ NOTES  
 \_\_\_\_\_ TAPE READ  
 \_\_\_\_\_ TAPE OR ROD  
 \_\_\_\_\_ TAPE OR ROD  
 \_\_\_\_\_ INSTRUMENT NO.  
 \_\_\_\_\_ TAPE NO.

WEATHER  
 CLEAR \_\_\_\_\_  
 CLOUDY \_\_\_\_\_  
 WINDY \_\_\_\_\_  
 RAIN \_\_\_\_\_  
 SNOW \_\_\_\_\_  
 HOT \_\_\_\_\_  
 MODERATE \_\_\_\_\_  
 COLD \_\_\_\_\_  
 FOG \_\_\_\_\_  
 FIGURED BY \_\_\_\_\_  
 NOTES CHECKED BY \_\_\_\_\_  
 PLOTTED BY \_\_\_\_\_

FILE No. \_\_\_\_\_  
 FLDR. No. \_\_\_\_\_  
 SHEET 28 of 10  
 DATE 4-21-1961

Quad. No. \_\_\_\_\_

| STATION  | DIST.           | ANGLE<br>° ' " | + | H. I.<br>BEARING | VER: ANG.<br>DIFF. | ELEVATION      |
|----------|-----------------|----------------|---|------------------|--------------------|----------------|
| P.I. #23 |                 |                |   |                  |                    |                |
| P.I. #22 | 1-186°26'30"    |                |   |                  |                    |                |
|          | 3-199°18'25"    |                |   |                  |                    |                |
|          | MEAN 186°26'15" |                |   |                  |                    |                |
|          | 608.03'         |                |   |                  |                    |                |
|          |                 |                |   |                  |                    | 185.328 meters |
|          |                 |                |   |                  |                    |                |
|          |                 |                |   |                  |                    |                |
|          | 1-173°20'15"    |                |   |                  |                    |                |
|          | 3-160°00'30"    |                |   |                  |                    |                |
|          | MEAN 173°20'10" |                |   |                  |                    |                |
|          |                 |                |   |                  |                    | Mag: 542°35'E  |
| P.I. #21 |                 |                |   |                  |                    |                |
|          | 298.19'         |                |   |                  |                    |                |
|          |                 |                |   |                  |                    | 90.889 meters  |
|          | 1-121°29'00"    |                |   |                  |                    |                |
|          | 3-304°27'15"    |                |   |                  |                    |                |
|          | MEAN 121°29'05" |                |   |                  |                    |                |
| P.I. #20 |                 |                |   |                  |                    |                |
|          | 555.26'         |                |   |                  |                    |                |
|          |                 |                |   |                  |                    | 169.244 meters |

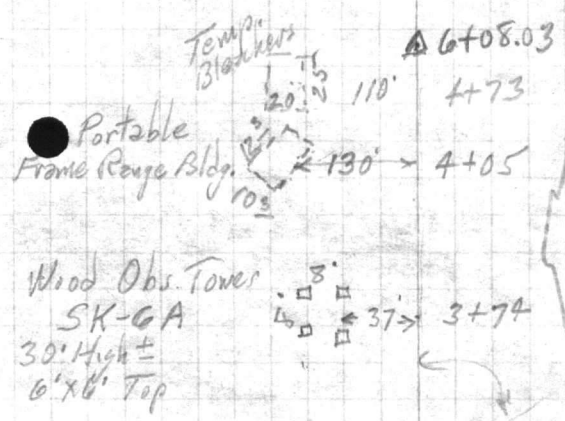

For Range lines  
 See sheet #20 of 3  
 Dated 6/13/21


186-26-30

199-18-45  
360

3 | 559 74  
186-26-15

186-26-30

259-19-30

173-20360

199-

160-00-30

360

3 | 520 60  
173-20-10



**VALUABLE**

SUBJECT Location of "K" Ranges  
L. T. R. Area  
Rhodes Point Road

RETURN TO  
 PUBLIC WORKS  
 OFFICE  
 CAMP LEJEUNE  
 NORTH CAROLINA

**FIELD PARTY**

\_\_\_\_\_  
 IN CHARGE  
 \_\_\_\_\_  
 INSTRUMENT  
 \_\_\_\_\_  
 NOTES  
 \_\_\_\_\_  
 TAPE READ  
 \_\_\_\_\_  
 TAPE OR ROD  
 \_\_\_\_\_  
 TAPE OR ROD  
 \_\_\_\_\_  
 INSTRUMENT NO. \_\_\_\_\_  
 TAPE NO. \_\_\_\_\_

**WEATHER**

CLEAR \_\_\_\_\_ SNOW \_\_\_\_\_  
 CLOUDY \_\_\_\_\_ HOT \_\_\_\_\_  
 WINDY \_\_\_\_\_ MODERATE \_\_\_\_\_  
 RAIN \_\_\_\_\_ COLD \_\_\_\_\_  
 FAIR \_\_\_\_\_ FOG \_\_\_\_\_  
 FIGURED BY \_\_\_\_\_  
 NOTES CHECKED BY \_\_\_\_\_  
 PLOTTED BY \_\_\_\_\_


FILE No. \_\_\_\_\_  
 FLDR. No. \_\_\_\_\_  
 SHEET # 9 of 10  
 DATE 4/21/51

Quad. No. \_\_\_\_\_

| STATION        | DIST.   | ANGLE<br>° ' "     | + | H. I.<br>BEARING       | VER: ANG.<br>DIFF. | ELEVATION |
|----------------|---------|--------------------|---|------------------------|--------------------|-----------|
| P.I. #26       |         |                    |   |                        |                    |           |
| Center<br>Base | 412     | Stadia Distance    |   |                        |                    |           |
|                |         | Side Shot          |   |                        |                    |           |
|                |         | ① 190° 55' 30"     |   | Wood Observation Tower |                    |           |
|                |         | ② 21° 50'          |   | SK 25 A                |                    |           |
|                |         | 1- 148° 43' 45"    |   |                        |                    |           |
|                |         | 3- 86° 10' 30"     |   |                        |                    |           |
|                |         | MEAN 148° 43' 30"  |   |                        |                    |           |
| P.I. #25       | L/F     | Range K-325        | ✓ |                        |                    |           |
|                | 528.20' |                    |   | 160.996 meters         |                    |           |
|                |         | 1- 205° 41' 45"    |   |                        |                    |           |
|                |         | 3- 257° 05' 30"    |   |                        |                    |           |
|                |         | MEAN- 205° 41' 50" |   |                        |                    |           |
| P.I. #24       | R/F     | Range R-325        | ✓ |                        |                    |           |
|                | 919.80' |                    |   | 280.356 meters         |                    |           |
|                |         | 1- 159° 00' 00"    |   |                        |                    |           |
|                |         | 3- 116° 59' 45"    |   |                        |                    |           |
|                |         | MEAN- 158° 59' 55" |   |                        |                    |           |
| P.I. #23       |         |                    |   |                        |                    |           |
|                | 338.52' |                    |   | 103.181 meters         |                    |           |

6' 13 1/2 platform  
 4x4 Bldg.  
 on top

Portable  
 Frame  
 Range Bldg.

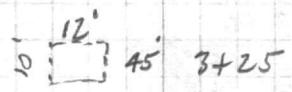
































































































































**VALUABLE**

SUBJECT

Location of "K" Ranges

I. T. R. Area

Rhodes Point Road

RETURN TO  
PUBLIC WORKS  
OFFICE  
CAMP LEJEUNE  
NORTH CAROLINA

**FIELD PARTY**

IN CHARGE \_\_\_\_\_  
INSTRUMENT \_\_\_\_\_  
NOTES \_\_\_\_\_  
TAPE READ \_\_\_\_\_  
TAPE OR ROD \_\_\_\_\_  
TAPE OR ROD \_\_\_\_\_  
INSTRUMENT NO. \_\_\_\_\_  
TAPE NO. \_\_\_\_\_

**WEATHER**

CLEAR \_\_\_\_\_  
CLOUDY \_\_\_\_\_  
WINDY \_\_\_\_\_  
RAIN \_\_\_\_\_  
FAIR \_\_\_\_\_  
SNOW \_\_\_\_\_  
HOT \_\_\_\_\_  
MODERATE \_\_\_\_\_  
COLD \_\_\_\_\_  
FOG \_\_\_\_\_

FILE No. \_\_\_\_\_

FLDR. No. \_\_\_\_\_

SHEET

10 of 10

FIGURED BY \_\_\_\_\_

NOTES CHECKED BY \_\_\_\_\_

PLOTTED BY \_\_\_\_\_

DATE 4-24 1961

Quad. No. \_\_\_\_\_

| STATION | DIST. | ANGLE<br>° ' " | + | H. I.<br>BEARING | VER: ANG.<br>DIFF. | ELEVATION |
|---------|-------|----------------|---|------------------|--------------------|-----------|
|---------|-------|----------------|---|------------------|--------------------|-----------|

MON. of Rhodes Point

551.49'

168.095 meters

1- 139° 51' 15"


3- 59° 34' 00"

NOON- 139° 51' 20"

P.I. #26

737.65'

224.836 meters

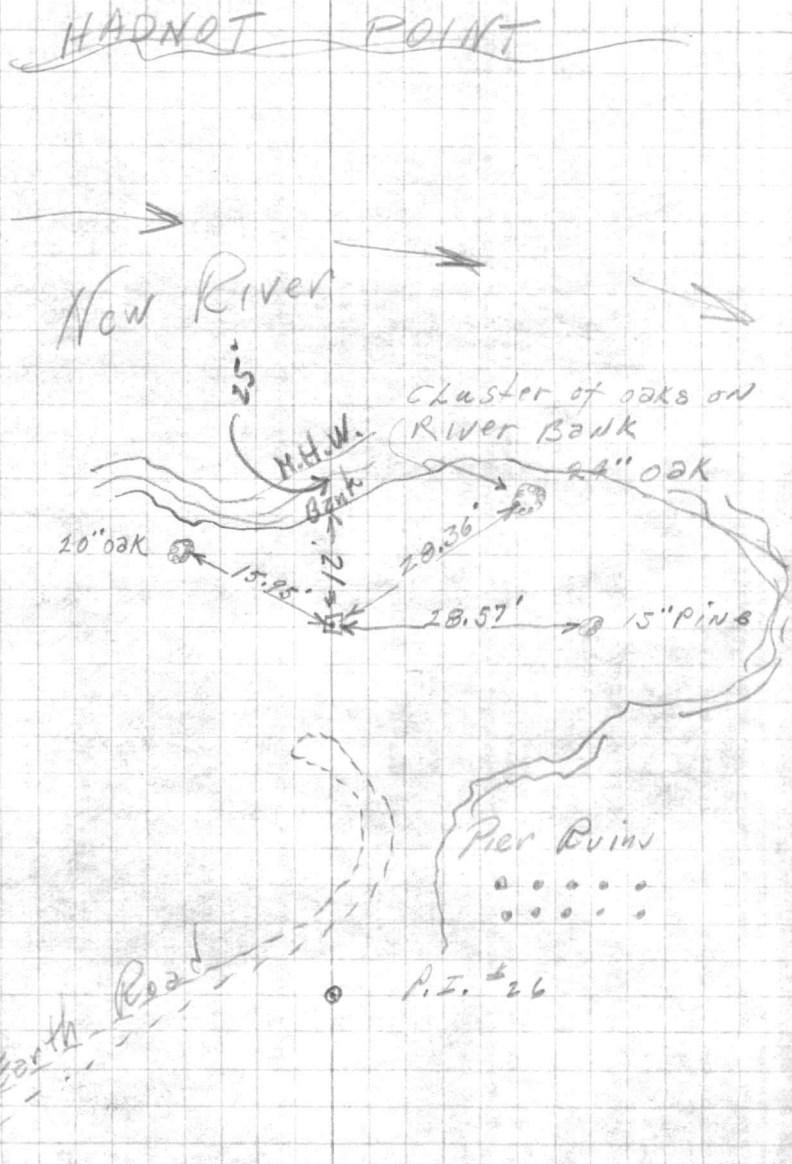























**VALUABLE**
 RETURN TO  
 PUBLIC WORKS  
 OFFICE  
 CAMP LEJEUNE  
 NORTH CAROLINA

SUBJECT

 Bearing Tie "  
 "Sime" - Mon #400 to Rhodes"

## FIELD PARTY

 \_\_\_\_\_ IN CHARGE  
 \_\_\_\_\_ INSTRUMENT  
 \_\_\_\_\_ NOTES  
 \_\_\_\_\_ TAPE READ  
 \_\_\_\_\_ TAPE OR ROD  
 \_\_\_\_\_ TAPE OR ROD  
 \_\_\_\_\_ INSTRUMENT NO.  
 \_\_\_\_\_ TAPE NO.

## WEATHER

 CLEAR SNOW  
 CLOUDY HOT  
 WINDY MODERATE  
 RAIN COLD  
 FAIR FOG

FILE No. \_\_\_\_\_


FLDR. No. \_\_\_\_\_

SHEET \_\_\_\_\_

DATE \_\_\_\_\_ 19\_\_

Quad. No. \_\_\_\_\_

| STATION  | DIST. | ANGLE<br>° ' " | + | H. I.<br>BEARING | VER: ANG.<br>DIFF. | ELEVATION |
|--|-------|----------------|---|------------------|--------------------|-----------|
| To Water Tanks at Camp Geiger<br>Tent Camp No. 1 |       |                |   |                  |                    |           |
| ①  |       | 51° 52' 15"    |   |                  |                    |           |
| ③  |       | 155° 37' 15"   |   |                  |                    |           |
| ④  |       | 51° 52' 25"    |   |                  |                    |           |
| To Copala  |       |                |   |                  |                    |           |
| ①  |       | 57° 42' 15"    |   |                  |                    |           |
| ③  |       | 173° 07' 00"   |   |                  |                    |           |
| ④  |       | 57° 42' 20"    |   |                  |                    |           |
| T to "Sime" Mon #400                             |       |                |   |                  |                    |           |
| Sight on "Rhodes"                                |       |                |   |                  |                    |           |

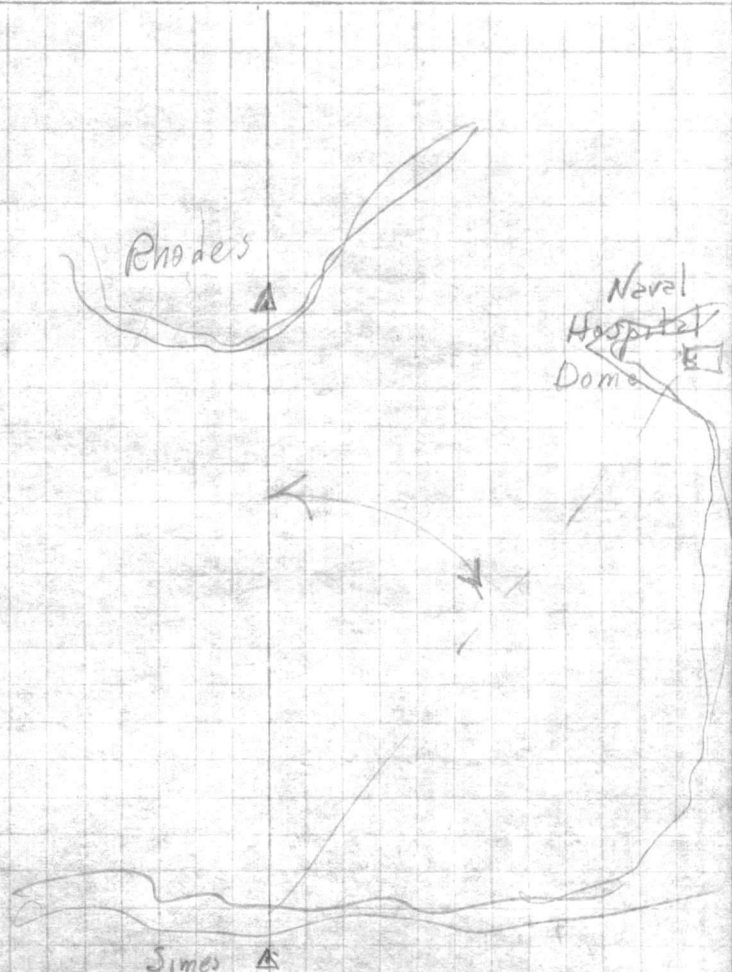

51-52-15

2 3

155-36-45

37-

57-42-15

2 3

173-06-45


**VALUABLE**

RETURN TO  
PUBLIC WORKS  
OFFICE  
CAMP LEJEUNE  
NORTH CAROLINA

SUBJECT

*Triangulation for  
Traverse Tie to  
"K" Series Range Traverse*

**FIELD PARTY**

*Dillon* IN CHARGE  
*Kellum* INSTRUMENT  
NOTES  
TAPE READ  
TAPE OR ROD  
TAPE OR ROD  
INSTRUMENT NO.  
TAPE NO.


**WEATHER**

CLEAR  
CLOUDY  
WINDY  
RAIN  
FAIR  
SNOW  
HOT  
MODERATE  
COLD  
FOG  
FIGURED BY  
NOTES CHECKED BY  
PLOTTED BY

FILE No. \_\_\_\_\_  
FLDR. No. \_\_\_\_\_  
SHEET *#1 of 2*  
DATE *4/19/61*

Quad. No. \_\_\_\_\_

| STATION | DIST. | ANGLE<br>" "  | + | H. I.<br>BEARING | VER: ANG.<br>DIFF. | ELEVATION |
|---------|-------|---------------|---|------------------|--------------------|-----------|
| "Y"     | ①     | 149° 18'      |   |                  | 359-59-60          |           |
|         | ③     | 147° 53' 45"  |   |                  | 169-17-55          |           |
|         | ④     | 169° 17' 55"  |   |                  | 190-42-03          |           |
|         | (M)   |               |   |                  |                    |           |
| "C"     | ①     | 69° 31' 15"   |   |                  |                    |           |
|         | ③     | 208° 34' 00"  |   |                  |                    |           |
|         | ④     | 57° 07' 30"   |   |                  |                    |           |
|         | (M)   | 69° 31' 15"   |   |                  | -01" = 69-31-14    |           |
| "B"     | ①     | 59° 09' 30" ± |   |                  |                    |           |
|         | ③     | 177° 29' 15"  |   |                  |                    |           |
|         | ④     | 354° 58' 30"  |   |                  |                    |           |
|         | (M)   | 59° 09' 45"   |   |                  | -02" = 59-09-43    |           |
| "A"     | ①     | 57° 19' 15"   |   |                  |                    |           |
|         | ③     | 153° 57' 30"  |   |                  |                    |           |
|         | ④     | 307° 54' 30"  |   |                  |                    |           |
|         | (M)   | 57° 19' 05"   |   |                  | -02" = 51-19-03    |           |

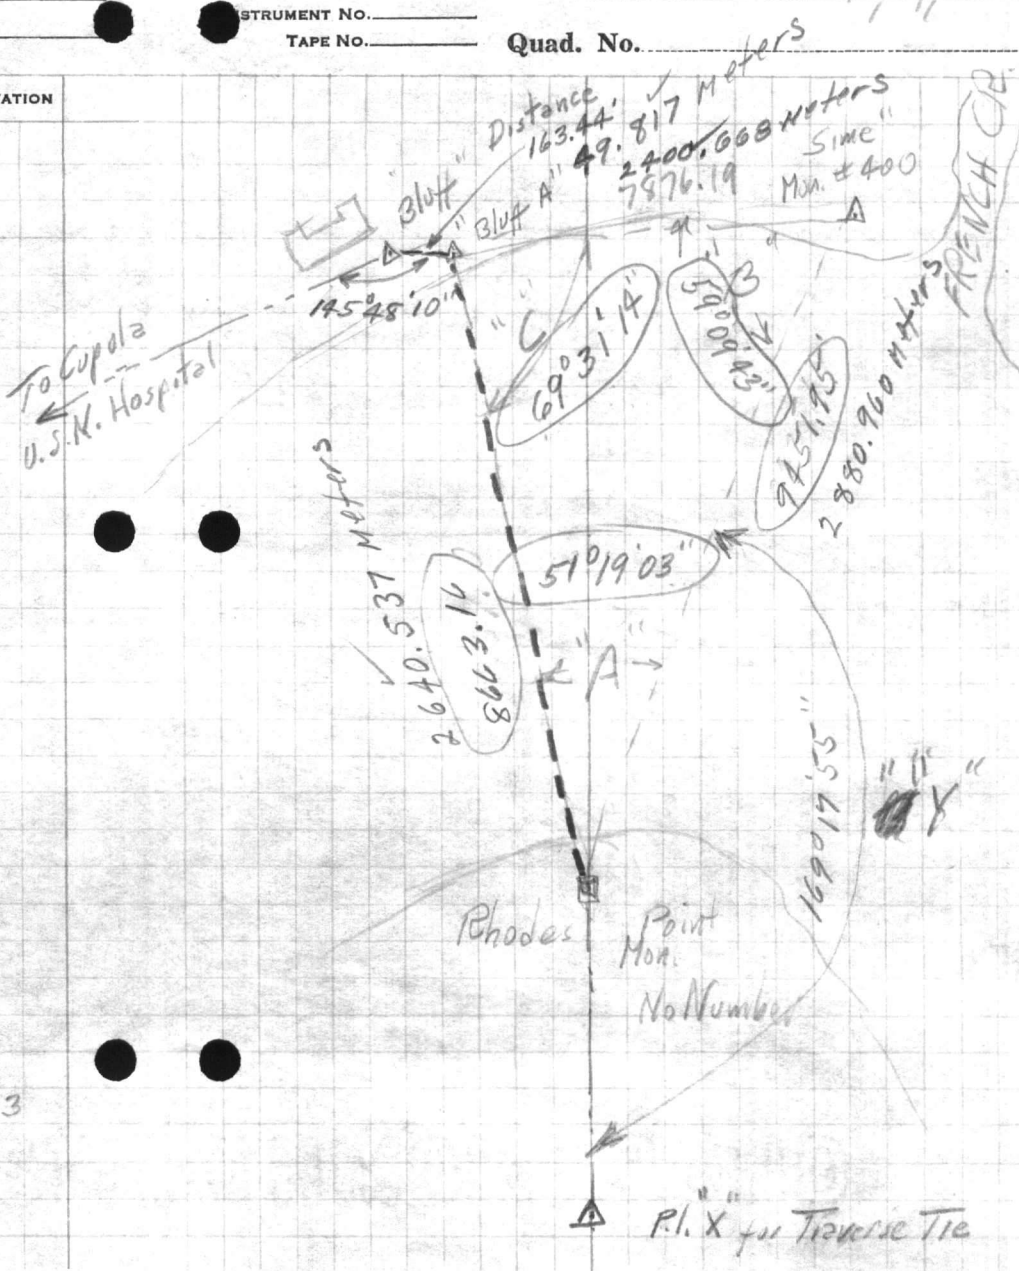

57-19-15  
307 55 30  
114  
6 307-54-30  
57-19-05

917  
360  
5 57-10  
157  
6 417-07-30  
69-31-30

113 53-45  
169-18  
507-54  
3 165  
3 149-53-45  
3 17-55

54-09-30  
3 6  
354-57-00  
220  
6 354-58-38  
59-09-45  
51-14-05  
110-28-50  
69-31-10

69-31-15  
3  
8 33-95





VALUABLE

SUBJECT Angle Ties for Resection Comp.  
Un-numbered monument on Rhodes Point

RETURN TO  
PUBLIC WORKS  
OFFICE  
CAMP LEJEUNE  
NORTH CAROLINA

FIELD PARTY

\_\_\_\_ IN CHARGE  
\_\_\_\_ INSTRUMENT  
\_\_\_\_ NOTES  
\_\_\_\_ TAPE READ  
\_\_\_\_ TAPE OR ROD  
\_\_\_\_ TAPE OR ROD  
\_\_\_\_ INSTRUMENT NO.  
\_\_\_\_ TAPE NO.


WEATHER

CLEAR \_\_\_\_\_  
CLOUDY \_\_\_\_\_  
WINDY \_\_\_\_\_  
RAIN \_\_\_\_\_  
FAIR \_\_\_\_\_  
SNOW \_\_\_\_\_  
HOT \_\_\_\_\_  
MODERATE \_\_\_\_\_  
COLD \_\_\_\_\_  
FOG \_\_\_\_\_

FILE No. \_\_\_\_\_  
FLDR. No. \_\_\_\_\_  
SHEET # 2 of 2  
DATE \_\_\_\_\_ 19\_\_

Quad. No. \_\_\_\_\_

| STATION   | DIST. | ANGLE<br>° ' "                            | + | H. I.<br>BEARING | VER: ANG.<br>DIFF. | ELEVATION |
|---|-------|---|---|------------------|--------------------|-----------|
| "Z"<br>①<br>②<br>③<br>④<br>⑤<br>⑥<br>⑦<br>⑧<br>⑨<br>⑩ |       | 30° 09' 00"<br>90° 27' 00"<br>✓           |   |                  |                    |           |
| "Y"<br>①<br>②<br>③<br>④<br>⑤<br>⑥<br>⑦<br>⑧<br>⑨<br>⑩ |       | 26° 46' 00"<br>80° 18' 00"<br>✓           |   |                  |                    |           |
| "X"<br>①<br>②<br>③<br>④<br>⑤<br>⑥<br>⑦<br>⑧<br>⑨<br>⑩ |       | 28° 30' 00"<br>85° 30' 15"<br>28° 30' 05" |   |                  |                    |           |

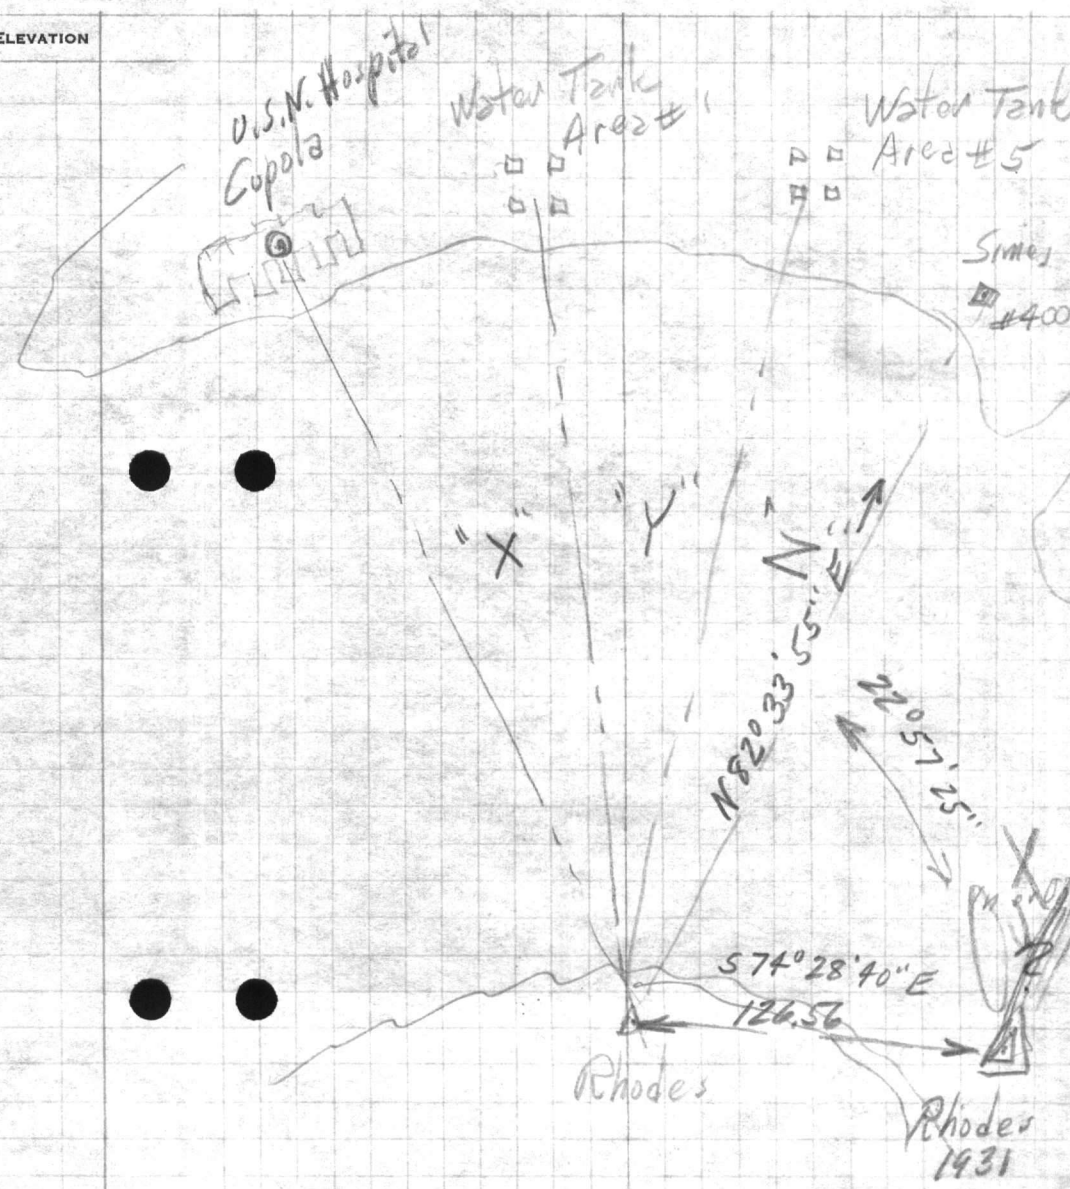



PUBLIC WORKS DEPARTMENT  
Camp Lejeune, North Carolina  
Survey Department

Traverse Computation  
Description

*Not so good. Worked from Resection Angles.*

File \_\_\_\_\_  
Quadrangle \_\_\_\_\_  
Date \_\_\_\_\_  
Sheet \_\_\_\_\_ of \_\_\_\_\_

| Station                                 | Distance  | Bearing       | Cosine     | Sine        | Latitude  | Departure | Y Coordinate<br>North | X Coordinate<br>East |
|---|-----------|---------------|------------|-------------|-----------|-----------|-----------------------|----------------------|
| Cupola U.S.N. Hospital<br>"Rhodes 1961" |           | S80°41'54"E   | To Area #1 | Water Tank. |           |           | 340,861.44            | 2,489,326.06         |
|   | 13,303.51 | S2°47'02.5"E  | 9988197    | 0485713     | 13,287.81 | 646.17    | 327,573.63            | 2,489,972.23         |
| Area #5 Water Tank<br>"Rhodes 1961"     |           | N37°03'02"W   | To Area #1 | Water Tank  |           |           | 334,917.16            | 2,449,537.00         |
|   | 12,058.74 | S52°29'02.5"W | 6089826    | 7931836     | 7,343.56  | 9,564.79  | 327,573.60            | 2,489,972.21         |
| Area #1 Water Tank<br>Rhodes 1961       |           | S37°03'02"E   | To Area #5 | Water Tank  |           |           | 339,791.76            | 2,495,857.00         |
|   | 13,561.27 | S25°38'13"W   | 9015537    | 4326672     | 12,226.21 | 5,867.52  | 327,565.55            | 2,489,989.48         |
| Simes<br>Rhodes 1961                    |           | N1°38'40"E    | To Area #5 | Water Tank  |           |           | 328,790.42            | 2,499,361.09         |
|   | 9,451.34  | S82°33'13"W   | 1295984    | 9915666     | 1,224.88  | 9,371.63  | 327,565.54            | 2,489,989.46         |

X

|      |            |              |
|------|------------|--------------|
|      | 327,573.62 | 2,489,972.22 |
|      | 327,565.54 | 2,489,989.47 |
| 2    | 655,139.16 | 4,979,961.69 |
| Mean | 327,569.58 | 2,489,980.85 |
|      | 327,563.53 | 2,489,986.91 |
|      | +6.05      | -6.06        |












PUBLIC WORKS DEPARTMENT  
Camp Lejeune, North Carolina  
Survey Department

File 178-Gen  
Quadrangle 178-179  
Date \_\_\_\_\_  
Sheet #1 of 3

Traverse Computation  
Description

Location of "K" Ranges - I.T.R. Area - Verona Loop

| Station                    | Distance | Bearing     | Ccsine  | Sine    | Latitude | Departure | Y Coordinate North | X Coordinate East |
|----------------------------|----------|-------------|---------|---------|----------|-----------|--------------------|-------------------|
| U.S.M.C. Mon. #47          |          |             |         |         | 2266.05  |           | 326,998.16         | 2,476,585.81      |
| U.S.M.C. Mon. #46          | 2276.70  | N5°47'45"E  | 9948881 | 1009839 | 2265.06  | 229.91    | 329,264.21         | 2,476,815.76      |
| ⊕ P.I. #1 L/F Range K-301  | 578.11   | N85-30-08E  | 0784204 | 9969204 | 45.94    | 576.33    | 329,309.57         | 2,477,392.21      |
| P.I. #2                    | 814.18   | N88-48-16E  | 0208649 | 9997823 | 16.99    | 814.00    | 329,326.56         | 2,478,206.37      |
| P.I. #3                    | 701.41   | S76-58-57E  | 2252486 | 9743013 | 157.44   | 683.38    | 329,168.64         | 2,478,889.89      |
| * P.I. #4 R/F Range K-303  | 1009.68  | S69-51-54E  | 3442333 | 9388841 | 347.57   | 948.17    | 328,821.22         | 2,479,838.06      |
| * P.I. #5 L/F " K-303      | 406.64   | N81-14-39E  | 1522240 | 9883460 | 61.40    | 401.40    | 328,883.14         | 2,480,240.04      |
| * P.I. #6 R/F Range K-305  | 429.16   | N83-54-46E  | 1060423 | 9943616 | 45.51    | 426.74    | 328,928.67         | 2,480,666.87      |
| * P.I. #7 L/F Range K-305  | 1048.84  | N86-26-44E  | 0619970 | 9980763 | 65.02    | 1047.03   | 328,993.71         | 2,481,713.90      |
| P.I. #8                    | 477.35   | N15-01-18 W | 9658279 | 2591843 | 461.54   | 123.72    | 329,454.95         | 2,481,590.20      |
| P.I. #9                    | 842.42   | N78-56-29E  | 1918131 | 9814315 | 161.59   | 826.78    | 329,616.61         | 2,482,417.15      |
| ⊕ P.I. #10 R/F Range K-309 | 513.06   | S49-49-13 E | 6451873 | 7640244 | 330.88   | 392.07    | 329,285.73         | 2,482,809.22      |
| * P.I. #11 L/F Range K-309 | 334.00   | S84-09-35E  | 1017556 | 9948094 | 33.49    | 332.27    | 329,251.75         | 2,483,141.56      |
| * P.I. #12 L/F Range K-311 | 565.98   | S83-25-38E  | 1144652 | 9934273 | 64.74    | 562.26    | 329,186.99         | 2,483,703.93      |
| * P.I. #13 R/F Range K-315 | 275.15   | S68-23-40E  | 3682147 | 9297408 | 101.31   | 255.82    | 329,085.72         | 2,483,959.81      |

\* This position marked by Sgt. Borek of I.T.R. Range Office.  
⊕ Monument.



PUBLIC WORKS DEPARTMENT  
Camp Lejeune, North Carolina  
Survey Department

File \_\_\_\_\_  
Quadrangle \_\_\_\_\_  
Date \_\_\_\_\_  
Sheet # 2 of 3

Traverse Computation  
Description

| Station                    | Distance | Bearing    | Cosine  | Sine    | Latitude                                     | Departure  | Y Coordinate North | X Coordinate East |
|----------------------------|----------|------------|---------|---------|--|--|--------------------|-------------------|
| P.I. #13 R/F Range K-315   |          |            |         |         |  |  | 329,085.72         | 2,483,959.81      |
| * P.I. #14 L/F Range K-315 | 445.92   | S85-52-52E | 0718263 | 9974172 | 32.03 <sup>.02</sup><br><del>32.03</del>     | 444.77 <sup>.86</sup><br><del>444.77</del> .09     | 329,053.70         | 2,484,404.67      |
| * P.I. #15 R/F Range K-317 | 303.22   | S85-14-15E | 0830256 | 9965474 | 25.18 <sup>.17</sup><br><del>25.18</del>     | 302.17 <sup>.23</sup><br><del>302.17</del> .06     | 329,028.53         | 2,484,706.90      |
| * P.I. #16 L/F Range K-317 | 492.31   | S56-18-42E | 5546750 | 8320671 | 27.2.95 <sup>.17</sup><br><del>27.2.95</del> | 409.63 <sup>.71</sup><br><del>409.63</del> .08     | 328,755.58         | 2,485,116.61      |
| * P.I. #17 R/F Range K-319 | 491.52   | N78-26-06E | 2004795 | 9796979 | 98.57 <sup>.58</sup><br><del>98.57</del>     | 481.54 <sup>.64</sup><br><del>481.54</del> .10     | 328,854.16         | 2,485,598.25      |
| * P.I. #18 L/F Range K-319 | 284.18   | N87-35-23E | 0420549 | 9991153 | 11.95 <sup>.99</sup>                         | 283.43 <sup>.67</sup><br><del>283.43</del> .06     | 328,866.11         | 2,485,882.24      |
| P.I. #19                   | 698.72   | N29-27-21E | 8707350 | 4917525 | 608.40 <sup>.66</sup><br><del>608.40</del>   | 343.60 <sup>.67</sup><br><del>343.60</del> .07     | 329,474.77         | 2,486,225.91      |
| P.I. #20                   | 555.26   | S82-38-36E | 1280455 | 9917683 | 71.10 <sup>.07</sup><br><del>71.10</del>     | 550.69 <sup>.80</sup><br><del>550.69</del> .11     | 329,403.70         | 2,486,776.71      |
| * P.I. #21 R/F Range K-321 | 298.19   | S41-09-44E | 7528490 | 6581932 | 224.44 <sup>.39</sup><br><del>224.44</del>   | 196.27 <sup>.31</sup><br><del>196.27</del> .04     | 329,179.31         | 2,486,973.02      |
| * P.I. #22 L/F Range K-321 | 608.03   | S47-49-46E | 6713398 | 7411497 | 408.14 <sup>.02</sup><br><del>408.14</del>   | 450.64 <sup>.73</sup><br><del>450.64</del> .09     | 328,771.29         | 2,487,423.75      |
| P.I. #23                   | 338.52   | S41-23-43E | 7501656 | 6612500 | 253.75 <sup>.84</sup><br><del>253.75</del>   | 223.85 <sup>.89</sup><br><del>223.85</del> .04     | 328,517.45         | 2,487,647.64      |
| * P.I. #24 R/F Range K-325 | 919.80   | S62-24-01E | 4632917 | 8862058 | 425.96 <sup>.28</sup><br><del>425.96</del>   | 815.13 <sup>.30</sup><br><del>815.13</del> .17     | 328,091.49         | 2,488,462.94      |
| * P.I. #25 L/F Range K-325 | 528.20   | S36-42-23E | 8017090 | 5977145 | 423.46 <sup>.28</sup><br><del>423.46</del>   | 315.71 <sup>.77</sup><br><del>315.71</del> .06     | 327,668.21         | 2,488,778.71      |
| P.I. #26                   | 737.65   | S67-59-05E | 3748538 | 9270839 | 276.57 <sup>.38</sup><br><del>276.57</del>   | 683.86 <sup>.684.00</sup><br><del>683.86</del> .14 | 327,391.83         | 2,489,462.71      |





PUBLIC WORKS DEPARTMENT  
Camp Lejeune, North Carolina  
Survey Department

File \_\_\_\_\_  
Quadrangle \_\_\_\_\_  
Date \_\_\_\_\_  
Sheet 3 of 3

Traverse Computation  
Description

| Station                             | Distance                      | Bearing              | Cosine  | Sine    | Latitude                             | Departure                            | Y Coordinate North | X Coordinate East |
|-------------------------------------|-------------------------------|----------------------|---------|---------|--------------------------------------|--------------------------------------|--------------------|-------------------|
| P.I. # 26                           |                               |                      |         |         |                                      |                                      | 327,391.83         | 2,489,462.71      |
| Unnumbered Monument<br>Rhodes Point | 551.44 ✓                      | N71-52-02E           | 3112201 | 9503378 | 171. <sup>70</sup> <del>53</del> .07 | 524. <sup>20</sup> <del>70</del> .10 | 327,563.53         | 2,489,986.91      |
| P.I. near Bluff                     | <del>8663.16</del><br>8639.10 | N31-14-52E           | 8549320 | 5187401 | 7409.57<br><del>7406.41</del> 3.16   | 4494.84<br><del>4493.93</del>        | 334,973.10         | 2,494,481.75      |
| "Bluff" Mon. # 384                  | 163.44 ✓                      | N7-40-36W            | 9910377 | 1335826 | 162.05<br><del>161.78</del> .07      | 21.83                                | 335,135.15         | 2,494,459.92 ✓    |
| To Copola - U.S.N. Hospital         |                               | N41°52'39"W          |         |         |                                      |                                      | 335,128.73         | 2,494,456.25      |
|                                     |                               | Err. -00°06'10" Adj. |         |         |                                      |                                      | - 6.42             | - 3.67            |
| Mon. # 46                           |                               | N85°30'08"E          |         |         |                                      |                                      | 329,264.21         | 2,476,815.76      |
| R/F Range K-301                     | 147.78                        | S48-02-45E           | 6685359 | 7436798 | 98.80                                | 109.90                               | 329,165.41         | 2,476,925.66      |
|                                     |                               |                      |         |         |                                      |                                      |                    |                   |
$$26,342.29 = \sqrt{6.42^2 + 3.67^2} = \frac{1}{3565'}$$

$$\begin{array}{r}
 + 11,560.79 \\
 - 3,450.79 \\
 \hline
 + 8,110.00 \\
 + 20.57 \\
 \hline
 8,130.57
 \end{array}
 \quad
 \begin{array}{r}
 + 18,003.51 \\
 - 145.55 \\
 \hline
 + 17,857.96 \\
 + 12.48 \\
 \hline
 17,870.44
 \end{array}$$



PUBLIC WORKS DEPARTMENT  
Camp Lejeune, North Carolina  
Survey Department

*Rhodes Point Road "K" Ranges*  
*U.T.M. Positions of I.T.R. Ranges - Verona Loop*

File \_\_\_\_\_  
Quadrangle \_\_\_\_\_  
Date \_\_\_\_\_  
Sheet #1 of 3

Traverse Computation  
Description

| Station                   | Distance<br>Meters | Bearing    | Cosine                | Sine    | Latitude    | Departure   | Y Coordinate<br>North<br>Meters | X Coordinate<br>East<br>Meters |
|---------------------------|--------------------|------------|-----------------------|---------|-------------|-------------|---------------------------------|--------------------------------|
| U.S.M.C. Mon. # 47        |                    | N8°05'02"E | to U.S.M.C. Mon. # 46 |         |             |             | 3835,362.688                    | 278,583.484                    |
| U.S.M.C. Mon. # 46        | 693.940            | "          | 9900632               | 1406228 | 687.044,378 | 97.584,042  | 3,836,050.110                   | 278,681.110                    |
| ⊕ P.I.#1 L/F Range K-301  | 176.242            | N87-47-25E | 0385574               | 9992564 | 6.795,004   | 176.111,076 | 3,836,056.909                   | 278,857.297                    |
| P.I.#2                    | 248.199            | S88-54-27E | 0190666               | 9998182 | 4.732,003   | 248.154,107 | 3,836,052.180                   | 279,105.558                    |
| P.I.#3                    | 213.812            | S74-41-39E | 2639712               | 9645305 | 56.440,031  | 206.228,089 | 3,835,995.771                   | 279,311.875                    |
| * P.I.#4 R/F Range K-303  | 307.782            | S67-34-36E | 3814469               | 9243908 | 117.402,065 | 284.511,122 | 3,835,878.434                   | 279,596.508                    |
| * P.I.#5 L/F Range K-303  | 123.956            | N83-31-56E | 1126444               | 9936354 | 13.963,008  | 123.167,053 | 3,835,892.405                   | 279,719.728                    |
| * P.I.#6 R/F Range K-305  | 130.820            | N86-12-04E | 0662545               | 9978027 | 8.667,005   | 130.533,056 | 3,835,901.077                   | 279,850.317                    |
| * P.I.#7 L/F Range K-305  | 319.711            | N88-44-02E | 0220960               | 9997558 | 7.464,004   | 319.633,137 | 3,835,908.145                   | 280,170.087                    |
| P.I.#8                    | 145.506            | N12-44-00W | 9754065               | 2204137 | 142.005     | 32.072,014  | 3,836,050.150                   | 280,138.029                    |
| P.I.#9                    | 256.785            | N81-13-48E | 1524684               | 9883083 | 39.152,022  | 253.783,109 | 3,836,089.324                   | 280,391.921                    |
| ⊕ P.I.#10 R/F Range K-309 | 156.390            | S47-31-55E | 6751790               | 7376539 | 105.511,058 | 115.362,050 | 3,835,983.791                   | 280,507.333                    |
| * P.I.#11 R/F Range K-311 | 101.806            | S81-52-17E | 1413956               | 9899532 | 14.395,008  | 100.783,043 | 3,835,969.404                   | 280,608.159                    |
| * P.I.#12 L/F Range K-311 | 172.517            | S81-08-19E | 1540446               | 9880639 | 26.575,015  | 170.458,013 | 3,835,942.844                   | 280,778.690                    |

See sheet #3 for R/F

\* Position marked by Sgt. Borek, I.T.R. Range Office  
⊕ Concrete Marker



PUBLIC WORKS DEPARTMENT  
Camp Lejeune, North Carolina  
Survey Department

File \_\_\_\_\_  
Quadrangle \_\_\_\_\_  
Date \_\_\_\_\_  
Sheet #2 of 3

Traverse Computation  
Description

"K" Ranges - I.T.R. Area - Verona Loop

| Station                    | Distance<br>Meters | Bearing    | Cosine  | Sine    | Latitude                       | Departure                        | Y Coordinate<br>North | X Coordinate<br>East |
|----------------------------|--------------------|------------|---------|---------|--------------------------------|----------------------------------|-----------------------|----------------------|
| P.I. #12 L/F Range K-311   |                    |            |         |         |                                |                                  | 3,835,942.844         | 280,778.690          |
| * P.I. #13 R/F Range K-315 | 83.866             | S66-06-21E | 4050485 | 9142952 | <sup>951</sup><br>33.970 .019  | <sup>711</sup><br>76.778 .033    | 3,835,908.893         | 280,855.401          |
| * P.I. #14 L/F Range K-315 | 135.917            | S83-35-33E | 1115990 | 9937533 | <sup>160</sup><br>15.768 .008  | <sup>126</sup><br>135.668 .058   | 3,835,893.733         | 280,990.527          |
| * P.I. #15 R/F Range K-317 | 92.422             | S82-57-06E | 1229953 | 9924073 | <sup>335</sup><br>11.341 .006  | <sup>763</sup><br>91.724 .039    | 3,835,882.398         | 281,082.290          |
| * P.I. #16 L/F Range K-317 | 150.056            | S54-01-23E | 5874597 | 8092534 | <sup>103</sup><br>88.452 .049  | <sup>485</sup><br>121.433 .052   | 3,835,794.295         | 281,203.775          |
| * P.I. #17 R/F Range K-319 | 149.816            | N80-43-25E | 1611971 | 9869222 | <sup>163</sup><br>24.450 .013  | <sup>921</sup><br>147.857 .064   | 3,835,818.458         | 281,351.696          |
| * P.I. #18 L/F Range K-319 | 86.618             | N89-52-43E | 0021186 | 9999978 | 0.184                          | <sup>655</sup><br>86.618 .037    | 3,835,818.642         | 281,438.351          |
| P.I. #19                   | 212.970            | N31-44-41E | 8504007 | 5261356 | <sup>210</sup><br>181.110 .100 | <sup>099</sup><br>112.651 .048   | 3,835,999.852         | 281,550.450          |
| P.I. #20                   | 169.244            | S80-21-17E | 1675479 | 9858639 | <sup>340</sup><br>28.356 .016  | <sup>924</sup><br>166.852 .072   | 3,835,971.512         | 281,717.374          |
| * P.I. #21 R/F Range K-321 | 90.889             | S38-52-24E | 7785353 | 6276008 | <sup>721</sup><br>70.760 .039  | <sup>067</sup><br>57.842 .025    | 3,835,900.791         | 281,774.441          |
| * P.I. #22 L/F Range K-321 | 185.328            | S45-32-26E | 7004042 | 7137464 | <sup>733</sup><br>129.805 .072 | <sup>334</sup><br>132.277 .057   | 3,835,771.058         | 281,906.775          |
| P.I. #23                   | 103.181            | S39-06-23E | 7759761 | 6307623 | <sup>022</sup><br>80.066 .044  | <sup>111</sup><br>65.883 .028    | 3,835,691.036         | 281,971.886          |
| * P.I. #24 R/F Range K-325 | 280.356            | S60-06-40E | 4983196 | 8669934 | <sup>630</sup><br>139.707 .077 | <sup>171</sup><br>243.867 .104   | 3,835,551.406         | 282,215.057          |
| * P.I. #25 L/F Range K-325 | 160.996            | S34-25-03E | 8249409 | 5652190 | <sup>739</sup><br>132.812 .073 | <sup>91.037</sup><br>90.998 .039 | 3,835,418.667         | 282,306.094          |



PUBLIC WORKS DEPARTMENT  
Camp Lejeune, North Carolina  
Survey Department

File \_\_\_\_\_  
Quadrangle \_\_\_\_\_  
Date \_\_\_\_\_  
Sheet # 3 of 3

Traverse Computation  
Description

"K" Ranges - I.T.R. Area - Verona Loop

| Station                             | Distance<br>Meters | Bearing               | Cosine      | Sine    | Latitude                              | Departure                           | Y Coordinate<br>North | X Coordinate<br>East |
|-------------------------------------|--------------------|-----------------------|-------------|---------|---------------------------------------|-------------------------------------|-----------------------|----------------------|
| P.I. # 25 L/F Range K-325           |                    |                       |             |         |                                       |                                     | 3,835,418.667         | 282,306.094          |
| P.I. # 26                           | 224.836            | S65-41-45E            | 4115806     | 9113733 | <sup>.487</sup><br>92.538 .051        | <sup>.998</sup><br>204.910 .088     | 3,835,326.780         | 282,511.092          |
| Unnumbered Monument<br>Rhodes Point | 168.095            | N74-09-23E            | 2730126     | 9620105 | <sup>.917</sup><br>45.892 .025        | <sup>.778</sup><br>161.769 .069     | 3,835,372.097         | 282,672.870          |
| P.I. near "Bluff"                   | 2640.537           | N33-32-13E            | 8335298     | 5524746 | <sup>.2202177</sup><br>2200.966 1.291 | <sup>1459.457</sup><br>1458.830.627 | 3,837,574.274         | 284,132.327          |
| "Bluff" U.S.M.C. Mon. # 384         | 49.817             | N5-23-15 W            | 9955825     | 0938911 | <sup>.624</sup><br>49.597 .027        | <sup>675</sup><br>4.477 .002        | 3,837,623.898         | 284,127.652          |
| To Cupola - U.S.N. Hospital         |                    | N39°35'17" W          |             |         |                                       |                                     | - 2.509               | - 2.413              |
|                                     |                    | Err. - 00°06'05" Adj. |             |         |                                       |                                     |                       |                      |
| Mon. # 46                           |                    | N87°47'25" E          | To P.I. # 1 |         | Mon. # 735<br>L/F # K-301             |                                     | 3,836,050.110         | 278,681.110          |
| * R/F Range K-301                   | 45.043             | S45-45-28 E           | 6976932     | 7163967 | 31.426                                | 32.269                              | 3,836,018.684         | 278,713.379          |
| Bearing to L/F of Range K-301       |                    | N75°07'02" E          |             |         |                                       |                                     |                       |                      |

+ 3406.511 + 5578.504  
- 1147.810 - 36.744  
+ 2258.701 + 5541.755

