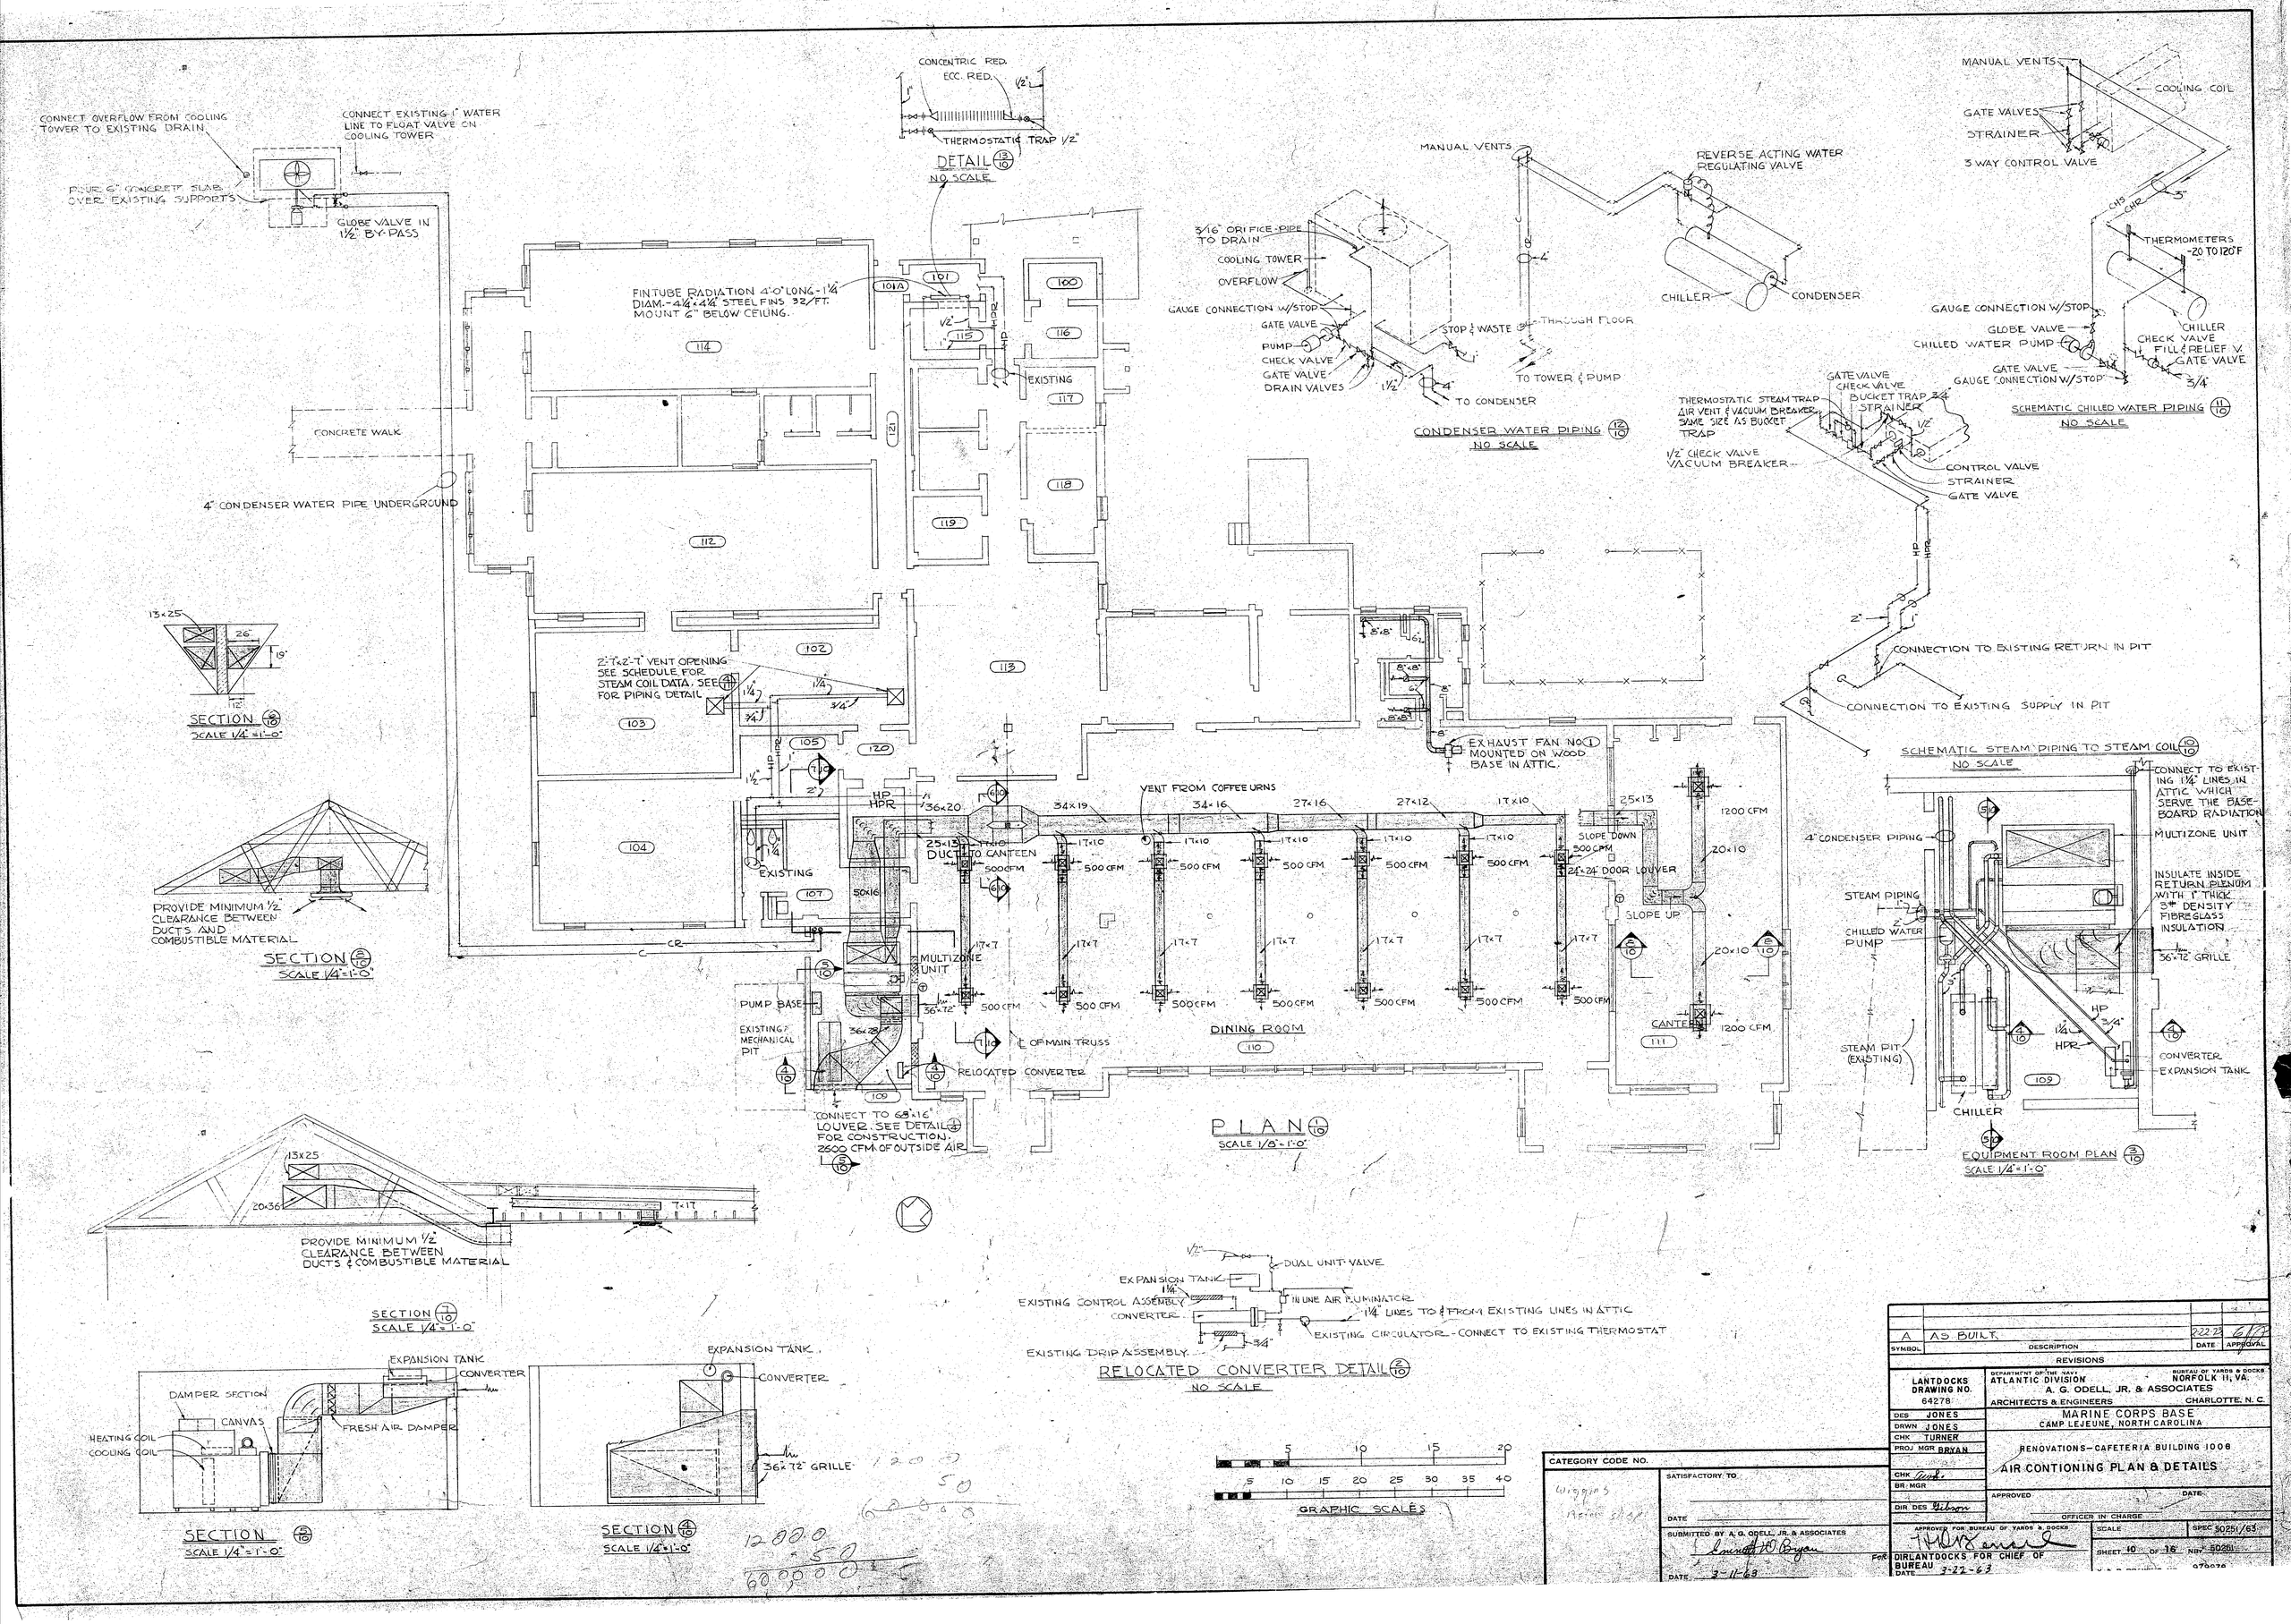

SYMBOL	DESCRIPTION	DATE	APPROVAL
A	AS BUILT	2-22-73	

REVISIONS

LANTDOCKS DRAWING NO. 64278

DEPARTMENT OF THE NAVY — ATLANTIC DIVISION — A. G. ODELL, JR. & ASSOCIATES — ARCHITECTS & ENGINEERS
BUREAU OF YARDS & DOCKS — NORFOLK 11, VA. — CHARLOTTE, N. C.

DES JONES
DRWN JONES
CHK TURNER
PROJ MGR BRYAN
CHK
BR. MGR
DIR DES Gibson

MARINE CORPS BASE
CAMP LEJEUNE, NORTH CAROLINA

RENOVATIONS—CAFETERIA BUILDING 1008

AIR CONTIONING PLAN & DETAILS

APPROVED — DATE — OFFICER IN CHARGE

APPROVED FOR BUREAU OF YARDS & DOCKS — DIRLANTDOCKS FOR CHIEF OF BUREAU — DATE 3-22-63

SCALE — SPEC 50251/63

SHEET 10 OF 16 — NBY 50261

CATEGORY CODE NO.

Wiggins Reinf Slab

SATISFACTORY TO — DATE

SUBMITTED BY A. G. ODELL, JR. & ASSOCIATES — DATE 3-11-63

1006 H.C.
Earthquake Studies