


TELEPHONE POLE

STONE ST

STONE ST

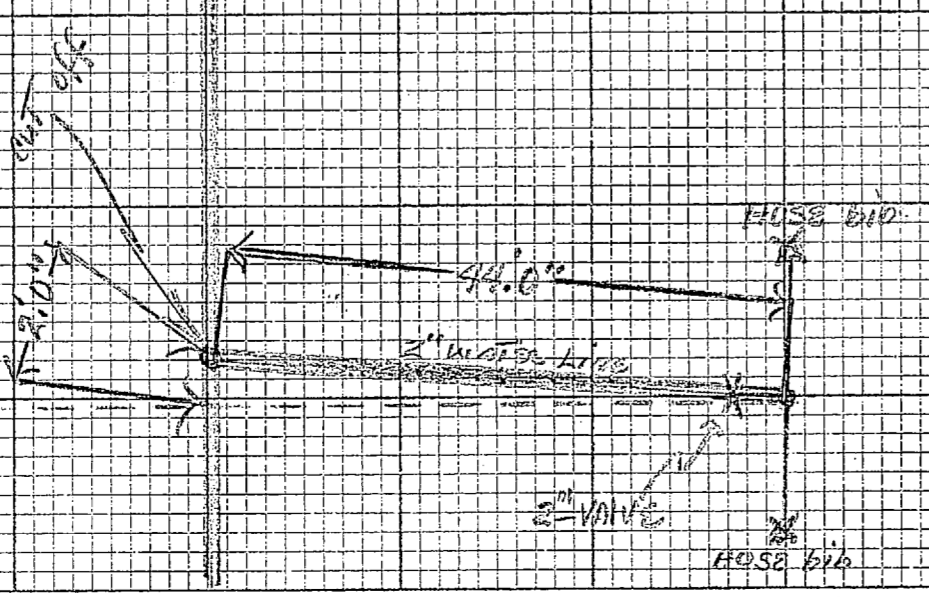


TELEPHONE POLE

TELEPHONE POLE

80'-0"

12'-0" OK

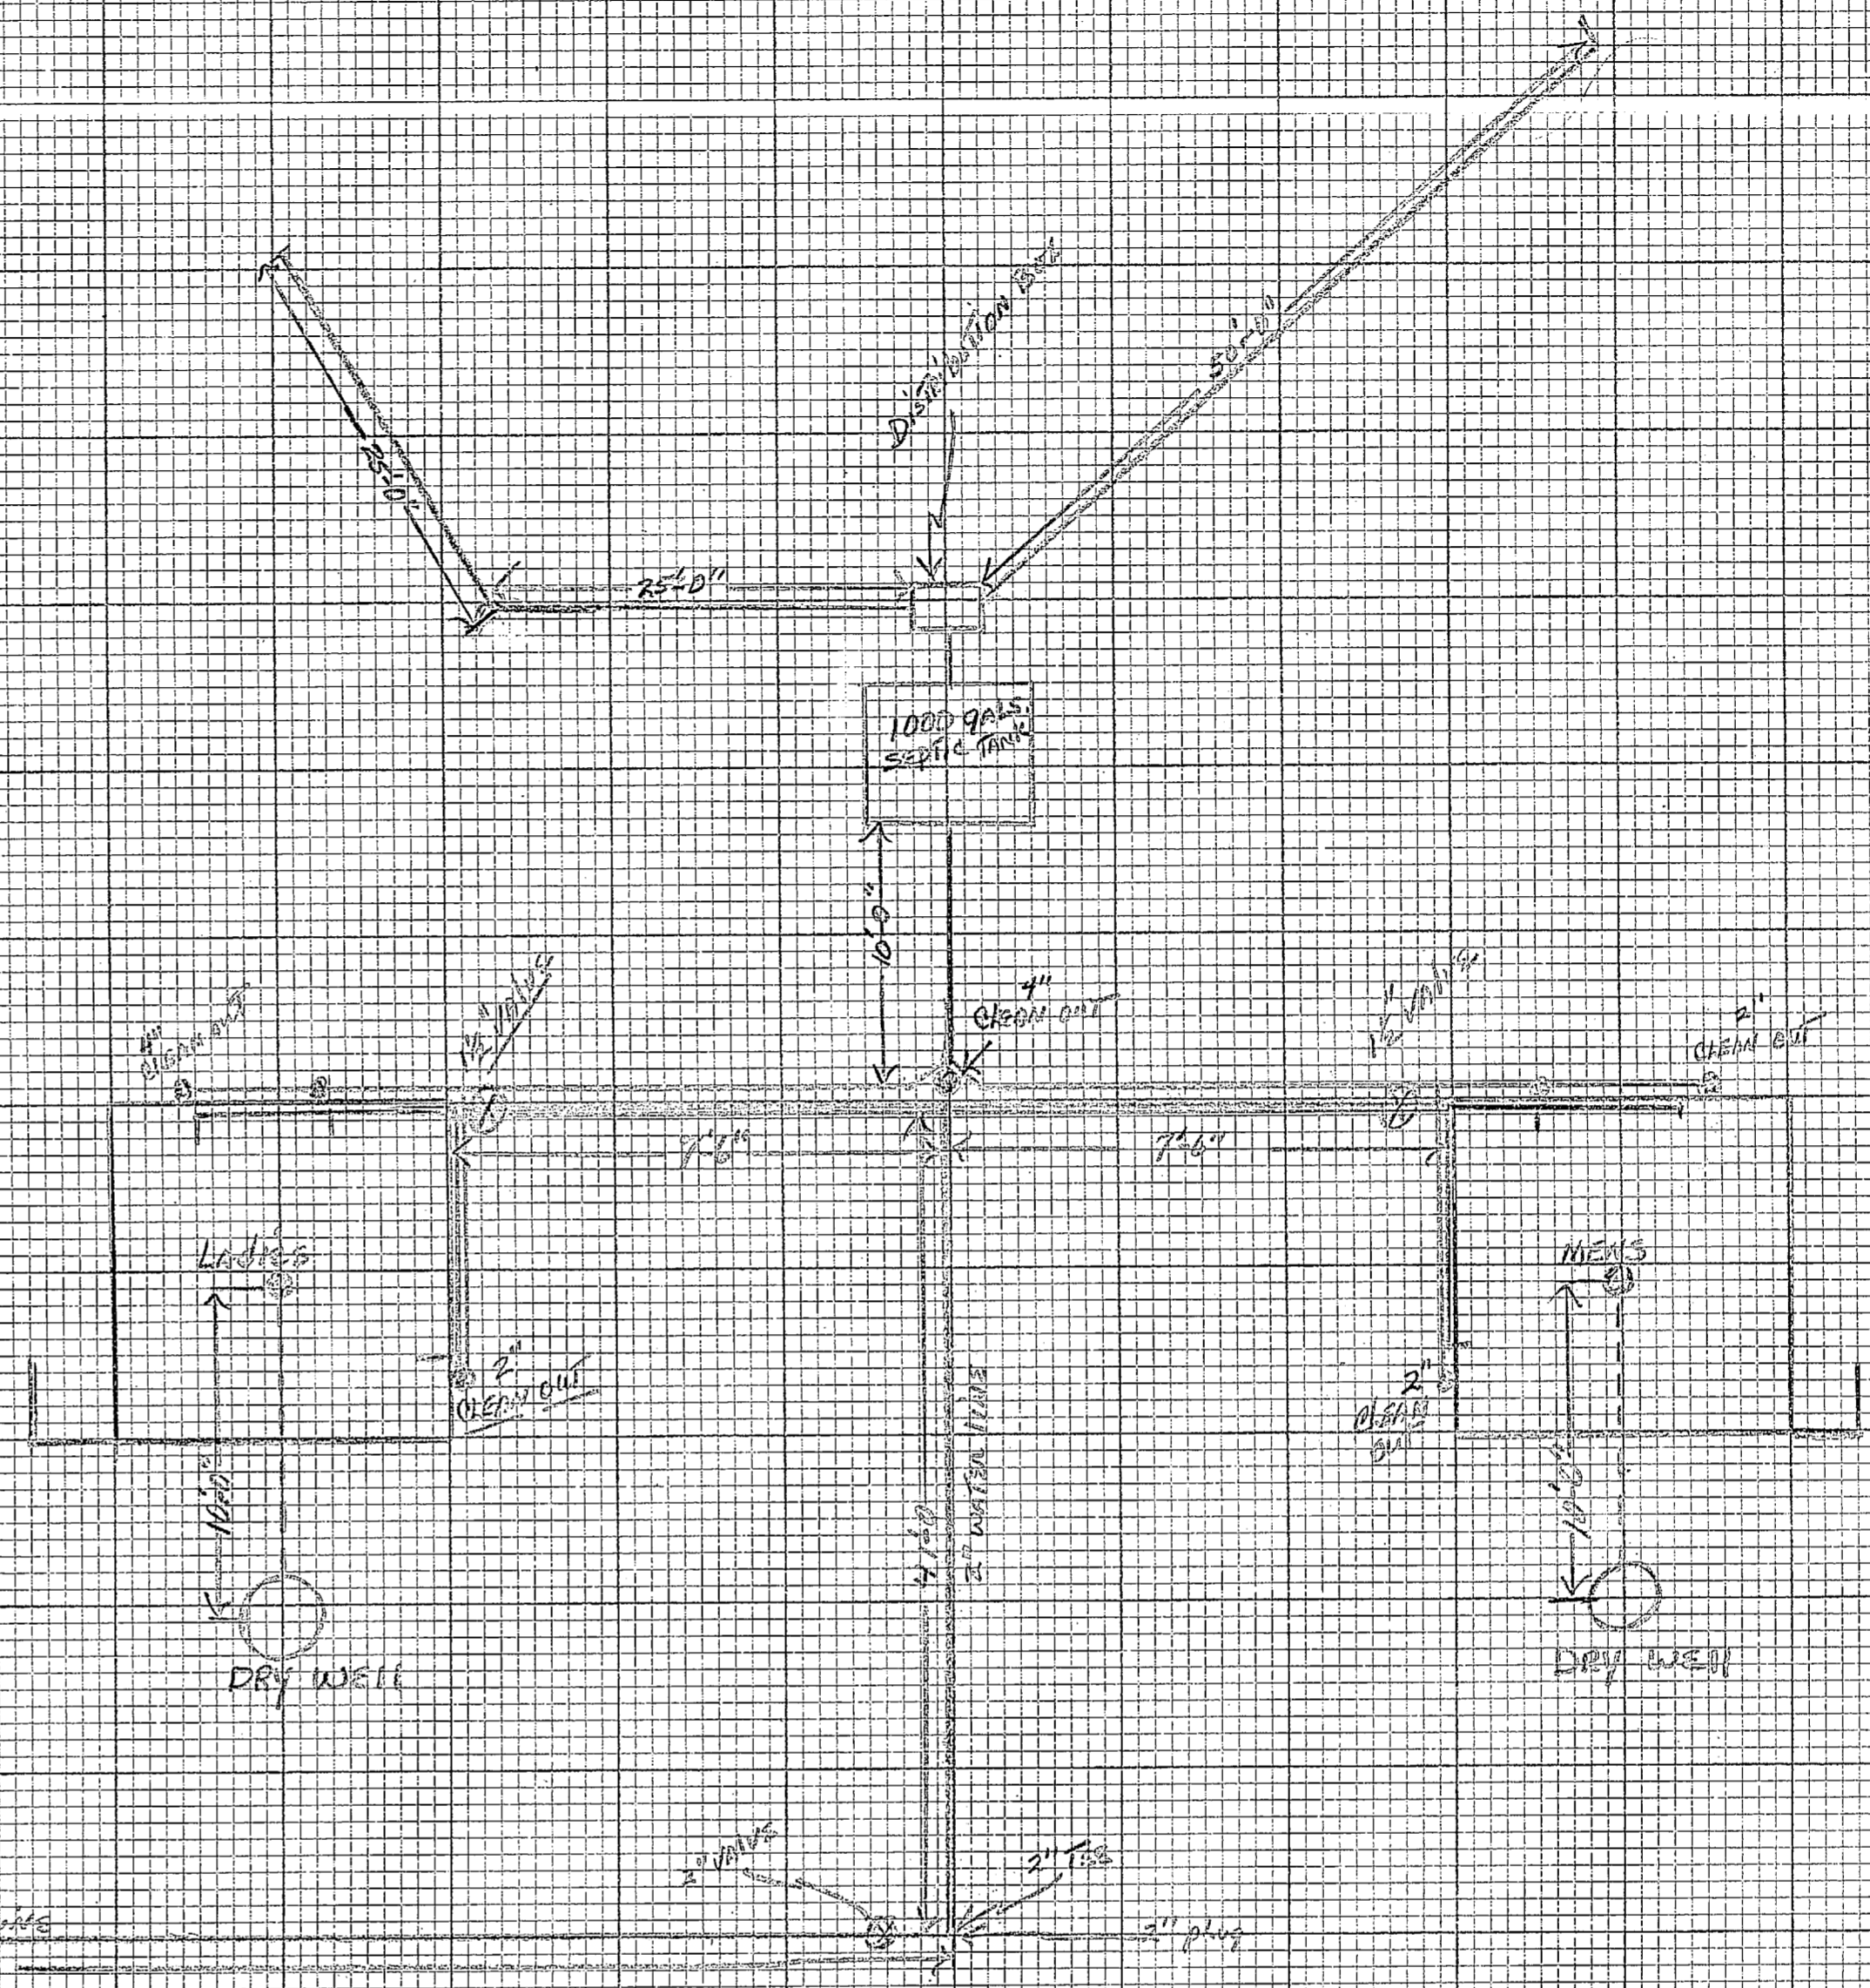

STONE STREET SCHOOL
LITTLE LEAGUE BATH PARK

PLUMBING & WATER SERVICE CONNECTIONS AND UTILITIES

BY SGT. J. S. DAVID

