



REVISION	DATE	APPD.	DESCRIPTION	BY
P.W. DRAWING NO.		DESCRIPTION		
4516		MARINE BARRACKS CAMP LEJEUNE, N. C.		
DES	DRWN		WATER SUPPLY SYSTEM - RECORD MAP	
TR	CHK		MAIN GATE	
SUPV	APPROVED		DATE	
IN CHARGE		PUBLIC WORKS OFFICER		
APPROVED		SCALE	IN.	ZDDP.T.
THE QUARTERMASTER GENERAL OF THE MARINE CORPS		SHEET 12 OF 12		NOY
DATE		Y & D DRAWING NO.		

 



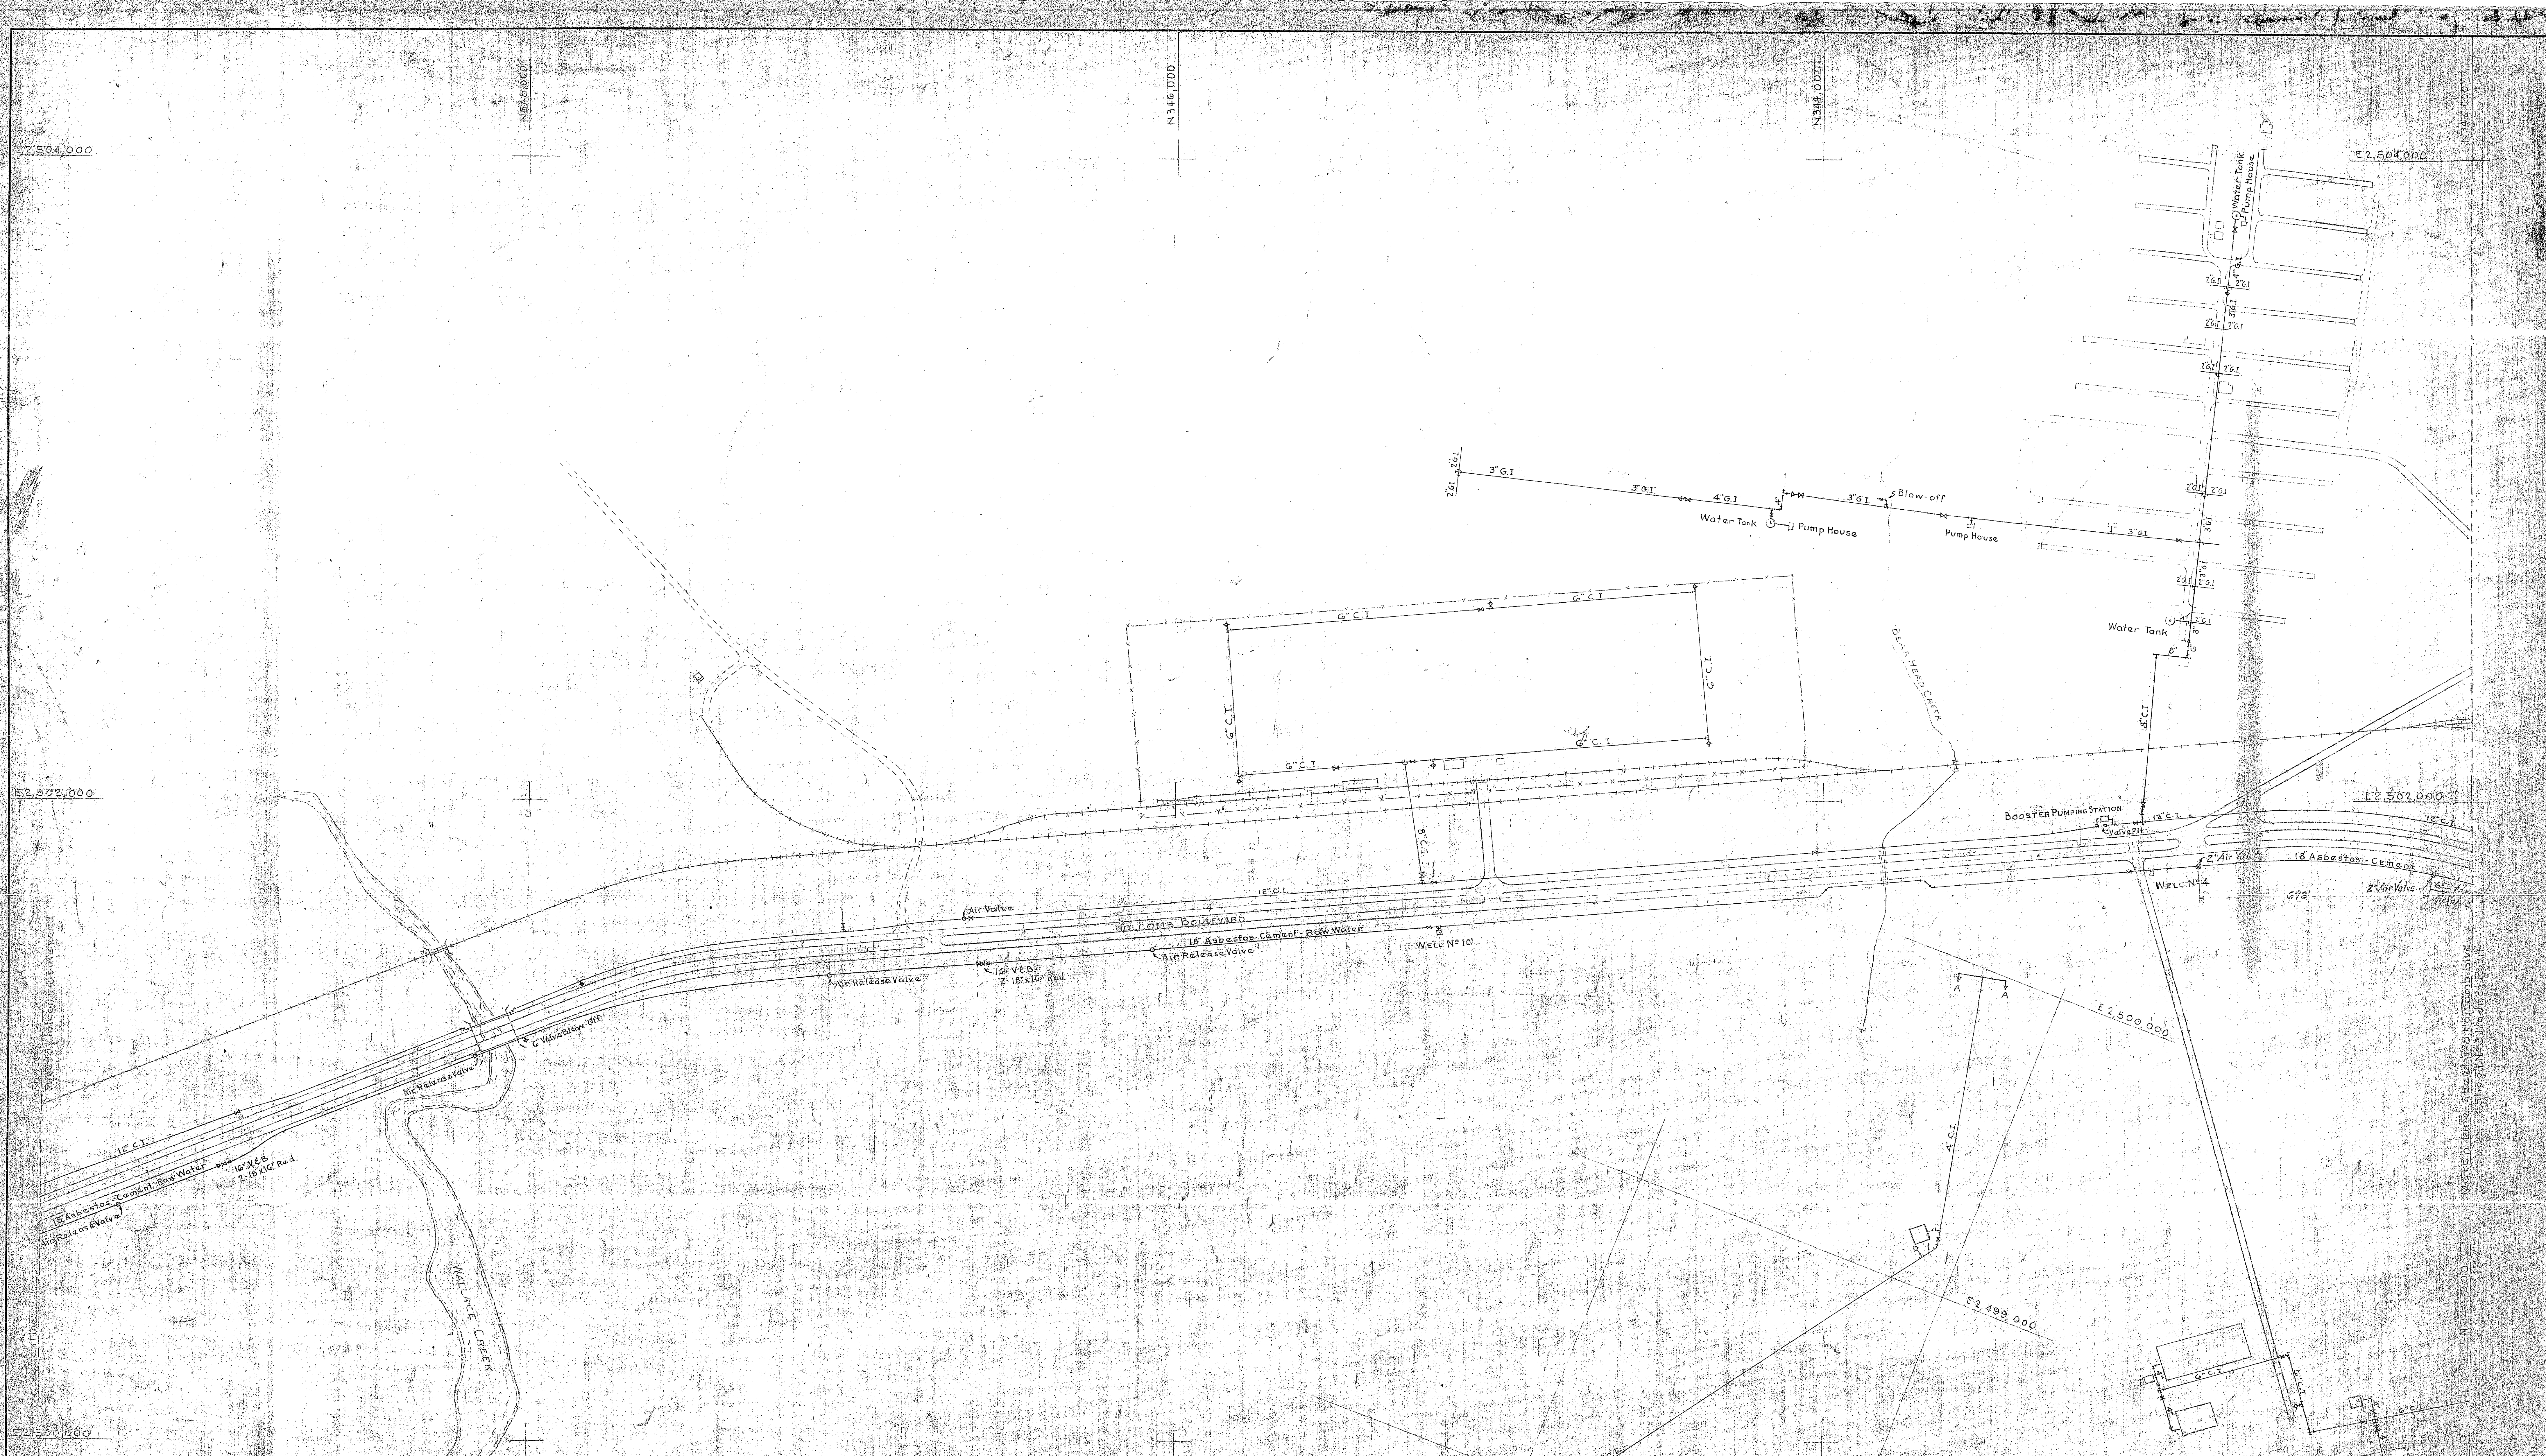

REVISION DATE	APPR.	DESCRIPTION	BY
P.W. DRAWING NO.		<b>MARINE BARRACKS</b>	
<b>4512</b>		CAMP LEJEUNE, N. C.	
DES.		WATER SUPPLY SYSTEM-RECORD MAP	
DRWN.		HOLCOMB BLVD.	
TR.			
CHK.			
SUPV.			
IN CHARGE			
APPROVED		DATE	
PUBLIC WORKS OFFICER			
APPROVED		SCALE 1" = 200'	
THE QUARTERMASTER GENERAL OF THE MARINE CORPS		SHEET 8 OF 12	
DATE		NOY	
		Y.D. DRAWING NO.	



