


1. Water Extension to 3<sup>rd</sup> Parachute Tower.
2. Plotted conns. to Power House, Servants Quarters, Family Hospital.
3. Plotted conns. to B.O. Q (Hospital Area) and Boat House Toilet Bldg.
4. ~~#~~ Conn. to Tent Camp Incinerator.

 

Elevations on Water Mains Plotted  
by  
g.f.t.

1. Hospital.
2. Line to 300,000 gal water tank near "C" St  
on Main Service Road.
3. K St. + Service Rd. to M St. + Service Rd.
4. L St. + M. St.
5. K St. + River Rd along River Rd, N St.,  
Service Rd. to M St. + Service Rd.
6. M St - River Rd to L St.
7. Lateral between M & N St.
- ~~8. 4" Lines to S.D. # 517, 519~~
8. Water Main to Div. Hdqtrs.
9. Post Lane - Post Troops Area.
- 10.

check these  
streets for changes in  
water line profiles

1032

1. Equipment Sheds in Balloon Motor  
Storage Yard - Ind. + Supply Area.  
50' x 500'.
2. Plotted wells # 17-21 on 500'  
maps.
3. Checking plotting of bent basin,  
glider bldgs. with stakeouts.

AMERMIT

BOND

MADE IN U.S.A.