

VALUABLE

SUBJECT Stadia Survey - Golf  
Cour 39  
North Side of Brewster Blvd.

Return To  
 Public Works  
 Office  
 Camp Lejeune  
 North Carolina

FIELD PARTY  
Hamm In Charge  
Deavis Instrument  
 \_\_\_\_\_ Notes  
 \_\_\_\_\_ Tape Read  
McLean Tape or Rod  
Padwick Tape or Rod  
 \_\_\_\_\_ Instrument No.  
 \_\_\_\_\_ Tape No.

WEATHER  
 Clear \_\_\_\_\_  
 Cloudy \_\_\_\_\_  
 Windy \_\_\_\_\_  
 Rain \_\_\_\_\_  
 Fair \_\_\_\_\_  
 Snow \_\_\_\_\_  
 Hot \_\_\_\_\_  
 Moderate \_\_\_\_\_  
 Cold \_\_\_\_\_  
 Fog \_\_\_\_\_  
 Figured By \_\_\_\_\_  
 Notes Checked By \_\_\_\_\_  
 Plotted By \_\_\_\_\_

FILE No. 11960  
 Fldr. No. \_\_\_\_\_  
 Sheet 1 of  
 Date 6-5 19 50

Quad. No. \_\_\_\_\_

Station	Dist.	Angle	"	+	H. I. Bearing	Ver: Ang. Diff.	Elevation
---------	-------	-------	---	---	------------------	--------------------	-----------

103 11 30  
 42 136 30  
 43 234 00  
 91 226 45

64 231 20

70 190 55  
 91 185 30  
 98 175 10  
 100 151 10  
 92 132 25  
 57 125 50  
 42 171 30

} putting green

1 cor tee #1  
 cor tee #1  
 cor. tee #1  
 Center putting green 35' Radius  
 Water Outlet

PI #3  
 684 160 05 45

△ PI #3

PI #2  
 654 163 28 15

△ PI #2

PI #1  
 665 70 55 15

△ PI #1

387 E Rd  
 Mon #71

△ Mon N354,424.06  
 #71 E2,485,786.10

BS

△ N353,570.83 E2,484,706.17  
 Water Tank

N51°21'47"E









































**VALUABLE**

SUBJECT \_\_\_\_\_  
 \_\_\_\_\_  
 Return To  
 Public Works  
 Office  
 Camp Lejeune  
 North Carolina

**FIELD PARTY**

\_\_\_\_\_ In Charge  
 \_\_\_\_\_ Instrument  
 \_\_\_\_\_ Notes  
 \_\_\_\_\_ Tape Read  
 \_\_\_\_\_ Tape or Rod  
 \_\_\_\_\_ Tape or Rod  
 \_\_\_\_\_ Instrument No.  
 \_\_\_\_\_ Tape No.

**WEATHER**

Clear  
 Cloudy  
 Windy  
 Rain  
 Fair

Snow  
 Hot  
 Moderate  
 Cold  
 Fog

FILE No. \_\_\_\_\_  
 Fldr. No. \_\_\_\_\_  
 Sheet. 207  
 Date \_\_\_\_\_ 19\_\_

Figured By \_\_\_\_\_  
 Notes Checked By \_\_\_\_\_  
 Plotted By \_\_\_\_\_  
 Quad. No. \_\_\_\_\_

Station	Dist.	Angle	"	+	H. I. Bearing	Ver: Ang. Diff.	Elevation	
	153	355	20					10 Cherry
	430	330	11					3" oak
	340	10	18					4" oak
	273	323	50					12" oak
	310	01	30					2' Ditch Edge fair way
	261	326	50					2" Ditch Edge fair way
	253	06	00					4" oak
	217	328	20					2" oak
	217	06	40					3" oak
	190	11	20					4" oak
	94	264	10					Drinking fountain
	97	267	40					Water Outlet
	70	295	50					4" oak
	60	48	40					1" oak
	58	258	10					4" oak
	40	94	00					4" oak
	76	64	00					{ 15" CMP
	83	51	00					
	154	55	00					Center putting green 40' Radius
Cor "C"	238	107	38					{ Club House
Cor "B"	155	80	17					
Cor "A"	202	60	07					
PI # 3	106	399	40					
PI # 3								PI # 3
PI # 2								PI # 2




































VALUABLE

SUBJECT \_\_\_\_\_

Return To  
Public Works  
Office  
Camp Lejeune  
North Carolina

## FIELD PARTY

 \_\_\_\_\_ In Charge  
 \_\_\_\_\_ Instrument  
 \_\_\_\_\_ Notes  
 \_\_\_\_\_ Tape Read  
 \_\_\_\_\_ Tape or Rod  
 \_\_\_\_\_ Tape or Rod  
 \_\_\_\_\_ Instrument No. \_\_\_\_\_  
 \_\_\_\_\_ Tape No. \_\_\_\_\_

## WEATHER

 Clear \_\_\_\_\_  
 Cloudy \_\_\_\_\_  
 Windy \_\_\_\_\_  
 Rain \_\_\_\_\_  
 Fair \_\_\_\_\_  
 Snow \_\_\_\_\_  
 Hot \_\_\_\_\_  
 Moderate \_\_\_\_\_  
 Cold \_\_\_\_\_  
 Fog \_\_\_\_\_

FILE No. \_\_\_\_\_

Fldr. No. \_\_\_\_\_

Sheet 301

Date \_\_\_\_\_ 19\_\_

Quad. No. \_\_\_\_\_

Station	Dist.	Angle	"	+	H. I. Bearing	Ver: Ang. Diff.	Elevation
---------	-------	-------	---	---	------------------	--------------------	-----------

96 52 30

110 41 00

105 28 00

84 18 50

73 32 10

493 261 18 15

325 168 00

328 210 00

209 149 00

204 159 40

136 147 40

300 217 20

121 124 40

260 221 40

78 96 50

229 235 40

98 69 10

147 258 20

150 21 40

132 12 20

123 27 40

143 33 40

584 343 50 45

} sand trap

4 PI # 5

3" oak

Edge fair way

3" oak

3" oak

4" oak

3" oak

3" oak

3" oak

Edge fair way

3" oak

3" oak

3" oak

} sand trap

4 PI # 4

4 PI # 3

4 PI # 2

PI # 5

PI # 4

PI # 3

B5















VALUABLE

SUBJECT \_\_\_\_\_

Return To \_\_\_\_\_  
 Public Works \_\_\_\_\_  
 Office \_\_\_\_\_  
 Camp Lejeune \_\_\_\_\_  
 North Carolina \_\_\_\_\_

FIELD PARTY

\_\_\_\_\_ In Charge  
 \_\_\_\_\_ Instrument  
 \_\_\_\_\_ Notes  
 \_\_\_\_\_ Tape Read  
 \_\_\_\_\_ Tape or Rod  
 \_\_\_\_\_ Tape or Rod  
 \_\_\_\_\_ Instrument No.  
 \_\_\_\_\_ Tape No.

WEATHER

Clear \_\_\_\_\_  
 Cloudy \_\_\_\_\_  
 Windy \_\_\_\_\_  
 Rain \_\_\_\_\_  
 Fair \_\_\_\_\_  
 Snow \_\_\_\_\_  
 Hot \_\_\_\_\_  
 Moderate \_\_\_\_\_  
 Cold \_\_\_\_\_  
 Fog \_\_\_\_\_

FILE No. \_\_\_\_\_

Fldr. No. \_\_\_\_\_

Figured By \_\_\_\_\_ Sheet 74

Notes Checked By \_\_\_\_\_

Plotted By \_\_\_\_\_ Date \_\_\_\_\_ 19 \_\_\_\_\_

Quad. No. \_\_\_\_\_

Station	Dist.	Angle "	+	H. I. Bearing	Ver: Ang. Diff.	Elevation
---------	-------	---------	---	---------------	-----------------	-----------

132 142 50

134 149 20

159 151 50

177 152 00

184 149 20

183 146 40

166 142 20

145 138 00

*Sand trap*

149 130 40

166 140 00

199 144 00

223 137 20

205 128 50

174 123 20

*#1 green*

183 121 20

200 126 00

220 129 10

229 124 40

210 121 30

201 118 10

187 118 20

244 108 20

214 83 50

*Sand trap*

*4" Oak  
3" Oak*

*PT #5*

*B3*













VALUABLE

SUBJECT \_\_\_\_\_

Return To  
Public Works  
Office  
Camp Lejeune  
North Carolina

## FIELD PARTY

 \_\_\_\_\_ In Charge  
 \_\_\_\_\_ Instrument  
 \_\_\_\_\_ Notes  
 \_\_\_\_\_ Tape Read  
 \_\_\_\_\_ Tape or Rod  
 \_\_\_\_\_ Instrument No.  
 \_\_\_\_\_ Tape No.

## WEATHER

 Clear \_\_\_\_\_  
 Cloudy \_\_\_\_\_  
 Windy \_\_\_\_\_  
 Rain \_\_\_\_\_  
 Fair \_\_\_\_\_  
 Snow \_\_\_\_\_  
 Hot \_\_\_\_\_  
 Moderate \_\_\_\_\_  
 Cold \_\_\_\_\_  
 Fog \_\_\_\_\_

FILE No. \_\_\_\_\_

Fldr. No. \_\_\_\_\_

Figured By \_\_\_\_\_ Sheet 5

Notes Checked By \_\_\_\_\_

Plotted By \_\_\_\_\_ Date \_\_\_\_\_ 19\_\_

Quad. No. \_\_\_\_\_

Station	Dist.	Angle " "	+	H. I. Bearing	Ver: Ang. Diff.	Elevation
468	283	10				
491	201	00				
468	198	00				
448	200	20				
440	202	60				
442	203	40				
345	216	40				
336	214	20				
460	193	20				
316	210	40				
267	289	10				
400	181	40				
220	282	30				
142	182	50				
349	155	10				
224	164	10				
242	176	20				
284	173	10				
265	161	00				
274	150	40				
312	146	40				
325	138	40				
267	134	50				
253	144	00				

Sand trap

 2" Maple  
 ditch } No hazard  
 ditch }  
 3" oak Edge fair way  
 3" oak  
 Woods Line  
 3" oak  
 4" shade tree

Woods Line

Edge fair way

#2 short tree

Water outlet

#2 Long tree

PI #5

PI #5

B5

PI #7









VALUABLE

SUBJECT \_\_\_\_\_  
 \_\_\_\_\_  
 \_\_\_\_\_  
 \_\_\_\_\_  
 \_\_\_\_\_

Return To  
 Public Works  
 Office  
 Camp Lejeune  
 North Carolina

FIELD PARTY

\_\_\_\_\_ In Charge  
 \_\_\_\_\_ Instrument  
 \_\_\_\_\_ Notes  
 \_\_\_\_\_ Tape Read  
 \_\_\_\_\_ Tape or Rod  
 \_\_\_\_\_ Instrument No.  
 \_\_\_\_\_ Tape No.

WEATHER

Clear  
 Cloudy  
 Windy  
 Rain  
 Fair

Snow  
 Hot  
 Moderate  
 Cold  
 Fog

FILE No. \_\_\_\_\_

Fldr. No. \_\_\_\_\_

Notes Checked By \_\_\_\_\_ Sheet 609

Plotted By \_\_\_\_\_ Date \_\_\_\_\_ 19\_\_

Quad. No. \_\_\_\_\_

Station	Dist.	Angle "	+	H. I. Bearing	Ver: Ang. Diff.	Elevation
---------	-------	---------	---	---------------	-----------------	-----------

81 226 50

90 337 23

228 301 03

66 325 00

62 349 50

104 05 20

137 02 50

194 354 20

113 337 23

92 323 00

104 319 10

115 332 00

137 345 10

141 344 20

169 339 20

148 327 40

117 316 20

60 20 00

83 19 20

109 17 00

119 13 10

107 08 00

72 01 00

51 09 10

638 205 22 00

Tel Pole  
 PP + Tel pole  
 PP + Tel pole

#2 ground

sand trap

sand trap

PI#6

PI#5

B3

B PI#6

A PI#5

A PI#4






























**VALUABLE**

SUBJECT \_\_\_\_\_

Return To \_\_\_\_\_  
 Public Works Office \_\_\_\_\_  
 Camp Lejeune \_\_\_\_\_  
 North Carolina \_\_\_\_\_

**FIELD PARTY**

\_\_\_\_\_ In Charge  
 \_\_\_\_\_ Instrument  
 \_\_\_\_\_ Notes  
 \_\_\_\_\_ Tape Read  
 \_\_\_\_\_ Tape or Rod  
 \_\_\_\_\_ Tape or Rod  
 \_\_\_\_\_ Instrument No.  
 \_\_\_\_\_ Tape No.

**WEATHER**

Clear  
 Cloudy  
 Windy  
 Rain  
 Fair

Snow  
 Hot  
 Moderate  
 Cold  
 Fog

FILE No. \_\_\_\_\_

Fldr. No. \_\_\_\_\_

Figured By \_\_\_\_\_ Sheet 7

Notes Checked By \_\_\_\_\_

Plotted By \_\_\_\_\_ Date \_\_\_\_\_ 19\_\_

Quad. No. \_\_\_\_\_

Station	Dist.	Angle "	+	H. I. Bearing	Ver: Ang. Diff.	Elevation
---------	-------	---------	---	---------------	-----------------	-----------

159 196 40

198 188 50

123 186 40

122 209 30

159 206 20

128 60 00

61 327 40

215 23 40

200 352 40

} Sand trap

Woods Line - Edge Soil way  
 " " " " " "  
 Woods Line - Edge Soil way  
 Woods Line - Edge Soil way

341 04 10

340 355 00

414 02 15

420 355 00

430 357 15

} #3 tree

Water outlet

PI #7

640 121 09 40

80 147 02

75 138 58

87 136 23

} Rest / Shed

S-1936 Destroyed

42 71 40

58 276 50

Woods Line  
 Water Outlet

84 72 43

93 100 40

104 190 40

Tel Pole  
 PP - (Pine tree)  
 PP - Tel Pole

PI #6

4 PI #6

PI #5

B3 4 PI #5
















**VALUABLE**

SUBJECT \_\_\_\_\_

Return To \_\_\_\_\_  
 Public Works Office \_\_\_\_\_  
 Camp Lejeune \_\_\_\_\_  
 North Carolina \_\_\_\_\_

**FIELD PARTY**

\_\_\_\_\_ In Charge  
 \_\_\_\_\_ Instrument  
 \_\_\_\_\_ Notes  
 \_\_\_\_\_ Tape Read  
 \_\_\_\_\_ Tape or Rod  
 \_\_\_\_\_ Tape or Rod  
 \_\_\_\_\_ Instrument No.  
 \_\_\_\_\_ Tape No.

**WEATHER**

Clear \_\_\_\_\_  
 Cloudy \_\_\_\_\_  
 Windy \_\_\_\_\_  
 Rain \_\_\_\_\_  
 Fair \_\_\_\_\_  
 Snow \_\_\_\_\_  
 Hot \_\_\_\_\_  
 Moderate \_\_\_\_\_  
 Cold \_\_\_\_\_  
 Fog \_\_\_\_\_

FILE No. \_\_\_\_\_

Fldr. No. \_\_\_\_\_

Figured By \_\_\_\_\_ Sheet 8

Notes Checked By \_\_\_\_\_

Plotted By \_\_\_\_\_ Date \_\_\_\_\_ 19\_\_

Quad. No. \_\_\_\_\_

Station	Dist.	Angle "	+	H. I. Bearing	Ver: Ang. Diff.	Elevation
---------	-------	---------	---	---------------	-----------------	-----------

352 204 40

346 202 30

322 201 50

324 204 40

325 207 30

405 176 40

218 213 40

} Sand trap

Edge fair way - Woods Line  
 Edge fair way

146 224 40

169 213 40

147 206 00

135 208 40

126 214 40

} Sand trap

93 104 20

121 112 50

136 106 00

135 97 20

99 90 20

} Sand trap ✓

PJ#8

630 212 13 30

505 215 00

550 195

498 215 50

217 207 40

370 169 00

2' ditch  
 2' ditch  
 Edge fair way - Woods Line  
 Edge fair way  
 Woods Line - Fair way

PJ#7

A PJ#7

B3

A PJ#6


































VALUABLE

SUBJECT \_\_\_\_\_

Return To  
Public Works  
Office  
Camp Lejeune  
North Carolina

## FIELD PARTY

 \_\_\_\_\_ In Charge  
 \_\_\_\_\_ Instrument  
 \_\_\_\_\_ Notes  
 \_\_\_\_\_ Tape Read  
 \_\_\_\_\_ Tape or Rod  
 \_\_\_\_\_ Tape or Rod  
 \_\_\_\_\_ Instrument No.  
 \_\_\_\_\_ Tape No.

## WEATHER

 Clear  
 Cloudy  
 Windy  
 Rain  
 Fair

 Snow  
 Hot  
 Moderate  
 Cold  
 Fog

FILE No. \_\_\_\_\_

Fldr. No. \_\_\_\_\_

Sheet 94

Date \_\_\_\_\_ 19\_\_

Quad. No. \_\_\_\_\_

Station	Dist.	Angle " "	+	H. I. Bearing	Ver: Ang. Diff.	Elevation
---------	-------	--------------	---	------------------	--------------------	-----------

420 207 00

365 212 40

325 209 00

447 201 50

440 202 50

400 203 40

438 200 20

410 202 20

448 187 30

414 186 00

418 184 10

396 183 10

396 186 10

364 182 10

355 182 40

340 182 10

337 186 40

325 194 20

330 189 40

365 187 50

400 189 10

408 193 10

380 196 10

337 196 40

} Sand trap

} Sand trap

} #3 green

Edge fair way  
Edge fair way  
Edge fair way

12" Pine

12" Pine

12" Pine

Water outlet

12" Pine

24" Pine

PI# 8

B3

4 PI# 8

4 PI# 7



AVAILABLE

Return To  
Public Works  
Office  
North Carolina

SUBJECT

\_\_\_\_\_

\_\_\_\_\_

\_\_\_\_\_

FIELD PARTY

In Charge \_\_\_\_\_

Instrument \_\_\_\_\_

Notes \_\_\_\_\_

Base Road \_\_\_\_\_

Top of Rod \_\_\_\_\_

Top of Rod \_\_\_\_\_

Station No. \_\_\_\_\_

Tape No. \_\_\_\_\_

WEATHER

Clear \_\_\_\_\_

Snow \_\_\_\_\_

Hot \_\_\_\_\_

Cloudy \_\_\_\_\_

Moderate \_\_\_\_\_

Cold \_\_\_\_\_

Rain \_\_\_\_\_

Fog \_\_\_\_\_

Figured By \_\_\_\_\_

Notes Checked By \_\_\_\_\_

Checked By \_\_\_\_\_

FILE No.

\_\_\_\_\_

\_\_\_\_\_

\_\_\_\_\_

\_\_\_\_\_

\_\_\_\_\_

\_\_\_\_\_


\_\_\_\_\_

Station \_\_\_\_\_ Dist. \_\_\_\_\_ Angle \_\_\_\_\_

By \_\_\_\_\_ Reading \_\_\_\_\_

Ver. Ang. \_\_\_\_\_

Dis. \_\_\_\_\_ Elevation \_\_\_\_\_

 

VALUABLE

SUBJECT \_\_\_\_\_

Return To  
Public Works  
Office  
Camp Lejeune  
North Carolina

## FIELD PARTY

 \_\_\_\_\_ In Charge  
 \_\_\_\_\_ Instrument  
 \_\_\_\_\_ Notes  
 \_\_\_\_\_ Tape Read  
 \_\_\_\_\_ Tape or Rod  
 \_\_\_\_\_ Instrument No.  
 \_\_\_\_\_ Tape No.

## WEATHER

 Clear  
 Cloudy  
 Windy  
 Rain  
 Fair  
 Snow  
 Hot  
 Moderate  
 Cold  
 Fog

FILE No. \_\_\_\_\_

Fldr. No. \_\_\_\_\_

Sheet 100

Date \_\_\_\_\_ 19\_\_

Quad. No. \_\_\_\_\_

Station	Dist.	Angle " "	+	H. I. Bearing	Ver: Ang. Diff.	Elevation
	164	92 17				
	40	38 40				
	134	94 20				
	76	64 20				
	77	99 28				
	163	85 11	}	Rest shed		
	103	77 35				
	119	77 43				
	189	56 50				
	111	206 40				
	129	226 20				
	263	279 04				
	203	258 20				
	205	255 40				
	199	255 07				
	190	262 20				
	201	268 10				
	189	270 30	}	#4 tree		
	194	253 00				
	128	249 10				
	124	274 10				
PT#9	528	1734745				
PT#8						
BS						

 12" Cherry berry  
 Edge fair way  
 12" cherry berry  
 " " "  
 8" " "

5-1910

14' x 16'

 8" Earth Rd  
 3" Oak Edge fair way Wood Line  
 4" Oak

Edge Brewster Blvd - 8" 14" Earth Rd

 Water outlet  
 6" shade trees  
 Water fountain  
 Water outlet  
 8" shade trees

A PT#9

B PT#8

C PT#7

VALUABLE  
Return To  
Public Works  
Office  
Camp I elms  
North Carolina

SUBJECT

\_\_\_\_\_

\_\_\_\_\_

\_\_\_\_\_

Station \_\_\_\_\_  
Dist. \_\_\_\_\_  
Angle \_\_\_\_\_  
+ \_\_\_\_\_  
Hill \_\_\_\_\_  
Reading \_\_\_\_\_  
Vol. Ang. \_\_\_\_\_  
Dir. \_\_\_\_\_  
Elevation \_\_\_\_\_

FIELD PARTY

In Charge \_\_\_\_\_  
Instrument \_\_\_\_\_  
Notes \_\_\_\_\_  
Tape Read \_\_\_\_\_  
Type of Rod \_\_\_\_\_  
Type of Pole \_\_\_\_\_  
Instrument No. \_\_\_\_\_  
Tape No. \_\_\_\_\_

WEATHER

Clear \_\_\_\_\_  
Cloudy \_\_\_\_\_  
Fog \_\_\_\_\_  
Rain \_\_\_\_\_  
Snow \_\_\_\_\_  
Thunder \_\_\_\_\_  
Wind \_\_\_\_\_  
Temp \_\_\_\_\_  
Bar \_\_\_\_\_  
Humidity \_\_\_\_\_  
Direction \_\_\_\_\_  
Force \_\_\_\_\_  
State \_\_\_\_\_  
Time \_\_\_\_\_

FILE No.

\_\_\_\_\_

\_\_\_\_\_

\_\_\_\_\_

\_\_\_\_\_



VALUABLE

SUBJECT \_\_\_\_\_

Return To  
Public Works  
Office  
Camp Lejeune  
North Carolina

FIELD PARTY

\_\_\_\_\_ In Charge  
\_\_\_\_\_ Instrument  
\_\_\_\_\_ Notes  
\_\_\_\_\_ Tape Read  
\_\_\_\_\_ Tape or Rod  
\_\_\_\_\_ Tape or Rod  
\_\_\_\_\_ Instrument No.  
\_\_\_\_\_ Tape No.

WEATHER

Clear  
Cloudy  
Windy  
Rain  
Fair

Snow  
Hot  
Moderate  
Cold  
Fog

Figured By \_\_\_\_\_  
Notes Checked By \_\_\_\_\_  
Plotted By \_\_\_\_\_

FILE No. \_\_\_\_\_

Fldr. No. \_\_\_\_\_

Sheet 119

Date \_\_\_\_\_ 19\_\_

Quad. No. \_\_\_\_\_

Station	Dist.	Angle "	+	H. I. Bearing	Ver: Ang. Diff.	Elevation
---------	-------	---------	---	---------------	-----------------	-----------

110	46	50				
196	257	30				
94	358	20				
115	04	10				
195	355	50				
195	20	20				
251	15	20				
242	06	40				
237	06	30				
283	05	00				
285	358	40				

6" pine  
3" oak - Edge Fairway  
Edge Fairway  
3" oak  
3" oak  
3" persimmon  
4" Apple  
6" Apple  
4" Apple  
6" Apple  
6" Apple

PI#10

560	87	25	30			
-----	----	----	----	--	--	--

600	108	10				
-----	-----	----	--	--	--	--

Edge Fairway

127	97	50				
-----	----	----	--	--	--	--

420	92	40				
-----	----	----	--	--	--	--

396	93	00				
-----	----	----	--	--	--	--

407	98	40				
-----	----	----	--	--	--	--

} Sand trap

403	127	00				
-----	-----	----	--	--	--	--

293	104	20				
-----	-----	----	--	--	--	--

290	128	10				
-----	-----	----	--	--	--	--

219	93	10				
-----	----	----	--	--	--	--

211	94	50				
-----	----	----	--	--	--	--

199	90	50				
-----	----	----	--	--	--	--

77	106	50				
----	-----	----	--	--	--	--

Woods Log  
8" Pear tree  
Edge Fairway  
5" Oak  
Edge Fairway  
4" Apple tree  
Edge Fairway

PI#9

PI#9

BS

PI#8

AVAILABLE

Return to  
Public Works  
Office  
Camp Lejeune  
North Carolina

SUBJECT

\_\_\_\_\_

\_\_\_\_\_

\_\_\_\_\_

Station      Dist      Angle      +      Bearing      Vert. Ang.      Elevation

FIELD PARTY

In Charge \_\_\_\_\_

Instrument \_\_\_\_\_

Notes \_\_\_\_\_

Tape Reel \_\_\_\_\_

Tape on Rod \_\_\_\_\_

Level of Rod \_\_\_\_\_

Number of \_\_\_\_\_

Tape No. \_\_\_\_\_

WEATHER

Clear \_\_\_\_\_

Cloudy \_\_\_\_\_

Wind \_\_\_\_\_

Temp \_\_\_\_\_

Humidity \_\_\_\_\_

Bar \_\_\_\_\_

Notes \_\_\_\_\_

File No. \_\_\_\_\_

Field No. \_\_\_\_\_

Sheet \_\_\_\_\_

Date \_\_\_\_\_

WIND  
 FROM  
 SOUTHWEST

VALUABLE

SUBJECT \_\_\_\_\_

Return To  
Public Works  
Office  
Camp Lejeune  
North Carolina

FIELD PARTY

\_\_\_\_\_ In Charge  
\_\_\_\_\_ Instrument  
\_\_\_\_\_ Notes  
\_\_\_\_\_ Tape Read  
\_\_\_\_\_ Tape or Rod  
\_\_\_\_\_ Instrument No. \_\_\_\_\_  
\_\_\_\_\_ Tape No. \_\_\_\_\_

WEATHER

Clear  
Cloudy  
Windy  
Rain  
Fair

Snow  
Hot  
Moderate  
Cold  
Fog

FILE No. \_\_\_\_\_

Fldr. No. \_\_\_\_\_

Figured By \_\_\_\_\_ Sheet 12

Notes Checked By \_\_\_\_\_

Plotted By \_\_\_\_\_ Date \_\_\_\_\_ 19\_\_

Quad. No. \_\_\_\_\_

Station	Dist.	Angle " "	+	H. I. Bearing	Ver: Ang. Diff.	Elevation	
285	168	40					} #A Green ✓
243	172	40					
280	177	20					
251	181	50					
230	176	20					
246	168	50					
270	166	30					
195	147	50					
333	159	40					
282	157	40					
216	173	30					} Sand trap
233	172	40					
249	166	50					
245	162	40					
227	165	30					
213	169	00					
337	123	10					
187	117	50					
132	100						
560	241	30					
92	210	40					} Sand trap
107	206	30					
117	280	10					
95	181	00					
81	180	50					
71	188	40					
480	284	20					
72	150	20					
220	265	10					
PI #10							
BS							

4" shade tree  
6" shade trees  
Earth Rd

⊙ Rd  
⊙ Rd  
Intersection Earth Rds  
Woods Line

Woods Line  
Edge Fairway  
3" Oak

4 PI #10

4 PI #19



VALUABLE

SUBJECT

Return To  
Public Works  
Office  
Carp. Section  
North Carolina

BIRDS PARTY

\_\_\_\_\_ in Charge  
\_\_\_\_\_ Instrument  
\_\_\_\_\_ Notes  
\_\_\_\_\_ Tape Read  
\_\_\_\_\_ Tape or Rod  
\_\_\_\_\_ Tape or Rod  
\_\_\_\_\_ Instrument No.  
\_\_\_\_\_ Lens No.

WEATHER

\_\_\_\_\_ Clear  
\_\_\_\_\_ Cloudy  
\_\_\_\_\_ Fog  
\_\_\_\_\_ Moderate  
\_\_\_\_\_ Wind  
\_\_\_\_\_ Rain  
\_\_\_\_\_ Fog  
\_\_\_\_\_ Fanned By  
\_\_\_\_\_ Notes Checked By  
\_\_\_\_\_ Plotted By

FILE No.

Fig. No.

Sheet No.

Date

Grid No.

Station      Date      Angle      H. I.      Vert. Ang.      Elevation  
   Bearing      Dip

Grid area with faint text and lines, containing a grid pattern and some illegible markings.

VALUABLE

SUBJECT \_\_\_\_\_  
 \_\_\_\_\_  
 \_\_\_\_\_  
 \_\_\_\_\_

Return To  
 Public Works  
 Office  
 Camp Lejeune  
 North Carolina

FIELD PARTY

\_\_\_\_\_ In Charge  
 \_\_\_\_\_ Instrument  
 \_\_\_\_\_ Notes  
 \_\_\_\_\_ Tape Read  
 \_\_\_\_\_ Tape or Rod  
 \_\_\_\_\_ Tape or Rod  
 \_\_\_\_\_ Instrument No.  
 \_\_\_\_\_ Tape No.

WEATHER

Clear \_\_\_\_\_  
 Cloudy \_\_\_\_\_  
 Windy \_\_\_\_\_  
 Rain \_\_\_\_\_  
 Fair \_\_\_\_\_  
 Snow \_\_\_\_\_  
 Hot \_\_\_\_\_  
 Moderate \_\_\_\_\_  
 Cold \_\_\_\_\_  
 Fog \_\_\_\_\_  
 Figured By \_\_\_\_\_  
 Notes Checked By \_\_\_\_\_  
 Plotted By \_\_\_\_\_

FILE No. \_\_\_\_\_  
 Fldr. No. \_\_\_\_\_  
 Sheet 13  
 Date \_\_\_\_\_ 19\_\_\_\_

Quad. No. \_\_\_\_\_

Station	Dist.	Angle ° ' "	+	H. I. Bearing	Ver: Ang. Diff.	Elevation
	218	96 50				
	238	93 00				
	178	32 20	}	Sand Trap		
	165	29 30				
	141	28 10				
	136	33 00				
	151	37 00				
	177	38 20				
	178	33 00				
PT# 11	680	226 2030				
	367	199 80				
	350	195 30				
	535	190 10				
	480	177 10				
	488	172 40				
	468	166 10				
	427	159 00				
	432	158 40				
	432	161 40	}	= 5 Feet ✓		
	422	168 20				
	363	167 20				
	378	159 00				
	330	184 30				
	286	189 50				
	337	161 00				
	262	194 50				

1" Maple  
 & Rd

2" oak - Edge of way ✓  
 3" shade tree  
 3" oak  
 4" oak  
 & Rd  
 & Rd  
 & Rd  
 Car Woods

3" oak  
 3" oak  
 Water outlet  
 3" oak

PT# 10

PT# 10

BS

PT# 9

WILLIAMS

Return To  
Public Works  
Division  
Camp Lejeune  
North Carolina

SUBJECT

Section  
Date

Angle

Point

Vol. And  
Dist

Station

FIELD PARTY

In Charge

Instrument

Notes

Time Used

Type of Work

Time on Job

Station No.

Job No.

WEATHER

Clear

Cloudy

Hot

Moderate

Cold

Rain

Fog

Other

Wind

Temp

Humidity

Barometer

Altimeter

Compass

Other

FILE No.

Tab. No.

Sheet

Date

Draw No.



**VALUABLE**

 SUBJECT \_\_\_\_\_  
 \_\_\_\_\_  
 Return To  
 Public Works  
 Office  
 Camp Lejeune  
 North Carolina

**FIELD PARTY**

 \_\_\_\_\_ In Charge  
 \_\_\_\_\_ Instrument  
 \_\_\_\_\_ Notes  
 \_\_\_\_\_ Tape Read  
 \_\_\_\_\_ Tape or Rod  
 \_\_\_\_\_ Tape or Rod  
 \_\_\_\_\_ Instrument No.  
 \_\_\_\_\_ Tape No.

**WEATHER**

 Clear \_\_\_\_\_  
 Cloudy \_\_\_\_\_  
 Windy \_\_\_\_\_  
 Rain \_\_\_\_\_  
 Fair \_\_\_\_\_  
 Snow \_\_\_\_\_  
 Hot \_\_\_\_\_  
 Moderate \_\_\_\_\_  
 Cold \_\_\_\_\_  
 Fog \_\_\_\_\_  
 Figured By \_\_\_\_\_  
 Notes Checked By \_\_\_\_\_  
 Plotted By \_\_\_\_\_

 FILE No. \_\_\_\_\_  
 Fldr. No. \_\_\_\_\_  
 Sheet 147  
 Date \_\_\_\_\_ 19\_\_\_\_

Quad. No. \_\_\_\_\_

Station	Dist.	Angle " "	+	H. I. Bearing	Ver: Ang. Diff.	Elevation
---------	-------	--------------	---	------------------	--------------------	-----------

205 162 50

109 161 50

108 152 00

87 151 50

81 163 20

PJ#12

530 200 16 00

538 190 20

507 208 00

413 209 40

414 208 30

403 208 10

411 206 20

342 224 20

380 199 00

375 201 20

375 204 20

400 205 20

407 201 20

392 198 40

140 248 10

93 236 00

229 161 00

199 140 20

199 118 10

199 110 30

PJ#11

BS

{ Sand trap

{ Sand trap

3" Maple

3" Maple

Woods Line

Woods Line

1" Dog wood

8" Gum

Holly Tree

Woods Line

Edge Fair Way

Woods Line

Edge Fair Way

2" Maple

3" Maple

2" Oak Maple

Edge Fair Way

&amp; PJ#11

&amp; PJ#18

VALUABLE

Return to  
Rifle Works  
Office  
North Carolina

SUBJECT

\_\_\_\_\_  
\_\_\_\_\_  
\_\_\_\_\_

FIELD PARTY

Lead \_\_\_\_\_  
in Charge \_\_\_\_\_  
Cloudy \_\_\_\_\_  
Instrument \_\_\_\_\_  
Windy \_\_\_\_\_  
Notes \_\_\_\_\_  
Rain \_\_\_\_\_  
Fog \_\_\_\_\_  
Tape Band \_\_\_\_\_  
Tape or Rod \_\_\_\_\_  
Tape or Rod \_\_\_\_\_  
Tape or Rod \_\_\_\_\_  
Tape No. \_\_\_\_\_  
Tape No. \_\_\_\_\_

WEATHER

Snow \_\_\_\_\_  
Hot \_\_\_\_\_  
Cloudy \_\_\_\_\_  
Windy \_\_\_\_\_  
Clear \_\_\_\_\_  
Rain \_\_\_\_\_  
Fog \_\_\_\_\_  

FIELD NO.

\_\_\_\_\_

Station \_\_\_\_\_  
Date \_\_\_\_\_  
Angle \_\_\_\_\_  
M. S. \_\_\_\_\_  
Station \_\_\_\_\_  
V. A. \_\_\_\_\_  
D. W. \_\_\_\_\_  
Elevation \_\_\_\_\_

RECEIVED  
D-TRAIL  
BOND

VALUABLE

SUBJECT \_\_\_\_\_  
 \_\_\_\_\_  
 \_\_\_\_\_  
 \_\_\_\_\_

Return To  
 Public Works  
 Office  
 Camp Lejeune  
 North Carolina

FIELD PARTY

\_\_\_\_\_ In Charge  
 \_\_\_\_\_ Instrument  
 \_\_\_\_\_ Notes  
 \_\_\_\_\_ Tape Read  
 \_\_\_\_\_ Tape or Rod  
 \_\_\_\_\_ Tape or Rod  
 \_\_\_\_\_ Instrument No.  
 \_\_\_\_\_ Tape No.

WEATHER

Clear \_\_\_\_\_  
 Cloudy \_\_\_\_\_  
 Windy \_\_\_\_\_  
 Rain \_\_\_\_\_  
 Fair \_\_\_\_\_  
 Snow \_\_\_\_\_  
 Hot \_\_\_\_\_  
 Moderate \_\_\_\_\_  
 Cold \_\_\_\_\_  
 Fog \_\_\_\_\_  
 Figured By \_\_\_\_\_  
 Notes Checked By \_\_\_\_\_  
 Plotted By \_\_\_\_\_

FILE No. \_\_\_\_\_  
 Fldr. No. \_\_\_\_\_  
 Sheet 159  
 Date \_\_\_\_\_ 19\_\_\_\_

Quad. No. \_\_\_\_\_

Station	Dist.	Angle " "	+	H. I. Bearing	Ver: Ang. Diff.	Elevation
383	174	30				
409	169	40				
369	166	20				
410	159	40				
445	163	50				
494	172	10				
420	209	58				
337	182	18				
333	184	10				
350	184	25				
303	217	20				
318	208	00				
325	200	40				
320	193	20				
294	197	00				
197	189	20				
186	197	30				
206	206	40				
240	205	50				
260	201	00				
261	195	00				
236	191	20				
264	178	10				
250	191	00				
257	187	20				
232	182	20				
200	179	10				
180	186	30				

#6 Tee  
 Rest shed  
 #5 green  
 Sand trap

Edge fair way

Woods line  
 Woods line

5-1937

18'x12'

Woods line  
 3" oak  
 4" oak  
 4" oak  
 Water outlet

2" Maple

PI#12

1 PI#12

BS

1 PI#11





SUBJECT

Station

Date

Angle

Reading

Year

Level

FIELD PARTY

In Charge

Instrument

Notes

Time Used

Type of Rod

Type of Rod

Instrument No.

Case No.

WEATHER

Clear

Cloudy

Fog

Light B

Notes Checked By

Plotted By

Case No.

FILE No.

Plot No.

Sheet

Notes Checked By

Date

**VALUABLE**

SUBJECT \_\_\_\_\_  
 \_\_\_\_\_  
 \_\_\_\_\_  
 \_\_\_\_\_  
 \_\_\_\_\_

Return To  
 Public Works  
 Office  
 Camp Lejeune  
 North Carolina

**FIELD PARTY**

\_\_\_\_\_ In Charge  
 \_\_\_\_\_ Instrument  
 \_\_\_\_\_ Notes  
 \_\_\_\_\_ Tape Read  
 \_\_\_\_\_ Tape or Rod  
 \_\_\_\_\_ Tape or Rod  
 \_\_\_\_\_ Instrument No.  
 \_\_\_\_\_ Tape No.

**WEATHER**

Clear  
 Cloudy  
 Windy  
 Rain  
 Fair

Snow  
 Hot  
 Moderate  
 Cold  
 Fog

FILE No. \_\_\_\_\_  
 Fldr. No. \_\_\_\_\_  
 Sheet 16 of \_\_\_\_\_  
 Date \_\_\_\_\_ 19\_\_\_\_

Figured By \_\_\_\_\_  
 Notes Checked By \_\_\_\_\_  
 Plotted By \_\_\_\_\_

Quad. No. \_\_\_\_\_

Station	Dist.	Angle ' "	+	H. I. Bearing	Ver: Ang. Diff.	Elevation
---------	-------	--------------	---	------------------	--------------------	-----------

PI #13

564 18 43 30

575 43 20

420 26 00

602 47 20

330 29 10

165 54 50

307 82 00

236 163 40

297 131 00

378 178 20

Edge Fair way  
 2" Maple  
 3" Maple Edge Fair way  
 2" Maple  
 Woods Line Edge Fair way  
 2" Maple  
 Woods Line - Edge Fair way  
 End Rd.

PI #12

BS

Δ PI #12

Δ PI #11

TABLE

Return To  
Public Works  
Office  
Camp (Leone)  
North Carolina

SUBJECT

Station

Dist.

Angle

Height

Vol. And  
Dir.

Elevation

Top No

Instrument No.

Top of Rod

Notes

Type Rod

Notes

Instrument

the Station

FIELD PARTY

WEATHER

Clear  
Cloudy  
Windy  
Rain  
Fog

Lighted B.

Notes Checked B.

Plotted B.

Cont. No.

Date

Sheet

Plot No.

THE NO.



VALUABLE

SUBJECT \_\_\_\_\_  
 \_\_\_\_\_  
 Return To  
 Public Works  
 Office  
 Camp Lejeune  
 North Carolina

FIELD PARTY

\_\_\_\_\_ In Charge  
 \_\_\_\_\_ Instrument  
 \_\_\_\_\_ Notes  
 \_\_\_\_\_ Tape Read  
 \_\_\_\_\_ Tape or Rod  
 \_\_\_\_\_ Tape or Rod  
 \_\_\_\_\_ Instrument No.  
 \_\_\_\_\_ Tape No.

WEATHER

Clear  
 Cloudy  
 Windy  
 Rain  
 Fair

Snow  
 Hot  
 Moderate  
 Cold  
 Fog

FILE No. \_\_\_\_\_  
 Fldr. No. \_\_\_\_\_  
 Sheet 17  
 Date \_\_\_\_\_ 19\_\_\_\_

Figured By \_\_\_\_\_  
 Notes Checked By \_\_\_\_\_  
 Plotted By \_\_\_\_\_  
 Quad. No. \_\_\_\_\_

Station	Dist.	Angle ° ' "	+	H. I. Bearing	Ver: Ang. Diff.	Elevation
232	197	00	} #7 tree			
218	191	00				
144	187	15				
164	204	00				
180	207	40				
63	239					
90	229	00				
103	202	00				
142	217	40				
162	223	00				
172	257	30	} #6 green			
137	253	35				
118	266	25				
140	282	40				
172	276	10				
176	280	40	} Sand trap			
177	263	10				
197	263	10				
200	276	10				
187	285	40				
167	285	35	} Sand trap ✓			
167	321	30				
165	316	50				
191	312	40				
287	316	15				
192	321	30				
179	323	50				
PI#13	565	.				

Drinking fountain  
 tree  
 tree  
 tree  
 water outlet  
 wood line

4 PI#13  
 6 PI#12

VALUABLE

Return to  
Public Works  
Office  
Cann. Johnson  
North Carolina

Subject

\_\_\_\_\_  
\_\_\_\_\_  
\_\_\_\_\_

Station

Date

Angle

W

Setting

Vertical  
Dist.

Station

Tape No. \_\_\_\_\_

Instrument No. \_\_\_\_\_

Tape or Rod \_\_\_\_\_

Type of Rod \_\_\_\_\_

Type of Rod \_\_\_\_\_

Notes \_\_\_\_\_

Instrument \_\_\_\_\_

In Charge \_\_\_\_\_

FIELD PARTY

WEATHER

Clear \_\_\_\_\_  
Snow \_\_\_\_\_  
Ice \_\_\_\_\_  
Fog \_\_\_\_\_  
Rain \_\_\_\_\_  
Wind \_\_\_\_\_  
Mist \_\_\_\_\_  
Cold \_\_\_\_\_

Figured By \_\_\_\_\_

Notes Checked By \_\_\_\_\_

Plotted By \_\_\_\_\_

Date \_\_\_\_\_

FILE NO.

Plot No. \_\_\_\_\_

Sheet \_\_\_\_\_

Date \_\_\_\_\_

Grid No.

VALUABLE  
FIELD PARTY

**VALUABLE**

SUBJECT \_\_\_\_\_  
 \_\_\_\_\_  
 \_\_\_\_\_  
 \_\_\_\_\_

Return To  
 Public Works  
 Office  
 Camp Lejeune  
 North Carolina

**FIELD PARTY**

\_\_\_\_\_ In Charge  
 \_\_\_\_\_ Instrument  
 \_\_\_\_\_ Notes  
 \_\_\_\_\_ Tape Read  
 \_\_\_\_\_ Tape or Rod  
 \_\_\_\_\_ Instrument No.  
 \_\_\_\_\_ Tape No.

**WEATHER**

Clear \_\_\_\_\_  
 Cloudy \_\_\_\_\_  
 Windy \_\_\_\_\_  
 Rain \_\_\_\_\_  
 Fair \_\_\_\_\_

Snow \_\_\_\_\_  
 Hot \_\_\_\_\_  
 Moderate \_\_\_\_\_  
 Cold \_\_\_\_\_  
 Fog \_\_\_\_\_

FILE No. \_\_\_\_\_  
 Fldr. No. \_\_\_\_\_  
 Sheet 18  
 Date \_\_\_\_\_ 19\_\_\_\_

Figured By \_\_\_\_\_  
 Notes Checked By \_\_\_\_\_  
 Plotted By \_\_\_\_\_

Quad. No. \_\_\_\_\_

Station	Dist.	Angle " "	+	H. I. Bearing	Ver: Ang. Diff.	Elevation
---------	-------	--------------	---	------------------	--------------------	-----------

337	182	40				
360	182	46				
392	184	00				
378	186	10				
342	187	00				
310	185	10				

Sand trap ✓

197	200	55				
155	133	05				

Ends of 36" concrete culverts

125	92	40				
-----	----	----	--	--	--	--

Rd

87	66	30	✓			
110	65	50				
116	48	40				
90	42	00	✓			

Sand trap ✓

PI#15

645	177	06 45				
-----	-----	-------	--	--	--	--

542	166	06				
-----	-----	----	--	--	--	--

Woods Line

442	185	30				
-----	-----	----	--	--	--	--

Woods Line

105	257	00				
-----	-----	----	--	--	--	--

128	265	15				
-----	-----	----	--	--	--	--

Sand trap ✓

102	278	00				
-----	-----	----	--	--	--	--

77	265	30				
----	-----	----	--	--	--	--

167	73	45				
-----	----	----	--	--	--	--

Woods Line - Cor.

PI#14

665	177	46 30				
-----	-----	-------	--	--	--	--

659	188	40				
-----	-----	----	--	--	--	--

Woods Line

PI#13

PI#13

BS

PI#12



VALUABLE

Return to  
Public Works  
Office  

SUBJECT

\_\_\_\_\_  
\_\_\_\_\_  
\_\_\_\_\_

Station

Date

Time

Altitude

Dist.

Vol. and Elevation

FIELD PARTY

In Order \_\_\_\_\_  
Instrument \_\_\_\_\_  
Notes \_\_\_\_\_  
Tape Head \_\_\_\_\_  
Tape of Rod \_\_\_\_\_  
Notes \_\_\_\_\_  
Tape of Rod \_\_\_\_\_  
Tape of Rod \_\_\_\_\_  
Tape of Rod \_\_\_\_\_

WEATHER

Clear \_\_\_\_\_  
Cloudy \_\_\_\_\_  
Hot \_\_\_\_\_  
Windy \_\_\_\_\_  
Cold \_\_\_\_\_  
Fog \_\_\_\_\_  
Rain \_\_\_\_\_  
Thunder \_\_\_\_\_  
Lightning \_\_\_\_\_  
Snow \_\_\_\_\_

FILE NO.

\_\_\_\_\_  
\_\_\_\_\_  
\_\_\_\_\_

RECORD

VALUABLE

SUBJECT \_\_\_\_\_

Return To  
Public Works  
Office  
Camp Lejeune  
North Carolina

## FIELD PARTY

 \_\_\_\_\_ In Charge  
 \_\_\_\_\_ Instrument  
 \_\_\_\_\_ Notes  
 \_\_\_\_\_ Tape Read  
 \_\_\_\_\_ Tape or Rod  
 \_\_\_\_\_ Tape or Rod  
 \_\_\_\_\_ Instrument No.  
 \_\_\_\_\_ Tape No.

## WEATHER

 Clear \_\_\_\_\_  
 Cloudy \_\_\_\_\_  
 Windy \_\_\_\_\_  
 Rain \_\_\_\_\_  
 Fair \_\_\_\_\_  
 Snow \_\_\_\_\_  
 Hot \_\_\_\_\_  
 Moderate \_\_\_\_\_  
 Cold \_\_\_\_\_  
 Fog \_\_\_\_\_

FILE No. \_\_\_\_\_

Fldr. No. \_\_\_\_\_

Sheet 19

Date \_\_\_\_\_ 19\_\_\_\_

 Figured By \_\_\_\_\_  
 Notes Checked By \_\_\_\_\_  
 Plotted By \_\_\_\_\_

Quad. No. \_\_\_\_\_

Station	Dist.	Angle ° ' "	+	H. I. Bearing	Ver: Ang. Diff.	Elevation
	155	31 50 ✓				
	240	203 00 ✓				
	280	233 20 ✓				
PT#16	754	181 13				
	225	147 30				
	467	161 00				
	535	175 30				
	475	173 10				
	482	186 15				
	495	190 30				
	428	186 20				
	422	184 40				
	420	172 35				
	322	171 50				
	308	167 50				
	330	165 45				
	347	168 30				
	340	177 00				
	349	172 10				
	306	177 40				
	344	182 06				

 Edge fair way  
 Woods Line  
 Woods Line

 2 Rd  
 2 Rd

 Tree  
 Tree

{ #8 Tan

 Water Valve  
 Tree

{ Sand trap ✓

{ #7 green ✓

PT#15

BS

4 PT#15

1 PT#14

VALUABLE

SUBJECT

Return to  
Public Works  
Office  
North Carolina

Station

Date

Angle

Reading

Dist. And Elevation

H. I.

Traverse No.

Instrument

Notes

Table of Rod

Notes

Instrument

In Transit

LOCAL PARTY

WEATHER

Snow

Fog

Cloud

Wind

Temp

Bar

Humidity

Notes

Checked By

Date

Quadr. No.

FILE No.

FILE No.

Sheet

Date




VALUABLE

SUBJECT \_\_\_\_\_

Return To  
Public Works  
Office  
Camp Lejeune  
North Carolina

## FIELD PARTY

\_\_\_\_ In Charge  
\_\_\_\_ Instrument  
\_\_\_\_ Notes  
\_\_\_\_ Tape Read  
\_\_\_\_ Tape or Rod  
\_\_\_\_ Tape or Rod  
\_\_\_\_ Instrument No.  
\_\_\_\_ Tape No.

## WEATHER

Clear  
Cloudy  
Windy  
Rain  
Fair  
Snow  
Hot  
Moderate  
Cold  
Fog

FILE No. \_\_\_\_\_

Fldr. No. \_\_\_\_\_

Sheet 20

Date \_\_\_\_\_ 19\_\_

Figured By \_\_\_\_\_

Notes Checked By \_\_\_\_\_

Plotted By \_\_\_\_\_

Quad. No. \_\_\_\_\_

Station	Dist.	Angle " "	+	H. I. Bearing	Ver: Ang. Diff.	Elevation
---------	-------	--------------	---	------------------	--------------------	-----------

318 153 40

306 155 50

} sand trap

298 155 20

293 149 20

257 136 40

229 152 00

243 158 10

284 159 00

} #8 green

210 133 00

214 138 50

232 136 20

228 131 40

} sand trap ✓

271 159 40

269 163 20

247 163 40

215 165 40

217 159 00

} sand trap ✓

85 115 40

88 134 40

113 136 20

122 116 00

} sand trap ✓

36 239 00

230 122 30

PI#16 79 219 20 ✓

Edge of air way  
Wood's Line  
Wood's Line (over) & PI#16  
& PI#15

BS

7210411

Return To  
Public Works  
Office  
Camp Lejeune  
North Carolina

SUBJECT

Station  
Dist  
Angle  
H. I.  
Bearing  
Vertical  
Elevation

RECEIVED  
NOV 19 1954  
NAVY  
BOARD

FIELD PARTY  
in Charge  
Instrument  
Notes  
Tape Read  
Tape of Rod  
Tape of Rod  
Instrument No.  
Tape No.

WEATHER  
Clear  
Hot  
Cloudy  
Mild  
Moderate  
Rain  
Cold  
Fog

FILE No.

File No.

Date

Date

FILE No.

VALUABLE

SUBJECT \_\_\_\_\_

Return To  
Public Works  
Office  
Camp Lejeune  
North Carolina

## FIELD PARTY

\_\_\_\_ In Charge  
\_\_\_\_ Instrument  
\_\_\_\_ Notes  
\_\_\_\_ Tape Read  
\_\_\_\_ Tape or Rod  
\_\_\_\_ Instrument No. \_\_\_\_\_  
\_\_\_\_ Tape No. \_\_\_\_\_

## WEATHER

Clear \_\_\_\_\_  
Cloudy \_\_\_\_\_  
Windy \_\_\_\_\_  
Rain \_\_\_\_\_  
Fair \_\_\_\_\_  
Snow \_\_\_\_\_  
Hot \_\_\_\_\_  
Moderate \_\_\_\_\_  
Cold \_\_\_\_\_  
Fog \_\_\_\_\_

FILE No. \_\_\_\_\_

Fldr. No. \_\_\_\_\_

Sheet 21

Date \_\_\_\_\_ 19\_\_\_\_

Figured By \_\_\_\_\_  
Notes Checked By \_\_\_\_\_  
Plotted By \_\_\_\_\_

Quad. No. \_\_\_\_\_

Station	Dist.	Angle	"	+	H. I. Bearing	Ver: Ang. Diff.	Elevation
---------	-------	-------	---	---	------------------	--------------------	-----------

465 208 50

447 206 30

126 207 00

428 211 40

446 212 20

} Sand trap ✓

257 202 30 ✓

292 230 40 ✓

144 252 30 ✓

136 51 08 ✓

Edge Soil way

Woods Line

89 11 30

94 14 00

35 66 40

37 340 00

} #9 tree ✓

PI#17

589 153 38 00

362 161 30

450 149 40

445 164 30

316 176 08

260 173 40

319 167 00

Drinking Fountain  
Woods Line  
Woods Line  
Woods Line  
Edge Soil way  
Edge Soil way

307 159 40

319 157 00

} Sand trap ✓

PI#16

BS

a PI#18

s PI#15



VALUABLE

Return To  
Post Office  
Camp Lejeune  
North Carolina

SUBJECT

\_\_\_\_\_  
\_\_\_\_\_  
\_\_\_\_\_

Station

Date

Time

Weather

Remarks

FIELD PARTY

Name \_\_\_\_\_  
In Charge \_\_\_\_\_  
Instrument \_\_\_\_\_  
Notes \_\_\_\_\_  

WEATHER

Clear \_\_\_\_\_  
Snow \_\_\_\_\_  
Fog \_\_\_\_\_  
Windy \_\_\_\_\_  
Rain \_\_\_\_\_  
Fair \_\_\_\_\_  
Thunder \_\_\_\_\_  
Notes \_\_\_\_\_  
Checked by \_\_\_\_\_  
Recorded by \_\_\_\_\_

FILE No.

\_\_\_\_\_

Cont. No.

\_\_\_\_\_

VALUABLE

SUBJECT \_\_\_\_\_  
 \_\_\_\_\_  
 Return To  
 Public Works  
 Office  
 Camp Lejeune  
 North Carolina

FIELD PARTY

\_\_\_\_\_ In Charge  
 \_\_\_\_\_ Instrument  
 \_\_\_\_\_ Notes  
 \_\_\_\_\_ Tape Read  
 \_\_\_\_\_ Tape or Rod  
 \_\_\_\_\_ Tape or Rod  
 \_\_\_\_\_ Instrument No.  
 \_\_\_\_\_ Tape No.

WEATHER

Clear \_\_\_\_\_  
 Cloudy \_\_\_\_\_  
 Windy \_\_\_\_\_  
 Rain \_\_\_\_\_  
 Fair \_\_\_\_\_  
 Snow \_\_\_\_\_  
 Hot \_\_\_\_\_  
 Moderate \_\_\_\_\_  
 Cold \_\_\_\_\_  
 Fog \_\_\_\_\_  
 Figured By \_\_\_\_\_  
 Notes Checked By \_\_\_\_\_  
 Plotted By \_\_\_\_\_

FILE No. \_\_\_\_\_  
 Fldr. No. \_\_\_\_\_  
 Sheet 22  
 Date \_\_\_\_\_ 19\_\_

Quad. No. \_\_\_\_\_

Station	Dist.	Angle " "	+	H. I. Bearing	Ver: Ang. Diff.	Elevation
---------	-------	--------------	---	------------------	--------------------	-----------

567 153 00  
 545 156 00  
 525 157 00  
 538 159 10  
 563 157 20  
 580 155 10

} Sand trap

582 149 20

550 150 50  
 560 153 00  
 543 152 30  
 500 151 10  
 474 153 00  
 500 150 20

} #9 green

502 149 40  
 512 149 00  
 542 148 10  
 500 147 20  
 452 149 00

} Sand trap

387 161 30  
 385 145 40  
 345 162 50  
 360 142 20

Ditch  
 Edge Foot Way

PJ#18 690 215 44 45

PJ#17

BS

Δ PI=1

Δ

Δ

RECEIVED  
Public Works  
Office  
Camp Station  
North Carolina

SUBJECT

\_\_\_\_\_

\_\_\_\_\_

\_\_\_\_\_

\_\_\_\_\_

Section

Dist

Angle

Bearing

Year

Division







Notes \_\_\_\_\_

Instrument \_\_\_\_\_

In Charge \_\_\_\_\_

FIELD PARTY

WEATHER

Clear \_\_\_\_\_  
Cloudy \_\_\_\_\_  
Windy \_\_\_\_\_  
Moderate \_\_\_\_\_  
Cool \_\_\_\_\_  
Rain \_\_\_\_\_  
Fog \_\_\_\_\_

Checked By \_\_\_\_\_

Notes Checked By \_\_\_\_\_

Plotted By \_\_\_\_\_

Sheet \_\_\_\_\_

Plot No. \_\_\_\_\_

FILE No. \_\_\_\_\_

Date \_\_\_\_\_



VALUABLE

SUBJECT \_\_\_\_\_

Return To  
Public Works  
Office  
Camp Lejeune  
North Carolina

FIELD PARTY

\_\_\_\_ In Charge  
\_\_\_\_ Instrument  
\_\_\_\_ Notes  
\_\_\_\_ Tape Read  
\_\_\_\_ Tape or Rod  
\_\_\_\_ Tape or Rod  
\_\_\_\_ Instrument No.  
\_\_\_\_ Tape No.

WEATHER

Clear \_\_\_\_\_  
Cloudy \_\_\_\_\_  
Windy \_\_\_\_\_  
Rain \_\_\_\_\_  
Fair \_\_\_\_\_  
Snow \_\_\_\_\_  
Hot \_\_\_\_\_  
Moderate \_\_\_\_\_  
Cold \_\_\_\_\_  
Fog \_\_\_\_\_  
Figured By \_\_\_\_\_  
Notes Checked By \_\_\_\_\_  
Plotted By \_\_\_\_\_

FILE No. \_\_\_\_\_

Fldr. No. \_\_\_\_\_

Sheet 23

Date \_\_\_\_\_ 19\_\_\_\_

Quad. No. \_\_\_\_\_

Station	Dist.	Angle	"	+	H. I. Bearing	Ver: Ang. Diff.	Elevation
---------	-------	-------	---	---	---------------	-----------------	-----------

203 187 10

212 187 50

212 196 50

233 199 10

224 186 00

201 181 40

182 189 30

197 193 20

PI#19

541 291 35 45 ✓

550 293 70

420 291 40

428 288 20

492 289 10

390 292 40

310 289 50 ✓

393 220 00 ✓

185 210 50 ✓

453 188 00 ✓

396 171 00 ✓

510 171 40

492 165 20

562 170 10

356 163 50

PI#18

BS

Sand trap

Edge Pathway

Sand trap ✓

Edge Pathway

Edge Pathway

Ditch

#10 tree ✓

Δ #18

Δ #17



VALUABLE..

SUBJECT \_\_\_\_\_

Return To  
Public Works  
Office  
Camp Lejeune  
North Carolina

FIELD PARTY

\_\_\_\_\_ In Charge  
\_\_\_\_\_ Instrument  
\_\_\_\_\_ Notes  
\_\_\_\_\_ Tape Read  
\_\_\_\_\_ Tape or Rod  
\_\_\_\_\_ Tape or Rod  
\_\_\_\_\_ Instrument No.  
\_\_\_\_\_ Tape No.

WEATHER

Clear  
Cloudy  
Windy  
Rain  
Fair

Snow  
Hot  
Moderate  
Cold  
Fog

FILE No. \_\_\_\_\_

Fldr. No. \_\_\_\_\_

Figured By \_\_\_\_\_

Sheet 24

Notes Checked By \_\_\_\_\_

Plotted By \_\_\_\_\_

Date \_\_\_\_\_ 19\_\_

Quad. No. \_\_\_\_\_

Station	Dist.	Angle " "	+	H. I. Bearing	Ver: Ang. Diff.	Elevation
	340	142	00			
	326	134	20			
	302	134	50			
	309	143	20			
	326	143	50			
	150	92	20			
	139	147	20			
PI#20	117	249	40			
	600	168	38 00			
	486	177	10			
	540	179	10			
	465	183	20			
	516	183	30			
	357	182	10			
	289	171	00			
	271	165	20			
	245	163	30			
	258	170	20			
	235	185	00			
	275	182	20			
	260	173	20			
	221	173	50			

Sand trap

Edge Fairway  
Edge Fairway  
Woods Line

#11 tree

Woods Line

Sand trap

#12 green

PI#19  
BS

PI#19  
PI#18






FIELD PARTY  
In Charge  
Instrument  
Notes  
Tape Roll  
Type of Job  
Type of Rod  
Name No.  
Tape No.

WEATHER  
Snow  
Ice  
Cloudy  
Windy  
Misty  
Clear  
Fog  
Signed By  
Checked By  
Date

Field No.

Quest No.

RECORDED

VALUABLE

SUBJECT \_\_\_\_\_

Return To  
Public Works  
Office  
Camp Lejeune  
North Carolina

FIELD PARTY

\_\_\_\_ In Charge  
\_\_\_\_ Instrument  
\_\_\_\_ Notes  
\_\_\_\_ Tape Read  
\_\_\_\_ Tape or Rod  
\_\_\_\_ Instrument No.  
\_\_\_\_ Tape No.

WEATHER

Clear  
Cloudy  
Windy  
Rain  
Fair

Snow  
Hot  
Moderate  
Cold  
Fog

FILE No. \_\_\_\_\_

Fldr. No. \_\_\_\_\_

Sheet 25

Figured By \_\_\_\_\_

Notes Checked By \_\_\_\_\_

Plotted By \_\_\_\_\_

Date \_\_\_\_\_ 19\_\_

Quad. No. \_\_\_\_\_

Station	Dist.	Angle "	+	H. I. Bearing	Ver: Ang. Diff.	Elevation
---------	-------	---------	---	---------------	-----------------	-----------

452 219 40

279 192 10

257 186 00

302 190 20

318 195 40

Woods Line

345 231 50

Woods Line

257 209 40

296 205 10

304 198 40

265 193 20

227 201 20

#11 gree

280 214 40

242 216 50

237 210 30

202 213 00

Sand trap

74 126 40

99 113 20

70 102 30

44 118 10

Sand trap

PI#21

693 139 18

562 126 30

491 141 40

Edge Footway

PI#20

< PI#20

BS

< PI#19

AVAILABLE

Return to  
Field Work  
Office  
Camp Johnson  
North Carolina

SUBJECT

\_\_\_\_\_  
\_\_\_\_\_  
\_\_\_\_\_

FIELD PARTY

In Charge \_\_\_\_\_  
Assistant \_\_\_\_\_  
Notes \_\_\_\_\_  
Tape Roll \_\_\_\_\_  
Tape on Roll \_\_\_\_\_  
Tape on Roll \_\_\_\_\_  
Tape No. \_\_\_\_\_  
Tape No. \_\_\_\_\_

WEATHER

Clear \_\_\_\_\_  
Cloudy \_\_\_\_\_  
Windy \_\_\_\_\_  
Rain \_\_\_\_\_  
Fog \_\_\_\_\_  
Thunder \_\_\_\_\_  
Lightning \_\_\_\_\_  
Snow \_\_\_\_\_  
Ice \_\_\_\_\_  
Frost \_\_\_\_\_  
Hail \_\_\_\_\_  
Moderate \_\_\_\_\_  
Cold \_\_\_\_\_  
Hot \_\_\_\_\_

FIELD NO.

\_\_\_\_\_

Station \_\_\_\_\_  
Dist. \_\_\_\_\_  
Angle \_\_\_\_\_  
+ \_\_\_\_\_  
Ground \_\_\_\_\_  
H. I. \_\_\_\_\_  
Vol: Ang. \_\_\_\_\_  
Dir. \_\_\_\_\_  
Elevation \_\_\_\_\_

RECEIVED

NOV 19 1950



VALUABLE

SUBJECT \_\_\_\_\_

Return To  
Public Works  
Office  
Camp Lejeune  
North Carolina

FIELD PARTY

\_\_\_\_ In Charge  
\_\_\_\_ Instrument  
\_\_\_\_ Notes  
\_\_\_\_ Tape Read  
\_\_\_\_ Tape or Rod  
\_\_\_\_ Tape or Rod  
\_\_\_\_ Instrument No.  
\_\_\_\_ Tape No.

WEATHER

Clear  
Cloudy  
Windy  
Rain  
Fair  
Snow  
Hot  
Moderate  
Cold  
Fog  
Figured By \_\_\_\_\_  
Notes Checked By \_\_\_\_\_  
Plotted By \_\_\_\_\_

FILE No. \_\_\_\_\_

Fldr. No. \_\_\_\_\_

Sheet 26 of

Date \_\_\_\_\_ 19\_\_\_\_

Quad. No. \_\_\_\_\_

Station	Dist.	Angle	"	+	H. I. Bearing	Ver. Ang. Diff.	Elevation
274	214	10			} #12 green		
326	210	20					
319	212	10			} Sand trap		
350	210	40					
332	215	40					
300	218	30					
215	226	50			} Sand trap		
240	225	60					
262	229	40					
239	228	20					
111	265	20					
263	269	30					Edge Fairway
378	307	20			} #12 tree		
363	317	20					
286	313	50					
327	301	40					
410	281	50					Woods Line
219	222	24			} Rain shed S-1905		
217	225	57					
234	326	35					
524	147	1430					

Edge Fairway

Woods Line  
18' x 14'

PI#22

PI#21

BS

PI#22

PI#21

PI#20


SUBJECT

Station \_\_\_\_\_  
Dist. \_\_\_\_\_  
Angle \_\_\_\_\_  
Bar. \_\_\_\_\_  
Elev. \_\_\_\_\_

FIELD PARTY  
in Charge \_\_\_\_\_  
Instrument \_\_\_\_\_  
Notes \_\_\_\_\_  
Type Rod \_\_\_\_\_  
Type of Rod \_\_\_\_\_  
Type of Rod \_\_\_\_\_  
Type No. \_\_\_\_\_

WEATHER  
Clear \_\_\_\_\_  
Cloudy \_\_\_\_\_  
Windy \_\_\_\_\_  
Rain \_\_\_\_\_  
Fog \_\_\_\_\_

Notes Checked By \_\_\_\_\_  
Plotted By \_\_\_\_\_

RECORDED  
INDEXED

VALUABLE

SUBJECT \_\_\_\_\_

Return To  
Public Works  
Office  
Camp Lejeune  
North Carolina

## FIELD PARTY

 \_\_\_\_\_ In Charge  
 \_\_\_\_\_ Instrument  
 \_\_\_\_\_ Notes  
 \_\_\_\_\_ Tape Read  
 \_\_\_\_\_ Tape or Rod  
 \_\_\_\_\_ Instrument No.  
 \_\_\_\_\_ Tape No.

## WEATHER

 Clear \_\_\_\_\_ Snow \_\_\_\_\_  
 Cloudy \_\_\_\_\_ Hot \_\_\_\_\_  
 Windy \_\_\_\_\_ Moderate \_\_\_\_\_  
 Rain \_\_\_\_\_ Cold \_\_\_\_\_  
 Fair \_\_\_\_\_ Fog \_\_\_\_\_

FILE No. \_\_\_\_\_

Fldr. No. \_\_\_\_\_

Figured By \_\_\_\_\_ Sheet 27 of

Notes Checked By \_\_\_\_\_

Plotted By \_\_\_\_\_ Date \_\_\_\_\_ 19\_\_

Quad. No. \_\_\_\_\_

Station	Dist.	Angle	+	H. I. Bearing	Ver. Ang. Diff.	Elevation
<i>Mon.</i>		<u>35° 53' 00"</u>				
	537	192 40 00				
	500	93 10				
	165	120 20	}	Sand trap		
	184	114 40				
	160	110 40				
	135	116 00				
	230	197 30				
	90	148 10				
	500	179 40				
	412	249 40				
	407	182 20	}	# 13 tree		
	440	187 00				
	412	192 00				
	364	187 40				
	347	193 30				
	221	206 10	}	Sand trap		
	241	220 00				
	265	197 30				
	258	203 50				
	329	201 30	}	# 12 green		
	278	201 20				

To Water Tank  
USMC # 69

Woods Line

Edge Fair way

Woods Line  
" "

Drinking Fountain

PI# 22

BS

△ PI# 22

△ PI# 21



1X10 8' 12/50 6.6 10 ft  
66





SUBJECT

MEMBER

MEMBER

PUBLIC WORKS DEPARTMENT  
Camp Lejeune, North Carolina  
Survey Department

File 119-Gen  
Quadrangle \_\_\_\_\_  
Date 6/14/50  
Sheet 1 of \_\_\_\_\_

Traverse Computation  
Description

*Golf Course - Paradise Point*

Station	Distance	Bearing	Cosine	Sine	Latitude	Departure	Y Coordinate North	X Coordinate East
Mon. # 71		551°21'47"W	To Water Tank				354,424.06	2,485,786.10
P.I. #1	665'	N57-42-55W	53413	84540	<sup>354.90</sup> <del>353.20</del> - 30	<sup>561.24</sup> <del>562.19</del> - 95	354,778.96	2,485,224.86
P.I. #2	554'	N74-14-40W	27153	96243	<sup>30</sup> <del>150.43</del> - 13	<sup>532.28</sup> <del>533.19</del> - 91	354,929.26	2,484,692.58
P.I. #3	684'	S85-51-05W	07234	99738	<sup>52</sup> <del>49.78</del> + 04	<sup>681.64</sup> <del>682.99</del> - 115	354,879.74	2,484,011.52
P.I. #4	584'	N69-41-50E	34698	93787	<sup>54</sup> <del>202.84</del> - 17	<sup>548.63</sup> <del>547.72</del> + 93	355,082.21	2,484,560.17
P.I. #5	493'	S88-59-55E	01748	99985	<sup>93</sup> <del>8.62</del>	<sup>493.97</sup> <del>492.43</del> + 84	355,073.59	2,485,053.94
P.I. #6	638'	S63-17-55E	44934	89336	<sup>95</sup> <del>286.68</del> + 25	<sup>570.69</sup> <del>569.46</del> + 92	354,786.66	2,485,624.87
P.I. #7	648'	N57-51-45E	53195	84677	<sup>41</sup> <del>344.70</del> - 29	<sup>548.64</sup> <del>548.71</del> + 93	355,131.07	2,486,174.51
P.I. #8	630'	S89-54-45E	00153	99999	<sup>22</sup> <del>0.96</del>	<sup>630.06</sup> <del>630.00</del> + 100	355,130.11	2,486,805.57
P.I. #9	528'	N83-53-00E	10655	99431	<sup>89</sup> <del>56.26</del> - 04	<sup>528.89</sup> <del>525.80</del> + 89	355,186.33	2,487,331.46
P.I. #10	560'	N8-41-30W	98852	15112	<sup>10</sup> <del>553.57</del> - 47	<sup>417.33</sup> <del>84.63</del> - 14	355,739.43	2,487,246.97
P.I. #11	680'	N37-47-00E	79033	61268	<sup>96</sup> <del>537.42</del> - 40	<sup>417.33</sup> <del>416.62</del> + 71	356,276.39	2,487,664.30
P.I. #12	530'	N58-03-00E	52918	84851	<sup>23</sup> <del>280.47</del> - 24	<sup>450.47</sup> <del>449.71</del> + 76	356,556.62	2,488,114.77
P.I. #13	564'	S76-46-30W	22878	97348	<sup>15</sup> <del>129.83</del> + 12	<sup>548.11</sup> <del>549.04</del> - 93	356,427.47	2,487,566.66
P.I. #14	665'	S74-35-00W	26584	96402	<sup>93</sup> <del>176.78</del> + 15	<sup>639.99</sup> <del>641.07</del> - 108	356,250.54	2,486,926.67
P.I. #15	645'	S71-41-45W	31406	94940	<sup>24</sup> <del>202.57</del> + 17	<sup>611.83</sup> <del>612.36</del> - 108	356,047.80	2,486,315.34
P.I. #16	754'	S72-54-45W	29383	95586	<sup>24</sup> <del>221.55</del> + 19	<sup>719.51</sup> <del>720.72</del> - 121	355,826.06	2,485,595.83
P.I. #17	589'	S46-32-45W	68777	72592	<sup>44</sup> <del>405.70</del> + 34	<sup>426.84</sup> <del>427.57</del> - 73	355,420.62	2,485,168.99
P.I. #18	690'	S82-17-30W	13413	99096	<sup>63</sup> <del>92.55</del> + 08	<sup>689.61</sup> <del>683.76</del> - 116	355,327.99	2,484,486.38
P.I. #19	541'	N18-53-15E	94616	32371	<sup>44</sup> <del>511.87</del> - 43	<sup>43</sup> <del>175.73</del> + 30	355,839.43	2,484,661.81
P.I. #20	600'	N7-23-15E	99170	12858	<sup>52</sup> <del>595.02</del> - 50	<sup>29</sup> <del>77.75</del> + 14	356,433.95	2,484,739.10





PUBLIC WORKS DEPARTMENT  
 Camp Lejeune, North Carolina  
 Survey Department

File 119  
 Quadrangle \_\_\_\_\_  
 Date 6/14/50  
 Sheet #2 of \_\_\_\_\_

Traverse Computation  
 Description

*Golf Course - Paradise Point*

Station	Distance	Bearing	Cosine	Sine	Latitude	Departure	Y Coordinate North	X Coordinate East
P.I. # 20							356,433.95	2,484,739.10
P.I. # 21	693'	N33-18-45W	83569	54921	<sup>578.63</sup> <del>579.13</del> - 50	<sup>379.95</sup> <del>380.10</del> - 15	357,012.58	2,484,359.15
P.I. # 22	524'	N66-04-15W	40561	91405	<sup>36</sup> <del>212.54</del> - 18	<sup>14</sup> <del>478.96</del> - 92	357,224.94	2,483,881.01
Mon. # 69	537'	N53-24-15W	59617	80286	<sup>319.86</sup> <del>320.14</del> - 28	<sup>430.44</sup> <del>431.14</del> - 73	357,544.80	2,483,450.60
To Water Tank		S17°30'08" E ✓					357,544.80	2,483,450.60
		S17°31'15" E					357,550.13	2,483,431.59
		+00°01'07" Not Adjusted					+ 5.33	- 19.01

Stadia 13,996 ÷ √(5.33<sup>2</sup> + 19.01<sup>2</sup>) = 1/710'

+ 4699.39	+ 4432.93
- 1573.32	- 6787.44
+ 3126.07	- 2354.51



**VALUABLE**

SUBJECT

Golf CourseNorth Side of Brewster Blvd.Return To  
Public Works  
Office  
Camp Lejeune  
North Carolina

## FIELD PARTY

Hamilton In Charge  
\_\_\_\_ Instrument  
\_\_\_\_ Notes  
\_\_\_\_ Tape Read  
\_\_\_\_ Tape or Rod  
\_\_\_\_ Instrument No.  
\_\_\_\_ Tape No.

## WEATHER

Clear \_\_\_\_\_  
Cloudy \_\_\_\_\_  
Windy \_\_\_\_\_  
Rain \_\_\_\_\_  
Fair \_\_\_\_\_  
Snow Hot \_\_\_\_\_  
Moderate \_\_\_\_\_  
Cold \_\_\_\_\_  
Fog \_\_\_\_\_

FILE No. \_\_\_\_\_

Fldr. No. \_\_\_\_\_

Figured By \_\_\_\_\_

Sheet

28 of

Notes Checked By \_\_\_\_\_

Plotted By \_\_\_\_\_

Date

6/14 1950

Quad. No. \_\_\_\_\_

Station	Dist.	Angle	"	+	H. I. Bearing	Ver: Ang. Diff.	Elevation
---------	-------	-------	---	---	---------------	-----------------	-----------

176 155 50 ✓

201 158 10 ✓

192 163 26 ✓

170 165 50 ✓

92 297 50 ✓

224 33 30 ✓

230 25 40 ✓

237 28 30 ✓

257 34 50 ✓

114 331 80 ✓

386 21 90 ✓

36 212 00 ✓

46 191 00 ✓

35 166 40 ✓

18 186 00 ✓

PI#24 ✓

687 167 25 30

PI#23

568 344 58 00

Mon. A

B.S.

35 53 00

Mon.

B.S.

} Sand trap

} Sand trap

} Sand trap

Ditch

Edge Fairway  
Edge Fairway

A PI#24

A PI#23

A 213MC#69

A Water Tank

Water Tank

A Mon., 213MC#69

A PI#22



Region  
Public Works  
Office  
Central  
North Carolina

Station

Dist

Area

M. I. Hearing

Verbal  
Dist.

Verbal  
Dist.

FIELD PARTY

In Charge

Instruments

Notes

Tape Read

Time of Read

Time of Read

Instrument No.

Tape No.

WEATHER

Clear

Cloudy

Fog

Light

Medium

Heavy

Snow

Ice

FILE NO.

FILE NO.

Sheet

Date

Checked by

Checked by

Checked by

Check No.

VALUABLE

SUBJECT \_\_\_\_\_

Return To  
Public Works  
Office  
Camp Lejeune  
North Carolina

FIELD PARTY

\_\_\_\_\_ In Charge  
\_\_\_\_\_ Instrument  
\_\_\_\_\_ Notes  
\_\_\_\_\_ Tape Read  
\_\_\_\_\_ Tape or Rod  
\_\_\_\_\_ Tape or Rod  
\_\_\_\_\_ Instrument No.  
\_\_\_\_\_ Tape No.

WEATHER

Clear \_\_\_\_\_  
Cloudy \_\_\_\_\_  
Windy \_\_\_\_\_  
Rain \_\_\_\_\_  
Fair \_\_\_\_\_  
Snow \_\_\_\_\_  
Hot \_\_\_\_\_  
Moderate \_\_\_\_\_  
Cold \_\_\_\_\_  
Fog \_\_\_\_\_

FILE No. \_\_\_\_\_

Fldr. No. \_\_\_\_\_

Figured By \_\_\_\_\_ Sheet # 294

Notes Checked By \_\_\_\_\_

Plotted By \_\_\_\_\_ Date \_\_\_\_\_ 19\_\_

Quad. No. \_\_\_\_\_

Station	Dist.	Angle "	+	H. I. Bearing	Ver. Ang. Diff.	Elevation
PJ#25	600	311 15 45				
155	239	30	✓			
322	265	00	✓			
408	193	10	✓	} Rain shed		
393	193	40	✓			
393	191	52	✓			
373	209	00	✓	} #14 Tee		
408	209	00	✓			
382	199	20	✓			
337	203	30	✓			
193	192	00	✓	} Sand trap		
164	199	38	✓			
184	198	20	✓			
205	197	00	✓			
175	187	20	✓	} #13 green		
207	191	00	✓			
235	187	00	✓			
237	199	20	✓			
206	179	20	✓			
174	171	50	✓			
347	190	20	✓			
292	204	50	✓			
PJ#21						
BS						

Edge Rainway

S-1935 12x15'

Ditch

4 PJ#24  
4 PJ#23


North Carolina

SUBJECT

\_\_\_\_\_  
\_\_\_\_\_  
\_\_\_\_\_

Station

Dist

Area

Station

Dist

Ver. Ang. Elevation

FIELD PARTY

In Charge \_\_\_\_\_  
Instrument \_\_\_\_\_  
Notes \_\_\_\_\_  
Tape Read \_\_\_\_\_  
Tape of Rod \_\_\_\_\_  
Tape of Rod \_\_\_\_\_  
Station No. \_\_\_\_\_  
Tape No. \_\_\_\_\_

WEATHER

Clear \_\_\_\_\_  
Cloudy \_\_\_\_\_  
Fog \_\_\_\_\_  
Hazy \_\_\_\_\_  
Mist \_\_\_\_\_  
Rain \_\_\_\_\_  
Sleet \_\_\_\_\_  
Snow \_\_\_\_\_

Quadr. No.

Plotted By \_\_\_\_\_  
Notes Checked By \_\_\_\_\_  
Sheet \_\_\_\_\_

FILE NO.

Plot No. \_\_\_\_\_  
Date \_\_\_\_\_





**VALUABLE**

SUBJECT \_\_\_\_\_

Return To  
Public Works  
Office  
Camp Lejeune  
North Carolina

**FIELD PARTY**

\_\_\_\_\_ In Charge  
\_\_\_\_\_ Instrument  
\_\_\_\_\_ Notes  
\_\_\_\_\_ Tape Read  
\_\_\_\_\_ Tape or Rod  
\_\_\_\_\_ Tape or Rod  
\_\_\_\_\_ Instrument No.  
\_\_\_\_\_ Tape No.

**WEATHER**

Clear  
Cloudy  
Windy  
Rain  
Fair

Snow  
Hot  
Moderate  
Cold  
Fog

FILE No. \_\_\_\_\_

Fldr. No. \_\_\_\_\_

Figured By \_\_\_\_\_ Sheet # 30 of \_\_\_\_\_

Notes Checked By \_\_\_\_\_

Plotted By \_\_\_\_\_ Date \_\_\_\_\_ 19 \_\_\_\_\_

Quad. No. \_\_\_\_\_

Station	Dist.	Angle "	+	H. I. Bearing	Ver. Ang. Diff.	Elevation
183	301	00	✓			
495	192	40	✓			
525	214	00	✓			
400	199	20	✓			
417	192	00	✓			
416	192	50	✓			
365	193	20	✓			
360	196	15	✓			
323	229	30	✓			
325	227	20	✓			
313	225	10	✓			
283	223	40	✓			
268	227	20	✓			
287	232	20	✓			
223	184	00	✓			
182	296	30	✓			
45	74	20	✓			
147	316	30	✓			
338	26	50	✓			
331	31	30	✓			
358	30	20	✓			
368	27	00	✓			

Woods Line

Edge Fairway - Woods Line  
Edge Fairway - Woods Line

} Sand trap

} Sand trap

(Cord) Woods Line  
Woods Line

Edge Fairway  
" "

} Sand trap

PI#25

PI#25

38

PI#24
































**VALUABLE**

SUBJECT \_\_\_\_\_

Return To  
Public Works  
Office  
Camp Lejeune  
North Carolina

**FIELD PARTY**

\_\_\_\_ In Charge  
\_\_\_\_ Instrument  
\_\_\_\_ Notes  
\_\_\_\_ Tape Read  
\_\_\_\_ Tape or Rod  
\_\_\_\_ Tape or Rod  
\_\_\_\_ Instrument No.  
\_\_\_\_ Tape No.

**WEATHER**

Clear \_\_\_\_\_  
Cloudy \_\_\_\_\_  
Windy \_\_\_\_\_  
Rain \_\_\_\_\_  
Fair \_\_\_\_\_  
Snow \_\_\_\_\_  
Hot \_\_\_\_\_  
Moderate \_\_\_\_\_  
Cold \_\_\_\_\_  
Fog \_\_\_\_\_  
Figured By \_\_\_\_\_  
Notes Checked By \_\_\_\_\_  
Plotted By \_\_\_\_\_

FILE No. \_\_\_\_\_

Fldr. No. \_\_\_\_\_

Sheet 31

Date 6/14 1950

Quad. No. \_\_\_\_\_

Station	Dist.	Angle "	+	H. I. Bearing	Ver: Ang. Diff.	Elevation
290	172	40	✓			
282	168	15	✓			
246	165	15	✓			
212	167	40	✓			
210	177	15	✓			
257	177	50	✓			
140	157	00	✓			
133	166	20	✓			
150	173	30	✓			
163	165	30	✓			
173	162	00	✓			
203	191	20	✓			
183	184	30	✓			
210	182	00	✓			
228	185	50	✓			
169	125	00	✓			
143	212	00	✓			
153	146	00	✓			
109	277	30	✓			
155	277	30	✓			
48	131	00	✓			
70	51	00	✓			
PI#26	618	199	0845			

#14 green

Sand trap

sand trap

Woods Line  
Ditch  
Woods Line  
Edge Fairway  
Woods Line  
Ditch  
Edge Fairway - Woods Line  
PI# 26  
PI# 25  
PI# 24

BS





















WEATHER

Clear

Cloudy

Windy

Rain

Fog

Snow

Hot

Moderate

Cold

Fair

FILE No.

Field No.

Station

Plotted BY

Checked BY

Date

Sketch No.

DUPLICATE

VALUABLE

SUBJECT \_\_\_\_\_

Return To  
Public Works  
Office  
Camp Lejeune  
North Carolina

FIELD PARTY

\_\_\_\_\_ In Charge  
\_\_\_\_\_ Instrument  
\_\_\_\_\_ Notes  
\_\_\_\_\_ Tape Read  
\_\_\_\_\_ Tape or Rod  
\_\_\_\_\_ Instrument No.  
\_\_\_\_\_ Tape No.

WEATHER

Clear  
Cloudy  
Windy  
Rain  
Fair

Snow  
Hot  
Moderate  
Cold  
Fog

FILE No. \_\_\_\_\_

Fldr. No. \_\_\_\_\_

Sheet 32

Figured By \_\_\_\_\_

Notes Checked By \_\_\_\_\_

Plotted By \_\_\_\_\_

Date \_\_\_\_\_ 19\_\_

Quad. No. \_\_\_\_\_

Station	Dist.	Angle	"	+	H. I. Bearing	Ver: Ang. Diff.	Elevation	
	243	141	40	✓				Edge of fairway - Woods Line
	226	101	40	✓				
PI#28	423	89	11 45					
	309	85	10	✓				Edge Fairway - Woods Line
	520	91	10	✓				
	187	130	10					Edge Fairway Woods Line
	355	122	00	✓				
	235	330	00	✓				Woods Line
	187	12	30	✓				
	98	237	00	✓				" "
	95	75	00	✓				
	339	270	30	✓				" "
	296	268	45	✓				
	293	275	50	✓				} #15 Tee
	232	279	10	✓				
	222	267	50	✓				
	222	322	307 10	✓				
	215	303	15	✓				} Rain shed
	230	301	10	✓				
PI#27	471	172	26 00					
	335	141	00	✓				Woods Line Edge Fairway Woods Line PI#26
	295	195	15	✓				
BS								PI#25

Edge of fairway - Woods Line

Edge Fairway - Woods Line

Edge Fairway  
Woods Line

Woods Line

" "

" "

} #15 Tee

} Rain shed

3-1904  
20' x 16'

Woods Line  
Edge Fairway Woods Line  
PI#26

PI#25

VALUABLE

Reason for  
Public Works  
City  
County  
North Carolina

SUBJECT

\_\_\_\_\_  
\_\_\_\_\_  
\_\_\_\_\_

Station

Dist

L

H. T.  
Elevation

W. A. D. B.  
Elevation

FIELD PARTY

In Charge \_\_\_\_\_  
Instruments \_\_\_\_\_  
Notes \_\_\_\_\_  
Tape Read \_\_\_\_\_  
Tape on Road \_\_\_\_\_  
Tape at foot \_\_\_\_\_  
Tape No. \_\_\_\_\_

WEATHER

Clear \_\_\_\_\_  
Cloudy \_\_\_\_\_  
Hot \_\_\_\_\_  
Moderate \_\_\_\_\_  
Cold \_\_\_\_\_  
Fog \_\_\_\_\_  
Rain \_\_\_\_\_

FILE NO.

\_\_\_\_\_

Check No.

Printed By \_\_\_\_\_  
Checked By \_\_\_\_\_  
Filed By \_\_\_\_\_

VALUABLE



VALUABLE

SUBJECT: \_\_\_\_\_

 Return To  
 Public Works  
 Office  
 Camp Lejeune  
 North Carolina

## FIELD PARTY

 \_\_\_\_\_ In Charge  
 \_\_\_\_\_ Instrument  
 \_\_\_\_\_ Notes  
 \_\_\_\_\_ Tape Read  
 \_\_\_\_\_ Tape or Rod  
 \_\_\_\_\_ Tape or Rod  
 \_\_\_\_\_ Instrument No.  
 \_\_\_\_\_ Tape No.

## WEATHER

 Clear \_\_\_\_\_  
 Cloudy \_\_\_\_\_  
 Windy \_\_\_\_\_  
 Rain \_\_\_\_\_  
 Fair \_\_\_\_\_  
 Snow \_\_\_\_\_  
 Hot \_\_\_\_\_  
 Moderate \_\_\_\_\_  
 Cold \_\_\_\_\_  
 Fog \_\_\_\_\_

FILE No. \_\_\_\_\_

Fldr. No. \_\_\_\_\_

Sheet 33

Notes Checked By \_\_\_\_\_

Plotted By \_\_\_\_\_ Date \_\_\_\_\_ 19\_\_\_\_

Quad. No. \_\_\_\_\_

Station	Dist.	Angle	+	H. I. Bearing	Ver: Ang. Diff.	Elevation
---------	-------	-------	---	---------------	-----------------	-----------

384	113	20	✓			
335	112	10	✓			
427	106	40	✓			
372	106	30	✓			

#16 Tee

PI# 29

522	159	23	15	✓		
-----	-----	----	----	---	--	--

590	108	10	✓			
-----	-----	----	---	--	--	--

625	125	20	✓			
-----	-----	----	---	--	--	--

Woods line

535	121	20	✓			
-----	-----	----	---	--	--	--

570	122	00	✓			
-----	-----	----	---	--	--	--

603	120	50	✓			
-----	-----	----	---	--	--	--

597	118	00	✓			
-----	-----	----	---	--	--	--

524	116	20	✓			
-----	-----	----	---	--	--	--

527	117	40	✓			
-----	-----	----	---	--	--	--

#15 green

530	127	20	✓			
-----	-----	----	---	--	--	--

520	125	00	✓			
-----	-----	----	---	--	--	--

480	125	00	✓			
-----	-----	----	---	--	--	--

480	129	00	✓			
-----	-----	----	---	--	--	--

Sand trap

470	113	20	✓			
-----	-----	----	---	--	--	--

355	115	30	✓			
-----	-----	----	---	--	--	--

435	113	20	✓			
-----	-----	----	---	--	--	--

455	111	10	✓			
-----	-----	----	---	--	--	--

Sand trap

432	132	30	✓			
-----	-----	----	---	--	--	--

390	107	40	✓			
-----	-----	----	---	--	--	--

Ditch

A PI# 28

A PI# 27

BS

WATER

Station  
Public Works  
City  
State  
County  
Water Control

Station \_\_\_\_\_  
Date \_\_\_\_\_  
Elevation \_\_\_\_\_  
Barometric \_\_\_\_\_  
H. \_\_\_\_\_  
Barometric \_\_\_\_\_  
Elevation \_\_\_\_\_

FIELD PARTY

in Charge \_\_\_\_\_  
Instrument \_\_\_\_\_  
Notes \_\_\_\_\_  
Type Road \_\_\_\_\_  
Type of Road \_\_\_\_\_  
Numbered \_\_\_\_\_  
Type No. \_\_\_\_\_

Checked By \_\_\_\_\_  
Checked By \_\_\_\_\_  
FILE NO.

FILE NO.

WEATHER

Snow \_\_\_\_\_  
Fog \_\_\_\_\_  
Moderate \_\_\_\_\_  
Cold \_\_\_\_\_  
Rain \_\_\_\_\_

Lighted \_\_\_\_\_  
Checked \_\_\_\_\_  
Checked \_\_\_\_\_  
\_\_\_\_\_ Tape Read  
\_\_\_\_\_ Tape or Rod  
\_\_\_\_\_ Tape or Rod  
\_\_\_\_\_ Instrument No.  
\_\_\_\_\_ Tape No.

**WEATHER**

Clear \_\_\_\_\_  
Cloudy \_\_\_\_\_  
Windy \_\_\_\_\_  
Rain \_\_\_\_\_  
Fair \_\_\_\_\_  
Snow \_\_\_\_\_  
Hot \_\_\_\_\_  
Moderate \_\_\_\_\_  
Cold \_\_\_\_\_  
Fog \_\_\_\_\_

FILE No. \_\_\_\_\_

Fldr. No. \_\_\_\_\_

Sheet 34

Figured By \_\_\_\_\_

Notes Checked By \_\_\_\_\_

Plotted By \_\_\_\_\_

Date \_\_\_\_\_ 19\_\_

Quad. No. \_\_\_\_\_

Station	Dist.	Angle	+	H. I. Bearing	Ver: Ang. Diff.	Elevation
---------	-------	-------	---	---------------	-----------------	-----------

540	295	40		} Sand trap		
510	294	00				

527	285	30	✓	} Sand trap		
554	285	30	✓			
568	283	40	✓			
535	281	40	✓			
520	282	50	✓			

500	277	40	✓			Edge Fairway
-----	-----	----	---	--	--	--------------

450	287	20	✓	} Sand trap		
495	285	40	✓			
490	288	30	✓			
475	291	10	✓			
447	292	00	✓			

355	311	00	✓			Edge Fairway
133	198	60	✓			Edge Fairway

146	316	00	✓	} Sand trap		
175	323	50	✓			
174	333	20	✓			
142	324	30	✓			

317	101	50	✓			Woods Line
116	41	00	✓			Edge Fairway - Woods Line
452	113	40	✓			Drinking Fountain

+

BS

PI#29

PI#28



Return to  
Public Works  
Office  
Care of  
Post-Office

SUBJECT

\_\_\_\_\_  
\_\_\_\_\_  
\_\_\_\_\_

Station \_\_\_\_\_ Date \_\_\_\_\_  
H. I. \_\_\_\_\_  
Gear \_\_\_\_\_  
V. A. \_\_\_\_\_  
E. \_\_\_\_\_

FIELD PARTY  
H. Grade \_\_\_\_\_  
Instruments \_\_\_\_\_  
Notes \_\_\_\_\_  
Tape Rod \_\_\_\_\_  
Tap or Rod \_\_\_\_\_  
Tap or Rod \_\_\_\_\_  
Type No. \_\_\_\_\_

WEATHER  
Clear \_\_\_\_\_  
Cloudy \_\_\_\_\_  
Rain \_\_\_\_\_  
Cold \_\_\_\_\_  
Fog \_\_\_\_\_

Checked By \_\_\_\_\_  
Checked By \_\_\_\_\_  
Checked By \_\_\_\_\_

File No.

\_\_\_\_\_  
\_\_\_\_\_  
\_\_\_\_\_

Card No.



VALUABLE

SUBJECT \_\_\_\_\_

Return To  
Public Works  
Office  
Camp Lejeune  
North Carolina

## FIELD PARTY

\_\_\_\_\_  
In Charge  
\_\_\_\_\_  
Instrument  
\_\_\_\_\_  
Notes  
\_\_\_\_\_  
Tape Read  
\_\_\_\_\_  
Tape or Rod  
\_\_\_\_\_  
Tape or Rod  
\_\_\_\_\_  
Instrument No.  
\_\_\_\_\_  
Tape No.

## WEATHER

Clear  
Cloudy  
Windy  
Rain  
Fair  
Snow  
Hot  
Moderate  
Cold  
Fog

FILE No. \_\_\_\_\_

Fldr. No. \_\_\_\_\_

Sheet 35

Date \_\_\_\_\_ 19\_\_

Figured By \_\_\_\_\_

Notes Checked By \_\_\_\_\_

Plotted By \_\_\_\_\_

Quad. No. \_\_\_\_\_

Station	Dist.	Angle	+	H. I. Bearing	Ver: Ang. Diff.	Elevation
345	236	40	✓	Sand trap		
362	234	10	✓			
394	243	20	✓	Sand trap		
407	240	10	✓			
433	241	10	✓			
425	244	10	✓			
317	250	00	✓			
485	253	00	✓			
614	286	15		#17 Tee		
640	276	30	✓			
685	279	50	✓			
660	283	00	✓			
573	298	20	✓			
542	290	20	✓	#16 green		
523	292	20	✓			
595	292	00	✓			
610	289	00	✓			
588	286	30	✓			
553	287	20	✓			
533	292	00	✓	Sand trap		
575	295	20	✓			
556	297	20	✓			

Edge Fairway

Woods Line

A

BS

PI#29

PI#28

AVAILABLE

Return To  
Public Works  
Office  
Camp Lejeune  
North Carolina

SUBJECT

\_\_\_\_\_  
\_\_\_\_\_  
\_\_\_\_\_

Station

Day

+

Spring

Vert. Ang.

Elevation

\_\_\_\_\_

\_\_\_\_\_

\_\_\_\_\_

\_\_\_\_\_

\_\_\_\_\_

\_\_\_\_\_

\_\_\_\_\_

Quod. No.

Plotted By

Notes Checked By

Figured By

\_\_\_\_\_

\_\_\_\_\_

\_\_\_\_\_

WEATHER

Fair

Cloudy

Snow

FILE NO.

\_\_\_\_\_

\_\_\_\_\_

\_\_\_\_\_

\_\_\_\_\_



VALUABLE

SUBJECT \_\_\_\_\_

Return To  
Public Works  
Office  
Camp Lejeune  
North Carolina

FIELD PARTY

\_\_\_\_\_ In Charge  
\_\_\_\_\_ Instrument  
\_\_\_\_\_ Notes  
\_\_\_\_\_ Tape Read  
\_\_\_\_\_ Tape or Rod  
\_\_\_\_\_ Tape or Rod  
\_\_\_\_\_ Instrument No.  
\_\_\_\_\_ Tape No.

WEATHER

Clear \_\_\_\_\_  
Cloudy \_\_\_\_\_  
Windy \_\_\_\_\_  
Rain \_\_\_\_\_  
Fair \_\_\_\_\_  
Snow \_\_\_\_\_  
Hot \_\_\_\_\_  
Moderate \_\_\_\_\_  
Cold \_\_\_\_\_  
Fog \_\_\_\_\_

FILE No. \_\_\_\_\_

Fldr. No. \_\_\_\_\_

Figured By \_\_\_\_\_ Sheet 36

Notes Checked By \_\_\_\_\_

Plotted By \_\_\_\_\_ Date \_\_\_\_\_ 19\_\_

Quad. No. \_\_\_\_\_

Station	Dist.	Angle	+	H. I. Bearing	Ver. Ang. Diff.	Elevation
---------	-------	-------	---	---------------	-----------------	-----------

260	239	20	✓			
58	229	20	✓			

Edge Fairway

442	282	40	✓	} #18 Tee		
398	280	10	✓			
383	288	00	✓			
433	289	30	✓			
423	299	00				

Woods Line

PI#30

536	165	28 00	✓			
-----	-----	-------	---	--	--	--

243	213	20	✓	} Rain shed		
230	214	40	✓			
236	217	40	✓			

5-1934

14' x 14'

446	228	40	✓			
-----	-----	----	---	--	--	--

Woods Line

345	224	30	✓	} #17 green		
395	223	00	✓			
400	224	40	✓			
403	230	30	✓			
396	233	15	✓			
355	230	10	✓			

346	230	20	✓	} Sand trap		
323	231	30	✓			

T

PI#29

BS

PI#28

AVAILABLE

Return to  
Public Works  
Division  
C. and L. Harris  
North Carolina

SUBJECT

Station

Altitude

Barometric

Wind Dir. - Elevation

Time of Day

Type of Road

Notes

Instrument

FIELD PARTY

WEATHER

Clear  
Snow  
Hot  
Cloudy  
Windy  
Moderate  
Cold  
Fog  
Fair

Figures by

Notes Checked by

Plotted by

Quad No.

THE No.

Plan No.

Sheet

Date

RECEIVED  
PUBLIC WORKS DIVISION  
NORTH CAROLINA

VALUABLE

SUBJECT \_\_\_\_\_

Return To  
Public Works  
Office  
Camp Lejeune  
North Carolina

FIELD PARTY

\_\_\_\_\_ In Charge  
\_\_\_\_\_ Instrument  
\_\_\_\_\_ Notes  
\_\_\_\_\_ Tape Read  
\_\_\_\_\_ Tape or Rod  
\_\_\_\_\_ Instrument No. \_\_\_\_\_  
\_\_\_\_\_ Tape No. \_\_\_\_\_

WEATHER

Clear  
Cloudy  
Windy  
Rain  
Fair

Snow  
Hot  
Moderate  
Cold  
Fog

FILE No. \_\_\_\_\_

Fldr. No. \_\_\_\_\_

Sheet 37

Date \_\_\_\_\_ 19\_\_

Figured By \_\_\_\_\_  
Notes Checked By \_\_\_\_\_  
Plotted By \_\_\_\_\_

Quad. No. \_\_\_\_\_

Station	Dist.	Angle	+	H. I. Bearing	Ver. Ang. Diff.	Elevation
---------	-------	-------	---	---------------	-----------------	-----------

430	165	30	✓	} #18 green		
405	162	20	✓			
365	164	20	✓			
357	169	00	✓			
390	171	40	✓			
424	170	10	✓			

420	175	10	✓	} Sand Trap		
117	192	30	✓			
370	173	30	✓			
367	176	40	✓			

240 201 20

Edge Fairway

176	197	10	✓	} Sand trap		
202	191	45	✓			
189	183	30	✓			
160	185	00	✓			

123 103 10 ✓

Edge Fairway

542 141 18 30

463 162 50 ✓

126	178	30	✓	} Sand Trap		
136	171	10	✓			
129	156	50	✓			
100	159	40	✓			

PI# 30

PI# 29

BS



VALUABLE


SUBJECT

\_\_\_\_\_  
\_\_\_\_\_  
\_\_\_\_\_

FIELD PARTY

In Charge \_\_\_\_\_  
Instruments \_\_\_\_\_  
Notes \_\_\_\_\_  
Time \_\_\_\_\_  
Time on Job \_\_\_\_\_  
Time on Road \_\_\_\_\_  
Remarks \_\_\_\_\_  
Time \_\_\_\_\_

WEATHER

Clear \_\_\_\_\_  
Cloudy \_\_\_\_\_  
Windy \_\_\_\_\_  
Rain \_\_\_\_\_  
Snow \_\_\_\_\_  
Fog \_\_\_\_\_

FILE NO

\_\_\_\_\_

Grid No

\_\_\_\_\_

Station  
Dist  
Angle  
Bearing  
H.I.  
Vernier  
Dip

\_\_\_\_\_

REPRODUCTION PROHIBITED

VALUABLE

SUBJECT: \_\_\_\_\_

Return To  
Public Works  
Office  
Camp Lejeune  
North Carolina

FIELD PARTY

\_\_\_\_ In Charge  
\_\_\_\_ Instrument  
\_\_\_\_ Notes  
\_\_\_\_ Tape Read  
\_\_\_\_ Tape or Rod  
\_\_\_\_ Instrument No.  
\_\_\_\_ Tape No.

WEATHER

Clear \_\_\_\_\_  
Cloudy \_\_\_\_\_  
Windy \_\_\_\_\_  
Rain \_\_\_\_\_  
Fair \_\_\_\_\_  
Snow \_\_\_\_\_  
Hot \_\_\_\_\_  
Moderate \_\_\_\_\_  
Cold \_\_\_\_\_  
Fog \_\_\_\_\_  
Figured By \_\_\_\_\_  
Notes Checked By \_\_\_\_\_  
Plotted By \_\_\_\_\_

FILE No. \_\_\_\_\_

Fldr. No. \_\_\_\_\_

Sheet 38

Date \_\_\_\_\_ 19\_\_\_\_

Quad. No. \_\_\_\_\_

Station	Dist.	Angle	"	+	H. I. Bearing	Ver. Ang. Diff.	Elevation
---------	-------	-------	---	---	---------------	-----------------	-----------

185	175	20					
209	164	00					
212	149	00					
137	137	00					
110	174	00					

{ Circle dr. (16' pavement)

intersection of drive to Brewster Blvd.  
intersection of drive to Club House

intersection of drive to parking lot.

271	238	15					
210	198	30					
182	270	40					
61	200	00					

{ Asphalt Parking Lot

175	126	40					
118	121	56					
143	100	40					

{ Officers Club House

108	318	40	✓				
89	318	50	✓				
93	337	10	✓				

{ Rest shed

S-1901

28 x 10

PT#32

450	202	06.45	✓				
-----	-----	-------	---	--	--	--	--

368

Edge Fairway

345	160	30	✓				
351	156	00	✓				
373	156	10	✓				
376	159	50	✓				

{ Sand trap

π

PI#31

BS

PI#30

TABLED

SUBJECT

Return to  
Post Office  
Office  
Comptroller  
North Carolina


\_\_\_\_\_  
\_\_\_\_\_  
\_\_\_\_\_

FIELD PARTY  
Class \_\_\_\_\_  
to Class \_\_\_\_\_  
Instrument \_\_\_\_\_  
Notes \_\_\_\_\_  
Tape Head \_\_\_\_\_  
Type of Rod \_\_\_\_\_  
Stations on Rod \_\_\_\_\_  
Instrument No. \_\_\_\_\_  
Tape No. \_\_\_\_\_

WEATHER  
Clear \_\_\_\_\_  
Snow \_\_\_\_\_  
Rain \_\_\_\_\_  
Moonlight \_\_\_\_\_  
Wind \_\_\_\_\_  
Fog \_\_\_\_\_  
Thunder \_\_\_\_\_  
Lightning \_\_\_\_\_  
Other \_\_\_\_\_  
Remarks \_\_\_\_\_

FILE No. \_\_\_\_\_  
Date \_\_\_\_\_  
Sheet No. \_\_\_\_\_

Station \_\_\_\_\_ Dist. \_\_\_\_\_ Angle \_\_\_\_\_  
H.I. \_\_\_\_\_  
W.A.S. \_\_\_\_\_  
Elevation \_\_\_\_\_

 



VALUABLE

SUBJECT \_\_\_\_\_

Return To  
Public Works  
Office  
Camp Lejeune  
North Carolina

FIELD PARTY

\_\_\_\_\_ In Charge  
\_\_\_\_\_ Instrument  
\_\_\_\_\_ Notes  
\_\_\_\_\_ Tape Read  
\_\_\_\_\_ Tape or Rod  
\_\_\_\_\_ Tape or Rod  
\_\_\_\_\_ Instrument No.  
\_\_\_\_\_ Tape No.

WEATHER

Clear  
Cloudy  
Rain  
Fair  
Snow  
Hot  
Moderate  
Cold  
Fog

FILE No. \_\_\_\_\_

Fldr. No. \_\_\_\_\_

Sheet 39

Date \_\_\_\_\_ 19\_\_

Figured By \_\_\_\_\_  
Notes Checked By \_\_\_\_\_  
Plotted By \_\_\_\_\_

Quad. No. \_\_\_\_\_

Station	Dist.	Angle	+	H. I. Bearing	Ver: Ang. Diff.	Elevation
---------	-------	-------	---	---------------	-----------------	-----------

990 175 20

725 181 10

484 190 20

280 175 10

245 183 15

265 193 00

313 188 30

387 203 10

370 202 35

375 198 00

PJ#34

574 21 57 15

480 134 10

435 126 10

370 112 20

207 113 20

91 121 00

62 160 00

215 197 50

117 194 30

22 165 00

29 248 00

75 337 40

PJ#33

278 197 51 00

A

BS

Edge driving Range

" " "

{ Driving Range Tee

{ Driving Range Shed

1 Intersection drive + Brewster Blvd

2 E drive

3 E drive

4 E drive

5 E drive

6 E drive to Club House

7 intersection drive + Brewster Blvd

8 intersection drive to Parking Lot Officers Club + Club House

9 intersection drive to Officers Club + Club House

10 intersection drive to Parking Lot + drive to Club House

11 intersection drive + Parking Lot

PI#32

PJ#31

AVAILABLE


SUBJECT

Station Date + Angle H. T. Bearing Vol. and Elevation

FIELD PARTY

In Charge  
Instrument  
Notes  
Type Mark  
Line or Rod  
Type of Rod  
Number  
Type of

WEATHER

Clear  
Cloudy  
Wind  
Rain  
Fog  
Thunder  
Notes Checked by  
Checked by

FIELD NO.


DATE

BY

DATE

FIELD NO.


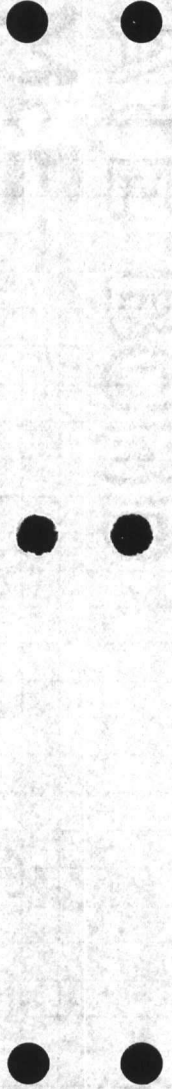

VALUABLE

SUBJECT \_\_\_\_\_

Return To  
Public Works  
Office  
Camp Lejeune  
North Carolina

FIELD PARTY

\_\_\_\_\_ In Charge  
\_\_\_\_\_ Instrument  
\_\_\_\_\_ Notes  
\_\_\_\_\_ Tape Read  
\_\_\_\_\_ Tape or Rod  
\_\_\_\_\_ Tape or Rod  
\_\_\_\_\_ Instrument No.  
\_\_\_\_\_ Tape No.

WEATHER

Clear  
Cloudy  
Windy  
Rain  
Fair

Snow  
Hot  
Moderate  
Cold  
Fog

FILE No. \_\_\_\_\_

Fldr. No. \_\_\_\_\_

Sheet 40

Figured By \_\_\_\_\_

Notes Checked By \_\_\_\_\_

Plotted By \_\_\_\_\_

Date \_\_\_\_\_ 19\_\_

Quad. No. \_\_\_\_\_

Station	Dist.	Angle	+	H. I. Bearing	Ver. Ang. Diff.	Elevation
<i>PT#35</i>						
612	292	1760	5			
218	158	40	4			
255	158	30	3			
275	174	10	2			
245	178	40	1			
<i>Practice Approach tree</i>						
493	158	15	4			
490	160	15	3			
460	160	30	4			
458	158	00	1			
<i>Sand trap</i>						
445	156	106				
475	157	40	5			
505	157	40	4			
572	154	40	3			
480	153	10	2			
460	152	50	1			
<i>Practice Approach green</i>						
473	150	10	4			
470	152	40	3			
495	152	40	2			
500	151	30	1			
<i>Sand trap</i>						
232	150	40	4			
660	149	00	2			
999	147	50	2			
1000	139	50	1			
<i>Edge Driving Range</i>						

T  
BS

PT#34  
PT#33



VALUABLE

Return To  
Public Works  
Office  
Camp Lejeune  
North Carolina

SUBJECT

\_\_\_\_\_  
\_\_\_\_\_  
\_\_\_\_\_

Station

Dial

Angle

Ht

Bearing

Var. Ang.  
Dir.

Elevation

Instrument No.  
Tape No.

Take of Rod

Take of Rod

Instrument

in Charge

FIELD PARTY

WEATHER

Clear  
Cloudy  
Fog  
Mist  
Rain  
Snow  
Thunder  
Windy  
Mist  
Fog

Plotted BY

Checked BY

Checked BY

FIELD NO.

PLA. No.

Station

Date

FIELD NO.

FIELD NO. 1000

VALUABLE

SUBJECT \_\_\_\_\_

Return To  
Public Works  
Office  
Camp Lejeune  
North Carolina

FIELD PARTY

\_\_\_\_\_ In Charge  
\_\_\_\_\_ Instrument  
\_\_\_\_\_ Notes  
\_\_\_\_\_ Tape Read  
\_\_\_\_\_ Tape or Rod  
\_\_\_\_\_ Instrument No.  
\_\_\_\_\_ Tape No.

WEATHER

Clear  
Cloudy  
Windy  
Rain  
Fair

Snow  
Hot  
Moderate  
Cold  
Fog

FILE No. \_\_\_\_\_

Fldr. No. \_\_\_\_\_

Sheet 41

Figured By \_\_\_\_\_  
Notes Checked By \_\_\_\_\_  
Plotted By \_\_\_\_\_

Date \_\_\_\_\_ 19\_\_\_\_

Quad. No. \_\_\_\_\_

Station	Dist.	Angle	+	H. I. Bearing	Ver: Ang. Diff.	Elevation
---------	-------	-------	---	------------------	--------------------	-----------

Mon

277 19 00

Elevated Water Tank

Mon.

365 268 11 15

USMC #71

PI#37

530 181 54 30

PI#36

623 176 41 15

X

PI#35

BS

PI#34

*[Faint, mostly illegible text and markings at the top of the page, possibly bleed-through from another page.]*

W 353,560  
 E 2,484,706

4-24  
 5-24  
 6-24

N 3,57,224.94  
 E 2,483,881.01




900-304

5117211



**VALUABLE**

SUBJECT \_\_\_\_\_

RETURN TO  
PUBLIC WORKS  
OFFICE  
CAMP LEJEUNE  
NORTH CAROLINA

27  
518  
100  
68  
32

**FIELD PARTY**

\_\_\_\_\_  
IN CHARGE  
\_\_\_\_\_  
INSTRUMENT  
\_\_\_\_\_  
NOTES  
\_\_\_\_\_  
TAPE READ  
\_\_\_\_\_  
TAPE OR ROD  
\_\_\_\_\_  
TAPE OR ROD  
\_\_\_\_\_  
INSTRUMENT NO.  
\_\_\_\_\_  
TAPE NO.

**WEATHER**

\_\_\_\_\_  
CLEAR  
\_\_\_\_\_  
CLOUDY  
\_\_\_\_\_  
WINDY  
\_\_\_\_\_  
RAIN  
\_\_\_\_\_  
FAIR  
\_\_\_\_\_  
SNOW  
\_\_\_\_\_  
HOT  
\_\_\_\_\_  
MODERATE  
\_\_\_\_\_  
COLD  
\_\_\_\_\_  
FOG

FILE No. 11960

FLDR. No. \_\_\_\_\_


FIGURED BY \_\_\_\_\_ SHEET 150F

NOTES CHECKED BY \_\_\_\_\_

PLOTTED BY \_\_\_\_\_ DATE \_\_\_\_\_ 19\_\_


Quad. No. \_\_\_\_\_

STATION	DIST.	ANGLE	H. I.	VER. ANG.	ELEVATION
		° ' "	BEARING	DIFF.	

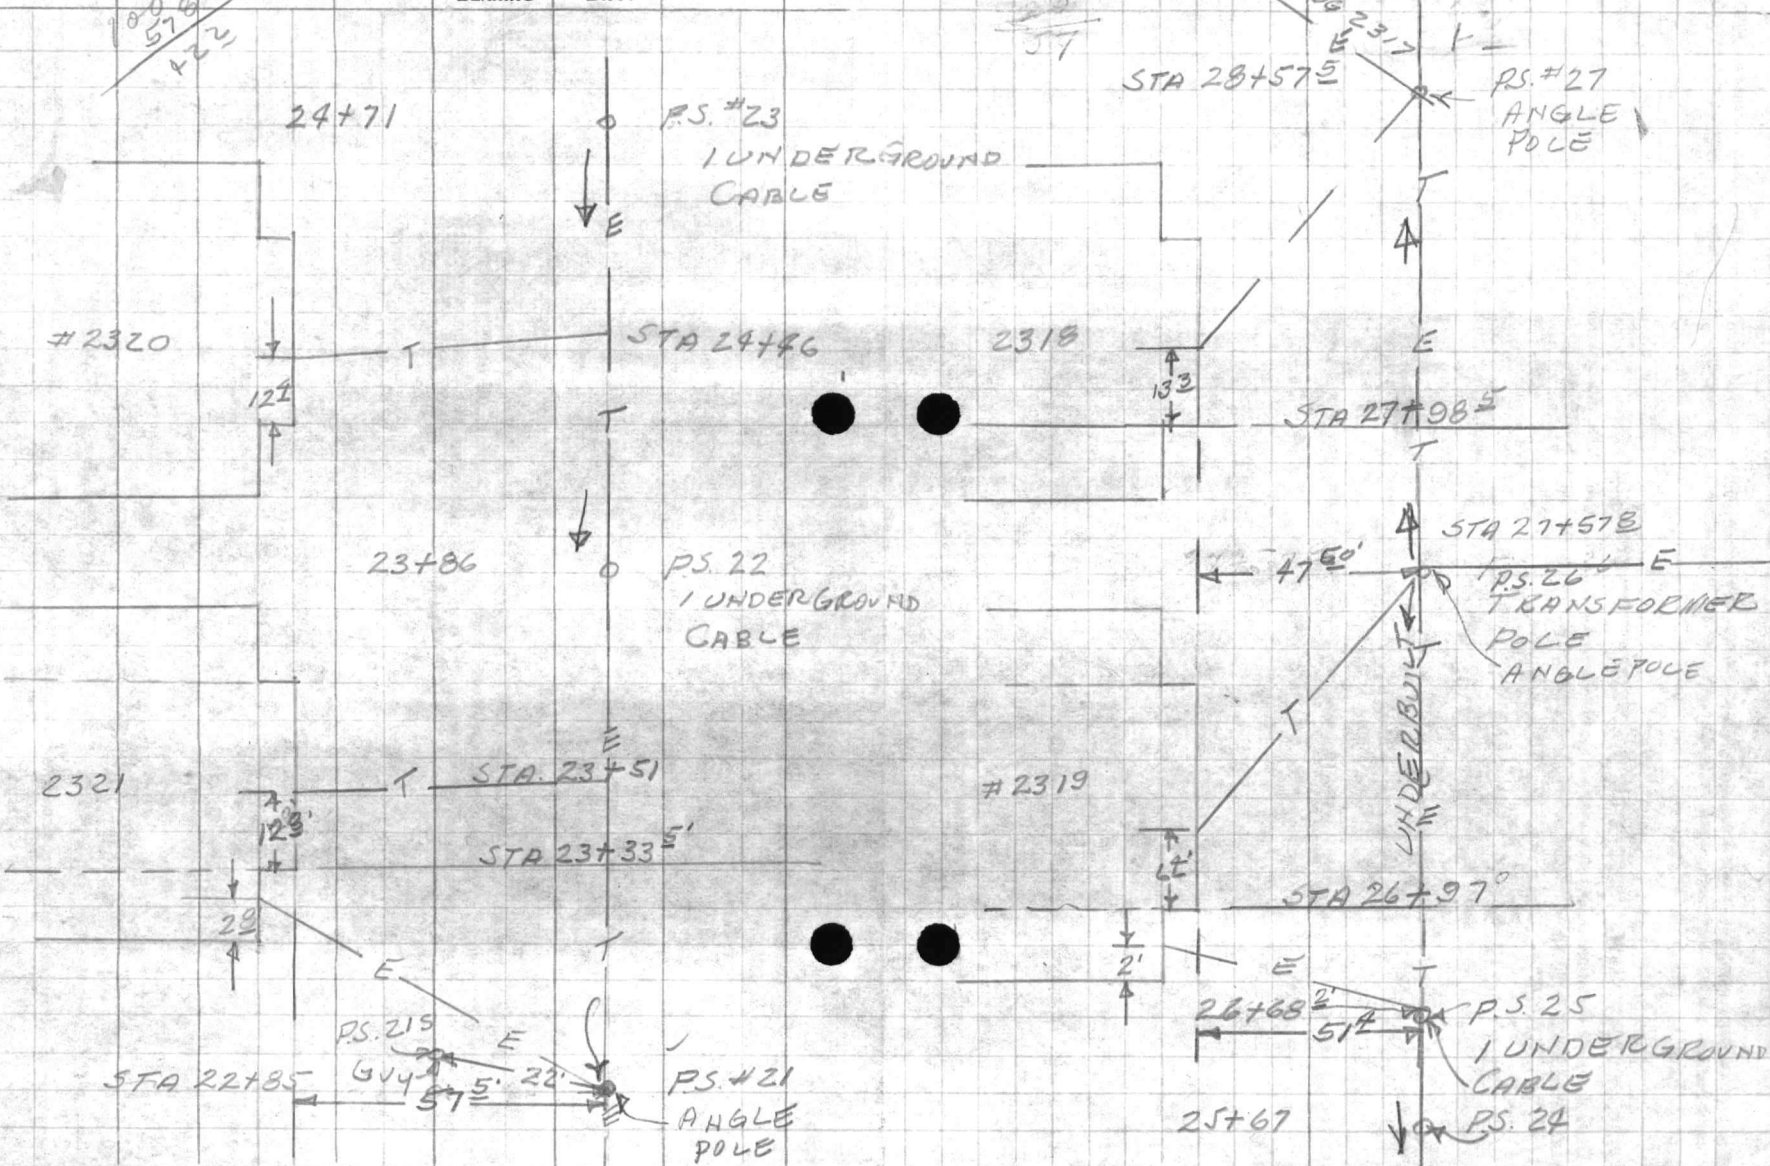



 

VALUABLE

SUBJECT \_\_\_\_\_

RETURN TO  
PUBLIC WORKS  
OFFICE  
CAMP LEJEUNE  
NORTH CAROLINA

FIELD PARTY

\_\_\_\_\_  
IN CHARGE  
\_\_\_\_\_  
INSTRUMENT  
\_\_\_\_\_  
NOTES  
\_\_\_\_\_  
TAPE READ  
\_\_\_\_\_  
TAPE OR ROD  
\_\_\_\_\_  
TAPE OR ROD  
\_\_\_\_\_  
INSTRUMENT NO.  
\_\_\_\_\_  
TAPE NO.

WEATHER

CLEAR  
CLOUDY  
WINDY  
RAIN  
FAIR  
SNOW  
HOT  
MODERATE  
COLD  
FOG

FILE No. \_\_\_\_\_

FLDR. No. \_\_\_\_\_


FIGURED BY \_\_\_\_\_ SHEET 15-A

NOTES CHECKED BY \_\_\_\_\_

PLOTTED BY \_\_\_\_\_ DATE \_\_\_\_\_ 19\_\_

Quad. No. \_\_\_\_\_

STATION	DIST.	ANGLE " "	+	H. I. BEARING	VER. ANG. DIFF.	ELEVATION
---------	-------	--------------	---	------------------	--------------------	-----------

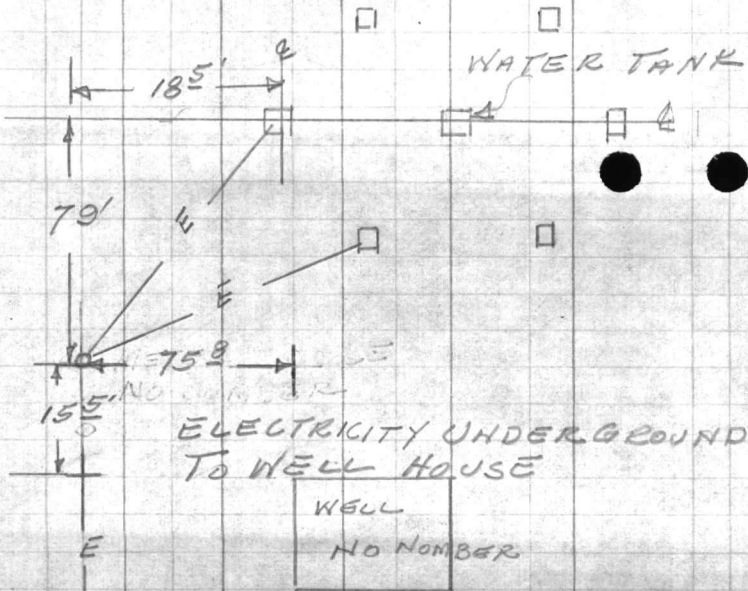

3+0920

1+54.5

STA. 27+572 MAINLINE

E 0+00 LATERAL TO WELL HOUSE

PS. 26








**VALUABLE**

SUBJECT \_\_\_\_\_  
\_\_\_\_\_  
\_\_\_\_\_  
RETURN TO  
PUBLIC WORKS  
OFFICE  
CAMP LEJEUNE  
NORTH CAROLINA

**FIELD PARTY**

\_\_\_\_\_  
IN CHARGE  
\_\_\_\_\_  
INSTRUMENT  
\_\_\_\_\_  
NOTES  
\_\_\_\_\_  
TAPE READ  
\_\_\_\_\_  
TAPE OR ROD  
\_\_\_\_\_  
TAPE OR ROD  
\_\_\_\_\_  
INSTRUMENT NO.  
\_\_\_\_\_  
TAPE NO.


**WEATHER**

\_\_\_\_\_  
CLEAR  
\_\_\_\_\_  
CLOUDY  
\_\_\_\_\_  
WINDY  
\_\_\_\_\_  
RAIN  
\_\_\_\_\_  
FAIR  
\_\_\_\_\_  
SNOW  
\_\_\_\_\_  
HOT  
\_\_\_\_\_  
MODERATE  
\_\_\_\_\_  
COLD  
\_\_\_\_\_  
FOG

FILE No. \_\_\_\_\_  
FLDR. No. \_\_\_\_\_  
SHEET 160F  
FIGURED BY \_\_\_\_\_  
NOTES CHECKED BY \_\_\_\_\_  
PLOTTED BY \_\_\_\_\_ DATE \_\_\_\_\_ 19\_\_


Quad. No. \_\_\_\_\_

STATION	DIST.	ANGLE " +	H. I. BEARING	VER. ANG. DIFF.	ELEVATION
---------	-------	--------------	------------------	--------------------	-----------

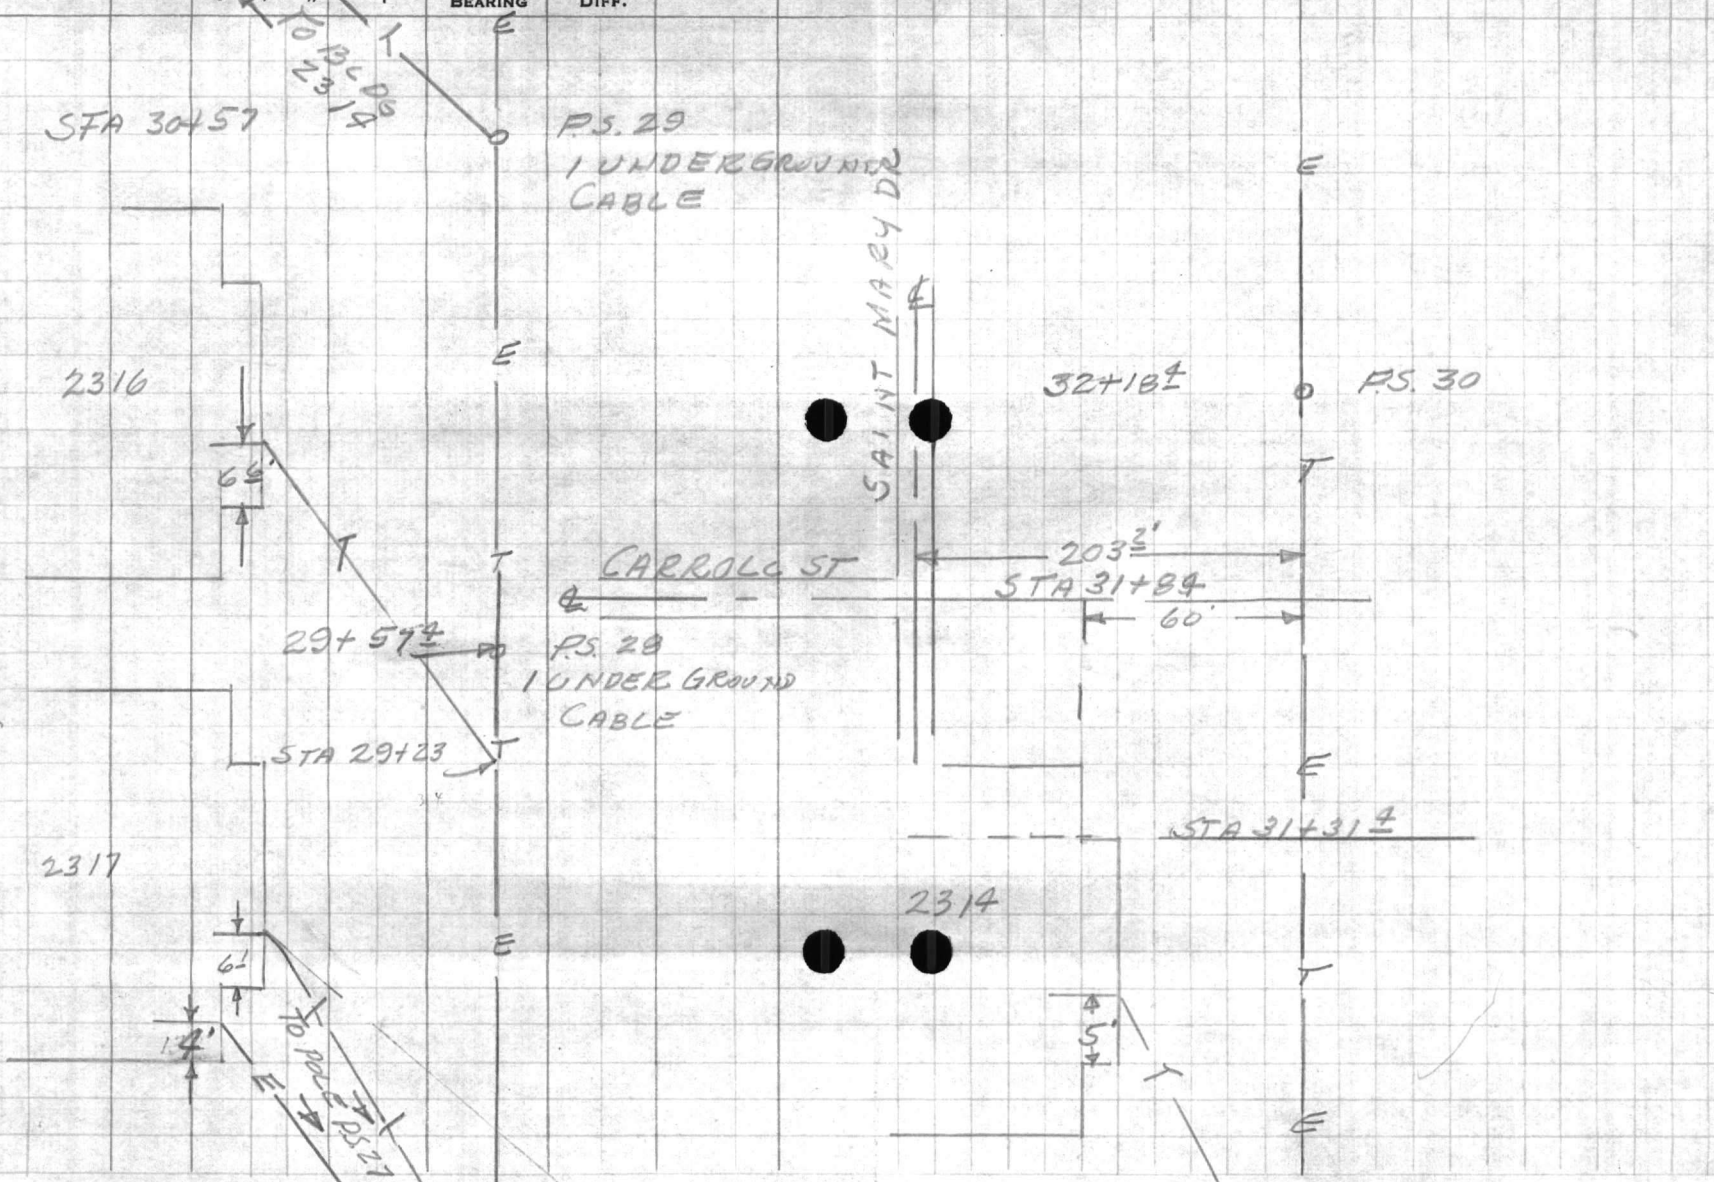



 



**VALUABLE**

SUBJECT \_\_\_\_\_

RETURN TO  
PUBLIC WORKS  
OFFICE  
CAMP LEJEUNE  
NORTH CAROLINA

**FIELD PARTY**

\_\_\_\_\_  
IN CHARGE  
\_\_\_\_\_  
INSTRUMENT  
\_\_\_\_\_  
NOTES  
\_\_\_\_\_  
TAPE READ  
\_\_\_\_\_  
TAPE OR ROD  
\_\_\_\_\_  
TAPE OR ROD  
\_\_\_\_\_  
INSTRUMENT NO.  
\_\_\_\_\_  
TAPE NO.

**WEATHER**

\_\_\_\_\_  
CLEAR  
\_\_\_\_\_  
CLOUDY  
\_\_\_\_\_  
WINDY  
\_\_\_\_\_  
RAIN  
\_\_\_\_\_  
FAIR  
\_\_\_\_\_  
SNOW  
\_\_\_\_\_  
HOT  
\_\_\_\_\_  
MODERATE  
\_\_\_\_\_  
COLD  
\_\_\_\_\_  
FOG

FILE No. \_\_\_\_\_


FLDR. No. \_\_\_\_\_

SHEET 170F

DATE 7.2.19

Quad. No. \_\_\_\_\_

STATION	DIST.	ANGLE ° ' "	H. I. BEARING	VER. ANG. DIFF.	ELEVATION
---------	-------	----------------	------------------	--------------------	-----------

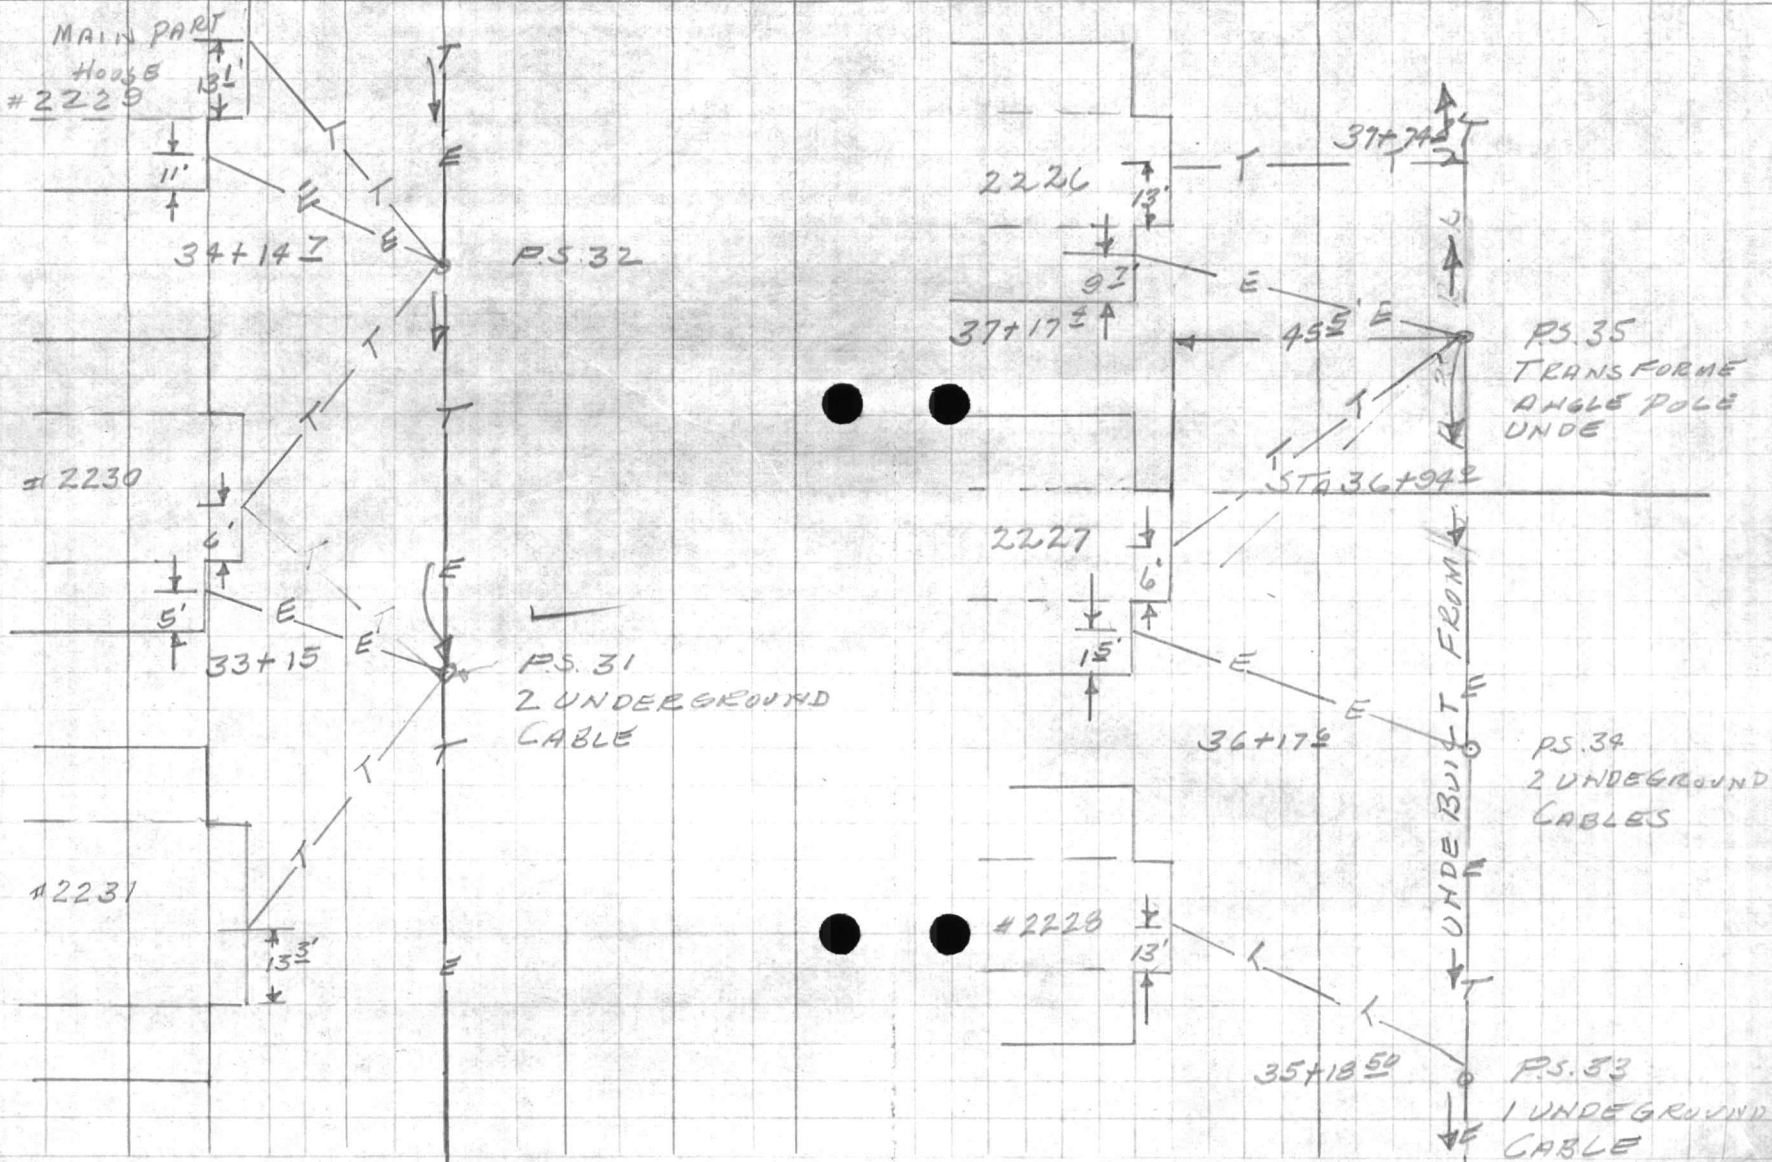








**VALUABLE**

SUBJECT \_\_\_\_\_  
\_\_\_\_\_  
\_\_\_\_\_  
RETURN TO  
PUBLIC WORKS  
OFFICE  
CAMP LEJEUNE  
NORTH CAROLINA

**FIELD PARTY**

\_\_\_\_\_  
IN CHARGE  
\_\_\_\_\_  
INSTRUMENT  
\_\_\_\_\_  
NOTES  
\_\_\_\_\_  
TAPE READ  
\_\_\_\_\_  
TAPE OR ROD  
\_\_\_\_\_  
TAPE OR ROD  
\_\_\_\_\_  
INSTRUMENT NO.  
\_\_\_\_\_  
TAPE NO.

**WEATHER**

\_\_\_\_\_  
CLEAR  
\_\_\_\_\_  
CLOUDY  
\_\_\_\_\_  
WINDY  
\_\_\_\_\_  
RAIN  
\_\_\_\_\_  
FAIR  
\_\_\_\_\_  
SNOW  
\_\_\_\_\_  
HOT  
\_\_\_\_\_  
MODERATE  
\_\_\_\_\_  
COLD  
\_\_\_\_\_  
FOG

FILE No. \_\_\_\_\_


FLDR. No. \_\_\_\_\_

SHEET 18 OF

FIGURED BY \_\_\_\_\_ NOTES CHECKED BY \_\_\_\_\_

PLOTTED BY \_\_\_\_\_ DATE \_\_\_\_\_ 19\_\_

Quad. No. \_\_\_\_\_

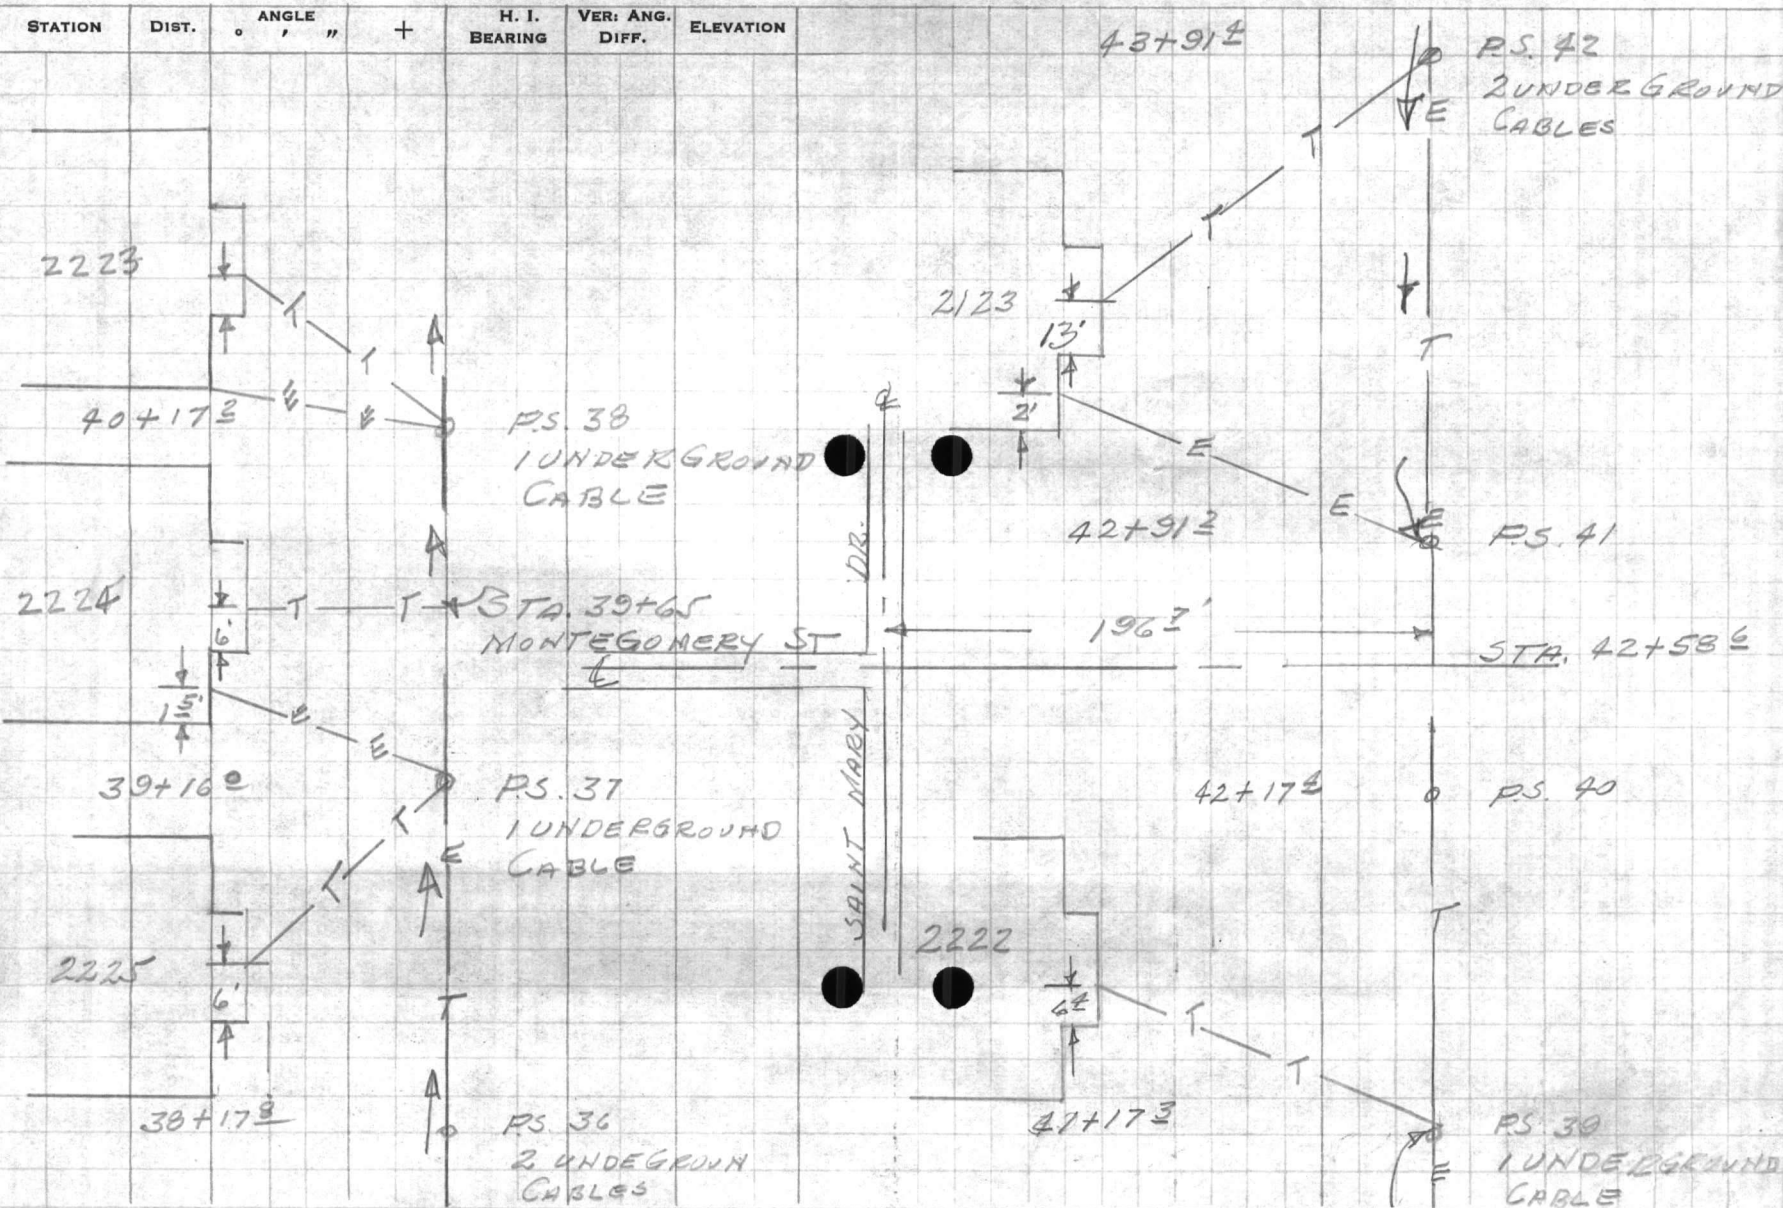





**VALUABLE**

SUBJECT \_\_\_\_\_  
 \_\_\_\_\_  
 \_\_\_\_\_  
 \_\_\_\_\_

RETURN TO  
 PUBLIC WORKS  
 OFFICE  
 CAMP LEJEUNE  
 NORTH CAROLINA

**FIELD PARTY**

\_\_\_\_\_  
 IN CHARGE  
 \_\_\_\_\_  
 INSTRUMENT  
 \_\_\_\_\_  
 NOTES  
 \_\_\_\_\_  
 TAPE READ  
 \_\_\_\_\_  
 TAPE OR ROD  
 \_\_\_\_\_  
 TAPE OR ROD  
 \_\_\_\_\_  
 INSTRUMENT No. \_\_\_\_\_  
 TAPE No. \_\_\_\_\_

**WEATHER**

CLEAR  
 CLOUDY  
 WINDY  
 RAIN  
 FAIR

SNOW  
 HOT  
 MODERATE  
 COLD  
 FOG

FILE No. \_\_\_\_\_  
 FLDR. No. \_\_\_\_\_  
 SHEET 19 OF \_\_\_\_\_  
 DATE \_\_\_\_\_ 19\_\_

Quad. No. \_\_\_\_\_

STATION	DIST.	ANGLE		+	H. I. BEARING	VER: ANG. DIFF.	ELEVATION
		°	"				

