

VALUABLE

SUBJECT AS BUILT WATER LINE
LOCATION AT COURT
HOUSE B27

RETURN TO
PUBLIC WORKS
OFFICE
CAMP LEJEUNE
NORTH CAROLINA


FIELD PARTY
Kellum IN CHARGE
INSTRUMENT _____
NOTES _____
TAPE READ _____
TAPE OR ROD _____
TAPE OR ROD _____
INSTRUMENT NO. _____
TAPE NO. _____

WEATHER
CLEAR _____
CLOUDY _____
WINDY _____
RAIN _____
FAIR _____
SNOW _____
HOT _____
MODERATE _____
COLD _____
FOG _____
FIGURED BY _____
NOTES CHECKED BY _____
PLOTTED BY _____

FILE No. 220-F
FLDR. No. _____
SHEET 1 of _____
DATE 7-18 1960

Quad. No. _____

STATION	DIST.	ANGLE ° ' "	H. I. BEARING	VER. ANG. DIFF.	ELEVATION
---------	-------	----------------	------------------	--------------------	-----------

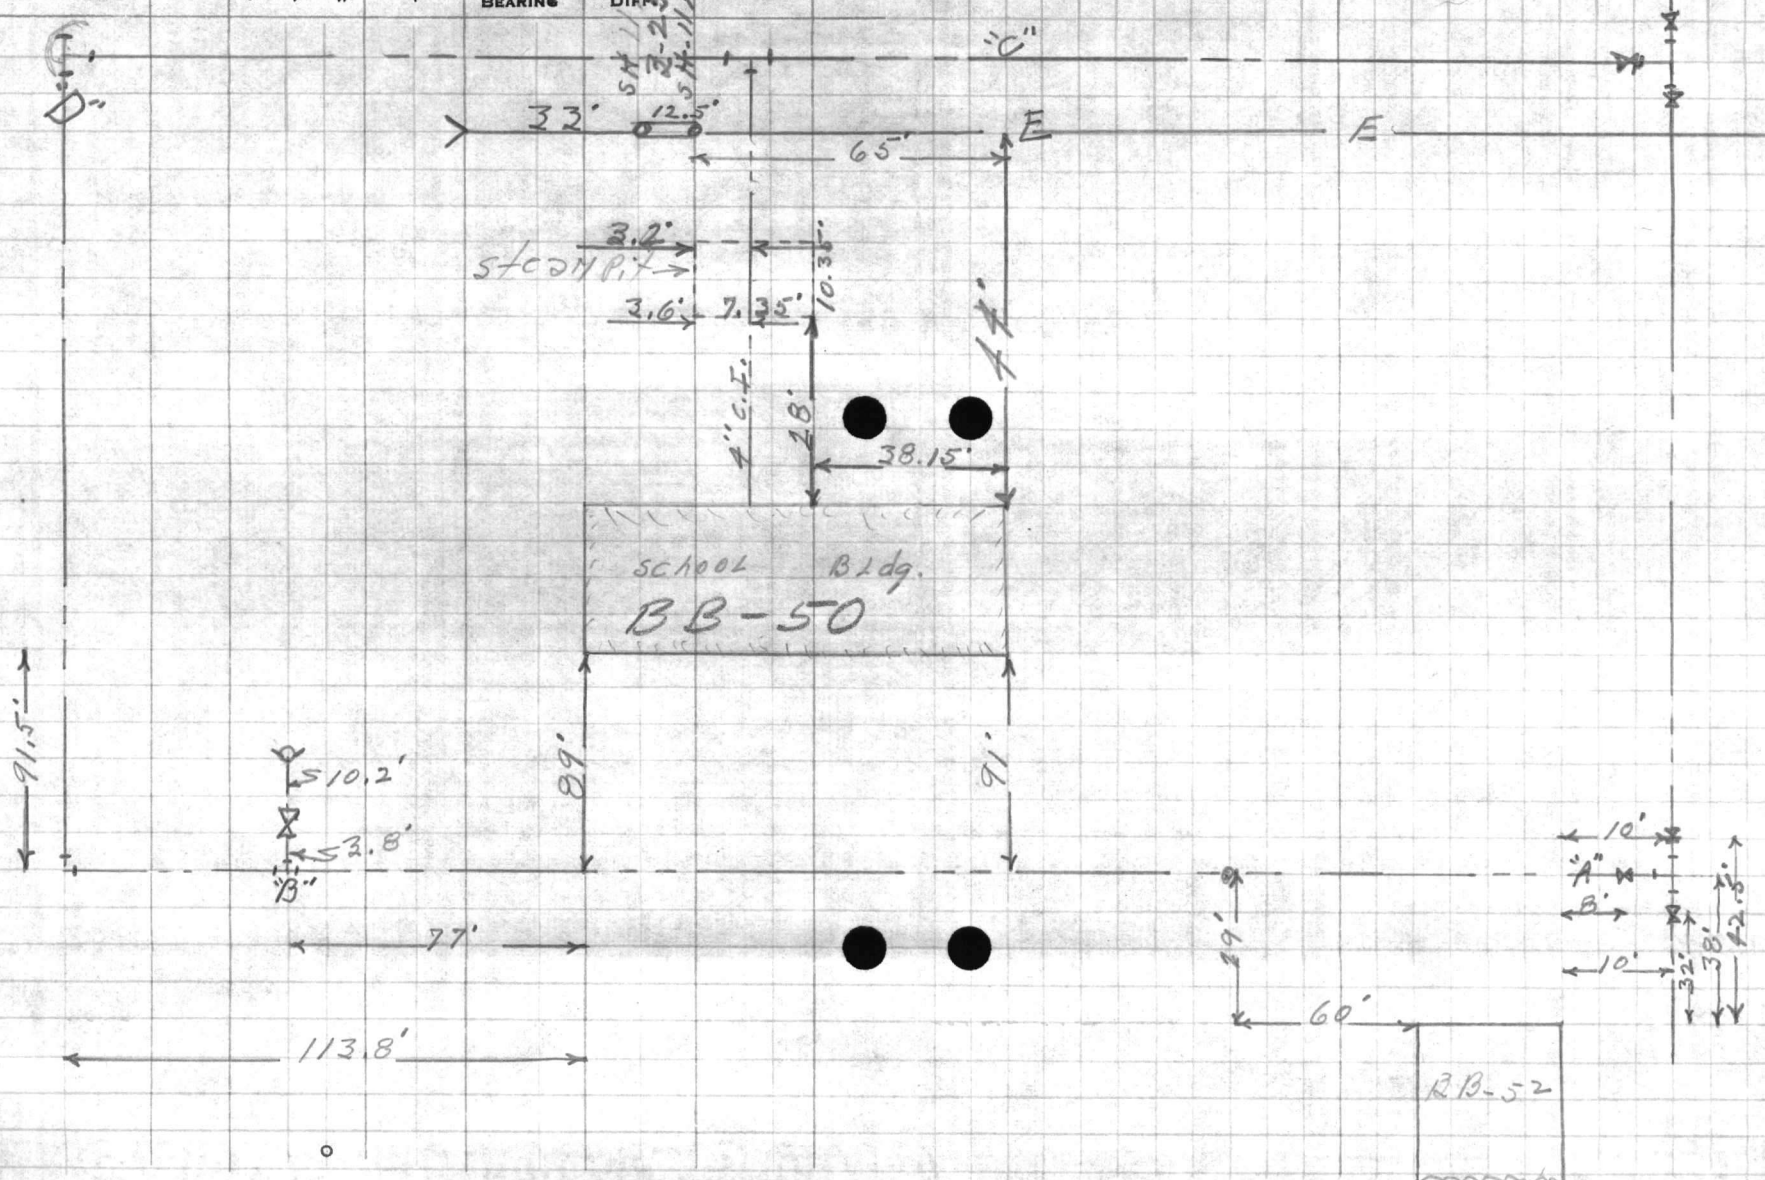






















VALUABLE

SUBJECT

water 2 ino loci
contd.RETURN TO
PUBLIC WORKS
OFFICE
CAMP LEJEUNE
NORTH CAROLINA

FIELD PARTY

IN CHARGE

INSTRUMENT

NOTES

TAPE READ

TAPE OR ROD

TAPE OR ROD

INSTRUMENT NO.

TAPE NO.

WEATHER

CLEAR _____ SNOW _____
CLOUDY _____ HOT _____
WINDY _____ MODERATE _____
RAIN _____ COLD _____
FAIR _____ FOG _____7.50
2.7
FILE No. 58

FLDR. No. _____

FIGURED BY _____

SHEET 2 of

NOTES CHECKED BY _____

PLOTTED BY _____

DATE 7-14-1960

Quad. No. _____

STATION	DIST.	ANGLE ' "	+	H. I. BEARING	VER. ANG. DIFF.	ELEVATION
R.M.				0.43 29.25		28.82
					1.8 24.5-	
					9.62 20.63	
T.P.				6.80 23.45		
				2.39 25.84		
					4.68 21.16	
					12.55 13.29	

Nail in Transformer Pole

Top of 8" W.L. AT "A" see sheet #1

" " " " " " " "B"

Top of 8" C.I. AT "C"

Top of 6" C.I. AT "D"

VALUABLE

RETURN TO
FIELD WORK
OFFICE










VALUABLE

SUBJECT

U.S. Tel. Cable and Water Lines
Courthouse Bay

See other sheets

Dated 7/14/60

RETURN TO
PUBLIC WORKS
OFFICE
CAMP LEJEUNE
NORTH CAROLINA

FIELD PARTY

Dillon IN CHARGE
INSTRUMENT
NOTES
TAPE READ
TAPE OR ROD
TAPE OR ROD
INSTRUMENT NO.
TAPE NO.

WEATHER

CLEAR
CLOUDY
WINDY
RAIN
FAIR
SNOW
HOT
MODERATE
COLD
FOG

FILE No. 220-F
FLDR. No.
SHEET
DATE 7/13/1960

Quad. No.

STATION DIST. ANGLE ° ' " + H. I. BEARING VER. ANG. DIFF. ELEVATION

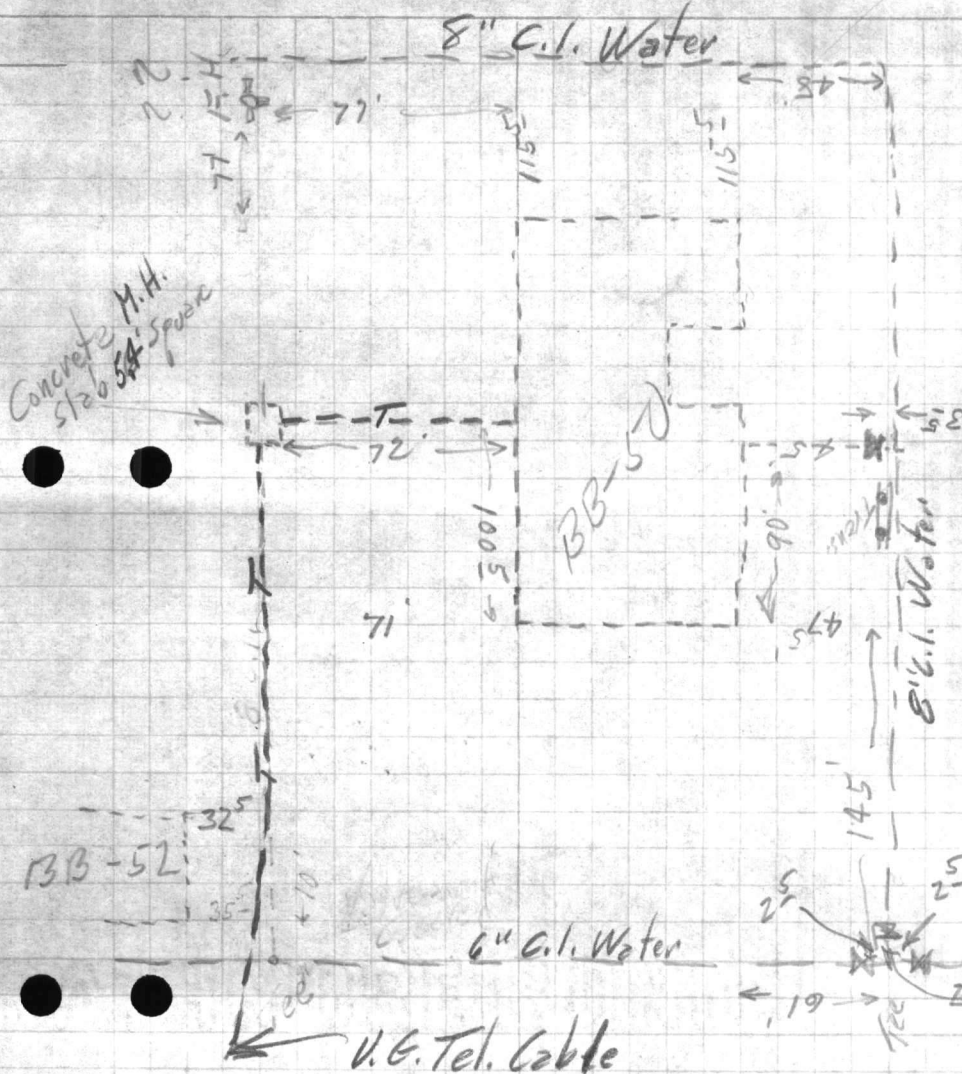









VALUABLE

RETURN TO
PUBLIC WORKS
OFFICE
CAMP LEJEUNE
NORTH CAROLINA

SUBJECT

AD 117
AD 118
1213-29

FIELD PARTY

IN CHARGE

INSTRUMENT

NOTES

TAPE READ

TAPE OR ROD

TAPE OR ROD

INSTRUMENT NO.

TAPE NO.

WEATHER

CLEAR

CLOUDY

WINDY

RAIN

FAIR

SNOW

HOT


MODERATE

COLD

FOG

FILE No. 220-F
FLDR. No. _____
SHEET _____
DATE 12-7 1959
FIGURED BY _____
NOTES CHECKED BY _____
PLOTTED BY _____
Quad. No. _____

Marines Rd.
TO S.F. Rd.

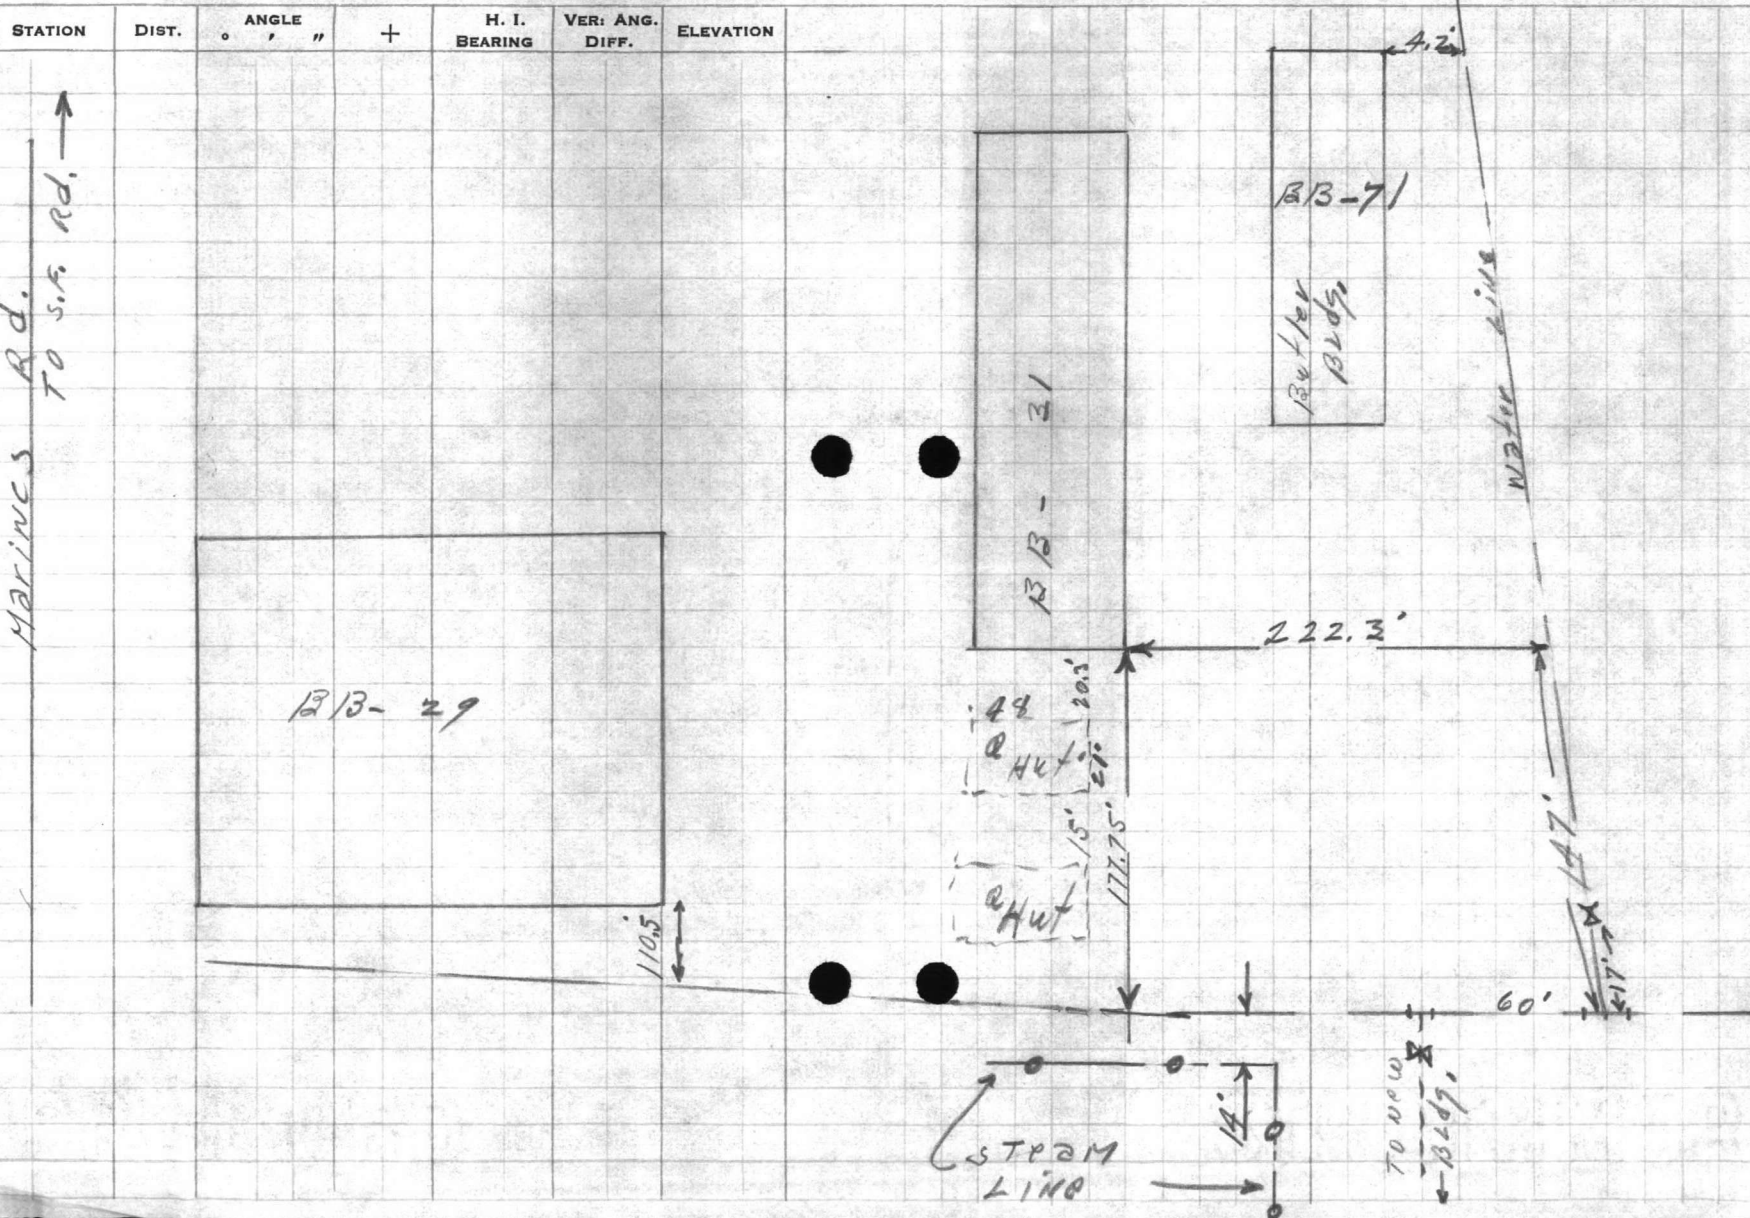

STREAM
LINE

TO NEW
Bldg.








VALUABLE

SUBJECT BENCH MARK FOR
WELL SITE T-20 N.E. OF BLDG.
#52 COURT HOUSE BAY

RETURN TO
 PUBLIC WORKS
 OFFICE
 CAMP LEJEUNE
 NORTH CAROLINA

FIELD PARTY
DENNIS IN CHARGE
 _____ INSTRUMENT
 _____ NOTES
 _____ TAPE READ
 _____ TAPE OR ROD
 _____ TAPE OR ROD
 _____ INSTRUMENT NO.
 _____ TAPE NO.

WEATHER
 CLEAR SNOW
 CLOUDY HOT
 WINDY MODERATE
 RAIN COLD
 FAIR FOG
 FIGURED BY _____
 NOTES CHECKED BY _____
 PLOTTED BY _____

FILE No. 220-F
 FLDR. No. _____
 SHEET 1 of 1
 DATE 11-A 1958

Quad. No. _____

STATION	DIST.	ANGLE ° ' "	+	H. I. BEARING	VER. ANG. DIFF.	ELEVATION	
B.m				5 26 34.08		28.82	For Well T-21 2 NAILS IN P.P.# S-H-12 NEAR N. COR. BLDG.# B-B-51
				7 13 40 34 ✓	0 87	33.21 ✓	
B.m.				2 06 40 22 ✓	2 18	38.16 ✓	SPIKE IN 8" PINE 30' LT. FROM & DIRT RD. For Well T-20
				1 08 34 63 ✓	6 67	33.55 ✓	
B.m.				5 80		28.83	(28.82) ON P.P.# S-H-12

VALUABLE

SUBJECT

RETURN TO
PUBLIC WORKS



























VALUABLE

RETURN TO
PUBLIC WORKS
OFFICE
CAMP LEJEUNE
NORTH CAROLINA

SUBJECT

Existing water line
Loc. on proposed steady
LINE AT C.H. Bay

FIELD PARTY

Kellum IN CHARGE

INSTRUMENT

NOTES

TAPE READ

TAPE OR ROD

TAPE OR ROD

INSTRUMENT No.

TAPE No.

WEATHER

CLEAR
CLOUDY
WINDY
RAIN
FAIR

SNOW
HOT
MODERATE
COLD
FOG

FIGURED BY

NOTES CHECKED BY

PLOTTED BY

FILE No. 220-F

FLDR. No.

SHEET

DATE

1-of 1

6-7 1956

Quad. No.

STATION	DIST.	ANGLE " "	+	H. I. BEARING	VER: ANG. DIFF.	ELEVATION
						17+42.5 66 18108.5
						Top of valve 0.8' Below top of ground
						Exist. water line
						0.8'
						17+42.5 Elev. top of pipe of 20.33
						Top of water line 4.37 Below ground AT STA. 17+42.5
						17+0
						24.70 4.37 20.33
						Proposed steady line
						Exist. water line







 

VALUABLE

RETURN TO
PUBLIC WORKS
OFFICE
CAMP LEJEUNE
NORTH CAROLINA

SUBJECT Test Boring, Diesel Oil Storage
Court House Bay

FIELD PARTY

Kellum IN CHARGE
INSTRUMENT _____
NOTES _____
TAPE READ _____
TAPE OR ROD _____
TAPE OR ROD _____
INSTRUMENT NO. _____
TAPE NO. _____

WEATHER

CLEAR _____ SNOW _____
CLOUDY _____ HOT _____
WINDY _____ MODERATE _____
RAIN _____ COLD _____
FAIR _____ FOG _____

FILE No. 220-F

FLDR. No. _____

SHEET 1 of 1


DATE 1/30 1953

FIGURED BY _____
NOTES CHECKED BY _____
PLOTTED BY _____

Quad. No. _____

STATION	DIST.	ANGLE		+	H. I. BEARING	VER. ANG. DIFF.	ELEVATION
		°	"				

Bldg 88.52

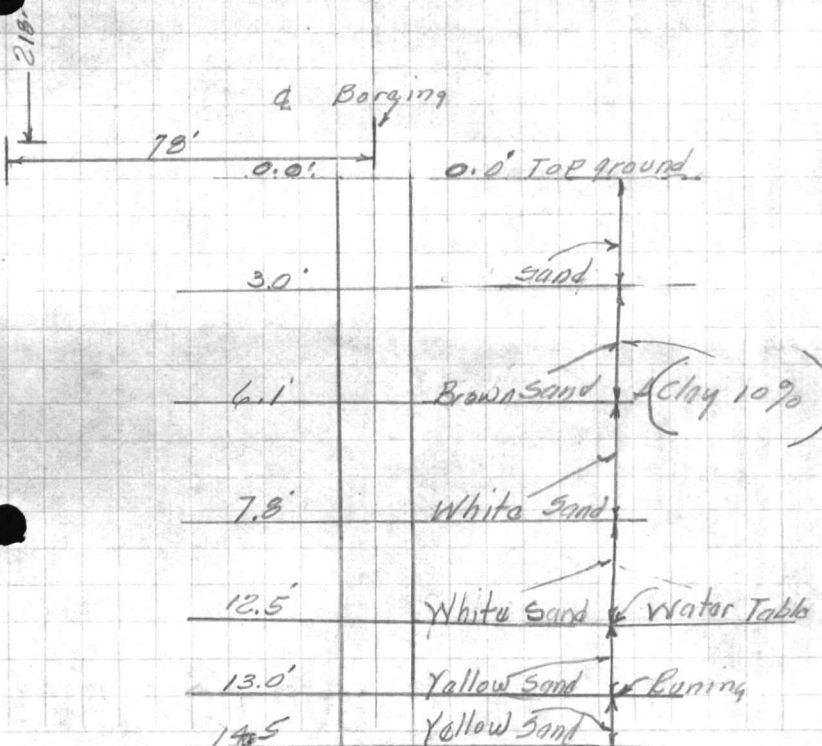

VALUABLE



























VALUABLE

SUBJECT WATER LINE LOCATION
AT COURT HOUSE BAY.


Return To
Public Works
Office
Camp Lejeune
North Carolina

FIELD PARTY
KELLMAN In Charge
Instrument _____
Notes _____
Tape Read _____
Tape or Rod _____
Tape or Rod _____
Instrument No. _____
Tape No. _____

WEATHER
Clear _____
Cloudy _____
Windy _____
Rain _____
Fair _____
Snow _____
Hot _____
Moderate _____
Cold _____
Fog _____
Figured By _____
Notes Checked By _____
Plotted By _____

FILE No. 220-F
Fldr. No. _____
Sheet 1-01-5
Date 2-17-1917

Quad. No. _____

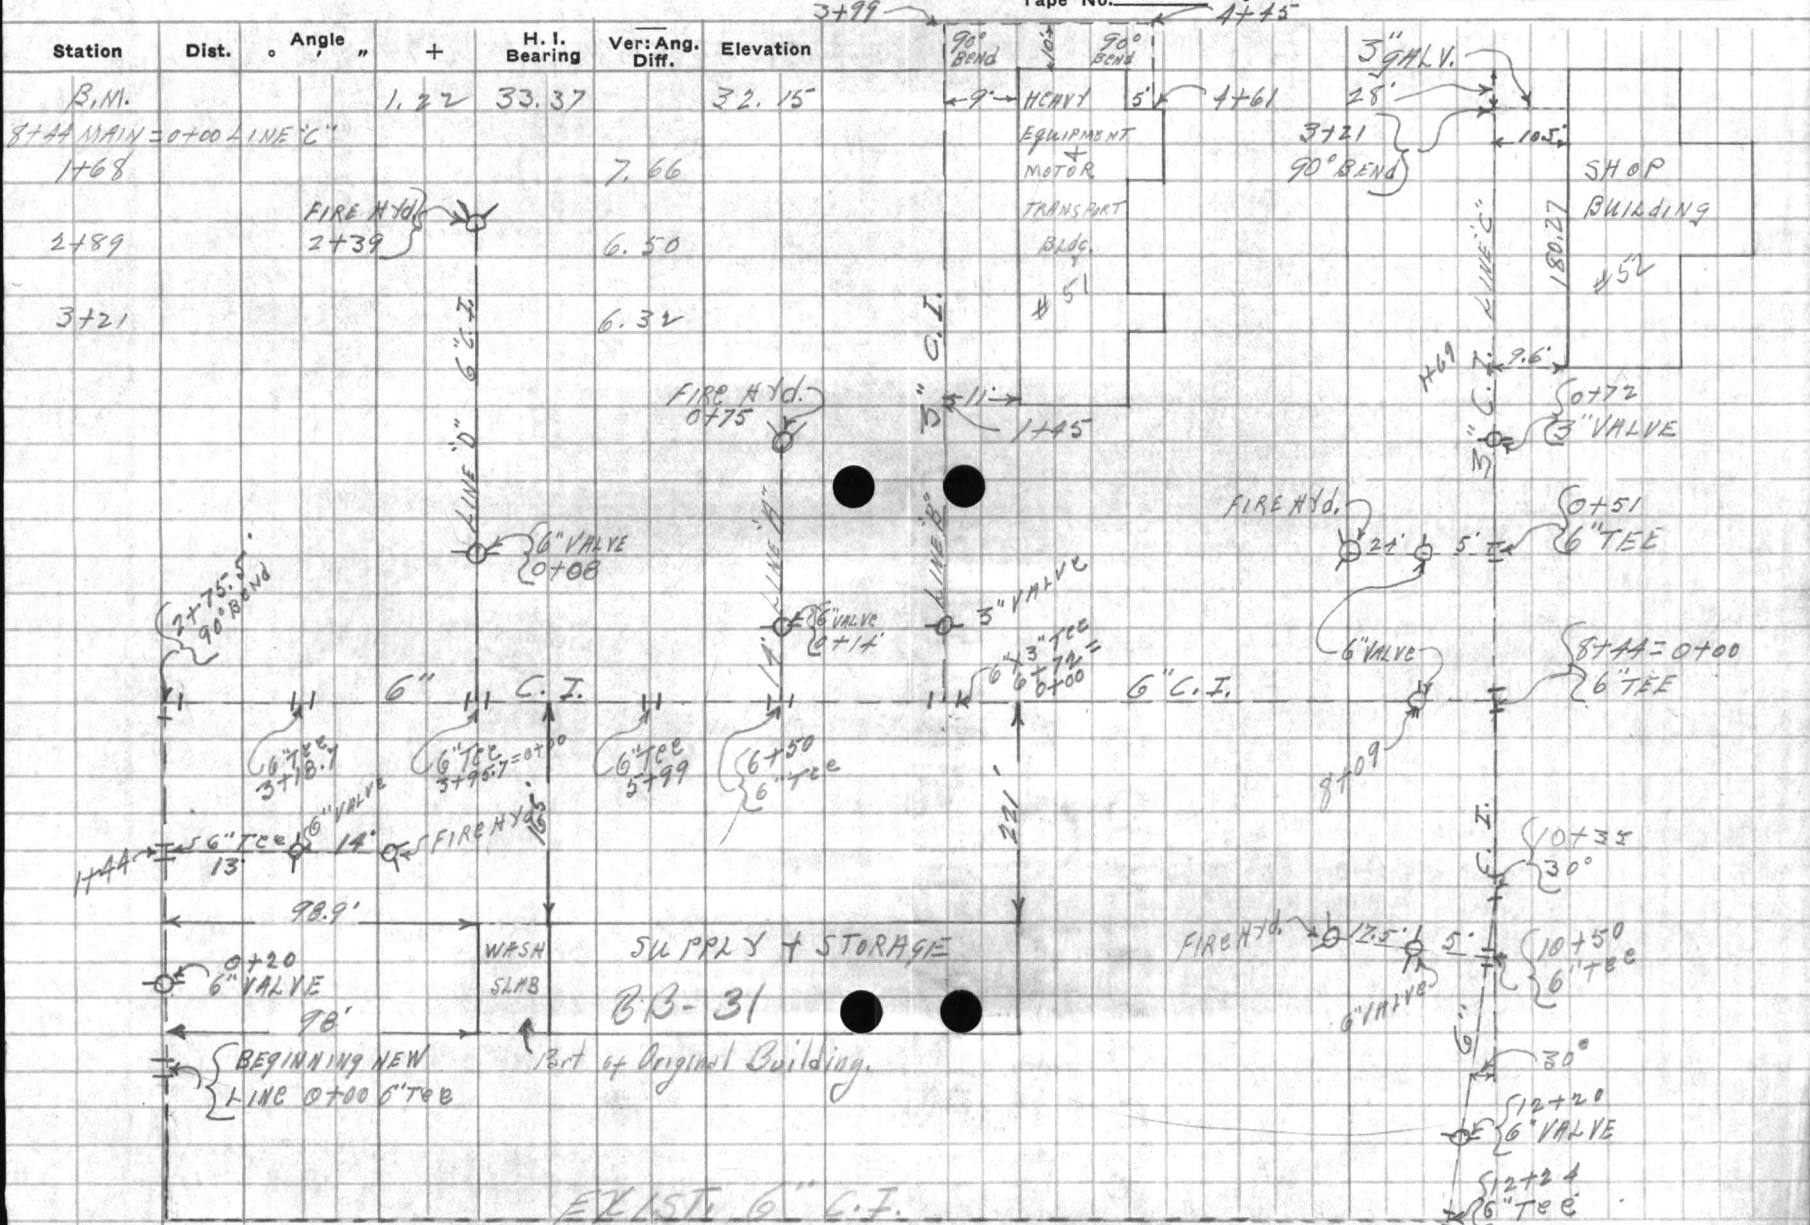

Station	Dist.	Angle "	+	H. I. Bearing	Ver: Ang. Diff.	Elevation
B.M.						
1+68			1.22	33.37		32.15
2+89					7.66	
3+21					6.50	
					6.32	

SUPPLY + STORAGE
BB-31

Part of Original Building.

EXIST. 6" C.I.

VALENTINE

SUBJECT

Report To
Public Works
Office
Cann. Licensure
North Carolina

Station # _____
City _____
State _____
+ _____
H. _____
Barometer _____
Elevation _____

FIELD PARTY

Name _____
In Charge _____
Instrument _____
Type of Read _____
Type of Rod _____
Type of Method _____
Type of _____

WEATHER

Clear _____
Snow _____
Fog _____
Cloudy _____
Wind _____
Moon _____
Rain _____
Temp _____
Bar _____
Pressure _____
Notes Checked By _____
Checked By _____
Date _____

FILE No.

Check No.

RECEIVED
FEBRUARY 20 1954
NORTH CAROLINA
PUBLIC WORKS
DIVISION

VALUABLE

Return To
Public Works
Office
Camp Lejeune
North Carolina

SUBJECT PROFILE ON WATER LINE
AT COURTHOUSE BAY, SEE
SKETCH SHEET #1

FIELD PARTY
KELLMAN in Charge
____ Instrument
____ Notes
____ Tape Read
____ Tape or Rod
____ Instrument No.
____ Tape No.

WEATHER
Clear _____
Cloudy _____
Windy _____
Rain _____
Fair _____
Snow _____
Hot _____
Moderate _____
Cold _____
Fog _____
Figured By _____
Notes Checked By _____
Plotted By _____

FILE No. _____
Fldr. No. _____
Sheet 2-015
Date 2-17-1927

Quad. No. _____

Station	Dist.	Angle " +	H. I. Bearing	Ver. Ang. Diff.	Elevation	
B.M.		1.08	28.03		26.95	ON MULBERRY TREE
0+00				9.08	18.95	
0+20				9.38	18.65	VAIVE
0+50				9.18	18.85	
1+00				6.25	21.78	
1+44				6.10	21.93	AT FIRE HYD.
2+00				6.95	22.08	
2+75.5				3.23	24.80	ON 90° BEND
T.P.		5.76	30.50	3.29	24.74	
3+18.7				5.95	24.55	6" X 6" TREE
3+50				6.04	24.46	
3+95.7				6.55	23.95	6" X 6" TREE
4+50				7.13	23.37	
5+00				7.89	22.61	
5+50				8.21	22.29	
5+99				8.40	22.10	6" TREE

AVAILABLE

Refer to
Public Works
Office
Columbia
North Carolina

SUBJECT

FIELD PARTY

In Charge _____
Instrument _____
Notes _____
Tape Head _____
Tape or Roll _____
Tape or Roll _____
Instrument No. _____
Tape No. _____

WEATHER

Clear _____
Cloudy _____
Windy _____
Moderate _____
Rain _____
Cold _____
Fog _____

File No.

File No.

Spec.

Date

File No.

Station _____
Dist. _____
Angle _____
Bearing _____
Mag. and Elevation _____

RECEIVED
MAY 10 1960
U.S. GEOLOGICAL SURVEY

VALUABLE

SUBJECT PROFILE ON WATER LINE
AT COURT HOUSE BAY CONTINUED.

Return To
Public Works
Office
Camp Lejeune
North Carolina

FIELD PARTY
KEELER In Charge
____ Instrument
____ Notes
____ Tape Read
____ Tape or Rod
____ Tape or Rod
____ Instrument No.
____ Tape No.

WEATHER
Clear _____
Cloudy _____
Windy _____
Rain _____
Fair _____
Snow _____
Hot _____
Moderate _____
Cold _____
Fog _____
Figured By _____
Notes Checked By _____
Plotted By _____

FILE No. _____
Fldr. No. _____
Sheet 3-01-5
Date 2-17-1941

Quad. No. _____

Station	Dist.	Angle "	+	H. I. Bearing	Ver: Ang. Diff.	Elevation	
				30.50			
6+50					8.30	22.20	FIRE MTD.
6+72					8.36	22.14	6" TEE
7+00					9.53	20.97	
7+50					9.56	20.94	
8+00					9.54	20.96	
8+09					9.54	20.96	6" VALVE
T.P.		11.02		32.67	8.85	21.65	
B.M.					0.53	32.14	ON 2" PINE
						32.15	
						.01	
B.M.		4.47		29.49		26.02	ON PINE TREE
8+44=0+00					9.18		6" X 6" TEE
9+00					9.75		
9+50					10.71		
10+00					12.87		
10+35							

734244B11

Return to
Public Works
Office
Camp Lejeune
North Carolina

SUBJECT

Station
Dist
Angle
Bearing
Mag. and
Elevation

FIELD PARTY

in Charge
Instrument
Notes
Lead Head
Tape at End
Tape at End
Instrument No.
Tape No.

WEATHER

Clear
Snow
Fog
Windy
Mist
Rain
Fair

Height by
Notes checked by
Plotted by

Grid No.

FILE No.

Date

RECEIVED
OFFICE
PUBLIC WORKS
CAMP LEJEUNE
NORTH CAROLINA

VALUABLE

Station
Camp Lejeune
Office
Public Works
Pattern To

SUBJECT

Station
Dist
Angle
Dearing
H. V. Ang
Elevation

FIELD REPORT
In Charge
Date
Notes
Tap Read
Type of Tap
Tap No.
Instrument No.

WEATHER
Clear
Hot
Windy
Rain
Fog
Thunder
Notes Checked By
Printed by

FILE No.
Flow
Sheet
Date

0103

0103

VALUABLE

SUBJECT PROFILE ON WATER LINE
AT COURT HOUSE BAY CONTG.

Return To
Public Works
Office
Camp Lejeune
North Carolina

FIELD PARTY

KELLM In Charge
____ Instrument
____ Notes
____ Tape Read
____ Tape or Rod
____ Instrument No.
____ Tape No.

WEATHER

Clear _____
Cloudy _____
Windy _____
Rain _____
Fair _____
Snow _____
Hot _____
Moderate _____
Cold _____
Fog _____
Figured By _____
Notes Checked By _____
Plotted By _____

FILE No. _____
Fldr. No. _____
Sheet 8-01-5
Date 2-18-1917

Quad. No. _____

Station	Dist.	Angle "	+	H. I. Bearing	Ver. Ang. Diff.	Elevation	
B.M.		6.25		28.40		32.15	ON PINE TREE
672 MAIN = 0+00 LINE "B"							
0+18					12.6		3" VALVE
1+45					12.0		
3+99					9.1		ON 90° BEND
4+56					9.4		
4+61							INTO BLDG.
6+50 MAIN = 0+00 LINE "A"							
0+75					14.5		HT FIRE HYD.
3+95.7 MAIN = 0+00 LINE "D"							
0+08							6" VALVE
2+39					10.8		HT FIRE HYD.
B.M.		6.25		32.15			ON PINE TREE

VALUABLE
Return to
Public Works
Office
Camp Lejeune
North Carolina

SUBJECT

Station

Dist.

Angle

Bearing

Vertical
Dist. Elevation

FIELD PARTY

Lead Change _____
Notes _____
Lead Used _____
Name of Rod _____
Name of Rod _____
Name of Rod _____

WEATHER

Clear _____
Cloudy _____
Windy _____
Rain _____
Fog _____
Fogged By _____
Name Checked By _____
Date _____

FILE NO.

File No. _____
Date _____

FILE NO.

844
275
569

VALUABLE

SUBJECT

Sketch Showing
Location of Water Line
at Engineering Bldg

Return To
Public Works
Office
Camp Lejeune
North Carolina


FIELD PARTY
Pierce In Charge
Instrument
Notes
Tape Read
Tape or Rod
Tape or Rod
Instrument No.
Tape No.

WEATHER
Clear
Cloudy
Windy
Rain
Fair
Snow
Hot
Moderate
Cold
Fog
Figured By
Notes Checked By
Plotted By
Quad. No.

FILE No. 220-F
Fldr. No.
Sheet #1 of
Date 6-6-1946
220

Station Dist. Angle " + H. I. Bearing Ver: Ang. Diff. Elevation

See Sheets Dated 2/17/47

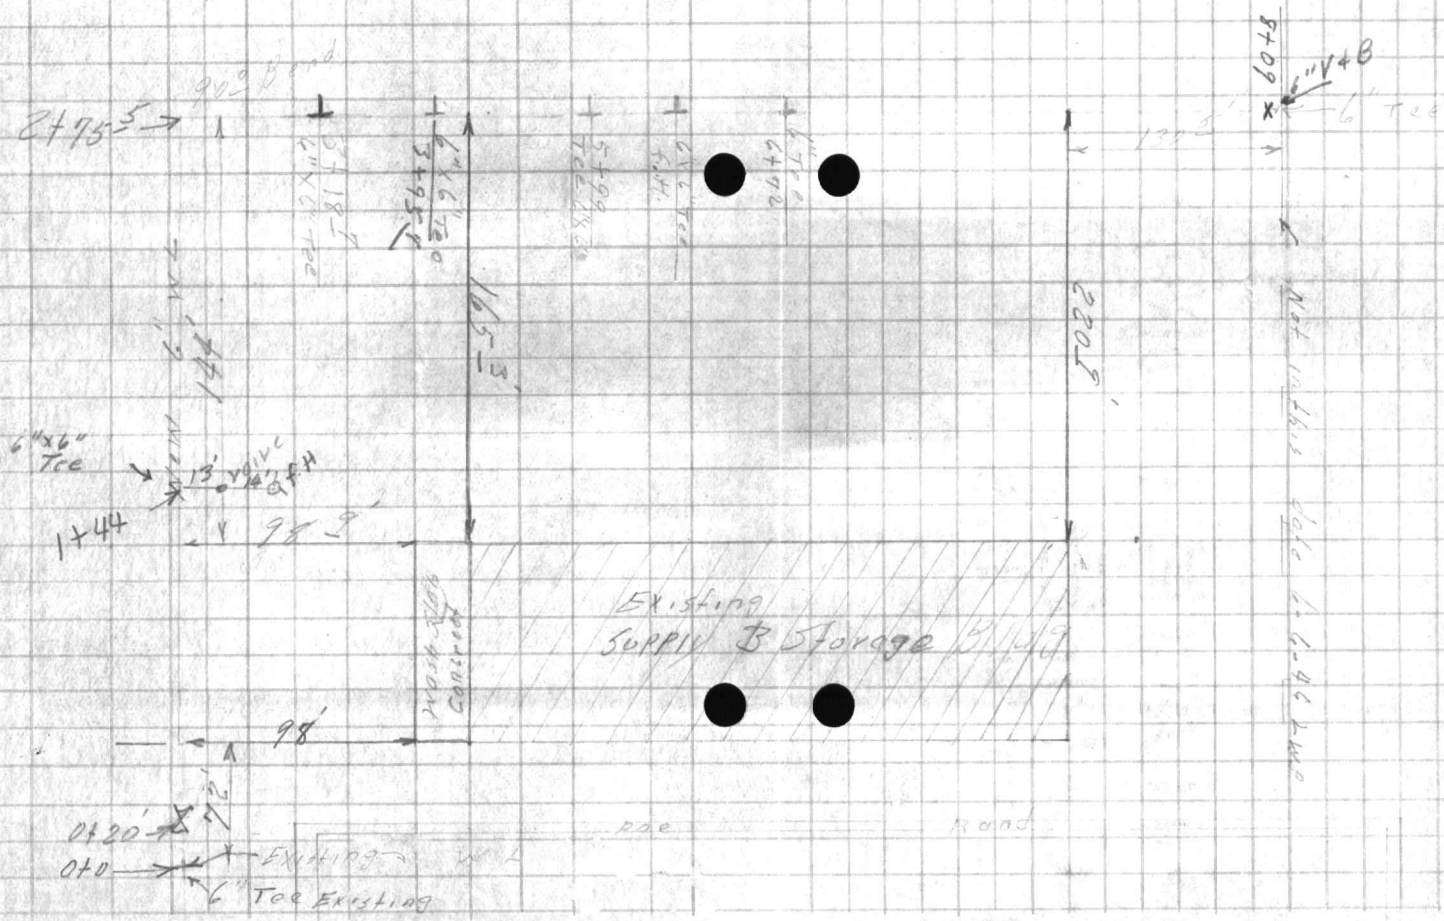



SUBJECT

Return to
Public Works
Office
North Carolina

RECORDED
INDEXED

APR 19 1954

VALUABLE

SUBJECT

Profile on WL

Return To
Public Works
Office
Camp Lejeune
North Carolina

FIELD PARTY

Pierce In Charge
Instrument
Notes
Tape Read
Tape or Rod
Tape or Rod
Instrument No.
Tape No.

WEATHER

Clear
Cloudy
Windy
Rain
Fair
Snow
Hot
Moderate
Cold
Fog

FILE No. 220-1

Fldr. No.

Sheet #20f

Date

19

Figured By

Notes Checked By

Plotted By

Quad. No. 220

Station	Dist.	Angle " "	+	H. I. Bearing	Ver: Ang. Diff.	Elevation	
Bm				1.08 28.03	✓	26.95'	on mulberry tree
0+0					9.08	18.95	
0+20					9.38	18.65	VALVE
1+50					9.18	18.85	
1+0					6.25	21.78	
1+44					6.10	21.93	at F.H.
2+0					5.95	22.08	
2+75					✓ 3.23	24.80	on 90° Bend
TP				5.76 30.50	3.29	24.74	on pipe
3+48					5.95	24.55	6" x 6" Tee
3+50					6.04	24.46	
3+95					6.55	23.95	6" x 6" Tee
4+50					7.13	23.37	
5+0					7.89	22.61	
+50					8.21	22.29	
5+99					8.40	22.10	











VALUABLE

SUBJECT Water Line

Engineers Battalion

Return To
Public Works
Office
Camp Lejeune
North Carolina

FIELD PARTY
Pierre In Charge
Instrument _____
Notes _____
Tape Read _____
Tape or Rod _____
Instrument No. _____
Tape No. _____

WEATHER
Clear _____
Cloudy _____
Windy _____
Rain _____
Fair _____
Snow _____
Hot _____
Moderate _____
Cold _____
Fog _____

FILE No. 220-F
Fldr. No. _____
Sheet #30F
Date _____ 19____
Quad. No. 220

Station	Dist.	Angle " "	+	H. I. Bearing	Ver: Ang. Diff.	Elevation	
				30.50 ✓			
6450				8.30	22.20		f.H
6472				8.34	22.14		6 Tee
740				9.53	20.97		
7450				9.54	20.94		
840				9.54	20.96		
8409				9.54	20.96		Valve End of Existing
TP	11.02	32.67		8.83	21.65 ✓		
Bm				0.53	32.14		(32.15) on 24" Pine

VA-113

Return To
Public Works
Office
Camp Lejeune
North Carolina

SUBJECT

Station _____
Dist. _____
Angle _____
H. I. _____
Bearing _____
Vel: 1:500 _____
Dist. _____
Elevation _____

FUDGE PARTY

In Charge _____
Instrument _____
Notes _____
Tape Read _____
Tape of Rod _____
Tape of Rod _____
Instrument No. _____
Tape No. _____

WEATHER

Clear _____
Cloudy _____
Rain _____
Fair _____
Fog _____
Thunder _____
Notes checked by _____
Notes plotted by _____

FILE No

Sta. _____
Date _____

COPIED
FROM
ORIGINAL

VALUABLE

Return To
Public Works
Office
Camp LeJeune
North Carolina

SUBJECT Water line at
Engineering Bat

FIELD PARTY

Charge
Instrument
Notes
Tape Read
Tape or Rod
Tape or Rod
Instrument No.
Tape No.

WEATHER

Clear
Cloudy
Windy
Rain
Fair
Snow
Hot
Moderate
Cold
Fog
Figured By
Notes Checked By
Plotted By

FILE No. _____
Fldr. No. _____
Sheet 1-3
Date _____ 19____

Quad. No. _____

Station	Dist.	Angle "	+	H. I. Bearing	Ver: Ang. Diff.	Elevation	
BM			4 47	29 49		25.02	BM on Pine
8744					9.18		Tea Water ^{line} 6" X 6"
9100					9.75		
9450					10.71		
10403					12.87		
10435							30° L "
10450					13.15		Tea & hydrea
11					13.97		
12400					16.77		
12420					12.03		TOP of valve box
12424					9.10		EXT. Line.
BM.					4.47		on Pine

LABORABLE

SUBJECT

Return To
Public Works
Office
North Carolina

Station

Dist.

Angle

Bearing

North and Elevation

IDENTITY

Change

Attachment

Notes

Type Read

Type of Rod

Type of Rod

Number

Type No.

WEATHER

Clear

Cloudy

Moderate

Hot

Windy

Light

Other

Wind

Temp

Humidity

Pressure

Direction

Speed

Other

Notes

Checked By

Printed By

Date

Time

Place

Project

Number

Sheet

Total

Scale
































































RECEIVED
MAY 19 1960

VALUABLE

SUBJECT _____

Return To
 Public Works
 Office
 Camp Lejeune
 North Carolina

FIELD PARTY

_____ In Charge
 _____ Instrument
 _____ Notes
 _____ Tape Read
 _____ Tape or Rod
 _____ Tape or Rod
 _____ Instrument No.
 _____ Tape No.

WEATHER

Clear
 Cloudy
 Windy
 Rain
 Fair

Snow
 Hot
 Moderate
 Cold
 Fog

FILE No. _____
 Fldr. No. _____
 Sheet 2-3
 Date _____ 19____

Figured By _____
 Notes Checked By _____
 Plotted By _____
 Quad. No. _____

Station	Dist.	Angle ° ' "	+	H. I. Bearing	Ver: Ang. Diff.	Elevation
BM.				593 3095		Elev 28.02 on pine
of 57					1084	6" Tean Valve of hydron shot out
+ 71				514	1059 ✓	6" Valve Top valve TOP line
H 00						

VALUABLE

SUBJECT

Return to
Public Works
Office
Camp Lejeune
North Carolina

Station

Dial

Angle

Bearing

Dist. Vert. Ang. Elevation

FIELD PARTY

2. The District

Instrument

Notes

Time Read

Type of Rod

Target Rod

Amount of

Time

WEATHER

Clear

Cloudy

Windy

Rain

Fog

Snow

Hail

Mist

LINE No.

Field No.

Sheet

Checked By

Checked By

Date

Grid No.

DRY

WIND

