

**VALUABLE**

RETURN TO  
PUBLIC WORKS  
OFFICE  
CAMP LEJEUNE  
NORTH CAROLINA

SUBJECT LOCATION FENCE  
SEWERAGE PLANT  
ON SLOW BEACH


FIELD PARTY  
DENNIS IN CHARGE  
\_\_\_\_\_  
INSTRUMENT  
\_\_\_\_\_  
NOTES  
\_\_\_\_\_  
TAPE READ  
\_\_\_\_\_  
TAPE OR ROD  
\_\_\_\_\_  
TAPE OR ROD  
\_\_\_\_\_  
INSTRUMENT NO. \_\_\_\_\_  
TAPE NO. \_\_\_\_\_

WEATHER  
CLEAR \_\_\_\_\_  
CLOUDY \_\_\_\_\_  
WINDY \_\_\_\_\_  
RAIN \_\_\_\_\_  
FAIR \_\_\_\_\_  
SNOW \_\_\_\_\_  
HOT \_\_\_\_\_  
MODERATE \_\_\_\_\_  
COLD \_\_\_\_\_  
FOG \_\_\_\_\_  
FIGURED BY \_\_\_\_\_  
NOTES CHECKED BY \_\_\_\_\_  
PLOTTED BY \_\_\_\_\_

FILE No. 221-5  
FLDR. No. \_\_\_\_\_  
SHEET 1 of 1  
DATE 12-12 1955

Quad. No. \_\_\_\_\_

STATION	DIST.	ANGLE ° ' "	+	H. I. BEARING	VER: ANG. DIFF.	ELEVATION
---------	-------	----------------	---	------------------	--------------------	-----------

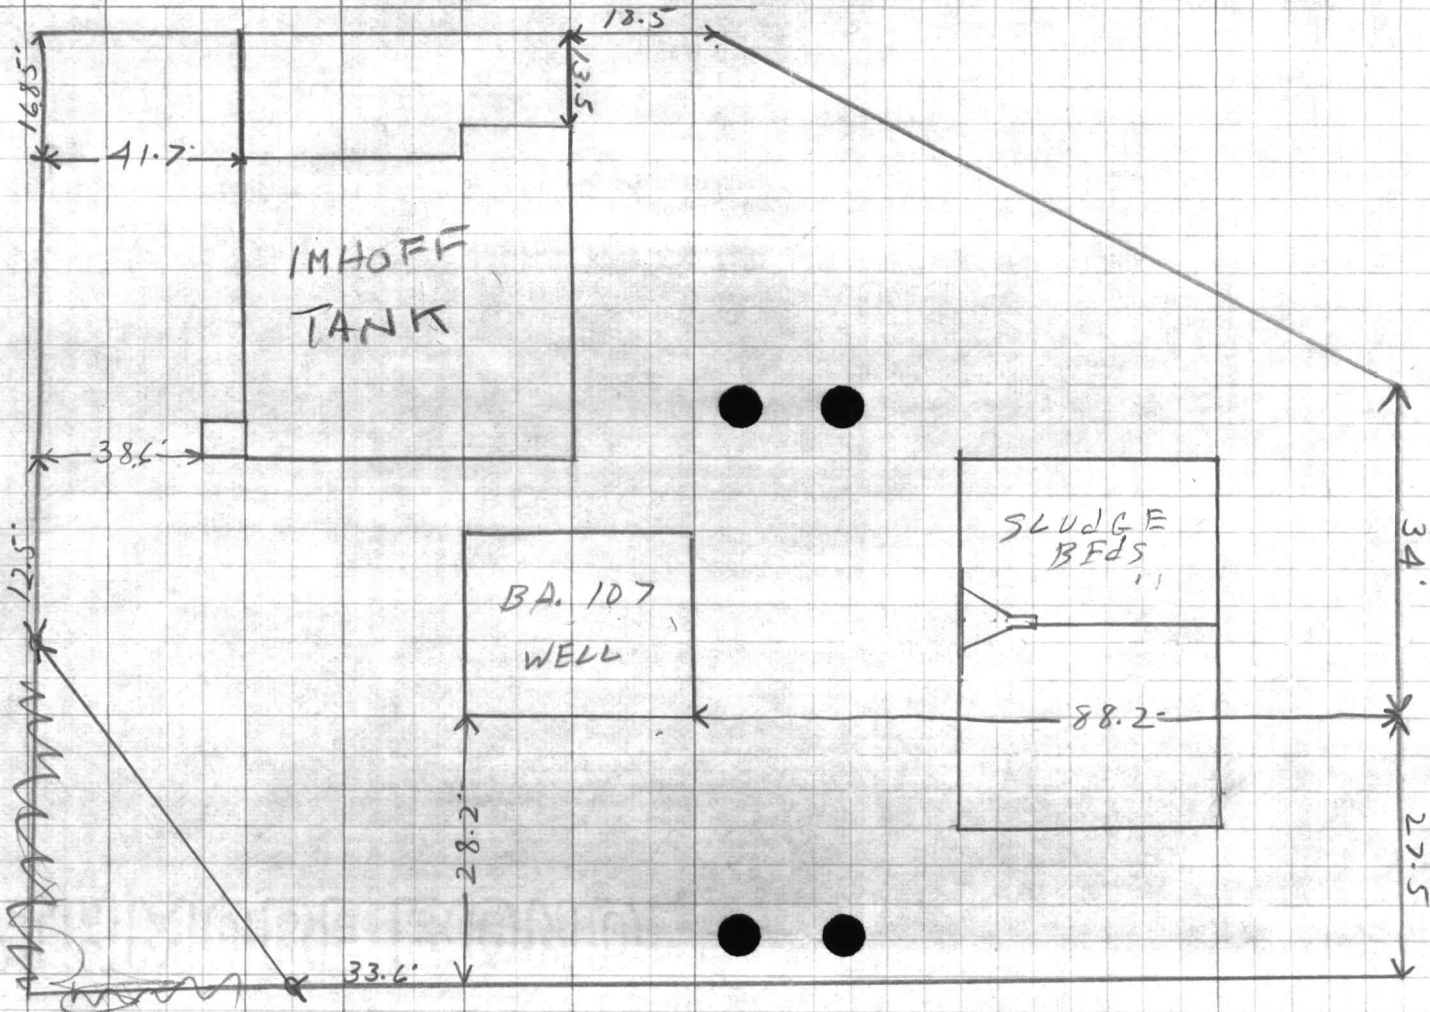

FACING ST

X









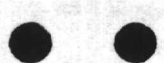

**VALUABLE**


RETURN TO  
PUBLIC WORKS  
OFFICE  
CAMP LEJEUNE  
NORTH CAROLINA

SUBJECT LOCATION FOR  
GARBAGE HOUSE MESS  
HALL ONSLOW BEACH

FIELD PARTY  
DEWINS IN CHARGE  
\_\_\_\_ INSTRUMENT  
\_\_\_\_ NOTES  
\_\_\_\_ TAPE READ  
\_\_\_\_ TAPE OR ROD  
\_\_\_\_ TAPE OR ROD  
\_\_\_\_ INSTRUMENT NO.  
\_\_\_\_ TAPE NO.

WEATHER  
CLEAR \_\_\_\_\_  
CLOUDY \_\_\_\_\_  
WINDY \_\_\_\_\_  
RAIN \_\_\_\_\_  
FAIR \_\_\_\_\_  
SNOW \_\_\_\_\_  
HOT \_\_\_\_\_  
MODERATE \_\_\_\_\_  
COLD \_\_\_\_\_  
FOG \_\_\_\_\_  
FIGURED BY \_\_\_\_\_  
NOTES CHECKED BY \_\_\_\_\_  
PLOTTED BY \_\_\_\_\_  
FILE No. 221-5  
FLDR. No. \_\_\_\_\_  
SHEET 10/1  
DATE 3-15 19\_\_\_\_  
Quad. No. \_\_\_\_\_

STATION	DIST.	ANGLE " "	+	H. I. BEARING	VER. ANG. DIFF.	ELEVATION
---------	-------	--------------	---	------------------	--------------------	-----------

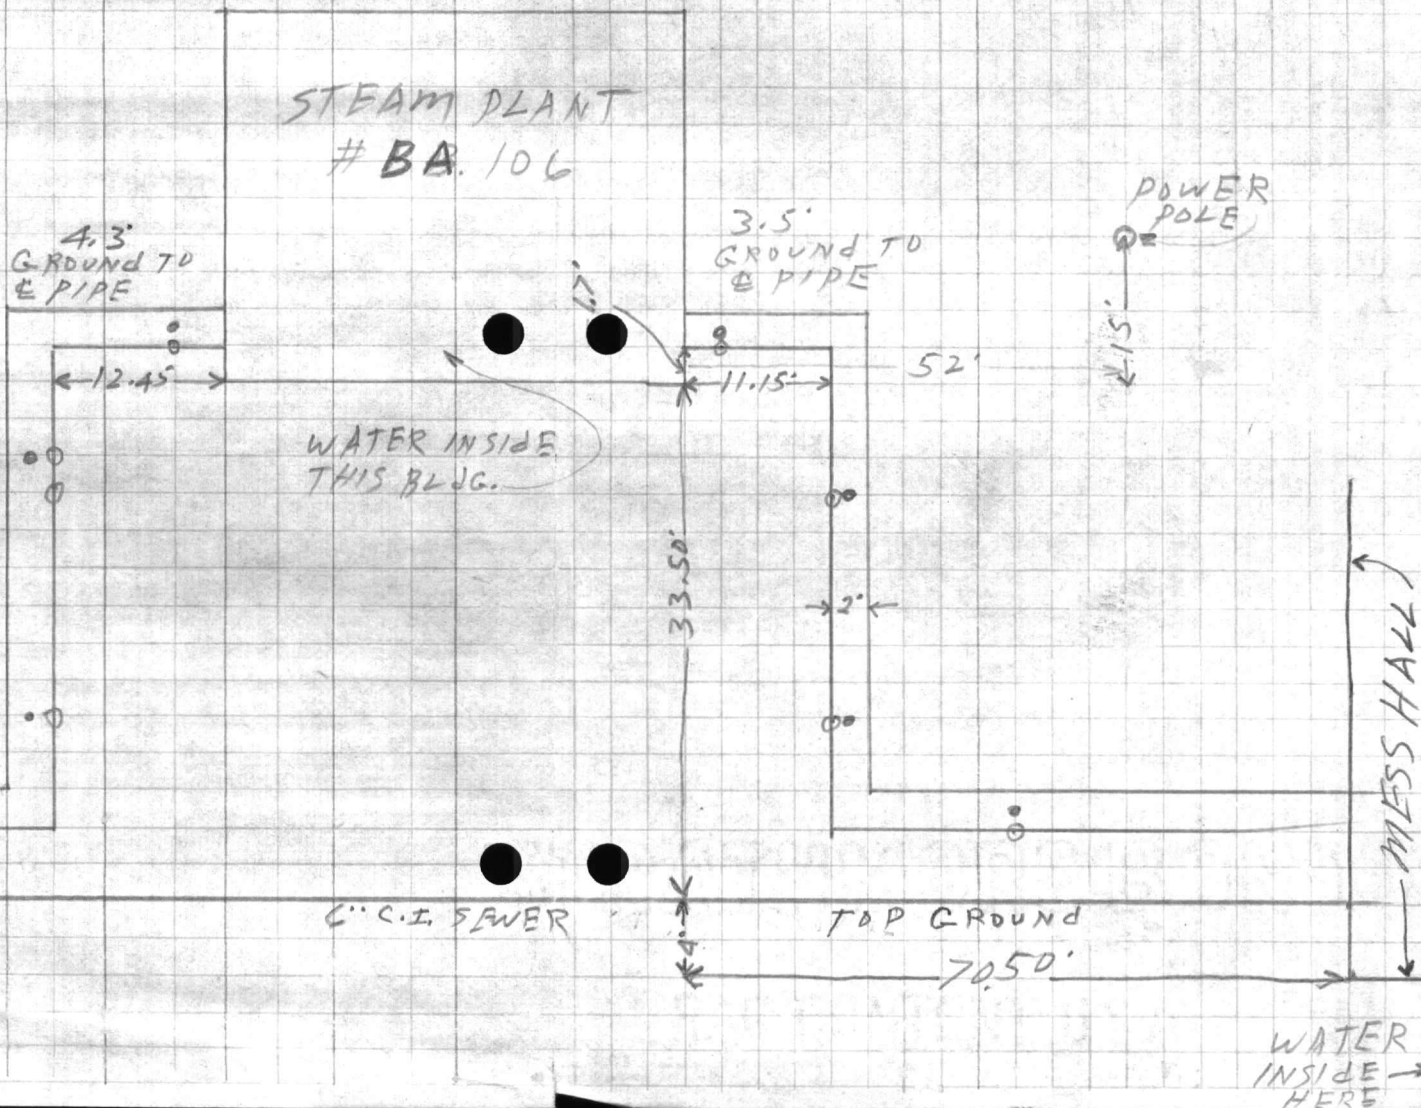

VALUABLE  
RETURN TO  
PUBLIC WORKS  
OFFICE  











**VALUABLE**

RETURN TO  
PUBLIC WORKS  
OFFICE  
CAMP LEJEUNE  
NORTH CAROLINA

SUBJECT

Test boring #1 between  
Bldg # BA 100 & Water tank  
Onslow Beach

FIELD PARTY

*Murphy* IN CHARGE  
INSTRUMENT  
NOTES  
TAPE READ  
TAPE OR ROD  
TAPE OR ROD  
INSTRUMENT NO.  
TAPE NO.

WEATHER

CLEAR  
CLOUDY  
WINDY  
RAIN  
FAIR  
SNOW  
HOT  
MODERATE  
COLD  
FOG

FILE No. 221-5

FLDR. No. \_\_\_\_\_

SHEET 2 of 2



DATE 10-13 1953

Quad. No. \_\_\_\_\_

STATION	DIST.	ANGLE ° ' "	+	H. I. BEARING	VER. ANG. DIFF.	ELEVATION
---------	-------	----------------	---	------------------	--------------------	-----------

*66.8 ft.*  
4.8 0 to 3.5' Coarse sand  
3.5 to 5.0' Rotted vegetation & sand  
5.0 to 10.2 Coarse sand  
-5.4 10.2' Shell rock

Water table - 2, 3'

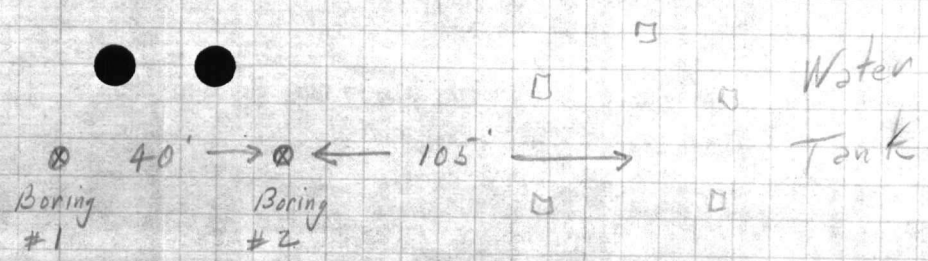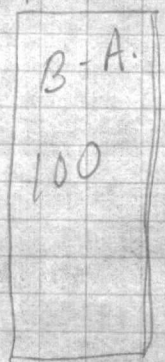


















1
































**VALUABLE**

SUBJECT

Test boring #2 between  
Bldg # BA-100 & Water  
Tank - Onslow Beach

RETURN TO  
PUBLIC WORKS  
OFFICE  
CAMP LEJEUNE  
NORTH CAROLINA

**FIELD PARTY**

*Murphy*  
IN CHARGE  
INSTRUMENT  
NOTES  
TAPE READ  
TAPE OR ROD  
TAPE OR ROD  
INSTRUMENT NO.  
TAPE NO.

**WEATHER**

CLEAR  
CLOUDY  
WINDY  
RAIN  
FAIR  
SNOW  
HOT  
MODERATE  
COLD  
FOG

FILE No. \_\_\_\_\_

FLDR. No. \_\_\_\_\_

FIGURED BY \_\_\_\_\_ SHEET 1082

NOTES CHECKED BY \_\_\_\_\_

PLOTTED BY \_\_\_\_\_ DATE 10-13-1953

Quad. No. \_\_\_\_\_

STATION	DIST.	ANGLE ° ' "	+	H. I. BEARING	VER: ANG. DIFF.	ELEVATION
---------	-------	----------------	---	------------------	--------------------	-----------

<i>old Defo 3.6</i>						Water table - 2.3'
0 to 3'						coarse sand
3 to 5'						rotted vegetation & sand
5 to 10.6'						Coarse sand
10.6						shell rock
-7.0						







**VALUABLE**SUBJECT Test borings - proposed  
storage Building - Onslow BeachRETURN TO  
PUBLIC WORKS  
OFFICE  
CAMP LEJEUNE  
NORTH CAROLINA

## FIELD PARTY

Murphy IN CHARGE  
INSTRUMENT \_\_\_\_\_  
NOTES \_\_\_\_\_  
TAPE READ \_\_\_\_\_  
TAPE OR ROD \_\_\_\_\_  
TAPE OR ROD \_\_\_\_\_  
INSTRUMENT NO. \_\_\_\_\_  
TAPE NO. \_\_\_\_\_

## WEATHER

CLEAR \_\_\_\_\_  
CLOUDY \_\_\_\_\_  
WINDY \_\_\_\_\_  
RAIN \_\_\_\_\_  
FAIR \_\_\_\_\_  
SNOW \_\_\_\_\_  
HOT \_\_\_\_\_  
MODERATE \_\_\_\_\_  
COLD \_\_\_\_\_  
FOG \_\_\_\_\_FILE No. 221-5

FLDR. No. \_\_\_\_\_

FIGURED BY \_\_\_\_\_ SHEET 105-1

NOTES CHECKED BY \_\_\_\_\_

PLOTTED BY \_\_\_\_\_ DATE 5-8 1952

Quad. No. \_\_\_\_\_

STATION	DIST.	ANGLE ° ' "	+	H. I. BEARING	VER: ANG. DIFF.	ELEVATION
---------	-------	----------------	---	------------------	--------------------	-----------

Test Boring "A" From 0 to 1' shell rock, from 1' to 7' coarse sand - (water table at 3')

Test Boring "B" From 0 to 6" top soil from 6" to 5' coarse sand, from 5' to 6' fine sand and rotted vegetation. (water table = 4')

Test Boring "C" From 0 to 4' coarse sand, from 4' to 5' fine sand, from 5' to 7' fine sand and rotted vegetation (water table = 5')

Test Boring "D" From 0 to 5' coarse sand, from 5' to 6' fine sand. (water table = 4')  
(Test Boring A = 0+00)Test Boring "A<sup>1</sup>" From 0 to 6" top soil, 6" to 6' coarse sand. (water table 4') = 0+70Test Boring "A<sup>2</sup>" From 0 to 6" top soil, from 6" to 4' coarse sand. (water table 4') = 0+78Test Boring "A<sup>3</sup>" from 0 to 4' coarse sand, from 4' to 5' fine sand, from 5' to 7' fine sand & rotted vegetation (water table 4') = 0+92Test Boring "A<sup>4</sup>" from 0 to 5.5' coarse sand, from 5.5' to 6' coarse sand with traces of rotted vegetation - indicative of edge of marsh. (water table 4') 0+85'

RECEIVED  
FBI  
NOV 10 1964










**VALUABLE**

SUBJECT TEST Boreing site  
Elev.<sup>s</sup> AND description of  
EXISTING B.M. AT onslow  
Beach proposed TREATMENT  
PLANT Site  
on Beach

RETURN TO  
 PUBLIC WORKS  
 OFFICE  
 CAMP LEJEUNE  
 NORTH CAROLINA

## FIELD PARTY

KELLY IN CHARGE  
 \_\_\_\_\_ INSTRUMENT  
 \_\_\_\_\_ NOTES  
 \_\_\_\_\_ TAPE READ  
 \_\_\_\_\_ TAPE OR ROD  
 \_\_\_\_\_ TAPE OR ROD  
 \_\_\_\_\_ INSTRUMENT NO.  
 \_\_\_\_\_ TAPE NO.

## WEATHER

CLEAR  
 CLOUDY  
 WINDY  
 RAIN  
 FAIR

SNOW  
 HOT  
 MODERATE  
 COLD  
 FOG

FILE No. 2215

FLDR. No. \_\_\_\_\_

FIGURED BY \_\_\_\_\_ SHEET 1-0 of 5NOTES CHECKED BY \_\_\_\_\_ DATE 8-19 1954

PLOTTED BY \_\_\_\_\_

Quad. No. \_\_\_\_\_

STATION	DIST.	ANGLE		H. I. BEARING	VER. ANG. DIFF.	ELEVATION
		'	"			
B.M.						8.49
		1.52	10.01			
			10.0			
TEST "A"				4.6		5.4
TEST "B"				4.5		5.5
TEST "C"				5.5		4.5
TEST "D"				4.8		5.2
TEST "E"				5.0		5.0
TEST "F"				5.3		4.7
TEST "G"				5.3		4.7
TEST "H"				5.6		4.4
B.M.				1.52		8.49

Top of Bolt in Base of Water Tank.  
 Bolt being nearest to Entrance  
 to Steps but NOT under steps.





**VALUABLE**

SUBJECT TEST BORINGS AT  
ONSLOW BEACH proposed water  
TREATMENT PLANT site.

RETURN TO  
PUBLIC WORKS  
OFFICE  
CAMP LEJEUNE  
NORTH CAROLINA

FIELD PARTY

Kellum IN CHARGE  
\_\_\_\_ INSTRUMENT  
\_\_\_\_ NOTES  
\_\_\_\_ TAPE READ  
\_\_\_\_ TAPE OR ROD  
\_\_\_\_ TAPE OR ROD  
\_\_\_\_ INSTRUMENT NO.  
\_\_\_\_ TAPE NO.

WEATHER

CLEAR  
CLOUDY  
WINDY  
RAIN  
FAIR

SNOW  
HOT  
MODERATE  
COLD  
FOG

FILE No. \_\_\_\_\_

FLDR. No. \_\_\_\_\_

FIGURED BY \_\_\_\_\_ SHEET 2 of 5  
NOTES CHECKED BY \_\_\_\_\_  
PLOTTED BY \_\_\_\_\_ DATE 8-19 1954

Quad. No. \_\_\_\_\_

STATION	DIST.	ANGLE ° ' "	+	H. I. BEARING	VER. ANG. DIFF.	ELEVATION
---------	-------	----------------	---	------------------	--------------------	-----------


TEST HOLE "A"

5.4

Ground Elev.

3.9

Area of sand overlay

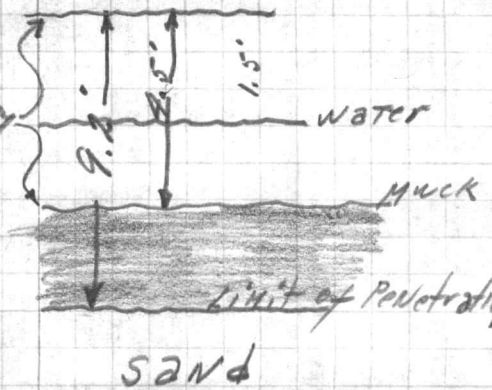


TEST HOLE "B"

5.5

Ground Elev.

3.6


Area of sand overlay

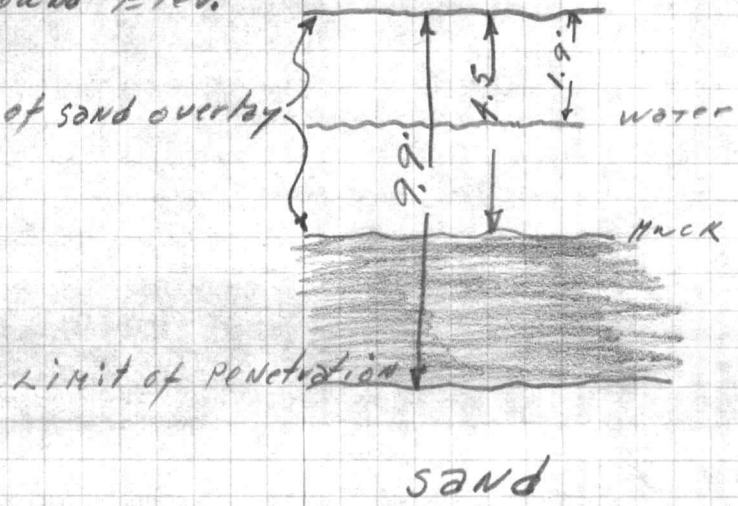




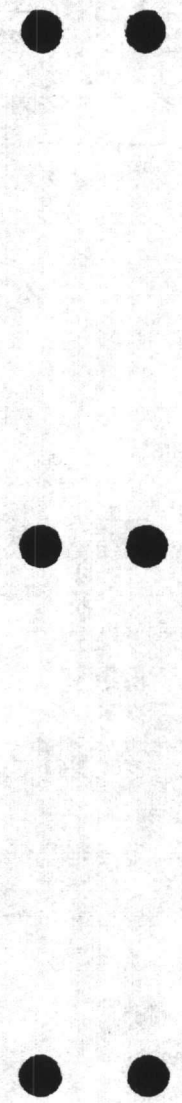

**VALUABLE**

SUBJECT TEST BORINGS AT  
BEACH CONTD.

RETURN TO  
PUBLIC WORKS  
OFFICE  
CAMP LEJEUNE  
NORTH CAROLINA

**FIELD PARTY**

\_\_\_\_\_  
IN CHARGE  
\_\_\_\_\_  
INSTRUMENT  
\_\_\_\_\_  
NOTES  
\_\_\_\_\_  
TAPE READ  
\_\_\_\_\_  
TAPE OR ROD  
\_\_\_\_\_  
TAPE OR ROD  
\_\_\_\_\_  
INSTRUMENT NO.  
\_\_\_\_\_  
TAPE NO.

**WEATHER**

CLEAR  
CLOUDY  
WINDY  
RAIN  
FAIR

SNOW  
HOT  
MODERATE  
COLD  
FOG

FILE No. \_\_\_\_\_

FLDR. No. \_\_\_\_\_

SHEET 3-0 of 5

DATE 8-19 1954

FIGURED BY \_\_\_\_\_  
NOTES CHECKED BY \_\_\_\_\_  
PLOTTED BY \_\_\_\_\_  
Quad. No. \_\_\_\_\_

STATION	DIST.	ANGLE ° ' "	+	H. I. BEARING	VER. ANG. DIFF.	ELEVATION
TEST Hole "C"						4.5
					3.2	
TEST Hole "D"						5.2
					2.7	

Ground Elev.

Area of sand  
overlay

Water

MUCK

Limit of Penetration

sand

Ground Elev.

Area of sand overlay

Water

MUCK


Limit of Penetration

sand




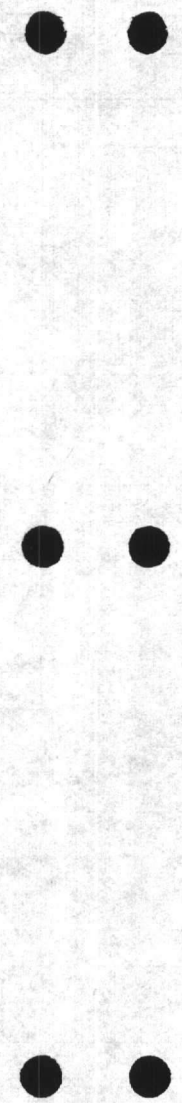



**VALUABLE**

SUBJECT Test Borings  
contd.

RETURN TO  
PUBLIC WORKS  
OFFICE  
CAMP LEJEUNE  
NORTH CAROLINA

**FIELD PARTY**

\_\_\_\_\_  
IN CHARGE  
\_\_\_\_\_  
INSTRUMENT  
\_\_\_\_\_  
NOTES  
\_\_\_\_\_  
TAPE READ  
\_\_\_\_\_  
TAPE OR ROD  
\_\_\_\_\_  
TAPE OR ROD  
\_\_\_\_\_  
STRUMENT NO.  
\_\_\_\_\_  
TAPE NO.

**WEATHER**

CLEAR  
CLOUDY  
WINDY  
RAIN  
FAIR  
SNOW  
HOT  
MODERATE  
COLD  
FOG


FILE No. \_\_\_\_\_  
FLDR. No. \_\_\_\_\_  
SHEET 4-0 of 5  
DATE 8-12-1954

FIGURED BY \_\_\_\_\_  
NOTES CHECKED BY \_\_\_\_\_  
PLOTTED BY \_\_\_\_\_  
Quad. No. \_\_\_\_\_

STATION	DIST.	ANGLE " "	+	H. I. BEARING	VER: ANG. DIFF.	ELEVATION
TEST Hole "E"						5.0
					2.5	
TEST Hole "F"						4.7
					1.2	

Ground Elev.


Area of sand overlay

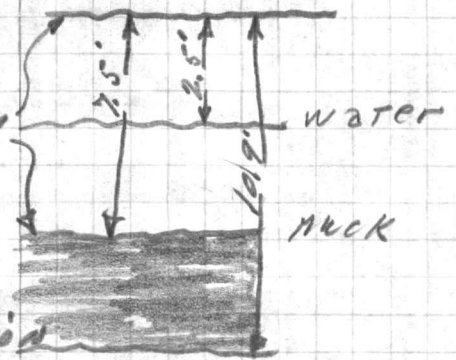

Limit of Penetration

Ground Elev.

Area of sand overlay

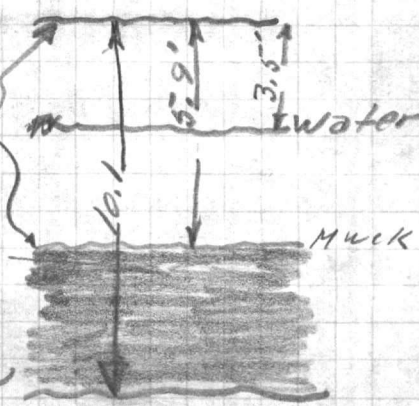

Limit of Penetration

sand



**VALUABLE**

SUBJECT TEST BORINGS  
CONTD.

RETURN TO  
PUBLIC WORKS  
OFFICE  
CAMP LEJEUNE  
NORTH CAROLINA

**FIELD PARTY**

\_\_\_\_\_  
IN CHARGE  
\_\_\_\_\_  
INSTRUMENT  
\_\_\_\_\_  
NOTES  
\_\_\_\_\_  
TAPE READ  
\_\_\_\_\_  
TAPE OR ROD  
\_\_\_\_\_  
TAPE OR ROD  
\_\_\_\_\_  
INSTRUMENT NO.  
\_\_\_\_\_  
TAPE NO.

**WEATHER**

CLEAR  
CLOUDY  
WINDY  
RAIN  
FAIR  
SNOW  
HOT  
MODERATE  
COLD  
FOG


FILE No. \_\_\_\_\_  
FLDR. No. \_\_\_\_\_  
SHEET 5-045  
DATE 8-19 1959

FIGURED BY \_\_\_\_\_  
NOTES CHECKED BY \_\_\_\_\_  
PLOTTED BY \_\_\_\_\_  
Quad. No. \_\_\_\_\_

STATION DIST. ANGLE " + H. I. BEARING VER. ANG. DIFF. ELEVATION  
TEST HOLE "G" 4.7

Ground Elev.

Area of sand overlay

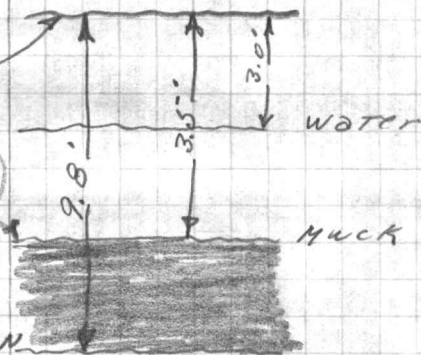


Limit of Penetration

SAND

TEST HOLE "H" 4.4

Ground Elev.

Area of sand overlay

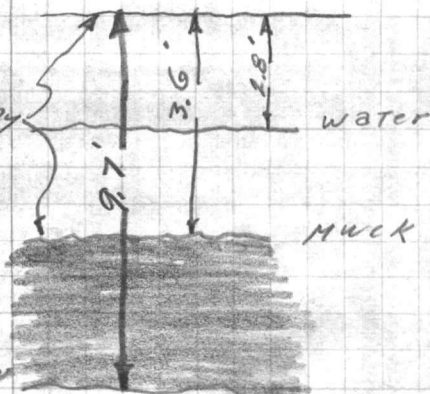

Limit of Penetration

SAND








**VALUABLE**

RETURN TO  
PUBLIC WORKS  
OFFICE  
CAMP LEJEUNE  
NORTH CAROLINA

SUBJECT

*X-Sections after Hurricane  
Erosion on Onslow Beach*

FIELD PARTY  
*Dillon* IN CHARGE  
INSTRUMENT  
NOTES  
TAPE READ  
TAPE OR ROD  
TAPE OR ROD  
INSTRUMENT NO.  
TAPE NO.

WEATHER  
CLEAR  
CLOUDY  
WINDY  
RAIN  
FAIR  
SNOW  
HOT  
MODERATE  
COLD  
FOG  
FIGURED BY  
NOTES CHECKED BY  
PLOTTED BY

FILE No. *221-5*  
FLDR. No.  
SHEET *#1 of*  
DATE *8/22/55*

Quad. No.

STATION	DIST.	ANGLE " "	+	H. I. BEARING	VER. ANG. DIFF.	ELEVATION	Diagram												
							<p><i>Enlisted Beach House</i></p> <p><i>Base Line</i></p> <p><i>Mon. #141</i></p> <p><i>Water Treatment Plant Site</i></p>												
							<p><i>Mon. #141</i></p> <p><i>T.B.M.</i></p> <p><i>T.B.M.</i></p> <p><i>12.90 18.60</i></p> <p><i>10.09 18.58</i></p> <p><i>5.57</i></p> <p><i>7.05</i></p> <p><i>5.70</i></p> <p><i>8.49</i></p> <p><i>280'</i></p> <p><i>0+00</i></p> <p><i>7+0</i></p> <p><i>8+0</i></p> <p><i>9+0</i></p> <p><i>Mon. #141</i></p> <p><i>Water Treatment Plant Site</i></p> <p><i>Op. Pole #5D 62 - Opposite Road from Water Tank</i></p> <p><i>Bolt on Water Tank, Lt. Side, Left of Door.</i></p>												
							<p><i>Edge Beach</i></p> <p><i>Top Dune</i></p> <p><i>E.R.</i></p>												
<i>Sta 7+00</i>							<i>243</i>	<i>207</i>	<i>181</i>	<i>152</i>	<i>138</i>	<i>118</i>	<i>100</i>	<i>87</i>	<i>65</i>	<i>20</i>	<i>10</i>	<i>±</i>	
							<i>16.4</i>	<i>14.7</i>	<i>13.3</i>	<i>10.3</i>	<i>34</i>	<i>7.0</i>	<i>11.0</i>	<i>12.3</i>	<i>13.7</i>	<i>14.1</i>	<i>13.5</i>	<i>13.1</i>	
							<i>2.2</i>	<i>3.9</i>	<i>5.3</i>	<i>8.3</i>	<i>15.2</i>	<i>11.6</i>	<i>7.6</i>	<i>6.3</i>	<i>4.9</i>	<i>4.5</i>	<i>5.1</i>	<i>5.5</i>	
<i>8+00</i>		<i>335°</i>					<i>252</i>	<i>198</i>	<i>175</i>	<i>152</i>	<i>142</i>	<i>120</i>	<i>110</i>	<i>100</i>	<i>76</i>	<i>48</i>	<i>23</i>	<i>10</i>	<i>±</i>
		<i>-0.8</i>					<i>16.6</i>	<i>14.3</i>	<i>12.7</i>	<i>9.5</i>	<i>1.6</i>	<i>3.6</i>	<i>7.6</i>	<i>9.9</i>	<i>11.3</i>	<i>13.1</i>	<i>13.5</i>	<i>13.3</i>	<i>13.1</i>
							<i>2.0</i>	<i>4.3</i>	<i>5.9</i>	<i>9.1</i>	<i>12.0</i>	<i>15.0</i>	<i>11.0</i>	<i>8.7</i>	<i>2.3</i>	<i>5.5</i>	<i>5.1</i>	<i>5.3</i>	<i>5.5</i>
<i>9+00</i>							<i>233</i>	<i>193</i>	<i>165</i>	<i>148</i>	<i>137</i>	<i>123</i>	<i>117</i>	<i>87</i>	<i>68</i>	<i>33</i>	<i>12</i>	<i>±</i>	
							<i>16.9</i>	<i>14.6</i>	<i>12.6</i>	<i>10.5</i>	<i>40.6</i>	<i>6.1</i>	<i>11.0</i>	<i>11.1</i>	<i>7.2</i>	<i>12.8</i>	<i>13.1</i>	<i>13.0</i>	
							<i>1.7</i>	<i>4.0</i>	<i>4.0</i>	<i>8.1</i>	<i>19.2</i>	<i>12.5</i>	<i>7.6</i>	<i>7.5</i>	<i>11.4</i>	<i>5.8</i>	<i>5.5</i>	<i>5.6</i>	





























Return To  
Public Works  
Office  
Camp Lejeune  
North Carolina

SUBJECT Elevation & Overflow of  
100,000 Gal. Water Tank  
Onslow Beach  
S-B A-108

FIELD PARTY  
Turlington In Charge  
Instrument \_\_\_\_\_  
Notes \_\_\_\_\_  
Tape Read \_\_\_\_\_  
Tape or Rod \_\_\_\_\_  
Tape or Rod \_\_\_\_\_  
Instrument No. \_\_\_\_\_  
Tape No. \_\_\_\_\_

WEATHER  
Clear \_\_\_\_\_  
Cloudy \_\_\_\_\_  
Windy \_\_\_\_\_  
Rain \_\_\_\_\_  
Fair \_\_\_\_\_  
Snow \_\_\_\_\_  
Hot \_\_\_\_\_  
Moderate \_\_\_\_\_  
Cold \_\_\_\_\_  
Fog \_\_\_\_\_  
Figured By \_\_\_\_\_  
Notes Checked By \_\_\_\_\_  
Plotted By \_\_\_\_\_

FILE No. 221-5  
Fldr. No. \_\_\_\_\_  
Sheet 41 of 2  
Date 11/25 1946  
Quad. No. \_\_\_\_\_

Station	Dist.	Angle	H. I. Bearing	Ver. Ang. Diff.	Elevation
					Barrel + 45" Down
BM	1.05		9.64 Mean <del>9.59</del>		8.54
Top Tank		24° 14'	133.54 Height 135.11	134.32 Mean + 9.64 = 143.96	Elev. at Top of Tank
Top Over Flo Pipe 6"		22° 07'	122.00 - 0.50 (Bottom of Pipe)	121.50	Overflow + 9.64 = 131.14 Elevation of Overflow Pipe
Bottom Tank		17° 17'	93.42 92.75	93.04 + 9.64 =	102.73 Elev. Top of Riser Pipe
BM	1.15		9.64 Mean <del>9.69</del>		8.54
Top Tank		23° 59'	133.54 Height 135.11	134.32 Mean + 9.64 = 143.96	Elevation at Top of Tank
Top over Flo Pipe 6"		22° 07'	122.00 - 0.50	121.50	Overflow
Bottom		17° 10'	93.75 93.42	93.04 + 9.64 =	102.73 Elev. Top of Riser Pipe
















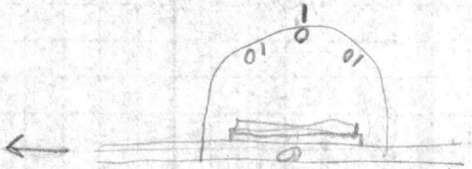



**VALUABLE**

SUBJECT Onslow Beach Water Tank

Return To  
Public Works  
Office  
Camp Lejeune  
North Carolina

FIELD PARTY  
Turlington In Charge  
Instrument \_\_\_\_\_  
Notes \_\_\_\_\_  
Tape Read \_\_\_\_\_  
Tape or Rod \_\_\_\_\_  
Tape or Rod \_\_\_\_\_  
Instrument No. \_\_\_\_\_  
Tape No. \_\_\_\_\_

WEATHER  
Clear \_\_\_\_\_  
Cloudy \_\_\_\_\_  
Windy \_\_\_\_\_  
Rain \_\_\_\_\_  
Fair \_\_\_\_\_  
Snow \_\_\_\_\_  
Hot \_\_\_\_\_  
Moderate \_\_\_\_\_  
Cold \_\_\_\_\_  
Fog \_\_\_\_\_  
Figured By \_\_\_\_\_  
Notes Checked By \_\_\_\_\_  
Plotted By \_\_\_\_\_

FILE No. \_\_\_\_\_  
Fldr. No. \_\_\_\_\_  
Sheet # 242  
Date 11/25 1946

Quad. No. \_\_\_\_\_

Station	Dist.	Angle " "	+	H. I. Bearing	Ver: Ang. Diff.	Elevation	
BM						7.05	Mon #141
	2.08	9	13		5.35	3.78	
BM	5.32	9	10		0.50	8.54	Head of bot 2A. Side of Water Tank First Bolt Left Door Top Bolt
					2.09	7.01	concrete base
	0.58	9	12		3.1	6.0	Ground
					5.37	3.75	
	5.35	9	10				
BM					2.04	7.06	Mon #141

Return To  
Public Works  
Office  
Camp Lejeune  
North Carolina

SUBJECT

Station Dist. Angle H. of Bench  
Var. And. elevation

FIELD PARTY

In Charge  
Instruments  
Notes  
Type Read  
Type of Rod  
Type of Rod  
Station No.  
Type No.

WEATHER

Clear  
Cloudy  
Moderate  
Cold  
Fog  
Rain  
Snow  
Hot  
Windy

FILE No.

File No.

Sheet

Date

Plotted By

Notes Checked By

Plotted By

Quadr. No.

**VALUABLE**

SUBJECT NEW BENCH MARK  
AT WATER TREATMENT PLANT  
Site - on slough beach

RETURN TO  
PUBLIC WORKS  
OFFICE  
CAMP LEJEUNE  
NORTH CAROLINA

FIELD PARTY

KEPNEY IN CHARGE  
\_\_\_\_ INSTRUMENT  
\_\_\_\_ NOTES  
\_\_\_\_ TAPE READ  
\_\_\_\_ TAPE OR ROD  
\_\_\_\_ TAPE OR ROD  
\_\_\_\_ INSTRUMENT NO.  
\_\_\_\_ TAPE NO.

WEATHER

CLEAR  
CLOUDY  
WINDY  
RAIN  
FAIR  
SNOW  
HOT  
MODERATE  
COLD  
FOG

FILE No. \_\_\_\_\_  
FLDR. No. \_\_\_\_\_  
SHEET 1-0f  
DATE 8-20 1959

FIGURED BY \_\_\_\_\_  
NOTES CHECKED BY \_\_\_\_\_  
PLOTTED BY \_\_\_\_\_  
Quad. No. \_\_\_\_\_

STATION	DIST.	ANGLE ° ' "	+	H. I. BEARING	VER. ANG. DIFF.	ELEVATION
B.M.						6.47
			5.28	11.75		
T.P.					4.61	7.14
			4.05	11.19		
T.P.					4.06	7.13
			2.54	10.67		
NEW B.M.					4.97	5.70
			3.40	9.10		
original B.M. ON BOLT of WATER TANK					0.60	8.50
						8.49

NOV. #40

No. 5 D 62  
#20 Nail in Power Pole directly across  
Road from Water Tank.

BOLT is 2.5' South from Edge of  
BOTTOM STEP































PUBLIC WORKS DEPARTMENT  
Camp Lejeune, North Carolina  
Survey Department


221-5

File ~~221-5~~  
Quadrangle 221-5  
Date 1/12/48  
Sheet      of     

Traverse Computation  
Description

North  
R/W of Inland Waterway at Sta. 298+73  $\frac{1}{2}$  Mi. SW. of Mock-up \*

Station	Distance	Bearing	Cosine	Sine	Latitude	Departure	Y Coordinate North	X Coordinate East
<i>Passet</i>							293,173.64	2,509,046.21
	186'	S86°10'E	06685	99776	12.43	185.58	293,161.21	2,509,231.79
	2558'	N51°30'E	62251	78261	1592.38	2001.92	294,753.59	2,511,233.71
	1530'	N40°W	76604	64279	1172.04	983.47	295,925.63	2,510,250.24
	8526'	N59°42'E	50453	8634	4301.62	7361.35	300,227.25	2,517,611.59
P.I. on North R/W	1000'	N30°18'W	8634	50453	863.40	504.53	301,090.65	2,517,107.06
						*	301,092.52	2,517,008.56
							1.87	38.50
							5.21	44.37

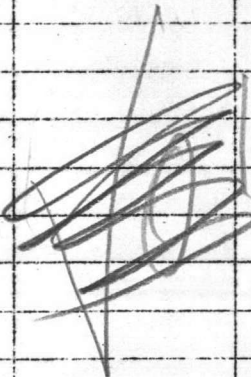

\* Computed from Boney + Broadfoot R/W Tie Magnetic Bearings & Approximate Distances.  
\* Computed from Corps of Engineers Datum as interpreted from print furnished by Wilmington District Office





