

VALUABLE

SUBJECT Profile & Location of Water
Service at Signal School Area
Onslow Beach

RETURN TO
 PUBLIC WORKS
 OFFICE
 CAMP LEJEUNE
 NEW RIVER, N. C.

FIELD PARTY
Dillon IN CHARGE
Reed INSTRUMENT
 NOTES
Adams TAPE READ
Batson TAPE OR ROD
 TAPE OR ROD
 INSTRUMENT NO.
 TAPE NO.

WEATHER
 CLEAR
 CLOUDY
 WINDY
 RAIN
 FAIR
 SNOW
 HOT
 MODERATE
 COLD
 FOG

221 GEN
 FILE No.

FLDR. No.


FIGURED BY _____ SHEET #1 of 3

NOTES CHECKED BY _____

PLOTTED BY _____ DATE 3/4 1944

Quad. No. 221

STATION	DIST.	ANGLE "	+	H. I.	VER: ANG DIFF.	ELEVATION
B.M.			1.40	9.00		7.60
0+00 = 10" X 10" Tee + Plug					8.62	0.38
0+04 10" X 6" Tee						
0+07 10" X 6" Tee						
1+0					8.62	0.38
1+94 10" X 4" Tee					8.60	0.40
= 0+00						
1+0 4' Line Rt to Storage Plant					7.54	1.16
1+16 4" X 2" Tee + Plug					7.70	1.30
1+67 54" X 2" Tee + Plug					7.70	1.30
2+76 45° Bend Lt					7.74	1.26
3+67 Present End of Pipe					7.93	1.17
3+0 10" Line					8.77	0.23
4+26 10" X 4" Tee					7.32	1.68
= 0+00 4' Line to Mess Hall Rt.						
T.P.			1.40	7.60		
			3.17	10.77		
1+0					8.00	2.77
1+68 Inlet at Mess Hall					6.65	4.12
5+0 10" Line					7.54	3.23
5+73 10" X 6" Tee					7.10	3.67
= 0+00 6" Line Lt. to Heating Plant.						

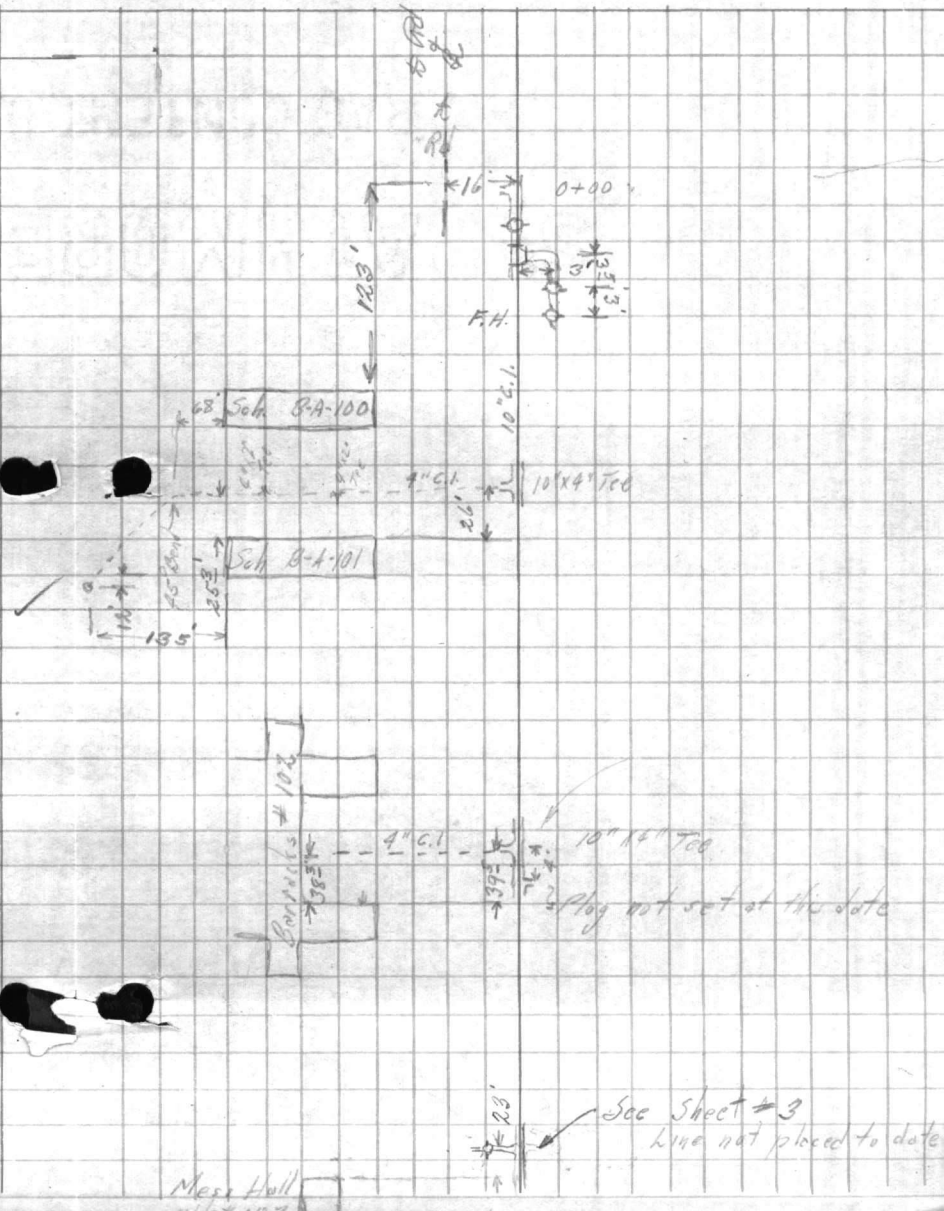

Mess Hall
 #103

See Sheet #3
 Line not placed to date

Water Distribution
Signal School Area.

VALUABLE

SUBJECT

*Water line
Signal School Ared.*

RETURN TO
PUBLIC WORKS
OFFICE

CAMP LEJEUNE
NEW RIVER, N. C.

FIELD PARTY

Dillon IN CHARGE
INSTRUMENT
NOTES
TAPE READ
TAPE OR ROD
TAPE OR ROD
INSTRUMENT NO.
TAPE NO.

WEATHER

CLEAR
CLOUDY
WINDY
RAIN
FAIR
SNOW
HOT
MODERATE
COLD
FOG

FILE No.


FLDR. No.

FIGURED BY SHEET *# 2 of 3*

NOTES CHECKED BY DATE *3/4 19 44*

Plotted By Quad. No.

STATION	DIST.	ANGLE "	+	H. I.	VER: ANG. DIFF.	ELEVATION
				<i>10.77</i>		
<i>7+0</i>	<i>10" Line</i>				<i>6.81</i>	<i>3.96</i> ✓
	<i>T.P.</i>				<i>3.64</i>	<i>7.13</i>
		<i>4.89</i>	<i>12.02</i>			
<i>8+0</i>						
<i>8+94</i>	<i>10" X 6" Tee</i>				<i>9.09</i>	<i>2.93</i>
<i>10+23</i>	<i>10" X 4" Tee</i>				<i>8.08</i>	<i>3.94</i>
<i>= 0+00</i>	<i>Line to Bldg. #104</i>					
<i>0+04</i>	<i>4" V&B</i>				<i>8.39</i>	<i>3.63</i>
<i>1+0</i>					<i>8.93</i>	<i>3.09</i>
<i>1+68</i>	<i>Inlet at Bldg. #104</i>				<i>7.75</i>	<i>4.27</i>
<i>11+0</i>	<i>10" Line</i>				<i>7.70</i>	<i>4.32</i>
	<i>T.P.</i>				<i>1.89</i>	<i>10.13</i>
		<i>2.38</i>	<i>12.51</i>			
<i>12+0</i>					<i>8.53</i>	<i>3.98</i>
<i>12+96</i>	<i>10" X 4" Tee</i>				<i>8.36</i>	<i>4.15</i>
<i>= 0+00</i>	<i>Line to Bldg. #105</i>					
<i>0+04</i>	<i>4" V&B</i>				<i>8.62</i>	<i>3.89</i>
<i>1+0</i>					<i>9.58</i>	<i>2.93</i>
<i>1+68</i>	<i>Inlet at Bldg. #105</i>				<i>7.70</i>	<i>4.81</i> ✓
<i>B.M. Mon. # V.S.N. 40</i>					<i>6.04</i>	<i>6.44</i>

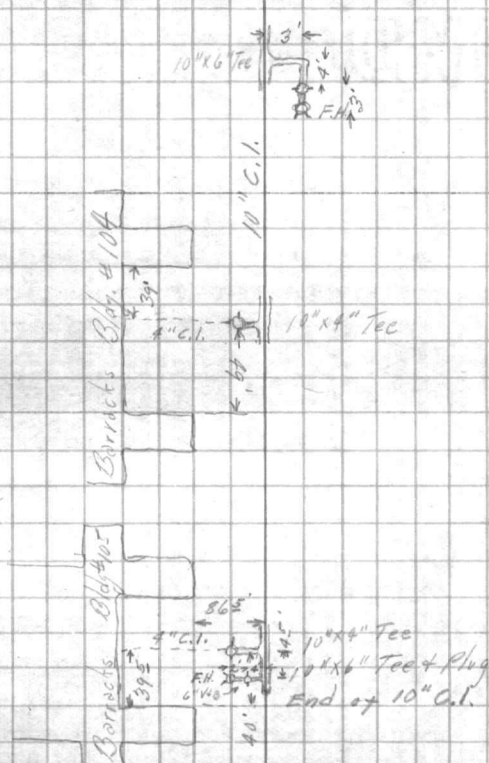

(to #65)




VALUABLE

SUBJECT

Water Lines

RETURN TO
PUBLIC WORKS
OFFICE
CAMP LEJEUNE
NEW RIVER, N. C.

Signal School Area

FIELD PARTY

Dillie IN CHARGE
INSTRUMENT
NOTES
TAPE READ
TAPE OR ROD
TAPE OR ROD
INSTRUMENT NO.
TAPE NO.

WEATHER

CLEAR
CLOUDY
WINDY
RAIN
FAIR
SNOW
HOT
MODERATE
COLD
FOG

FILE No.

FLDR. No.

FIGURED BY

SHEET

3 of 3

NOTES CHECKED BY


PLOTTED BY

DATE

5/7/44

Quad. No.

STATION	DIST.	ANGLE "	+	H. I.	VER. ANG. DIFF.	ELEVATION
B.M. Fl. Elev. Mess Hall	0.86			10.86		10.00
5+73 ³ 10" line = 10" x 6" Tee = 0+00 6" line to Heating Plant						3.47
0+03.5 6" V&B						
1+0					7.70	3.14
2+13 6" x 4" Tee = 0+00 line to Heating Plant					8.95	1.91
1+18 4" x 3" Tee Inlet at Mess Hall					7.85	3.01
					6.05	4.81
1+38 4" x 3" Tee & Plug 1+42 V&B 2+03 Inlet at Heating Plant					6.63	4.23
3+31.5 6" x 6" Tee & Plug					8.40	2.46
B.M.					0.86	

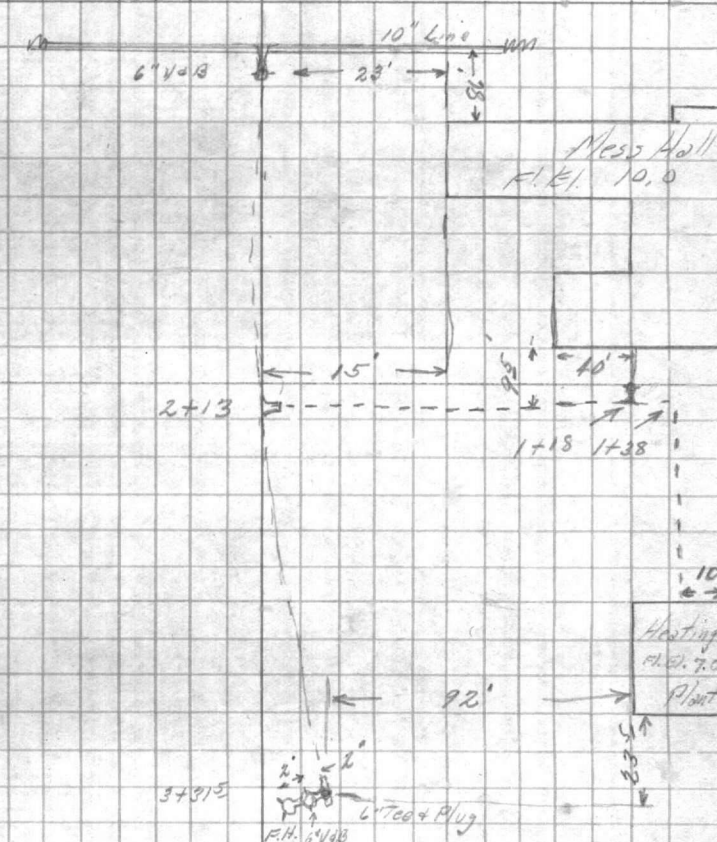






VALUABLE

Return To
Public Works
Office
Camp LeJeune
North Carolina

SUBJECT LOCATION OF WATER LINE
(6") AT HURST BEACH

FIELD PARTY

KELLUM In Charge
____ Instrument
____ Notes
____ Tape Read
____ Tape or Rod
____ Tape or Rod
____ Instrument No.
____ Tape No.

WEATHER

Clear
Cloudy
Windy
Rain
Fair

Snow
Hot
Moderate
Cold
Fog

FILE No. 221-T

Fldr. No. _____


Figured By _____ Sheet 1-066

Notes Checked By _____

Plotted By _____ Date 2-6 1946

Quad. No. _____

Station	Dist.	Angle	H. I. Bearing	Ver. Ang. Diff.	Elevation
---------	-------	-------	---------------	-----------------	-----------

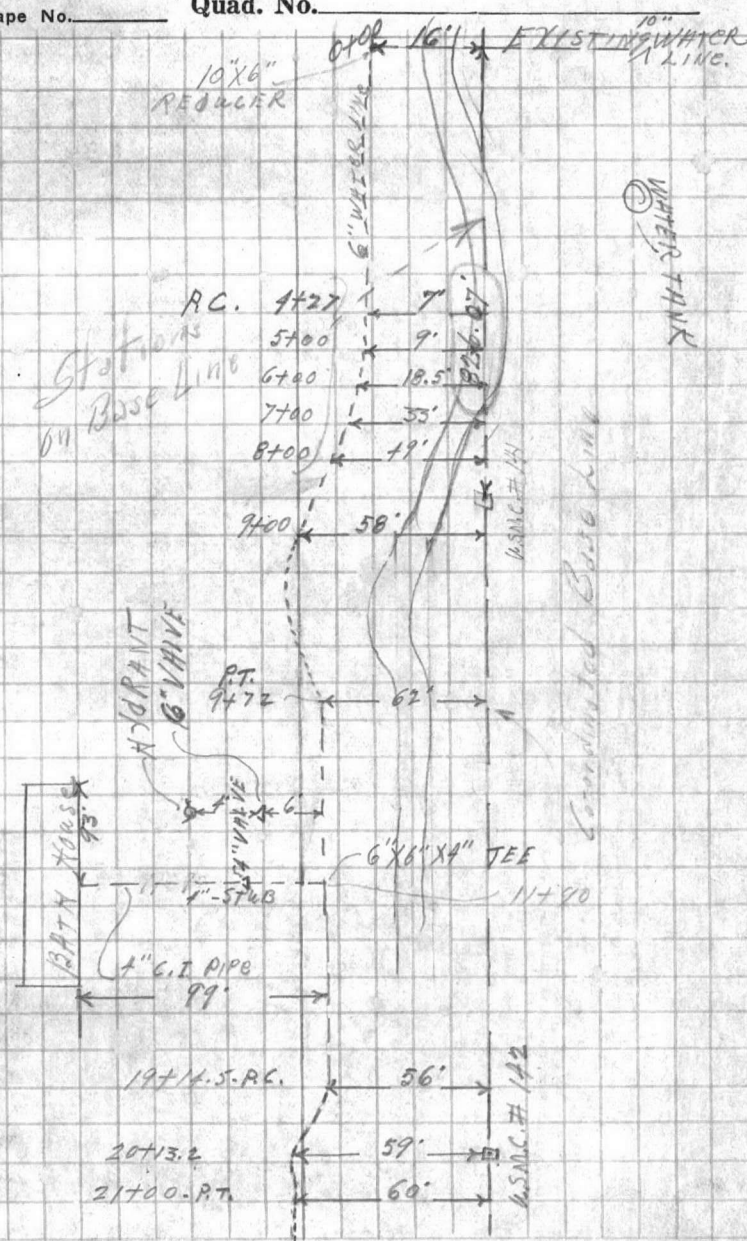












ABLE

SUBJECT PROFILE ON 6" WATER
LINE AT HURST BEACH

Return To
Public Works
Office
Camp Lejeune
North Carolina

FIELD PARTY

NEJLMM In Charge
Instrument _____
Notes _____
Tape Read _____
Tape or Rod _____
Tape or Rod _____
Instrument No. _____
Tape No. _____

WEATHER

Clear _____
Cloudy _____
Windy _____
Rain _____
Fair _____
Snow _____
Hot _____
Moderate _____
Cold _____
Fog _____

FILE No. 221-T
Fldr. No. _____
Figured By _____ Sheet 3-056
Notes Checked By _____
Plotted By _____ Date 2-6 1916
Quad. No. _____

Station	Dist.	Angle "	+	H. I. Bearing	Ver: Ang. Diff.	Elevation	
B.M.			1.23	8.28		7.05	MON. # 111
0+00					8.0	0.3	INTERSECTION OF EXISTING 10" LINE WITH NEW 6" LINE 10" X 6" REDUCER.
0+05					8.2	0.1	
1+00					7.0	1.3	
2+00					7.5	0.8	
3+00					8.0	0.3	
4+00					7.8	0.5	
5+00					8.1	0.2	
6+00					7.5	0.8	
7+00					6.8	1.5	
8+00					5.9	2.4	
B.M. (T.P.)			4.595	11.645	1.23	7.05	MON. # 111
9+00					8.0	3.6	
10+00					8.2	3.4	
11+00					7.8	3.8	

TABLE

SUBJECT PROFILE ON WATER LINE
CONT.Return To
Public Works
Office
Camp Lejeune
North Carolina

FIELD PARTY

In Charge WELLMAN
Instrument _____
Notes _____
Tape Read _____
Tape or Rod _____
Tape or Rod _____
Instrument No. _____
Tape No. _____

WEATHER

Clear _____
Cloudy _____
Windy _____
Rain _____
Fair _____
Snow _____
Hot _____
Moderate _____
Cold _____
Fog _____FILE No. 221-T

Fldr. No. _____

Sheet 1-OF-6Date 2-6 1916

Quad. No. _____

Station	Dist.	Angle	"	+	H. I. Bearing	Ver. Ang. Diff.	Elevation	
					11.645 ✓			
1147B					7.5	4.1		ON 6"X6"X6" TEE TO HYDRANT
					7.5	4.1		6' OFF OF MAIN TO RIGHT
					7.5	4.1		AT HYDRANT 10' OFF MAIN TO RIGHT
11498					7.7	3.9		6"X6"X4" TEE TO BATH HOUSE
					7.8	3.8		7' TO 4" VALVE
12402					7.7	3.9		TO 6" VALVE
					6.2	5.4		99' OFF MAIN AT BATH HOUSE
T.P.	5.34	13.225	3.76	7.885 ✓				ON BOLT ON FIRE HYDRANT
13400					9.5	3.7		
14410					9.3	3.9		
15400					8.6	4.6		
16400					8.4	4.8		
17400					5.8	7.4		
18400					6.5	6.7		
19400					7.1	6.1		

















TABLE

SUBJECT PROFILE ON WATER LINE
AT HURST BEACH CONT.

Return To
Public Works
Office
Camp Lejeune
North Carolina

FIELD PARTY

____ In Charge
____ Instrument
____ Notes
____ Tape Read
____ Tape or Rod
____ Tape or Rod
____ Instrument No.
____ Tape No.

WEATHER

Clear
Cloudy
Windy
Rain
Fair

Snow
Hot
Moderate
Cold
Fog

FILE No. 221-T
Fidr. No. _____
Sheet 5-OF-6
Date 2-7 1916
Quad. No. _____

Station	Dist.	Angle	H. I. Bearing	Ver. Ang. Diff.	Elevation
			13.225		
20+00				7.1	6.1
B.M.				4.57	8.655 <u>8.670</u>
B.M.	3.14	118.1		7.1	8.67
21+00				7.6	4.2
21+97				7.7	4.1
				7.7	4.1
				7.7	4.1
22+00				7.7	4.1
23+00				8.1	3.7
24+00				7.9	3.9
25+00				7.4	4.4
26+00				6.6	5.2
T.P.	3.79	116.3		3.97	7.84
27+00				7.9	3.7


MAN. # 112

MAN. # 112

TEE - 6" X 6" X 6"

6" VALVE 3' TO LEFT OF MAIN

HYD. 5.5' TO LEFT OF MAIN

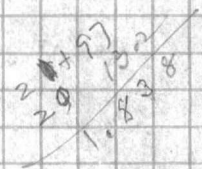

















TABLE

SUBJECT

PROFILE ON WATER LINE

AT HURST BEACH CONT.

Return To
Public Works
Office
Camp Lejeune
North Carolina

FIELD PARTY

NEELUM In Charge
Instrument
Notes
Tape Read
Tape or Rod
Tape or Rod
Instrument No.
Tape No.

WEATHER

Clear
Cloudy
Windy
Rain
Fair

Snow
Hot
Moderate
Cold
Fog

FILE No. 221-T

Fldr. No.

Sheet 6-OF-6

Date 2-7 1946

Quad. No.

Station	Dist.	Angle	"	+	H. I. Bearing	Ver: Ang. Diff.	Elevation	
					11.63	✓		
28+00						7.6	4.0	
29+00						7.4	4.2	
30+00						7.0	4.6	
31+00						6.6	5.0	
T.P.	4.60	13.44			2.79	8.84	✓	
32+00						7.2	6.2	
33+00						7.5	5.9	
33+00						7.9	5.5	ON 6"X6"X6" TEE
						7.9	5.5	3' OFF MAIN TO LEFT (VALVE)
						7.9	5.5	HYD. 6' OFF MAIN TO LEFT
34+00						7.7	5.7	6"X6"X4" TEE
						7.8	5.6	4" VALVE 7' TO RIGHT OF MAIN
						7.1	6.3	25' TO RIGHT ON END OF 4" LINE TO BATH HOUSE
B.M.					5.68	7.76	✓	MON. # 143
						7.74		














VALUABLE

RETURN TO
PUBLIC WORKS
OFFICE
CAMP BUNNING
NEW RIVER N.S.
















VALUABLE

RETURN TO
PUBLIC WORKS
OFFICE
CAMP LEJEUNE
NORTH CAROLINA


SUBJECT Location fence @
Onslow Beach
Sneeds ferry Fire tower
Hubert fire tower
Trans former @ foot of
Onslow Beach Rd. & Courthouse Bay Emb.

FIELD PARTY
Calk IN CHARGE
INSTRUMENT
NOTES
TAPE READ
TAPE OR ROD
TAPE OR ROD
INSTRUMENT NO.
TAPE NO.

WEATHER
CLEAR
CLOUDY
WINDY
RAIN
FAIR
SNOW
HOT
MODERATE
COLD
FOG
FIGURED BY
NOTES CHECKED BY
PLOTTED BY

FILE No. 221-T
FLDR. No. _____
SHEET 1 of
DATE 2-8 1951

Quad. No. _____

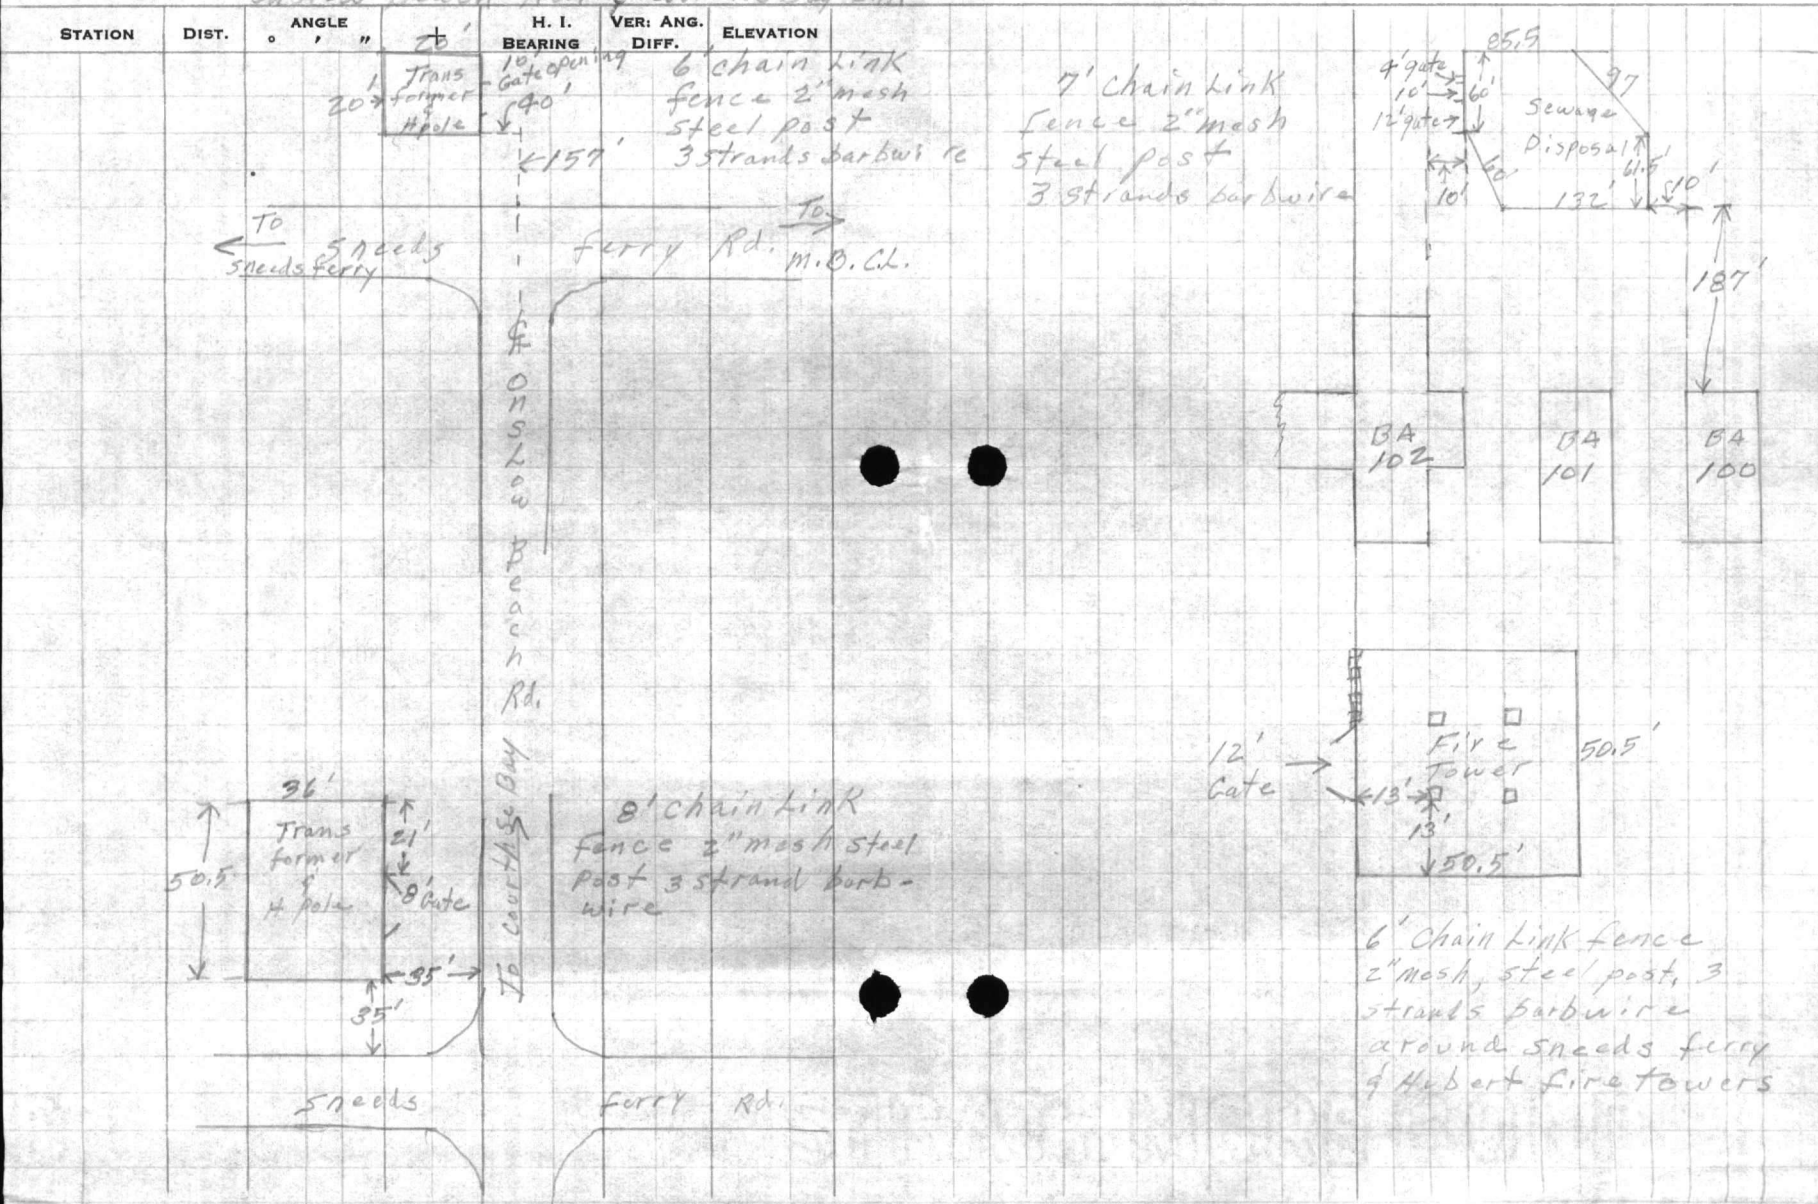










VALUABLE

SUBJECT

sewer Man holes,
Power Line & Road
Location, Onslow Beach.

Return To
Public Works
Office
Camp Lejeune
North Carolina

FIELD PARTY

McClung In Charge
Hamilton Instrument
Benson Notes
Tyrance Tape Read
Tape or Rod
Tape or Rod
Instrument No.
Tape No.

WEATHER

Clear
Cloudy
Windy
Rain
Fair
Snow
Hot
Moderate
Cold
Fog

FILE No. 221-T

Fldr. No.

Sheet # 1 of 1

Date 13 Feb 1946


Figured By

Notes Checked By

Plotted By

Quad. No. 221

Station	Dist.	Angle	H. I.	Ver. Ang.	Elevation
"	"	"	Bearing	Diff.	"

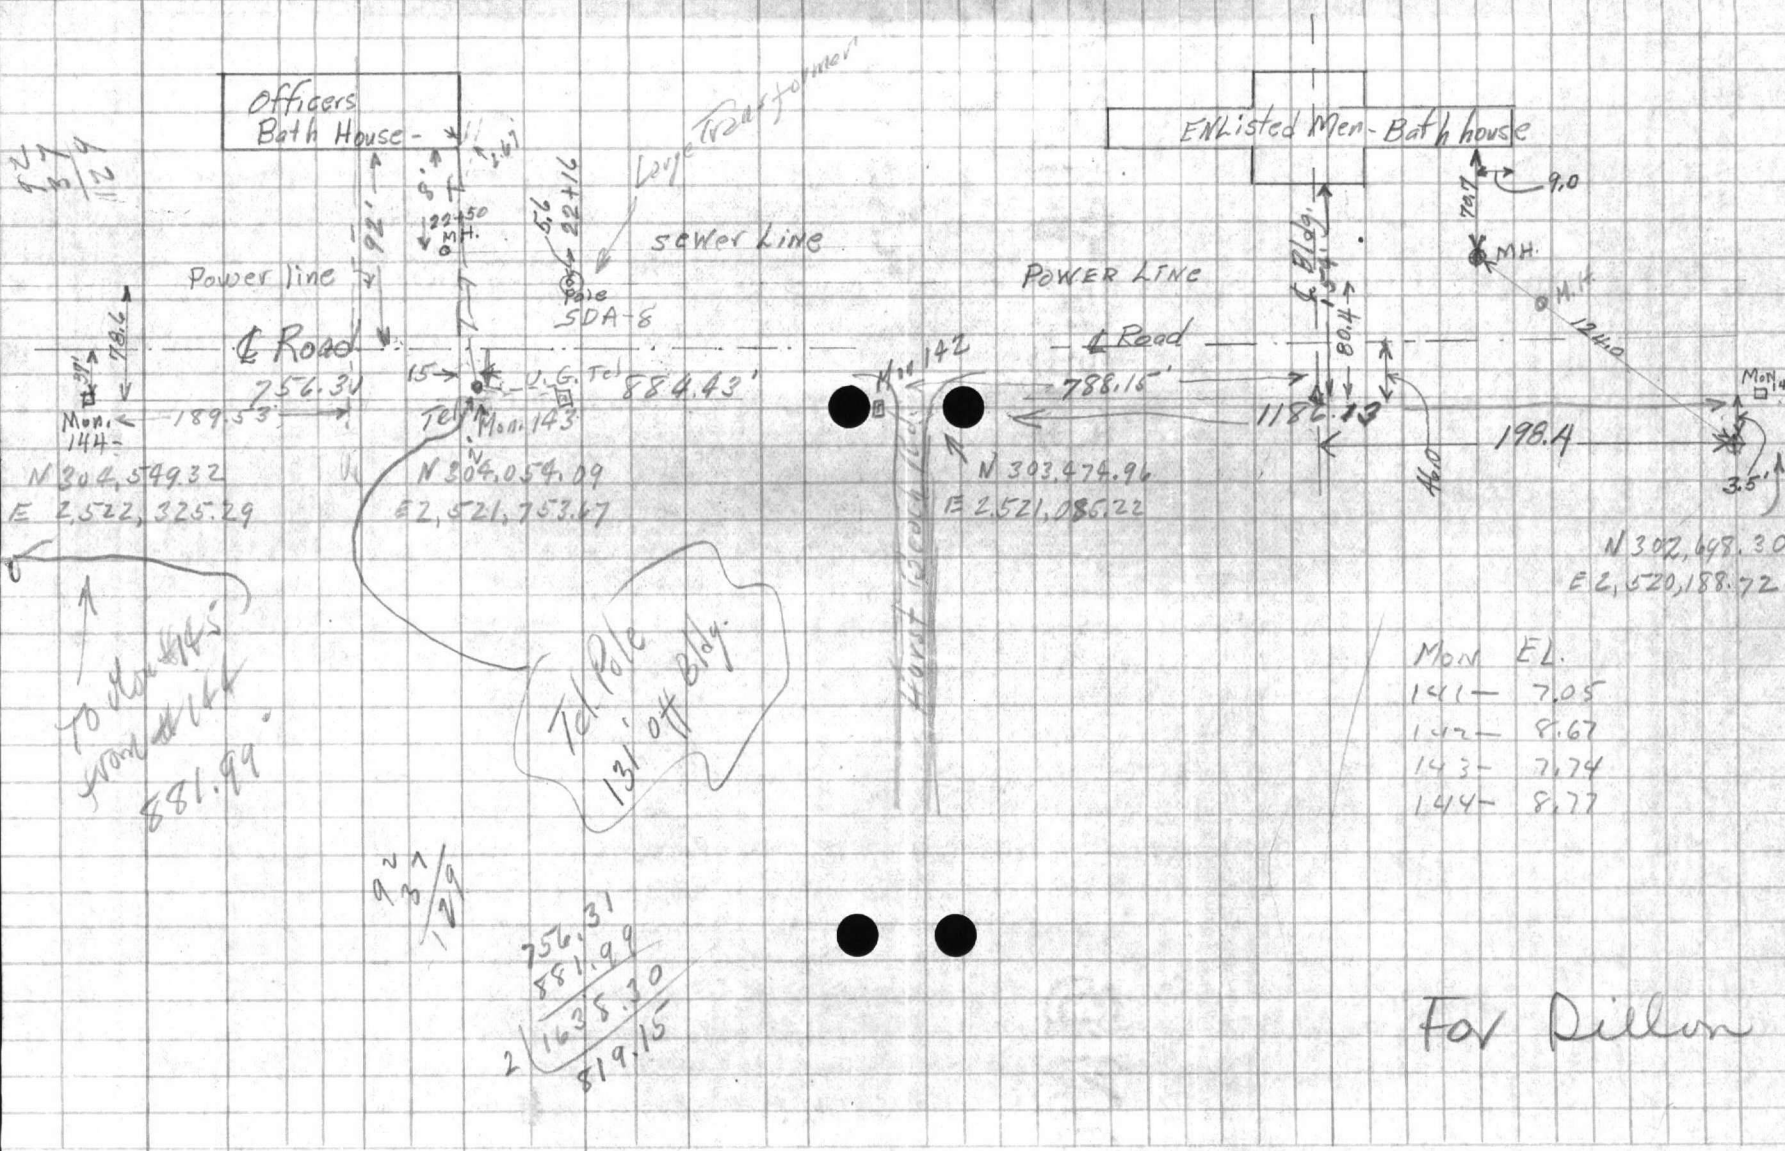

Mon	EL.
141	7.05
142	8.67
143	7.74
144	8.77

For Dillon

AVAILABLE

Return To
Public Works
Office
Camp Lejeune
North Carolina

SUBJECT

FIELD PARTY

WEATHER

Clear
Snow
Fog
Moderate
Wind
Cloudy
Hot

Plotted BY

Checked BY

Plotted BY

GEN. NO.

THE NO.

DATE

SHEET

DATE

Station

Dist

Angle


+

Baroid

H. I.

Baroid

Alt. Ang. Elevation

 







 




Power Line
Custow Besch































VALUABLE

SUBJECT _____

FIELD PARTY

_____ In Charge
 _____ Instrument
 _____ Notes
 _____ Tape Read
 _____ Tape or Rod
 _____ Tape or Rod
 _____ Instrument No.
 _____ Tape No.

WEATHER

Clear
 Cloudy
 Windy
 Rain
 Fair

Snow
 Hot
 Moderate
 Cold
 Fog

FILE No. _____

Fldr. No. _____

Sheet 201

Date _____ 19__

Quad. No. _____

Station	Dist.	Angle "	+	H. I. Bearing	Ver: Ang. Diff.	Elevation													
				M 31			Left					Right							
3775							300	275											
							137	128											
							06	25											
							E. Rd E. Rd												
470							85	50	39	26	17	8	32	62	92	117	163		
+20	Power Pole	70'	Left				49	73	76	66	75	8.3	86	84	69	56	7.0		
+41	Tel. Pole	2'	Left				94	70	67	77	68	60	57	59	74	87	73		
							225	200	173	144	117		180						
							107	91	65	37	15		4.8						
							3.6	52	78	106	128		9.5						
							300	275	250										
							135	126	115										
							08	17	28										
							E. Rd E. Rd												
4745							93	78	51	31	26	17	8	37	67	96	118	144	
							44	62	73	75	65	79	80	81	82	85	71	7.9	
							99	87	70	68	78	64	63	62	61	58	72	64	
							225	200	172	145	118		180						
							107	87	62	26	26		82						
							3.6	58	81	117	117		41						
							300	275	250										
							134	123	113										
							09	20	30										
							E. Rd E. Rd												
4758							100	76	51	30	24	16	8	45	63	90	121	146	165
							53	56	74	75	66	77	8.3	84	80	8.8	64	80	74
							90	87	69	68	77	66	60	59	63	55	79	63	69















VALUABLE

SUBJECT _____

Return To
 Public Works
 Office
 Camp Lejeune
 North Carolina

FIELD PARTY

_____ In Charge
 _____ Instrument
 _____ Notes
 _____ Tape Read
 _____ Tape or Rod
 _____ Tape or Rod
 _____ Instrument No.
 _____ Tape No.

WEATHER

Clear
 Cloudy
 Windy
 Rain
 Fair
 Snow
 Hot
 Moderate
 Cold
 Fog
 Figured By _____
 Notes Checked By _____
 Plotted By _____

FILE No. _____
 Fldr. No. _____
 Sheet 709
 Date _____ 19__

Quad. No. _____

Station	Dist.	Angle "	+	H. I. Bearing	Ver: Ang. Diff.	Elevation											
				15 60													
5450							ERL	ERL									
							52	30	28	19	2	50	70	88	100		
							88	86	77	92	96	91	82	101	101		
							68	70	79	64	60	65	74	55	55		
							124	100	89	73		144	154	166	175		
							34	74	70	89		95	103	91	87		
							126	82	86	67		61	53	65	69		
5489		Tel. pole	2' East														
							169	144	135								
							+5.1	+73	+28								
							207	229	184								
							250	200	173								
							12.1	97	33								
							3.5	59	123								
							ERL	ERL									
640							77	57	30	28	17	2	50	77	100	150	
							90	86	85	78	94	95	89	104	82	94	
							66	70	71	78	67	61					
							145	137	129	92		175					
							+35	1.0	51	69		95					
							141	146	105	97		61					
							168	164	152								
							+52	+60	+60								
							208	216	216								
							277	261	218	190	175						
							13.0	11.7	108	79	21						
							2639	48	77	135							

VALUABLE

SUBJECT _____

Return To
 Public Works
 Office
 Camp Lejeune
 North Carolina

FIELD PARTY

_____ In Charge
 _____ Instrument
 _____ Notes
 _____ Tape Read
 _____ Tape or Rod
 _____ Tape or Rod
 _____ Instrument No.
 _____ Tape No.

WEATHER

Clear
 Cloudy
 Windy
 Rain
 Fair

Snow
 Hot
 Moderate
 Cold
 Fog

FILE No. _____

Fldr. No. _____

Sheet 501

Date _____ 19__

Quad. No. _____

Station	Dist.	Angle	H. I. Bearing	Ver: Ang. Diff.	Elevation
			15 60		
6430	Power Pole	79° Left			
+50					
					ERd ERd
					50 31 29 20 6 37 71 100 103
					83 82 66 82 90 84 10.7 101 98
					73 74 90 74 66 72 51.2 55 58
					127 93 87 83 175
					52 81 71 79 101
					104 75 85 77 53
					168 152 145 137
					157 140 137 11
					213 226 193 14.5
					287 256 203 180
					140 122 96 44
6490	Concrete sewer	84° Left	10.78	5 42	invert. Elev
	2 1/2' x 4 1/2' outside		6.99	8 61	Top MH
			8.7	6 3	ground
740					ERd
					30 30 25 17 8 19 46 64 98
					83 82 63 75 6.9 34 65 79 10.1
7404	Fire Hyd	56° Left			
					73 74 93 81 87 120 91 77 55
+04	Water Valve	58° Left	742	8 18	
					136 124 115 100 100 132 175
					+60 1.0 59 76 81 103 10.2
+38	Tet pole	3° Left			
					216 146 97 80 75 55 54
					208 194 180 168 149
					100 82 29 +73 +11.7
					56 74 127 22 9 273











VALUABLE

SUBJECT _____

 Return To
 Public Works
 Office
 Camp Lejeune
 North Carolina

FIELD PARTY

_____ In Charge
 _____ Instrument
 _____ Notes
 _____ Tape Read
 _____ Tape or Rod
 _____ Tape or Rod
 _____ Instrument No.
 _____ Tape No.

WEATHER

Clear
 Cloudy
 Windy
 Rain
 Fair
 Snow
 Hot
 Moderate
 Cold
 Fog
 Figured By _____
 Notes Checked By _____
 Plotted By _____

FILE No. _____
 Fldr. No. _____
 Sheet 60
 Date _____ 19__

Quad. No. _____

Station	Dist.	Angle	"	+	H. I. Bearing	Vert. Ang. Diff.	Elevation	Left				Right					
					15 60												
770									190	156							
									40	120							
									16	3.6							
									ER6	ER6							
780									50	31	24	17	2	35	68	85	100
									88	82	70	86	87	75	94	102	96
									73	74	86	70	69	81	62	74	50
									100	90	85	76		150	177		
									78	79	66	81		100	100		
									76	77	90	75		56	56		
									140	131	122	118					
									+5.7	1.1	53	66					
									21.3	4.5	103	90					
									196	180	164	149					
									90	34	+64	+100					
									66	122	220	256					
									290	251	219						
									142	122	110						
									1.4	3.4	4.6						
									ER6	ER6							
840									50	32	23	14	2	19	35	56	77
									81	83	68	89	92	81	74	94	92
									75	73	88	67	64	75	82	62	64
									129	100	84	75		85	100	102	
									50	76	69	78		84	94	103	
									106	80	87	78		72	62	53	

2353

1176

































































































VALUABLE

SUBJECT Base Line and Taping for
Relocated Area for
Civilian Beach House

RETURN TO
PUBLIC WORKS
OFFICE
CAMP LEJEUNE
NORTH CAROLINA

FIELD PARTY
Morris IN CHARGE
Dillon INSTRUMENT
NOTES
TAPING READ
TAPING OR ROD
TAPING OR ROD
INSTRUMENT NO.
TAPING NO.

WEATHER
CLEAR
CLOUDY
WINDY
RAIN
FAIR ✓
SNOW
HOT
MODERATE ✓
COLD
FOG
FIGURED BY
NOTES CHECKED BY
PLOTTED BY

FILE No. 221-T
FLDR. No.
SHEET #1 of 5
DATE 11-5-62
1962

Quad. No. _____

STATION	DIST.	ANGLE " "	+	H. I. BEARING	VER. ANG. DIFF.	ELEVATION
Mon. #143				✓		7.74
	3.61	11.35		✓		10.45
Top Nut				✓	0.90	10.45
	1.69	12.14		✓		8.11
B.M.					4.03	8.11

check
Fire Hydrant
Nail in Base of Load Coil Tel. Pole 200' ± North
of Road Intersection.

Sight on U.S.N. # 40

P.O.T. 954.25
00° 00'
Mon. U.S.M.C. # 143

549° 05' 45" W →

Tack 5' above Ground Tel Pole Reference

E 0611 1190

VALUABLE

SUBJECT _____

RETURN TO
PUBLIC WORKS
OFFICE
CAMP LEJEUNE
NORTH CAROLINA

FIELD PARTY

 _____ IN CHARGE
 _____ INSTRUMENT
 _____ NOTES
 _____ TAPE READ
 _____ TAPE OR ROD
 _____ TAPE OR ROD
 _____ INSTRUMENT No.
 _____ TAPE No.

WEATHER

 CLEAR _____ SNOW _____
 CLOUDY _____ HOT _____
 WINDY _____ MODERATE _____
 RAIN _____ COLD _____
 FAIR _____ FOG _____

FILE No. _____

FLDR. No. _____

SHEET #2 of 8


FIGURED BY _____



NOTES CHECKED BY _____

PLOTTED BY _____ DATE 1-5-1962

Quad. No. _____

CLOCKWISE

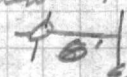STATION	DIST.	ANGLE ° ' "	+	H. I. BEARING	VER: ANG. DIFF.	ELEVATION	
Sight on Mon #143 ROT #1		0-00	4.30	12.41		8.11	
#1	123'	8°-30'		12.41	4.7	7.7	ER
#2	130'	20°-38'			4.9	7.5	ER
#3	320'	3°-00'			5.6	6.4	ER
#4	322'	8°-05'			5.5	6.9	ER
#5	328'	14°-00'			3.3	9.1	P.P.
#6	276'	18°-12'			1.32	11.04	M.H. (Center 4'SQUARE TOP)
#7	254'	13°-00'			4.3	8.1	F.HyD. 
#8	132'	36°-37'					PP
#9	54'	58°-08'			4.7	7.7	ER
#10	80'	51°-17'			4.5	7.9	GS
#11	93'	56°-28'			2.8	9.6	GS
#12	79'	81°-33'			4.7	8.2	GS
#13	85'	101°-45'			3.9	8.5	GS
#14	70'	101°-45'			5.1	7.3	GS
#15	48'	107°-35'			4.7	7.7	ER
#16	91'	167°-22'			4.8	7.6	E.R
#17	100'	152°-04'			4.8	7.6	ER
#18	104'	147°-35'			3.8	8.6	V.A. BOX
#19	112'	143°-07'			4.5	7.9	GS
#20	123'	139°-45'			2.9	9.5	P.P. (TRANSFORMER)
#21	109'	133°-47'			1.8	10.6	GU4
#22	138'	132°-25'			0.2	12.2	GU4
#23	120'	134°-08'			2.18	10.22	CENTER TOP OF MH (3X4)
#24	150'	146°-58'			4.4	8.0	FRONT CORNER OF L.S.
#25	155'	144°-22'			3.9	8.5	" " " "

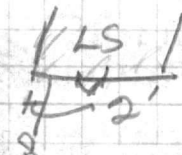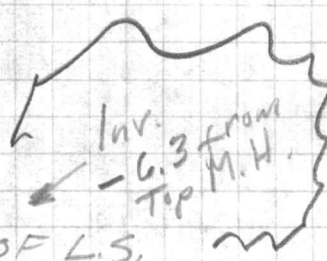




















VALUABLE

SUBJECT _____

 RETURN TO
 PUBLIC WORKS
 OFFICE
 CAMP LEJEUNE
 NORTH CAROLINA

FIELD PARTY

 _____ IN CHARGE
 _____ INSTRUMENT
 _____ NOTES
 _____ TAPE READ
 _____ TAPE OR ROD
 _____ TAPE OR ROD
 _____ INSTRUMENT NO.
 _____ TAPE NO.

WEATHER

 CLEAR
 CLOUDY
 WINDY
 RAIN
 FAIR
 SNOW
 HOT
 MODERATE
 COLD
 FOG

FILE No. _____

FLDR. No. _____

SHEET

DATE

Quad. No. _____

STATION	DIST.	ANGLE ° ' "	+	H. I. BEARING	VER: ANG. DIFF.	ELEVATION	
				12.41			
#26	161'	149°-40'			4.3	81	BACK COR OF L.S.
#27	280'	163°-22'			3.2	92	P.P.
#28	327'	174°-10'			4.1	83	CENTER OF ROAD INTERSECTION
#29	174'	173°-23'			4.9	75	E.R.
#30	183'	165°-18'			4.8	76	E.R.
#31	130'	218°-18'			4.8	76	P.P.
#32	62'	195°-07'			4.9	75	G.S.
#33	145'	251°-23'			4.5	79	G.S.
#34	157'	304°-00'			5.0	74	G.S.
#35	65'	307°-20'			4.6	78	G.S.
#36	108'	353°-08'			4.5	79	G.S.
#37	113'	90°-00'					PI #2
	P1 #2	0-00		BS ON POT #1 ✓		811	TBM
				11.78 19.89			
#38	50'	324°-47'			12.0	79	GS
#39	38'	310°-45'			10.0	99	GS
#40	32'	294°-53'			6.5	13.4	GS
#41	29'	279°-15'			2.7	172	GS
#42	28'	265°-48'			3.3	166	GS
#43	33'	235°-00'			8.4	115	GS
#44	46'	213°-43'			12.2	77	GS
#45	64'	204°-22'			13.6	63	GS
#46	132'	192°-04'			13.5	64	GS
#47	133'	162°-42'			13.3	66	GS
#48	90'	154°-12'			13.4	65	GS
#49	60'	142°-00'			13.0	69	GS
#50	46'	127°-37'			11.01	8.8	GS













VALUABLE

SUBJECT _____

 RETURN TO
 PUBLIC WORKS
 OFFICE
 CAMP LEJEUNE
 NORTH CAROLINA

FIELD PARTY

 IN CHARGE

 INSTRUMENT

 NOTES

 TAPE READ

 TAPE OR ROD

 TAPE OR ROD

 INSTRUMENT No. _____
 TAPE No. _____

WEATHER

CLEAR
 CLOUDY
 WINDY
 RAIN
 FAIR

SNOW
 HOT
 MODERATE
 COLD
 FOG

FILE No. _____
 FLDR. No. _____
 SHEET #4 of 5
 DATE 1-5-1922

FIGURED BY _____
 NOTES CHECKED BY _____
 PLOTTED BY _____
 Quad. No. _____

STATION	DIST.	ANGLE ° ' "	+	H. I. BEARING	VER: ANG. DIFF.	ELEVATION	
				19.89			
#51	39'	112°-52'			7.8	12.1	G.S.
#52	36'	90°-00'			1.5	18.4	G.S.
#53	37'	77°-40'		(19.9)	2.7	17.2	G.S.
#54	42'	56°-07'			8.3	11.6	G.S.
#55	50'	45°-12'			11.0	8.9	G.S.
#56	83'	54°-03'			11.1	9.8	G.S.
#57	81'	58°-50'			8.1	11.8	G.S.
#58	76'	67°-22'			4.1	15.8	G.S.
#59	70'	84°-10'			0.5	19.4	G.S.
#60	70'	77°-00'			+1.5	20.9	G.S.
#61	95'	81°-00'			+1.0	20.4	G.S.
#62	82'	85°-13'			+1.1	20.5	G.S.
#63	81'	93°-37'			4.0	15.9	G.S.
#64	84'	106°-03'			9.0	10.9	G.S.
#65	91'	117°-15'			12.3	7.6	G.S.
#66	108'	129°-36'			13.4	6.5	G.S.
#67	157'	144°-48'			13.3	6.6	G.S.
#68	154'	211°-10'			13.7	6.3	G.S.
#69	125'	220°-50'			13.5	6.4	G.S.
#70	105'	232°-30'			13.9	6.0	G.S.
#71	93'	243°-33'			12.0	7.0	G.S.
#72	87'	253°-00'			9.0	10.9	G.S.
#73	83'	264°-55'			1.5	18.4	G.S.
#74	82'	268°-22'			1.6	18.3	G.S.
#75	84'	275°-15'			6.1	13.8	G.S.
#76	88'	285°-35'			9.7	10.2	G.S.
#77	71'	285°-40'			7.3	12.6	G.S.
#78	61'	279°-35'			5.4	14.5	G.S.
#79	55'	270°-00'			1.1	18.8	G.S.

STATE

WIND
TEMP
PRESS
HUMIDITY
DIRECTION
SPEED








VALUABLE

SUBJECT _____

RETURN TO
PUBLIC WORKS
OFFICE
CAMP LEJEUNE
NORTH CAROLINA

FIELD PARTY

 _____ IN CHARGE
 _____ INSTRUMENT
 _____ NOTES
 _____ TAPE READ
 _____ TAPE OR ROD
 _____ TAPE OR ROD
 _____ INSTRUMENT No.
 _____ TAPE No.

WEATHER

 CLEAR
 CLOUDY
 WINDY
 RAIN
 FAIR
 SNOW
 HOT
 MODERATE
 COLD
 FOG

FILE No. _____

FLDR. No. _____

SHEET # 5 of 5

FIGURED BY _____

NOTES CHECKED BY _____

PLOTTED BY _____

DATE _____ 19__

Quad. No. _____

STATION	DIST.	ANGLE ° ' "	+	H. I. BEARING	VER: ANG. DIFF.	ELEVATION	
4.80	9	281°-45'		1789	4.7	15.2	G.S.
#81	9	90°-00		(19.9)	4.4	15.5	G.S.
					11.78		TBM

TABLET

SUBJECT

RETURN TO:
BUREAU WORKS
OFFICE
CAMP LABRANT
NORTH CAROLINA

STATION DIST. AND

H.P. VERT. AND
BEARING DIFF. ELEVATION

TABLE NO.
INSTRUMENT NO.

TABLE OR ROD

TAPK OR ROD

TAPK TREAD

TABLET

TREATMENT

H. CHARGE

TABLE NO.

CHARGE BY

FIGURED BY

SHEET

NO.

TABLET

NO.

TABLET

STANDARD

NO. 1

STATION
DATE
TIME
OBSERVER






































































VALUABLE

RETURN TO
PUBLIC WORKS
DIVISION
CAMP LEONIE
NORTH CAROLINA

OBJECT

STATION

DATE

1942

READING

DIR.

H. J. VAN ARMAN
ELEVATION

TAPE NO.

RUNNING NO.

TAPE OR ROD

TAPE OR ROD

TAPES READ

LEADS

ARRANGEMENT

IN CHARGE

FIELD PARTY

WIND

WIND

VALUABLE
 SUBJECT Typical beach cross
sections AT onslow beach
for Bldg. site

 RETURN TO
 PUBLIC WORKS
 OFFICE
 CAMP LEJEUNE
 NORTH CAROLINA

FIELD PARTY

 _____ IN CHARGE
 _____ INSTRUMENT
 _____ NOTES
 _____ TAPE READ
 _____ TAPE OR ROD
 _____ TAPE OR ROD
 _____ INSTRUMENT NO.
 _____ TAPE NO.

WEATHER

 CLEAR SNOW
 CLOUDY HOT
 WINDY MODERATE
 RAIN COLD
 FAIR FOG

FILE No. _____

FLDR. No. _____

SHEET 3-of

NOTES CHECKED BY _____

PLOTTED BY _____ DATE 10-22 1958

Quad. No. _____

STATION	DIST.	ANGLE ° ' "	+	H. I. BEARING	VER. ANG. DIFF.	ELEVATION
---------	-------	----------------	---	------------------	--------------------	-----------

B.M.						15.00
------	--	--	--	--	--	-------

		0.30		15.30		
--	--	------	--	-------	--	--

T.P.					0.95	14.35
------	--	--	--	--	------	-------

		4.54		18.89		
--	--	------	--	-------	--	--

Typical section approx.
 Midway between officer (B.M.)
 Bath House and Civ. Bath House

ocean side

(Power etc.)

(Edge Rd.)

0	50	100	147	160	185	200	222
---	----	-----	-----	-----	-----	-----	-----

14.0	13.2	11.7	2.8	2.0	8.4	10.0	10.0
------	------	------	-----	-----	-----	------	------

4.9	5.7	7.2	16.1	16.9	10.5	8.9	8.9
-----	-----	-----	------	------	------	-----	-----

T.P.					8.95	9.94
------	--	--	--	--	------	------

		4.50		14.44		
--	--	------	--	-------	--	--

B.M. (T.P.)					3.40	11.04
-------------	--	--	--	--	------	-------

		2.05		13.10		
--	--	------	--	-------	--	--

T.P.					6.73	6.37 ✓
------	--	--	--	--	------	--------

		2.80		9.17		
--	--	------	--	------	--	--

T.P.					0.69	8.48 ✓
------	--	--	--	--	------	--------

		12.29		20.77		
--	--	-------	--	-------	--	--

Typical section North East of Civ. Bath House

ocean side

(20.8)

0	50	100	149	200	225	246
---	----	-----	-----	-----	-----	-----

20.7	19.4	18.2	0.0	+4.0	2.0	9.7
------	------	------	-----	------	-----	-----

0.1	1.4	2.6	20.8	24.8	18.8	11.1
-----	-----	-----	------	------	------	------

Floor of officers Bath House

Section B-1

295	318	343	400	450	500	600
-----	-----	-----	-----	-----	-----	-----

7.9	6.2	10.6	10.2	11.5	10.3	12.4
-----	-----	------	------	------	------	------

11.0	12.7	8.3	8.7	7.4	8.6	6.5
------	------	-----	-----	-----	-----	-----

CITY
RAIN
700
 used for going ahead
 (11.05) Floor Civ. Bath House BA-134

Typical section North East of Civ. Bath House Section B-2

(E bend rd)

300	337	357
-----	-----	-----

11.6	8.8	16.7
------	-----	------

9.2	12.0	4.1
-----	------	-----





























VALUABLE

SUBJECT

Typical X-Sections
 Beach House Sites
 Onslow Beach

RETURN TO
 PUBLIC WORKS
 OFFICE
 CAMP LEJEUNE
 NORTH CAROLINA

FIELD PARTY
 Dillon IN CHARGE
 INSTRUMENT
 NOTES
 TAPE READ
 TAPE OR ROD
 TAPE OR ROD
 INSTRUMENT No.
 TAPE No.

WEATHER
 CLEAR
 CLOUDY
 WINDY
 RAIN
 FAIR
 SNOW
 HOT
 MODERATE
 COLD
 FOG
 FIGURED BY
 NOTES CHECKED BY
 PLOTTED BY

FILE No.
 FLDR. No.
 SHEET
 DATE 1/29/1959

Quad. No.

STATION	DIST.	ANGLE " "	+	H. I. BEARING	VER. ANG. DIFF.	ELEVATION
---------	-------	--------------	---	------------------	--------------------	-----------

Officers Beach House Section

Midway between Officers Beach House (Existing) Bldg. # BA-118 and Enlisted Bath House Bldg. BA-116

Approx. M.S.L. Elev. 6.5

0+0
 E
 R.L. Elev. 6.5

0
 0.0
 6.5

30
 -0.1
 6.4

Electric Line 47
 Sewer Line 52

Machine made Dune
 55 63 83 88 91 12.2 172
 +1.1 +4.9 +11.7 +11.8 +11.8 +1.5 -1.5
 7.6 11.4 17.9 18.3 18.3 8.0 5.0

Enlisted Beach House Section

Midway between Enlisted Bath House Bldg. BA-116 and Water Tank structure S-BA-108

Approx. M.S.L. Elev. 5.5

0+0
 E
 R.L. Elev. 5.5

0
 0.0
 5.5

Electric Line 51
 70
 +0.8
 6.3

98
 +2.2
 7.7

Natural ← Man made Dune
 116 130 149 157 182 232
 +4.3 +8.3 +11.3 +11.3 +3.3 +1.1
 9.8 13.8 16.8 16.8 8.8 6.6

VALUABLE

RETURN TO
PUBLIC WORKS
OFFICE
DANFELBERT
NORTH CAROLINA

SUBJECT

Station Dist.

ANGLE

BEARING

H. I. V. AND
DIRE.

ELEVATION

TAP NO.

PERMIT NO.

TAP OR HOPE
















VALUABLE

SUBJECT LOCATION EXISTING
SEWER MAN HOLES
UNSLow BEACH

RETURN TO
 PUBLIC WORKS
 OFFICE
 CAMP LEJEUNE
 NORTH CAROLINA

FIELD PARTY
DENNIS IN CHARGE
 _____ INSTRUMENT
 _____ NOTES
 _____ TAPE READ
 _____ TAPE OR ROD
 _____ TAPE OR ROD
 _____ INSTRUMENT No.
 _____ TAPE No.

WEATHER
 CLEAR _____ SNOW
 CLOUDY _____ HOT
 WINDY _____ MODERATE
 RAIN _____ COLD
 FAIR _____ FOG
 FIGURED BY _____
 NOTES CHECKED BY _____
 PLOTTED BY _____


FILE No. 221-T
 FLDR. No. _____
 SHEET 1 of 1
 DATE 3-13-59

Quad. No. _____

STATION	DIST.	ANGLE " "	H. I. BEARING	VER. ANG. DIFF.	ELEVATION
---------	-------	--------------	------------------	--------------------	-----------

See V&D #305036
 Note = Long size Tracing
 Enlisted Bath House
 V&D #305089
 Officers Bath House
 Reg. Tracing

13467.05 A
 10492.40
 274.65

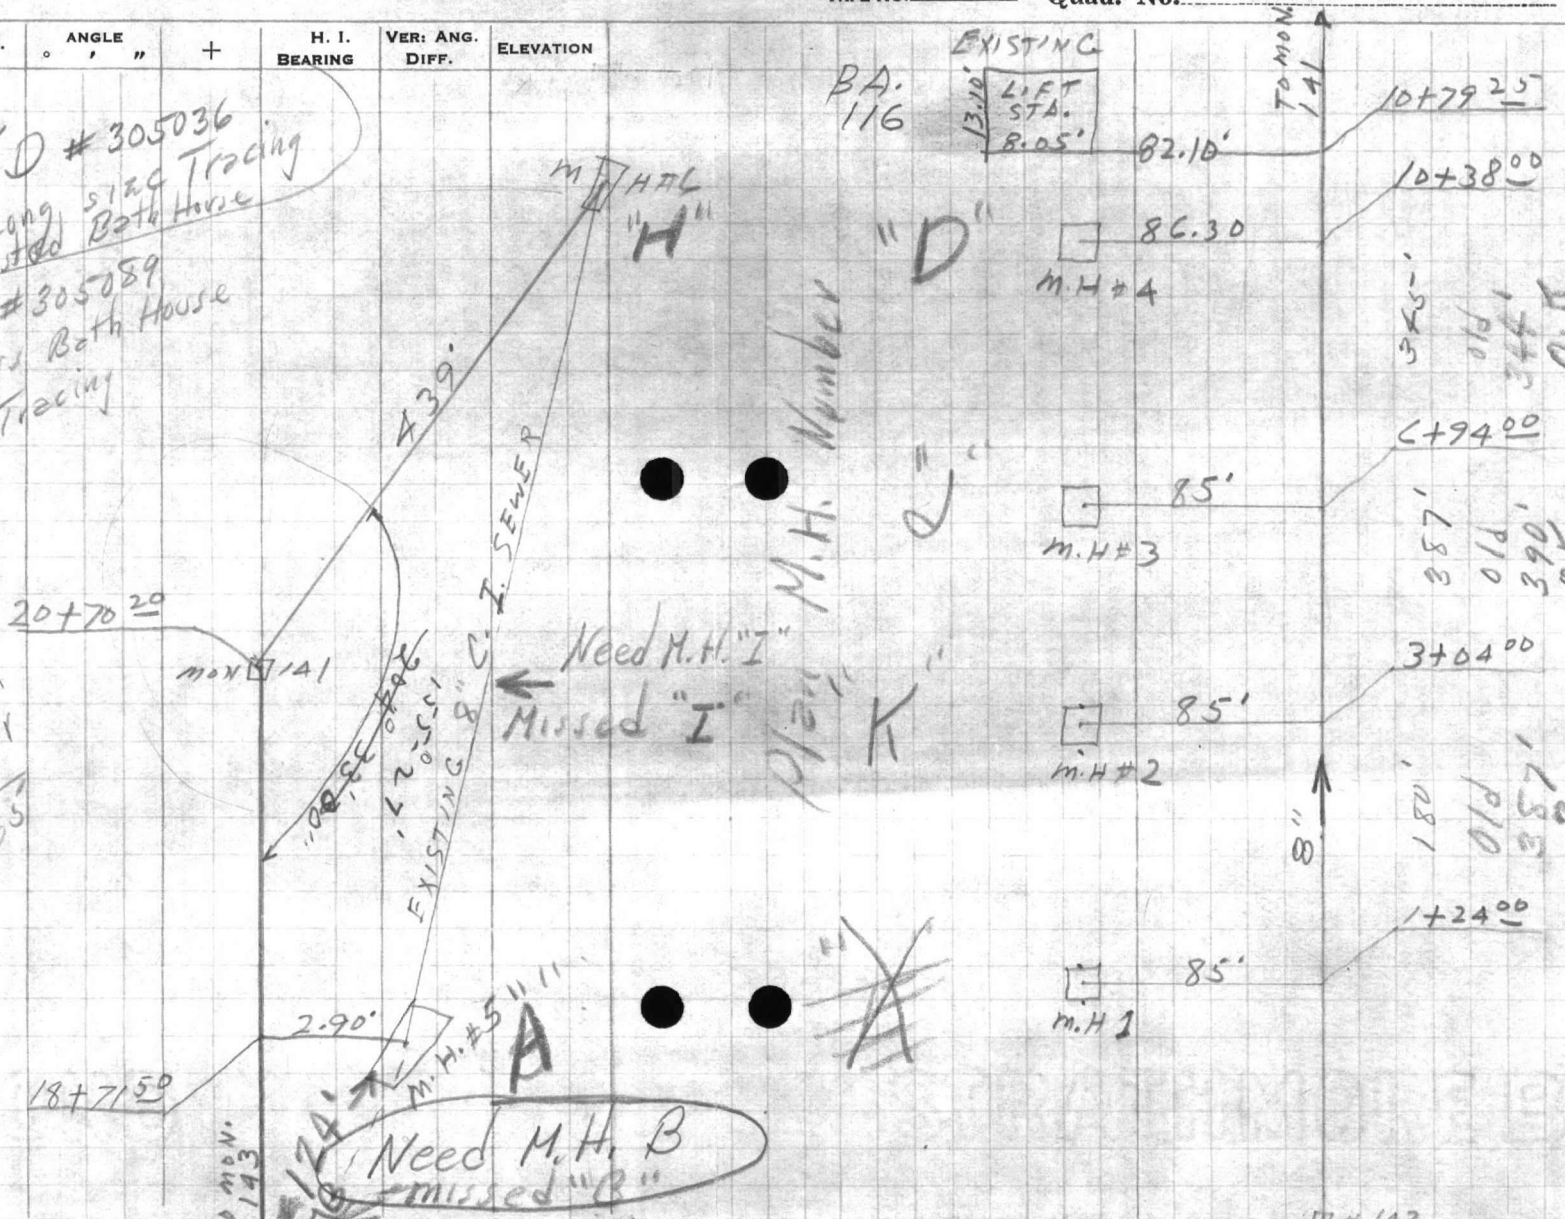

Need M.H. "I"
 Missed "I"

Need M.H. B
 Missed "B"

Plan M.H. Number
 "D"
 "K"

EXISTING
 13.10'
 LIFT
 STA.
 81.05'

TO MON
 141

8"
 ↑

MON #143
















































































VALUABLE

SUBJECT ELEV. EXISTING
SEWER MAN HOLES
ONSLOW BEACH

RETURN TO
PUBLIC WORKS
OFFICE
CAMP LEJEUNE
NORTH CAROLINA


FIELD PARTY
DENNIS IN CHARGE
____ INSTRUMENT
____ NOTES
____ TAPE READ
____ TAPE OR ROD
____ TAPE OR ROD
____ INSTRUMENT NO.
____ TAPE NO.

WEATHER
CLEAR _____ SNOW _____
CLOUDY _____ HOT _____
WINDY _____ MODERATE _____
RAIN _____ COLD _____
FAIR _____ FOG _____

FIGURED BY _____ SHEET 1 of 2
NOTES CHECKED BY _____ DATE 3-13-59
PLOTTED BY _____

FILE No. _____
FLDR. No. _____
Quad. No. _____

STATION	DIST.	ANGLE ° ' "	+	H. I. BEARING	VER. ANG. DIFF.	ELEVATION	
B.m.			7.02	14.76	✓	7.74	✓ M.H.#143
M.H.#1	A B	NEW			7.41 7.42	7.35 IN 7.34 OUT	2.50 X 4.00' #1 8"
M.H.#2	A B	"K"			8.09 8.04	6.67 IN 6.72 OUT	old 6.69 6.59 #2 3' X 4.30'
T.P.			15.01 14.50 5.64	5.38	8.38 9.37	8.38 9.37	old 8.38 -0.12 Plan Elevations
M.H.#3	A B	"J"			9.52 9.47	5.49 5.50 5.54	IN 5.51 } old 5.46 OUT
M.H.#4	A B	"D"			10.88 10.94	4.13 4.08 4.10	IN } old 4.18 OUT
T.P.			13 4.49	7.49	6.52 7.51	6.52 7.51	0.024
T.P.			12 3.72	4.74	8 7.28	7.94 7.28	0.036
			11.00 10.96				

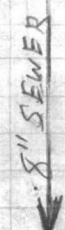











VALUABLE

SUBJECT _____

RETURN TO
PUBLIC WORKS
OFFICE
CAMP LEJEUNE
NORTH CAROLINA

FIELD PARTY

IN CHARGE

INSTRUMENT

NOTES

TAPE READ

TAPE OR ROD

TAPE OR ROD

INSTRUMENT No.

TAPE No. _____

WEATHER

CLEAR SNOW
CLOUDY HOT
WINDY MODERATE
RAIN COLD
FAIR FOG

FILE No. _____

FLDR. No. _____

SHEET _____



FIGURED BY _____
NOTES CHECKED BY _____

PLOTTED BY _____ DATE _____ 19__

Quad. No. _____

STATION	DIST.	ANGLE ° ' "	+	H. I. BEARING	VER. ANG. DIFF.	ELEVATION
M.H.#5	A B	"B"		75.00 11.00 ✓ 10.96	5 23 5 23	5 5.73 5 5.73 5.73
M.H.#6	A B			C 10 4.86 C 18 4.86	4.52	4.52
B.M.				5.37	5.63	7.00
T.P.				5.78	5.17	5.17
				5 18 10 ✓ 11.40		1.85

06
~~5.85~~ "A"

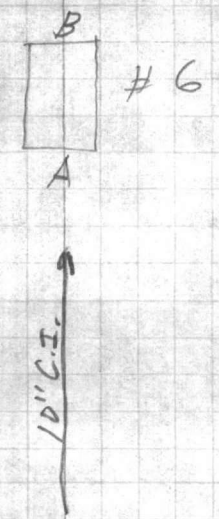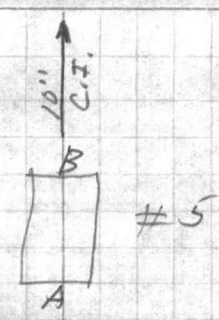

0.1633
← A 5.57
CHANGE TO 5.57
TOP OFF
M.H.#141

0.060
BOLT BY BOTTOM
STEP WATER TANK
ON SLOW BEACH

8.49
+ 1.85

10.34
- 5.18

5.16
- 5.78

10.94
- 5.37

5.57











VALUABLE

RETURN TO
PUBLIC WORKS
OFFICE
CAMP LEJEUNE
NORTH CAROLINA

SUBJECT Floor Elev's Onslow
Beach Area.

FIELD PARTY

____ IN CHARGE
____ INSTRUMENT
____ NOTES
____ TAPE READ
____ TAPE OR ROD
____ TAPE OR ROD
____ INSTRUMENT NO.
____ TAPE NO.

WEATHER

CLEAR _____ SNOW _____
CLOUDY _____ HOT _____
WINDY _____ MODERATE _____
RAIN _____ COLD _____
FAIR _____ FOG _____

FILE No. 221-GW
FLDR. No. _____
SHEET 1 of
DATE 5/12 1955

FIGURED BY _____
NOTES CHECKED BY _____
PLOTTED BY _____
Quad. No. _____

STATION	DIST.	ANGLE " "	+	H. I. BEARING	VER. ANG. DIFF.	ELEVATION	
B.M.			6.97	15.01		8.04	Mon. U.S. MG # 144
			B.A. # 115 ✓		9.01	15.00 ✓	Mon. - porch .45 below floor Elev.
T.P.			4.47	12.41	7.07	7.94	Wood structure
			B.A. # 118 ✓		1.08	11.33	Wood structure
T.P.			4.48	11.13	5.76	6.65	
T.P.			3.61	12.68	2.06	9.07	
			B.A. # 116 ✓		4.23	8.45	Masonite siding Bldg.
T.P.			4.50	11.33	5.85	6.83	
T.P.			4.40	10.09	5.64	5.69	
			B.A. # 117 ✓		2.80	7.29	Wood Bldg.
T.P.			3.65	10.03	3.71	6.38	
			B.A. 114 ✓		0.06	9.97	Top Deck 10.84 Above Bottom Deck
T.P.					2.14	7.89	$\frac{9.97}{20.81}$







VALUABLE

SUBJECT _____

 RETURN TO
 PUBLIC WORKS
 OFFICE
 CAMP LEJEUNE
 NORTH CAROLINA

FIELD PARTY

 _____ IN CHARGE
 _____ INSTRUMENT
 _____ NOTES
 _____ TAPE READ
 _____ TAPE OR ROD
 _____ TAPE OR ROD
 _____ INSTRUMENT NO.
 _____ TAPE NO.

WEATHER

 CLEAR _____
 CLOUDY _____
 WINDY _____
 RAIN _____
 FAIR _____
 SNOW _____
 HOT _____
 MODERATE _____
 COLD _____
 FOG _____

FILE No. _____

FLDR. No. _____

FIGURED BY _____ SHEET 20f

NOTES CHECKED BY _____

PLOTTED BY _____ DATE 5/12 1955

Quad. No. _____

STATION	DIST.	ANGLE " "	+	H. I. BEARING	VER. ANG. DIFF.	ELEVATION
T.P.			3.68	11.57		7.89
					5.38	6.19
T.P.			3.90	10.09		
					5.34	4.75
			5.36	10.11		
			S-BA-108 ✓		3.07	7.04
			BA-100 ✓		2.15	7.96
			BA-101 ✓		2.14	7.97
T.P.					4.30	5.81
			5.44	11.25		
			BA-102 ✓		2.18	9.07
			BA-107 ✓		5.21	6.04
			S-BA-126 ✓		5.38	5.87
T.P.					3.49	7.76
			3.85	11.59		
			BA-128 ✓		4.38	7.21
			BA-106 ✓		4.61	6.98
			BA-103 ✓		1.57	10.02
T.P.					4.20	7.39
			7.88	15.27		
			BA-113		1.27	14.00

Water Tank

$$\begin{array}{r} 7.04 \\ 1.15 \\ \hline 8.19 \end{array}$$

Sewer Disp.

 Tin Bldg. Supply Bldg
 Heating Plant

10.44 #105
2.29
12.78
6.45
6.30

VALUABLE

SUBJECT _____

RETURN TO
PUBLIC WORKS
OFFICE
CAMP LEJEUNE
NORTH CAROLINA

FIELD PARTY

IN CHARGE

INSTRUMENT

NOTES

TAPE READ

TAPE OR ROD

TAPE OR ROD

INSTRUMENT No.

TAPE No.

WEATHER

CLEAR
CLOUDY
WINDY
RAIN
FAIR

SNOW
HOT
MODERATE
COLD
FOG

FILE No. _____

FLDR. No. _____

FIGURED BY _____ SHEET 30f

NOTES CHECKED BY _____

PLOTTED BY _____ DATE 5/12 1955

Quad. No. _____

STATION	DIST.	ANGLE ' "	H. I. BEARING	VER. ANG. DIFF.	ELEVATION	
			15.27			
	BA-104'			5.27	10.00	
T.P.				7.43	7.84	
		3.83	11.67			
	BA-105'			1.18	10.49	
B.M.				5.19	6.48	(6.47) mon. U.S.N. #40
		2.29	8.76	✓		
T.P.				3.40	5.36	✓
		5.32	10.68	✓		
T.P.				4.81	5.87	✓
		6.55	12.42	✓		
	BA 130'			3.41	9.01	Metal Bldg. Shop
T.P.			76	3.41	9.4	
		6.75	15.87			
BA	BA-131			5.70	10.06	frame Roofing Siding
	BA-132			4.90	10.86	" " "
T.P.			14.99	5.71	10.78	
		4.94	15.72			
	BA-133			5.62	9.37	" " "







VALUABLE

SUBJECT _____

RETURN TO
 PUBLIC WORKS
 OFFICE
 CAMP LEJEUNE
 NORTH CAROLINA

FIELD PARTY

 IN CHARGE

 INSTRUMENT

 NOTES

 TAPE READ

 TAPE OR ROD

 TAPE OR ROD

 INSTRUMENT No. _____
 TAPE No. _____

WEATHER

CLEAR _____
 CLOUDY _____
 WINDY _____
 RAIN _____
 FAIR _____
 SNOW _____
 HOT _____
 MODERATE _____
 COLD _____
 FOG _____

FILE No. _____
 FLDR. No. _____
 SHEET 40f
 DATE 5/12 1955

FIGURED BY _____
 NOTES CHECKED BY _____
 PLOTTED BY _____
 Quad. No. _____

STATION	DIST.	ANGLE		+	H. I. BEARING	VER. ANG. DIFF.	ELEVATION	
		°	' "					
T.P.					17.99 51.535		64 9.77	
	5.90				15.77			
T.P.					34	8.39	15 7.28	
	3.19				10.77			
T.P.					023.61		6.73 6.28	
	3.29				10.15			
T.P.						5.08	4.94 5.07	
	4.35				29			
B.M.					9.42	2.78	57 6.47	(6.47) Mon U.S.N # 40

















































































VALUABLE

SUBJECT _____

Return To
Public Works
Office
Camp LeJeune
North Carolina

FIELD PARTY

_____ In Charge
_____ Instrument
_____ Notes
_____ Tape Read
_____ Tape or Rod
_____ Tape or Rod
_____ Instrument No.
_____ Tape No.

WEATHER

Clear
Cloudy
Windy
Rain
Fair

Snow
Hot
Moderate
Cold
Fog

FILE No. _____

Fldr. No. _____

Figured By _____ Sheet _____

Notes Checked By _____

Plotted By _____ Date _____ 19__

Quad. No. _____

Station	Dist.	Angle "	+	H. I. Bearing	Ver. Ang. Diff.	Elevation
BM						8.04
TP		7 80		15 84	0 84	15 00
		0 43		15 43		
0 foot	160 ft				34	120
+20					37	117
40					31	123
60					55	99
80					32	122
1+06					39	115
1+13					33	121
1+30					55	99
1+47					38	116
1+67					37	117
1+94					35	119

Mo. 144
Floor Bldg

















VALUABLE

SUBJECT _____

 Return To
 Public Works
 Office
 Camp Lejeune
 North Carolina

FIELD PARTY

_____ In Charge
 _____ Instrument
 _____ Notes
 _____ Tape Read
 _____ Tape or Rod
 _____ Instrument No. _____
 _____ Tape No. _____

WEATHER

Clear _____
 Cloudy _____
 Windy _____
 Rain _____
 Fair _____
 Snow _____
 Hot _____
 Moderate _____
 Cold _____
 Fog _____

FILE No. _____
 Fldr. No. _____
 Sheet _____
 Date _____ 19____

Notes Checked By _____
 Plotted By _____
 Quad. No. _____

Station	Dist.	Angle " +	H. I. Bearing	Ver: Ang. Diff.	Elevation													
TP					1500													
0+20		371	1871															
+40																		
+53.5			Edge walk															
+59.5			Edge walk															
+60																		
+64																		

20 17 15 8 4 0
 9.3 6.3 4.9 5.3 6.2 6.5
 9.4 12.4 13.8 13.4 12.5 12.2

26 17 14 10 8 0
 9.3 6.7 5.1 5.5 6.0 6.4
 9.4 12.0 13.6 13.2 12.7 12.3

25 15 15 0
 9.2 7.7 6.7 6.7
 9.5 11.0 12.0 12.0

Section same

22 10 10
 9.0 8.2 6.7
 9.7 10.5 12.0

Section same



































VALUABLE

SUBJECT _____

Return To
Public Works
Office
Camp Lejeune
North Carolina

FIELD PARTY

_____ In Charge
_____ Instrument
_____ Notes
_____ Tape Read
_____ Tape or Rod
_____ Tape or Rod
_____ Instrument No.
_____ Tape No.

WEATHER

Clear _____
Cloudy _____
Windy _____
Rain _____
Fair _____
Snow Hot _____
Moderate Cold _____
Fog _____
Figured By _____
Notes Checked By _____
Plotted By _____

FILE No. _____

Fldr. No. _____

Sheet _____

Date _____ 19__

Quad. No. _____

Station	Dist.	Angle ° "	+	H. I. Bearing	Ver: Ang. Diff.	Elevation						
				18 71								
34.5		Edge walk					46	30	23	15	15	
		side 0.4 thick					123	101	8.8	8.0	6.69	
							6.4	8.6	9.9	10.7	12.02	
40.5		Edge walk										
50							47	33	24	17	15	8
							12.6	10.9	8.9	7.0	6.0	6.2
							6.1	2.8	9.8	11.7	12.7	12.5
1 + 70							37	26	18	15	8	5
							11.5	9.6	7.1	5.6	5.3	6.2
							7.2	9.1	11.6	13.1	13.4	12.5



















VALUABLE

SUBJECT _____

RETURN TO
PUBLIC WORKS
OFFICE
CAMP LEJEUNE
NORTH CAROLINA

FIELD PARTY

 _____ IN CHARGE
 _____ INSTRUMENT
 _____ NOTES
 _____ TAPE READ
 _____ TAPE OR ROD
 _____ TAPE OR ROD
 _____ INSTRUMENT NO.
 _____ TAPE NO.

WEATHER

 CLEAR
 CLOUDY
 WINDY
 RAIN
 FAIR
 SNOW
 HOT
 MODERATE
 COLD
 FOG

FILE No. _____

FLDR. No. _____

SHEET #3 of 6

DATE _____ 19__

Quad. No. _____

STATION	DIST.	ANGLE ' "	+	H. I. BEARING	VER. ANG. DIFF.	ELEVATION																
				19.04																		
2+55								83	59	29	19	10	5	13	30	41	54					
								13.6	12.3	10.9	25	24	5.9	7.8	9.6	11.0	11.9					
								5.6	6.9	8.3	16.4	16.8	13.3	11.4	9.6	8.2	7.3					
3+6								79	44	32	22	8	2	14	29		53					
								13.5	11.1	9.5	+4.0	+3.0	0.9	7.6	10.0	11.7	11.5					
								5.7	8.1	9.7	23.2	22.2	18.3	11.6	9.2	7.5						
T.P.					9.06	10.18																
				12.42	22.60																	
3+35								86	60	23	8	8	14	29		53						
								16.4	14.7	14.0	4.1	6.8	9.7	12.3	15.1							
								6.2	7.9	8.6	18.5	15.8	12.9	10.3	7.5							
3+45				Bottom of Dune	13.2	9.4																
3+58								187	152	120	42	71	51	39								
								95	60	28	2	21	41	53								
								16.7	14.9	13.1	13.2	13.3	14.5	15.3								
								5.9	7.7	9.5	9.4	9.3	8.1	7.3								
3+55				Sewer M. H. Destroyed near here																		

Transformer
P.P. ← 45° 2.15

E. Rd.

E. Rd.

E. Rd.

E. Rd.







VALUABLE

SUBJECT _____

RETURN TO
PUBLIC WORKS
OFFICE
CAMP LEJEUNE
NORTH CAROLINA

FIELD PARTY

IN CHARGE

INSTRUMENT

NOTES

TAPE READ

TAPE OR ROD

TAPE OR ROD

INSTRUMENT NO.

TAPE NO.

WEATHER

CLEAR
CLOUDY
WINDY
RAIN
FAIR
SNOW
HOT
MODERATE
COLD
FOG

FILE No. _____

FLDR. No. _____

SHEET #4 of 6

FIGURED BY _____ NOTES CHECKED BY _____

PLOTTED BY _____ DATE _____ 19__

Quad. No. _____

STATION	DIST.	ANGLE " "	+	H. I. BEARING	VER. ANG. DIFF.	ELEVATION										
				22.60												
4+0							88	58	30	E	30	53	E. Rd.			
							16.8	14.6	13.0		13.5	13.9	15.4			
							5.8	8.0	9.6		9.1	8.7	7.2			
4+62	Bottom Drive				14.3	8.3										
4+70	= Mon. #143															
4+75							163	132	105	92	79	56	45' E. Rd.			
							71	40	13	E	13	36	52			
							16.4	13.2	13.6	11.4	11.9	14.8	15.5			
							6.2	9.4	9.0	11.2	10.7	7.8	7.1			
5+0							94	71	42	20	10	E	20	24	52 E. Rd.	
							16.6	16.4	14.7	3.4	7.5	10.6	11.7	14.5	15.6	
							6.0	6.2	7.9	19.2	15.1	12.0	10.9	8.1	7.0	
5+40							90	70	46	35	28	12	E	12	25	52 E. Rd.
							17.3	14.8	15.3	9.8	2.3	3.6	9.2	13.1	14.0	15.1
							5.3	5.8	7.3	12.8	20.3	19.0	13.4	9.5	8.6	7.0
5+53								100	74	47		18		53		
							17.3	17.1	15.3	13.2	13.4	15.7				
							5.3	5.5	7.4	9.4	9.2	6.9				




































































VALUABLE

SUBJECT _____

RETURN TO
 PUBLIC WORKS
 OFFICE
 CAMP LEJEUNE
 NORTH CAROLINA

FIELD PARTY

IN CHARGE _____
 INSTRUMENT _____
 NOTES _____
 TAPE READ _____
 TAPE OR ROD _____
 TAPE OR ROD _____
 INSTRUMENT No. _____
 TAPE No. _____

WEATHER

CLEAR _____
 CLOUDY _____
 WINDY _____
 RAIN _____
 FAIR _____
 SNOW _____
 HOT _____
 MODERATE _____
 COLD _____
 FOG _____
 FIGURED BY _____
 NOTES CHECKED BY _____
 PLOTTED BY _____

FILE No. _____

FLDR. No. _____

SHEET #6 of 6

DATE _____ 19__

Quad. No. _____

STATION	DIST.	ANGLE " "	+	H. I. BEARING	VER: ANG. DIFF.	ELEVATION
---------	-------	--------------	---	------------------	--------------------	-----------

7+06				20.92		
						Both sides of dunes.
						45 22 12 E 15 52
						13.3 0.3 +2.0 1.2 11.7 14.3
						7.6 20.6 22.9 19.7 9.2 6.6

T.P.				10.98	19.70	12.20 8.72
------	--	--	--	-------	-------	------------

7+44						
						E. Rd.
						64 44 31 14 E 22 54'
						13.3 11.4 2.6 11.6 4.6 12.0 13.2
						6.4 8.3 17.1 18.1 15.1 7.7 6.5

7+50						
						sewer Mt. H. Mr. Gnd.
						70 47 31 17 E 8 8 8 32 55
						13.6 12.2 2.8 5.2 9.7 9.7 12.8 11.9 13.7 13.2
						6.1 7.5 16.9 14.5 10.0 10.0 6.9 7.8 6.0 6.5

T.P.				6.29	15.01	10.98 8.72
Mon						6.88 8.13

(8.04)



















































































 

Beach Cabanas
Orston Beach

221 T