

VALUABLE

SUBJECT Bldg. LOCATION #1  
ONSLOW BEACH

Return To  
 Public Works  
 Office  
 Camp Lejeune  
 North Carolina

FIELD PARTY  
KELUM In Charge  
 \_\_\_\_\_ Instrument  
 \_\_\_\_\_ Notes  
 \_\_\_\_\_ Tape Read  
 \_\_\_\_\_ Tape or Rod  
 \_\_\_\_\_ Tape or Rod  
 \_\_\_\_\_ Instrument No.  
 \_\_\_\_\_ Tape No.

WEATHER  
 Clear \_\_\_\_\_  
 Cloudy \_\_\_\_\_  
 Windy \_\_\_\_\_  
 Rain \_\_\_\_\_  
 Fair \_\_\_\_\_  
 Snow \_\_\_\_\_  
 Hot \_\_\_\_\_  
 Moderate \_\_\_\_\_  
 Cold \_\_\_\_\_  
 Fog \_\_\_\_\_

FILE No. 221-X  
 Fldr. No. \_\_\_\_\_  
 Sheet 1-OF 4  
 Date 6-27-56  
 Plotted By \_\_\_\_\_  
 Figured By \_\_\_\_\_  
 Notes Checked By \_\_\_\_\_  
 Quad. No. 221


Station	Dist.	Angle	H. I.	Ver: Ang.	Elevation
		"	Bearing	Diff.	

P.I. #2  
 2-00.20  
 MEAN - 103° 10' 55"

P.I. #1  
 TO P.I. #2  
 MEAN - 162° 43' 30"

A  
 MEAN #40

P.I. #1

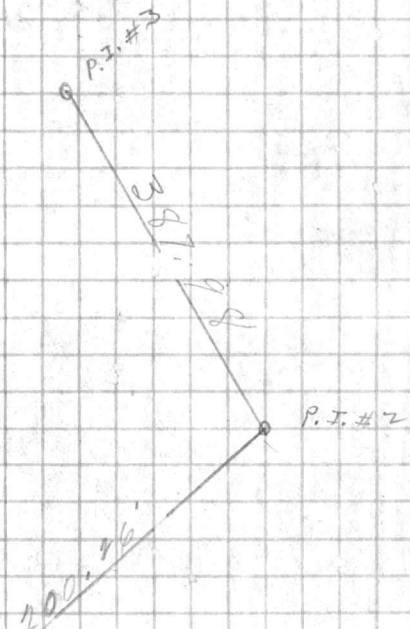

VALLEY

SUBJECT

Station  
Date  
Time  
Observer

Station  
Date  
Time  
Observer

LEAD PARTY

In Charge

Instrument

Notes

Type of

Notes of

Type of

Notes of

Type of

WEATHER

Clouds

Wind

Temp

Humidity

Pressure

Visibility

Remarks

FIELD NO.

DATE

TIME

LOCATION

RECORDED

**VALUABLE**

SUBJECT BLDG. LOCATION AT ONSLOW  
BEACH CONTD.


Return To  
Public Works  
Office  
Camp Lejeune  
North Carolina

FIELD PARTY  
KELLMAN In Charge  
\_\_\_\_ Instrument  
\_\_\_\_ Notes  
\_\_\_\_ Tape Read  
\_\_\_\_ Tape or Rod  
\_\_\_\_ Tape or Rod  
\_\_\_\_ Instrument No.  
\_\_\_\_ Tape No.

WEATHER  
Clear \_\_\_\_\_  
Cloudy \_\_\_\_\_  
Windy \_\_\_\_\_  
Rain \_\_\_\_\_  
Fair \_\_\_\_\_  
Snow \_\_\_\_\_  
Hot \_\_\_\_\_  
Moderate \_\_\_\_\_  
Cold \_\_\_\_\_  
Fog \_\_\_\_\_  
Figured By \_\_\_\_\_  
Notes Checked By \_\_\_\_\_  
Plotted By \_\_\_\_\_

FILE No. 221-X  
Fldr. No. \_\_\_\_\_  
Sheet 2-OF-4  
Date 6-27 19-46

Quad. No. 221

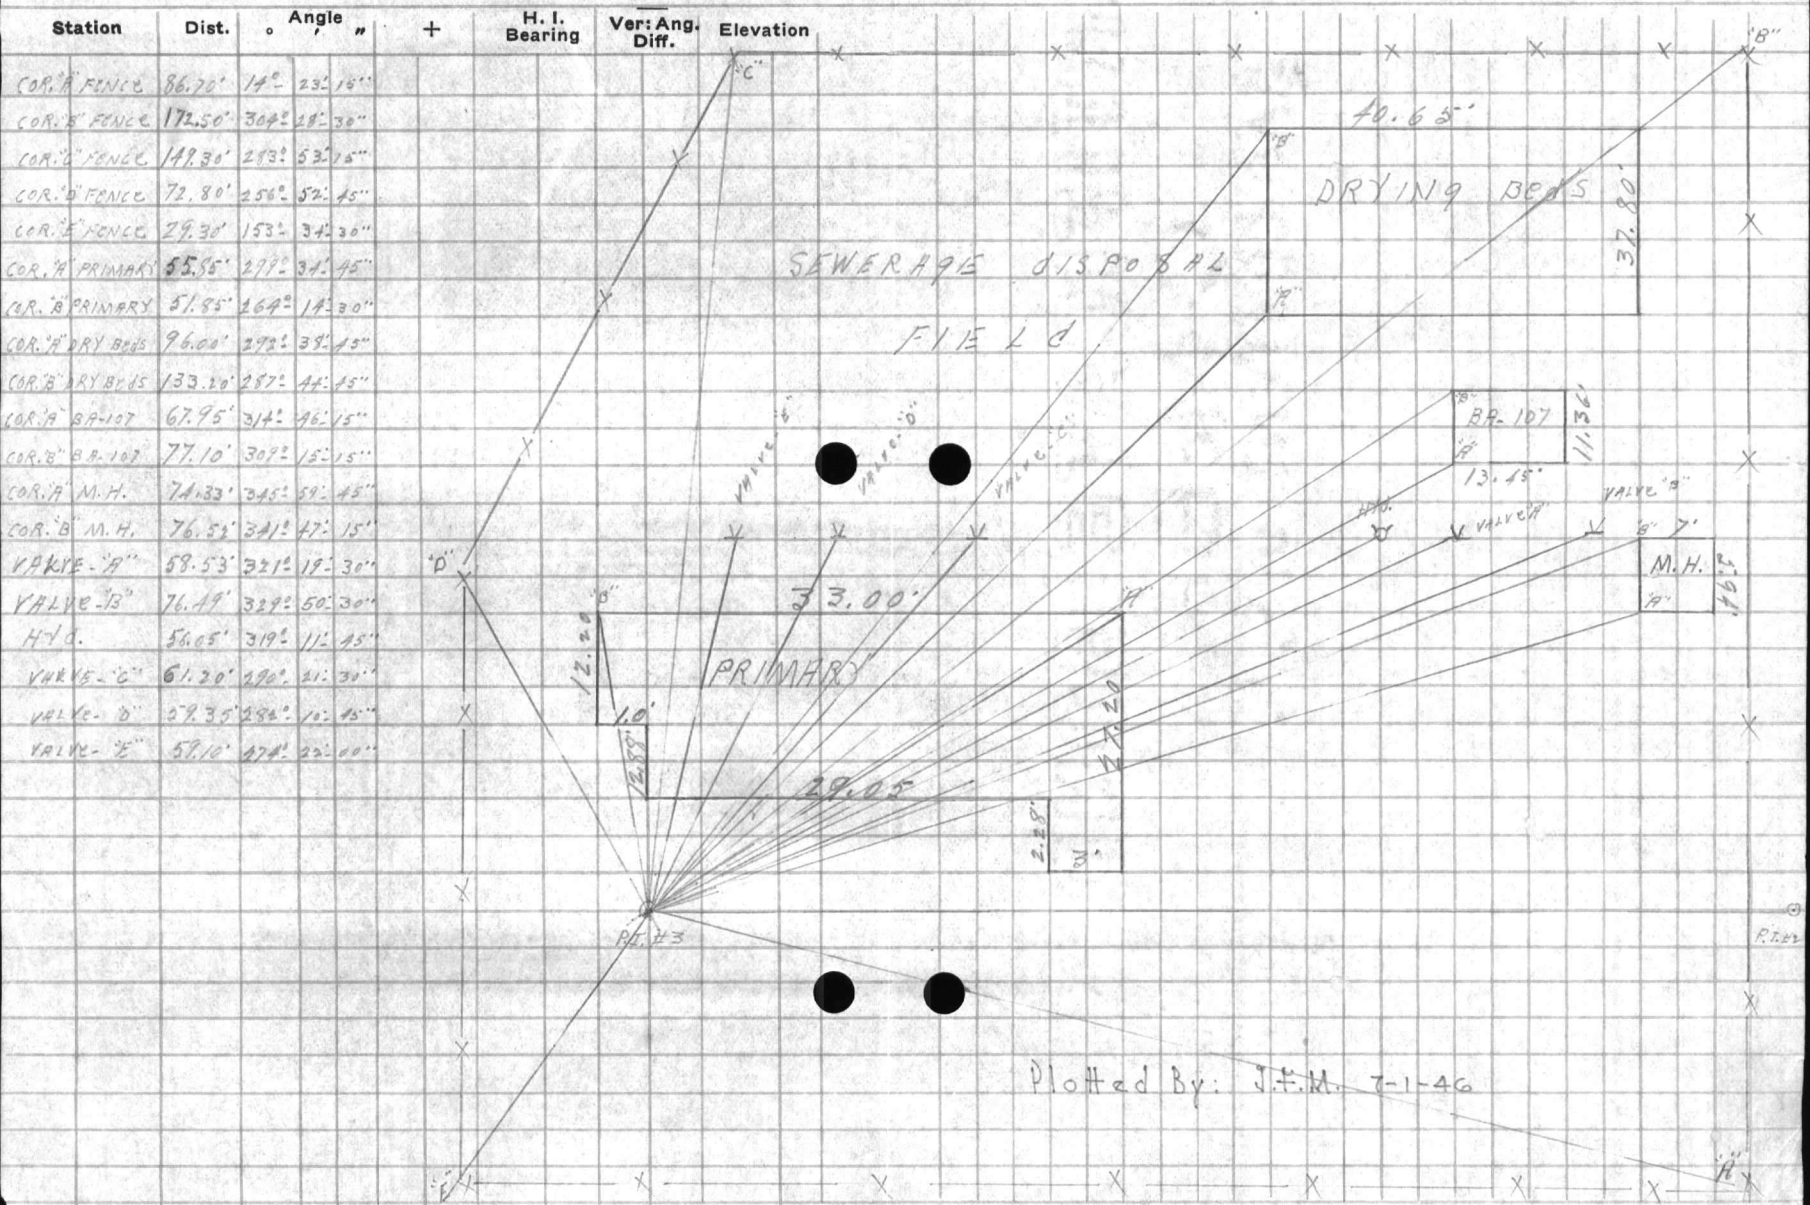

AVAILABLE

Return To  
Public Works  
Office  
Camp Station  
North Carolina

SUBJECT

Station

Date

Angle

Base

H. I. V. or  
Dist.

Elevation

FIELD PARTY

In Charge

Instrument

Notes

Table Read

Type of Rod

Time on Rod

Instrument No.

Table No.

WEATHER

Clear

Cloudy

Mist

Windy

Light

Good

Other

Notes

FILE NO.

Ext. No.

Sheet

Date

VALUABLE

SUBJECT BLDG. LOCATION AT ONSLOW  
BEACH CONTS.

Return To  
Public Works  
Office  
Camp Lejeune  
North Carolina

FIELD PARTY

XE L LANN In Charge  
\_\_\_\_ Instrument  
\_\_\_\_ Notes  
\_\_\_\_ Tape Read  
\_\_\_\_ Tape or Rod  
\_\_\_\_ Tape or Rod  
\_\_\_\_ Instrument No.  
\_\_\_\_ Tape No.

WEATHER

Clear  
Cloudy  
Windy  
Rain  
Fair

Snow  
Hot  
Moderate  
Cold  
Fog

FILE No. 221-X

Fldr. No. \_\_\_\_\_

Sheet 3-054

Date 6-27 19 46

Figured By \_\_\_\_\_

Notes Checked By \_\_\_\_\_

Plotted By \_\_\_\_\_

Quad. No. 221

Station    Dist.    °    Angle    "    +    H. I.    Ver: Ang.    Elevation

ENLISTED MEN'S  
BATH HOUSE

T-MON #141    1. 16° 49' 30"  
TO COR. B    2. 33° 40' 00"  
BATH HOUSE MEAN. 16° 50' 20"

T-MON #141    1. 29° 50' 30"  
TO COR. H    2. 59° 41' 30"  
BATH HOUSE MEAN. 29° 50' 45"



Mon. #129 from Bldg. Cor.  
Elev. Mon. #141 top damaged  
5.57

Referenced  
Dec 1, 1960

Plotted by: J.F.M. 7-2-46

Beach  
CAPAINS  
A. Elev. 18.0

MON # 144

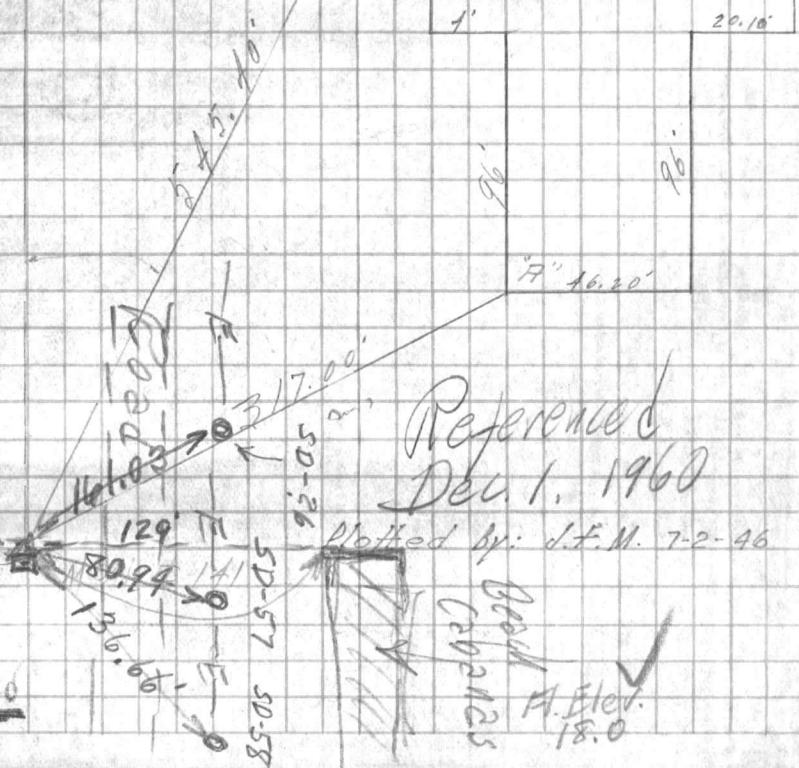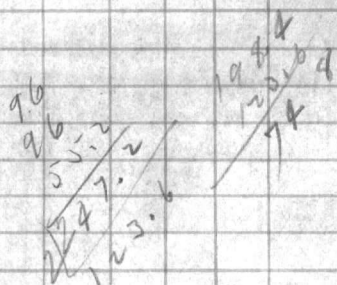

ATTACHED

SUBJECT

Return to  
Post Office  
Care  
Camp Lejeune  
Fort Carolina

Station

Return to  
Post Office  
Care  
Camp Lejeune  
Fort Carolina

FIELD PARTY

WEATHER



FILE NO.









Ocean


BA-146  
Y&D 859198

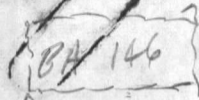

100'

Tel. Pole

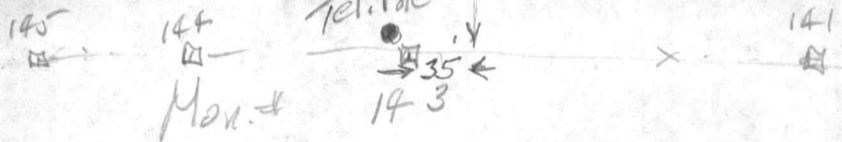

 



VALUABLE

SUBJECT Bldg. LOCATION AT ON SLOW  
BEACH CONTS.

Return To  
Public Works  
Office  
Camp Lejeune  
North Carolina

FIELD PARTY


KEELMAN In Charge  
\_\_\_\_ Instrument  
\_\_\_\_ Notes  
\_\_\_\_ Tape Read  
\_\_\_\_ Tape or Rod  
\_\_\_\_ Tape or Rod  
\_\_\_\_ Instrument No.  
\_\_\_\_ Tape No.

WEATHER

Clear  
Cloudy  
Windy  
Rain  
Fair  
Snow  
Hot  
Moderate  
Cold  
Fog

FILE No. 221-X  
Fldr. No. \_\_\_\_\_  
Sheet 4-014  
Date 6-27 1946  
Plotted By \_\_\_\_\_  
Quad. No. 221

Station    Dist.    Angle    +    H. I.    Ver: Ang.    Elevation

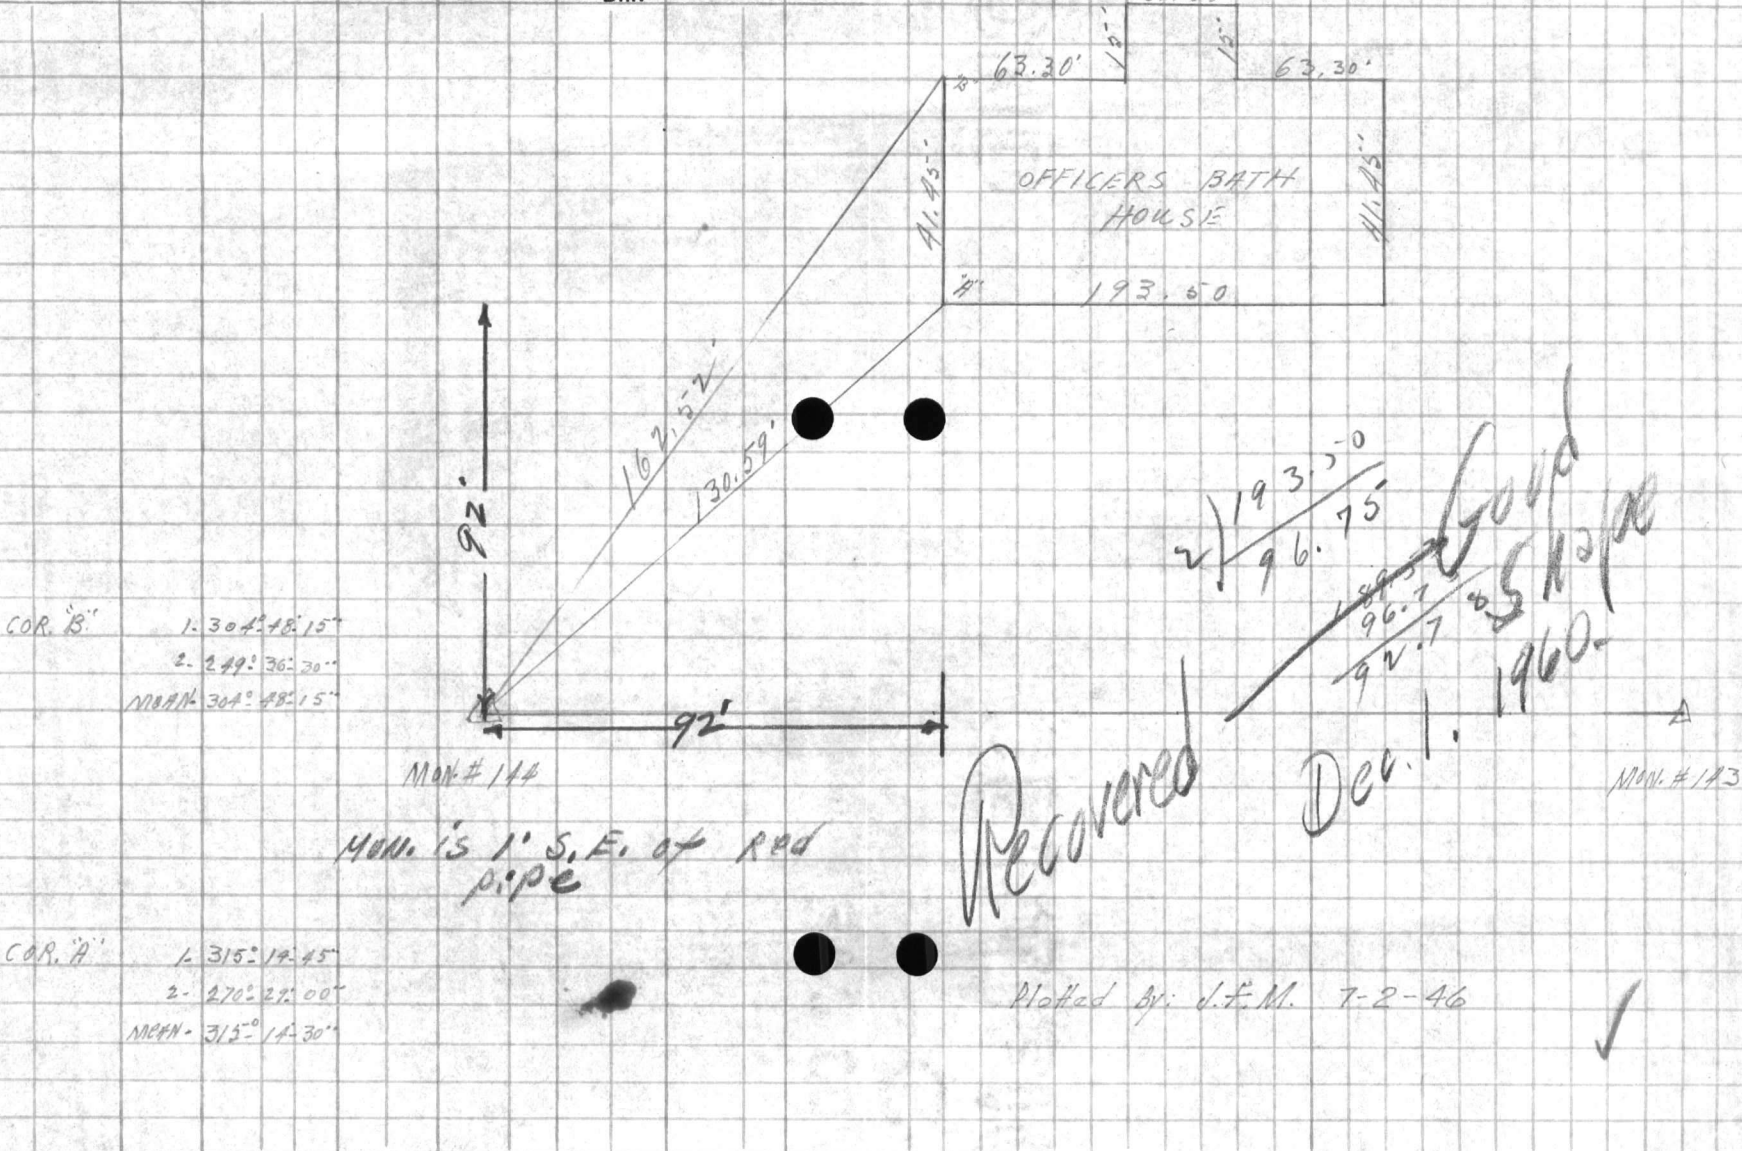


FILE NO. \_\_\_\_\_  
Date \_\_\_\_\_  
Time \_\_\_\_\_  
\_\_\_\_\_

WREATHEN  
Wind \_\_\_\_\_  
Temp \_\_\_\_\_  
\_\_\_\_\_

FIELD PARTY  
\_\_\_\_\_

Station \_\_\_\_\_  
Date \_\_\_\_\_  
Time \_\_\_\_\_  
\_\_\_\_\_

\_\_\_\_\_

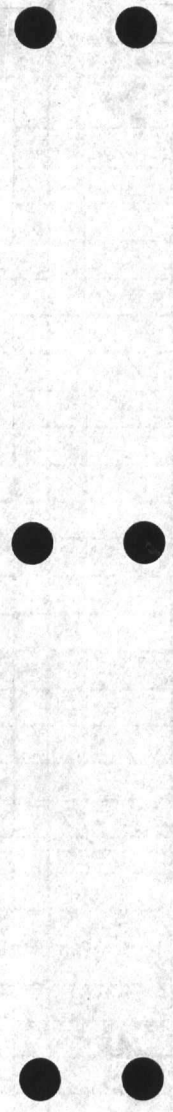

VALUABLE

SUBJECT BUILDING LOCATION AT  
ON SLOW BEACH


Return To  
 Public Works  
 Office  
 Camp Lejeune  
 North Carolina

FIELD PARTY  
KEILAN In Charge  
 \_\_\_\_\_ Instrument  
 \_\_\_\_\_ Notes  
 \_\_\_\_\_ Tape Read  
 \_\_\_\_\_ Tape or Rod  
 \_\_\_\_\_ Tape or Rod  
 \_\_\_\_\_ Instrument No.  
 \_\_\_\_\_ Tape No.

WEATHER  
 Clear \_\_\_\_\_  
 Cloudy \_\_\_\_\_  
 Windy \_\_\_\_\_  
 Rain \_\_\_\_\_  
 Fair \_\_\_\_\_  
 Snow \_\_\_\_\_  
 Hot \_\_\_\_\_  
 Moderate \_\_\_\_\_  
 Cold \_\_\_\_\_  
 Fog \_\_\_\_\_  
 Figured By \_\_\_\_\_  
 Notes Checked By \_\_\_\_\_  
 Plotted By \_\_\_\_\_

FILE No. 221-X  
 Fldr. No. \_\_\_\_\_  
 Sheet 1-01-4  
 Date 6-14 1946  
 Quad. No. 221

Station	Dist.	Angle	"	+	H. I. Bearing	Ver. Ang. Diff.	Elevation
---------	-------	-------	---	---	---------------	-----------------	-----------

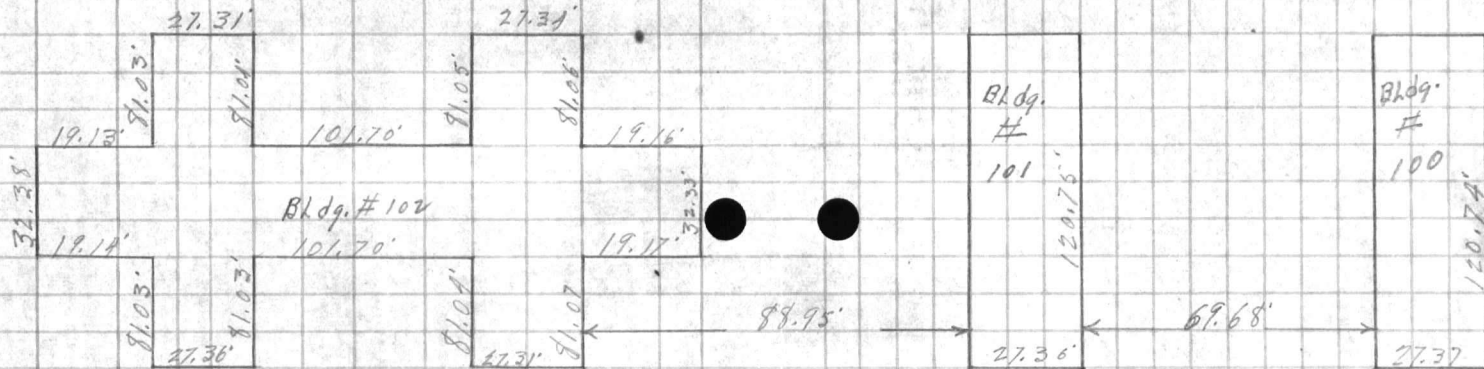

1239.63 Measured  
 1239.28 Computed

T-PI #1 1. 172° 46' 45"  
 12+06.90 2. 345° 21' 30"  
 COR. Bldg. MEAN 172° 46' 45"  
 # 100

348.75'

Plotted By: J.F.M. 6-28-46

Mon. # 40

P.I. # 1

Station No.  
Date  
Camp Location  
Name of Party

Observer

Station No. \_\_\_\_\_ Date \_\_\_\_\_  
Camp Location \_\_\_\_\_ Name of Party \_\_\_\_\_



FIELD PARTY

In Charge \_\_\_\_\_  
Instrument \_\_\_\_\_  
Notes \_\_\_\_\_  
Tape Read \_\_\_\_\_  
Tape on Rod \_\_\_\_\_  
Tape on Rod \_\_\_\_\_  
Tape No. \_\_\_\_\_

WEATHER

Clear \_\_\_\_\_  
Cloudy \_\_\_\_\_  
Rain \_\_\_\_\_  
Fog \_\_\_\_\_  
Thunder by \_\_\_\_\_  
Thunder checked by \_\_\_\_\_  
Thunder plotted by \_\_\_\_\_  
Tape No. \_\_\_\_\_

Field No. \_\_\_\_\_  
Date \_\_\_\_\_

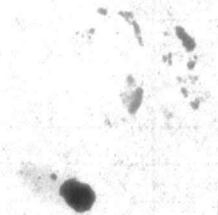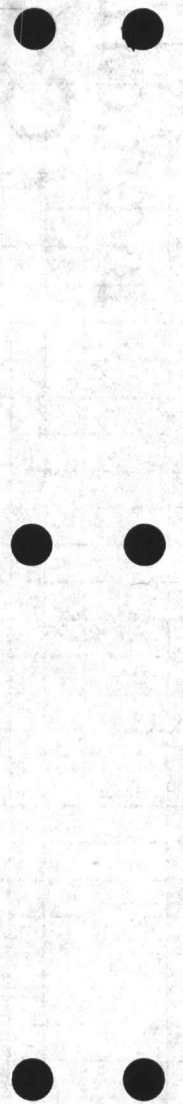

VALUABLE

Return To  
Public Works  
Office  
Camp Lejeune  
North Carolina


SUBJECT BUILDING LOCATION AT  
ONSLOW BEACH

FIELD PARTY  
KELLUM In Charge  
Instrument \_\_\_\_\_  
Notes \_\_\_\_\_  
Tape Read \_\_\_\_\_  
Tape or Rod \_\_\_\_\_  
Tape or Rod \_\_\_\_\_  
Instrument No. \_\_\_\_\_  
Tape No. \_\_\_\_\_

WEATHER  
Clear \_\_\_\_\_  
Cloudy \_\_\_\_\_  
Windy \_\_\_\_\_  
Rain \_\_\_\_\_  
Fair \_\_\_\_\_  
Snow \_\_\_\_\_  
Hot \_\_\_\_\_  
Moderate \_\_\_\_\_  
Cold \_\_\_\_\_  
Fog \_\_\_\_\_  
Figured By \_\_\_\_\_  
Notes Checked By \_\_\_\_\_  
Plotted By \_\_\_\_\_

FILE No. 221-X  
Fldr. No. \_\_\_\_\_  
Sheet 2-01-4  
Date 6-14 1946  
Quad. No. 221

Station    Dist.    Angle "    +    H. I. Bearing    Ver: Ang. Diff.    Elevation

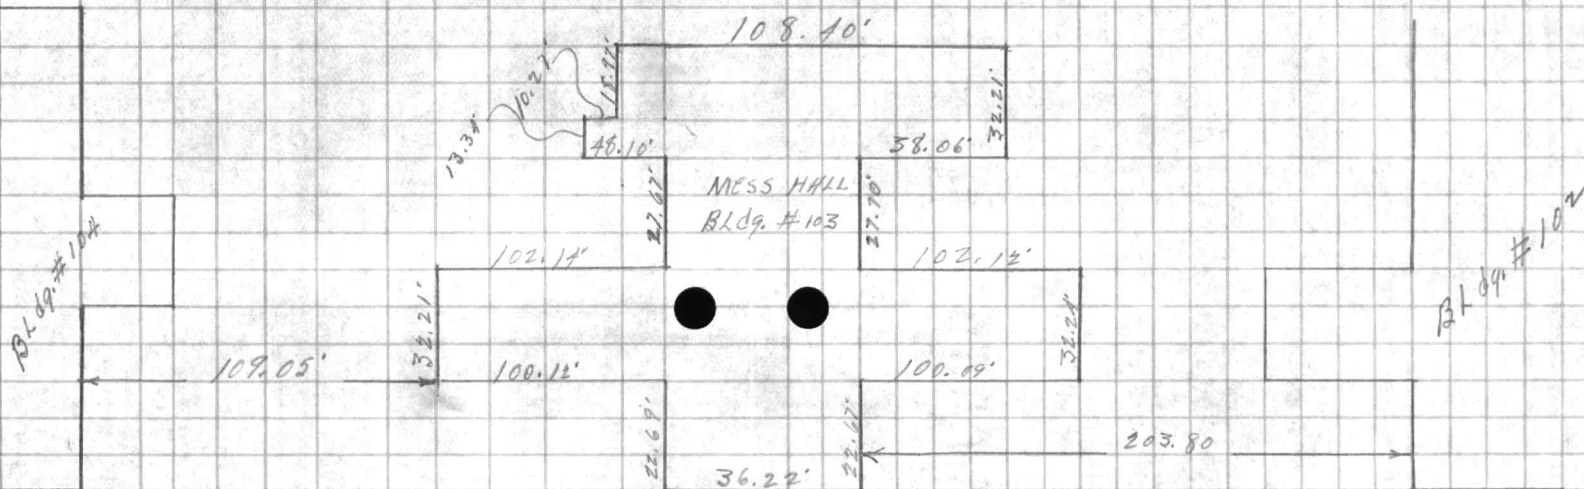

Plotted By: J.F.M. 6-23-46
























VALUABLE

SUBJECT BUILDING LOCATION AT  
ON SLOW BEACH

Return To  
 Public Works  
 Office  
 Camp Lejeune  
 North Carolina


FIELD PARTY

KELLM In Charge  
 \_\_\_\_\_ Instrument  
 \_\_\_\_\_ Notes  
 \_\_\_\_\_ Tape Read  
 \_\_\_\_\_ Tape or Rod  
 \_\_\_\_\_ Tape or Rod  
 \_\_\_\_\_ Instrument No.  
 \_\_\_\_\_ Tape No.

WEATHER

Clear \_\_\_\_\_  
 Cloudy \_\_\_\_\_  
 Windy \_\_\_\_\_  
 Rain \_\_\_\_\_  
 Fair \_\_\_\_\_  
 Snow \_\_\_\_\_  
 Hot \_\_\_\_\_  
 Moderate \_\_\_\_\_  
 Cold \_\_\_\_\_  
 Fog \_\_\_\_\_  
 Figured By \_\_\_\_\_  
 Notes Checked By \_\_\_\_\_  
 Plotted By \_\_\_\_\_

FILE No. 221-X  
 Fldr. No. \_\_\_\_\_  
 Sheet 3-054  
 Date 6-14 1946  
 Quad. No. 221

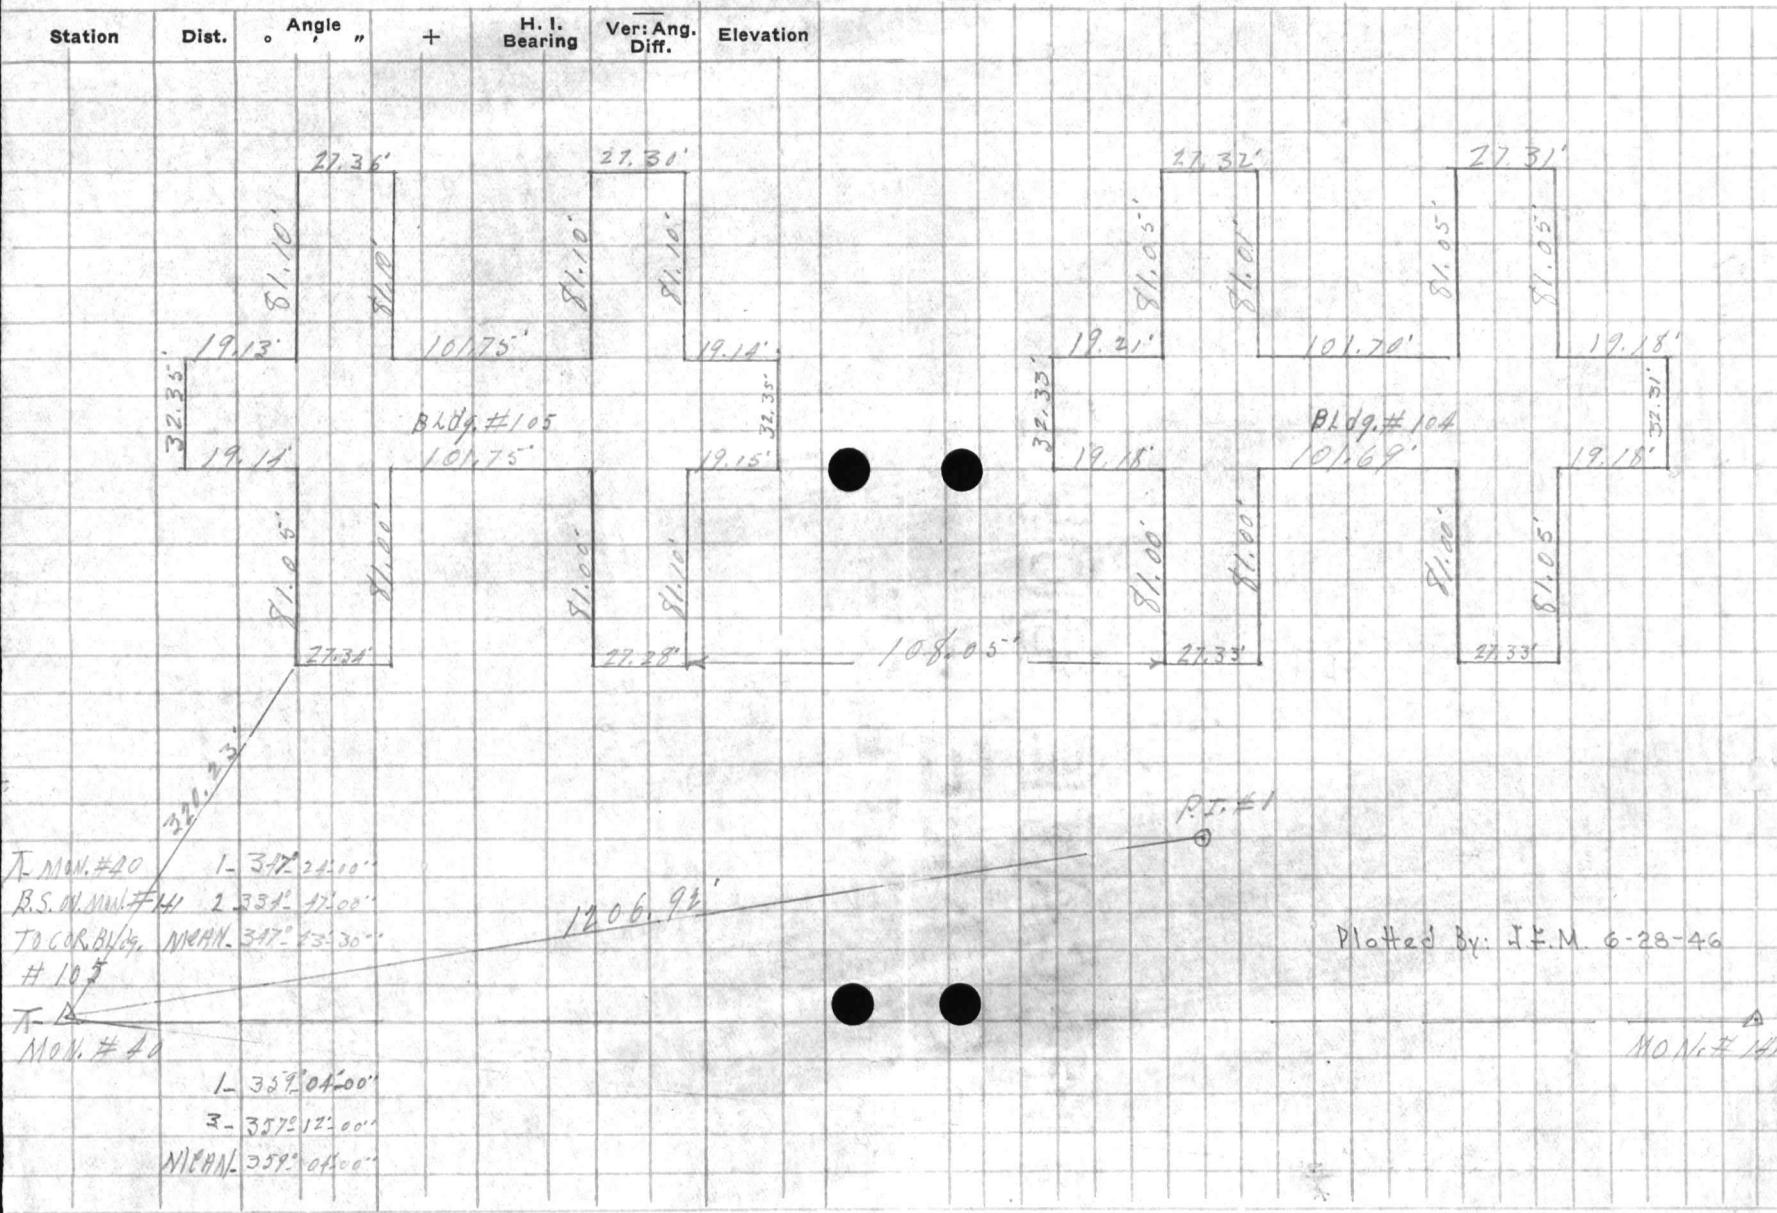

Plotted By: J.E.M. 6-28-46

MON. # 141






































**VALUABLE**

SUBJECT \_\_\_\_\_

Return To  
Public Works  
Office  
Camp Lejeune  
North Carolina

BLDG. LOCATION AT ONSBOW BEACH

**FIELD PARTY**

KELLY In Charge  
\_\_\_\_ Instrument  
\_\_\_\_ Notes  
\_\_\_\_ Tape Read  
\_\_\_\_ Tape or Rod  
\_\_\_\_ Tape or Rod  
\_\_\_\_ Instrument No.  
\_\_\_\_ Tape No.

**WEATHER**

Clear  
Cloudy  
Windy  
Rain  
Fair

Snow  
Hot  
Moderate  
Cold  
Fog

FILE No. 221-X

Fldr. No. \_\_\_\_\_

Sheet 1 of 4

Date 6-26 19 46


Figured By \_\_\_\_\_

Notes Checked By \_\_\_\_\_

Plotted By \_\_\_\_\_

Quad. No. 221

Station	Dist.	Angle	H. I.	Ver. Ang.	Elevation
		" "	Bearing	Diff.	

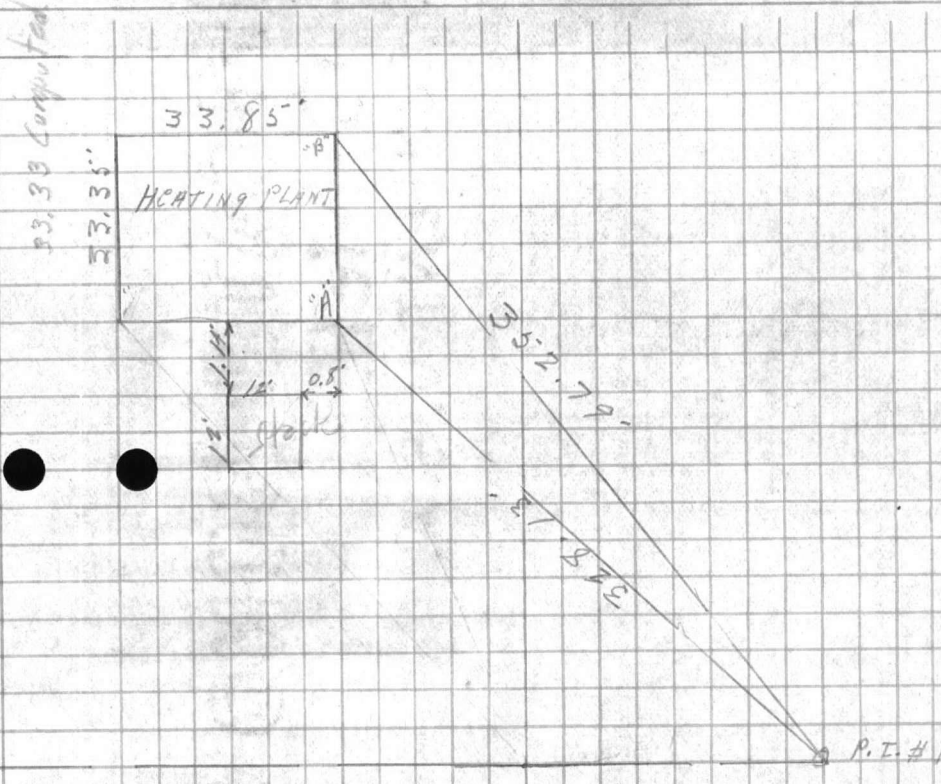

T-P.I. #1 1-50° 20' 00"  
TO COR. #20 4-100° 20' 00"  
HEATING PLANT MEAN. 60° 20' 00"

Plotted By: J.F.M. 6-28-46

T-P.I. #1 1-46° 33' 30"  
TO COR. #20 1-93° 07' 00"  
HEATING PLANT MEAN. 46° 33' 30"  
PLANT

VALUABLE

Return To  
Public Works  
Office  
Camp Latham  
North Carolina

SUBJECT

\_\_\_\_\_  
\_\_\_\_\_  
\_\_\_\_\_

Station

Date

Angle

M. I.  
Bearing

Var: And. Station  
Dist.

FIELD PARTY

In Charge \_\_\_\_\_

Instrument \_\_\_\_\_

Notes \_\_\_\_\_

Tap Read \_\_\_\_\_

\_\_\_\_\_

\_\_\_\_\_

\_\_\_\_\_

WEATHER

Clear \_\_\_\_\_

Cloudy \_\_\_\_\_

Windy \_\_\_\_\_

Hot \_\_\_\_\_

Cold \_\_\_\_\_

Fog \_\_\_\_\_

\_\_\_\_\_

\_\_\_\_\_

FILE NO.

\_\_\_\_\_

Sheet \_\_\_\_\_

Date \_\_\_\_\_

Grid No.

RECORDED

VALUABLE

SUBJECT Location of Colored Bath House

Onslow Beach

Return To  
Public Works  
Office  
Camp Lejeune  
North Carolina

FIELD PARTY

Garner In Charge  
Instrument \_\_\_\_\_  
Notes \_\_\_\_\_  
Tape Read \_\_\_\_\_  
Tape or Rod \_\_\_\_\_  
Tape or Rod \_\_\_\_\_  
Instrument No. \_\_\_\_\_  
Tape No. \_\_\_\_\_

WEATHER


Clear \_\_\_\_\_  
Cloudy \_\_\_\_\_  
Windy \_\_\_\_\_  
Rain \_\_\_\_\_  
Fair \_\_\_\_\_  
Snow \_\_\_\_\_  
Hot \_\_\_\_\_  
Moderate \_\_\_\_\_  
Cold \_\_\_\_\_  
Fog \_\_\_\_\_

FILE No. 221-X  
Fldr. No. \_\_\_\_\_  
Sheet \_\_\_\_\_  
Date 8/2/1946  
221  
Quad. No. \_\_\_\_\_

Station	Dist.	Angle	"	+	H. I. Bearing	Ver: Ang. Diff.	Elevation
<u>PI#1</u>							
<u>COR. "C"</u>	<u>395.10'</u>						
<u>COR. "B"</u>	<u>496.60'</u>						
<u>COR. "A"</u>	<u>395.10'</u>						

<u>PI#1</u>	<u>339°58'</u>	(1)					
<u>COR. "C"</u>		(2)					
<u>PI#1</u>	<u>343°25'00"</u>	(1)					
<u>COR. "B"</u>	<u>496.60</u>	<u>326°46'00"</u>	(2)				
		<u>343°23'</u>	(1)				
<u>PI#1</u>	<u>338°38'00"</u>	(1)					
<u>COR. "A"</u>	<u>395.10</u>	<u>317°16'30"</u>	(2)				
		<u>338°38'15"</u>	(1)				

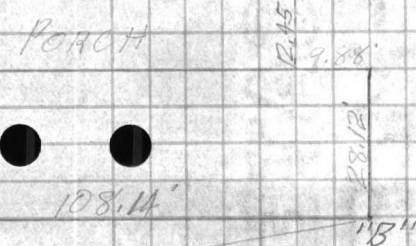

Mon. 40

B.S. Mon. 40












SUBJECT Colored Both House  
Onslow Beach  
New N.C.O. Beach House

Return To  
 Public Works  
 Office  
 Camp Lejeune  
 North Carolina

FIELD PARTY  
Beard In Charge  
 Instrument \_\_\_\_\_  
 Notes \_\_\_\_\_  
 Tape Read \_\_\_\_\_  
 Tape or Rod \_\_\_\_\_  
 Tape or Rod \_\_\_\_\_  
 Instrument No. \_\_\_\_\_  
 Tape No. \_\_\_\_\_

WEATHER  
 Clear \_\_\_\_\_  
 Cloudy \_\_\_\_\_  
 Windy \_\_\_\_\_  
 Rain \_\_\_\_\_  
 Fair \_\_\_\_\_  
 Snow \_\_\_\_\_  
 Hot \_\_\_\_\_  
 Moderate \_\_\_\_\_  
 Cold \_\_\_\_\_  
 Fog \_\_\_\_\_  
 Figured By \_\_\_\_\_  
 Notes Checked By \_\_\_\_\_  
 Plotted By \_\_\_\_\_

FILE No. 221-X  
 Fldr. No. \_\_\_\_\_  
 Sheet \_\_\_\_\_  
 Date \_\_\_\_\_ 19\_\_

Quad. No. 221  
 Fl. Elev. 17.00  
 Top of Piling 15.58  
 Change in Floor Grade 4.00  
11.58

Station	Dist.	Angle	H. I.	Ver. Ang.	Elevation
		"	Bearing	Diff.	

Barracks #104

Mess

Hall  
 Fl. Elev. 10.00

8.34  
 9.34

Set B.M. Somewhere on Corner  
 of Porch or Steps.

200' or Building Line

Onslow Drive

U.S.N. Monument #40, 300' West of Last Barracks (#105) on Monumented Base Line  
 Elev. 6.47



Set Grade Stakes  
 on Approximate Corners.

Fl. Elev. on Plan 17.00 - 4.00 per  
 Change approved by Commander = 13.00  
 1' Error on Construction B.M. =  
 Floor Elevation of 14.00 as built







VALUABLE

SUBJECT

B. M. Elev of Bldg

20 Green Pit at

mess Hall

Return To  
Public Works  
Office  
Camp Lejeune  
North Carolina

## FIELD PARTY

In Charge

Instrument

Notes

Tape Read

Tape or Rod

Tape or Rod

Instrument No.

Tape No.

## WEATHER

Clear  
Cloudy  
Windy  
Rain  
FairSnow  
Hot  
Moderate  
Cold  
Fog

Figured By

Notes Checked By

Plotted By

FILE No. \_\_\_\_\_

Fldr. No. \_\_\_\_\_

Sheet #1 of

Date 1-3-1945

Quad. No. \_\_\_\_\_

Station	Dist.	Angle " "	+	H. I. Bearing	Ver: Ang. Diff.	Elevation	
mon # 40			5.04	11.51		6.47	✓
TP			3.48	11.54	3.95	8.06	9.34
Bldg TP			3.04	11.38	3.20	8.34	✓ on top of concrete wall of green trap at mess Hall ocean side off trap
TP			1.53	11.44	1.47	9.91	
			4.76	6.48	(6.47)	mon # 40	








17.00  
1.42  

---

15.58  
4.00  

---

11.58

8.34  
7.23  

---

15.57  
3  

---

12.57

