

2704 75

VALUABLE

SUBJECT _____

RETURN TO
 PUBLIC WORKS
 OFFICE
 CAMP LEJEUNE
 NORTH CAROLINA

FIELD PARTY

 IN CHARGE

 INSTRUMENT

 NOTES

 TAPE READ

 TAPE OR ROD

 TAPE OR ROD

 INSTRUMENT No. _____
 TAPE No. _____

WEATHER

CLEAR _____
 CLOUDY _____
 WINDY _____
 RAIN _____
 FAIR _____

SNOW _____
 HOT _____
 MODERATE _____
 COLD _____
 FOG _____

FILE No. _____

FLDR. No. _____

SHEET 10F

DATE 10-16-1957


FIGURED BY _____

NOTES CHECKED BY _____

PLOTTED BY _____

Quad. No. _____

STATION	DIST.	ANGLE ' "	+	H. I. BEARING	VER: ANG. DIFF.	ELEVATION
---------	-------	--------------	---	------------------	--------------------	-----------

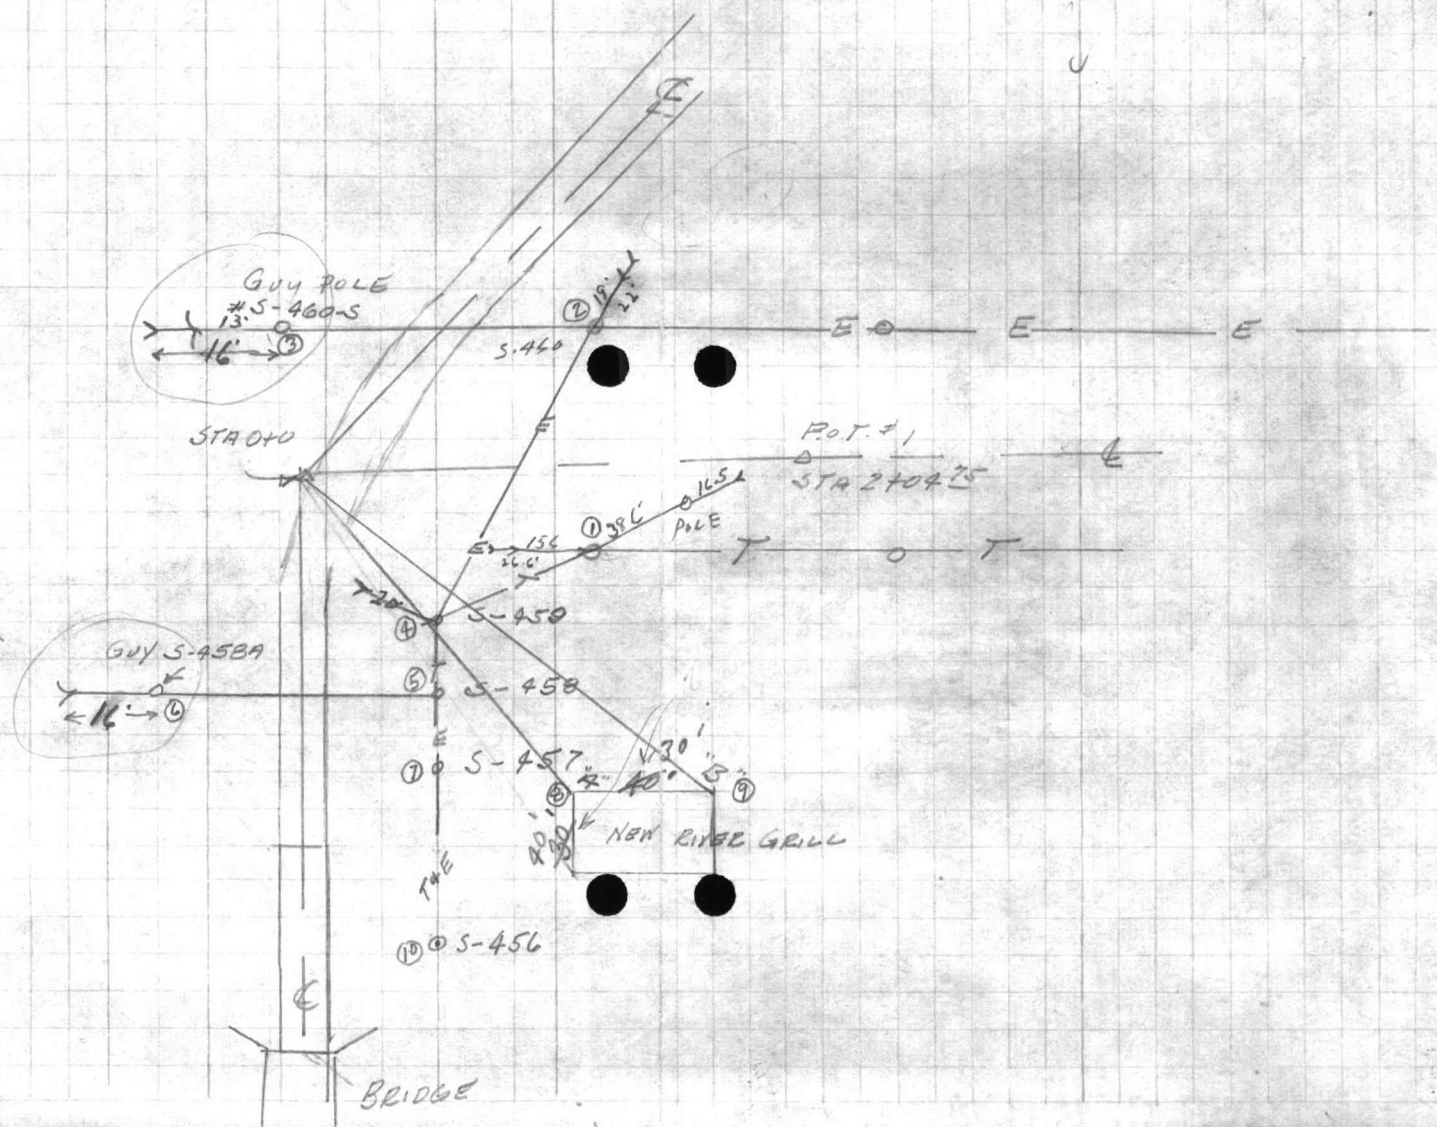





VALUABLE

SUBJECT _____

 RETURN TO
 PUBLIC WORKS
 OFFICE
 CAMP LEJEUNE
 NORTH CAROLINA

FIELD PARTY

 _____ IN CHARGE
 _____ INSTRUMENT
 _____ NOTES
 _____ TAPE READ
 _____ TAPE OR ROD
 _____ TAPE OR ROD
 _____ INSTRUMENT No.
 _____ TAPE No.

WEATHER

 CLEAR _____ SNOW _____
 CLOUDY _____ HOT _____
 WINDY _____ MODERATE _____
 RAIN _____ COLD _____
 FAIR _____ FOG _____


FILE No. _____

FLDR. No. _____

SHEET 2
 FIGURED BY _____
 NOTES CHECKED BY _____
 PLOTTED BY _____ DATE _____ 19____

Quad. No. _____

STATION	DIST.	ANGLE ° ' "	+	H. I. BEARING	VER: ANG. DIFF.	ELEVATION
---------	-------	----------------	---	------------------	--------------------	-----------

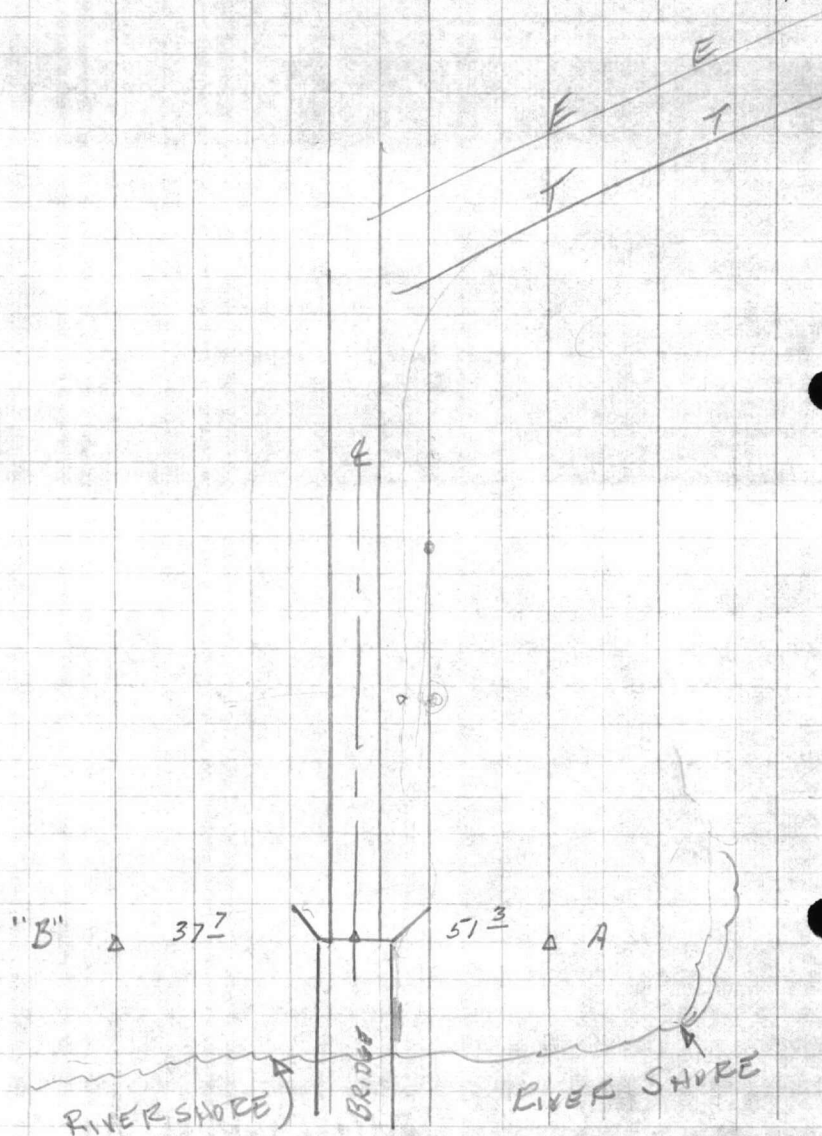

VALUABLE

SUBJECT LOCATION TEL. & ELEC.
POLES

RETURN TO
PUBLIC WORKS
OFFICE
CAMP LEJEUNE
NORTH CAROLINA

FIELD PARTY
MORTON
IN CHARGE
INSTRUMENT
NOTES
TAPE READ
TAPE OR ROD
TAPE OR ROD
INSTRUMENT NO.
TAPE NO.

WEATHER
CLEAR
CLOUDY
WINDY
RAIN
FAIR
SNOW
HOT
MODERATE
COLD
FOG
FIGURED BY
NOTES CHECKED BY
PLOTTED BY

FILE No. _____
FLDR. No. _____
SHEET KA
DATE 10-16 1957

Quad. No. _____

STATION	DIST.	ANGLE " "	+	H. I. BEARING	VER: ANG. DIFF.	ELEVATION
138	25	37 30				
138	25	37 30	12			
81	46	35 00	14			
106	82	47 30	18			
180	104	53 00	16			
256	112	04 30	17			
179 ³⁰	19	08 30	1			
158 ⁴⁰	340	42 00	2			
62	301	30 00	3			
97	80	08 00	4			
218	110	34 00	5			
212	130	53 00	6			
305	114	30 00	7			
360	110	58 45	8			
366	106	28 45	9			
493	117	47 30	10			
179 ³⁰	18	08 30	11			

TO END TELEPHONE POLE ON MAIN LINE
" " ELEC, " #S960 ON MAIN LINE
ELECT GUY POLE #S-460-S
TO POWER POLES-459 TELEP. COND. ON POLE
" " " S-458 " " " "
GUY POLE S-458A
TO POWER POLES S-457 " " " "
TO COR "A" NEW RIVER GRILL
" " "B" " " " "
POWER POLE #S-456 TELEP. COND. GOES
UNDER GROUND AT THIS POLE
END OLD UNDERGROUND TELEP CABLE
AT END TELEPH. POLE
TOP OLD TELEPH CABLE
" " " " 30" DEEP
" " " " " "
" " " " " "
" " " " " "








180
2
360

VALUABLE

SUBJECT _____

RETURN TO
PUBLIC WORKS
OFFICE
CAMP LEJEUNE
NORTH CAROLINA

FIELD PARTY

 _____ IN CHARGE
 _____ INSTRUMENT
 _____ NOTES
 _____ TAPE READ
 _____ TAPE OR ROD
 _____ INSTRUMENT No. _____
 _____ TAPE No. _____

WEATHER

 CLEAR
 CLOUDY
 WINDY
 RAIN
 FAIR
 SNOW
 HOT
 MODERATE
 COLD
 FOG

FILE No. _____

FLDR. No. _____

SHEET 3A of

FIGURED BY _____

NOTES CHECKED BY _____

PLOTTED BY _____ DATE _____ 19__

Quad. No. _____

STATION	DIST.	ANGLE ° ' "	+	H. I. BEARING	VER: ANG. DIFF.	ELEVATION
---------	-------	----------------	---	------------------	--------------------	-----------

72 87 02 00 1 ✓

70 83 54 30 2 ✓

73 81 23 00 3 ✓

6.50 56 30 30 4 ✓

12.50 32 44 00 5 ✓

14 32 40 30 6 ✓

38 355 11 30 7 ✓

35 358 56 30 8 ✓

31 359 02 45 9

16 356 21 30 10

14 352 36 00 11 ✓

TEL. CABLE (LEAD)

BIG BLACK CABLE ?

BIG BLACK CABLE ?

TEL. CABLE (LEAD)

BIG BLACK CABLE

BIG BLACK CABLE

BIG BLACK CABLE COMES OUT GROUND & GOES
DOWN SIDE OF BRIDGE2" CONDUCT COMES OUT GROUND & LEAD
CABLE GOES DOWN SIDE OF BRIDGECOR. BRIDGE BUTMENT TWO LEAD CABLES
& TWO SMALL BLACK CABLES UNDER GROUND AT
THIS COR.

BIG BLACK CABLE GOING TO BRIDGE

TEL. CABLE (LEAD) GOING TO BRIDGE

VALUABLE

SUBJECT _____

 RETURN TO
 PUBLIC WORKS
 OFFICE
 CAMP LEJEUNE
 NORTH CAROLINA

FIELD PARTY

 _____ IN CHARGE
 _____ INSTRUMENT
 _____ NOTES
 _____ TAPE READ
 _____ TAPE OR ROD
 _____ TAPE OR ROD
 _____ INSTRUMENT NO.
 _____ TAPE NO.

WEATHER

 CLEAR SNOW
 CLOUDY HOT
 WINDY MODERATE
 RAIN COLD
 FAIR FOG

FILE No. _____

FLDR. No. _____

SHEET 2A

DATE _____ 19__

Quad. No. _____

STATION	DIST.	ANGLE " "	+	H. I. BEARING	VER. ANG. DIFF.	ELEVATION
---------	-------	--------------	---	------------------	--------------------	-----------

 AT POINT 'A'
 BS. @ END @ BRIDGE

66'	291	53'00"	1			
80'	163	42'00"	2			
141'	140	31'00"	3			
200'	129	30'30"	4			
283	115	13'30"	5			
351	106	21'00"	6			
382	106	54'30"	7			

WORKED BY DENNIS 10-17-57

29.50	285	03	1	✓		
58	278	19	2	✓		
46	290	13	3	✓	?	
40.50	313	03'30"	4	✓		
8	335	43'30"	5	✓		
5	290	19'00"	6	✓		
69	162	02'30"	7	✓		
205	111	32'30"	8	✓		
259	103	46'00"	9	✓		
343	103	42'30"	10	✓		
410	108	30'00"	11	✓		
448	108	00'30"	12	✓		
475	114	47'30"	13	✓		
274	89	24'30"	14	✓		
278	88	46'00"	15	✓		
278	87	56'00"	16	✓		
84	85	14'30"	17	✓		
91	91	41'30"	18	✓		

 WORKED BY MORTON
 10-14-57

HIGH WATER MARL RIVER BANK

"	"	"	"	"	"	"
"	"	"	"	"	"	"
"	"	"	"	"	"	"
"	"	"	"	"	"	"
"	"	"	"	"	"	"
"	"	"	"	"	"	"
"	"	"	"	"	"	"
"	"	"	"	"	"	"

OLD SHORE LINE

 POWER POLE # 5-453
 GUY WIRE P.P. 5-453
 DEAD POWER CABLE
 GUY WIRE P.P. 5-453
 GUY WIRE P.P. 5-453
 PINE POWER POLE TO FISHING PIER
 POWER POLE TO FISHING PIER
 POWER POLE TO FISHING PIER
 OLD SHORE LINE
 POWER POLE TO FISHING PIER & OLD SHORE
 OLD SHORE LINE
 OLD SHORE LINE
 OLD SHORE LINE
 TEL. CABLE (LEAD)
 POWER POLE # 5-453
 BIG BLACK CABLE ?
 TRANSFORMER POLE # 5-454
 GUY WIRE P.P. 5-454























VALUABLE

RETURN TO
PUBLIC WORKS
OFFICE
CAMP LEJEUNE
NORTH CAROLINA

SUBJECT LOCATION SHORE
LINE & BRIDGETENDERS
HOUSE

FIELD PARTY
DENNIS IN CHARGE
INSTRUMENT _____
NOTES _____
TAPE READ _____
TAPE OR ROD _____
TAPE OR ROD _____
INSTRUMENT No. _____
TAPE No. _____

WEATHER
CLEAR _____
CLOUDY _____
WINDY _____
RAIN _____
FAIR _____
SNOW _____
HOT _____
MODERATE _____
COLD _____
FOG _____
FIGURED BY _____
NOTES CHECKED BY _____
PLOTTED BY _____

FILE No. _____
FLDR. No. _____
SHEET 1 of 1
DATE 10-12-57

Quad. No. _____

STATION	DIST.	ANGLE ° ' "	+	H. I. BEARING	VER: ANG. DIFF.	ELEVATION
* AT POINT "B" BS & SOUTHEAST BRIDGE						
"A"	34	281 03 30	1	✓		
"B"	82	260 46 00	2	✓		
"C"	53	256 01 45	3	✓		
	71	226 23 45	4	✓		
	108	82 15 00	5			
	97	82 15 00				
	115	113 09	6			
	109	113 09				
	153	139 40	7			
	147	139 40				
	195	163	8			


D.P. # 5-454 "A"
COR. BRIDGETENDERS HOUSE
COR. " " " "
COR. " " " "

EDGE WATER
HIGH WATER

EDGE WATER
HIGH WATER

EDGE WATER
HIGH WATER

EDGE WATER

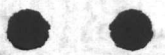



VALUABLE

SUBJECT BRIDGE TENDERS
HOUSE

RETURN TO
PUBLIC WORKS
OFFICE
CAMP LEJEUNE
NORTH CAROLINA


FIELD PARTY
DENNIS IN CHARGE
INSTRUMENT _____
NOTES _____
TAPED READ _____
TAPED OR ROD _____
TAPED OR ROD _____
INSTRUMENT NO. _____
TAPE NO. _____

WEATHER
CLEAR _____ SNOW _____
CLOUDY _____ HOT _____
WINDY _____ MODERATE _____
RAIN _____ COLD _____
FAIR _____ FOG _____
FIGURED BY _____
NOTES CHECKED BY _____
PLOTTED BY _____

FILE No. _____
FLDR. No. _____
SHEET 1 of 1
DATE 10-12 1957

Quad. No. _____

STATION	DIST.	ANGLE			+	H. I. BEARING	VER. ANG. DIFF.	ELEVATION
		°	'	"				

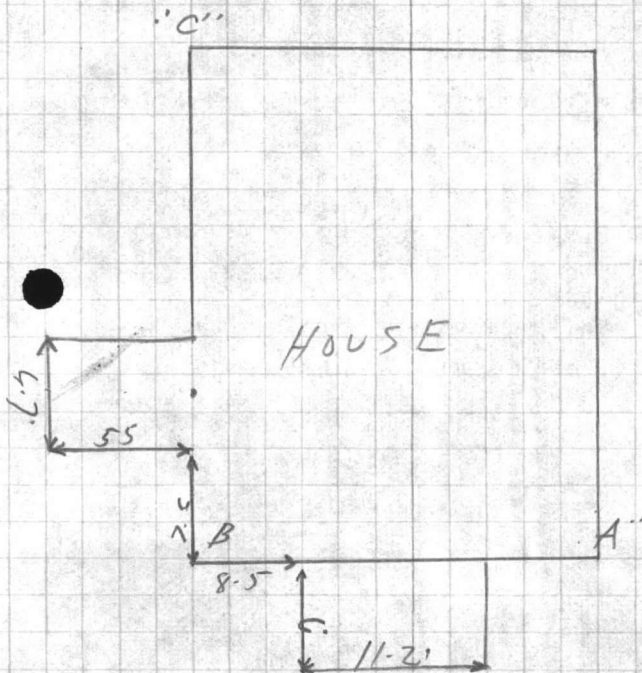

BRIDGE

172






VALUABLE

RETURN TO
PUBLIC WORKS
OFFICE
CAMP LEJEUNE
NORTH CAROLINA

SUBJECT LOCATION HIWAY
172 SOUTH OF BRIDGE

FIELD PARTY
DENNIS IN CHARGE
_____ INSTRUMENT
_____ NOTES
_____ TAPE READ
_____ TAPE OR ROD
_____ TAPE OR ROD
_____ INSTRUMENT NO.
_____ TAPE NO.

WEATHER
CLEAR _____ SNOW _____
CLOUDY _____ HOT _____
WINDY _____ MODERATE _____
RAIN _____ COLD _____
FAIR _____ FOG _____
FIGURED BY _____
NOTES CHECKED BY _____
PLOTTED BY _____


FILE No. _____
FLDR. No. _____
SHEET 1 of 1
DATE 10-17 1957

Quad. No. _____

STATION	DIST.	ANGLE			H. I. BEARING	VER. ANG. DIFF.	ELEVATION
		°	'	"			

7+00.00

6+00

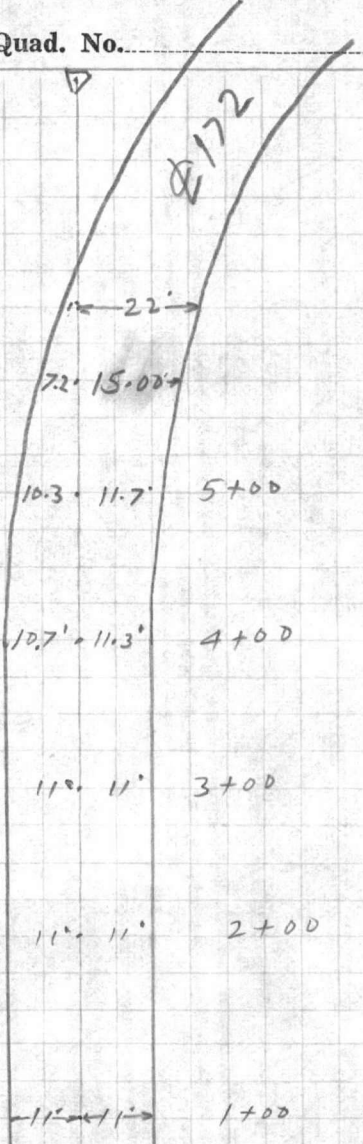

END BRIDGE







VALUABLE

RETURN TO
PUBLIC WORKS
OFFICE
CAMP LEJEUNE
NORTH CAROLINA

SUBJECT LOCATION @ HIWAY #172
@ SLAVER RD. (DIRT)

FIELD PARTY
DENNIS IN CHARGE
INSTRUMENT _____
NOTES _____
TAPE READ _____
TAPE OR ROD _____
TAPE OR ROD _____
INSTRUMENT NO. _____
TAPE NO. _____

WEATHER
CLEAR _____ SNOW _____
CLOUDY _____ HOT _____
WINDY _____ MODERATE _____
RAIN _____ COLD _____
FAIR _____ FOG _____
FIGURED BY _____
NOTES CHECKED BY _____
PLOTTED BY _____

FILE No. _____
FLDR. No. _____
SHEET 1 of 1
DATE 10-18-1957

Quad. No. _____

STATION	DIST.	ANGLE		+	H. I. BEARING	VER: ANG. DIFF.	ELEVATION		
		°	"						
<u>1 AT 0+00</u>									
<u>BS. POT. 2+04 75</u>									
	<u>555</u>	<u>318</u>	<u>2630</u>	<u>1</u>					<u>@ HIWAY # 172</u>
	<u>478</u>	<u>318</u>	<u>2330</u>	<u>2</u>					<u>" "</u>
	<u>405</u>	<u>318</u>	<u>1130</u>	<u>3</u>					<u>" "</u>
	<u>312</u>	<u>318</u>	<u>2130</u>	<u>4</u>					<u>" "</u>
	<u>212</u>	<u>319</u>	<u>4430</u>	<u>5</u>	<u>✓</u>				<u>" "</u>
	<u>138</u>	<u>322</u>	<u>5830</u>	<u>6</u>	<u>✓</u>				<u>" "</u>
	<u>57</u>	<u>339</u>	<u>1230</u>	<u>7</u>	<u>✓</u>				<u>" "</u>
	<u>3550</u>	<u>81</u>	<u>2400</u>	<u>8</u>	<u>✓</u>				<u>" "</u>
	<u>79</u>	<u>110</u>	<u>0900</u>	<u>9</u>	<u>✓</u>				<u>" "</u>
	<u>122</u>	<u>116</u>	<u>5230</u>	<u>10</u>	<u>✓</u>				<u>" "</u>
<u>✓</u>	<u>99</u>	<u>320</u>	<u>2700</u>	<u>11</u>					<u>@ DIRT RD. @ EDGE HIWAY # 172</u>
	<u>102</u>	<u>302</u>	<u>4400</u>	<u>12</u>					<u>@ 13' DIRT RD.</u>
	<u>112</u>	<u>283</u>	<u>29</u>	<u>13</u>					<u>@ 13' " "</u>
	<u>147</u>	<u>254</u>	<u>59</u>	<u>14</u>					<u>@ 13' " "</u>
	<u>282</u>	<u>238</u>	<u>1000</u>	<u>15</u>					<u>@ 13' " "</u>
	<u>435</u>	<u>230</u>	<u>40</u>	<u>16</u>					<u>@ 13' " "</u>








VALUABLE

RETURN TO
PUBLIC WORKS
OFFICE
CAMP LEJEUNE
NORTH CAROLINA

SUBJECT LOCATION MOUTH
OF CREEK STA. 22+46
PROPERTY LINE

FIELD PARTY
DENNIS IN CHARGE

INSTRUMENT

NOTES

TAPE READ

TAPE OR ROD

TAPE OR ROD

INSTRUMENT NO. _____
TAPE NO. _____

WEATHER
CLEAR SNOW
CLOUDY HOT
WINDY MODERATE
RAIN COLD
FAIR FOG
FIGURED BY _____
NOTES CHECKED BY _____
PLOTTED BY _____
FILE No. _____
FLDR. No. _____
SHEET 3 Box 1
DATE 10-12 1957

Quad. No. _____

STATION	DIST.	ANGLE ° ' "	+	H. I. BEARING	VER: ANG. DIFF.	ELEVATION	
<u>POINT A</u>							
<u>BS PI. 24 +21.48</u>							
<u>TD</u>							
<u>490</u>	<u>287</u>	<u>4130</u>	<u>1</u>				<u>EDGE WATER NEW RIVER</u>
<u>469</u>	<u>287</u>	<u>5400</u>	<u>2</u>				<u>EDGE WATER NEW RIVER</u>
<u>464</u>	<u>290</u>	<u>1130</u>	<u>3</u>				<u>EDGE CREEK</u>
<u>456</u>	<u>290</u>	<u>0630</u>	<u>4</u>				<u>EDGE CREEK</u>
<u>426</u>	<u>286</u>	<u>5130</u>	<u>5</u>				<u>INTER. NEW RIVER & CREEK</u>
<u>417</u>	<u>286</u>	<u>5600</u>	<u>6</u>				<u>INTER NEW RIVER & CREEK</u>
<u>362</u>	<u>287</u>	<u>0500</u>	<u>7</u>				<u>EDGE WATER NEW RIVER</u>




31x60
24x21
7 38

VALUABLE

SUBJECT _____

RETURN TO
PUBLIC WORKS
OFFICE
CAMP LEJEUNE
NORTH CAROLINA

FIELD PARTY

IN CHARGE

INSTRUMENT

NOTES

TAPE READ

TAPE OR ROD

TAPE OR ROD

INSTRUMENT No.

TAPE No.

WEATHER

CLEAR
CLOUDY
WINDY
RAIN
FAIR

SNOW
HOT
MODERATE
COLD
FOG

FILE No. _____

FLDR. No. _____

SHEET 3A4

DATE _____ 19__

FIGURED BY _____

NOTES CHECKED BY _____


PLOTTED BY _____

Quad. No. _____

STATION	DIST.	ANGLE ° ' "	+	H. I. BEARING	VER: ANG. DIFF.	ELEVATION

267 37 30 (1)
82 53 00 (3)
267 37 40 (18)

TAPE #1
B.S. POINT #
TO POINT 'A'

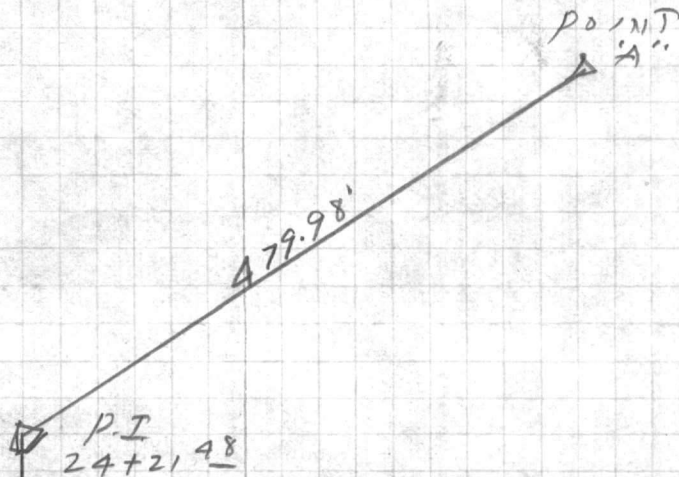

$$\begin{array}{r} 267 \ 3230 \\ 3 \overline{) 825300} \\ \underline{42} \end{array}$$

$$\begin{array}{r} 720 \\ 3 \overline{) 802} \end{array}$$

$$\begin{array}{r} 267 \\ 20 \\ 22 \\ 22 \end{array}$$

$$\begin{array}{r} 60 \\ 3 \overline{) 113} \\ \underline{60} \\ 53 \\ \underline{37} \\ 16 \end{array}$$

$$\begin{array}{r} 257 \ 3730 \\ 8 \overline{) 2205230} \\ \underline{2} \end{array}$$

VALUABLESUBJECT LOCATION POLES & GUY
WIRES P.I. 24+21.48RETURN TO
PUBLIC WORKS
OFFICE
CAMP LEJEUNE
NORTH CAROLINA

FIELD PARTY

DENNISIN CHARGE
INSTRUMENT
NOTES
TAPE READ
TAPE OR ROD
TAPE OR ROD
INSTRUMENT No.
TAPE No.

WEATHER

CLEAR
CLOUDY
WINDY
RAIN
FAIRSNOW
HOT
MODERATE
COLD
FOG

FILE No. _____

FLDR. No. _____

SHEET 3C10fDATE 10-12 1957


FIGURED BY _____


NOTES CHECKED BY _____

PLOTTED BY _____

Quad. No. P.O.T. 31+LD 45

STATION	DIST.	ANGLE ° ' "	+	H. I. BEARING	VER: ANG. DIFF.	ELEVATION
<u>AT P.I. 24+21.48</u>						
<u>F.S. P.O.T. 31+LD 45</u>						
<u>TD</u>						
	<u>62.70</u>	<u>64 05 00</u>	<u>1</u>	<u>TEL. POLE</u>		
	<u>38.56</u>	<u>23 00</u>	<u>2</u>	<u>GUY</u>		
	<u>60.70</u>	<u>263 07 00</u>	<u>3</u>	<u>ELEC. POLE # S-472</u>		
	<u>84</u>	<u>262 11 30</u>	<u>4</u>	<u>GUY WIRE (ELEC)</u>		
	<u>66</u>	<u>245 52 30</u>	<u>5</u>	<u>GUY WIRE (ELEC)</u>		

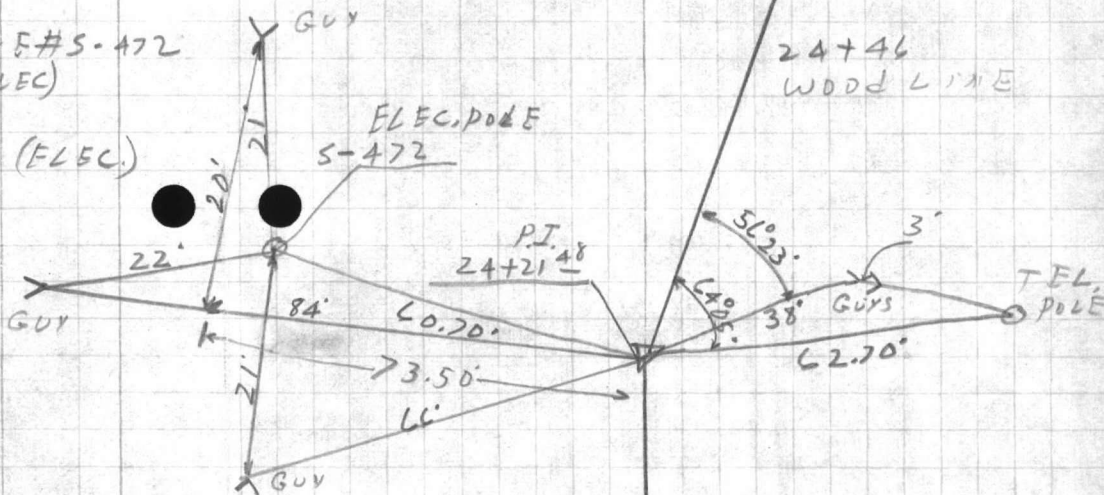

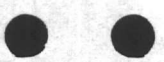

1950
 1951
VALUABLE
 SUBJECT Telephone & Power
LINE SURVEY CONTD.

 RETURN TO
 PUBLIC WORKS
 OFFICE
 CAMP LEJEUNE
 NORTH CAROLINA

FIELD PARTY

 _____ IN CHARGE
 _____ INSTRUMENT
 _____ NOTES
 _____ TAPE READ
 _____ TAPE OR ROD
 _____ TAPE OR ROD
 _____ INSTRUMENT No.
 _____ TAPE No.

WEATHER

 CLEAR SNOW
 CLOUDY HOT
 WINDY MODERATE
 RAIN COLD
 FAIR FOG


FILE No. _____

FLDR. No. _____

SHEET 4-0fDATE 10-15 1947

Quad. No. _____

STATION	DIST.	ANGLE			+	H. I. BEARING	VER. ANG. DIFF.	ELEVATION
		°	'	"				

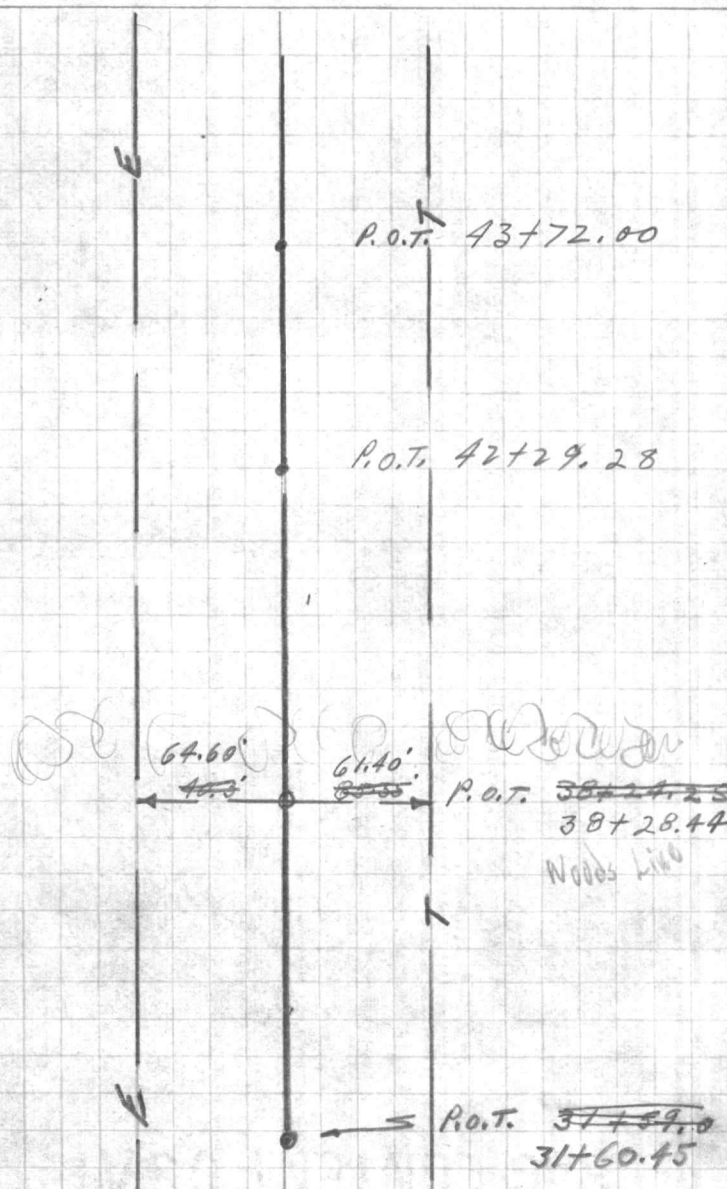

VALUABLE










VALUABLE

SUBJECT _____

RETURN TO
PUBLIC WORKS
OFFICE
CAMP LEJEUNE
NORTH CAROLINA

FIELD PARTY

_____. IN CHARGE
_____. INSTRUMENT
_____. NOTES
_____. TAPE READ
_____. TAPE OR ROD
_____. TAPE OR ROD
_____. INSTRUMENT NO.
_____. TAPE NO.

WEATHER

CLEAR
CLOUDY
WINDY
RAIN
FAIR
SNOW
HOT
MODERATE
COLD
FOG

FILE No. _____

FLDR. No. _____

SHEET 5 of

DATE _____ 19__


FIGURED BY _____

NOTES CHECKED BY _____

PLOTTED BY _____

Quad. No. _____

STATION	DIST.	ANGLE			H. I. BEARING	VER: ANG. DIFF.	ELEVATION
		°	'	"			

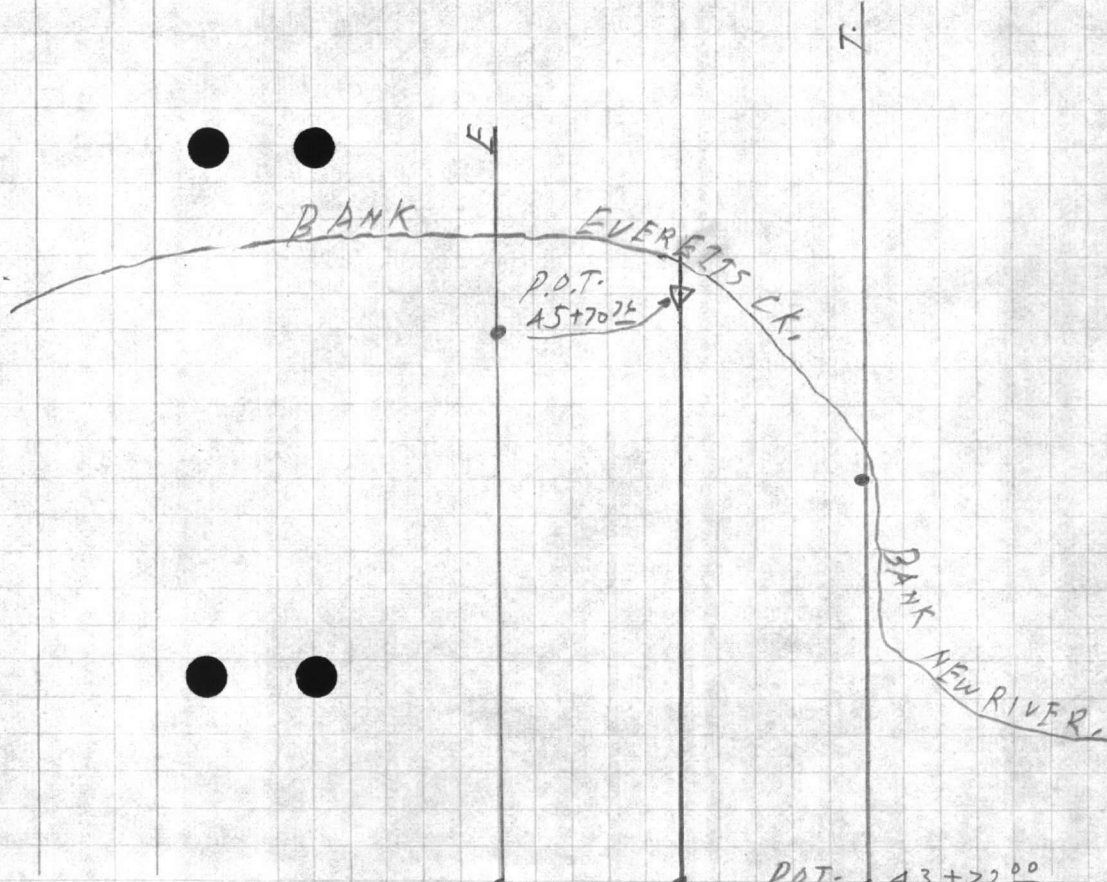







VALUABLE

SUBJECT _____

RETURN TO
PUBLIC WORKS
OFFICE
CAMP LEJEUNE
NORTH CAROLINA

FIELD PARTY

____ IN CHARGE
____ INSTRUMENT
____ NOTES
____ TAPE READ
____ TAPE OR ROD
____ TAPE OR ROD
____ INSTRUMENT NO.
____ TAPE NO.

WEATHER

CLEAR
CLOUDY
WINDY
RAIN
FAIR
SNOW
HOT
MODERATE
COLD
FOG

FILE No. _____


FLDR. No. _____

SHEET 604

DATE 10-12-1957

Quad. No. _____

STATION	DIST.	ANGLE ' "	+	H. I. BEARING	VER. ANG. DIFF.	ELEVATION
AT P.O.T. 43+72 ⁰⁰						
F.S. P.O.T. 45+70 ⁷⁶						
TD						
TEL. POLE # 524	1	152 08 00				
	2	304 16 00				DIST. 133.10'
	M	152 08 00				
GUY WIRE # 524	1	138 12 00				
	2	276 24 00				DIST. 93.80'
	M	138 12 00				
ELEC. POLE ANGLE	1	219 38 30				
	2	79 17 00				DIST. 104.40'
	M	219 38 30				

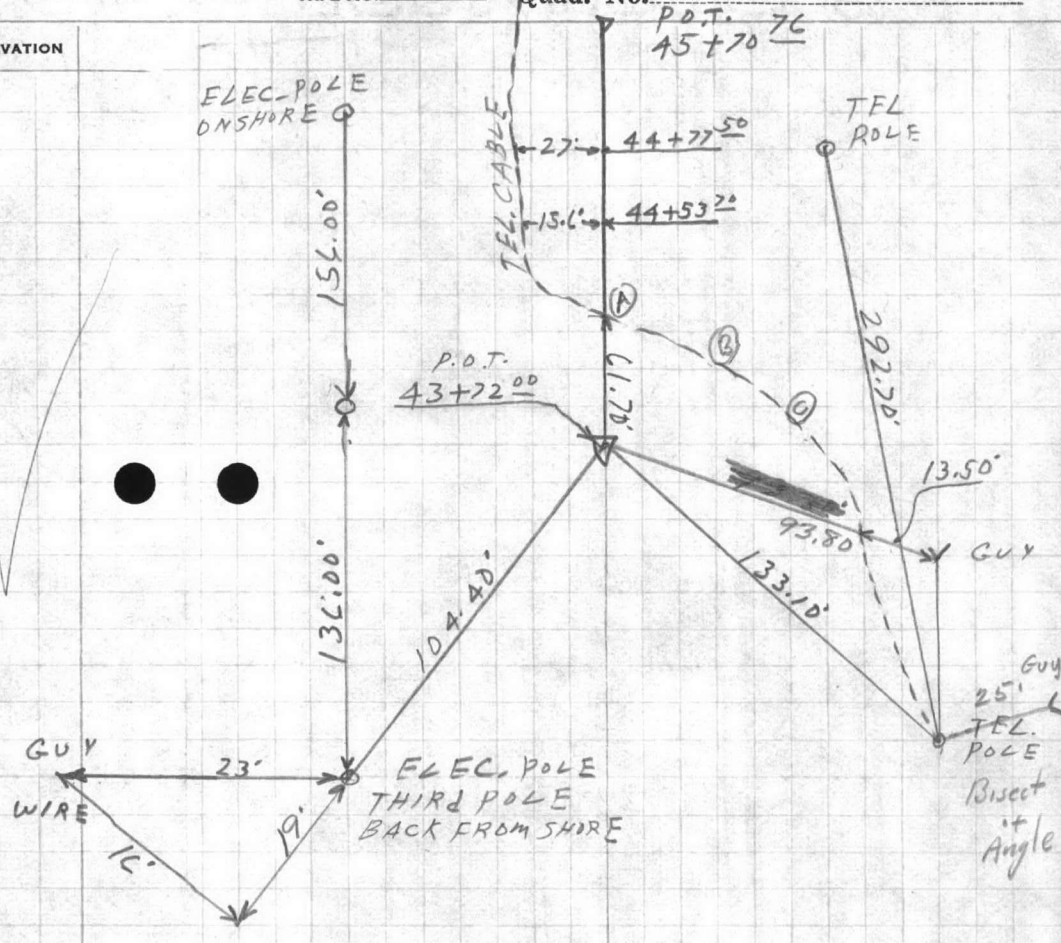

VALUABLE

SUBJECT

LOCATION UNDER

GROUND TEL. CABLE

RETURN TO
PUBLIC WORKS
OFFICE
CAMP LEJEUNE
NORTH CAROLINA

FIELD PARTY

 _____ IN CHARGE
 _____ INSTRUMENT
 _____ NOTES
 _____ TAPE READ
 _____ TAPE OR ROD
 _____ TAPE OR ROD
 _____ INSTRUMENT No.
 _____ TAPE No.

WEATHER

 CLEAR
 CLOUDY
 WINDY
 RAIN
 FAIR
 SNOW
 HOT
 MODERATE
 COLD
 FOG

FILE No. _____

FLDR. No. _____

SHEET

DATE

6Aaf

19

Quad. No. _____

STATION	DIST.	ANGLE		+	H. I. BEARING	VER: ANG. DIFF.	ELEVATION
		°	"				
AT POT. 43+72	00						
F.S. POT. 45+70	26						
AT TEL. CABLE	0 0 0			✓		DIST. 61.70	
TEL. CABLE	65 17			✓		DIST. 37.00	
TEL. CABLE	112 22 30			✓		DIST. 53.50'	

APR 19 1950

RECEIVED
PUBLIC WORKS
DIVISION










VALUABLE

SUBJECT _____

RETURN TO
PUBLIC WORKS
OFFICE
CAMP LEJEUNE
NORTH CAROLINA

FIELD PARTY

IN CHARGE

INSTRUMENT

NOTES

TAPE READ

TAPE OR ROD

TAPE OR ROD

INSTRUMENT No.

TAPE No. _____

WEATHER

CLEAR
CLOUDY
WINDY
RAIN
FAIR
SNOW
HOT
MODERATE
COLD
FOG
FIGURED BY _____
NOTES CHECKED BY _____
PLOTTED BY _____

FILE No. _____

FLDR. No. _____

SHEET CCaf

DATE 10-17 1957

Quad. No. _____

STATION	DIST.	ANGLE ' "	+	H. I. BEARING	VER: ANG. DIFF.	ELEVATION	
AT P.O.T. 45+70.76							
B.S. P.O.T. A3+72.00							
T.O.							
53	26	25 30	1	✓			UNDERGROUND TEL.
15.5	131	08 00	2	✓			UNDERGROUND TEL. BANK
41	61	29 30	3	✓			GUYWIRE
39	65	20 45	4	✓			GUYWIRE
153	102	58 30	5	✓			BANK
189	102	58 30	6	✓			EDGE WATER
130	112	13 00	7	✓			BANK
137	112	13 00	8	✓			EDGE WATER
34	112	37 00	9	✓			BANK
121	123	47 00	10	✓			EDGE WATER
104	140	15 00	11	✓			EDGE WATER
44	165	37 00	12				EDGE WATER
42.5	182	00 00	13	✓			EDGE WATER & UNDERGROUND TEL.
34.45	108	03 30	✓				ELEC. POLE ON SHORE LINE (BANK)
35.50	316	53 30	✓				TEL. POLE ON SHORE LINE (BANK)
	309	40 30					(TO SNEEDS FERRY FIRE TOWER)
C	259	22 00	1	✓			BANK
45	226	35 00	2	✓			EDGE WATER
26	266	36 00	3	✓			EDGE WATER
48	312	04 00	4	✓			EDGE WATER
39	324	31 00	5	✓			BANK
85	334	27 00	6	✓			EDGE WATER
85	336	45 00	7	✓			BANK
117	336	41 00	8	✓			BANK
116	332	04 00	9	✓			EDGE WATER
144	326	47 00	10	✓			BANK

Bearing N35°25'15"E
(Computed N35°25'24"E)









VALUABLE

SUBJECT _____

RETURN TO
 PUBLIC WORKS
 OFFICE
 CAMP LEJEUNE
 NORTH CAROLINA

FIELD PARTY

_____ IN CHARGE
 _____ INSTRUMENT
 _____ NOTES
 _____ TAPE READ
 _____ TAPE OR ROD
 _____ TAPE OR ROD
 _____ INSTRUMENT NO.
 _____ TAPE NO.

WEATHER

CLEAR
 CLOUDY
 WINDY
 RAIN
 FAIR

SNOW
 HOT
 MODERATE
 COLD
 FOG

FILE No. _____

FLDR. No. _____

SHEET 6 Duf

FIGURED BY _____

NOTES CHECKED BY _____

PLOTTED BY _____

DATE _____ 19 _____

Quad. No. _____

STATION	DIST.	ANGLE ° ' "	+	H. I. BEARING	VER: ANG. DIFF.	ELEVATION	
144	324	38 00	11	✓			EDGE WATER
175	322	07 00	12	✓			BANK
173	320	20 00	13	✓			EDGE WATER
213	323	46 00	14	✓			BANK
213	322	35 00	15	✓			EDGE WATER
36	357	32 00	16				GUY WIRE TEL. POLE ON SHORE
7	180	00 00	17				BANK







