

VALUABLEReturn To
Public Works
Office
Camp Lejeune
North Carolina

SUBJECT

ADDITIONAL DATA ON
SEWER DISPOSAL PLANT AT
TCNT CAMPFIELD PARTY
KELLUM In Charge
Instrument _____
Notes _____
Tape Read _____
Tape or Rod _____
Instrument No. _____
Tape No. _____WEATHER
Clear _____
Cloudy _____
Windy _____
Rain _____
Fair _____
Snow _____
Hot _____
Moderate _____
Cold _____
Fog _____
Figured By _____
Notes Checked By _____
Plotted By _____

FILE No.

98-9


Fldr. No. _____

Sheet _____

Date 6-2 1946

Quad. No. _____

Station	Dist.	Angle " "	+	H. I. Bearing	Ver: Ang. Diff.	Elevation
---------	-------	--------------	---	------------------	--------------------	-----------

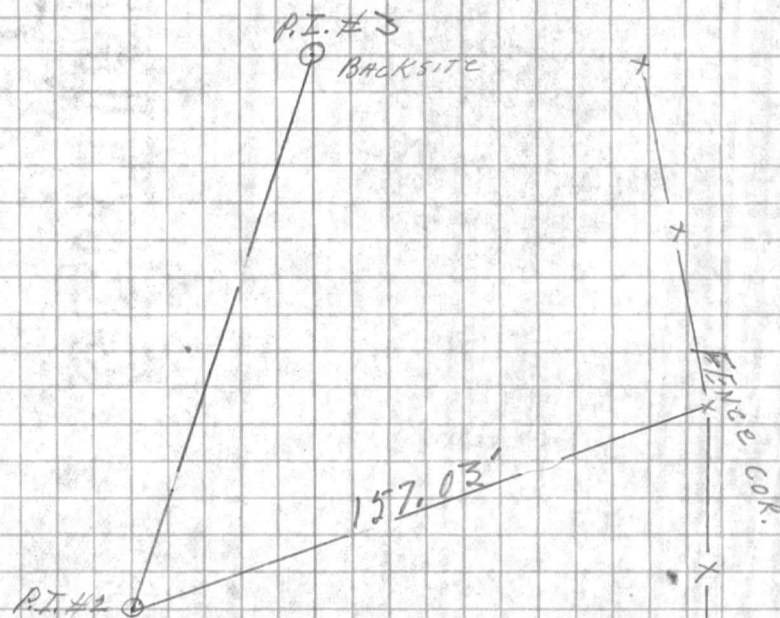

T. AT P.I. #2 1- 37° 21' 45"
 TO FENCE 2- 74° 43' 45"
 COR. MEAN = 37° 21' 52"















VALUABLE

SUBJECT SEWER DISPOSAL PLANT
LOCATION AT TENT CAMP

Return To
 Public Works
 Office
 Camp Lejeune
 North Carolina

FIELD PARTY

NEELUM In Charge
 _____ Instrument
 _____ Notes
 _____ Tape Read
 _____ Tape or Rod
 _____ Tape or Rod
 _____ Instrument No.
 _____ Tape No.


WEATHER

Clear _____
 Cloudy _____
 Windy _____
 Rain _____
 Fair _____

Snow _____
 Hot _____
 Moderate _____
 Cold _____
 Fog _____

FILE No. _____
 Fldr. No. _____
 Sheet 1-0512
 Date 3-27 19-46
 Plotted By _____
 Notes Checked By _____
 Figured By _____
 Quad. No. _____

Station	Dist.	Angle	+	H. I. Bearing	Ver: Ang. Diff.	Elevation
T-AT MON. #336	1-	140° 07' 30"				
T-AT MON. #336	2-	280° 19' 30"				
TO COR. "B" MCHN. FENCE.		140° 07' 45"				
T-AT MON. #336	1-	220° 51' 00"				
T-AT MON. #336	2-	81° 41' 45"				
TO COR. "A" MCHN. FENCE.		220° 50' 52"				
T-AT MON. #336	1-	197° 14' 00"				
T-AT MON. #336	2-	231° 42' 30"				
TO P.I. #1 MCHN.		197° 14' 10"				

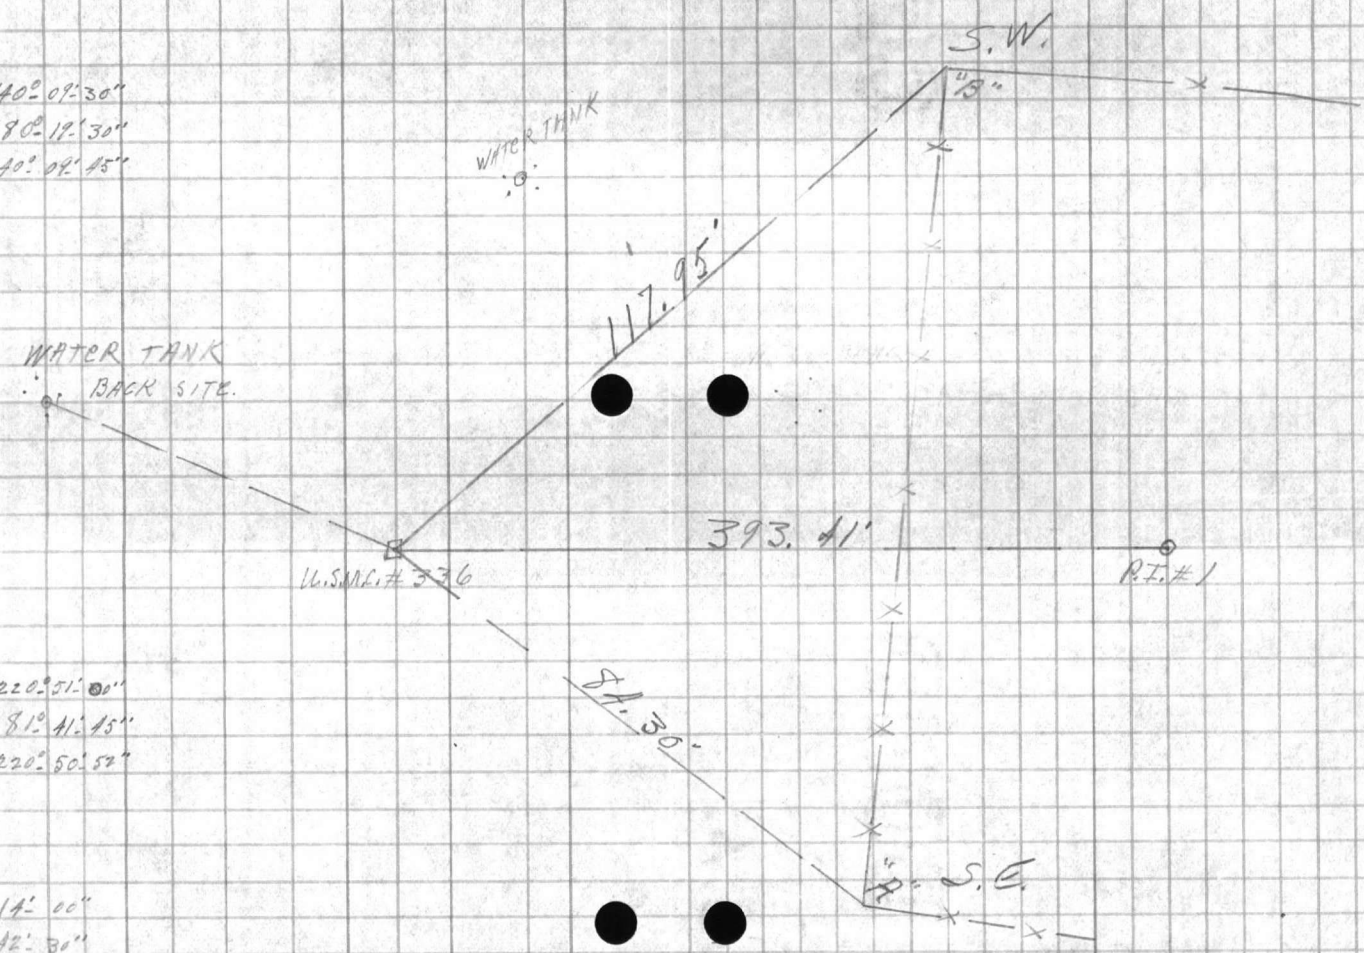

Plotted By: TDR 4-5-46
 checked By: J.F.M. 4-19-46
























VALUABLE

SUBJECT SEWER DISPOSAL LOCATION
AT TENT CAMP CONTO.

Return To
Public Works
Office
Camp Lejeune
North Carolina


FIELD PARTY
KELUM In Charge
Instrument _____
Notes _____
Tape Read _____
Tape or Rod _____
Tape or Rod _____
Instrument No. _____
Tape No. _____

WEATHER
Clear _____
Cloudy _____
Windy _____
Rain _____
Fair _____
Snow _____
Hot _____
Moderate _____
Cold _____
Fog _____
Figured By _____
Notes Checked By _____
Plotted By _____

FILE No. _____
Fldr. No. _____
Sheet 7-OF-12
Date 4-2 1946

Quad. No. _____

Station	Dist.	Angle	+	H. I. Bearing	Ver: Ang. Diff.	Elevation
TO COR. 'B'	1-281'	25' 30"				
MAN H.	2-202'	54' 00"				
MEAN	281'	25' 30"				
TO COR. 'H'	1-275'	31' 30"				
MAN H.	2-191'	00' 00"				
MEAN	275'	30' 00"				
TO COR. 'C'	1-308'	56' 15"				
CHARME	2-257'	53' 00"				
PIT	MEAN-308'	50' 30"				
TO COR. 'B'	1-302'	07' 15"				
CHARME	2-244'	15' 15"				
PIT	MEAN-302'	07' 32"				
TO COR. 'A'	1-285'	10' 00"				
CHARME	2-211'	30' 00"				
PIT	MEAN-285'	10' 00"				

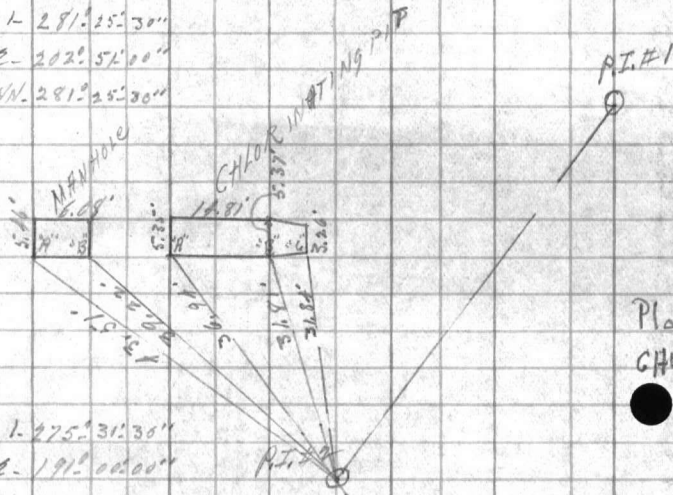

Plotted By: J.F.M. 4-18-46
CHECKED BY VLT - 4-19-46













VALUABLE

SUBJECT SEWER DISPOSAL LOCATION AT
TENT CAMP CONTD.


RETURN TO
PUBLIC WORKS
OFFICE
CAMP LEJEUNE
NEW RIVER, N. C.

FIELD PARTY
WELLMAN IN CHARGE
INSTRUMENT
NOTES
TAPE READ
TAPE OR ROD
TAPE OR ROD
INSTRUMENT No.
TAPE No.

WEATHER
CLEAR SNOW
CLOUDY HOT
WINDY MODERATE
RAIN COLD
FAIR FOG
FIGURED BY
NOTES CHECKED BY
PLOTTED BY
Quad. No.


FILE No.
FLDR. No.
SHEET B-01-13
DATE 1-2 1946

STATION	DIST.	ANGLE "	+	H. I.	VER. ANG. DIFF.	ELEVATION
TOP MAN. HOLE "G"	1- 98° 15' 00"					
	2- 196° 30' 00"					
	MEAN- 98° 15' 00"					
TOP MAN. HOLE "F"	1- 89° 26' 30"					
	2- 178° 53' 00"					
	MEAN- 89° 37' 00"					
TOP MAN. HOLE "E"	1- 106° 55' 45"					
	2- 213° 52' 15"					
	MEAN- 106° 58' 07"					
TOP MAN. HOLE "D"	1- 104° 23' 30"					
	2- 208° 46' 30"					
	MEAN- 104° 23' 15"					
TOP MAN. HOLE "C"	1- 89° 16' 45"					
	2- 178° 34' 00"					
	MEAN- 89° 17' 20"					
TOP MAN. HOLE "B"	1- 26° 41' 00"					
	2- 53° 22' 00"					
	MEAN- 26° 41' 00"					
TOP MAN. HOLE "A"	1- 22° 49' 30"					
	2- 45° 39' 00"					
	MEAN- 22° 49' 30"					

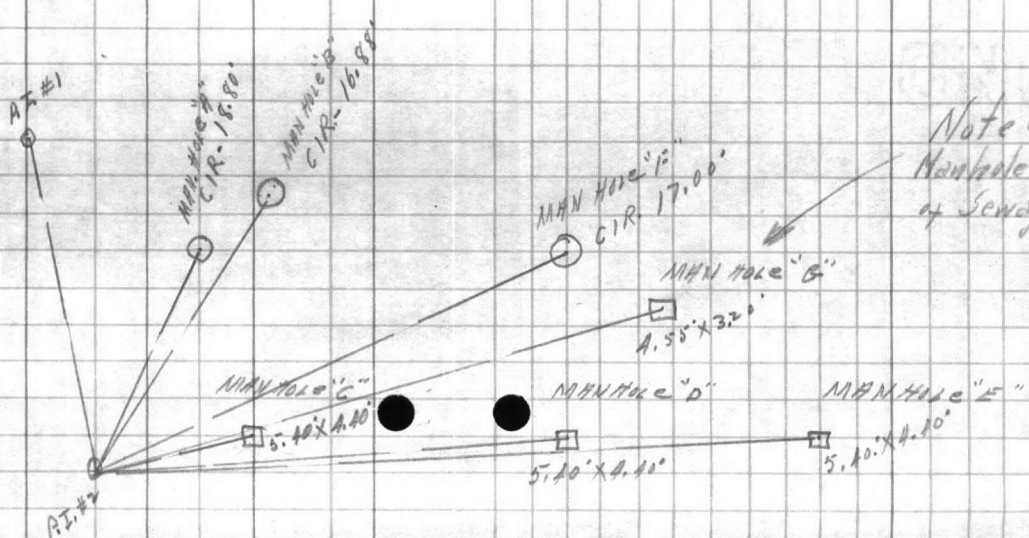

Note: Longest Dim. of Manholes is Parallel to Line of Sewage flow.

- TO R MANHOLE "A" - 68.45'
- TO R MANHOLE "B" - 78.87'
- TO R MANHOLE "C" - 19.28'
- TO R MANHOLE "D" - 68.08'
- TO R MANHOLE "E" - 117.65'
- TO R MANHOLE "F" - 54.34'
- TO R MANHOLE "G" - 88.02'

 






VALUABLE


SUBJECT SEWER DISPOSAL LOCATION
CONTG.

RETURN TO
PUBLIC WORKS
OFFICE
CAMP LEJEUNE
NEW RIVER, N. C.

FIELD PARTY
KELLY IN CHARGE
INSTRUMENT
NOTES
TAPE READ
TAPE OR ROD
TAPE OR ROD
INSTRUMENT NO.
TAPE NO.

WEATHER
CLEAR SNOW
CLOUDY HOT
WINDY MODERATE
RAIN COLD
FAIR FOG
FILE No.
FLDR. No.
SHEET 9-0F13
DATE 1-2 19 16
FIGURED BY
NOTES CHECKED BY
PLOTTED BY
Quad. No.

STATION	DIST.	ANGLE ° ' "	+	H. I.	VER. ANG. DIFF.	ELEVATION
TO COR. "A"	1-	205° 31' 30"				
	2-	512° 04' 00"				
	MEAN-	205° 32' 00"				
TO COR. "B"	1-	328° 25' 00"				
	2-	296° 50' 00"				
	MEAN-	328° 25' 00"				
TO COR. "A"	1-	316° 43' 15"				
	2-	273° 26' 30"				
	MEAN-	316° 43' 15"				
		169° 09' 00"				
TO P.T. #2		169° 09' 00"				
TO P.T. #3	3-	207° 27' 15"				
	MEAN-	69° 09' 05"				

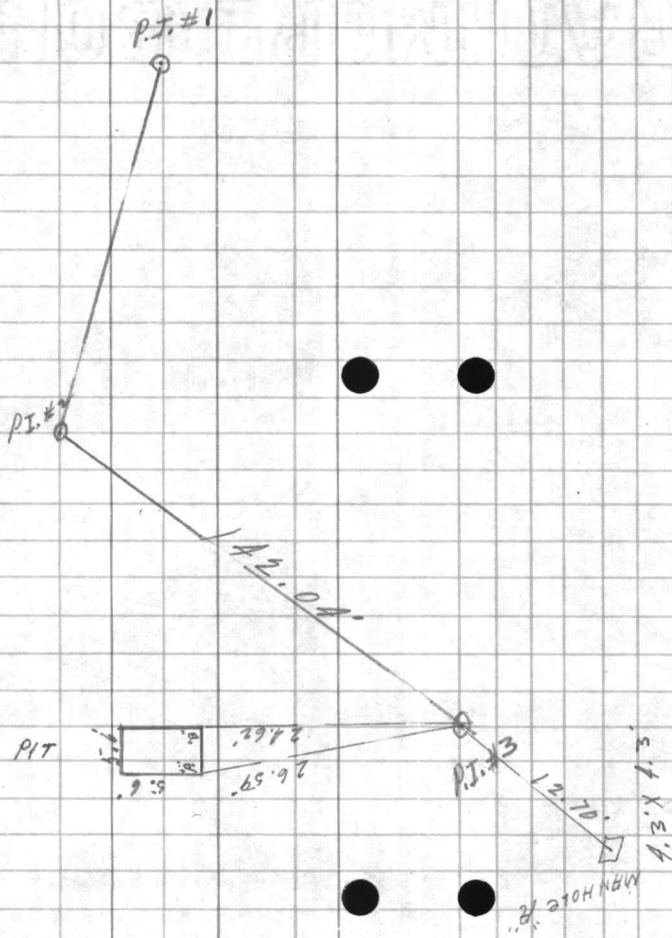











VALUABLEReturn To
Public Works
Office
Camp Lejeune
North CarolinaSUBJECT SEWER DISPOSAL LOCATION
ATTENT CAMP CONTD.

FIELD PARTY

RELLUM In Charge
 _____ Instrument
 _____ Notes
 _____ Tape Read
 _____ Tape or Rod
 _____ Tape or Rod
 _____ Instrument No.
 _____ Tape No.

WEATHER

Clear
Cloudy
Windy
Rain
Fair

Snow
Hot
Moderate
Cold
Fog


FILE No. _____

Fldr. No. _____

Sheet D-0-F-13Date 4-2 1946

Quad. No. _____

Station	Dist.	Angle " "	+	H. I. Bearing	Ver. Ang. Diff.	Elevation
TO SEWER INTAKE	1-271° 56' 00"					
	2-183° 52' 00"					
	MEAN-271° 56' 00"					
TO COR. 'B' #563	1-265° 46' 30"					
	2-171° 33' 00"					
	MEAN-265° 46' 30"					
TO COR. 'A' #563	1-234° 20' 00"					
	2-108° 40' 00"					
	MEAN-234° 20' 00"					
TO COR. 'B' STORE ROOM	1-265° 46' 30"	1-299° 04' 30"				
	2-171° 33' 00"	2-238° 09' 00"				
	MEAN-265° 46' 30"	MEAN-299° 04' 30"				
TO COR. 'A' STORE ROOM	1-234° 20' 00"	1-290° 37' 30"				
	2-108° 40' 00"	2-221° 15' 00"				
	MEAN-234° 20' 00"	MEAN-290° 37' 00"				
TO COR. 'B' PRIMARY	1-329° 41' 00"					
	2-299° 21' 30"					
	MEAN-329° 41' 15"					
TO COR. 'A' PRIMARY	1-206° 45' 30"					
	2-53° 37' 15"					
	MEAN-206° 45' 37"					

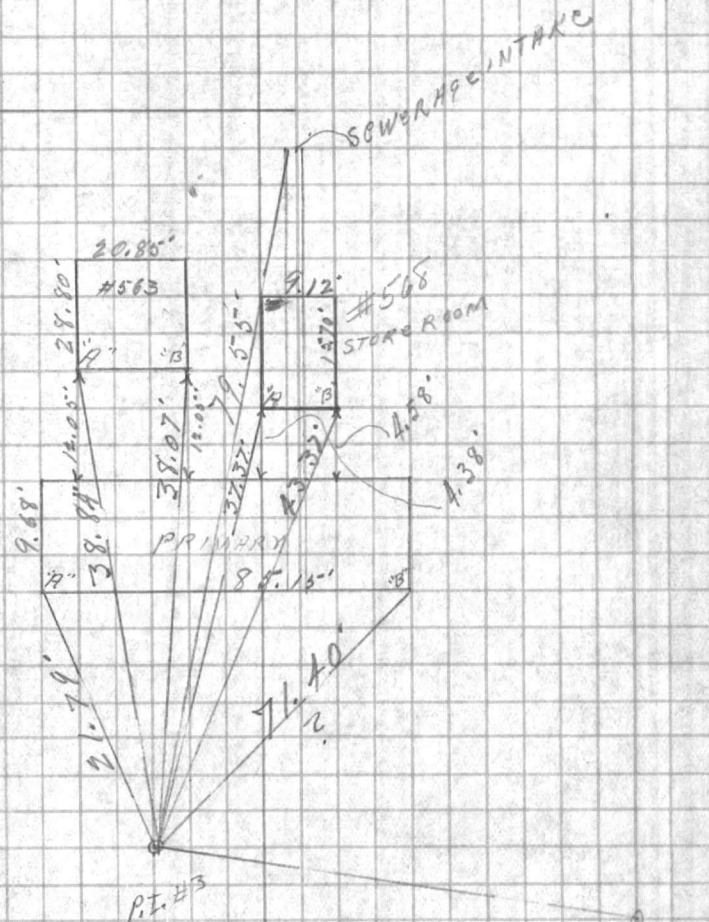

Plotted By: T.D.R. 4-5-46
 Checked By: J.A.M. 4-19-46

































VALUABLE
 SUBJECT SEWER DISPOSAL LOCATION
HT TENT CAMP

 Return To
 Public Works
 Office
 Camp Lejeune
 North Carolina


 FIELD PARTY
KELLAM In Charge
 _____ Instrument
 _____ Notes
 _____ Tape Read
 _____ Tape or Rod
 _____ Tape or Rod
 _____ Instrument No.
 _____ Tape No.

 WEATHER
 Clear _____
 Cloudy _____
 Windy _____
 Rain _____
 Fair _____
 Snow _____
 Hot _____
 Moderate _____
 Cold _____
 Fog _____
 Figured By _____
 Notes Checked By _____
 Plotted By _____

 FILE No. _____
 Fldr. No. _____
 Sheet 2-0 F1 B
 Date 3-27 1946

Quad. No. _____

Station	Dist.	Angle	+	H. I. Bearing	Ver: Ang. Diff.	Elevation
---------	-------	-------	---	---------------	-----------------	-----------

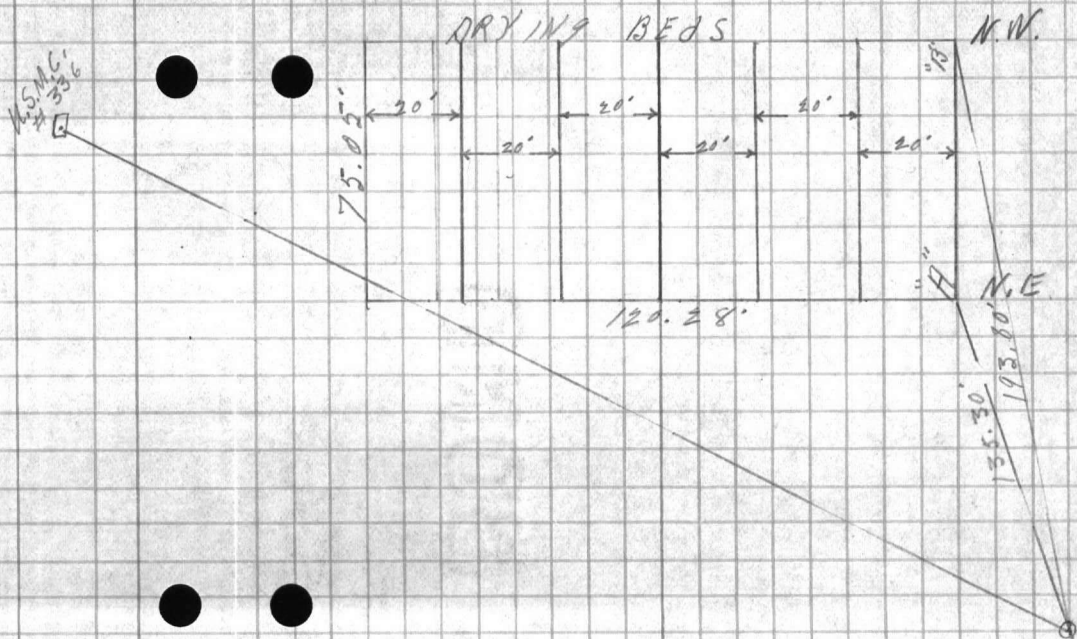

T-ATRZ #1	1-33° 56' 30"
TO CIR'S	2-67° 52' 30"
DRYING BEDS	MEAN- 33° 56' 15"

T-ATRZ	1-17° 10' 30"
H1-TOZ	2-34° 21' 00"
COR. 'H'	MEAN- 17° 16' 30"
DRYING BEDS	

 Plotted By: TDR 4-5-46
 Checked By: J.F.M. 4-19-46










SUBJECT TENT CAMP SEWER PLANT
LOCATION CONTD.

Return To
Public Works
Office
Camp Lejeune
North Carolina

FIELD PARTY
KELLUM In Charge
 _____ Instrument
 _____ Notes
 _____ Tape Read
 _____ Tape or Rod
 _____ Tape or Rod
 _____ Instrument No.
 _____ Tape No.


WEATHER
 Clear _____
 Cloudy _____
 Windy _____
 Rain _____
 Fair _____
 Snow _____
 Hot _____
 Moderate _____
 Cold _____
 Fog _____
 Figured By _____
 Notes Checked By _____
 Plotted By _____

FILE No. _____
 Fldr. No. _____
 Sheet 3-OF-12
 Date 3-27 1946

Quad. No. _____

Station	Dist.	Angle	+	H. I. Bearing	Ver: Ang. Diff.	Elevation
T-ATP.J.#1	1-68° 50' 00"					
TO COR. 'B'	2-137° 40' 00"					
Bldg. #	MCPN-68° 50' 00"					
M-566						
T-ATP.J.#1	1-44° 36' 15"					
TO COR. 'A'	2-89° 13' 00"					
Bldg. #	NDBAN-44° 36' 30"					
M-566						
T-ATP.J.#1	1-87° 55' 00"					
TO COR. 'B'	2-175° 50' 15"					
PRIMARY TANK MEAN	57° 55' 07"					
T-ATP.J.#1	1-33° 37' 00"					
TO COR. 'A'	2-67° 13' 45"					
PRIMARY TANK MEAN	33° 36' 52"					

TO COR. 'A' PRIMARY TANK - 114'
 TO COR. 'B' PRIMARY TANK - 105.75'

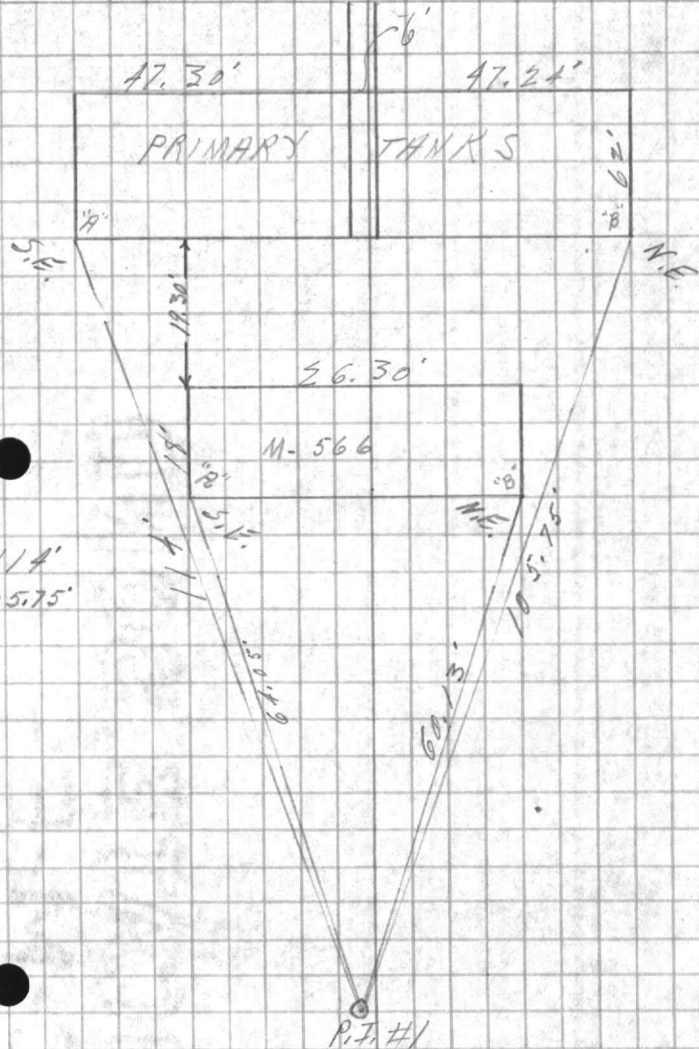

Plotted By: TDR 4-8-46
 Checked By: J.F.M. 4-18-46














SUBJECT SEWER DISPOSAL AT TENT
CAMP CONTD.

Return To
Public Works
Office
Camp Lejeune
North Carolina

FIELD PARTY

KELWIN In Charge
____ Instrument
____ Notes
____ Tape Read
____ Tape or Rod
____ Instrument No.
____ Tape No.

WEATHER

Clear _____
Cloudy _____
Windy _____
Rain _____
Fair _____

Snow _____
Hot _____
Moderate _____
Cold _____
Fog _____

FILE No. _____

Fldr. No. _____

Sheet 1-0F1B

Date 1-1 1946

Figured By _____
Notes Checked By _____
Plotted By _____

Quad. No. _____

Station	Dist.	Angle	+	H. I. Bearing	Ver: Ang. Diff.	Elevation
---------	-------	-------	---	---------------	-----------------	-----------

TO COR. 'E'
1- 272° 44' 15"
2- 227° 28' 30"
MEAN- 293° 44' 15"

TO COR. 'D'
1- 277° 16' 30"
2- 194° 33' 00"
MEAN- 272° 16' 30"

TO COR. 'C'
1- 317° 26' 45"
2- 274° 53' 30"
MEAN- 317° 26' 45"


TO COR. 'B'
1- 342° 31' 30"
2- 325° 03' 00"
MEAN- 342° 31' 30"

TO COR. 'A'
1- 292° 22' 15"
2- 224° 44' 30"
MEAN- 293° 22' 15"

36.90 Dia
3.1416) 115.940
94248
21692.0
188496
284240
282744
14960

CIRCUMFERENCE = 115.94'

#567
SEDIMENT TANK

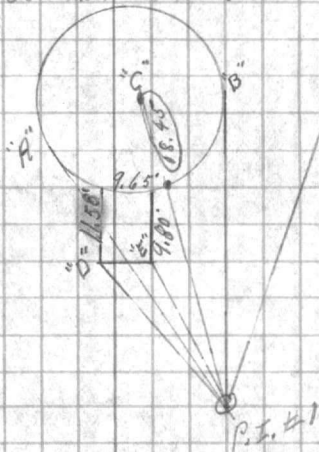

TO COR. 'E' - 17.75'
TO COR. 'D' - 25.06'
TO COR. 'A' - 39.71'
TO COR. 'C' - 25.10'
TO COR. 'B' - 39.01'

Plotted By: T.D.R. 4-8-46
Checked By: J.F.M. 4-18-46


























VALUABLE

SUBJECT SEWER DISPOSAL LOCATION

CONTD.

Return To
Public Works
Office
Camp Lejeune
North Carolina

FIELD PARTY

KEELIN In Charge
____ Instrument
____ Notes
____ Tape Read
____ Tape or Rod
____ Tape or Rod
____ Instrument No.
____ Tape No.

WEATHER

Clear _____
Cloudy _____
Windy _____
Rain _____
Fair _____
Snow _____
Hot _____
Moderate _____
Cold _____
Fog _____
Figured By _____
Notes Checked By _____
Plotted By _____

FILE No. _____


Fldr. No. _____

Sheet 5-01-13

Date 1-1 1946

Quad. No. _____

Station	Dist.	Angle	+	H. I. Bearing	Ver: Ang. Diff.	Elevation
TO FENCE	1-148°	00'15"				
COR. "B"	2-296°	00'30"				
MEAN-	148°	00'15"				
TO COR. "B"	1-138°	18'00"				
M-565	2-276°	36'00"				
MEAN-	138°	18'00"				
TO COR. "A"	1-127°	14'45"				
M-565	2-254°	29'30"				
MEAN-	127°	14'45"				
TO FENCE	1-258°	42'15"				
COR. "A"	2-147°	24'30"				
MEAN-	253°	42'15"				
TO COR. "B"	1-275°	30'00"				
HEATING	2-191°	06'00"				
MEAN-	275°	30'00"				
TO COR. "A"	1-267°	53'20"				
HEATING	2-175°	45'45"				
MEAN-	267°	52'52"				

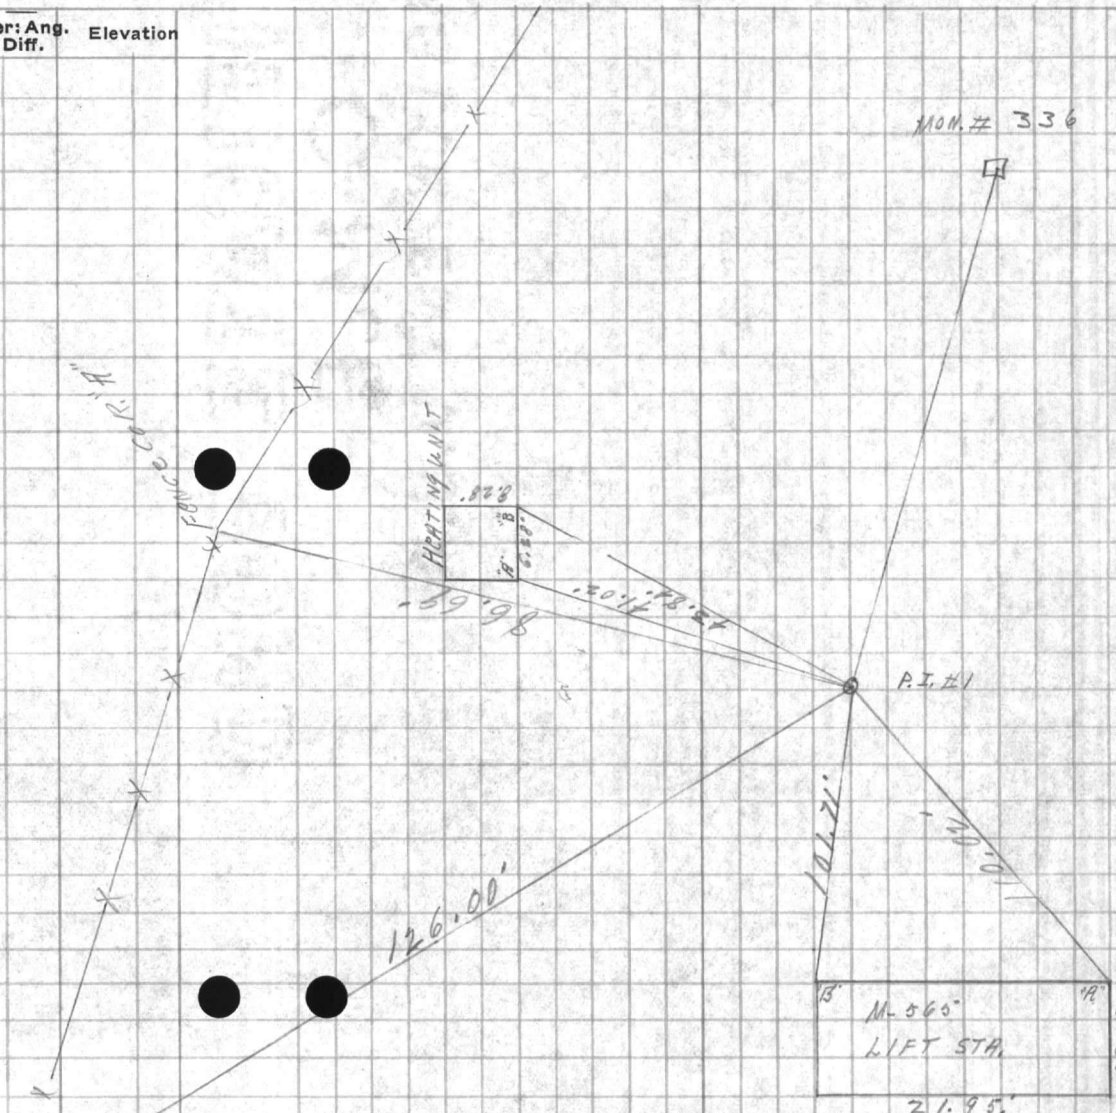

Plotted By: TDR. 4-8-46
Checked By: J.F.M. 4-18-46





























VALUABLE

SUBJECT SEWER DISPOSAL LOCATION
CONTD.

Return To
 Public Works
 Office
 Camp Lejeune
 North Carolina

FIELD PARTY

HELDON In Charge
 _____ Instrument
 _____ Notes
 _____ Tape Read
 _____ Tape or Rod
 _____ Instrument No.
 _____ Tape No.


WEATHER

Clear _____
 Cloudy _____
 Windy _____
 Rain _____
 Fair _____
 Snow _____
 Hot _____
 Moderate _____
 Cold _____
 Fog _____
 Figured By _____
 Notes Checked By _____
 Plotted By _____

FILE No. _____
 Fldr. No. _____
 Sheet 6-01-13
 Date 4-1 1946

Quad. No. _____

Station	Dist.	Angle	+	H. I. Bearing	Ver: Ang. Diff.	Elevation
TO FENCE	1-	106° 32' 00"				
COR. 'C'	2-	213° 04' 00"				
MEAN		106° 32' 00"				
TO FENCE	1-	181° 13' 00"				
COR. 'B'	2-	2° 25' 45"				
MEAN		181° 12' 52"				
TO FENCE	1-	243° 48' 45"				
COR. 'A'	2-	127° 37' 30"				
MEAN		243° 48' 45"				
P.I. #1	1-	103° 49' 15"				
TO P.I. #2	3-	311° 27' 00"				
MEAN		103° 49' 00"				

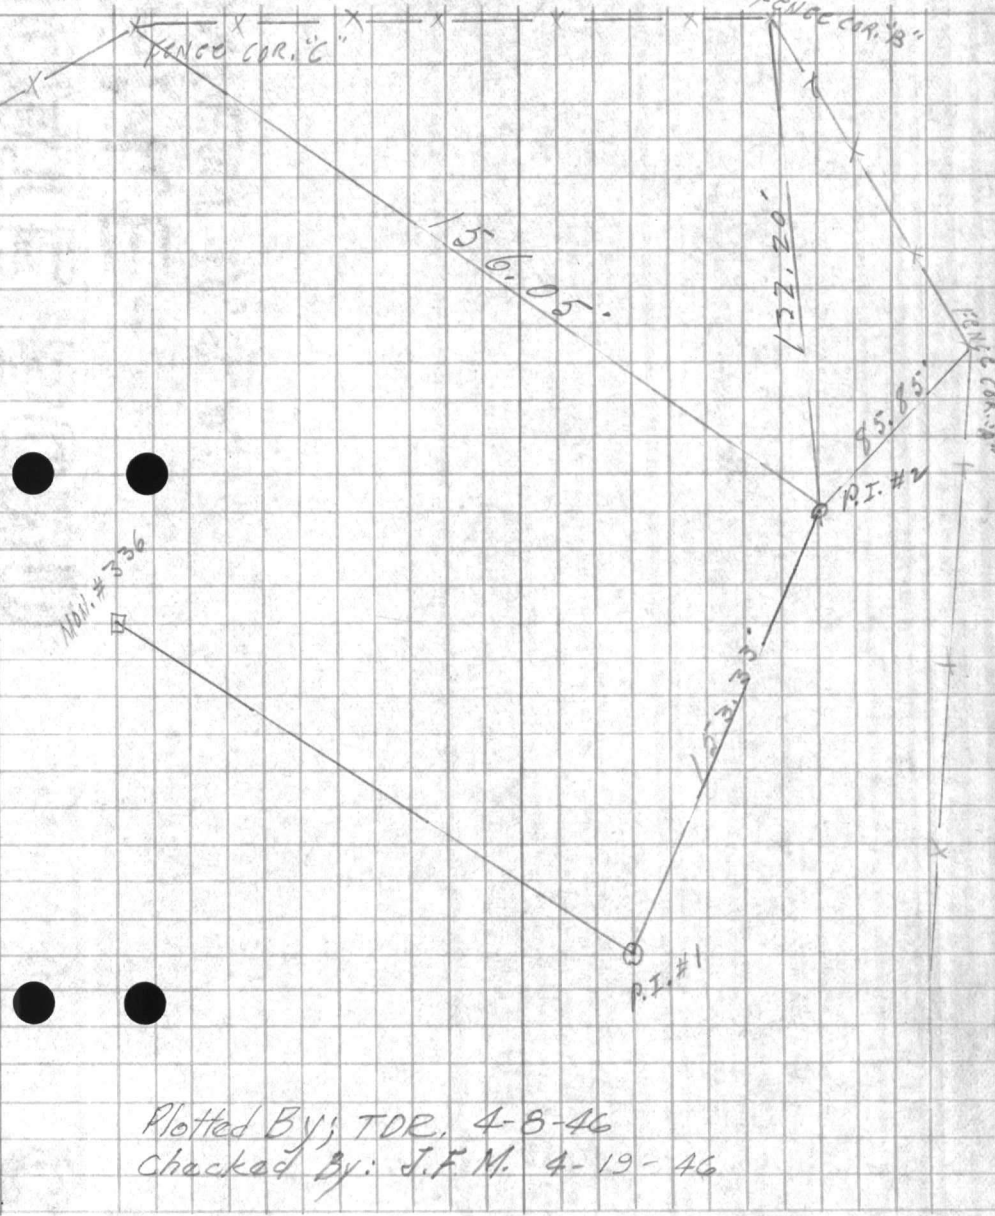

Plotted By: TDR. 4-8-46
 Checked By: J.F.M. 4-19-46



































VALUABLE

SUBJECT SEWER DISPOSAL
LOCATION AT TENT CAMP CONTD.

Return To
 Public Works
 Office
 Camp Lejeune
 North Carolina


FIELD PARTY
KELLUM In Charge
 _____ Instrument
 _____ Notes
 _____ Tape Read
 _____ Tape or Rod
 _____ Tape or Rod
 _____ Instrument No.
 _____ Tape No.

WEATHER
 Clear _____
 Cloudy _____
 Windy _____
 Rain _____
 Fair _____
 Snow _____
 Hot _____
 Moderate _____
 Cold _____
 Fog _____
 Figured By _____
 Notes Checked By _____
 Plotted By _____

FILE No. _____
 Fldr. No. _____
 Sheet 14-05-12
 Date 1-2 1946

Quad. No. _____

Station	Dist.	Angle	"	+	H. I. Bearing	Ver. Ang. Diff.	Elevation
TO FIRE HYD.	1-	158°	30'	30"			
	2-	301°	01'	00"			
	MEAN-	150°	30'	31"			
TO MANHOLE	1-	170°	39'	48"			
	2-	341°	18'	45"			
	MEAN-	170°	39'	22"			
TO CATCH BASIN "C"	1-	158°	10'	30"			
	2-	316°	21'	00"			
	MEAN-	158°	10'	30"			
TO CATCH BASIN "B"	1-	278°	06'	15"			
	2-	196°	12'	30"			
	MEAN-	278°	06'	15"			
TO CATCH BASIN "A"	1-	218°	08'	00"			
	2-	76°	15'	45"			
	MEAN-	218°	07'	52"			

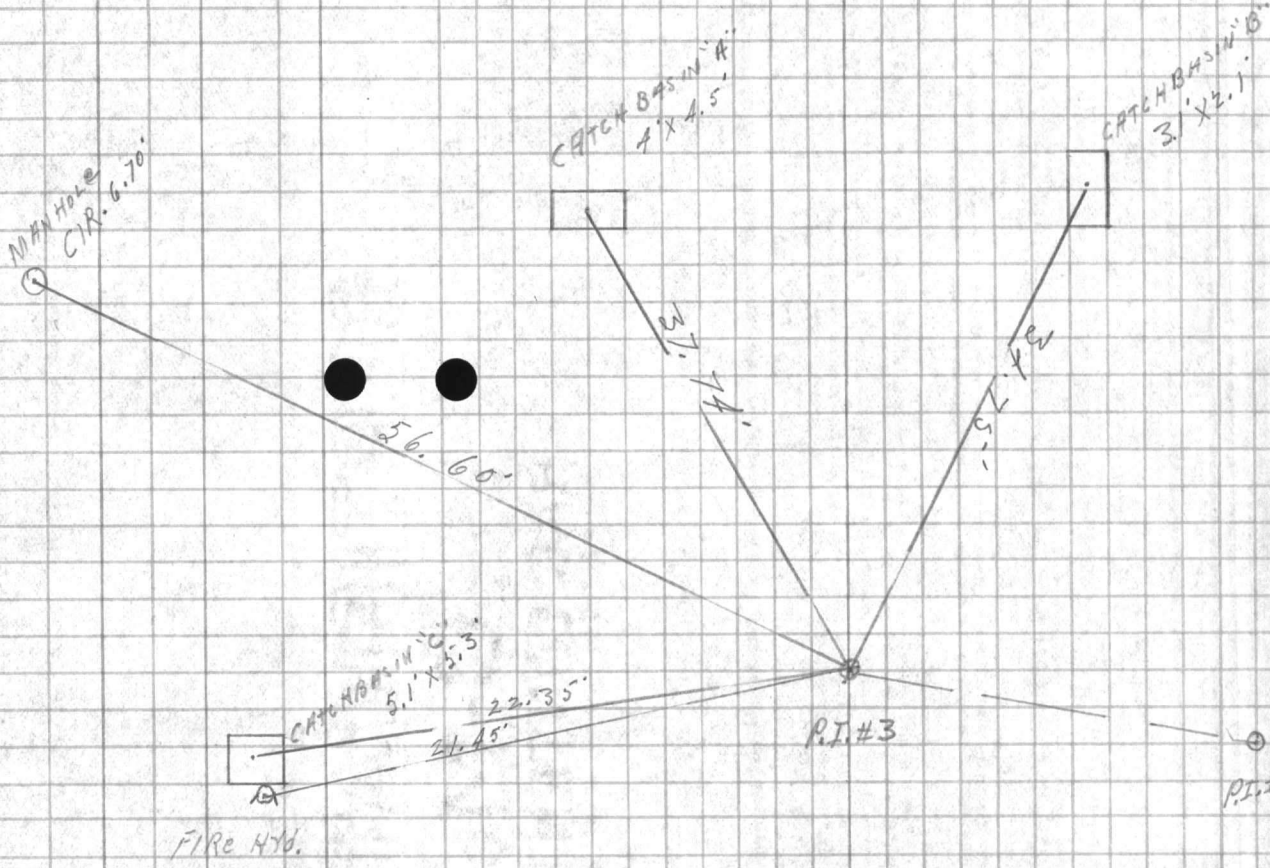



















VALUABLE

SUBJECT SEWER DISPOSAL LOCATION AT
TENT CAMP CONTD.

Return To
Public Works
Office
Camp Lejeune
North Carolina

FIELD PARTY

KELLM In Charge
____ Instrument
____ Notes
____ Tape Read
____ Tape or Rod
____ Tape or Rod
____ Instrument No.
____ Tape No.

WEATHER

Clear
Cloudy
Windy
Rain
Fair

Snow
Hot
Moderate
Cold
Fog

FILE No. _____


Fldr. No. _____

Sheet 12 OF 13

Figured By _____
Notes Checked By _____
Plotted By _____

Date 4-2 1946

Quad. No. _____

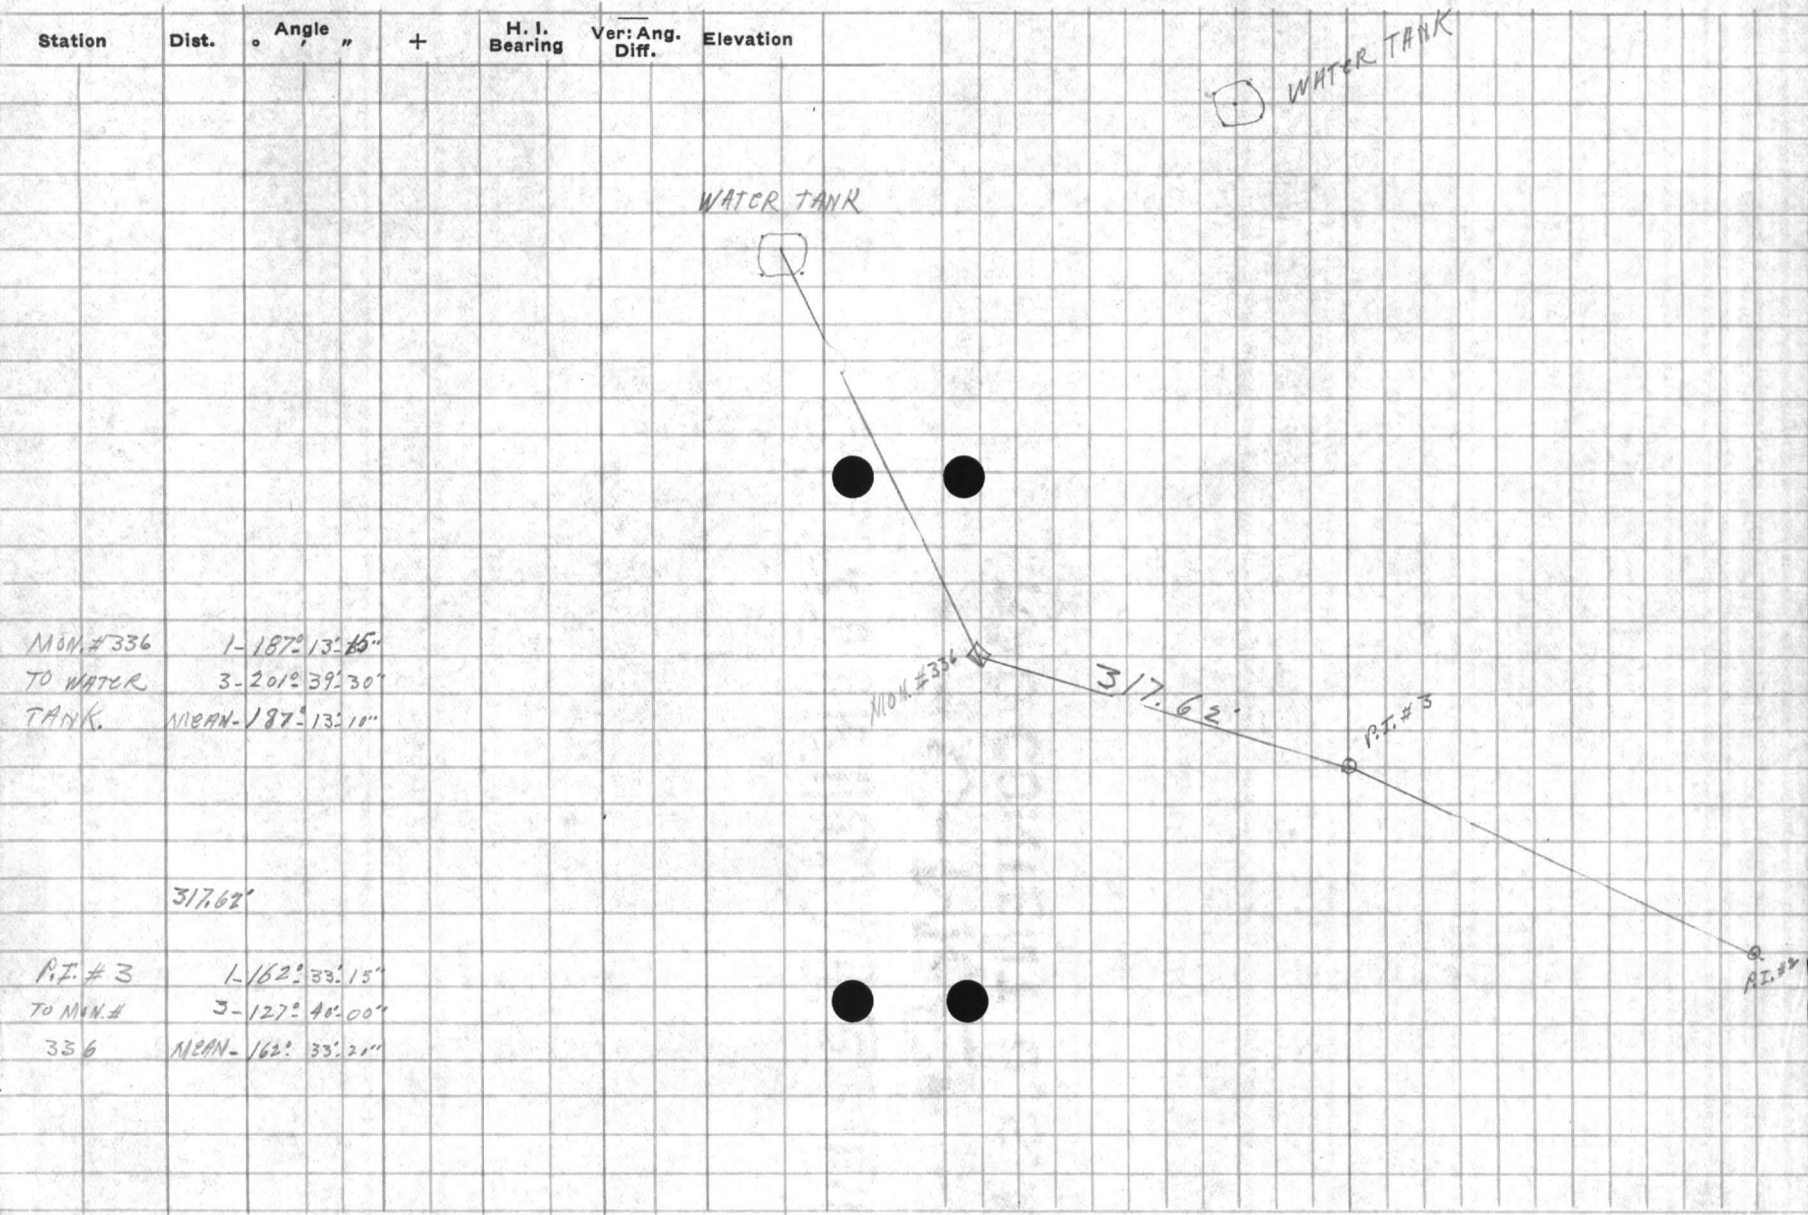



















PUBLIC WORKS DEPARTMENT
Camp Lejeune, North Carolina
Survey Department

1000
712
288

File 98-A
Quadrangle 98
Date 4/2/46
Sheet 41 of 3

Traverse Computation
Description

Bldg. Co-ordinates - Tent Camp Sewage Disposal Field.

Station	Distance	Bearing	Cosine	Sine	Latitude	Departure	Y Coordinate North	X Coordinate East
Mon # 336 from Water Tank	Comp # 2	N 25° 52' E					362,341.58	2,466,827.20
S.E. Corner of Fence	84.30'	N 66° 42' 50" E	3953228	9185422	33.37	77.43	362,374.90	2,466,904.63
S.W. " " "	117.95'	N 13° 58' 15" W	9704187	2414279	114.46	28.48	362,456.04	2,466,798.72
P.I. #1	393.41'	N 43° 06' 10" E	7301291	6833092	287.24	268.82	362,628.82	2,467,096.02
N.E. Cor. Sludge Drying Beds	125.30'	S 60° 16' 40" W	4957955	8684393	67.08	117.50	362,561.74	2,466,978.52
N.W. " " "	193.80'	S 77° 02' 25" W	2242660	9745280	43.46	188.86	362,585.36	2,466,907.16
N.E. " Bldg. M-566	60.13'	N 68° 03' 50" W	3735725	9276010	22.46	55.78	362,651.28	2,467,040.24
S.E. " " " "	64.05'	S 87° 42' 40" W	0399380	9992022	2.56	64.00	362,626.26	2,467,032.02
N.E. " Primary Tanks	105.75'	N 48° 58' 45" W	6563334	7544710	69.41	79.78	362,698.23	2,467,016.24
S.E. " " " "	114.00'	S 76° 43' W	2297666	9732457	26.19	110.95	362,602.63	2,466,985.07
Cor "D" on Tank Addition	25.06'	S 39° 37' 20" E	7702660	6377228	19.30	15.98	362,609.52	2,467,112.00
" "E" " " "	17.75'	S 23° 09' 35" E	919412	3932957	16.32	6.98	362,612.50	2,467,103.00
Center of Sediment Tank #567	43.55'	S 0° 32' 55" W	9999542	0095749	43.54	.42	362,585.27	2,467,095.60
Cor. "A" Lift Sta. Bldg. M-565	110.02'	N 9° 39' 05" W	9858461	1676530	108.46	18.44	362,737.28	2,467,077.58
" "B" " " " "	101.71'	N 1° 24' 10" E	9997003	0244806	101.68	2.49	362,730.50	2,467,098.51
" "A Heating Unit	41.02'	S 49° 01' E	6558358	7547036	26.90	30.97	362,601.92	2,467,126.99
" "B " " "	43.84'	S 41° 23' 50" E	7501431	6612755	32.62	28.75	362,596.20	2,467,124.77
Cor. Fence "A"	86.69'	S 63° 11' 35" E	4509857	8925312	39.09	77.37	362,589.73	2,467,173.39
" " "B"	126.00'	N 11° 06' 25" E	9812693	1926409	123.64	24.27	362,752.46	2,467,120.29
P.I. #2	153.33'	N 33° 04' 50" W	8319040	5458176	128.48	83.69	362,757.30	2,467,012.33
Cor. Fence "A"	85.85'	N 30° 43' 55" E	8595675	5110222	73.99	43.87	362,831.09	2,467,056.20
" " "B"	132.20'	N 31° 52' W	8492490	5279443	112.27	69.79	362,869.57	2,466,942.54
" " "C"	156.05'	S 73° 27' 10" W	2848055	9585853	44.44	149.59	362,712.86	2,466,862.74

Plotted By: T.D.R. 4-8-46

Checked By: J.F.M. 4-19-46



Station	Location	Bearing	Distance	Remarks

1000
827
 173

PUBLIC WORKS DEPARTMENT
Camp Lejeune, North Carolina
Survey Department

File 98-2
Quadrangle 98
Date 4/3/46
Sheet # 2 of 3

Traverse Computation
Description

Bldg. Co-ord. Tent Camp Sewage Disp. Field.

Station	Distance	Bearing	Cosine	Sine	Latitude	Departure	Y Coordinate North	X Coordinate East
<i>Pl. # 2 from Pl. # 1</i>		<i>N33°09'20"W</i>					<i>362,757.30</i>	<i>2,467,012.33</i>
<i>Cor. A Manhole at Chlorination Pit</i>	<i>43.51'</i>	<i>N62°25'40"E</i>	<i>4628663</i>	<i>8869281</i>	<i>20.13</i>	<i>38.57</i>	<i>362,777.43</i>	<i>2,467,050.90</i>
<i>" B " " " "</i>	<i>39.22'</i>	<i>N68°21'10"E</i>	<i>3688907</i>	<i>9294728</i>	<i>14.47</i>	<i>36.45</i>	<i>362,771.77</i>	<i>2,467,048.78</i>
<i>" A Chlorination Pit</i>	<i>36.94'</i>	<i>N72°35'40"E</i>	<i>2991333</i>	<i>9542113</i>	<i>11.05</i>	<i>35.75</i>	<i>362,769.35</i>	<i>2,467,047.58</i>
<i>" B " " " "</i>	<i>31.81'</i>	<i>N89°03'20"E</i>	<i>0164829</i>	<i>9998641</i>	<i>.57</i>	<i>31.90</i>	<i>362,757.82</i>	<i>2,467,044.13</i>
<i>" C " " " "</i>	<i>31.84'</i>	<i>S84°07'50"E</i>	<i>1022620</i>	<i>9947575</i>	<i>3.76</i>	<i>31.67</i>	<i>362,754.64</i>	<i>2,467,044.00</i>
<i>Manhole "A"</i>	<i>68.45'</i>	<i>S10°14'50"E</i>	<i>9840493</i>	<i>1778958</i>	<i>67.36</i>	<i>17.18</i>	<i>362,689.94</i>	<i>2,467,024.51</i>
<i>Manhole "B"</i>	<i>78.87'</i>	<i>S6°23'20"E</i>	<i>9937895</i>	<i>1112762</i>	<i>78.38</i>	<i>9.78</i>	<i>362,678.92</i>	<i>2,467,021.11</i>
<i>Manhole "C"</i>	<i>19.28'</i>	<i>S56°12'40"W</i>	<i>5561345</i>	<i>8300923</i>	<i>10.77</i>	<i>16.00</i>	<i>362,746.58</i>	<i>2,466,996.33</i>
<i>Manhole "D"</i>	<i>68.08'</i>	<i>S71°19'W</i>	<i>3203374</i>	<i>9473035</i>	<i>71.81</i>	<i>64.49</i>	<i>362,735.49</i>	<i>2,466,947.94</i>
<i>Manhole "E"</i>	<i>117.65'</i>	<i>S73°51'50"W</i>	<i>2789201</i>	<i>9606042</i>	<i>37.81</i>	<i>113.01</i>	<i>362,724.49</i>	<i>2,466,899.32</i>
<i>Manhole "F"</i>	<i>84.34'</i>	<i>S56°32'40"W</i>	<i>5512900</i>	<i>8343137</i>	<i>46.49</i>	<i>70.37</i>	<i>362,710.81</i>	<i>2,466,941.96</i>
<i>Manhole "G"</i>	<i>88.02'</i>	<i>S65°10'40"W</i>	<i>4198041</i>	<i>9076147</i>	<i>36.95</i>	<i>79.89</i>	<i>362,720.35</i>	<i>2,466,932.44</i>
<i>Pl. # 3</i>	<i>142.04'</i>	<i>S36°05'W</i>	<i>8081612</i>	<i>5889613</i>	<i>114.79</i>	<i>83.66</i>	<i>362,642.51</i>	<i>2,466,928.57</i>
<i>Cor. "A" Pit</i>	<i>26.59'</i>	<i>N7°11'45"W</i>	<i>9921238</i>	<i>1252611</i>	<i>76.38</i>	<i>3.33</i>	<i>362,668.89</i>	<i>2,466,925.24</i>
<i>" "B" " "</i>	<i>24.62'</i>	<i>N4°30'E</i>	<i>9969193</i>	<i>0784591</i>	<i>74.54</i>	<i>1.93</i>	<i>362,667.05</i>	<i>2,466,930.50</i>
<i>Manhole "A"</i>	<i>12.70'</i>	<i>S61°37'W</i>	<i>4953683</i>	<i>8797869</i>	<i>6.04</i>	<i>11.17</i>	<i>362,636.47</i>	<i>2,466,917.40</i>
<i>Cor. "A" Primary Tank</i>	<i>21.79'</i>	<i>S62°53'40"W</i>	<i>4556312</i>	<i>8901686</i>	<i>9.93</i>	<i>19.40</i>	<i>362,632.58</i>	<i>2,466,909.17</i>
<i>" "B" " "</i>	<i>71.40'</i>	<i>N5°45'45"E</i>	<i>9949466</i>	<i>1004051</i>	<i>71.04</i>	<i>7.17</i>	<i>362,713.55</i>	<i>2,466,935.74</i>
<i>" "A" Bldg # 563</i>	<i>38.84'</i>	<i>N89°35'W</i>	<i>0072721</i>	<i>9999736</i>	<i>.78</i>	<i>38.84</i>	<i>362,642.79</i>	<i>2,466,889.73</i>
<i>" "B" " "</i>	<i>38.07'</i>	<i>N58°08'30"W</i>	<i>5278208</i>	<i>8493557</i>	<i>20.09</i>	<i>37.33</i>	<i>362,662.60</i>	<i>2,466,928.55</i>

Plotted By: TDR 4-8-46
Checked By: J.F.M. 4-19-46

846.24

