
FIELD PARTY WEATHER FILE No. 98-R SANDEFUNN CHARGE CLEAR SNOW SUBJECT TEA. CABLE From CLOUDY Нот VALUABLE Cro/6 INSTRUMENT WINDY MODERATE Comp Gieger to Monford S - NOTES FLDR. No ._ RAIN COLD FAIR Fog KatchiaTAPE READ RETURN TO SHEET OF FIGURED BY__ Sanda TAPE OR ROD PUBLIC WORKS NOTES CHECKED BY OFFICE TAPE OR ROD DATE PLOTTED BY_ CAMP LEJEUNE STRUMENT NO._ NORTH CAROLINA Quad. No. TAPE NO ._ ANGLE VER: ANG. STATION DIST. ELEVATION BEARING DIFF. F.S. on 14+73.34 177 45 00 11) 177 4500 (M) 7100 173 1500 (3) 181 16 30(1) 1811630M P.1. 6+00 5182 1498. 3+90 4 strand 1/0 Wir 3+47. 1 +90 0+82 X= Location of existing 51 Tal. coble 0,000, NOTE: An offset line was run 10' F. Pole #122 South of the Proposed & for " construction Purposes

| RETURN TO PUBLIC WORI OFFICE CAMP LEJEUI | PUBLIC WORKS | | | | F. F.a. | on of Pf | FIELD PARTY WEATHER CLEAR SNOW FILE No. IN CHARGE CLOUDY HOT WINDY MODERATE RAIN COLD FAIR FOG TAPE READ FIGURED BY SHEET TAPE OR ROD TAPE OR ROD STRUMENT NO. Quad. No. | FLDR. NO | | | | |
|---|-----------------|--|----------|-------------------|---|-------------|--|----------|--|--|--|--|
| STATION | DIST. | ANGLE " | + | H. I. BEARING | VER: ANG. | ELEVATION | | | | | | |
| | | | | | | | | | | | | |
| | is an agents | | | | | 1000 | | | | | | |
| | | | | | | | | | | | | |
| | | | | 12 (8 (40) | 165 | | | | | | | |
| | | | | | | | | | | | | |
| | 100 | | | | | | Proposed = 30 A | | | | | |
| | | | | 1 | | | 770/0-1 | | | | | |
| | | | | | | | | | | | | |
| | | | | | | | 66. | | | | | |
| | | | | | | | | | | | | |
| 15-179.34 | History | | | | | | | | | | | |
| | | | erro est | | | | 1 2 2 | | | | | |
| | 40. | | | | | | POKE 4725 | | | | | |
| | | | | | | | \$ 126 2000 | | | | | |
| | | | | | | | 6 14423.34 | | | | | |
| 19473.34 | | | | | | | 7 200.00 | | | | | |
| | | | | | | | 100 | | | | | |
| | | | | | - 15 p. 0 | | Warek | 18 | | | | |
| | | | | | | | | 12 | | | | |
| | | | | | | | 20.00 | | | | | |
| | | 1 (2) (1) (1) (1) (1) (1) (1) (1) (1) (1) (1 | | | | | EDGE STER NEW RIVER | | | | | |
| | | | | | 1 | | NEW NEW | - | | | | |
| | 1 | | | | | | 3 M | 18 | | | | |
| | | | | | | | 1000 | - | | | | |
| | | | | | | | 100 | | | | | |
| | | | | Principal Control | | | 1/2 | | | | | |
| | | | | | - | | | 1. | | | | |
| | | | | | | | A CONTRACTOR OF THE CONTRACTOR | 14 | | | | |
| | | | | | | | | - | | | | |
| | | | | P | | | | | | | | |
| | L | | | | | | | | | | | |


| VALUABLE SUBJECT Tel. Cable-Comp Greger To Monford Point Public Works OFFICE CAMP LEJEUNE NORTH CAROLINA | | | | | | | NOT TAPE | HARGE RUMENT ES E READ E OR ROD E OR ROD | CLEAR CLOUDY WINDY RAIN FAIR NOTES | H M C | NOW OT IODERAT OLD OG ED BY ED BY | E F | FILE No. FLDR. NO. SHEET DATE 19 | | | | | |
|--|-------|---------|---------|------------------|--------------------|----------|----------|--|---|-------------|-----------------------------------|-------|--------------------------------------|-----|-----|------|---|-----|
| STATION | DIST. | ANGLE " | + | H. I. BEARING | VER: ANG. DIFF. | ELEVATIO | N | | 2 1 10 to 1 | | | | | | | | | |
| #10 7 | 91 | 7200- | F.S. | 00 191 | 73.74 | w 3 | | | | | | | | 81- | | | | 369 |
| #10 | 110 | | | 100 | | 0 | 0 | Ť | | #4 9 | | | | | | | | 31 |
| a se s e se s | 1000 | | | | | | | | Water | | | | | | | | | |
| | | | | | | -6 | 0 | 4 | | | | | | | | | | |
| | | | | | | 0 | | | Much | | | - 19- | | | | | | |
| | | | | | 7 | -9. | | | Hard b. | 11 | | | | | | | 1 | |
| | | | | | 9-1 | | | | 11010 0 | erron | | | | | | | | |
| # 11 | 45' | | | LAZINET | | 0 | 0 | | | | | | | | | | | |
| | | | | | | | | | Wester | | | | | | | | | |
| | | -20 80 | | | | -1.8 | 3 | • | | | | | | | | | | 1 |
| | | | | | | | | | Muck | | | | | | | | | |
| | | | | | | - 7. | 0 | | | | | -121 | | | | 18:1 | | |
| 2/2 | | 50 5 | | | | | | | - 1 | / | | | | | | | | |
| 12 | 15 | | | | | 0 | 0 | | Foge wa | ter | | | | | | | | |
| | | | | | | -25. | | | 170016 | | | | | | | | | 1 |
| | | | | | | - | | | Soud | | | | | | | | | |
| 6+00 | | | | | | 00 | , | | | 1 | | | | | | | | |
| 4 2 1 | | | | | | | | | Much grown | | | | | | | | | |
| | | | | | | -7. | 3 | | | | | | 4 | | 1.1 | | + | |
| | | | 100 | 23-4 | | | | | | 10 | | | | | | | | |
| 5100 | | | | | | 0 | 0 | Tales. | Top grow | nd | | | -1- | | | | | |
| | | | | | | -5- | 0 | | Muck | | | | | | | | | |
| | | | | 750 | | -5 | 0 | 9 | | | | | - | | | | | |
| 4100 | | | | | | 0 | 0 | | | | | | | | | | | |
| | | | | | | | | | Much | | | | | | | | | |
| | | | | | | -5, | 0 | | | Oxe, | | | | | | | | |
| | | | | | | | | | | 4 | | | | | | | | |
| | | | ma I at | | 1 . 1 . | 42 | | | | | | | | | | | | |

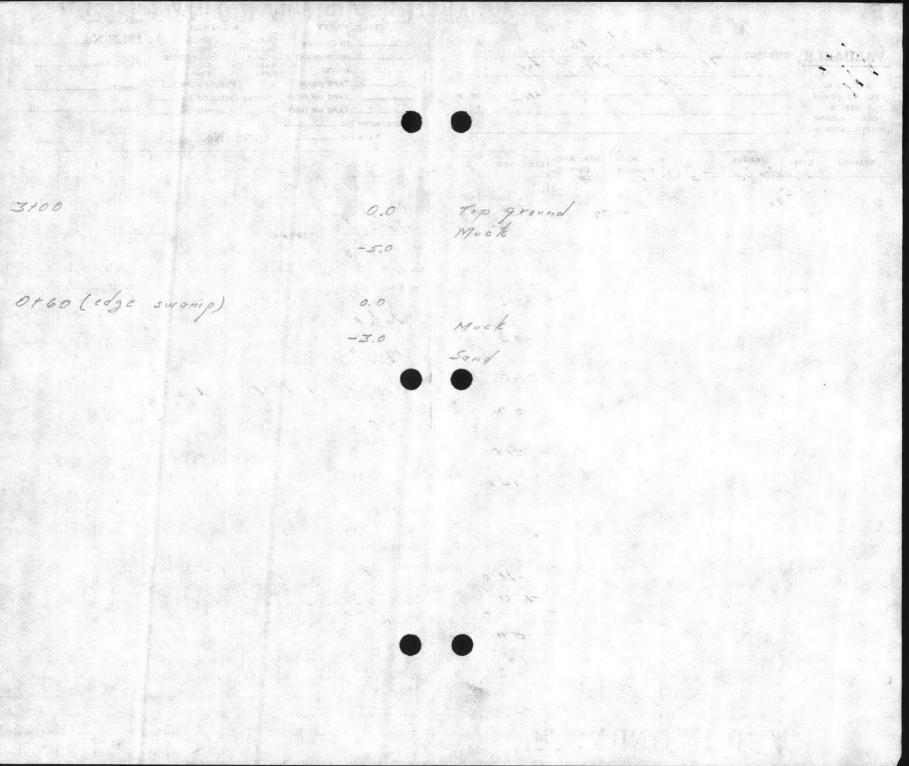

FIELD PARTY WEATHER FILE No .. CLEAR SNOW IN CHARGE SUBJECT Tel. Ca CLOUDY Нот VALUABLE INSTRUMENT WINDY MODERATE FLDR. No .. RAIN COLD Greger NOTES FAIR Fog RETURN TO TAPE READ FIGURED BY_ SHEET_ PUBLIC WORKS TAPE OR ROD NOTES CHECKED BY ings ocross New Pres OFFICE TAPE OR ROD PLOTTED BY_ DATE CAMP LEJEUNE TRUMENT NO ... NORTH CAROLINA Quad. No TAPE NO ._ ANGLE VER: ANG. STATION DIST. ELEVATION BEARING DIFF. of water J. 00 cope wate Sand 750 00 Water -13 # 3 00 700 Woter -21 620 0 0 Worlsk -4.0 Music -130 Hard bottom 560 -5.0 Muck -11.0 PYSR Hard battom

