

VALUABLE

SUBJECT Stake out Well House
@ Montford Point

Noy

RETURN TO
PUBLIC WORKS
OFFICE
CAMP LEJEUNE
NORTH CAROLINA


FIELD PARTY
Cault IN CHARGE
INSTRUMENT
NOTES
TAPE READ
TAPE OR ROD
TAPE OR ROD
INSTRUMENT NO.
TAPE NO.

WEATHER
CLEAR CLOUDY
WINDY
RAIN
FAIR
SNOW
HOT
MODERATE
COLD
FOG

FILE No. 98-T
FLDR. No. _____
FIGURED BY _____ SHEET 1 of
NOTES CHECKED BY _____
PLOTTED BY _____ DATE 7-6 1953

Quad. No. _____

STATION	DIST.	ANGLE ° ' "	+	H. I. BEARING	VER: ANG. DIFF.	ELEVATION
---------	-------	----------------	---	------------------	--------------------	-----------

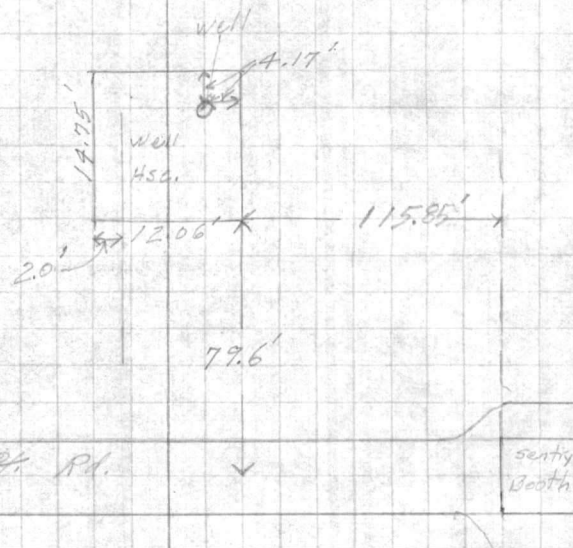














VALUABLE

SUBJECT Profile on water line
Former well near pt. 5'
Beach level

RETURN TO
 PUBLIC WORKS
 OFFICE
 CAMP LEJEUNE
 NORTH CAROLINA

FIELD PARTY

Carl IN CHARGE
 _____ INSTRUMENT
 _____ NOTES
 _____ TAPE READ
 _____ TAPE OR ROD
 _____ TAPE OR ROD
 _____ INSTRUMENT NO.
 _____ TAPE NO.

WEATHER

CLEAR
 CLOUDY
 WINDY
 RAIN
 FAIR

SNOW
 HOT
 MODERATE
 COLD
 FOG

FIGURED BY _____
 NOTES CHECKED BY _____
 PLOTTED BY _____

FILE No. 98-T

FLDR. No. _____

SHEET 104


DATE 2-15-53

Quad. No. _____

STATION	DIST.	ANGLE ° ' "	+	H. I. BEARING	VER: ANG. DIFF.	ELEVATION
BM Mon 406			6.15 5.15			19.99
				26.14 25.14		
0+00 New well					7.70	18.14
						17.39
1+00					7.75	19.39
						16.84
2+00					8.30	17.84
						16.74
3+00					8.40	17.74
						16.69
4+00					8.45	17.69
						16.79
5+00					8.35	17.79
6+98						17.59
					7.55	18.59
7+25 cross						21.61
BM TP			3.51	25.12 26.12	3.53	22.61
BM Mon 406					5.12	20.00 (19.99)

Big New const.

Power Pole Near
 Sentry Booth

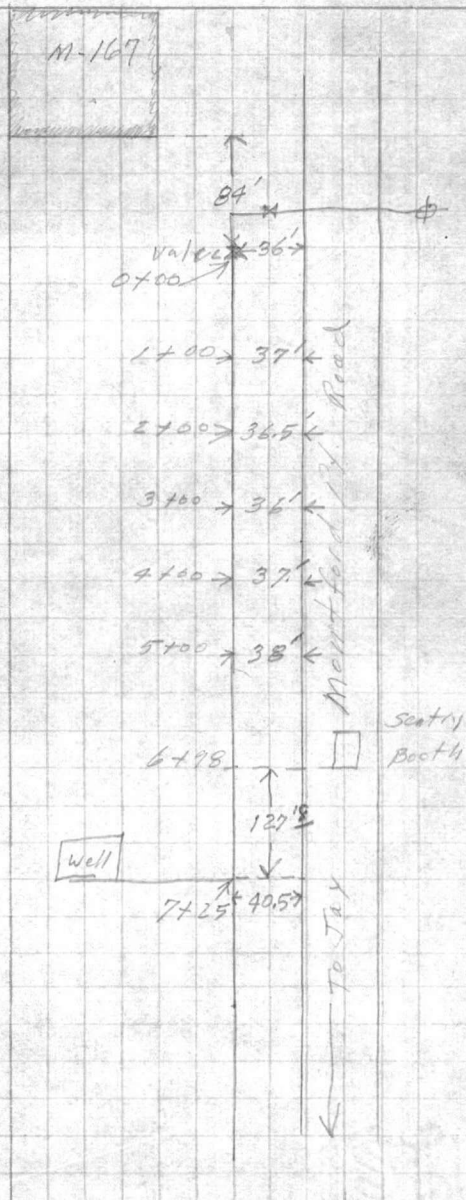






















VALUABLE

Return To
Public Works
Office
Camp Lejeune
North Carolina

SUBJECT

*Location and stamcut
of proposed 10" C.I. line
to proposed Well house.*

FIELD PARTY

Murphy In Charge
Instrument _____
Notes _____
Tape Read _____
Tape or Rod _____
Tape or Rod _____
Instrument No. _____
Tape No. _____

WEATHER

Clear _____
Cloudy _____
Windy _____
Rain _____
Fair _____
Snow _____
Hot _____
Moderate _____
Cold _____
Fog _____

FILE No. *98 T*

Fldr. No. _____

Sheet *1 of 8*


Date *5 March 1953*

Figured By _____

Notes Checked By _____

Plotted By _____

Quad. No. _____

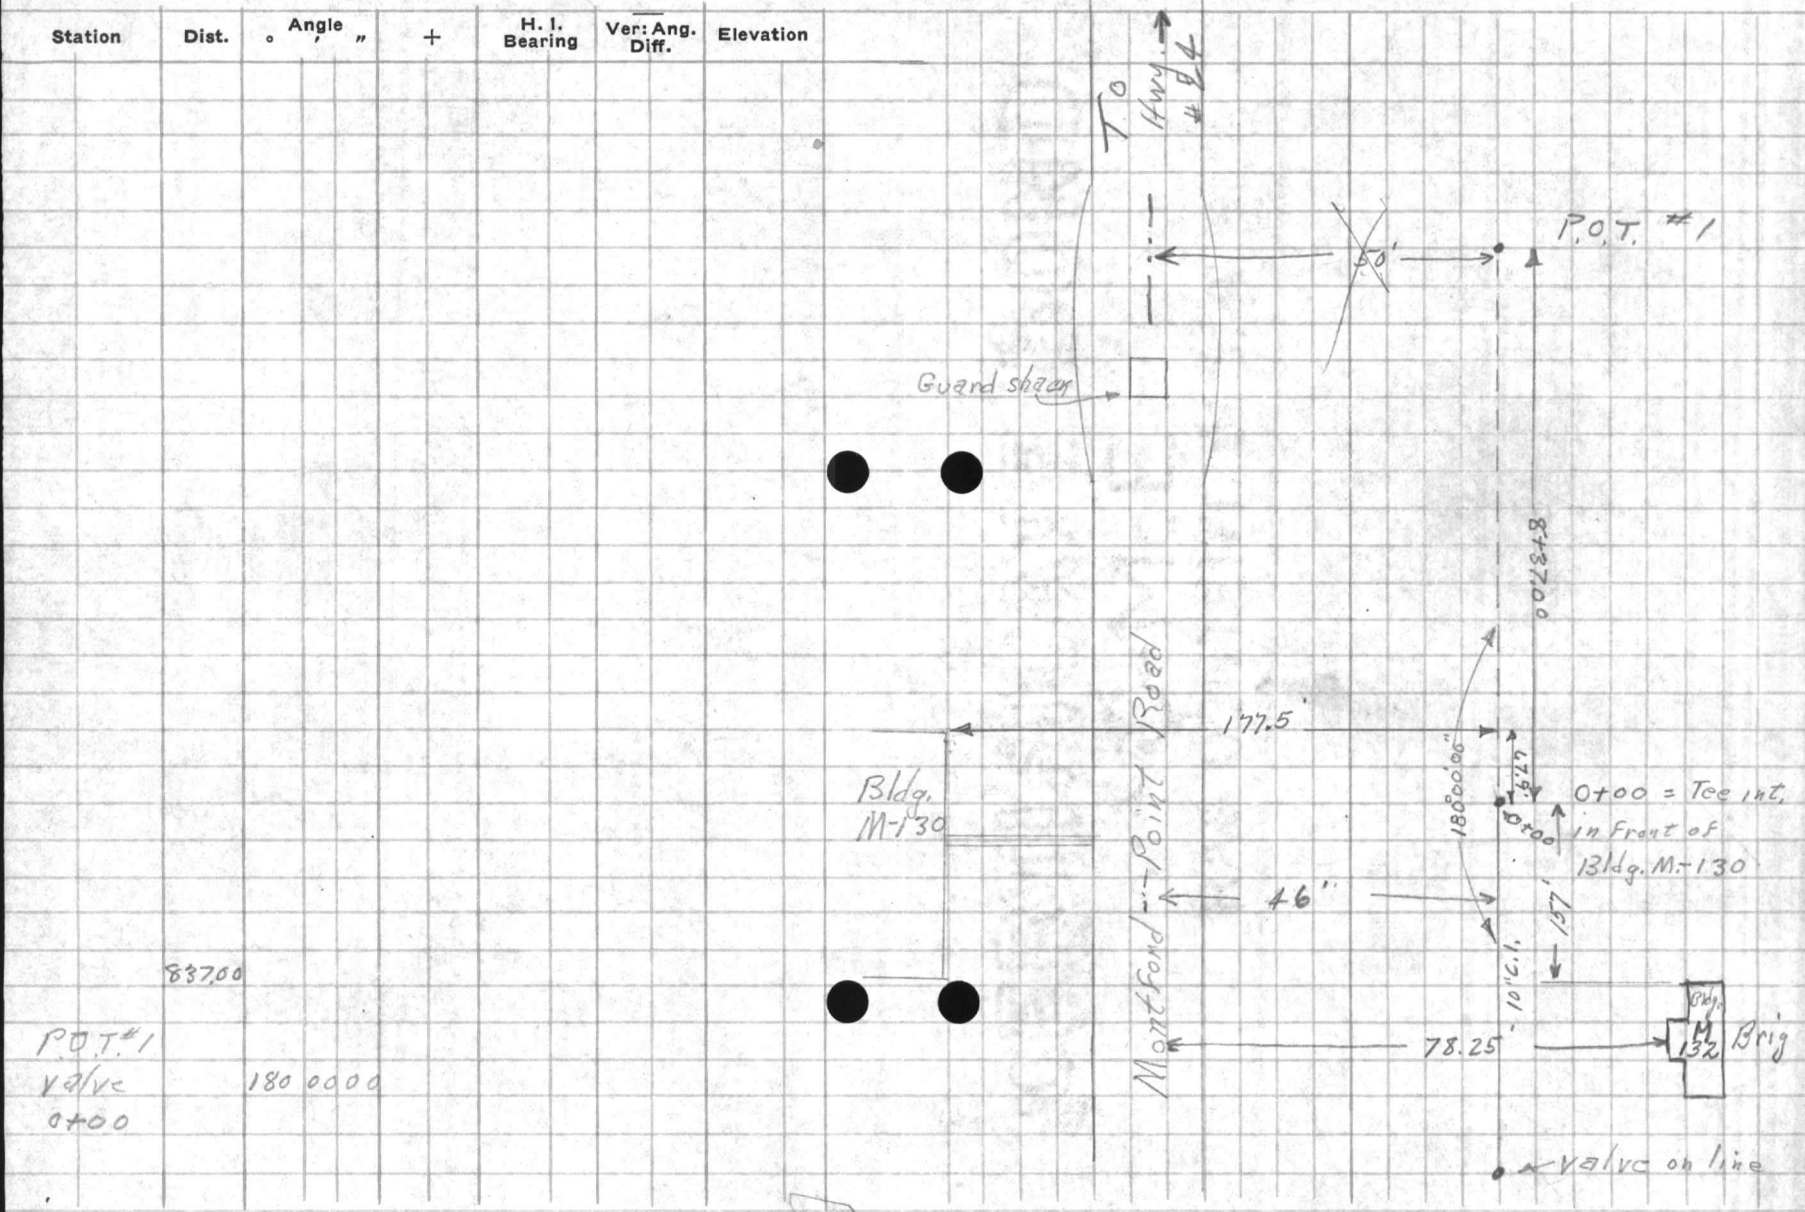












VALUABLE

SUBJECT Profile on proposed 10" C.I.
line - Montford PointReturn To
Public Works
Office
Camp Lejeune
North Carolina

FIELD PARTY

Murphy In Charge
 _____ Instrument
 _____ Notes
 _____ Tape Read
 _____ Tape or Rod
 _____ Instrument No.
 _____ Tape No.

WEATHER

Clear
 Cloudy
 Windy
 Rain
 Fair

Snow
 Hot
 Moderate
 Cold
 Fog

FILE No. _____

Fldr. No. _____

Sheet 2 of 5Date 5 March 1957

Figured By _____

Notes Checked By _____

Plotted By _____

Quad. No. _____

Station	Dist.	Angle " "	+	H. I. Bearing	Ver: Ang. Diff.	Elevation	
13 M						19.99	Mon # 106
			521	25.20			Top 10" water = 15.9
0+00					4.0	21.2	
0+00					5.8	19.4	19' Rt. ditch
0+00					4.0	21.2	2.5' Rt. conc elec conduit ground.
0+00					6.0	19.2	" " " " " - top of conduit
+2.5					4.1	21.1	conc elec. conduit-ground
+2.5					6.1	19.1	" " " " " - top of conduit
+13					4.2	21.0	8' left conc elec conduit-ground
+13					6.2	19.0	" " " " " top of conduit
+14					4.2	21.0	8.5' left-power pole - 8.5' Rt. 10" pine
+50					4.4	20.8	
+97					4.8	20.4	bank
1700					5.2	20.2	ditch - Rt. angle
+02					4.8	20.4	bank
+34					4.4	20.6	

VALIABLE

Return to
Rifle Works
Office
Camp Lejeune
North Carolina




























REPRODUCED FROM
NATIONAL ARCHIVES

VALUABLE

SUBJECT _____

Return To
 Public Works
 Office
 Camp Lejeune
 North Carolina

FIELD PARTY

_____ In Charge
 _____ Instrument
 _____ Notes
 _____ Tape Read
 _____ Tape or Rod
 _____ Instrument No.
 _____ Tape No.

WEATHER

Clear
 Cloudy
 Windy
 Rain
 Fair

Snow
 Hot
 Moderate
 Cold
 Fog

FILE No. _____

Fldr. No. _____

Sheet 3 of 5

Figured By _____

Notes Checked By _____

Plotted By _____

Date _____ 19__

Quad. No. _____

Station	Dist.	Angle " "	+	H. I. Bearing	Ver: Ang. Diff.	Elevation	
				25.20	✓		
+69					4.8	20.4	9.3' left-guy wire
+76					4.9	20.3	
+78					5.2	20.0	20' Rt. & 5' marl walk
+83					4.9	20.3	
+88					4.7	20.5	guy wire on ♀
+90					4.7	20.5	9' left-power pole
+93					4.7	20.5	♀ marl walk
2+00					4.8	20.4	
+06					4.8	20.4	20' left ♀ marl walk
+20					4.9	20.3	4' right 10" pine
+23					4.9	20.3	11' right 12" pine
+50					4.9	20.3	
3+00					4.9	20.3	
+34					4.8	20.4	






























VALUABLE

SUBJECT _____

Return To
 Public Works
 Office
 Camp Lejeune
 North Carolina

FIELD PARTY

_____ In Charge
 _____ Instrument
 _____ Notes
 _____ Tape Read
 _____ Tape or Rod
 _____ Tape or Rod
 _____ Instrument No.
 _____ Tape No.

WEATHER

Clear
 Cloudy
 Windy
 Rain
 Fair

Snow
 Hot
 Moderate
 Cold
 Fog

FILE No. _____
 Fldr. No. _____
 Sheet 4055
 Date _____ 19__

Figured By _____
 Notes Checked By _____
 Plotted By _____
 Quad. No. _____

Station	Dist.	Angle ° ' "	+	H. I. Bearing	Ver: Ang. Diff.	Elevation	
				25.20			
3+63					5.2	20.0	9.5' left power pole
4+00					5.5	19.7	
TIP					4.63	20.57	
				4.04	24.61		
4+24					4.9	19.7	9' right - 15' pine
+45					5.5	19.1	12.5' left inv. 18" RCP = 7.10 17.51 - 17' Rt = 2 d. tel = 17.4
+48					7.18	17.43	inv. 18" RCP
+51					5.2	19.4	
5+00					5.0	19.6	
+39					4.9	19.7	11' left power pole
6+00					4.8	19.8	
+50					4.8	19.8	
7+00					4.9	19.7	
+14					5.0	19.6	11' left - power pole


















VALUABLE

SUBJECT _____

Return To
 Public Works
 Office
 Camp Lejeune
 North Carolina

FIELD PARTY

_____ In Charge
 _____ Instrument
 _____ Notes
 _____ Tape Read
 _____ Tape or Rod
 _____ Tape or Rod
 _____ Instrument No.
 _____ Tape No.

WEATHER

Clear
 Cloudy
 Windy
 Rain
 Fair

Snow
 Hot
 Moderate
 Cold
 Fog

FILE No. _____
 Fldr. No. _____
 Sheet 5055
 Date _____ 19____

Figured By _____
 Notes Checked By _____
 Plotted By _____

Quad. No. _____

Station	Dist.	Angle " "	+	H. I. Bearing	Ver: Ang. Diff.	Elevation	
				24.61	✓		
7450					5.1	19.5	
8400					4.7	19.9	
+37.00					4.13	20.48"	end of line -
+37.00					4.5	18.1	22' left - ditch
T.P.					4.04	20.57	
				4.71	25	28	
B.M.					5.29	19.99	19.99 Mon. # 106

AVAILABLE

Return To
Public Works
Office
Camp Lejeune
North Carolina
































































