

VALUABLE

RETURN TO
PUBLIC WORKS
OFFICE
CAMP LEJEUNE
NORTH CAROLINA

SUBJECT Test Borings
COMMUNITY Bldg. Gite
Midway Park

FIELD PARTY

IN CHARGE

INSTRUMENT

NOTES

TAPE READ

TAPE OR ROD

TAPE OR ROD

INSTRUMENT NO.

TAPE NO. _____

WEATHER
CLEAR _____ SNOW _____
CLOUDY _____ HOT _____
WINDY _____ MODERATE _____
RAIN _____ COLD _____
FAIR _____ FOG _____
FIGURED BY _____ SHEET 1 of
NOTES CHECKED BY _____ DATE 4-9 1958
PLOTTED BY _____

FILE No. 100-N
FLDR. No. _____
DATE 4-9 1958

Quad. No. _____

STATION	DIST.	ANGLE ° ' "	+	H. I. BEARING	VER. ANG. DIFF.	ELEVATION
BORING # 1						32.3

NOTE:
All Readings Prefixed
By Minus Sign Means
Below ground level.

GROUND		
TOP SOIL	-1.0	1330-36' WATER TABLE
GREY SAND	90%	0901 AM
YELLOW CLAY	10%	-3.7' WATER TABLE
	-5.8'	
GREY SAND	100%	-7.4'
BLUE SAND.	90%	
CLAY	10%	
	-9.9'	STILL IN BLUE SAND

BORING # 2						32.5
------------	--	--	--	--	--	------

GROUND		
TOP SOIL	-1.7'	
HARD PAN	-2.2'	0930
GREY SAND	90%	-3.8' WATER TABLE
YELLOW CLAY	10%	-3.5' 1330
	-4.5'	
GREY SAND	100%	
	-8.0	
BLUE SAND	90%	
CLAY	10%	
	-10.0'	
STILL IN BLUE SAND,		

VALID

DATE
TIME
PLACE
OFFICE
NAME

MEMBER
 CLEAR
 NO. 1
 NO. 2
VALUABLE

SUBJECT _____

 RETURN TO
 PUBLIC WORKS
 OFFICE
 CAMP LEJEUNE
 NORTH CAROLINA

FIELD PARTY

 IN CHARGE

 INSTRUMENT

 NOTES

 TAPE READ

 TAPE OR ROD

 TAPE OR ROD

 INSTRUMENT NO. _____
 TAPE NO. _____

WEATHER

CLEAR
 CLOUDY
 WINDY
 RAIN
 FAIR
 SNOW
 HOT
 MODERATE
 COLD
 FOG
 FIGURED BY _____
 NOTES CHECKED BY _____
 PLOTTED BY _____

FILE No. _____

FLDR. No. _____

SHEET 20f

DATE _____

19 _____

Quad. No. _____

STATION	DIST.	ANGLE ° ' "	+	H. I. BEARING	VER. ANG. DIFF.	ELEVATION
BORING# 3						32.2

GROUND			
TOP SOIL	-1.3		
HARD PAN	1.8		
GREY SAND	25%	1000 WATER TABLE -4.1 -3.1 1330	
YELLOW CLAY	25%		-5.0
GREY SAND	100%		-10.0'
STILL IN GREY SAND			

BORING# 4						32.9
-----------	--	--	--	--	--	------

GROUND			
TOP SOIL	-0.5		
HARD PAN	-1.5		
GREY SAND	90%	-4.1 WATER TABLE 1000 1330 - 3.4	
YELLOW CLAY	10%		-5.7
GREY SAND			-9.0
BLUE SAND CLAY	90% 10%		-10.0



VALUABLE

SUBJECT _____

 RETURN TO
 PUBLIC WORKS
 OFFICE
 CAMP LEJEUNE
 NORTH CAROLINA

FIELD PARTY

 IN CHARGE

 INSTRUMENT

 NOTES

 TAPE READ

 TAPE OR ROD

 TAPE OR ROD

 INSTRUMENT NO. _____
 TAPE NO. _____

WEATHER

 CLEAR
 CLOUDY
 WINDY
 RAIN
 FAIR
 SNOW
 HOT
 MODERATE
 COLD
 FOG

FILE No. _____
 FLDR. No. _____
 SHEET 3 of
 DATE _____ 19__

FIGURED BY _____
 NOTES CHECKED BY _____
 PLOTTED BY _____
 Quad. No. _____

STATION	DIST.	ANGLE " "	+	H. I. BEARING	VER: ANG. DIFF.	ELEVATION	
BORING # 5						32.4	<p>GROUND TOP SOIL</p> <hr/> <p>- 2.0'</p> <p>GREY SAND 90% - 3.3 WATER 1130 YELLOW CLAY 10% - 3.2 1335</p> <hr/> <p>- 5.3</p> <p>GREY SAND 100% - 10.0</p> <hr/> <p>STILL IN GRAY SAND</p>
BORING # 6						32.2	<p>GROUND</p> <hr/> <p>- 1.7</p> <p>GREY SAND 90% 1300 YELLOW CLAY - 3.0 WATER TABLE</p> <hr/> <p>- 4.7' - 2.7-1400</p> <hr/> <p>GREY SAND</p> <hr/> <p>- 8.8</p> <p>90% 10% 10.0</p> <hr/> <p>BLUE SAND CLAY STILL IN BLUE SAND</p>






VALUABLE

SUBJECT _____

 RETURN TO
 PUBLIC WORKS
 OFFICE
 CAMP LEJEUNE
 NORTH CAROLINA

FIELD PARTY

 IN CHARGE

 INSTRUMENT

 NOTES

 TAPE READ

 TAPE OR ROD

 TAPE OR ROD

 INSTRUMENT NO. _____
 TAPE NO. _____

WEATHER

CLEAR SNOW
 CLOUDY HOT
 WINDY MODERATE
 RAIN COLD
 FAIR FOG
 FIGURED BY _____
 NOTES CHECKED BY _____
 PLOTTED BY _____

FILE No. _____
 FLDR. No. _____
 SHEET 4 of
 DATE _____ 19__

Quad. No. _____

STATION	DIST.	ANGLE ° ' "	+	H. I. BEARING	VER: ANG. DIFF.	ELEVATION
BORING # 7						32.1
BORING # 8						32.2 3

GROUND			
TOP SOIL		-1.0	-2.0: 1400
GREY SAND	90%		1325
YELLOW CLAY	10%		-2.4 WATER
-----		-4.0	
GREY SAND	100%	-8.8'	

BLUE SAND	90%		
CLAY	10%	-10.0	

GROUND			
TOP SOIL		-1.0'	
GREY SAND	90%		
YELLOW CLAY	10%		
-----		-4.5	1340
GREY SAND	100%		-4.7 WATER TABLE
-----		-8.2	-3.4: 1400

BLUE SAND	90%		
CLAY	10%	-10.0	
































VALUABLE

RETURN TO
PUBLIC WORKS
OFFICE
CAMP LEJEUNE
NEW RIVER, N. C.

SUBJECT Water Line Check
Store Bldg. Midway Park.

FIELD PARTY

____ IN CHARGE
____ INSTRUMENT
____ NOTES
____ TAPE READ
____ TAPE OR ROD
____ TAPE OR ROD
____ INSTRUMENT NO.
____ TAPE NO.

WEATHER


CLEAR _____ SNOW _____
CLOUDY _____ HOT _____
WINDY _____ MODERATE _____
RAIN _____ COLD _____
FAIR _____ FOG _____

FIGURED BY _____
NOTES CHECKED BY _____
PLOTTED BY _____ DATE 4/28 1945
Quad. No. 100

FILE No. 100-C
FLDR. No. _____
SHEET #1 of 1
DATE 4/28 1945
Quad. No. 100

STATION	DIST.	ANGLE "	+	H. I.	VER. ANG.	ELEVATION
					DIFF.	

Set points "A" & "B" as shown
in field. Check Offset distance of
Water Line at 90° angle to these points.

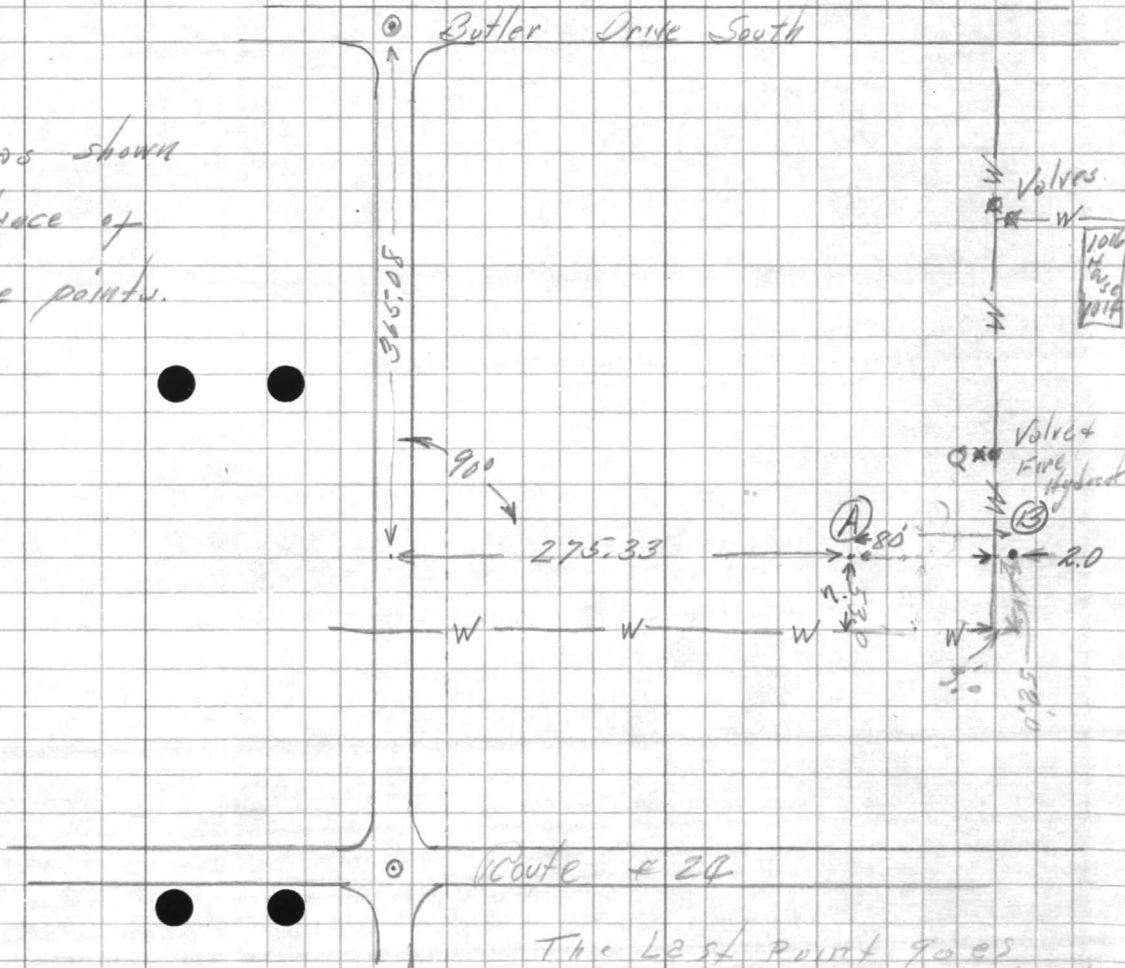

The last point goes
across water line about
2.0








VALUABLE

SUBJECT

Test Boring for
Building Site in Midway Park
Extension

 RETURN TO
PUBLIC WORKS
OFFICE

 CAMP LEJEUNE
NEW RIVER, N. C.

FIELD PARTY

 _____ IN CHARGE
 _____ INSTRUMENT
 _____ NOTES
 _____ TAPE READ
 _____ TAPE OR ROD
 _____ TAPE OR ROD
 _____ INSTRUMENT NO.
 _____ TAPE NO.

WEATHER

 CLEAR SNOW
 CLOUDY HOT
 WINDY MODERATE
 RAIN COLD
 FAIR FOG
 FIGURED BY _____
 CHECKED BY _____
 PLOTTED BY _____
 Quad. No. 100

FILE No. 100 W

FLDR. No. _____

SHEET #1 of 8

DATE 4/1 19 44

Quad. No. 100

STATION	DIST.	ANGLE	+	H. I.	VER. ANG. DIFF.	ELEVATION	
B.M.			5.00	30.52		25.525	
Ground Elevation					4.3	26.2	
Boring # 1 Center of Bldg # 3020 - #3023							
Ground Elevation						26.2	
Top of Sand (Depth of Top Soil)						25.3	
Top of Sand + Clay 50% - 50%				6.1		20.1	
Top of Hard Yellow Clay				8.0		18.2	
							Believed unnecessary to bore deeper Well Drained location Dry Hole
Ground Elevation					4.2	26.3	
Boring # 2 Center of Bldg # 3000 - #3007							
Top of Black Sand						25.7	
" " White Sand + Black Sand Mixed						24.3	Poor Soil Well Drained location Wet Hole
" " White Sand						22.9	
Top of White Clay + Sand 50% - 50%						21.8	
" " " " 90% Clay						21.0	
" " White Sand 10% Clay						17.4	
" " Yellow Clay						16.3	
Bottom of Boring in Yellow Clay						15.5	
							Very Wet
B.M.			3.25	38.67		35.42	
Ground Elevation					5.2	33.5	
Boring # 3 Center of Bldg # 3060 - #3067							
Top of Yellow Sand (Top Soil)						32.8	
" " " " + Clay						31.1	
" " White Sand						28.5	
Bottom of Hole in White Sand						24.1	
							Wet Very Wet

5.0 49






VALUABLE

SUBJECT

Test Boring

Midway Park Extension

RETURN TO
PUBLIC WORKS
OFFICECAMP LEJEUNE
NEW RIVER, N. C.

FIELD PARTY

IN CHARGE _____
 INSTRUMENT _____
 NOTES _____
 TAPE READ _____
 TAPE OR ROD _____
 TAPE OR ROD _____
 INSTRUMENT NO. _____
 TAPE NO. _____

WEATHER

CLEAR _____ SNOW _____
 CLOUDY _____ HOT _____
 WINDY _____ MODERATE _____
 RAIN _____ COLD _____
 FAIR _____ FOG _____

FIGURED BY _____
 NOTES CHECKED BY _____
 PLOTTED BY _____

FILE No. 100

FLDR. No. _____

SHEET # 2 of 8

DATE 4/1 1944

Quad. No. _____

T.P. 5.91
5.28

STATION	DIST.	ANGLE "	+	H. I.	VER. ANG. DIFF.	ELEVATION
---------	-------	---------	---	-------	-----------------	-----------

38.67

Ground Elevation 5.0 33.7

Boring # 4 Center of Bldg # 3050 - 3053

Top of Yellow Sand (Top Soil) 33.0

Top of Yellow Clay & Sand 25% Clay 30.1

Top of Brown Sand 28.7

" " Yellow Sand 26.9

" " " " & Clay 50% - 50% 25.2

Good Drainage - Unnecessary to Bore deeper

Wet

Dry Hole

Ground Elevation 5.8 32.9

Boring # 5 Center of Bldg # 3110 - 3117

Top of Brown Muck (Top Soil) 32.2

Top of Yellow Sand 30.9

Top of White Clay 35% Clay 29.7

Top of White Sand 28.2

Top of Yellow Sand 27.7

Bottom of Boring in Yellow Sand 23.5

Very Wet

Very Wet

Very Wet

Ground Elevation 4.1 34.6

Boring # 6 Center of Bldg # 3130 - 3137

Top of Brown Muck 34.0

Top of Brown Sand 31.7

Top of Brown & White Sand 30.3

Top of Gray Clay 75% Clay 24.6

Well Rotted Vegetable Matter & Sand Dry

Very Wet

Very Wet

T.P. 5.91 32.76


5.28 38.04





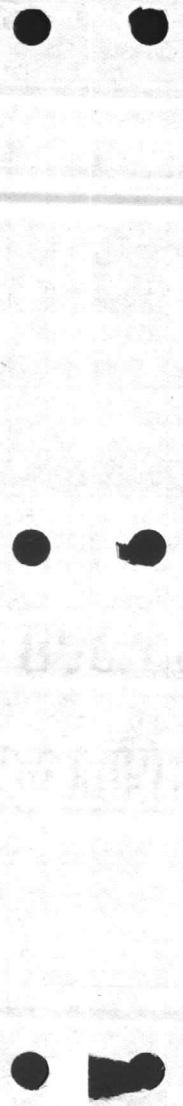

VALUABLE

SUBJECT

Test Borings
Midway Park ExtensionRETURN TO
PUBLIC WORKS
OFFICECAMP LEJEUNE
NEW RIVER, N. C.

FIELD PARTY

IN CHARGE _____
 INSTRUMENT _____
 NOTES _____
 TAPE READ _____
 TAPE OR ROD _____
 TAPE OR ROD _____
 INSTRUMENT No. _____
 TAPE No. _____

WEATHER

CLEAR SNOW
 CLOUDY HOT
 WINDY MODERATE
 RAIN COLD
 FAIR FOG

FIGURED BY _____
 CHECKED BY _____
 PLOTTED BY _____

FILE No. 120

FLDR. No. _____

SHEET # 3 of 8

DATE 4/1 19 44

Quad. No. _____

STATION	DIST.	ANGLE "	+	H. I.	VER. ANG. DIFF.	ELEVATION	
				38.04			
Boring # 7 at Rear E. of Bldg # 3120 - # 3127							
Ground Elevation				5.9		32.1	
Top of White Sand (Top Soil)						31.3	
Top of Clay & Sand 25% Clay						29.3	
Top of Yellow Sand						28.1	Wet
Top of White Sand						16.6	Very Wet
Bottom of Boring in White Sand						15.9	Hole too Wet. Coring in too fast to bore deeper.
B.M.	2.97			56.98		34.01	
Ground Elevation				4.5		32.5	
Boring # 8 at Center of Bldg # 3100 - # 3107							
Top of White Sand						31.7	Wet
Top of Gray Sand						29.0	Very Wet
Top of Sand & Clay 25% Clay						28.5	
Top of White Sand						24.3	Very Wet. Coring in too fast to bore deeper.
Bottom of Boring in White Sand						23.3	
Ground Elevation				5.1		31.9	
Boring # 9 at Center of Bldg # 3080 - # 3087							
Top of Yellow Sand (Top Soil)						31.3	
" " Gray "						28.3	
Bottom of Boring in Sand						25.4	Very Wet Coring in too fast to bore deeper.








VALUABLE

SUBJECT

*Test Borings**Midway Park Extension*RETURN TO
PUBLIC WORKS
OFFICE
CAMP LEJEUNE
NEW RIVER, N. C.

FIELD PARTY

IN CHARGE

INSTRUMENT

NOTES

TAPE READ

TAPE OR ROD

TAPE OR ROD

INSTRUMENT NO.

TAPE NO.

WEATHER

CLEAR SNOW
CLOUDY HOT
WINDY MODERATE
RAIN COLD
FAIR FOG

FIGURED BY _____
NOTES CHECKED BY _____
PLOTTED BY _____

FILE No. *100*

FLDR. No. _____

SHEET *4 of 5*DATE *4/1 19 44*

Quad. No. _____

STATION	DIST.	ANGLE "	+	H. I.	VER: ANG. DIFF.	ELEVATION
---------	-------	---------	---	-------	-----------------	-----------

*36.98**Ground Elevation**4.9**32.1**Top of Brown Sand**31.1**" " " " + Clay 35% Clay**30.1**" " Gray Sand**29.3**" " White "**27.3**" " Yellow "**26.6**Bottom of Boring " Yellow Sand**24.3**Boring # 10 at Center of Bldg # 3090 - 43097**Very Wet**Hole Caving too fast to Bore deeper*

77
132
209
50
159
25
125
40
85
25
60

VALUABLE

SUBJECT

Test Borings

Midway Park Extension

RETURN TO
PUBLIC WORKS
OFFICECAMP LEJEUNE
NEW RIVER, N. C.

FIELD PARTY

Dillon IN CHARGE

INSTRUMENT

NOTES

TAPE READ

TAPE OR ROD

TAPE OR ROD

INSTRUMENT NO.

TAPE NO.

WEATHER

CLEAR SNOW
CLOUDY HOT
WINDY MODERATE
RAIN COLD
FAIR FOG

FIGURED BY

NOTES CHECKED BY

PLOTTED BY

Quad. No.

FILE No. 100

FLDR. No.

SHEET # 5 of 8

DATE 4/4 19 44

STATION	DIST.	ANGLE "	+	H. I.	VER. ANG. DIFF.	ELEVATION
B.M.			4.04	38.08		34.04
Boring #			to Bldg #	3200 -	3207	
Ground Elevation			4.6			33.5
Top of Gray Sand						32.9
Top of Hard Black Pan						32.2
Top of White Sand						30.7
" " "Blue" Sand						28.8
" " Fine White Sand						25.0
Bottom of Boring in White Sand						24.4

25% Sand 15% Clay 60% Earth
Wet

Very Wet

Count # 4 Has a depth of Muck (Rotted Vegetation and Earth) from 1 foot to 3 feet, averaging 1.5' covering the entire Court and including 2 building sites East & West of Court. Believe that sufficient drainage will make this material satisfactory for Court & Bldg. construction

Boring #	Sta. 18 + 38.98	Top of Rd & Courts # 445
Ground Elevation	4.4	33.7
Top of White Sand		31.4
" " " " + Yellow Clay	40% Clay	30.5
" " Yellow Sand		29.4
" " White Sand		27.9
" " " Clay 85% Clay		27.4
" " Blue Clay		26.4
" " Gray Sand		26.2
" " Black Gumbo (Muck)		25.9

Muck

Entire Boring under Water

T.P.

4.50 33.58

4.76 38.34










Check No.

Rebore
*3/30-3/37


VALUABLE

SUBJECT Test Borings

Midway Park Extension

RETURN TO
PUBLIC WORKS
OFFICE
CAMP LEJEUNE
NEW RIVER, N. C.

FIELD PARTY
Dillon IN CHARGE
INSTRUMENT
NOTES
TAPE READ
TAPE OR ROD
TAPE OR ROD
INSTRUMENT No.
TAPE No.

WEATHER
CLEAR SNOW
CLOUDY HOT
WINDY MODERATE
RAIN COLD
FAIR FOG
FILE No. 100
FLDR. No.
SHEET # 6 of 8
NOTES CHECKED BY
PLOTTED BY DATE 4/4 19 44
Quad. No.

STATION	DIST.	ANGLE "	+	H. I.	VER. ANG. DIFF.	ELEVATION
				38.34		
Boring #						
Ground Elevation						31.70 - 31.77
Top of Yellow Sand				6.0		32.3
" " " " + Clay 25% Clay						31.3
" " Yellow Sand						29.9
" " Hard White Clay						28.0
" " White Sand						27.2
						26.3
Boring #	Op. E. of Road					between
Ground Elevation				4.5		33.8
Top of Black Sand						31.8
" " White Sand						30.6
" " Fine White Sand						28.6
" " Black Sand						26.5
Bottom of Boring in Dark Sand						24.2
						Bldgs # 3230 - 3234 and # 3220 + 3224
						Wet
						Very Wet
						Very Hard
						60% Sand + 40% Vegetable Matter.
T.P.				3.78		34.56
				4.23		38.79

VALUABLE
NEW RIVER, N. C.
DEPT. CLERK
OFFICE
PUBLIC WORKS
RECORDS

28.72
1.81
26.93

Added at Sta. 57+0
T.B.M. 25.77

2874
261
2613
611
2224

VALUABLE

SUBJECT

Test Boring

RETURN TO
PUBLIC WORKS
OFFICECAMP LEJEUNE
NEW RIVER, N. C.

Midway Park Extension

FIELD PARTY

Dillon IN CHARGE

INSTRUMENT

NOTES

TAPE READ

TAPE OR ROD

TAPE OR ROD

INSTRUMENT NO.

TAPE NO.

WEATHER

CLEAR

CLOUDY

WINDY

RAIN

FAIR

SNOW

HOT

MODERATE

COLD

FOG

FILE No. 100

FLDR. No.

SHEET #7 of 8

FIGURED BY _____

CHECKED BY _____

PLOTTED BY _____ DATE 4/4 1944

Quad. No.

STATION DIST. ANGLE " + H. I. VER. ANG. ELEVATION
DIFF.

Boring #

Ground Elevation

35.79
On E. of Road & E. of

Courts #6 & #7

4.6 34.2

Top of Black Sand

33.6

Sand & Rotted Vegetation (Earth)

Top of Brown Sand

32.2

Wet

Top of White Sand

30.6

Very Wet

Top of Yellow Sand

29.2

" "

Top of Fine White Sand

28.0

" "

" " Brown sand

26.8

" " Black Sand

26.4

(Sand & Vegetable Matter)

Boring #

Ground Elevation

E. of Bldg. # 3250 32.57

4.7 34.1

Top of White Sand

33.5

Top of Hard Pan

33.2

Very Hard & Dry

Top of White Sand

32.3

Very Wet

Top of Sand & Clay

40% Clay

29.3

Top of White Sand

28.2

Top of Hard White Clay

85% Clay

27.1

Courts # 5 & 6 are O.K. for Grading
Also Court # 7 . 0.7' of Top Soil on Top of0.8' of Top Soil on Top of White Sand.
Black Sand & Earth. Very Wet


38.79
4.21

34.58 34.56


VALUABLE

SUBJECT

Test Borings

Midway Park Extension

RETURN TO
PUBLIC WORKS
OFFICECAMP LEJEUNE
NEW RIVER, N. C.

FIELD PARTY

Dillon IN CHARGE

INSTRUMENT

NOTES

TAPE READ

TAPE OR ROD

TAPE OR ROD

INSTRUMENT NO.

TAPE NO.

WEATHER

CLEAR

CLOUDY

WINDY

RAIN

FAIR

SNOW

HOT

MODERATE

COLD

FOG

FILE No. 100

FLDR. No.

SHEET

#8 of 8

DATE

4/4 1944

FIGURED BY

NOTES CHECKED BY

PLOTTED BY

Quad. No.

STATION	DIST.	ANGLE "	+	H. I.	VER. ANG. DIFF.	ELEVATION
---------	-------	---------	---	-------	-----------------	-----------

38.79

Boring # 3280 - # 5287

Boring #
Ground Elevation

5.2 33.6

Top of Black Sand & Earth

33.0

Top of White Sand

29.9

Top of Fine White Sand

27.8

Bottom of Boring in Fine White Sand

25.9

60% Sand Very Wet Entire hole in Water

B.M.

7.21 34.58

(34.56)

Reboring for Bldg # 3130 - # 313.

Ground Elevation same as previous boring

Top of White Sand

-0.8

Tip of Black Wood Pile

-1.0


" " Crown Sand


-2.2

100 # 400

RETURN TO
PUBLIC WORKS
OFFICE
CAMP BARRON
SAN DIEGO, CALIF.

Cont. No.

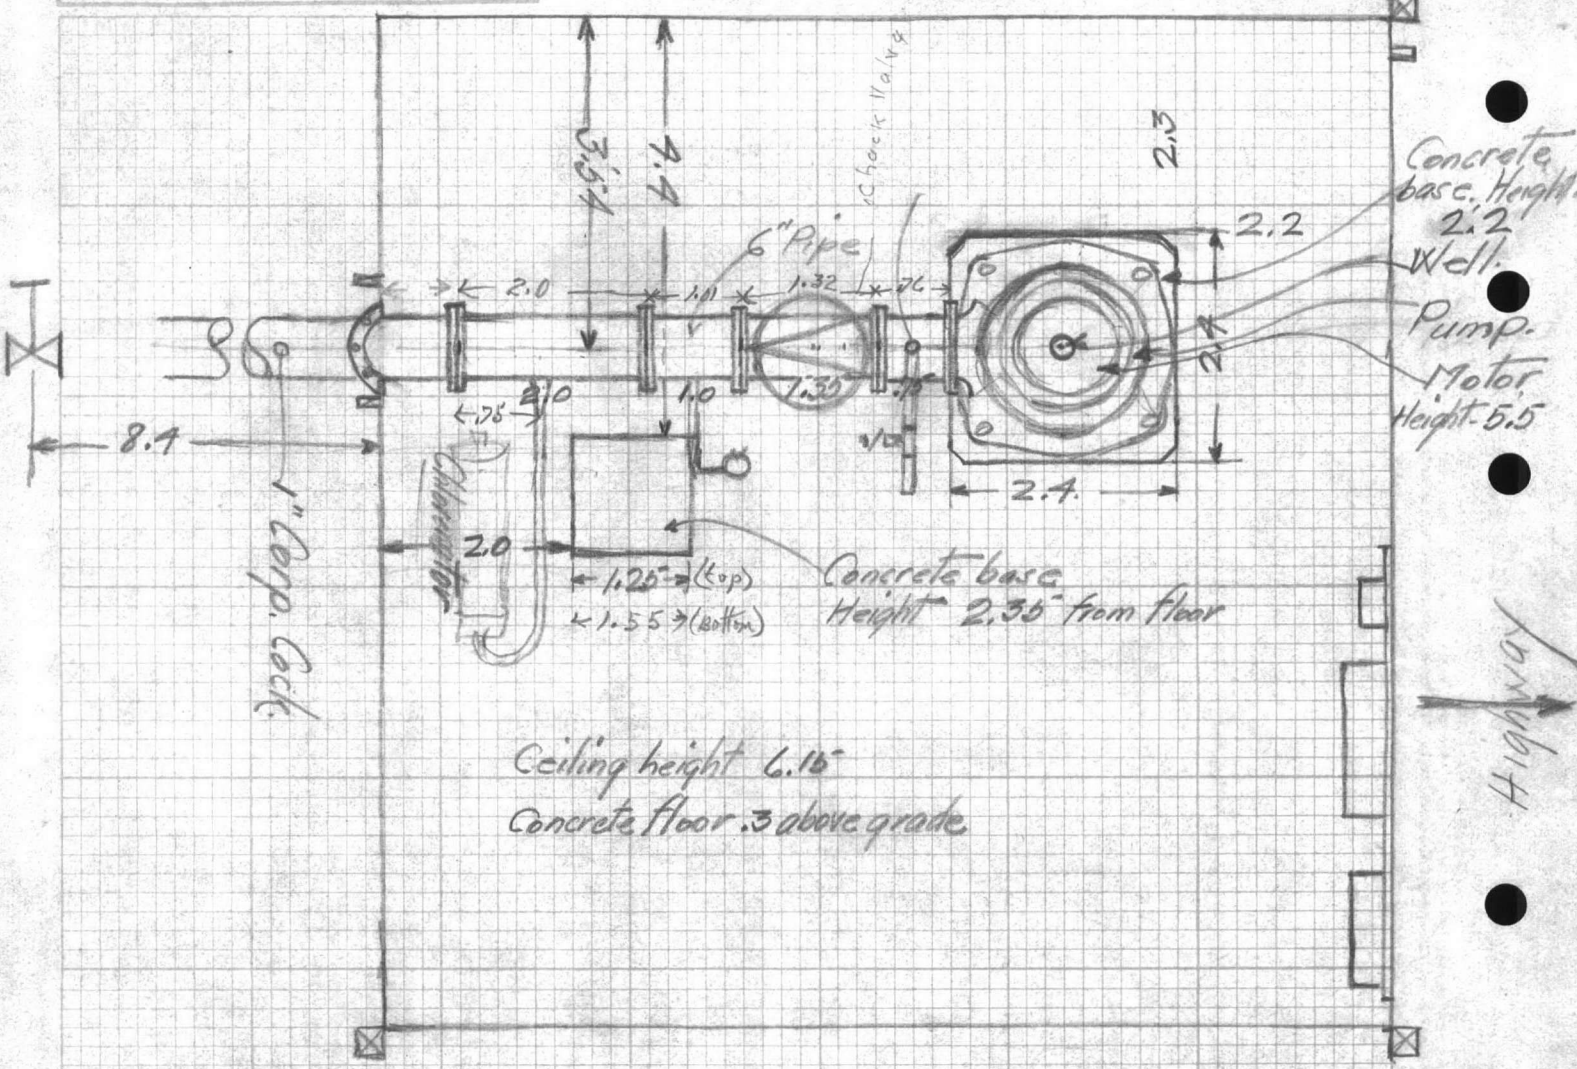

 

DATE _____
 DRAWN BY _____
 APPROVED BY _____
 JOHNSON SERVICE CO.
 REVISID _____

Motor height from floor
 6.9

CONTRACTOR: _____
 BRANCH OFFICE: _____
 LOCATION: _____
 JOB: _____
 SUBJECT: _____

Concrete Base
 2.3 x 2.3 x 1.6 H.
 Well
 Peerless Pump
 Gear Turbo No. J. 7476
 Gear ratio CA 1-1

Allis Chalmers
 Engine-Gasoline
 1.4 x 3.6

Concrete
 base 2.00 x 2.4

Height
 from floor
 5.5
 2.7

1 1/2" Swing Check valve
 upside down

1" Stop
 Cock

Rubber hose

Crock 1.8 x 2.4

Chloro-
 motor

2" Globe Valve

75.01

6" Tee

20" Cover

8'0"


1" x 4" Studs, 16" Centers

Door 2.7

10.65'
 Highway

WELL PUMP
 HOUSE No 4007
 16 May 1950
 Cassidy

10-314 from Grub

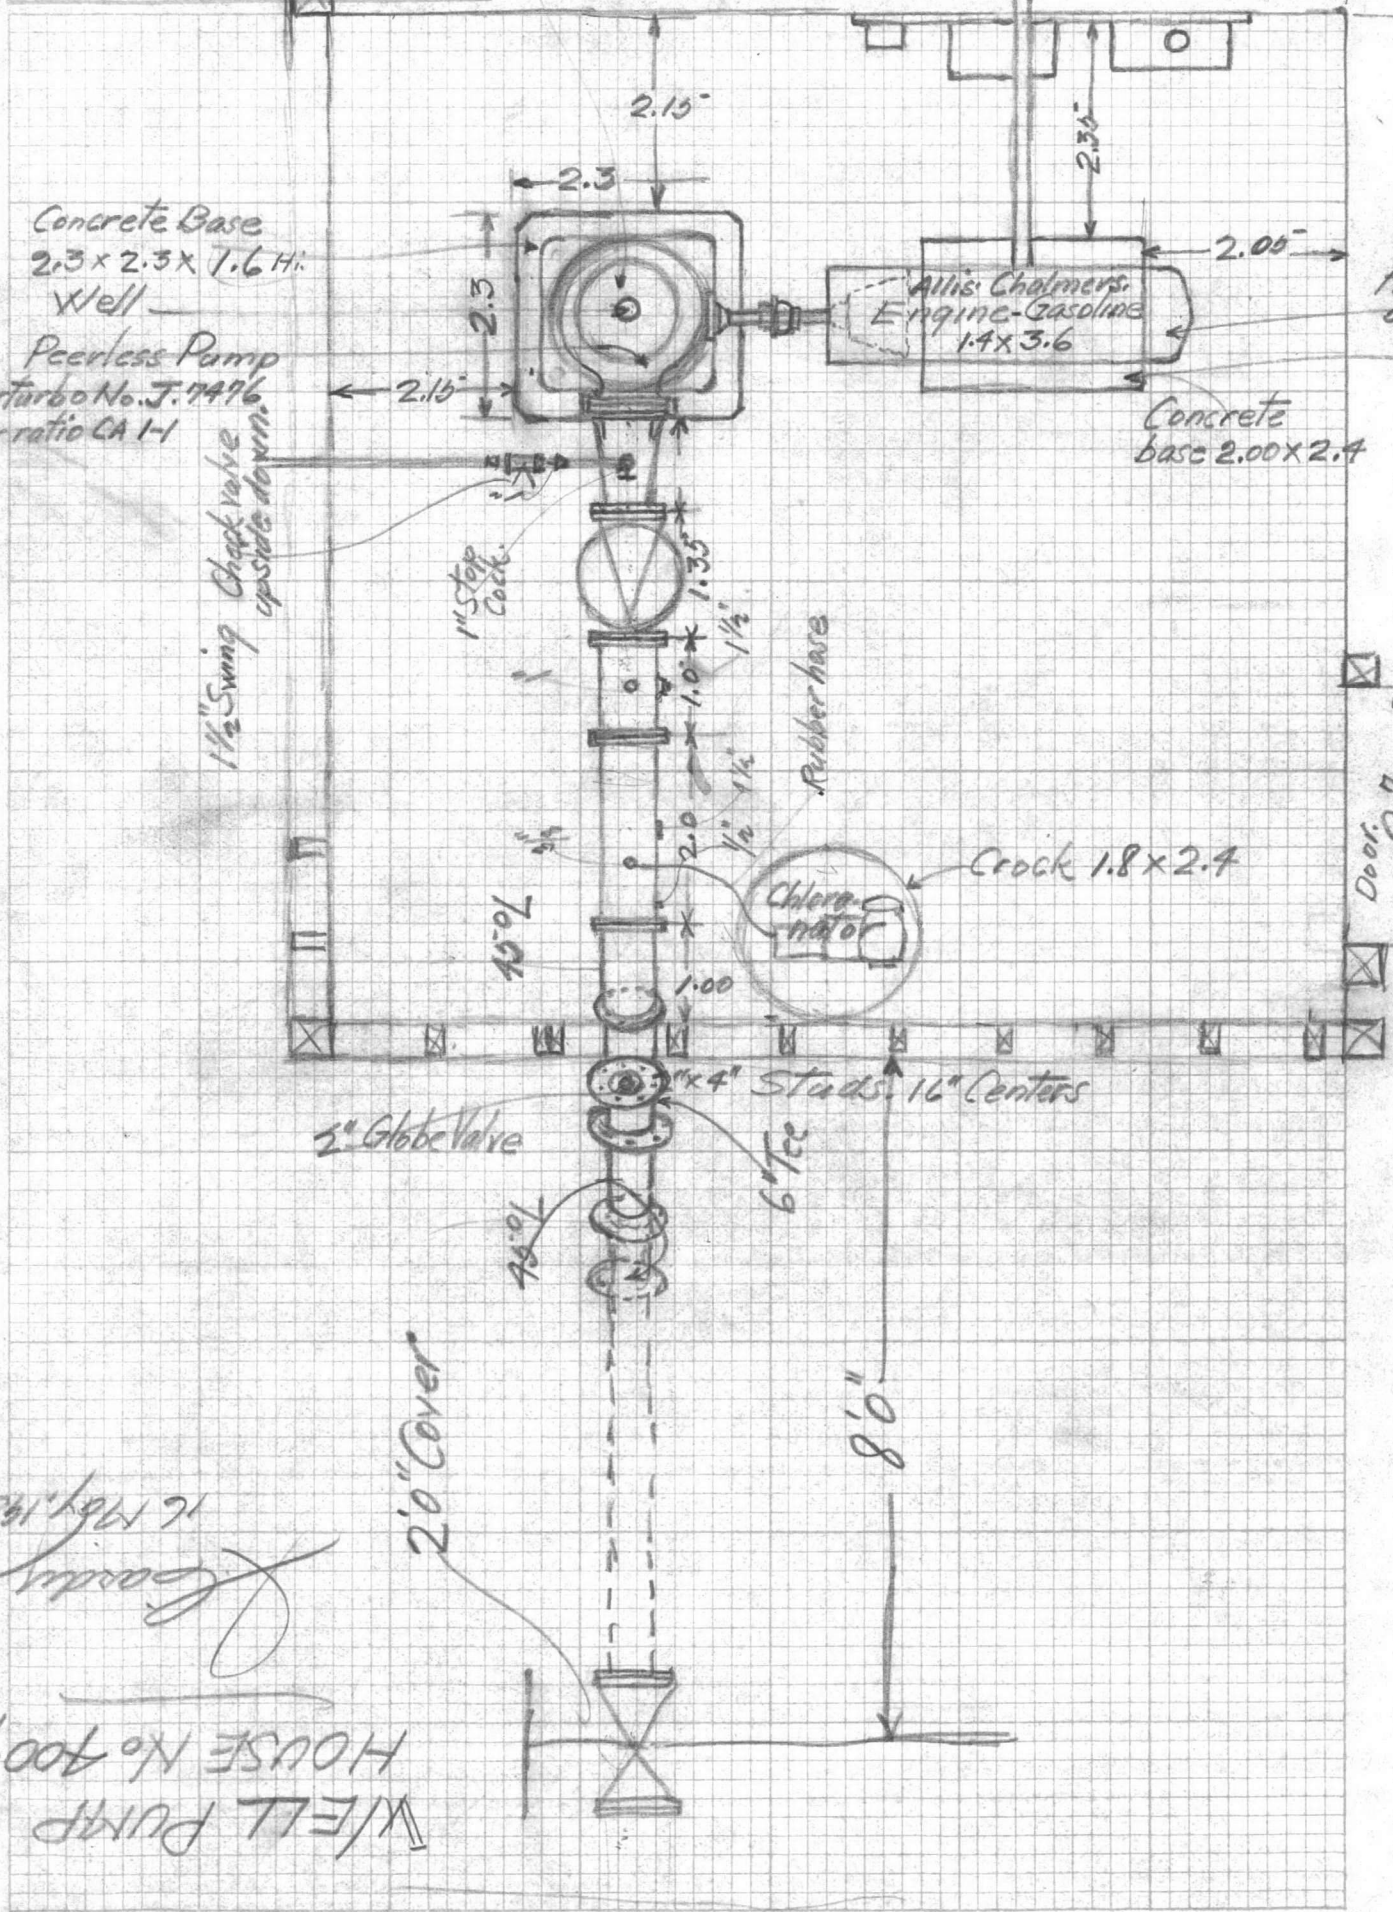



VALUABLE

SUBJECT Utilities Location
Midway Park school cont'd

Return To
 Public Works
 Office
 Camp Lejeune
 North Carolina





FIELD PARTY
 _____ In Charge
 _____ Instrument
 _____ Notes
 _____ Tape Read
 _____ Tape or Rod
 _____ Tape or Rod
 _____ Instrument No.
 _____ Tape No.

WEATHER
 Clear _____
 Cloudy _____
 Windy _____
 Rain _____
 Fair _____
 Snow _____
 Hot _____
 Moderate _____
 Cold _____
 Fog _____
 Figured By _____
 Notes Checked By _____
 Plotted By _____

FILE No. 100-W
 Fldr. No. _____
 Sheet 2 of 5
 Date 12-12-1950

Quad. No. _____

Station	Dist.	Angle "	H. I. Bearing	Ver: Ang. Diff.	Elevation
			37.54		
top of water line service to cafeteria			6.34		
B.M. Nail #351			4.05	33.49	

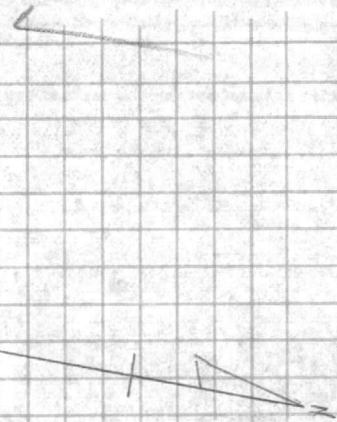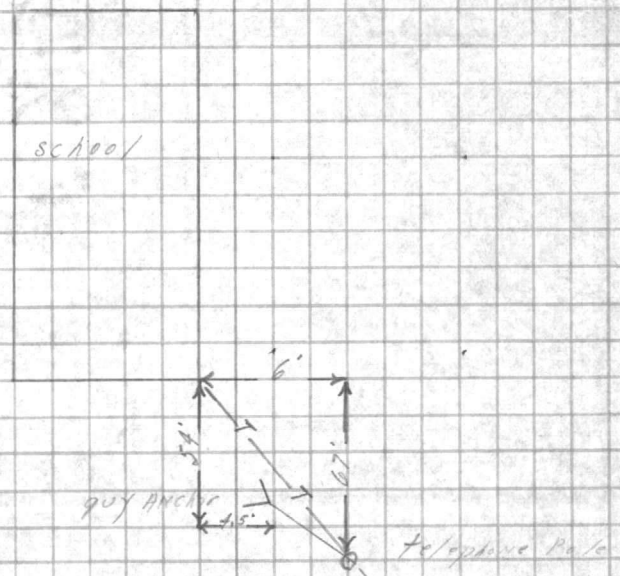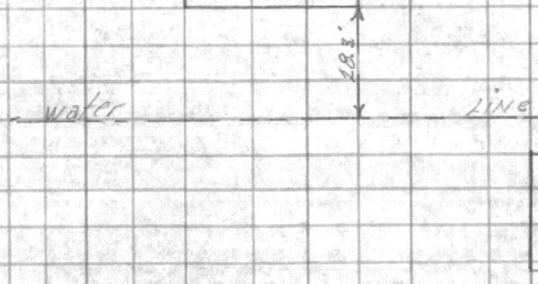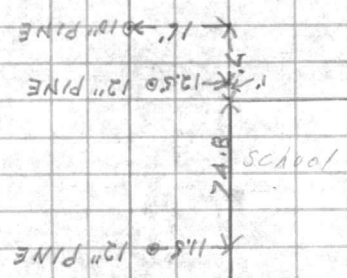


















VALUABLE

SUBJECT _____

Return To
Public Works
Office
Camp Lejeune
North Carolina

FIELD PARTY

____ In Charge
____ Instrument
____ Notes
____ Tape Read
____ Tape or Rod
____ Tape or Rod
____ Instrument No.
____ Tape No.

WEATHER

Clear
Cloudy
Windy
Rain
Fair

Snow
Hot
Moderate
Cold
Fog

FILE No. _____

Fldr. No. _____

Sheet 3-015

Date 12-13-1950

Figured By _____
Notes Checked By _____
Plotted By _____
Quad. No. _____

Station	Dist.	Angle ° ' "	+	H. I. Bearing	Ver: Ang. Diff.	Elevation
---------	-------	----------------	---	------------------	--------------------	-----------

MON #351

2 51

33.49

36 00

"A"

3 64 32 36 DN TOP 1" WATER LINE AT BLDG.

"B"


4 72 31 28 DN TOP 1" WATER LINE 15' FROM CORNER BLDG.

"C"

5 98 30 02 DN TOP 1" WATER LINE

~~2 52 3 348 (33.49)~~

~~13 27 DN TOP 8" WATER LINE NEAR DITCH~~

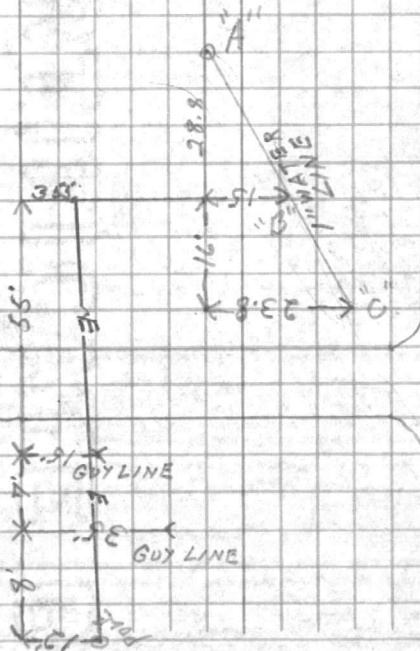























VALUABLE

SUBJECT Elevations of proposed
addition to midway Park school

Return To
 Public Works
 Office
 Camp Lejeune
 North Carolina


FIELD PARTY
Kellum In Charge
 Instrument _____
 Notes _____
 Tape Read _____
 Tape or Rod _____
 Tape or Rod _____
 Instrument No. _____
 Tape No. _____

WEATHER
 Clear _____
 Cloudy _____
 Windy _____
 Rain _____
 Fair _____
 Snow _____
 Hot _____
 Moderate _____
 Cold _____
 Fog _____
 Figured By _____
 Notes Checked By _____
 Plotted By _____

FILE No. _____
 Fldr. No. _____
 Sheet 4- of 5
 Date 12-13-1950

Quad. No. _____

Station	Dist.	Angle "	+	H. I. Bearing	Ver: Ang. Diff.	Elevation
B.M. MARK #351						33.49
	1.43	34.92				
"A"				2.7	32.2	
"B"				2.9	32.0	
"C"				3.3	31.6	
"F"				2.5	32.4	
"E"				3.8	31.1	
"D"				4.7	30.2	
"M"				3.9	31.0	
"O" top 8" C.I. water				11.84	23.10	
T.P.				2.25	32.67	
	4.70	37.37				
"L"				1.6	32.8	
"K"				1.4	33.0	
"J"				1.6	32.8	
"G"				1.4	33.0	
"H"				5.1	32.3	
"I"				4.7	32.7	
"N"				4.6	32.8	
"P" top of 8" C.I. water				8.90	28.47	
B.M. MARK #357				3.86	33.51	
						33.49

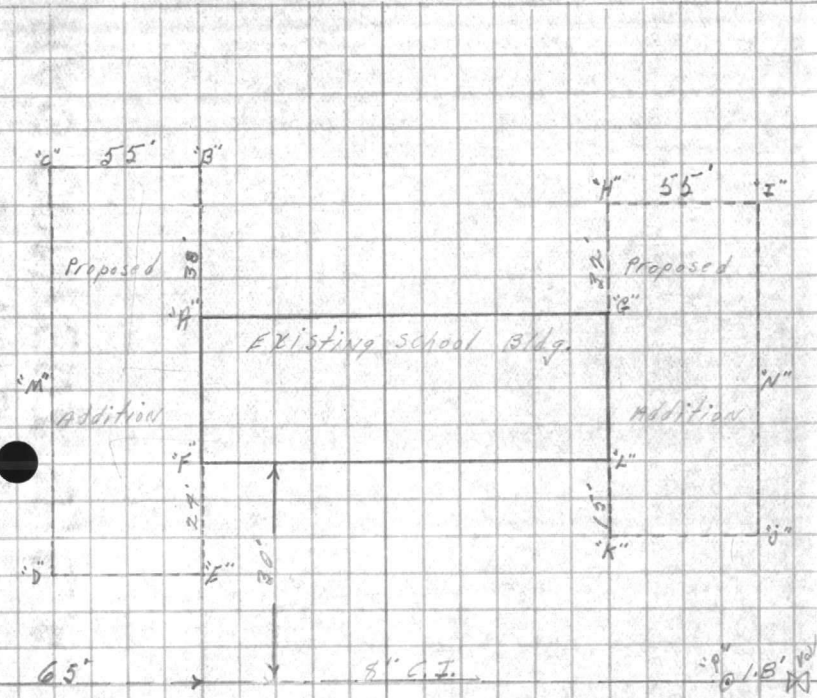

Butler drive north

VALIANCE

SUBJECT

Return To
Police Work
Office
Camp Lejeune
North Carolina

FIELD PARTY

WEATHER

FILE NO.

Station _____
Date _____
H. I. _____
BARTON _____
H. I. _____
BARTON _____
H. I. _____
BARTON _____

VALUABLE

SUBJECT water service location
to midway park school

Return To
 Public Works
 Office
 Camp Lejeune
 North Carolina

FIELD PARTY

In Charge _____
 Instrument _____
 Notes _____
 Tape Read _____
 Tape or Rod _____
 Tape or Rod _____
 Instrument No. _____
 Tape No. _____

WEATHER

Clear _____
 Cloudy _____
 Windy _____
 Rain _____
 Fair _____
 Snow _____
 Hot _____
 Moderate _____
 Cold _____
 Fog _____

FILE No. _____
 Fldr. No. _____
 Sheet 5 of 5
 Date 12-13-1950


Quad. No. _____

Station	Dist.	Angle "	+	H. I. Bearing	Ver: Ang. Diff.	Elevation
B.M. MON. # 351						33.49
	3.76	37.25				
"A"					5.19	32.06
"B"					5.68	31.57
"C"					5.98	31.27
B.M. MON. # 351	3.76					33.49

top of 2" Galv. water line

Butler Drive North

8" C.I. water

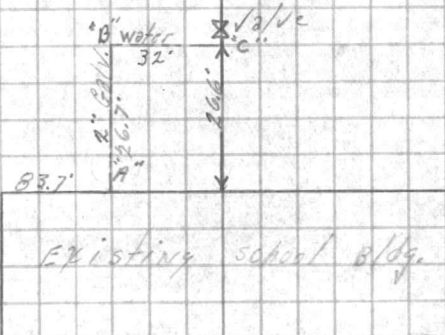

11-11-41
VARIABLE

Return To
Public Works
Office
Camp Johnson
North Carolina

SUBJECT

Station _____
Dist. _____
Angle _____
M. I. _____
H. I. _____
Dir. _____
Elev. _____
Elevation _____

FIELD PARTY

In Charge _____
Instrument _____
Line _____
Tape Read _____
Tape or Rod _____
Page or Rod _____

WEATHER

Clear _____
Snow _____
Fog _____
Cloudy _____
Wind _____
Rain _____
Cold _____
Hot _____
Faint _____

FILE No.

Speed

Figured By _____

Date

Checked By _____

Tape No.



VALUABLE

SUBJECT

Base Line and ground
Profile for Proposed water
Line Pump house 4006 to
4007 - Midway Park

Return To
Public Works
Office
Camp Lejeune
North Carolina

FIELD PARTY

Hamilton In Charge
Instrument
Notes
Tape Read
Tape or Rod
Tape or Rod
Instrument No.
Tape No.

WEATHER

Clear
Cloudy
Windy
Rain
Fair
Snow
Hot
Moderate
Cold
Fog

FILE No. _____

Fldr. No. _____

Sheet 101

Date 3-29 19 50



Figured By _____

Notes Checked By _____

Plotted By _____

Quad. No. _____

Station Dist. ° Angle " + H. I. Ver: Ang. Elevation

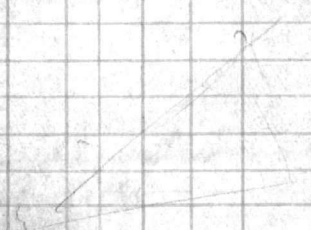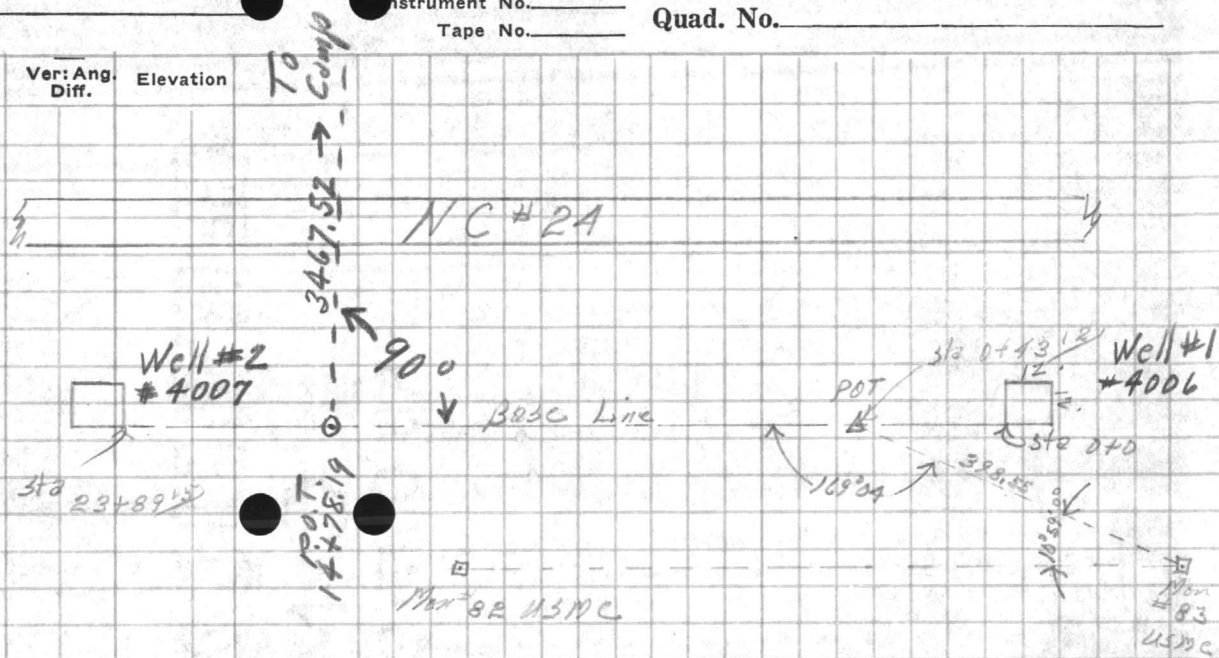











VALUABLE

SUBJECT

Location Water Cross
Holecamp Blvd

Return To
Public Works
Office
Camp Lejeune
North Carolina

FIELD PARTY

In Charge _____
Instrument _____
Notes _____
Tape Read _____
Tape or Rod _____
Tape or Rod _____
Instrument No. _____
Tape No. _____

WEATHER

Clear _____
Cloudy _____
Windy _____
Rain _____
Fair _____
Snow _____
Hot _____
Moderate _____
Cold _____
Fog _____

FILE No. _____

Fldr. No. _____

Figured By _____

Sheet 109

Notes Checked By _____

Plotted By _____

Date _____ 19__

Quad. No. _____

Station	Dist.	Angle " "	+	H. I. Bearing	Ver: Ang. Diff.	Elevation
BM			5 30			32 80 PI#4
PI#4 "A"				38 10	8 50	29 60 Top of tee 12" Tee
					5 30	80

PI#4

178 27 00 (1)
356 53 30 (2)
178 26 45 mean

PI#4 "A"

BS Mon

12" Tee

PI#4A ~~cross~~ on Existing Water Line.

314 89

358 44 (1)

357 27 30 (2)

358 44 15 mean

PI#4

BS Mon.

VARIABLE

SUBJECT

Return to
Public Works
Office
Camp Lejeune
North Carolina

Station

Dist

Angle

+

Observed

Vertical

Elevation

Tapc No.

Instrument No.

Tapc of Rod

Tapc of Rod

Notes

Instrument

In Charge

PARTY

WEATHER

Clear

Cloudy

Windy

Light

Cloud

Fog

Other

FILE NO.









