

**VALUABLE**

RETURN TO  
PUBLIC WORKS  
OFFICE  
CAMP LEJEUNE  
NORTH CAROLINA

SUBJECT Location Gas Line  
Parade Field

**FIELD PARTY**

\_\_\_\_ IN CHARGE  
\_\_\_\_ INSTRUMENT  
\_\_\_\_ NOTES  
\_\_\_\_ TAPE READ  
\_\_\_\_ TAPE OR ROD  
\_\_\_\_ TAPE OR ROD  
\_\_\_\_ INSTRUMENT NO.  
\_\_\_\_ TAPE NO.


**WEATHER**

CLEAR \_\_\_\_\_  
CLOUDY \_\_\_\_\_  
WINDY \_\_\_\_\_  
RAIN \_\_\_\_\_  
FAIR \_\_\_\_\_  
SNOW \_\_\_\_\_  
HOT \_\_\_\_\_  
MODERATE \_\_\_\_\_  
COLD \_\_\_\_\_  
FOG \_\_\_\_\_  
FIGURED BY \_\_\_\_\_  
NOTES CHECKED BY \_\_\_\_\_  
PLOTTED BY \_\_\_\_\_

FILE No. \_\_\_\_\_  
FLDR. No. \_\_\_\_\_  
SHEET 1 of 3  
DATE 12/29 1955

Quad. No. \_\_\_\_\_ Blk. # 15

STATION	DIST.	ANGLE		+	H. I. BEARING	VER: ANG. DIFF.	ELEVATION
		o	'				

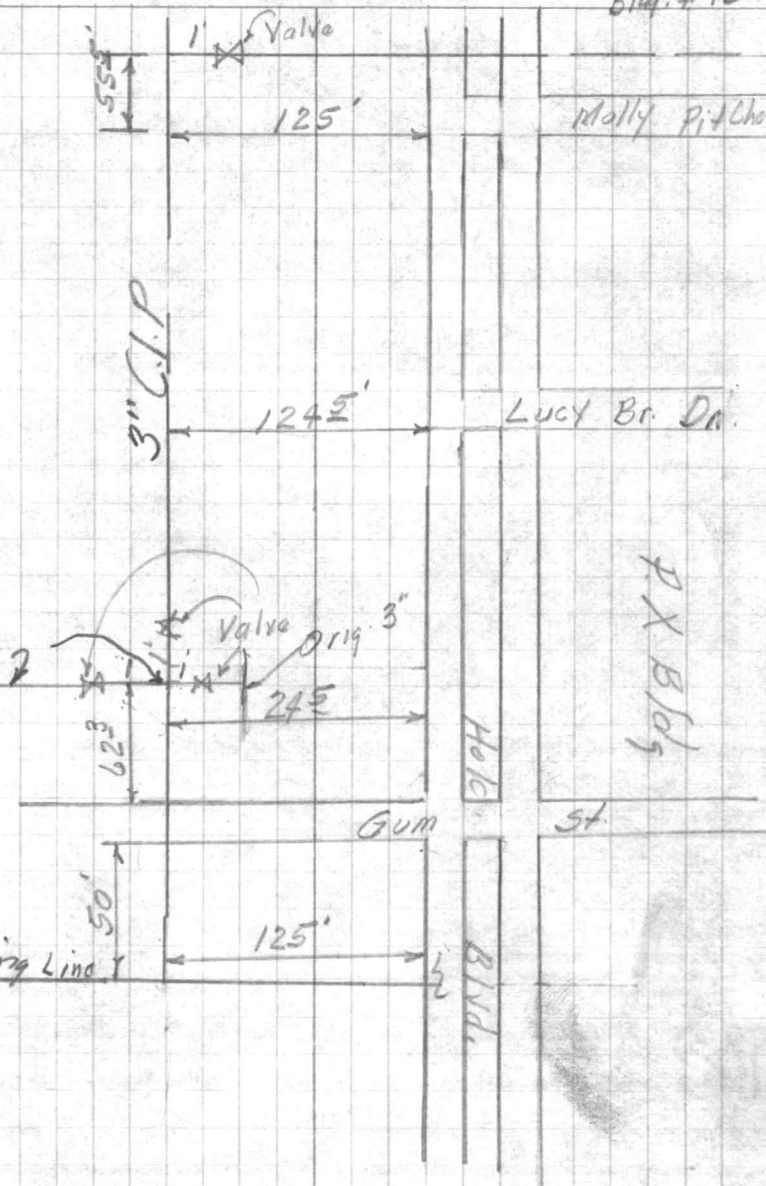





























**VALUABLE**

SUBJECT \_\_\_\_\_  
\_\_\_\_\_  
\_\_\_\_\_  
\_\_\_\_\_  
\_\_\_\_\_

RETURN TO  
PUBLIC WORKS  
OFFICE  
CAMP LEJEUNE  
NORTH CAROLINA

**FIELD PARTY**


\_\_\_\_\_  
IN CHARGE  
\_\_\_\_\_  
INSTRUMENT  
\_\_\_\_\_  
NOTES  
\_\_\_\_\_  
TAPE READ  
\_\_\_\_\_  
TAPE OR ROD  
\_\_\_\_\_  
TAPE OR ROD  
\_\_\_\_\_  
INSTRUMENT NO.  
\_\_\_\_\_  
TAPE NO.

**WEATHER**

CLEAR  
CLOUDY  
WINDY  
RAIN  
FAIR  
SNOW  
HOT  
MODERATE  
COLD  
FOG  
FIGURED BY \_\_\_\_\_  
NOTES CHECKED BY \_\_\_\_\_  
PLOTTED BY \_\_\_\_\_

FILE No. \_\_\_\_\_  
FLDR. No. \_\_\_\_\_  
SHEET 2 of 3  
DATE \_\_\_\_\_ 19\_\_

Quad. No. \_\_\_\_\_

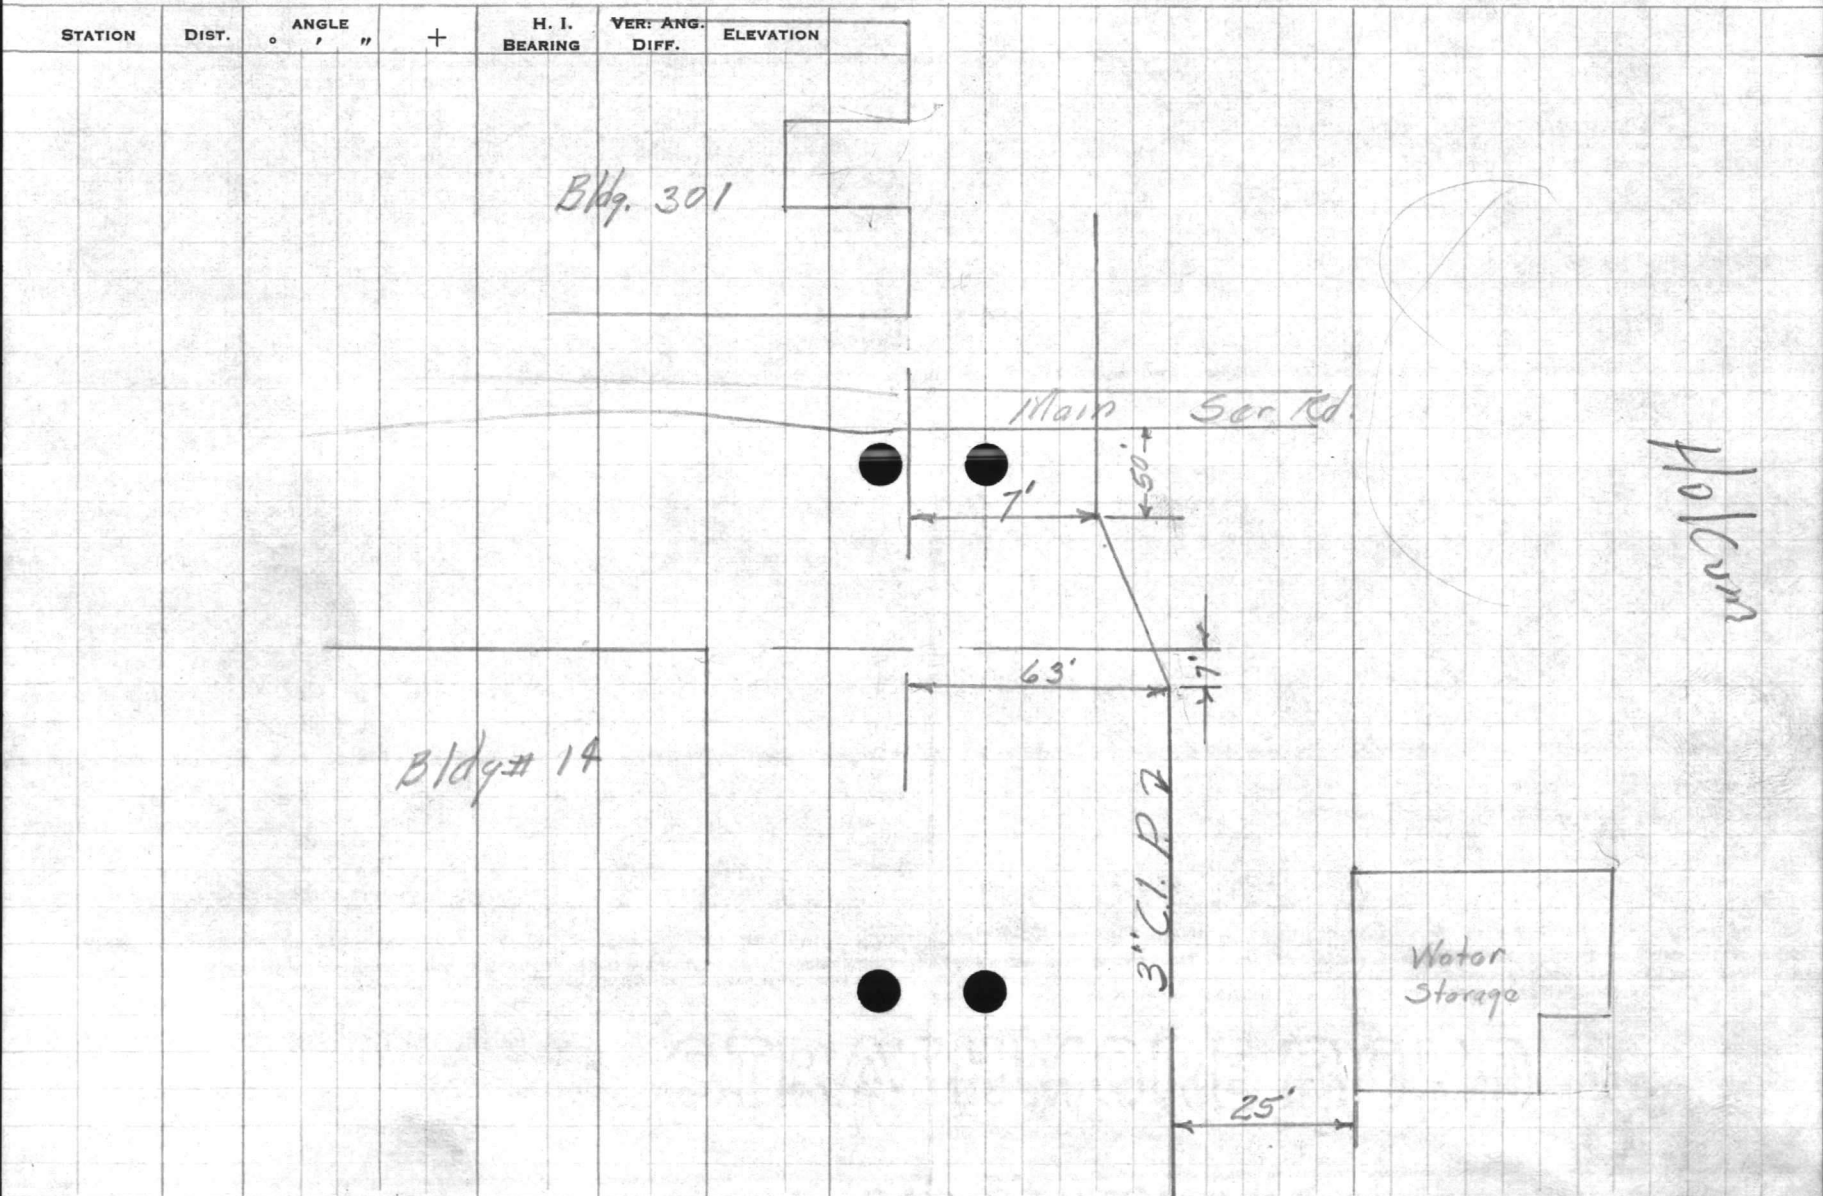

Holburn















**VALUABLE**

SUBJECT \_\_\_\_\_  
\_\_\_\_\_  
\_\_\_\_\_  
\_\_\_\_\_  
\_\_\_\_\_  
\_\_\_\_\_

RETURN TO  
PUBLIC WORKS  
OFFICE  
CAMP LEJEUNE  
NORTH CAROLINA

**FIELD PARTY**

\_\_\_\_\_  
IN CHARGE  
\_\_\_\_\_  
INSTRUMENT  
\_\_\_\_\_  
NOTES  
\_\_\_\_\_  
TAPE READ  
\_\_\_\_\_  
TAPE OR ROD  
\_\_\_\_\_  
TAPE OR ROD  
\_\_\_\_\_  
INSTRUMENT NO.  
\_\_\_\_\_  
TAPE NO. \_\_\_\_\_

**WEATHER**



CLEAR  
CLOUDY  
RAIN  
FAIR  
SNOW  
HOT  
MODERATE  
COLD  
FOG

FILE No. \_\_\_\_\_  
FLDR. No. \_\_\_\_\_  
SHEET 3 of 3  
FIGURED BY \_\_\_\_\_  
NOTES CHECKED BY \_\_\_\_\_  
PLOTTED BY \_\_\_\_\_ DATE \_\_\_\_\_ 19\_\_\_\_

Quad. No. \_\_\_\_\_

STATION	DIST.	ANGLE ° ' "	+	H. I. BEARING	VER: ANG. DIFF.	ELEVATION
---------	-------	----------------	---	------------------	--------------------	-----------

Main Sec. rd

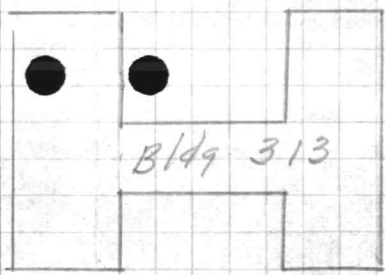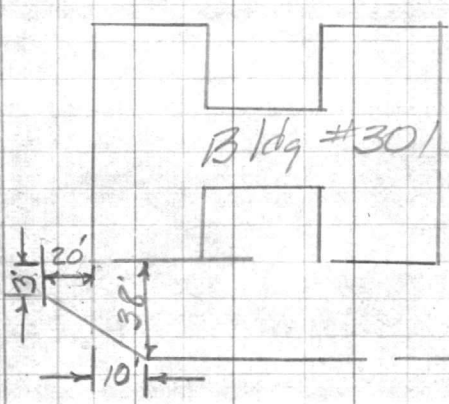

3" Gas 2

Existing Gas Line

38'  
45'

Halseum Blvd








**VALUABLE**

SUBJECT ELEV. FOR PITOMETER SURVEY HADNDTPT. FIELD.

RETURN TO  
PUBLIC WORKS  
OFFICE  
CAMP LEJEUNE  
NORTH CAROLINA

**FIELD PARTY**

DENNS IN CHARGE  
INSTRUMENT \_\_\_\_\_  
NOTES \_\_\_\_\_  
TAPE READ \_\_\_\_\_  
TAPE OR ROD \_\_\_\_\_  
TAPE OR ROD \_\_\_\_\_  
INSTRUMENT No. \_\_\_\_\_  
TAPE No. \_\_\_\_\_

**WEATHER**

CLEAR \_\_\_\_\_ SNOW \_\_\_\_\_  
CLOUDY \_\_\_\_\_ HOT \_\_\_\_\_  
WINDY \_\_\_\_\_ MODERATE \_\_\_\_\_  
RAIN \_\_\_\_\_ COLD \_\_\_\_\_  
FAIR \_\_\_\_\_ FOG \_\_\_\_\_  
FIGURED BY \_\_\_\_\_  
NOTES CHECKED BY \_\_\_\_\_  
PLOTTED BY \_\_\_\_\_

FILE No. 160 Gen.  
FLDR. No. \_\_\_\_\_  
SHEET 1 of 2  
DATE 10-1-57

Quad. No. \_\_\_\_\_

STATION	DIST.	ANGLE		H. I. BEARING	VER. ANG. DIFF.	ELEVATION	NOTES	
		°	"					
B.m.		5	35	25	77	20 42	N. MOST COR. STEAM PIT (OLD) NEAR S. E. COR. 300	
					1.90	23.87	ON RIM OF AIR VALVE IN REAR BLDG # 300	
		1	81	25	68			
B.m.					5	26	20 42	N. MOST COR. STEAM (OLD) NEAR S. E. COR. # 300
B.m.		4	46	31	42	26 96	N. MOST COR. STEAM PIT (OLD) NEAR N. COR. BLDG # 500	
					4.59	26 83	ON N. EDGE CONC. WALK AT AIR VALVE N. SIDE BLDG # 500	
		4	54	31	37			
B.m.					4.41	26 96	N. MOST COR. STEAM PIT (OLD) NEAR N. COR. BLDG # 500	





**VALUABLE**
 SUBJECT \_\_\_\_\_  
 \_\_\_\_\_  
 \_\_\_\_\_  
 \_\_\_\_\_  
 \_\_\_\_\_

 RETURN TO  
 PUBLIC WORKS  
 OFFICE  
 CAMP LEJEUNE  
 NORTH CAROLINA

## FIELD PARTY

 \_\_\_\_\_ IN CHARGE  
 \_\_\_\_\_ INSTRUMENT  
 \_\_\_\_\_ NOTES  
 \_\_\_\_\_ TAPE READ  
 \_\_\_\_\_ TAPE OR ROD  
 \_\_\_\_\_ TAPE OR ROD  
 \_\_\_\_\_ INSTRUMENT NO.  
 \_\_\_\_\_ TAPE NO.

## WEATHER

 CLEAR \_\_\_\_\_ SNOW \_\_\_\_\_  
 CLOUDY \_\_\_\_\_ HOT \_\_\_\_\_  
 WINDY \_\_\_\_\_ MODERATE \_\_\_\_\_  
 RAIN \_\_\_\_\_ COLD \_\_\_\_\_  
 FAIR \_\_\_\_\_ FOG \_\_\_\_\_  
 FIGURED BY \_\_\_\_\_  
 NOTES CHECKED BY \_\_\_\_\_  
 PLOTTED BY \_\_\_\_\_

 FILE No. \_\_\_\_\_  
 FLDR. No. \_\_\_\_\_  
 SHEET 2 of 2  
 DATE \_\_\_\_\_ 19\_\_

Quad. No. \_\_\_\_\_

STATION	DIST.	ANGLE ° ' "	H. I. BEARING	VER: ANG. DIFF.	ELEVATION	
B. m.		<del>0.81</del> 24	<del>26</del> 26		25.81	FINISH FL. WEST END <del>BUTLER BLDG</del> 739 Quonset Hut, Bldg # 746
		24 3.28	48 24	3.38 3.39	23.43 23.23	ON BOARD AT OPEN HOLE HOUSE OVER HOLE
B. m.				0.67 0.90	25.81 25.81	(25.81) <del>Quonset Hut, Bldg # 746</del>
B. m.			3 77 39	25	30.48	BOLT IN P.P. # APPROX. 50' S.E. WELL # 605
T.P.				3 19	31.06	
			3 51 34	57		
T.P.				5.08	29.49	ON TOP HUB 12.1' FROM EDGE ST. NEAR PT-DE RAD. NEAR EAST COR. BLDG. 916
			5 14 34	63		
T.P.				3 69	30.94	
			3 30 34	24		
B. m.				3 76	30.48	BOLT. IN P.P. APPROX 50' S.E. WELL # 605






















**VALUABLE**

SUBJECT \_\_\_\_\_

 RETURN TO  
 PUBLIC WORKS  
 OFFICE  
 CAMP LEJEUNE  
 NORTH CAROLINA

## FIELD PARTY

 \_\_\_\_\_ IN CHARGE  
 \_\_\_\_\_ INSTRUMENT  
 \_\_\_\_\_ NOTES  
 \_\_\_\_\_ TAPE READ  
 \_\_\_\_\_ TAPE OR ROD  
 \_\_\_\_\_ TAPE OR ROD  
 \_\_\_\_\_ INSTRUMENT NO.  
 \_\_\_\_\_ TAPE NO.

## WEATHER

 CLEAR  
 CLOUDY  
 WINDY  
 RAIN  
 FAIR  
 SNOW  
 HOT  
 MODERATE  
 COLD  
 FOG  
 FIGURED BY \_\_\_\_\_  
 NOTES CHECKED BY \_\_\_\_\_  
 PLOTTED BY \_\_\_\_\_

FILE No. \_\_\_\_\_

FLDR. No. \_\_\_\_\_

SHEET 3 of 3DATE 10-2 19\_\_

Quad. No. \_\_\_\_\_

STATION	DIST.	ANGLE		+	H. I. BEARING	VER. ANG. DIFF.	ELEVATION
		°	' "				
					3 85 30 82		26 97
T. P.						3,38	27.44
					4 41 32,05		
T. P.						3,24	28.81
					4 06 32 87		
B. m.						4,22	28 65
					4 29 32.94		
T. P.						4,17	28 77
					3,22	31,99	
T. P.						4,58	27,41
					3 50 30 91		
B. m.						3 95	26 96 (26 97) FL. WELL # 625

FL. WELL # 625

 ON RIM AIR VALVE MANHOLE 34' WEST  
 JANT CROSSING BETWEEN WELL HOUSE  
 # 625 & BUTLER BLDG # 739 ON M. S. R.



























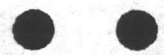

CONFIDENTIAL

**VALUABLE**

SUBJECT \_\_\_\_\_

RETURN TO  
PUBLIC WORKS  
OFFICE  
CAMP LEJEUNE  
NORTH CAROLINA

## FIELD PARTY

MORTON IN CHARGE  
 \_\_\_\_\_ INSTRUMENT  
 \_\_\_\_\_ NOTES  
 \_\_\_\_\_ TAPE READ  
 \_\_\_\_\_ TAPE OR ROD  
 \_\_\_\_\_ TAPE OR ROD  
 \_\_\_\_\_ INSTRUMENT NO.  
 \_\_\_\_\_ TAPE NO.

## WEATHER

CLEAR SNOW  
 CLOUDY HOT  
 WINDY MODERATE  
 RAIN COLD  
 FAIR FOG

FILE No. 160-60N

FLDR. No. \_\_\_\_\_


SHEET 10E

FIGURED BY \_\_\_\_\_  
 NOTES CHECKED BY \_\_\_\_\_  
 PLOTTED BY \_\_\_\_\_ DATE 10-9 1957

Quad. No. \_\_\_\_\_

STATION	DIST.	ANGLE ° ' "	+	H. I. BEARING	VER. ANG. DIFF.	ELEVATION	
B.M. ✓			3.43	24.57		21.14	FLOOR WELL # 613
					13.25	11.32 ✓	TOP WATER LINE
B.M. ✓			6.57	30.16		23.59 ✓	MON. # 128
					5.35	24.81 ✓	TOP WATER LINE <del>IN</del> <sup>AT</sup> M.H. AIR RELEASE VALUE IN M.H.
B.M.			4.27	27.83		23.56	MON. # 126
TP					3.53	24.30 ✓	
M.H. # 1			4.61	28.91		22.47 ✓	TOP WATER LINE AT AIR RELEASE VALUE <del>IN</del> M.H. # 1
<del>M.H. # 2</del>			9.24	31.71		22.76 ✓	
M.H. # 2					8.95	22.76 ✓	TOP WATER LINE AT AIR RELEASE VALUE IN M.H. # 2
B.M.			9.67	32.43		28.15 ✓	(28.17) MON. # 127
B.M.			4.28	27.84		23.56	MON. # 126
TP					9.50	18.34 ✓	
TP			2.33	20.67		12.04 ✓	
TP			3.24	15.28		7.76 ✓	TOP WATER LINE AT BEARHEAD CREEK
TP			9.77	17.53		16.48 ✓	
B.M.			11.33	27.81		23.56 ✓	MON. # 126

HOLCOM BVD.  
 TO MAIN GATE →

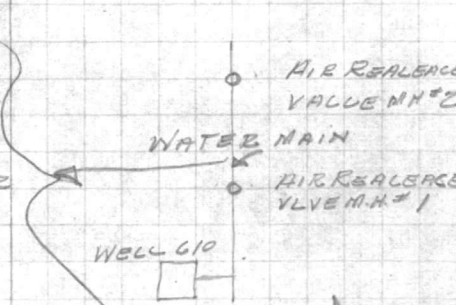










**VALUABLE**SUBJECT \_\_\_\_\_  
\_\_\_\_\_  
\_\_\_\_\_  
\_\_\_\_\_  
\_\_\_\_\_RETURN TO  
PUBLIC WORKS  
OFFICE  
CAMP LEJEUNE  
NORTH CAROLINA

## FIELD PARTY

\_\_\_\_\_  
IN CHARGE  
\_\_\_\_\_  
INSTRUMENT  
\_\_\_\_\_  
NOTES  
\_\_\_\_\_  
TAPE READ  
\_\_\_\_\_  
TAPE OR ROD  
\_\_\_\_\_  
TAPE OR ROD  
\_\_\_\_\_  
INSTRUMENT NO.  
\_\_\_\_\_  
TAPE NO. \_\_\_\_\_

## WEATHER

CLEAR  
CLOUDY  
WINDY  
RAIN  
FAIR  
SNOW  
HOT  
MODERATE  
COLD  
FOG

FILE No. \_\_\_\_\_

FLDR. No. \_\_\_\_\_

FIGURED BY \_\_\_\_\_ SHEET \_\_\_\_\_

NOTES CHECKED BY \_\_\_\_\_

PLOTTED BY \_\_\_\_\_ DATE \_\_\_\_\_ 19\_\_

Quad. No. \_\_\_\_\_

STATION	DIST.	ANGLE		+	H. I. BEARING	VER: ANG. DIFF.	ELEVATION	
		°	' "					
B.M.					4.24 36.35 ✓		32.11	FLOOR WELL # 604
					3.64 32.71 ✓			TOP BOARD AT DOOR TO SHELTER BOX NEAR WELL # 604
B.M.					6.05 32.89 ✓	70	26.84	ON H.W. ENTRANCE TO P.X.
					12.13 <sup>20.</sup> 30.76 ✓			TOP WATER LINE AT AIR RELEASE VALVE 1A.M.H. AT INT. HOLCOMB BLVD. & MOLLY RITCHER DR.






















**VALUABLE**

SUBJECT \_\_\_\_\_  
\_\_\_\_\_  
\_\_\_\_\_  
RETURN TO  
PUBLIC WORKS  
OFFICE  
CAMP LEJEUNE  
NORTH CAROLINA

**FIELD PARTY**

\_\_\_\_\_  
IN CHARGE  
\_\_\_\_\_  
INSTRUMENT  
\_\_\_\_\_  
NOTES  
\_\_\_\_\_  
TAPE READ  
\_\_\_\_\_  
TAPE OR ROD  
\_\_\_\_\_  
TAPE OR ROD  
\_\_\_\_\_  
INSTRUMENT NO.  
\_\_\_\_\_  
TAPE NO. \_\_\_\_\_

**WEATHER**

CLEAR  
CLOUDY  
WINDY  
RAIN  
FAIR  
SNOW  
HOT  
MODERATE  
COLD  
FOG

FILE No. \_\_\_\_\_  
FLDR. No. \_\_\_\_\_  
FIGURED BY \_\_\_\_\_ SHEET \_\_\_\_\_  
NOTES CHECKED BY \_\_\_\_\_  
PLOTTED BY \_\_\_\_\_ DATE \_\_\_\_\_ 19 \_\_\_\_\_

Quad. No. \_\_\_\_\_

STATION	DIST.	ANGLE ° ' "	+	H. I. BEARING	VER: ANG. DIFF.	ELEVATION
---------	-------	----------------	---	------------------	--------------------	-----------

B.M.				4.33 37.21		32.88
'A'					7.97 29.24	
					4.33	


FLOOR WELL # 617

TOP WATER LINE

WELL  
# 617

WATER LINE

A

 

**VALUABLE**

SUBJECT \_\_\_\_\_  
 \_\_\_\_\_  
 \_\_\_\_\_  
 \_\_\_\_\_

RETURN TO  
 PUBLIC WORKS  
 OFFICE  
 CAMP LEJEUNE  
 NORTH CAROLINA

**FIELD PARTY**

\_\_\_\_\_  
 IN CHARGE  
 \_\_\_\_\_  
 INSTRUMENT  
 \_\_\_\_\_  
 NOTES  
 \_\_\_\_\_  
 TAPE READ  
 \_\_\_\_\_  
 TAPE OR ROD  
 \_\_\_\_\_  
 TAPE OR ROD  
 \_\_\_\_\_  
 INSTRUMENT NO. \_\_\_\_\_  
 TAPE NO. \_\_\_\_\_

**WEATHER**

CLEAR  
 CLOUDY  
 WINDY  
 RAIN  
 FAIR  
 SNOW  
 HOT  
 MODERATE  
 COLD  
 FOG

FILE No. \_\_\_\_\_

FLDR. No. \_\_\_\_\_

FIGURED BY \_\_\_\_\_ SHEET \_\_\_\_\_



NOTES CHECKED BY \_\_\_\_\_

PLOTTED BY \_\_\_\_\_ DATE \_\_\_\_\_ 19\_\_\_\_

Quad. No. \_\_\_\_\_

STATION	DIST.	ANGLE		+	H. I. BEARING	VER: ANG. DIFF.	ELEVATION
		°	"				
B.M.					4.37 35.24		30.87
"A"						8.70	26.52
B.M.					4.37		

FLOOR WELL # 615

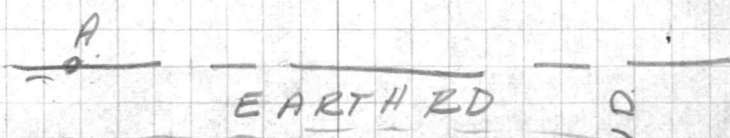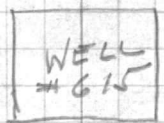

HOLCOM BLVD.









**VALUABLE**

SUBJECT \_\_\_\_\_  
 \_\_\_\_\_  
 \_\_\_\_\_  
 \_\_\_\_\_  
 \_\_\_\_\_

RETURN TO  
 PUBLIC WORKS  
 OFFICE  
 CAMP LEJEUNE  
 NORTH CAROLINA

**FIELD PARTY**

\_\_\_\_\_  
 IN CHARGE  
 \_\_\_\_\_  
 INSTRUMENT  
 \_\_\_\_\_  
 NOTES  
 \_\_\_\_\_  
 TAPE READ  
 \_\_\_\_\_  
 TAPE OR ROD  
 \_\_\_\_\_  
 TAPE OR ROD  
 \_\_\_\_\_  
 INSTRUMENT NO. \_\_\_\_\_  
 TAPE NO. \_\_\_\_\_

**WEATHER**

CLEAR  
 CLOUDY  
 WINDY  
 RAIN  
 FAIR


SNOW  
 HOT  
 MODERATE  
 COLD  
 FOG

FILE No. \_\_\_\_\_  
 FLDR. No. \_\_\_\_\_  
 SHEET \_\_\_\_\_  
 DATE \_\_\_\_\_ 19\_\_

FIGURED BY \_\_\_\_\_  
 NOTES CHECKED BY \_\_\_\_\_  
 PLOTTED BY \_\_\_\_\_  
 Quad. No. \_\_\_\_\_

STATION	DIST.	ANGLE		+	H. I. BEARING	VER. ANG. DIFF.	ELEVATION
		°	' "				
B.M.					4.88 38.03		33.15
A"						8.68	29.35
B.M.					4.88		33.15

FLOOR WELL #616  
 TOP WATER LINE

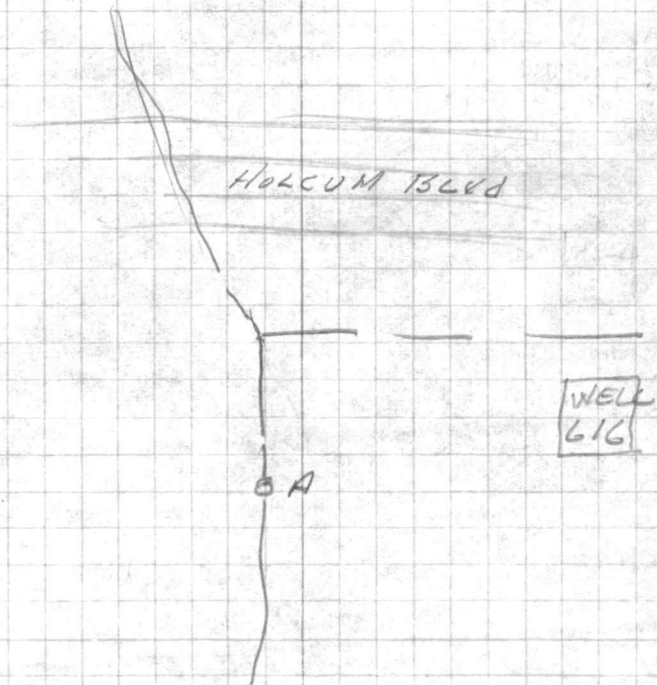








**VALUABLE**

SUBJECT \_\_\_\_\_  
 \_\_\_\_\_  
 \_\_\_\_\_  
 \_\_\_\_\_  
 \_\_\_\_\_

RETURN TO  
 PUBLIC WORKS  
 OFFICE  
 CAMP LEJEUNE  
 NORTH CAROLINA

**FIELD PARTY**

\_\_\_\_\_  
 IN CHARGE  
 \_\_\_\_\_  
 INSTRUMENT  
 \_\_\_\_\_  
 NOTES  
 \_\_\_\_\_  
 TAPE READ  
 \_\_\_\_\_  
 TAPE OR ROD  
 \_\_\_\_\_  
 TAPE OR ROD  
 \_\_\_\_\_  
 INSTRUMENT NO. \_\_\_\_\_  
 TAPE NO. \_\_\_\_\_

**WEATHER**

CLEAR  
 CLOUDY  
 WINDY  
 RAIN  
 FAIR

SNOW  
 HOT  
 MODERATE  
 COLD  
 FOG


FILE No. \_\_\_\_\_  
 FLDR. No. \_\_\_\_\_  
 SHEET \_\_\_\_\_  
 DATE \_\_\_\_\_ 19\_\_

FIGURED BY \_\_\_\_\_  
 NOTES CHECKED BY \_\_\_\_\_  
 PLOTTED BY \_\_\_\_\_  
 Quad. No. \_\_\_\_\_

STATION	DIST.	ANGLE		+	H. I. BEARING	VER. ANG. DIFF.	ELEVATION
		°	"				
B.M.					4.77 36.39		31.62
A						8.84	27.55
B						9.08	27.31
B.M.					4.77		

FLOOR WELL # 612

EARTH RD  
 TO HOLCCUM ISLUD →

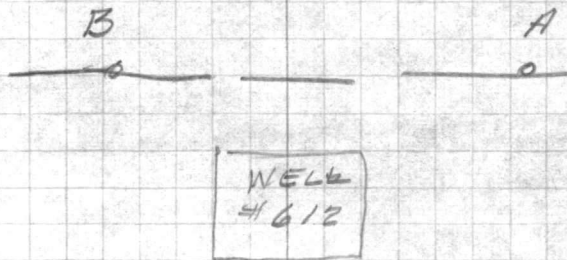








**VALUABLE**

SUBJECT \_\_\_\_\_  
\_\_\_\_\_  
\_\_\_\_\_  
RETURN TO  
PUBLIC WORKS  
OFFICE  
CAMP LEJEUNE  
NORTH CAROLINA

**FIELD PARTY**

\_\_\_\_\_  
IN CHARGE  
\_\_\_\_\_  
INSTRUMENT  
\_\_\_\_\_  
NOTES  
\_\_\_\_\_  
TAPE READ  
\_\_\_\_\_  
TAPE OR ROD  
\_\_\_\_\_  
TAPE OR ROD  
\_\_\_\_\_  
INSTRUMENT No.  
\_\_\_\_\_  
TAPE No.

**WEATHER**

CLEAR  
CLOUDY  
WINDY  
RAIN  
FAIR  
SNOW  
HOT  
MODERATE  
COLD  
FOG


FILE No. \_\_\_\_\_  
FLDR. No. \_\_\_\_\_  
SHEET \_\_\_\_\_  
DATE \_\_\_\_\_ 19\_\_

Quad. No. \_\_\_\_\_

STATION	DIST.	ANGLE ° ' "	+	H. I. BEARING	VER: ANG. DIFF.	ELEVATION
B.M.				4.8240.63		35.81
A					8.54	32.09
B					8.78	31.85
C					8.61	32.02
D						

FLOOR WELL # 618

TOP WATER LINE

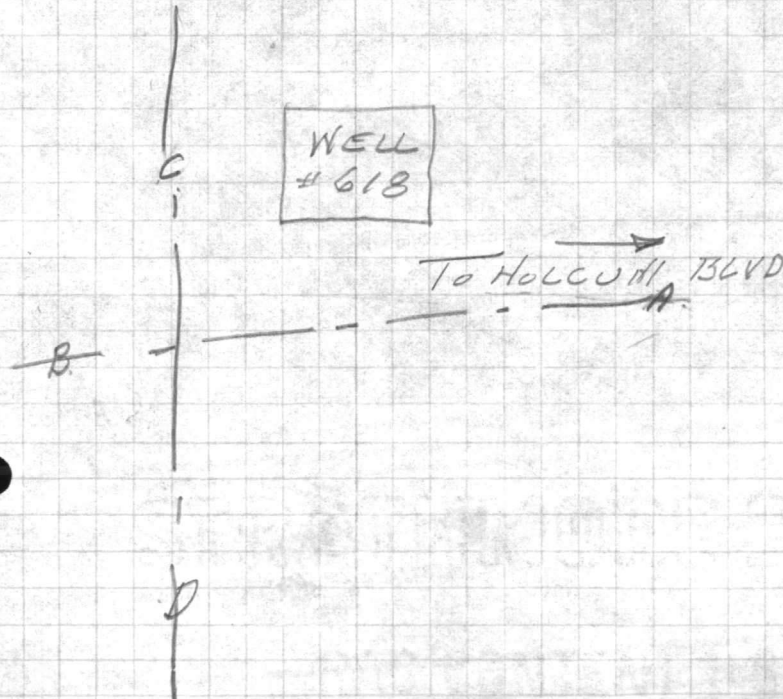























**VALUABLE**

SUBJECT \_\_\_\_\_  
 \_\_\_\_\_  
 \_\_\_\_\_  
 \_\_\_\_\_

RETURN TO  
 PUBLIC WORKS  
 OFFICE  
 CAMP LEJEUNE  
 NORTH CAROLINA

**FIELD PARTY**

\_\_\_\_\_  
 IN CHARGE  
 \_\_\_\_\_  
 INSTRUMENT  
 \_\_\_\_\_  
 NOTES  
 \_\_\_\_\_  
 TAPE READ  
 \_\_\_\_\_  
 TAPE OR ROD  
 \_\_\_\_\_  
 TAPE OR ROD  
 \_\_\_\_\_  
 INSTRUMENT NO. \_\_\_\_\_  
 TAPE NO. \_\_\_\_\_

**WEATHER**

CLEAR  
 CLOUDY  
 WINDY  
 RAIN  
 FAIR

SNOW  
 HOT  
 MODERATE  
 COLD  
 FOG

FILE No. \_\_\_\_\_  
 FLDR. No. \_\_\_\_\_  
 SHEET \_\_\_\_\_  
 DATE \_\_\_\_\_ 19\_\_

FIGURED BY \_\_\_\_\_  
 NOTES CHECKED BY \_\_\_\_\_  
 PLOTTED BY \_\_\_\_\_  
 Quad. No. \_\_\_\_\_

STATION	DIST.	ANGLE		+	H. I. BEARING	VER. ANG. DIFF.	ELEVATION
		°	' "				
B.M.					1.91 43.85		41.94
"A"						11.49	32.36
"B"						10.90	32.95
B.M.						1.91	

FLOOR WELL # 4007


WELL # 4006

WELL # 4007

A

B

N.C. # 24

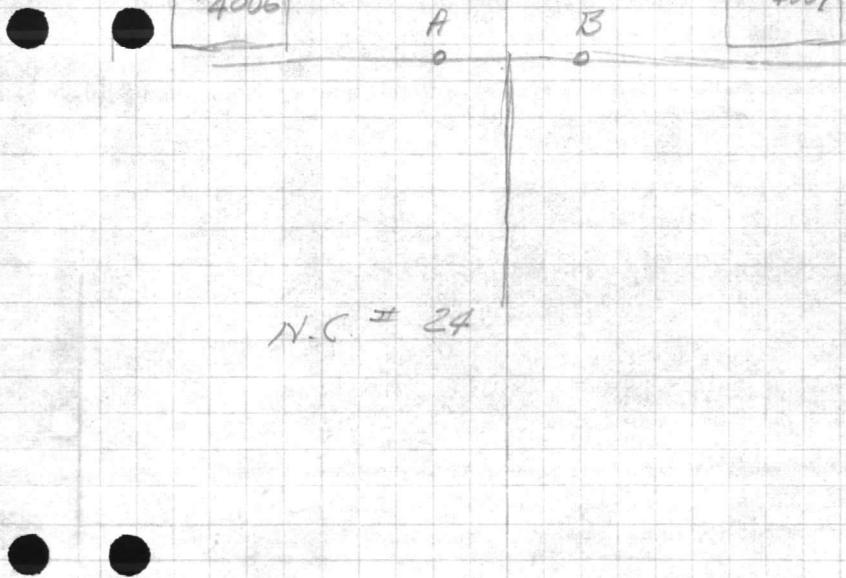






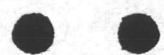



**VALUABLE**
 SUBJECT \_\_\_\_\_  
 \_\_\_\_\_  
 \_\_\_\_\_  
 \_\_\_\_\_  
 \_\_\_\_\_

 RETURN TO  
 PUBLIC WORKS  
 OFFICE  
 CAMP LEJEUNE  
 NORTH CAROLINA

## FIELD PARTY

 \_\_\_\_\_ IN CHARGE  
 \_\_\_\_\_ INSTRUMENT  
 \_\_\_\_\_ NOTES  
 \_\_\_\_\_ TAPE READ  
 \_\_\_\_\_ TAPE OR ROD  
 \_\_\_\_\_ TAPE OR ROD  
 \_\_\_\_\_ INSTRUMENT NO.  
 \_\_\_\_\_ TAPE NO.

## WEATHER

 CLEAR  
 CLOUDY  
 WINDY  
 RAIN  
 FAIR  
 SNOW  
 HOT  
 MODERATE  
 COLD  
 FOG

FILE No. \_\_\_\_\_

FLDR. No. \_\_\_\_\_

SHEET \_\_\_\_\_

NOTES CHECKED BY \_\_\_\_\_

PLOTTED BY \_\_\_\_\_ DATE \_\_\_\_\_ 19\_\_

Quad. No. \_\_\_\_\_

STATION	DIST.	ANGLE		+	H. I. BEARING	VER. ANG. DIFF.	ELEVATION
		°	' "				
B.M.				3.33	42.34		39.01
"A"						9.46	32.88
"B.M."						3.33	

B.M.

3.33 42.34

39.01

FLOOR WELL # 632


"A"

9.46 32.88

TOP WATER LINE

"B.M."

3.33

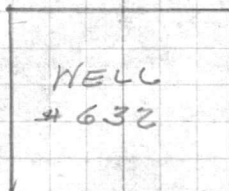WELL  
# 632

O.H.

 SNEADS FERRY RD  
 ← TO HADNOT PT.








**VALUABLE**
 SUBJECT \_\_\_\_\_  
 \_\_\_\_\_  
 \_\_\_\_\_  
 \_\_\_\_\_  
 \_\_\_\_\_

 RETURN TO  
 PUBLIC WORKS  
 OFFICE  
 CAMP LEJEUNE  
 NORTH CAROLINA

## FIELD PARTY

 \_\_\_\_\_ IN CHARGE  
 \_\_\_\_\_ INSTRUMENT  
 \_\_\_\_\_ NOTES  
 \_\_\_\_\_ TAPE READ  
 \_\_\_\_\_ TAPE OR ROD  
 \_\_\_\_\_ TAPE OR ROD  
 \_\_\_\_\_ INSTRUMENT NO.  
 \_\_\_\_\_ TAPE NO.

## WEATHER

 CLEAR  
 CLOUDY  
 WINDY  
 RAIN  
 FAIR  
 SNOW  
 HOT  
 MODERATE  
 COLD  
 FOG

 FILE No. \_\_\_\_\_  
 FLDR. No. \_\_\_\_\_  
 FIGURED BY \_\_\_\_\_ SHEET \_\_\_\_\_  
 NOTES CHECKED BY \_\_\_\_\_  
 PLOTTED BY \_\_\_\_\_ DATE \_\_\_\_\_ 19\_\_\_\_

Quad. No. \_\_\_\_\_

STATION	DIST.	ANGLE		+	H. I. BEARING	VER. ANG. DIFF.	ELEVATION
		°	' "				
B.M.					1.63 33.66		32.03

"A"						7.27	26.39
-----	--	--	--	--	--	------	-------

B.M.						1.63	
------	--	--	--	--	--	------	--

FLOOR WELL # 629

TOPWATER LINE

 WELL  
 # 629

 SHEADS FERRY RD  
 TO HADNOT PT.









**VALUABLE**

SUBJECT \_\_\_\_\_  
\_\_\_\_\_  
\_\_\_\_\_  
RETURN TO  
PUBLIC WORKS  
OFFICE  
CAMP LEJEUNE  
NORTH CAROLINA

**FIELD PARTY**

\_\_\_\_\_  
IN CHARGE  
\_\_\_\_\_  
INSTRUMENT  
\_\_\_\_\_  
NOTES  
\_\_\_\_\_  
TAPE READ  
\_\_\_\_\_  
TAPE OR ROD  
\_\_\_\_\_  
TAPE OR ROD  
\_\_\_\_\_  
INSTRUMENT NO.  
\_\_\_\_\_  
TAPE NO.

**WEATHER**

CLEAR  
CLOUDY  
WINDY  
RAIN  
FAIR  
SNOW  
HOT  
MODERATE  
COLD  
FOG

FILE No. \_\_\_\_\_  
FLDR. No. \_\_\_\_\_  
SHEET \_\_\_\_\_  
DATE \_\_\_\_\_ 19\_\_

FIGURED BY \_\_\_\_\_  
NOTES CHECKED BY \_\_\_\_\_  
PLOTTED BY \_\_\_\_\_  
Quad. No. \_\_\_\_\_

STATION	DIST.	ANGLE		+	H. I. BEARING	VER. ANG. DIFF.	ELEVATION
		°	' "				
B.M.					3.73 21.29		17.56

"A"						11.03	10.26
-----	--	--	--	--	--	-------	-------

B.M.						3.73	
------	--	--	--	--	--	------	--

FLOOR WELL #628  
TOP WATER LINE

WELL  
#628

14"

SHEEDS FERRY RD  
← TO HADNOT PT.






















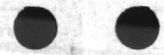



**VALUABLE**

SUBJECT \_\_\_\_\_

RETURN TO  
PUBLIC WORKS  
OFFICE  
CAMP LEJEUNE  
NORTH CAROLINA

**FIELD PARTY**

\_\_\_\_\_  
IN CHARGE  
\_\_\_\_\_  
INSTRUMENT  
\_\_\_\_\_  
NOTES  
\_\_\_\_\_  
TAPE READ  
\_\_\_\_\_  
TAPE OR ROD  
\_\_\_\_\_  
TAPE OR ROD  
\_\_\_\_\_  
INSTRUMENT NO.  
\_\_\_\_\_  
TAPE NO.

**WEATHER**

CLEAR  
CLOUDY  
WINDY  
RAIN  
FAIR  
SNOW  
HOT  
MODERATE  
COLD  
FOG

FILE No. \_\_\_\_\_

FLDR. No. \_\_\_\_\_

FIGURED BY \_\_\_\_\_ SHEET \_\_\_\_\_


NOTES CHECKED BY \_\_\_\_\_

PLOTTED BY \_\_\_\_\_ DATE \_\_\_\_\_ 19\_\_

Quad. No. \_\_\_\_\_

STATION	DIST.	ANGLE ° ' "	+	H. I. BEARING	VER. ANG. DIFF.	ELEVATION
B.M.				2.87 35.47		32.60
"A"	TOP WATERLINE				9.69	25.78
B.M.					2.87	

FLOOR WELL # 627

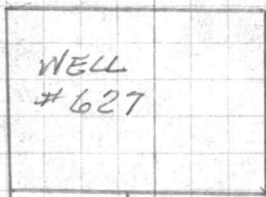

← SNEADS FERRY RD.  
TO HADNOT PT.








**VALUABLE**

SUBJECT \_\_\_\_\_  
 \_\_\_\_\_  
 \_\_\_\_\_  
 \_\_\_\_\_

RETURN TO  
 PUBLIC WORKS  
 OFFICE  
 CAMP LEJEUNE  
 NORTH CAROLINA

**FIELD PARTY**

\_\_\_\_\_  
 IN CHARGE  
 \_\_\_\_\_  
 INSTRUMENT  
 \_\_\_\_\_  
 NOTES  
 \_\_\_\_\_  
 TAPE READ  
 \_\_\_\_\_  
 TAPE OR ROD  
 \_\_\_\_\_  
 TAPE OR ROD  
 \_\_\_\_\_  
 INSTRUMENT NO. \_\_\_\_\_  
 TAPE NO. \_\_\_\_\_

**WEATHER**


CLEAR SNOW  
 CLOUDY HOT  
 WINDY MODERATE  
 RAIN COLD  
 FAIR FOG  
 FIGURED BY \_\_\_\_\_  
 NOTES CHECKED BY \_\_\_\_\_  
 PLOTTED BY \_\_\_\_\_

FILE No. \_\_\_\_\_  
 FLDR. No. \_\_\_\_\_  
 SHEET \_\_\_\_\_  
 DATE \_\_\_\_\_ 19\_\_

Quad. No. \_\_\_\_\_

STATION	DIST.	ANGLE			H. I. BEARING	VER. ANG. DIFF.	ELEVATION
		°	'	"			
B.M.				+	5.52 32.49	26.97	
"A"					11.58	20.91	
B.M.					5.52		

FLOOR WELL # ~~625~~ <sup>625</sup>  
 TOP WATER LINE

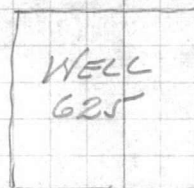

MAIN SERVICE RD  
 TO HAD NOT PT →









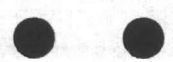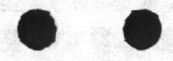

~~Elev~~ Elevations — Well Houses — Hadnot  
field collection area. 160-Gen.

Well #601 23.29  
✓ #602 25.17  
✓ #603 25.29  
✓ #604 32.11  
#605 - 30.62  
✓ #606 - 32.45 } ~~Sheet~~ #5 of 14  
✓ #608 30.32  
✓ #6247 ~~18.49~~ 18.49  
✓ #630 29.25

---

✓ #609 28.18  
✓ #625 26.97  
✓ #626 24.95  
✓ #627 32.60 } Sheet #6 of 14  
✓ #628 17.56  
✓ #629 32.03  
✓ #632 South of #629 New 39.01

---

#610 - 29.09  
✓ #631 } Sheet #11 of 14  
33.54  
#611 - 31.01  
~~?~~ } Sheet #4 of 14

Well #612 - 31.62  
#613 - 21.14  
#614 - 31.28  
#615 - 30.87  
#616 - 33.15  
#617 - 32.88  
W #618 - 35.81 } Sheet  
#619 - 29.91 #2 of 14  
#620 - 35.52  
#621 - 41.08  
#4006 - 32.88  
#4007 - 41.94


0830 1403  
0900  
Dillon  
Kellom

~~32~~ incl. 02322  
+ one on S.F. Rd.  
not shown

31

from  
2nd Topo Col  
in at 1:30

see

 



**VALUABLE**

SUBJECT FLOOR ELEV'S.  
WELL HOUSES

RETURN TO  
PUBLIC WORKS  
OFFICE  
CAMP LEJEUNE  
NORTH CAROLINA

**FIELD PARTY**

\_\_\_\_\_  
IN CHARGE  
\_\_\_\_\_  
INSTRUMENT  
\_\_\_\_\_  
NOTES  
\_\_\_\_\_  
TAPE READ  
\_\_\_\_\_  
TAPE OR ROD  
\_\_\_\_\_  
TAPE OR ROD  
\_\_\_\_\_  
INSTRUMENT NO.  
\_\_\_\_\_  
TAPE NO.

**WEATHER**

CLEAR  
CLOUDY  
WINDY  
RAIN  
FAIR  
SNOW  
HOT  
MODERATE  
COLD  
FOG

FILE No. \_\_\_\_\_  
FLDR. No. \_\_\_\_\_  
SHEET 105  
DATE \_\_\_\_\_ 19\_\_

Quad. No. \_\_\_\_\_

STATION	DIST.	ANGLE ° ' "	+	H. I. BEARING	VER. ANG. DIFF.	ELEVATION	
B.M.			3.59	27.51	✓	23.92	✓
						4.22	<u>23.29</u>
			3.59			23.92	
B.M.			4.57	30.43	✓	25.86	✓
						5.14	<u>25.29</u>
			4.57		✓		
B.M.			4.30	31.48	✓	27.18	✓
						6.31	<u>25.17</u>
			4.30		✓		
B.M.			8.55	34.26		25.71	✓
						2.15	<u>32.11</u>
			8.55		✓		
B.M.			1.86	36.00		34.14	✓
						2.46	<u>33.54</u>
			1.86		✓		

Int. Holcum Blvd. of Dogwood St.  
Floor Well House # 601

Int. Holcum Blvd of Gum St.  
Floor Well House # 603

Int. Holcum Blvd of Ash St.  
House  
Floor Well # 602

Spike in power pole # A.F. # 25' North  
Bldg # 742  
Floor Well House # 604

Nail in 14" pine 50' North Well # 631  
Floor Well House # 631





































**VALUABLE**

SUBJECT \_\_\_\_\_  
 \_\_\_\_\_  
 \_\_\_\_\_  
 \_\_\_\_\_

RETURN TO  
 PUBLIC WORKS  
 OFFICE  
 CAMP LEJEUNE  
 NORTH CAROLINA

**FIELD PARTY**

\_\_\_\_\_  
 IN CHARGE  
 \_\_\_\_\_  
 INSTRUMENT  
 \_\_\_\_\_  
 NOTES  
 \_\_\_\_\_  
 TAPE READ  
 \_\_\_\_\_  
 TAPE OR ROD  
 \_\_\_\_\_  
 TAPE OR ROD  
 \_\_\_\_\_  
 INSTRUMENT NO. \_\_\_\_\_  
 TAPE NO. \_\_\_\_\_

**WEATHER**

CLEAR  
 CLOUDY  
 WINDY  
 RAIN  
 FAIR


SNOW  
 HOT  
 MODERATE  
 COLD  
 FOG

FILE No. \_\_\_\_\_  
 FLDR. No. \_\_\_\_\_  
 SHEET 2 of  
 DATE \_\_\_\_\_ 19\_\_

FIGURED BY \_\_\_\_\_  
 NOTES CHECKED BY \_\_\_\_\_  
 PLOTTED BY \_\_\_\_\_  
 Quad. No. \_\_\_\_\_

STATION	DIST.	ANGLE		+	H. I. BEARING	VER. ANG. DIFF.	ELEVATION	
		°	' "					
B.M.					3.27 32.77 ✓		29.50 ✓	Nail in power pole # 5-52 North Transformer along Sneads Ferry Rd.
TP.					4.87 27.90 ✓			
					4.59 32.49 ✓			
TP.					3.14 29.35 ✓			
					5.76 35.11 ✓			
TP.					2.67 <del>32.44</del> <sup>32.45</sup> ✓			Floor Well House # 606
					2.54 34.92 ✓			
TP.					6.19 28.79 ✓			
					3.31 32.10 ✓			
TP.					4.24 27.86 ✓			
					5.03 32.89 ✓			
B.M.					3.41 29.48 ✓		(29.50)	
B.M.					3.51 33.17 ✓		29.66	On 24" oak 100' East Int. Main Service of Sneads Ferry Rd.
TP.					6.15 27.02 ✓ .01			
					5.26 32.28 ✓			
TP.					3.40 28.88 ✓ .02			



 

**VALUABLE**
 SUBJECT \_\_\_\_\_  
 \_\_\_\_\_  
 \_\_\_\_\_  
 \_\_\_\_\_  
 \_\_\_\_\_

 RETURN TO  
 PUBLIC WORKS  
 OFFICE  
 CAMP LEJEUNE  
 NORTH CAROLINA
**FIELD PARTY**
 \_\_\_\_\_ IN CHARGE  
 \_\_\_\_\_ INSTRUMENT  
 \_\_\_\_\_ NOTES  
 \_\_\_\_\_ TAPE READ  
 \_\_\_\_\_ TAPE OR ROD  
 \_\_\_\_\_ TAPE OR ROD  
 \_\_\_\_\_ INSTRUMENT NO.  
 \_\_\_\_\_ TAPE NO.
**WEATHER**
 CLEAR \_\_\_\_\_ SNOW \_\_\_\_\_  
 CLOUDY \_\_\_\_\_ HOT \_\_\_\_\_  
 WINDY \_\_\_\_\_ MODERATE \_\_\_\_\_  
 RAIN \_\_\_\_\_ COLD \_\_\_\_\_  
 FAIR \_\_\_\_\_ FOG \_\_\_\_\_

 FILE No. \_\_\_\_\_  
 FLDR. No. \_\_\_\_\_  
 SHEET 30f  
 DATE \_\_\_\_\_ 19\_\_\_\_  
 FIGURED BY \_\_\_\_\_  
 NOTES CHECKED BY \_\_\_\_\_  
 PLOTTED BY \_\_\_\_\_

Quad. No. \_\_\_\_\_

STATION	DIST.	ANGLE		+	H. I. BEARING	VER: ANG. DIFF.	ELEVATION	
		°	' "					
							28.88	02
	5.25	34.13		✓				
TP					4.00	30.13	✓	03
	4.13	34.26		✓				
TP					4.57	29.69	✓	04
	1.61	31.30		✓				
TP					4.16	27.14	✓	05
	3.79	30.93		✓				
TP					2.81	<del>28.16</del> <sup>28.18</sup>	✓	06
	2.18	30.30		✓				
TP					1.72	28.58		07
	5.76	34.34						
TP					4.59	29.75	✓	08
	4.70	34.45		✓				
TP					4.87	29.58	✓	09
	3.50	33.10		✓				
TP					6.00	27.10		"
	5.65	32.75						
B.M.					3.20	29.55		"
							(29.66)	

Floor Well House # 609








**VALUABLE**
 SUBJECT \_\_\_\_\_  
 \_\_\_\_\_  
 \_\_\_\_\_  
 \_\_\_\_\_  
 \_\_\_\_\_

 RETURN TO  
 PUBLIC WORKS  
 OFFICE  
 CAMP LEJEUNE  
 NORTH CAROLINA

## FIELD PARTY

 \_\_\_\_\_ IN CHARGE  
 \_\_\_\_\_ INSTRUMENT  
 \_\_\_\_\_ NOTES  
 \_\_\_\_\_ TAPE READ  
 \_\_\_\_\_ TAPE OR ROD  
 \_\_\_\_\_ TAPE OR ROD  
 \_\_\_\_\_ INSTRUMENT NO.  
 \_\_\_\_\_ TAPE NO.

## WEATHER

 CLEAR  
 CLOUDY  
 WINDY  
 RAIN  
 FAIR  
 SNOW  
 HOT  
 MODERATE  
 COLD  
 FOG

 FILE No. \_\_\_\_\_  
 FLDR. No. \_\_\_\_\_  
 SHEET 4 of \_\_\_\_\_  
 DATE \_\_\_\_\_ 19\_\_\_\_

 FIGURED BY \_\_\_\_\_  
 NOTES CHECKED BY \_\_\_\_\_  
 PLOTTED BY \_\_\_\_\_  
 Quad. No. \_\_\_\_\_

STATION	DIST.	ANGLE		+	H. I. BEARING	VER. ANG. DIFF.	ELEVATION	
		°	' "					
B.M.					3.59 33.25 ✓		29.66 ✓	on 24" oak 100' East Int. Sneads Ferry & Main Service Rd's.
T.P.					2.15 31.08 ✓	4.32	28.93 ✓	
T.P.						6.09 <del>24.99</del> <sup>24.98</sup> (626)		* Floor Well House # 626
T.P.					5.78 30.77 ✓	2.38	28.39 ✓	
B.M.					4.15 32.54	2.85	29.69 ✓	(29.66)
B.M.					0.32 34.88 ✓		34.56 ✓	Cor. Ramp Bldg # 5A-3
T.P.						2.27 <del>32.61</del> <sup>32.60</sup>		Floor Well House # 627
					2.46 35.07 ✓			
B.M.						0.99 34.58 ✓		(34.56)
B.M.					0.28 <del>17.00</del> <sup>17.00</sup> (17.03)		16.75 ✓	Nail Int. Yirhue & Sneads Ferry Rds
T.P.						9.98 7.0X <sup>7.05</sup>		
T.P.					6.13 <del>13.17</del> <sup>13.18</sup> +3.18 (11.47)		11.47	
T.P.					8.06 <del>19.5X</del> <sup>19.53</sup> 91.71 11.47			
T.P.						1.98 <del>17.67</del> <sup>17.56</sup> (17.55)		Floor Well House # 628
					<del>1.37 17.66</del>			








**VALUABLE**

SUBJECT \_\_\_\_\_  
 \_\_\_\_\_  
 \_\_\_\_\_  
 \_\_\_\_\_

RETURN TO  
 PUBLIC WORKS  
 OFFICE  
 CAMP LEJEUNE  
 NORTH CAROLINA

**FIELD PARTY**

\_\_\_\_\_  
 IN CHARGE  
 \_\_\_\_\_  
 INSTRUMENT  
 \_\_\_\_\_  
 NOTES  
 \_\_\_\_\_  
 TAPE READ  
 \_\_\_\_\_  
 TAPE OR ROD  
 \_\_\_\_\_  
 TAPE OR ROD  
 \_\_\_\_\_  
 INSTRUMENT NO. \_\_\_\_\_  
 TAPE NO. \_\_\_\_\_

**WEATHER**

CLEAR  
 CLOUDY  
 WINDY  
 RAIN  
 FAIR

SNOW  
 HOT  
 MODERATE  
 COLD  
 FOG

FILE No. \_\_\_\_\_  
 FLDR. No. \_\_\_\_\_  
 SHEET 50f  
 DATE \_\_\_\_\_ 19\_\_

FIGURED BY \_\_\_\_\_  
 NOTES CHECKED BY \_\_\_\_\_  
 PLOTTED BY \_\_\_\_\_

STATION	DIST.	ANGLE ° ' "	+	H. I. BEARING	VER: ANG. DIFF.	ELEVATION
				(18.66) 3		17.65 (17.55)
#		1.11		18.74		9.74 (9.66)
#		1.85		(11.51) 58 11.44	9.00	8.27 (8.13)
B.M.		9.75		17.94	3.38	16.83 (16.73)
B.M.		4.36		(17.88) 34.66	1.15	30.30
TP		2.60		34.63	2.63	32.03
B.M.		3.27		40.33	4.34	30.29
TP		1.24		40.25	2.63	39.01
B.M.		4.03		35.85	3.18	37.07
TP		4.81		36.71	3.95	31.90
TP		7.45		40.59	3.57	33.14
TP		1.93		38.26	4.26	36.33
TP		2.96		33.05	8.17	30.09
TP		6.56		33.53	6.08	26.97

(16.75)  
 Spike in power pole #5-141  
 Floor Well House #629  
 (30.30)  
 Nail in power pole #5-152  
 Floor Well House #632  
 (37.06)  
 Spike in power pole #5.F.4.  
 Floor Well House #625



29.02

5.24

34.26

3.94

30.32

3.88

34.20

5.18

29.02



**VALUABLE**

SUBJECT \_\_\_\_\_  
 \_\_\_\_\_  
 \_\_\_\_\_  
 \_\_\_\_\_  
 \_\_\_\_\_

RETURN TO  
 PUBLIC WORKS  
 OFFICE  
 CAMP LEJEUNE  
 NORTH CAROLINA

**FIELD PARTY**

\_\_\_\_\_  
 IN CHARGE  
 \_\_\_\_\_  
 INSTRUMENT  
 \_\_\_\_\_  
 NOTES  
 \_\_\_\_\_  
 TAPE READ  
 \_\_\_\_\_  
 TAPE OR ROD  
 \_\_\_\_\_  
 INSTRUMENT NO. \_\_\_\_\_  
 TAPE NO. \_\_\_\_\_

**WEATHER**

CLEAR \_\_\_\_\_  
 CLOUDY \_\_\_\_\_  
 WINDY \_\_\_\_\_  
 RAIN \_\_\_\_\_  
 FAIR \_\_\_\_\_  
 SNOW \_\_\_\_\_  
 HOT \_\_\_\_\_  
 MODERATE \_\_\_\_\_  
 COLD \_\_\_\_\_  
 FOG \_\_\_\_\_

FILE No. \_\_\_\_\_  
 FLDR. No. \_\_\_\_\_  
 SHEET 60F  
 DATE \_\_\_\_\_ 19\_\_

Quad. No. \_\_\_\_\_

STATION	DIST.	ANGLE		+	H. I. BEARING	VER. ANG. DIFF.	ELEVATION	
		°	' "					
					33.53 ✓		31.63 ✓	
TP					40.14 ✓	1.90	<del>32.73</del> 36.53 ✓	
TP	8.53				<del>38</del> 36 ✓	3.63	<del>37.53</del>	
	1.83				35 ✓	5.96	32. ✓	
TP					<del>36</del> 39 ✓		<del>32.40</del>	
B.M.	3.49					4.07	31. ✓	( <del>31.82</del> )
							<del>31.82</del>	31.82 ✓
B.M.	5.24				34. <sup>26</sup> ✓		29.02 ✓	
TP						3.94	30.33 ✓	Int. Gum St. of <del>the</del> Michael St. Floor Well House # 608
B.M.	3.88				34.2 <sup>0</sup> ✓		29.0 <sup>2</sup> ✓	( <del>29.06</del> )
						5.18	29.0 <sup>2</sup> ✓	
B.M.	4.23				34.68 ✓		28.45 ✓	Int. Louis of Birch St. <sup>s</sup>
TP						5.43	29.25 ✓	Floor Well House # 630
	5.16				34.41 ✓		29.25 ✓	
B.M.						5.96	28.45 ✓	(28.45)
B.M.	1.32				26.9 <sup>4</sup> ✓		25. <sup>62</sup> ✓	Q. Door West End Butler Bldg # 439
TP					<del>27.75</del>		<del>25.81</del>	
TP	5.53				23.81 ✓	8.60	18. <sup>34</sup> ✓	
					<del>27.06</del>		18.49 ✓	
TP	5.25				3.72 ✓	5.38	<del>17.8</del> 18.69 ✓	Floor Well House # 624
TP					<del>24.75</del>		17.92 ✓	
					27.07 ✓	5.80	18.13 ✓	
B.M.	9.15				<del>28.28</del>		25.58 ✓	(25.81) (25.62)
						1.49	<del>25.79</del>	



























452409



**VALUABLE**

SUBJECT \_\_\_\_\_  
 \_\_\_\_\_  
 \_\_\_\_\_  
 RETURN TO  
 PUBLIC WORKS  
 OFFICE  
 CAMP LEJEUNE  
 NORTH CAROLINA

**FIELD PARTY**

IN CHARGE \_\_\_\_\_  
 INSTRUMENT \_\_\_\_\_  
 NOTES \_\_\_\_\_  
 TAPE READ \_\_\_\_\_  
 TAPE OR ROD \_\_\_\_\_  
 TAPE OR ROD \_\_\_\_\_  
 INSTRUMENT NO. \_\_\_\_\_  
 TAPE NO. \_\_\_\_\_

**WEATHER**


CLEAR \_\_\_\_\_  
 CLOUDY \_\_\_\_\_  
 WINDY \_\_\_\_\_  
 RAIN \_\_\_\_\_  
 FAIR \_\_\_\_\_  
 SNOW \_\_\_\_\_  
 HOT \_\_\_\_\_  
 MODERATE \_\_\_\_\_  
 COLD \_\_\_\_\_  
 FOG \_\_\_\_\_

FILE No. \_\_\_\_\_  
 FLDR. No. \_\_\_\_\_  
 SHEET \_\_\_\_\_  
 DATE \_\_\_\_\_ 19\_\_

FIGURED BY \_\_\_\_\_  
 NOTES CHECKED BY \_\_\_\_\_  
 PLOTTED BY \_\_\_\_\_  
 Quad. No. \_\_\_\_\_

STATION	DIST.	ANGLE		+	H. I. BEARING	VER. ANG. DIFF.	ELEVATION
		°	' "				
B.M.					2.73 32.39		29.66
A	TOPWATER LINE					7.98	24.41
B	" "					7.82	24.57
C	" "					7.69	24.70
B.M.						2.73	

ON 24" OAK 100' RT. INT. MAIN SERVICE RD  
 SNEADS FERRY RD.

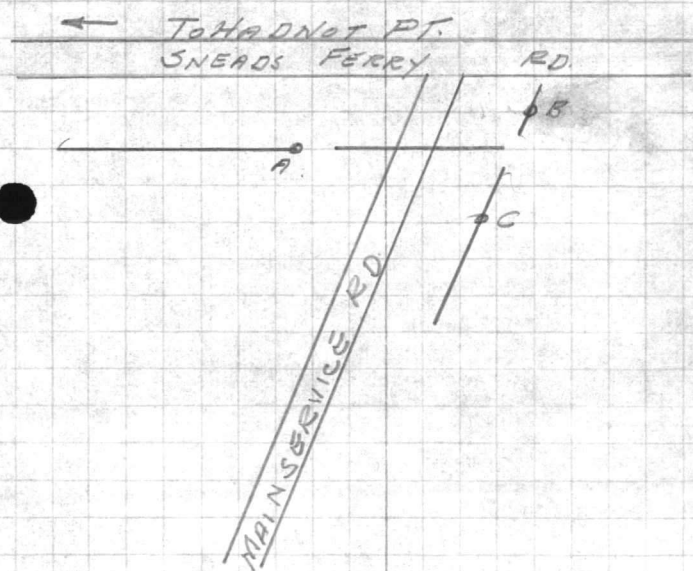






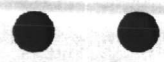

**VALUABLE**
 SUBJECT \_\_\_\_\_  
 \_\_\_\_\_  
 \_\_\_\_\_  
 RETURN TO  
 PUBLIC WORKS  
 OFFICE  
 CAMP LEJEUNE  
 NORTH CAROLINA

## FIELD PARTY

 \_\_\_\_\_ IN CHARGE  
 \_\_\_\_\_ INSTRUMENT  
 \_\_\_\_\_ NOTES  
 \_\_\_\_\_ TAPE READ  
 \_\_\_\_\_ TAPE OR ROD  
 \_\_\_\_\_ TAPE OR ROD  
 \_\_\_\_\_ INSTRUMENT NO.  
 \_\_\_\_\_ TAPE NO.

## WEATHER

 CLEAR  
 CLOUDY  
 WINDY  
 RAIN  
 FAIR  
 SNOW  
 HOT  
 MODERATE  
 COLD  
 FOG


 FILE No. \_\_\_\_\_  
 FLDR. No. \_\_\_\_\_  
 FIGURED BY \_\_\_\_\_ SHEET \_\_\_\_\_  
 NOTES CHECKED BY \_\_\_\_\_  
 PLOTTED BY \_\_\_\_\_ DATE \_\_\_\_\_ 19\_\_\_\_

Quad. No. \_\_\_\_\_

STATION	DIST.	ANGLE			H. I. BEARING	VER. ANG. DIFF.	ELEVATION
		°	'	"			
B.M.				+	27.30		24.98
						5.68	21.62
B.M.						2.32	

 626  
 FLOOR WELL #625

TOP WATER LINE

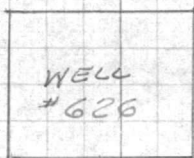
 SNEADS FERRY Rd.  
 TO HADNOT PT





























