

LYMAN Rd.

Topo -

Profile



**VALUABLE**

SUBJECT

Telex Landing  
 Excl -  
 Lyman Rd.

RETURN TO  
 PUBLIC WORKS  
 OFFICE  
 CAMP LEJEUNE  
 NORTH CAROLINA

FIELD PARTY

Morton  
 IN CHARGE  
 INSTRUMENT  
 NOTES  
 TAPE READ  
 TAPE OR ROD  
 TAPE OR ROD  
 INSTRUMENT NO.  
 TAPE NO.

WEATHER

CLEAR  
 CLOUDY  
 WINDY  
 RAIN  
 FAIR  
 SNOW  
 HOT  
 MODERATE  
 COLD  
 FOG

FILE No.

160-D

FLDR. No.

SHEET

1 of


DATE

3/27

1957

Quad. No.

STATION	DIST.	ANGLE ° ' "	H. I. BEARING	VER: ANG. DIFF.	ELEVATION
---------	-------	----------------	------------------	--------------------	-----------

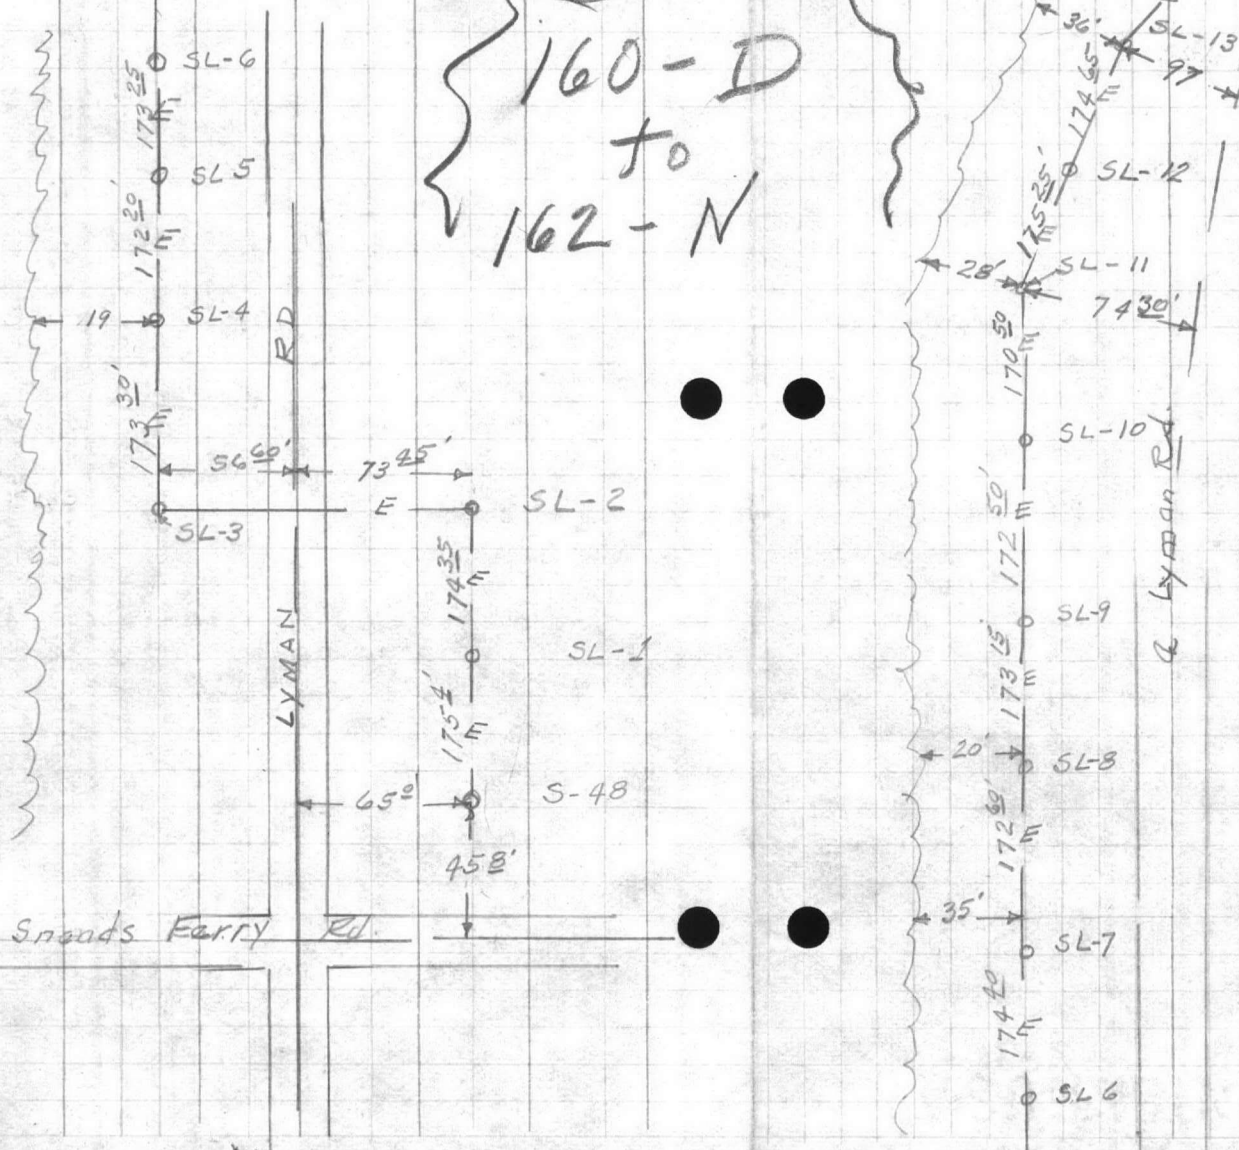






**VALUABLE**

SUBJECT \_\_\_\_\_

RETURN TO  
PUBLIC WORKS  
OFFICE  
CAMP LEJEUNE,  
NORTH CAROLINA

**FIELD PARTY**

\_\_\_\_\_  
IN CHARGE  
\_\_\_\_\_  
INSTRUMENT  
\_\_\_\_\_  
NOTES  
\_\_\_\_\_  
TAPE READ  
\_\_\_\_\_  
TAPE OR ROD  
\_\_\_\_\_  
TAPE OR ROD  
\_\_\_\_\_  
INSTRUMENT No.  
\_\_\_\_\_  
TAPE No.

**WEATHER**

CLEAR  
CLOUDY  
WINDY  
RAIN  
FAIR  
SNOW  
HOT  
MODERATE  
COLD  
FOG

FILE No. \_\_\_\_\_


FLDR. No. \_\_\_\_\_

SHEET *2 of*

DATE *3/27* 19*57*

Quad. No. \_\_\_\_\_

STATION	DIST.	ANGLE ° ' "	+	H. I. BEARING	VER: ANG. DIFF.	ELEVATION
---------	-------	----------------	---	------------------	--------------------	-----------

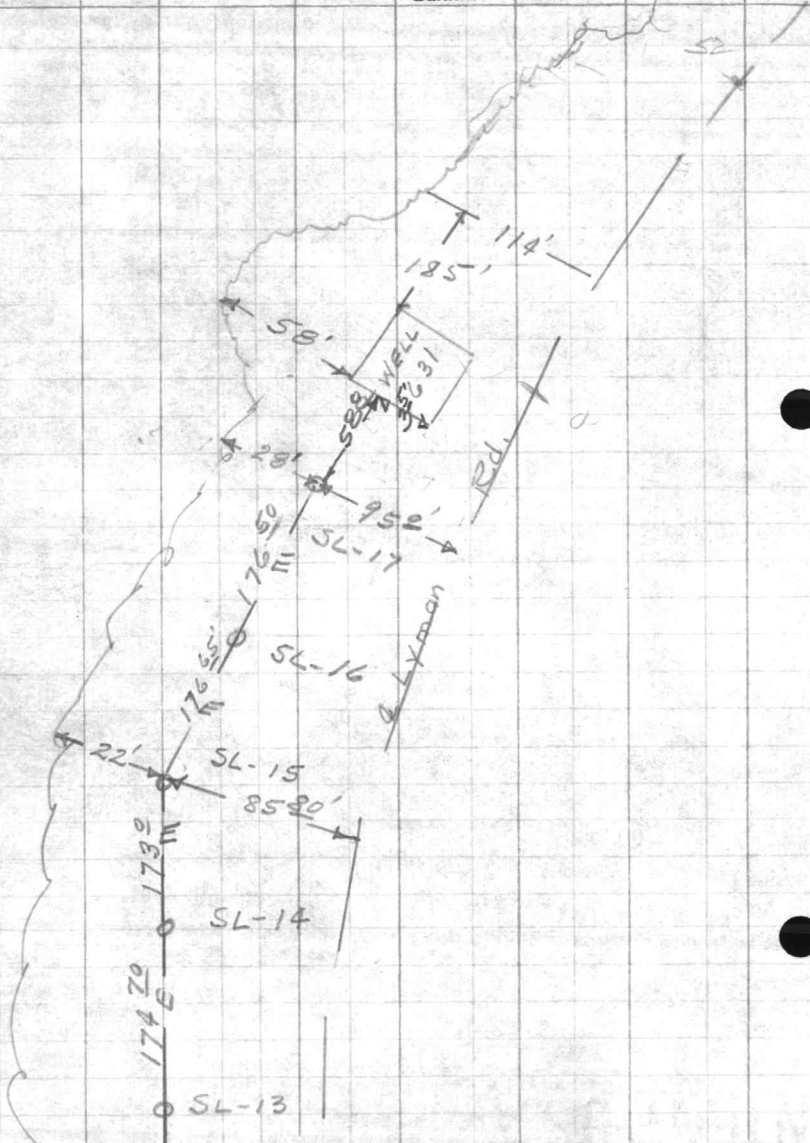

Well  
631

*0+0*



























**VALUABLE**

SUBJECT \_\_\_\_\_  
 \_\_\_\_\_  
 \_\_\_\_\_  
 \_\_\_\_\_

RETURN TO  
 PUBLIC WORKS  
 OFFICE  
 CAMP LEJEUNE,  
 NORTH CAROLINA

**FIELD PARTY**

\_\_\_\_\_  
 IN CHARGE  
 \_\_\_\_\_  
 INSTRUMENT  
 \_\_\_\_\_  
 NOTES  
 \_\_\_\_\_  
 TAPE READ  
 \_\_\_\_\_  
 TAPE OR ROD  
 \_\_\_\_\_  
 TAPE OR ROD  
 \_\_\_\_\_  
 INSTRUMENT NO. \_\_\_\_\_  
 TAPE NO. \_\_\_\_\_

**WEATHER**

CLEAR  
 CLOUDY  
 WINDY  
 RAIN  
 FAIR  
 SNOW  
 HOT  
 MODERATE  
 COLD  
 FOG  
 FIGURED BY \_\_\_\_\_  
 NOTES CHECKED BY \_\_\_\_\_  
 PLOTTED BY \_\_\_\_\_

FILE No. \_\_\_\_\_


FLDR. No. \_\_\_\_\_

SHEET 30f

DATE 3/27 1957

Quad. No. \_\_\_\_\_

STATION	DIST.	ANGLE		+	H. I. BEARING	VER. ANG. DIFF.	ELEVATION
		°	' "				

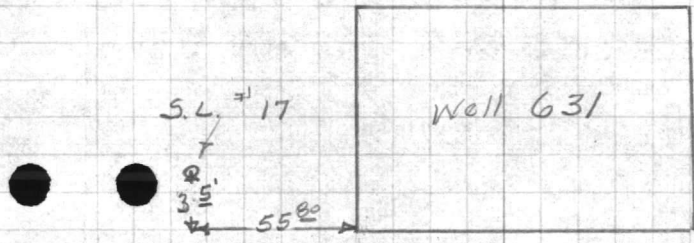

Lyman Rd.









**VALUABLE**

SUBJECT \_\_\_\_\_

RETURN TO  
PUBLIC WORKS  
OFFICE  
CAMP LEJEUNE  
NORTH CAROLINA

**FIELD PARTY**

\_\_\_\_\_  
IN CHARGE  
\_\_\_\_\_  
INSTRUMENT  
\_\_\_\_\_  
NOTES  
\_\_\_\_\_  
TAPE READ  
\_\_\_\_\_  
TAPE OR ROD  
\_\_\_\_\_  
TAPE OR ROD  
\_\_\_\_\_  
INSTRUMENT NO.  
\_\_\_\_\_  
TAPE NO.

**WEATHER**

CLEAR  
CLOUDY  
WINDY  
RAIN  
FAIR  
SNOW  
HOT  
MODERATE  
COLD  
FOG  
FIGURED BY \_\_\_\_\_  
NOTES CHECKED BY \_\_\_\_\_  
PLOTTED BY \_\_\_\_\_

FILE No. \_\_\_\_\_

FLDR. No. \_\_\_\_\_


SHEET 40f

DATE 3/28 1957


Quad. No. \_\_\_\_\_

STATION	DIST.	ANGLE " +	H. I. BEARING	VER: ANG. DIFF.	ELEVATION
---------	-------	--------------	------------------	--------------------	-----------

*Lyman Rd.*

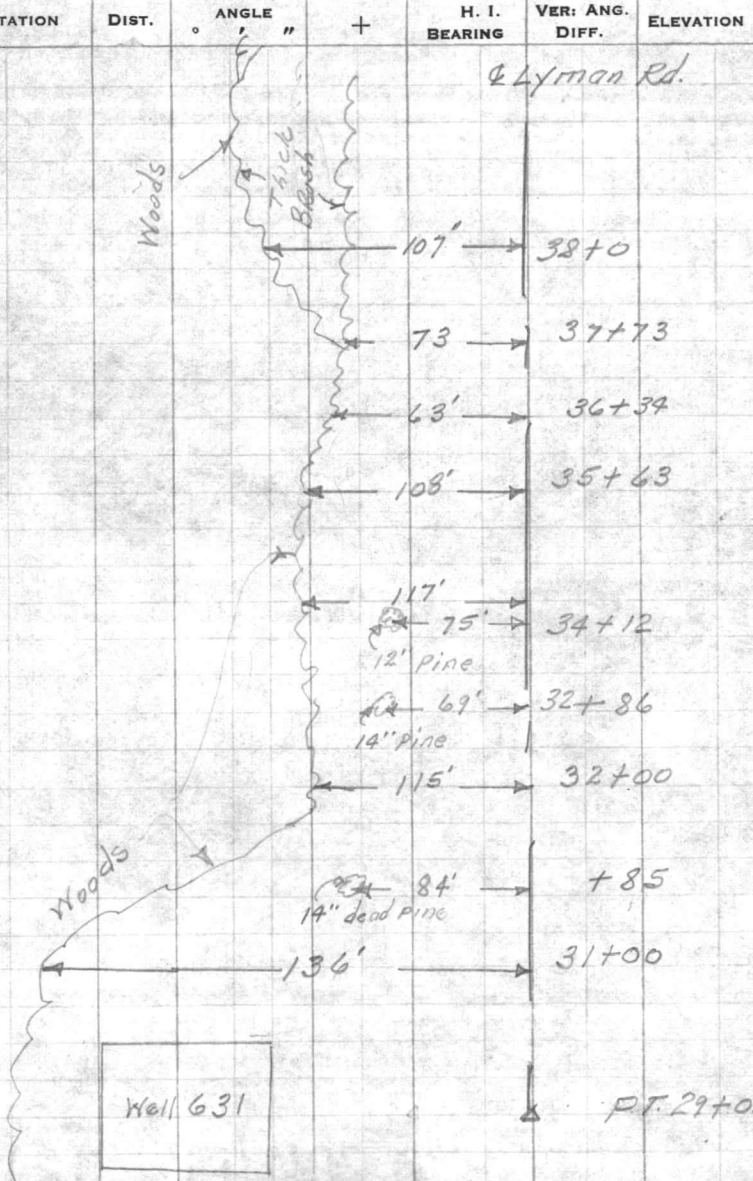

*E Rd.*

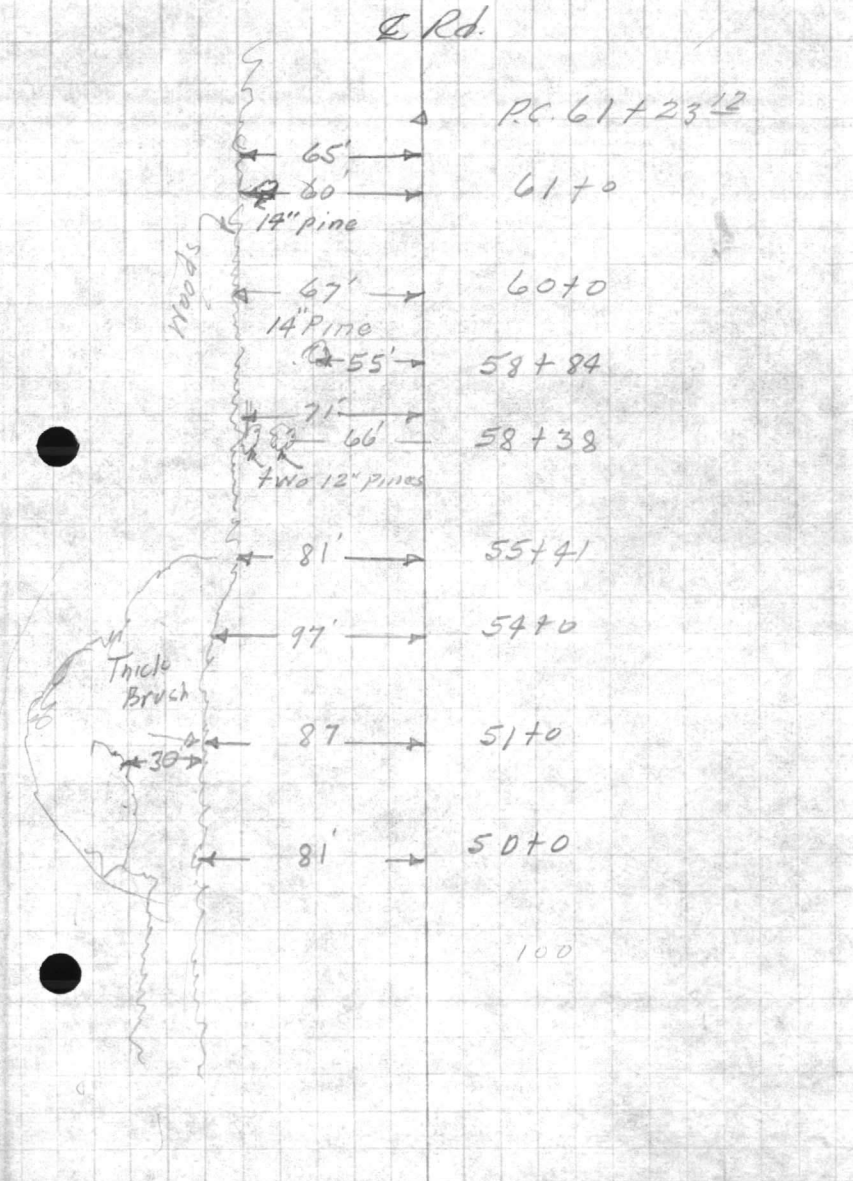

*PT. 29+03.74*























**VALUABLE**

SUBJECT \_\_\_\_\_  
 \_\_\_\_\_  
 \_\_\_\_\_  
 RETURN TO  
 PUBLIC WORKS  
 OFFICE  
 CAMP. LEJEUNE  
 NORTH CAROLINA

**FIELD PARTY**

\_\_\_\_\_  
 IN CHARGE  
 \_\_\_\_\_  
 INSTRUMENT  
 \_\_\_\_\_  
 NOTES  
 \_\_\_\_\_  
 TAPE READ  
 \_\_\_\_\_  
 TAPE OR ROD  
 \_\_\_\_\_  
 TAPE OR ROD  
 \_\_\_\_\_  
 INSTRUMENT No. \_\_\_\_\_  
 TAPE No. \_\_\_\_\_


**WEATHER**

CLEAR  
 CLOUDY  
 WINDY  
 RAIN  
 FAIR  
 SNOW  
 HOT  
 MODERATE  
 COLD  
 FOG  
 FIGURED BY \_\_\_\_\_  
 NOTES CHECKED BY \_\_\_\_\_  
 PLOTTED BY \_\_\_\_\_

FILE No. \_\_\_\_\_  
 FLDR. No. \_\_\_\_\_  
 SHEET 50f  
 DATE \_\_\_\_\_ 19\_\_

Quad. No. \_\_\_\_\_

STATION	DIST.	ANGLE ° ' "	+	H. I. BEARING	VER: ANG. DIFF.	ELEVATION
---------	-------	----------------	---	------------------	--------------------	-----------

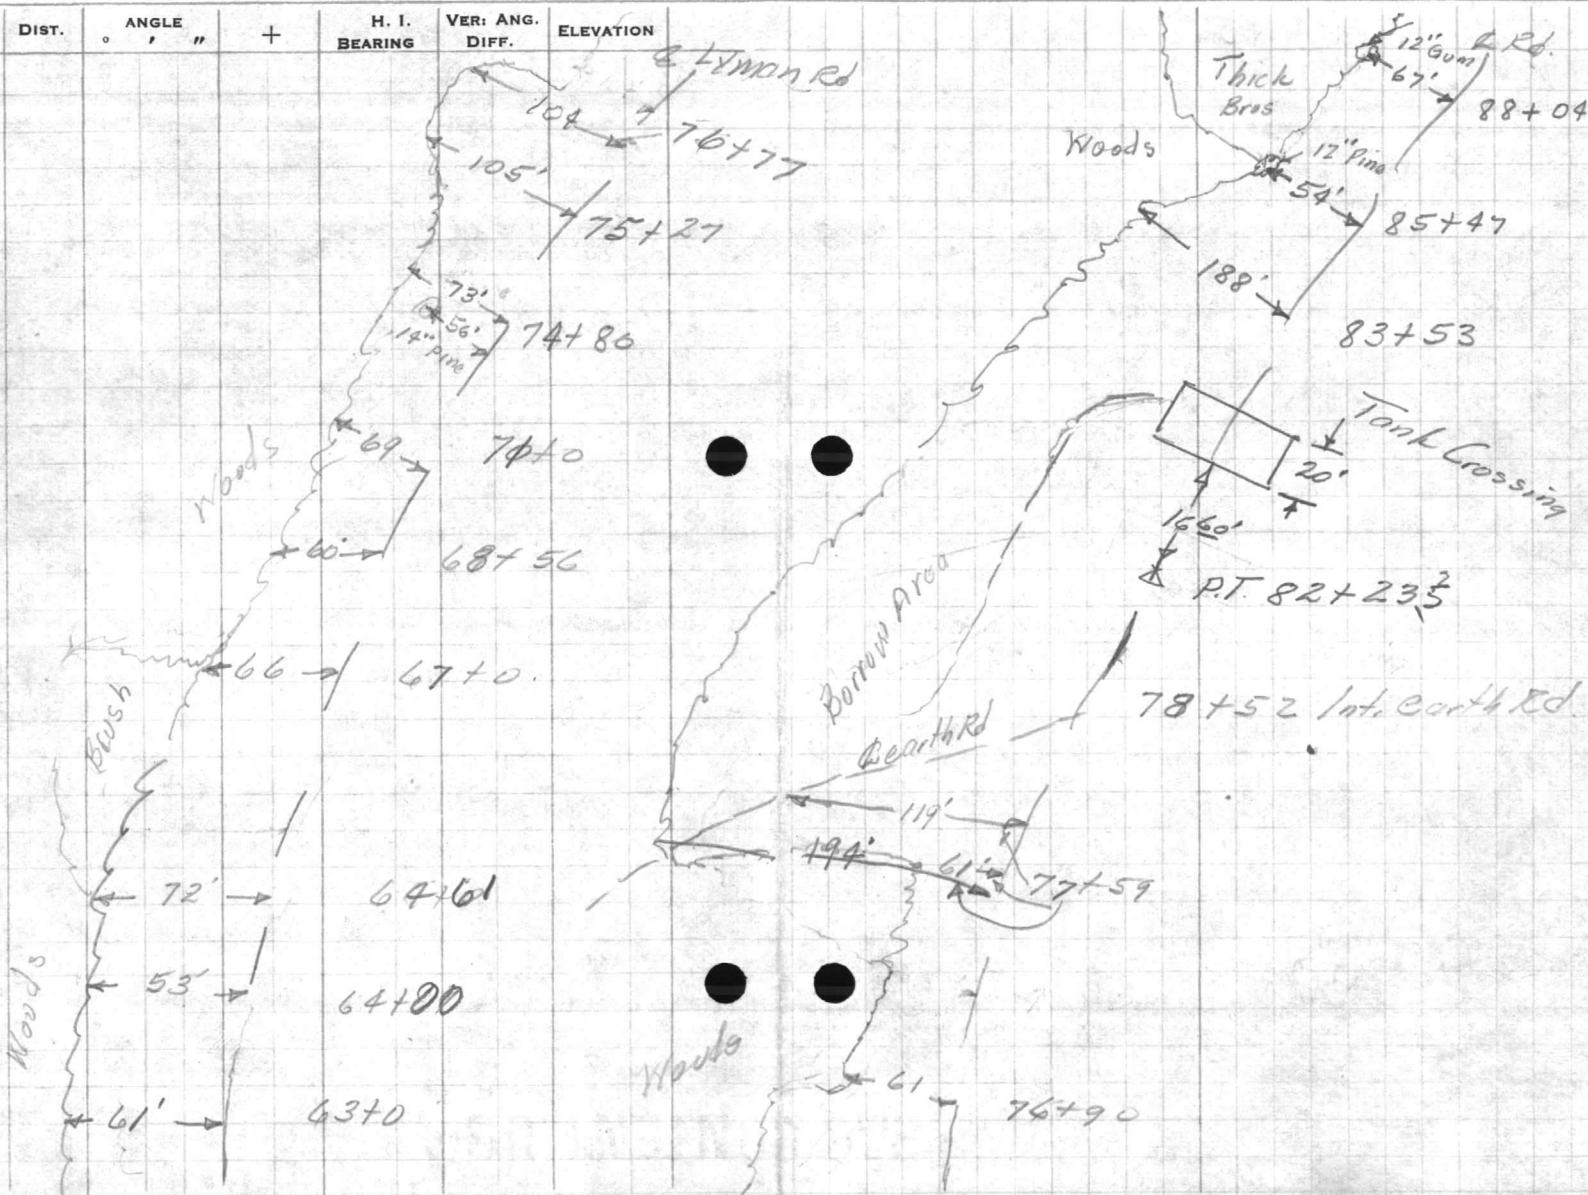











**VALUABLE**

RETURN TO,  
PUBLIC WORKS  
OFFICE  
CAMP LEJEUNE  
NORTH CAROLINA

SUBJECT PROFILE ON LYMAN  
R.D. FOR TELEPHONE  
LINE  
Profile TAKEN 60'  
Left of E Road.

FIELD PARTY  
\_\_\_\_ IN CHARGE  
\_\_\_\_ INSTRUMENT  
\_\_\_\_ NOTES  
\_\_\_\_ TAPE READ  
\_\_\_\_ TAPE OR ROD  
\_\_\_\_ TAPE OR ROD  
\_\_\_\_ INSTRUMENT NO.  
\_\_\_\_ TAPE NO.

WEATHER  
CLEAR \_\_\_\_\_  
CLOUDY \_\_\_\_\_  
WINDY \_\_\_\_\_  
RAIN \_\_\_\_\_  
FAIR \_\_\_\_\_  
SNOW \_\_\_\_\_  
HOT \_\_\_\_\_  
MODERATE \_\_\_\_\_  
COLD \_\_\_\_\_  
FOG \_\_\_\_\_  
FIGURED BY \_\_\_\_\_  
NOTES CHECKED BY \_\_\_\_\_  
PLOTTED BY \_\_\_\_\_  
FILE No. \_\_\_\_\_  
FLDR. No. \_\_\_\_\_  
SHEET 65  
DATE 4-22-57  
Quad. No. \_\_\_\_\_

STATION	DIST.	ANGLE ° ' "	+	H. I. BEARING	VER: ANG. DIFF.	ELEVATION
Bm				2.41 36.57 36.6		34.16
220+0	✓	219+76			1.5	35.1
221+0	✓	220+79			5.1	31.5
+35	✓	221+15			5.7	30.9
+51	✓	221+32			8.2	28.4
<sup>1</sup> 222+98		221+80			9.5	27.1
222+40 +52		222+32			10.8	25.8
54 +50		222+38			13.2	23.4
62 +60		222+46			10.5	26.1
<sup>2</sup> 223+94		222+50			8.6	28.0
223+26 +30		223+12			5.9	30.7
T.P.				37.78	5.07	31.50
+7570		223+58	6.28	<del>27.78</del> 37.8	1.5	36.3
<sup>3</sup> 224+95		223+84			1.8	36.0
224+15 +22		224+04			6.6	31.2

on 24" twin oak

NOTE:

ALL DIST'S  
Taken from  
A Rd.

CREEK BANK

Q CREEK

CREEK BANK

100  
60  

---

40

10000  
210 + 66 61

---

3339





**VALUABLE**

SUBJECT \_\_\_\_\_  
 \_\_\_\_\_  
 RETURN TO PUBLIC WORKS OFFICE  
 CAMP LEJEUNE NORTH CAROLINA

**FIELD PARTY**

\_\_\_\_\_  
 IN CHARGE  
 \_\_\_\_\_  
 INSTRUMENT  
 \_\_\_\_\_  
 NOTES  
 \_\_\_\_\_  
 TAPE READ  
 \_\_\_\_\_  
 TAPE OR ROD  
 \_\_\_\_\_  
 TAPE OR ROD  
 \_\_\_\_\_  
 INSTRUMENT No. \_\_\_\_\_  
 TAPE No. \_\_\_\_\_



**WEATHER**

CLEAR  
 CLOUDY  
 WINDY  
 RAIN  
 FAIR  
 SNOW  
 HOT  
 MODERATE  
 COLD  
 FOG

FILE No. \_\_\_\_\_  
 FLDR. No. \_\_\_\_\_  
 SHEET 60f  
 FIGURED BY \_\_\_\_\_  
 NOTES CHECKED BY \_\_\_\_\_  
 PLOTTED BY \_\_\_\_\_  
 DATE \_\_\_\_\_ 19\_\_

Quad. No. \_\_\_\_\_

STATION	DIST.	ANGLE ° ' "	+	H. I. BEARING	VER. ANG. DIFF.	ELEVATION
---------	-------	----------------	---	------------------	--------------------	-----------

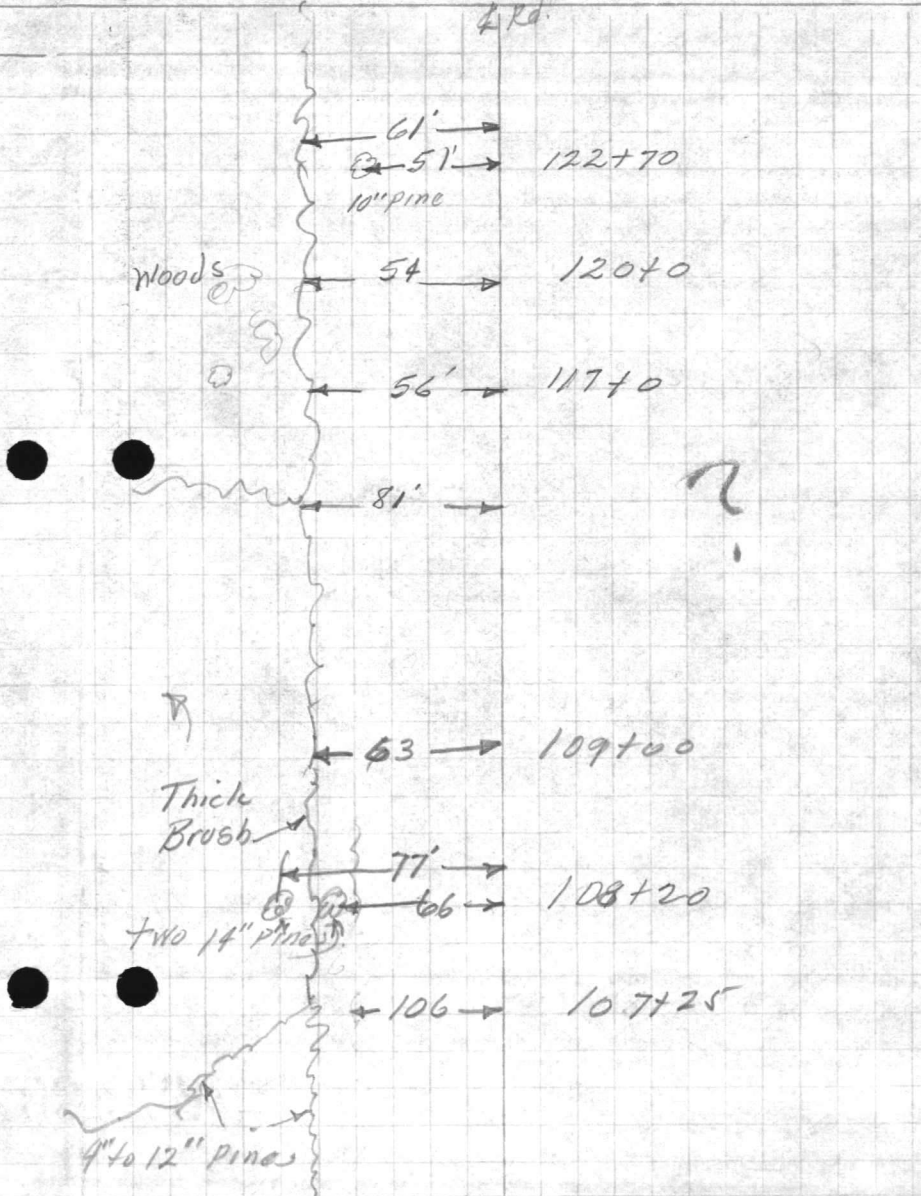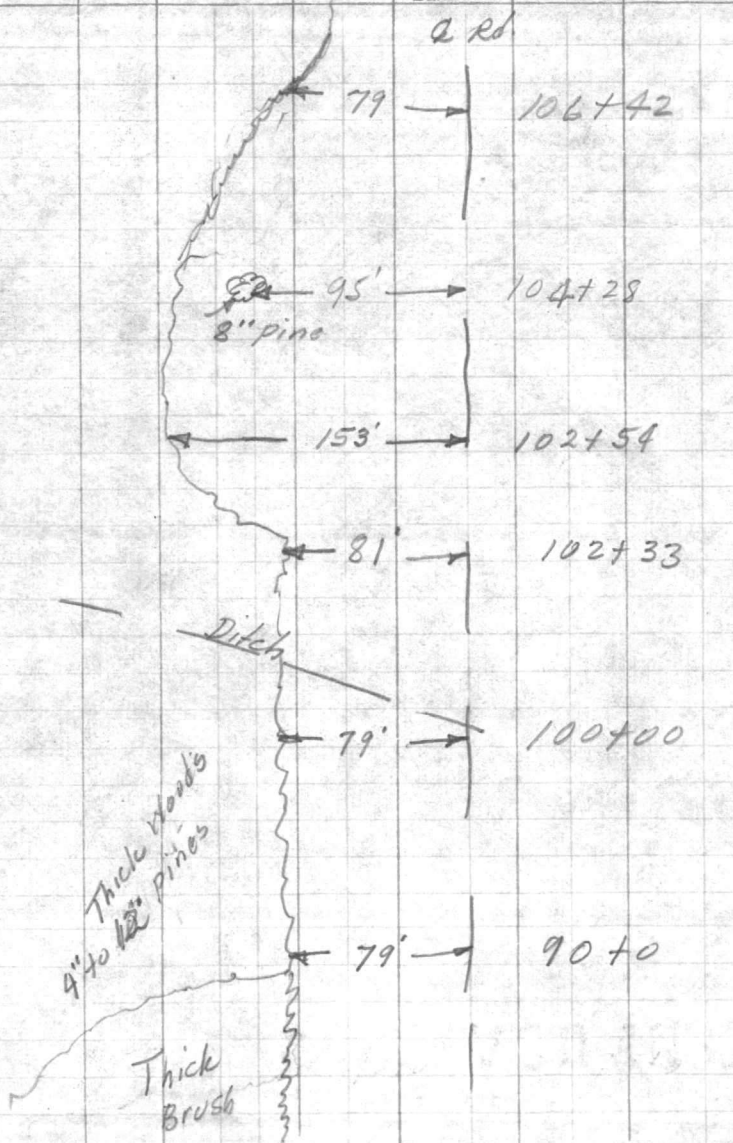

2 Rd  
 106+42

104+28

102+54

102+33

100+00

90+0

122+70

120+0

117+0

109+00

108+20

107+25






















**VALUABLE**

SUBJECT \_\_\_\_\_  
 \_\_\_\_\_  
 RETURN TO  
 PUBLIC WORKS  
 OFFICE  
 CAMP LEJEUNE  
 NORTH CAROLINA

**FIELD PARTY**

\_\_\_\_\_  
 IN CHARGE  
 \_\_\_\_\_  
 INSTRUMENT  
 \_\_\_\_\_  
 NOTES  
 \_\_\_\_\_  
 TAPE READ  
 \_\_\_\_\_  
 TAPE OR ROD  
 \_\_\_\_\_  
 TAPE OR ROD  
 \_\_\_\_\_  
 INSTRUMENT No. \_\_\_\_\_  
 TAPE No. \_\_\_\_\_


**WEATHER**

CLEAR  
 CLOUDY  
 WINDY  
 RAIN  
 FAIR  
 SNOW  
 HOT  
 MODERATE  
 COLD  
 FOG  
 FIGURED BY \_\_\_\_\_  
 NOTES CHECKED BY \_\_\_\_\_  
 PLOTTED BY \_\_\_\_\_

FILE No. \_\_\_\_\_  
 FLDR. No. \_\_\_\_\_  
 SHEET 7 of  
 DATE \_\_\_\_\_ 19\_\_

Quad. No. \_\_\_\_\_

STATION	DIST.	ANGLE ° ' "	+	H. I. BEARING	VER: ANG. DIFF.	ELEVATION
---------	-------	----------------	---	------------------	--------------------	-----------

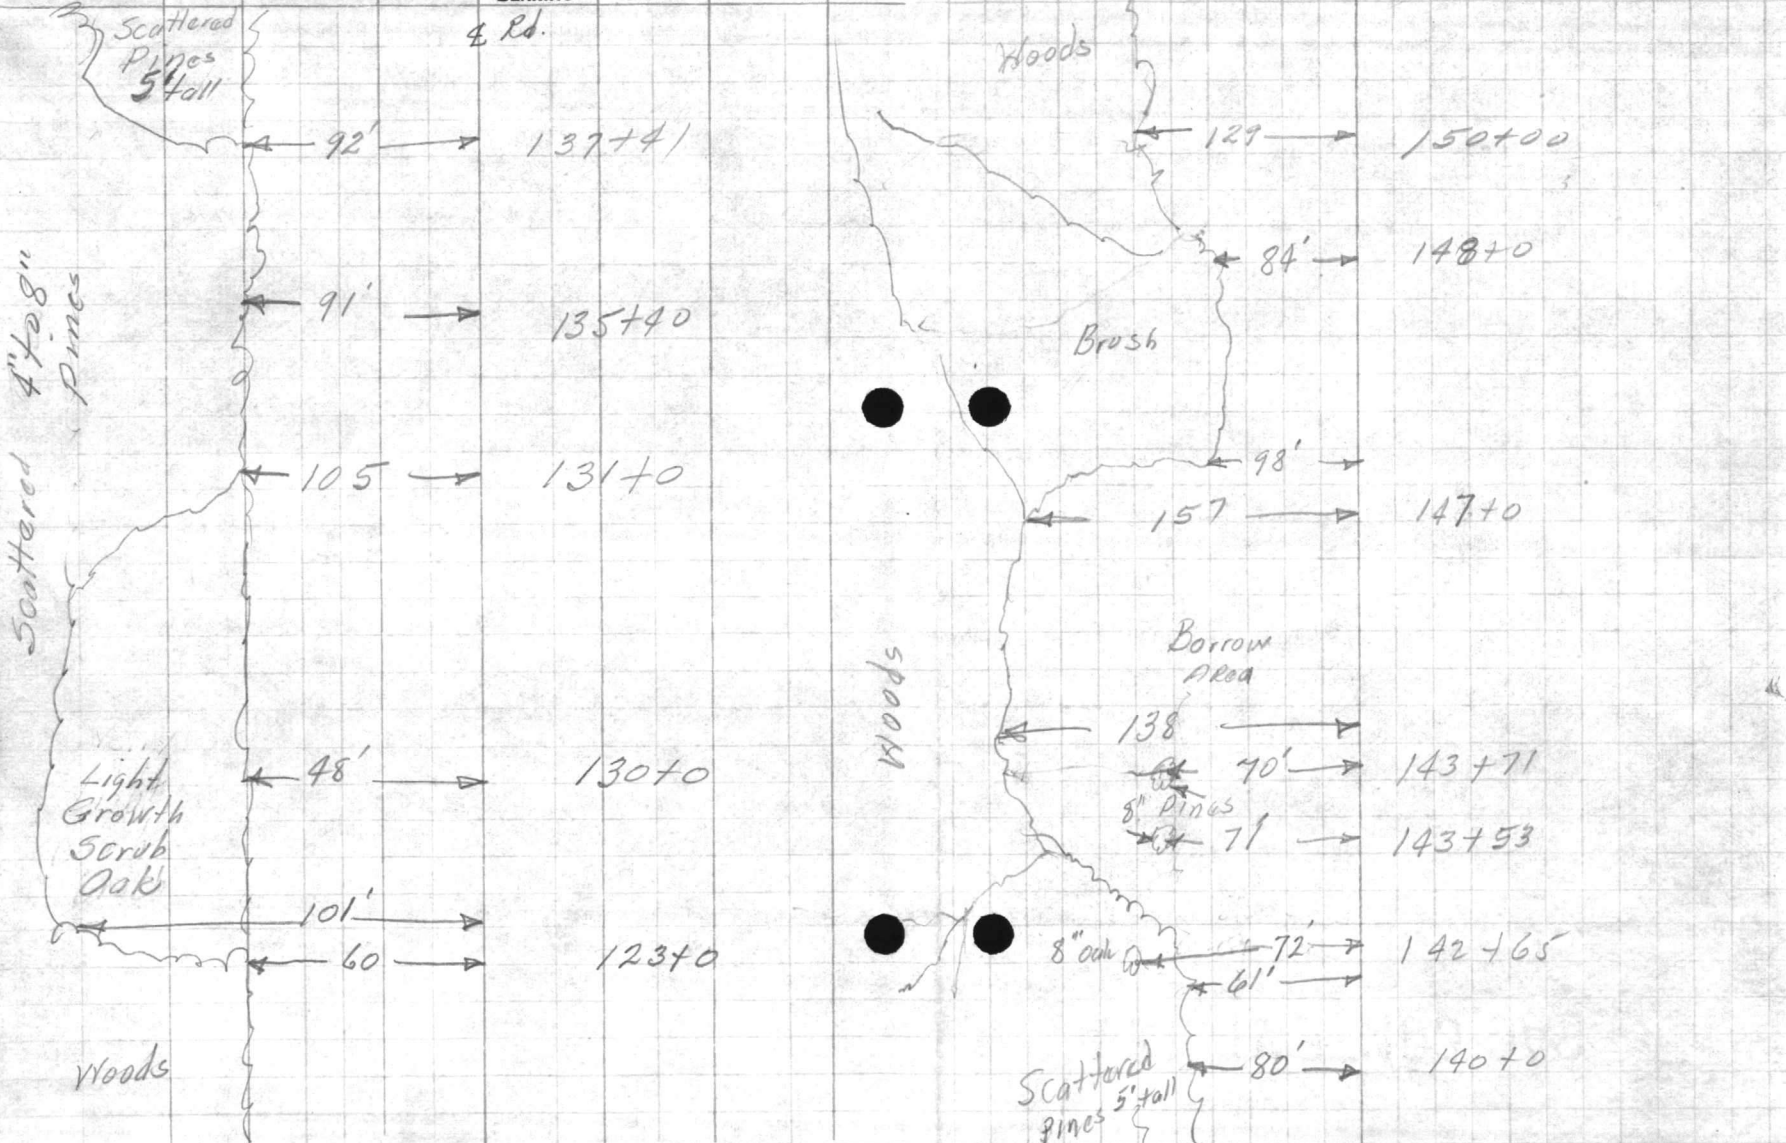


















 

**VALUABLE**

SUBJECT \_\_\_\_\_

 RETURN TO  
 PUBLIC WORKS  
 OFFICE  
 CAMP LEJEUNE  
 NORTH CAROLINA

FIELD PARTY

 \_\_\_\_\_ IN CHARGE  
 \_\_\_\_\_ INSTRUMENT  
 \_\_\_\_\_ NOTES  
 \_\_\_\_\_ TAPE READ  
 \_\_\_\_\_ TAPE OR ROD  
 \_\_\_\_\_ TAPE OR ROD  
 \_\_\_\_\_ INSTRUMENT NO.  
 \_\_\_\_\_ TAPE NO.

WEATHER

 CLEAR SNOW  
 CLOUDY HOT  
 WINDY MODERATE  
 RAIN COLD  
 FAIR FOG

FILE No. \_\_\_\_\_

FLDR. No. \_\_\_\_\_

SHEET



90f

DATE

19\_\_\_\_

Quad. No. \_\_\_\_\_

STATION	DIST.	ANGLE ° ' "	+	H. I. BEARING	VER: ANG. DIFF.	ELEVATION
---------	-------	----------------	---	------------------	--------------------	-----------

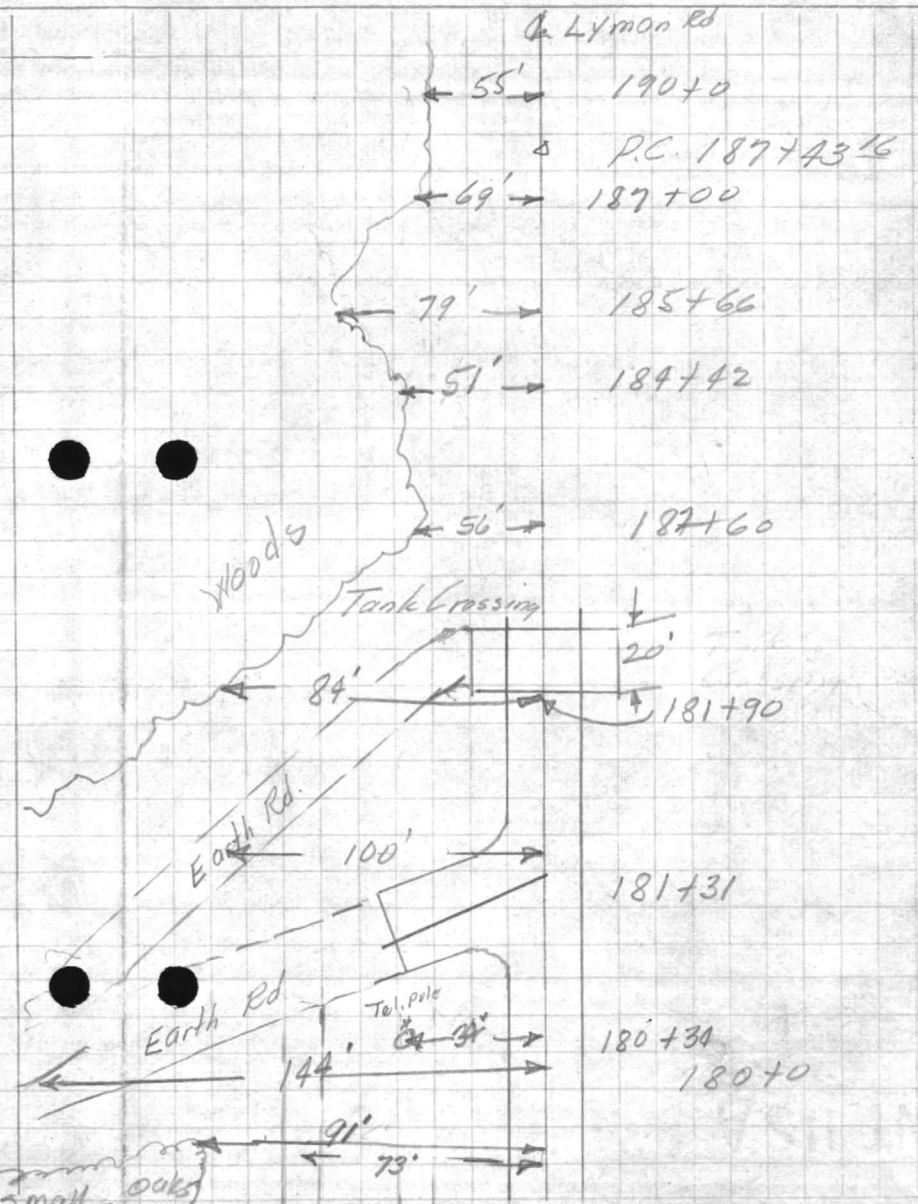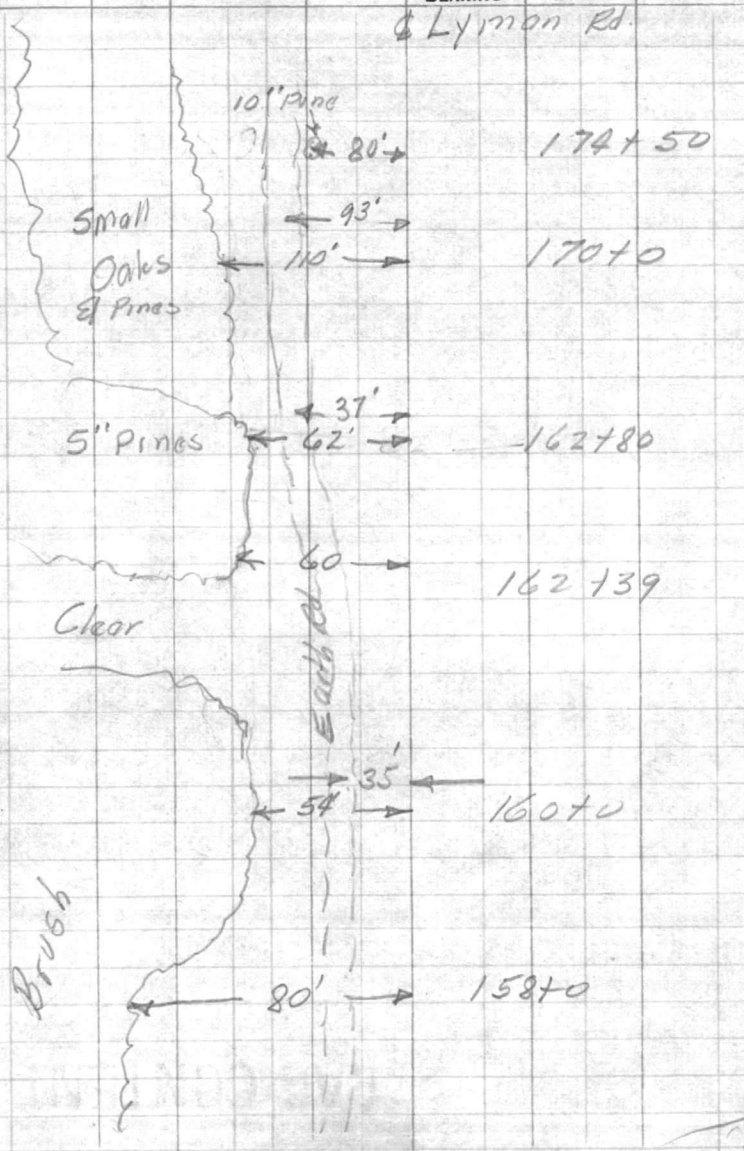












**VALUABLE**

SUBJECT \_\_\_\_\_  
 \_\_\_\_\_  
 \_\_\_\_\_  
 \_\_\_\_\_

RETURN TO  
 PUBLIC WORKS  
 OFFICE  
 CAMP LEJEUNE  
 NORTH CAROLINA

**FIELD PARTY**

\_\_\_\_\_  
 IN CHARGE  
 \_\_\_\_\_  
 INSTRUMENT  
 \_\_\_\_\_  
 NOTES  
 \_\_\_\_\_  
 TAPE READ  
 \_\_\_\_\_  
 TAPE OR ROD  
 \_\_\_\_\_  
 TAPE OR ROD  
 \_\_\_\_\_  
 INSTRUMENT NO. \_\_\_\_\_  
 TAPE NO. \_\_\_\_\_

**WEATHER**


CLEAR  
 CLOUDY  
 WINDY  
 RAIN  
 FAIR  
 SNOW  
 HOT  
 MODERATE  
 COLD  
 FOG  
 FIGURED BY \_\_\_\_\_  
 NOTES CHECKED BY \_\_\_\_\_  
 PLOTTED BY \_\_\_\_\_

FILE No. \_\_\_\_\_  
 FLDR. No. \_\_\_\_\_  
 SHEET 10 of \_\_\_\_\_  
 DATE \_\_\_\_\_ 19\_\_

Quad. No. \_\_\_\_\_

STATION	DIST.	ANGLE ° ' "	+	H. I. BEARING	VER: ANG. DIFF.	ELEVATION
---------	-------	----------------	---	------------------	--------------------	-----------

STATION	DIST.	ANGLE ° ' "	+	H. I. BEARING	VER: ANG. DIFF.	ELEVATION
				Lyman Rd.		
	69					
	47'					210+20
	62'					206+17
	121'					202+57
	67'					202+21
	79'			P.T. 201+76 <sup>51</sup>		200+00
	85'					197+0
	65'					193+51
	106					190+86
	71					

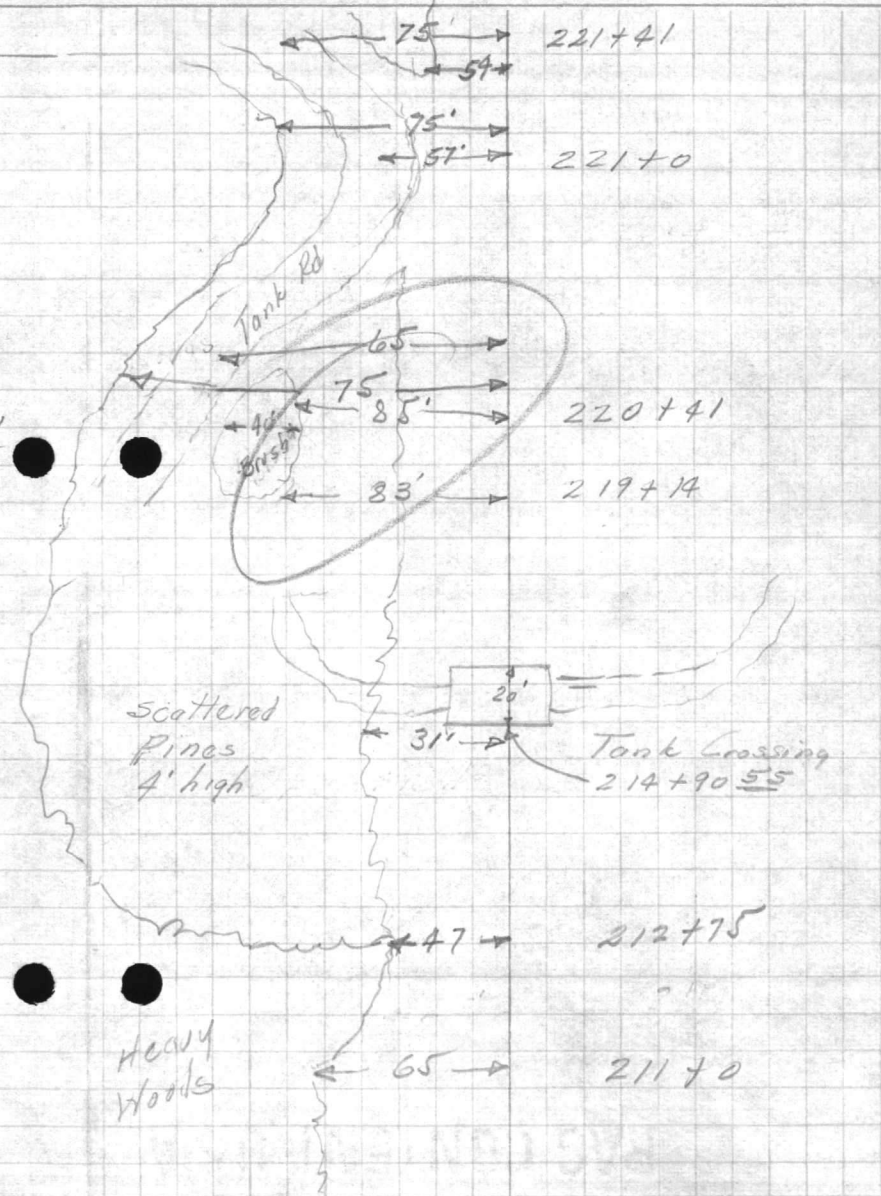

Woods

Heavy Woods

Tank Crossing  
 214+90<sup>55</sup>






**VALUABLE**

SUBJECT \_\_\_\_\_  
 \_\_\_\_\_  
 \_\_\_\_\_  
 \_\_\_\_\_

RETURN TO  
 PUBLIC WORKS  
 OFFICE  
 CAMP LEJEUNE  
 NORTH CAROLINA

**FIELD PARTY**


\_\_\_\_\_  
 IN CHARGE  
 \_\_\_\_\_  
 INSTRUMENT  
 \_\_\_\_\_  
 NOTES  
 \_\_\_\_\_  
 TAPE READ  
 \_\_\_\_\_  
 TAPE OR ROD  
 \_\_\_\_\_  
 TAPE OR ROD  
 \_\_\_\_\_  
 INSTRUMENT NO. \_\_\_\_\_  
 TAPE NO. \_\_\_\_\_

**WEATHER**

CLEAR \_\_\_\_\_ SNOW \_\_\_\_\_  
 CLOUDY \_\_\_\_\_ HOT \_\_\_\_\_  
 WINDY \_\_\_\_\_ MODERATE \_\_\_\_\_  
 RAIN \_\_\_\_\_ COLD \_\_\_\_\_  
 FAIR \_\_\_\_\_ FOG \_\_\_\_\_  
 FIGURED BY \_\_\_\_\_  
 NOTES CHECKED BY \_\_\_\_\_  
 PLOTTED BY \_\_\_\_\_

FILE No. \_\_\_\_\_  
 FLDR. No. \_\_\_\_\_  
 SHEET 1105  
 DATE \_\_\_\_\_ 19\_\_\_\_

Quad. No. \_\_\_\_\_

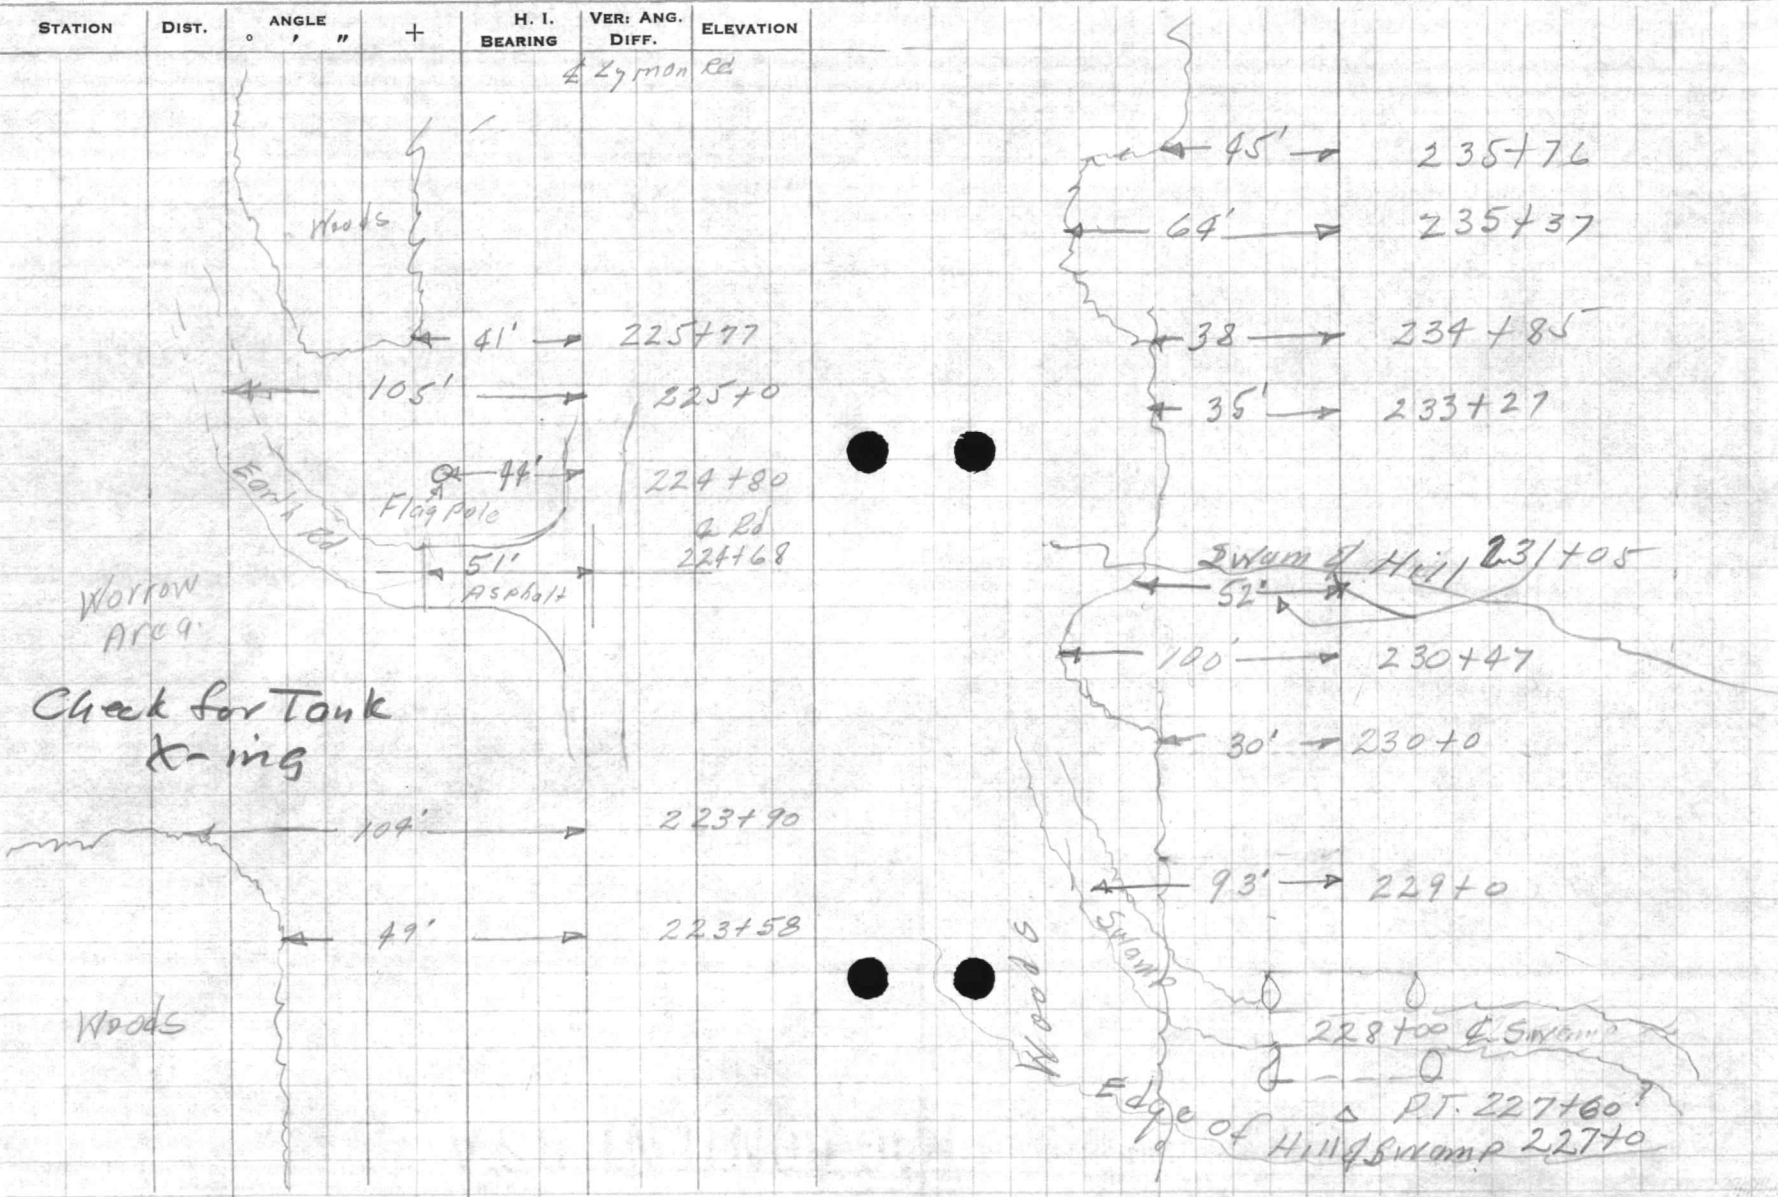

Check for Tank  
 to ring

Woods

Woods

Edge of Hill Swamp  
 227+0

90-  
19  
235495-  
58  

---

57  
235495- 76  
1 10  
23485-





**VALUABLE**

SUBJECT \_\_\_\_\_

RETURN TO  
PUBLIC WORKS  
OFFICE  
CAMP LEJEUNE  
NORTH CAROLINA

## FIELD PARTY

 \_\_\_\_\_ IN CHARGE  
 \_\_\_\_\_ INSTRUMENT  
 \_\_\_\_\_ NOTES  
 \_\_\_\_\_ TAPE READ  
 \_\_\_\_\_ TAPE OR ROD  
 \_\_\_\_\_ TAPE OR ROD  
 \_\_\_\_\_ INSTRUMENT NO.  
 \_\_\_\_\_ TAPE NO.

## WEATHER

 CLEAR  
 CLOUDY  
 WINDY  
 RAIN  
 FAIR  
 SNOW  
 HOT  
 MODERATE  
 COLD  
 FOG

FILE No. \_\_\_\_\_

FLDR. No. \_\_\_\_\_

SHEET 120P



NOTES CHECKED BY \_\_\_\_\_

PLOTTED BY \_\_\_\_\_ DATE \_\_\_\_\_ 19\_\_

Quad. No. \_\_\_\_\_

STATION	DIST.	ANGLE ° ' "	+	H. I. BEARING	VER: ANG. DIFF.	ELEVATION
---------	-------	----------------	---	------------------	--------------------	-----------

Lyman Rd.

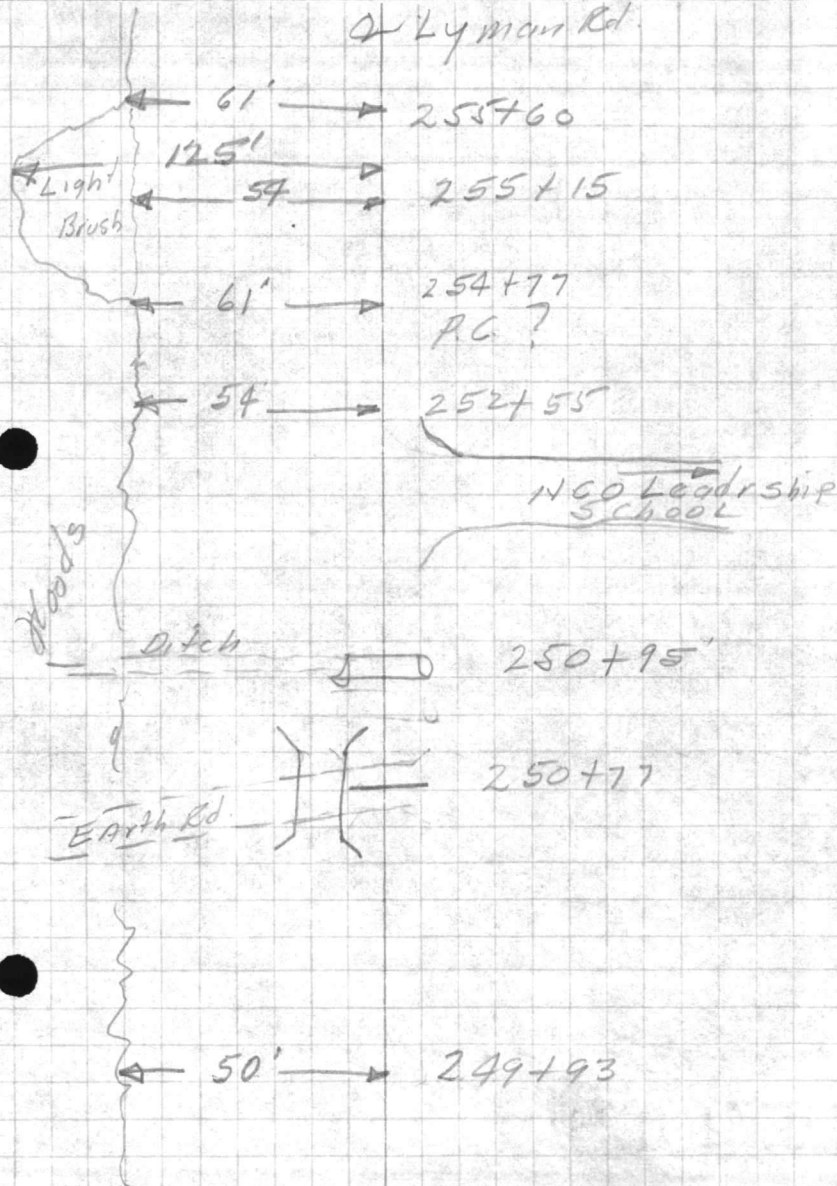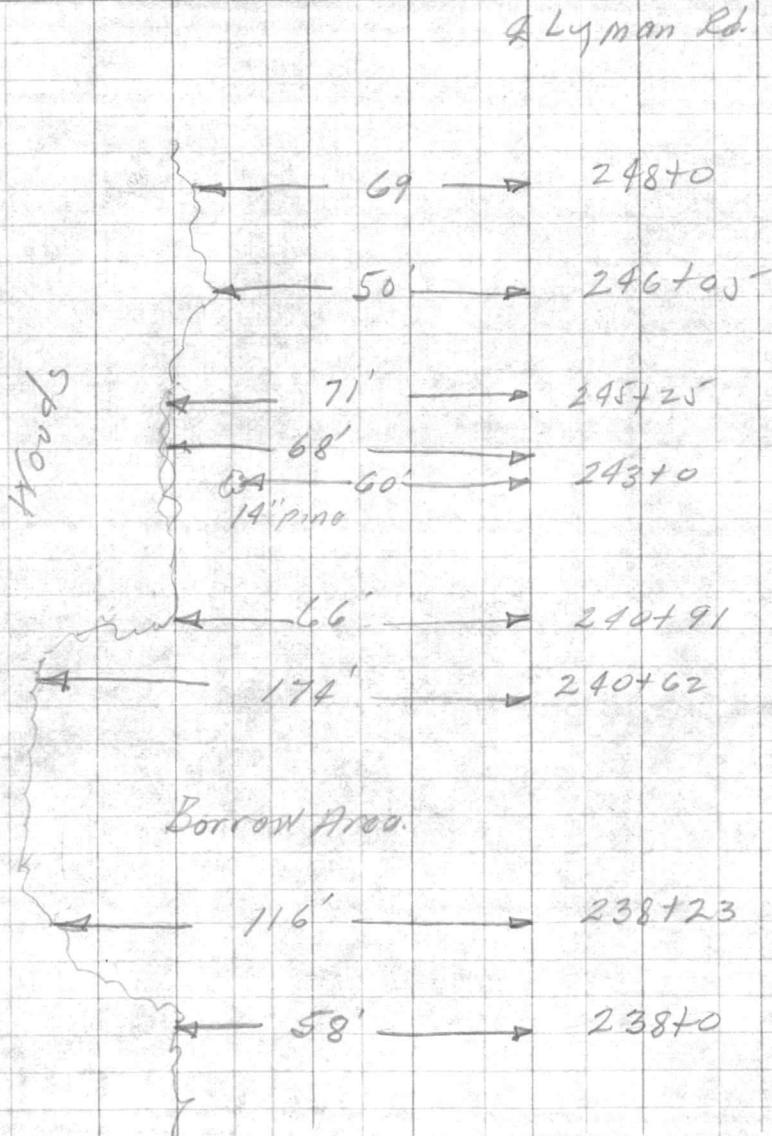





















**VALUABLE**

SUBJECT \_\_\_\_\_

 RETURN TO  
 PUBLIC WORKS  
 OFFICE  
 CAMP LEJEUNE  
 NORTH CAROLINA

## FIELD PARTY

 \_\_\_\_\_ IN CHARGE  
 \_\_\_\_\_ INSTRUMENT  
 \_\_\_\_\_ NOTES  
 \_\_\_\_\_ TAPE READ  
 \_\_\_\_\_ TAPE OR ROD  
 \_\_\_\_\_ TAPE OR ROD  
 \_\_\_\_\_ INSTRUMENT NO.  
 \_\_\_\_\_ TAPE NO.

## WEATHER

 CLEAR SNOW  
 CLOUDY HOT  
 WINDY MODERATE  
 RAIN COLD  
 FAIR FOG

FILE No. \_\_\_\_\_



FLDR. No. \_\_\_\_\_

SHEET *13 of*

DATE \_\_\_\_\_ 19\_\_

Quad. No. \_\_\_\_\_

STATION	DIST.	ANGLE ° ' "	+	H. I. BEARING	VER: ANG. DIFF.	ELEVATION
---------	-------	----------------	---	------------------	--------------------	-----------

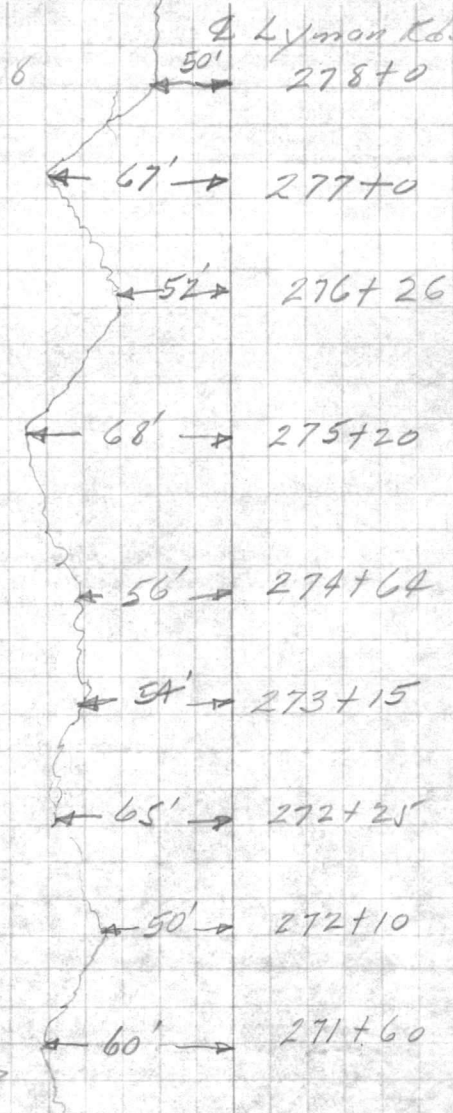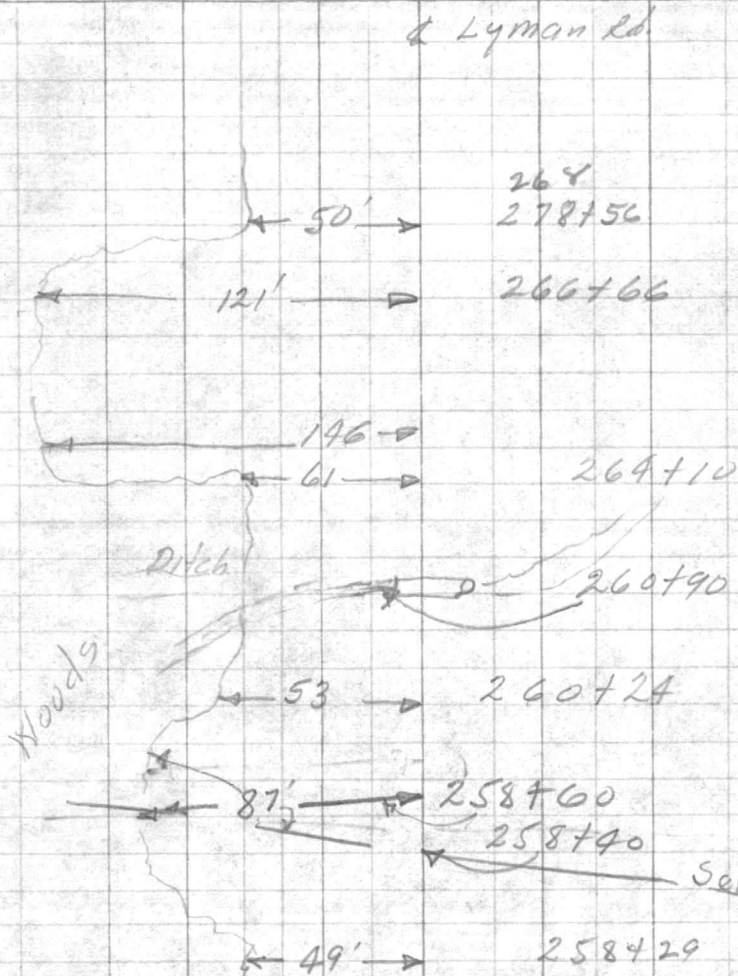























**VALUABLE**

SUBJECT \_\_\_\_\_

 RETURN TO  
 PUBLIC WORKS  
 OFFICE  
 CAMP LEJEUNE,  
 NORTH CAROLINA

## FIELD PARTY

 \_\_\_\_\_ IN CHARGE  
 \_\_\_\_\_ INSTRUMENT  
 \_\_\_\_\_ NOTES  
 \_\_\_\_\_ TAPE READ  
 \_\_\_\_\_ TAPE OR ROD  
 \_\_\_\_\_ TAPE OR ROD  
 \_\_\_\_\_ INSTRUMENT NO.  
 \_\_\_\_\_ TAPE NO.

## WEATHER

 CLEAR \_\_\_\_\_ SNOW \_\_\_\_\_  
 CLOUDY \_\_\_\_\_ HOT \_\_\_\_\_  
 WINDY \_\_\_\_\_ MODERATE \_\_\_\_\_  
 RAIN \_\_\_\_\_ COLD \_\_\_\_\_  
 FAIR \_\_\_\_\_ FOG \_\_\_\_\_

FILE No. \_\_\_\_\_

FLDR. No. \_\_\_\_\_

FIGURED BY \_\_\_\_\_

SHEET

140f

NOTES CHECKED BY \_\_\_\_\_

DATE



19

PLOTTED BY \_\_\_\_\_

Quad. No. \_\_\_\_\_

STATION	DIST.	ANGLE ° ' "	+	H. I. BEARING	VER: ANG. DIFF.	ELEVATION
---------	-------	----------------	---	------------------	--------------------	-----------

4 Lyman Rd.

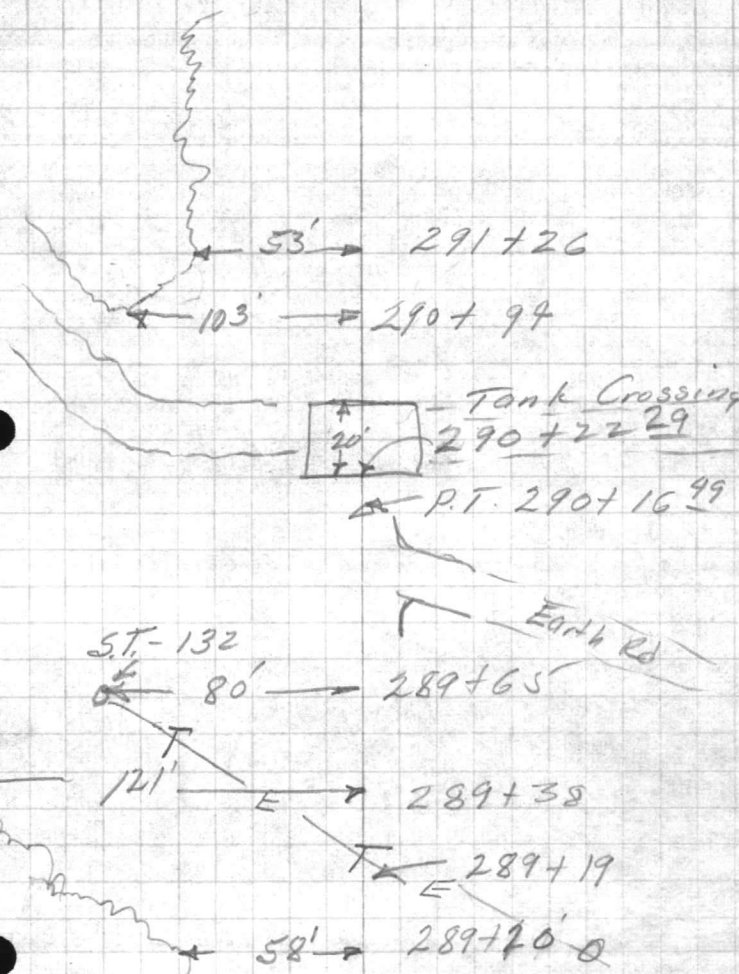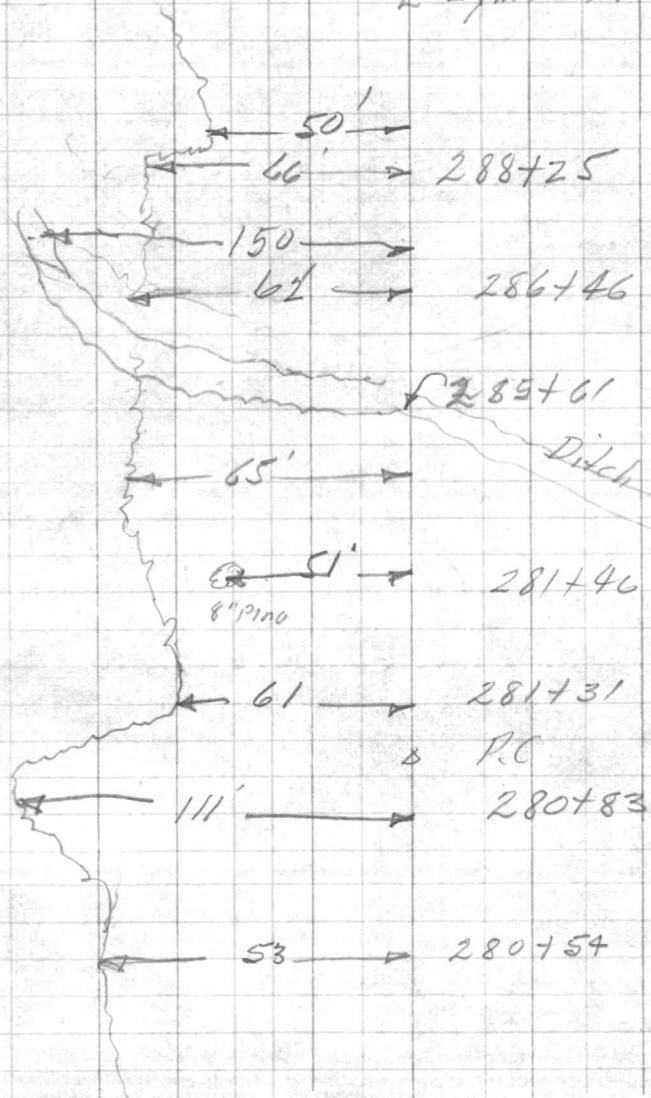

72

290	16	49	290	16	51
		99			
			289	65	

16	99

16	99



**VALUABLE**

SUBJECT \_\_\_\_\_

RETURN TO  
PUBLIC WORKS  
OFFICE  
CAMP LEJEUNE  
NORTH CAROLINA

**FIELD PARTY**

\_\_\_\_\_  
IN CHARGE  
\_\_\_\_\_  
INSTRUMENT  
\_\_\_\_\_  
NOTES  
\_\_\_\_\_  
TAPE READ  
40 \_\_\_\_\_  
TAPE OR ROD  
\_\_\_\_\_  
TAPE OR ROD  
\_\_\_\_\_  
INSTRUMENT NO.  
\_\_\_\_\_  
TAPE NO.

**WEATHER**

CLEAR \_\_\_\_\_  
CLOUDY \_\_\_\_\_  
WINDY \_\_\_\_\_  
RAIN \_\_\_\_\_  
FAIR \_\_\_\_\_  
SNOW \_\_\_\_\_  
HOT \_\_\_\_\_  
MODERATE \_\_\_\_\_  
COLD \_\_\_\_\_  
FOG \_\_\_\_\_  
FIGURED BY \_\_\_\_\_  
NOTES CHECKED BY \_\_\_\_\_  
PLOTTED BY \_\_\_\_\_

FILE No. \_\_\_\_\_


FLDR. No. \_\_\_\_\_

SHEET 15 of

DATE \_\_\_\_\_ 19\_\_

Quad. No. \_\_\_\_\_

STATION	DIST.	ANGLE ° ' "	+	H. I. BEARING	VER: ANG. DIFF.	ELEVATION
						301+72±
						56' → 300+78
						60' → 300+05
						79' → 299+45
						79' → 299+09
						61' → 298+47
						57' → 297+67
						32' → 297+43
						18' → 297+34
						63' →
						118' → 296+49
						30' →
						73' → 296+29
						19' →
						55' → 49' → 295+52.86 =
						P.L. 0+0
						R.P.P. Rd.

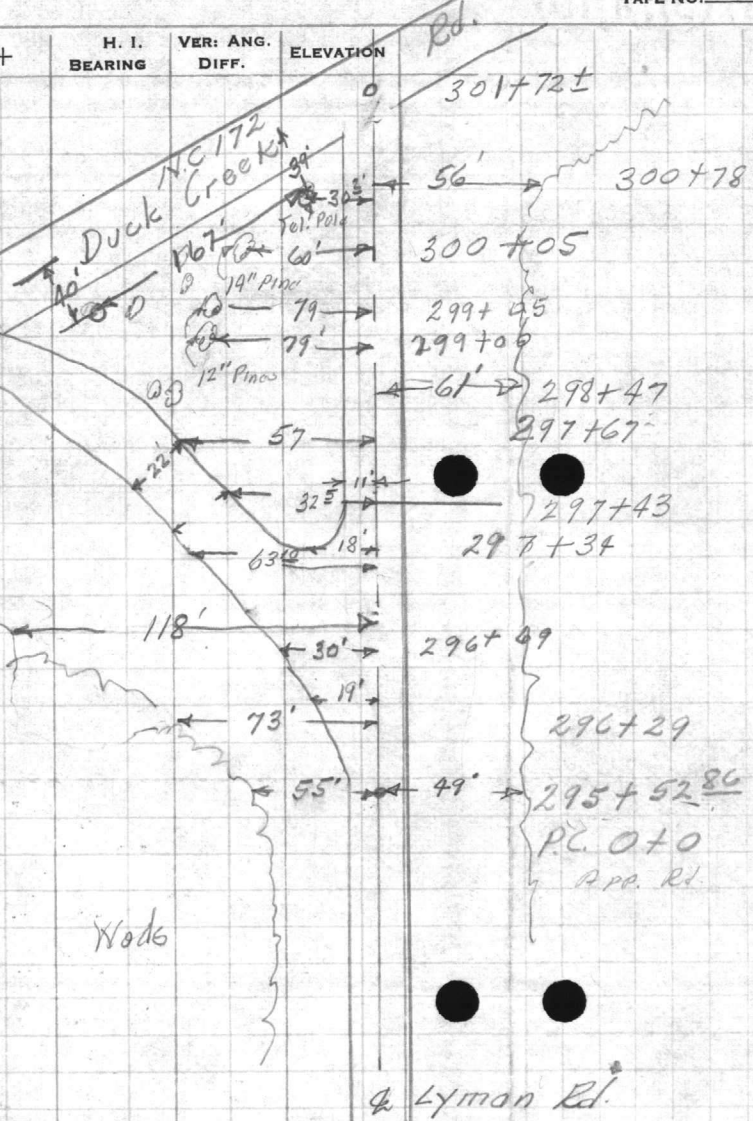

Woods

Lyman Rd.

100  
 52.86  
 -----  
 47.14







**VALUABLE**

SUBJECT \_\_\_\_\_

RETURN TO  
PUBLIC WORKS  
OFFICE  
CAMP LEJEUNE  
NORTH CAROLINA

**FIELD PARTY**

\_\_\_\_\_  
IN CHARGE  
\_\_\_\_\_  
INSTRUMENT  
\_\_\_\_\_  
NOTES  
\_\_\_\_\_  
TAPE READ  
\_\_\_\_\_  
TAPE OR ROD  
\_\_\_\_\_  
TAPE OR ROD  
\_\_\_\_\_  
INSTRUMENT NO.  
\_\_\_\_\_  
TAPE NO.

**WEATHER**

CLEAR  
CLOUDY  
WINDY  
RAIN  
FAIR  
SNOW  
HOT  
MODERATE  
COLD  
FOG  
FIGURED BY \_\_\_\_\_  
NOTES CHECKED BY \_\_\_\_\_  
PLOTTED BY \_\_\_\_\_

FILE No. \_\_\_\_\_

FLDR. No. \_\_\_\_\_

SHEET \_\_\_\_\_

DATE \_\_\_\_\_ 19\_\_

Quad. No. \_\_\_\_\_

STATION	DIST.	ANGLE ° ' "	+	H. I. BEARING	VER: ANG. DIFF.	ELEVATION
<del>219+06</del>					9 27 1 38	27 3 87
219+06				41' <sup>from</sup> 1/2 Rd	Telep. pole	
140+70				38' "	" " " "	
						223+15 Hill of Swamp
						222+58 Swamp APP. 8' drop
						221+35 Hill of Swamp


























**VALUABLE**

SUBJECT \_\_\_\_\_  
 \_\_\_\_\_  
 \_\_\_\_\_  
 \_\_\_\_\_  
 \_\_\_\_\_

RETURN TO  
 PUBLIC WORKS  
 OFFICE  
 CAMP LEJEUNE  
 NORTH CAROLINA

**FIELD PARTY**

\_\_\_\_\_  
 IN CHARGE  
 \_\_\_\_\_  
 INSTRUMENT  
 \_\_\_\_\_  
 NOTES  
 \_\_\_\_\_  
 TAPE READ  
 \_\_\_\_\_  
 TAPE OR ROD  
 \_\_\_\_\_  
 TAPE OR ROD  
 \_\_\_\_\_  
 INSTRUMENT NO. \_\_\_\_\_  
 TAPE NO. \_\_\_\_\_

**WEATHER**

CLEAR  
 CLOUDY  
 WINDY  
 RAIN  
 FAIR

SNOW  
 HOT  
 MODERATE  
 COLD  
 FOG

FILE No. \_\_\_\_\_  
 FLDR. No. \_\_\_\_\_  
 FIGURED BY \_\_\_\_\_ SHEET 207  
 NOTES CHECKED BY \_\_\_\_\_  
 PLOTTED BY \_\_\_\_\_ DATE \_\_\_\_\_ 19\_\_

Quad. No. \_\_\_\_\_

STATION	DIST.	ANGLE		+	H. I. BEARING	VER: ANG. DIFF.	ELEVATION	
		°	'					
224+60 <sup>55</sup>	224+45				<del>37.78</del> 37.8	8.0	29.8	Q EARTH RD.
+8783	224+74					8.5	29.3	
228+95 <sup>4</sup>	224+87					10.0	27.8	
225+59 <sup>59</sup>	225+53					10.4	27.4	
+82	225+76					8.8	29.0	
228+95 <sup>5</sup>	225+90					8.8	29.0	
T.P.							29.26	
228+95 <sup>6</sup>	226+93	2.28			31.54 <del>21.54</del>	8.52	<del>19.26</del>	
227+66 -PT	227+60				21.8 31.5	6.2	25.3	
227+82 ✓						8.5	23.0	CREEK BANK
+95.						13.7	17.8	BOTTOM CREEK
228+05 ✓						13.7	17.8	" "
+08 ✓						8.2	23.3	CREEK BANK
228+95 <sup>8</sup>						8.8	22.7	
T.P.							27.21	
					30.81 3.60 <del>20.81</del>	4.33	<del>17.21</del>	
230+9 ✓						6.7	24.1	








**VALUABLE**

SUBJECT \_\_\_\_\_  
 \_\_\_\_\_  
 \_\_\_\_\_  
 \_\_\_\_\_

RETURN TO  
 PUBLIC WORKS  
 OFFICE  
 CAMP LEJEUNE  
 NORTH CAROLINA

**FIELD PARTY**

\_\_\_\_\_  
 IN CHARGE  
 \_\_\_\_\_  
 INSTRUMENT  
 \_\_\_\_\_  
 NOTES  
 \_\_\_\_\_  
 TAPE READ  
 \_\_\_\_\_  
 TAPE OR ROD  
 \_\_\_\_\_  
 TAPE OR ROD  
 \_\_\_\_\_  
 INSTRUMENT NO. \_\_\_\_\_  
 TAPE NO. \_\_\_\_\_

**WEATHER**

CLEAR  
 CLOUDY  
 WINDY  
 RAIN  
 FAIR

SNOW  
 HOT  
 MODERATE  
 COLD  
 FOG

FILE No. \_\_\_\_\_  
 FLDR. No. \_\_\_\_\_  
 SHEET 30f  
 DATE \_\_\_\_\_ 19\_\_

FIGURED BY \_\_\_\_\_  
 NOTES CHECKED BY \_\_\_\_\_  
 PLOTTED BY \_\_\_\_\_  
 Quad. No. \_\_\_\_\_

STATION	DIST.	ANGLE ° ' "	+	H. I. BEARING	VER: ANG. DIFF.	ELEVATION	
230477				<del>30.81</del> <del>20.81</del> 30.8	8.6	22.2	DITCH BANK
230480					9.3	21.5	BOTTOM DITCH
+82					8.4	22.4	DITCH BANK
23140					7.8	23.0	
23240					5.0	25.8	
23340					4.4	26.4	
T.P.						27.31	
23440	6.24			<del>33.55</del> <del>23.55</del> 33.6	3.50	<del>17.31</del>	
23540					6.7	26.9	
23640					7.7	25.9	
23740					9.2	24.4	
T.P.						30.28	
23740	5.35			<del>35.63</del> <del>25.63</del> 35.6	3.27	<del>20.28</del>	
+36					11.1	24.5	
23840					9.5	26.1	
+32					5.8	29.8	
					5.0	30.6	









**VALUABLE**

SUBJECT \_\_\_\_\_  
 \_\_\_\_\_  
 \_\_\_\_\_  
 \_\_\_\_\_

RETURN TO  
 PUBLIC WORKS  
 OFFICE  
 CAMP LEJEUNE  
 NORTH CAROLINA

**FIELD PARTY**

\_\_\_\_\_  
 IN CHARGE  
 \_\_\_\_\_  
 INSTRUMENT  
 \_\_\_\_\_  
 NOTES  
 \_\_\_\_\_  
 TAPE READ  
 \_\_\_\_\_  
 TAPE OR ROD  
 \_\_\_\_\_  
 TAPE OR ROD  
 \_\_\_\_\_  
 INSTRUMENT NO. \_\_\_\_\_  
 TAPE NO. \_\_\_\_\_

**WEATHER**

CLEAR  
 CLOUDY  
 WINDY  
 RAIN  
 FAIR

SNOW  
 HOT  
 MODERATE  
 COLD  
 FOG

FILE No. \_\_\_\_\_

FLDR. No. \_\_\_\_\_

FIGURED BY \_\_\_\_\_ SHEET 4 of

NOTES CHECKED BY \_\_\_\_\_

PLOTTED BY \_\_\_\_\_ DATE \_\_\_\_\_ 19\_\_

Quad. No. \_\_\_\_\_

STATION	DIST.	ANGLE ° ' "	+	H. I. BEARING	VER: ANG. DIFF.	ELEVATION	
				<del>33.6</del> <del>29.6</del>			
238+73					6.4	29.2	
239+0					6.8	28.8	
240+0					6.0	29.6	
T.P.					4.58	<del>21.05</del> 31.05	
+62		7.15		<del>28.20</del> <del>28.20</del> 38.2	8.1	30.1	
+91					4.3	33.9	
241+0					4.2	34.0	
242+0					9.6	28.6	
+20					11.6	26.6	
BM					7.01	<del>21.19</del> 31.19	STA. 240+0 @ LYMAN RD.
BM		4.50		30.00 30.0		25.5	P.C. STA. 252+82? @ LYMAN RD.
249+0					6.8	23.2	
250+0					7.9	22.1	
+90 ✓					8.0	22.0	DITCH BANK
250+95					10.4	19.6	BOTTOM DITCH

12 / 26

8 / 75  
      
92  
11
































**VALUABLE**

SUBJECT \_\_\_\_\_  
 \_\_\_\_\_  
 \_\_\_\_\_  
 \_\_\_\_\_

RETURN TO  
 PUBLIC WORKS  
 OFFICE  
 CAMP LEJEUNE  
 NORTH CAROLINA

**FIELD PARTY**

\_\_\_\_\_  
 IN CHARGE  
 \_\_\_\_\_  
 INSTRUMENT  
 \_\_\_\_\_  
 NOTES  
 \_\_\_\_\_  
 TAPE READ  
 \_\_\_\_\_  
 TAPE OR ROD  
 \_\_\_\_\_  
 TAPE OR ROD  
 \_\_\_\_\_  
 INSTRUMENT NO. \_\_\_\_\_  
 TAPE NO. \_\_\_\_\_

**WEATHER**

CLEAR  
 CLOUDY  
 WINDY  
 RAIN  
 FAIR

SNOW  
 HOT  
 MODERATE  
 COLD  
 FOG

FILE No. \_\_\_\_\_

FLDR. No. \_\_\_\_\_

FIGURED BY \_\_\_\_\_ SHEET 50f

NOTES CHECKED BY \_\_\_\_\_

PLOTTED BY \_\_\_\_\_ DATE \_\_\_\_\_ 19\_\_

Quad. No. \_\_\_\_\_

STATION	DIST.	ANGLE ° ' "	+	H. I. BEARING	VER: ANG. DIFF.	ELEVATION	
				30.00			
251+04					8.6	21.4	DITCH BANK
252+0 ✓					8.2	21.8	
252+82.45							
253+0 ✓	253+01				7.8	22.2	
254+0 ✓	254+05				7.3	22.7	
T.P.					3.35	26.65	
<del>255+0</del>	254+98	5.65	32.30	255+06	9.1	23.2	
<del>256+0</del>	255+97	256+08			8.3	24.0	
<del>257+0</del>	256+97	257+10			8.0	24.3	
<del>258+0</del>	257+96	258+13			5.4	26.9	
<del>259+0</del>	258+96	259+16			3.6	28.7	
<del>260+0</del>	+45	259+17			3.0	29.3	
260+0 ✓	260+24				4.2	28.1	
260+49.75	P.T. ✓	260+74			6.5	25.8	
B.M.					4.80	27.50	(27.2) P.T. STA. 260+49.75 @ LYMAN RD.
260+75	260+99	5.80	33.30		9.1	24.2	DITCH BANK
				38.3			

P.T. 260+49.75

100  
82  
16









**VALUABLE**

SUBJECT \_\_\_\_\_  
 \_\_\_\_\_  
 \_\_\_\_\_  
 \_\_\_\_\_  
 \_\_\_\_\_

RETURN TO  
 PUBLIC WORKS  
 OFFICE  
 CAMP LEJEUNE  
 NORTH CAROLINA

**FIELD PARTY**

\_\_\_\_\_  
 IN CHARGE  
 \_\_\_\_\_  
 INSTRUMENT  
 \_\_\_\_\_  
 NOTES  
 \_\_\_\_\_  
 TAPE READ  
 \_\_\_\_\_  
 TAPE OR ROD  
 \_\_\_\_\_  
 TAPE OR ROD  
 \_\_\_\_\_  
 INSTRUMENT NO. \_\_\_\_\_  
 TAPE NO. \_\_\_\_\_

**WEATHER**

CLEAR \_\_\_\_\_  
 CLOUDY \_\_\_\_\_  
 WINDY \_\_\_\_\_  
 RAIN \_\_\_\_\_  
 FAIR \_\_\_\_\_  
 SNOW \_\_\_\_\_  
 HOT \_\_\_\_\_  
 MODERATE \_\_\_\_\_  
 COLD \_\_\_\_\_  
 FOG \_\_\_\_\_  
 FIGURED BY \_\_\_\_\_  
 NOTES CHECKED BY \_\_\_\_\_  
 PLOTTED BY \_\_\_\_\_

FILE No. \_\_\_\_\_  
 FLDR. No. \_\_\_\_\_  
 SHEET 60f  
 DATE \_\_\_\_\_ 19\_\_

Quad. No. \_\_\_\_\_

STATION	DIST.	ANGLE ° ' "	+	H. I. BEARING	VER: ANG. DIFF.	ELEVATION	
260+80 ✓		261+04		33.30 33.3	10.9	27.5 22.4	BOTTO DITCH
+84 ✓		261+08			9.0	24.3	DITCH BANK
261+0 ✓		261+24			8.7	24.6	
262+0		262+24			7.7	25.6	
263+0		263+24			6.4	26.9	
+75		263+99			4.0	29.3	
264+0		264+24			3.3	30.0	
265+0		265+24			1.8	31.5	
266+0		266+24			0.1	33.2	
B.M.					5.80	27.5	27.2 PT 260+4975 & LYMAN RD.
B.M.		4.74		AV. 24 92.2		37.50	P.C. STA. 295+52 <sup>86</sup> & LYMAN RD
294+0					7.3	34.9	
295+52 <sup>86</sup>					7.4	34.8	
296+0					5.6	36.6	
+54					5.2	37.0	





**VALUABLE**

SUBJECT \_\_\_\_\_  
 \_\_\_\_\_  
 \_\_\_\_\_  
 \_\_\_\_\_  
 \_\_\_\_\_

RETURN TO  
 PUBLIC WORKS  
 OFFICE  
 CAMP LEJEUNE  
 NORTH CAROLINA

**FIELD PARTY**

\_\_\_\_\_  
 IN CHARGE  
 \_\_\_\_\_  
 INSTRUMENT  
 \_\_\_\_\_  
 NOTES  
 \_\_\_\_\_  
 TAPE READ  
 \_\_\_\_\_  
 TAPE OR ROD  
 \_\_\_\_\_  
 TAPE OR ROD  
 \_\_\_\_\_  
 INSTRUMENT NO. \_\_\_\_\_  
 TAPE NO. \_\_\_\_\_

**WEATHER**

CLEAR \_\_\_\_\_ SNOW \_\_\_\_\_  
 CLOUDY \_\_\_\_\_ HOT \_\_\_\_\_  
 WINDY \_\_\_\_\_ MODERATE \_\_\_\_\_  
 RAIN \_\_\_\_\_ COLD \_\_\_\_\_  
 FAIR \_\_\_\_\_ FOG \_\_\_\_\_  
 FIGURED BY \_\_\_\_\_  
 NOTES CHECKED BY \_\_\_\_\_  
 PLOTTED BY \_\_\_\_\_

FILE No. \_\_\_\_\_  
 FLDR. No. \_\_\_\_\_  
 SHEET 70f  
 DATE \_\_\_\_\_ 19\_\_

Quad. No. \_\_\_\_\_

STATION	DIST.	ANGLE ° ' "	+	H. I. BEARING	VER: ANG. DIFF.	ELEVATION	
296+92				42.2 42.2	6.6	35.6	
297+0					6.5	35.7	
+32					6.1	36.1	
+75					7.3	34.9	BOTTOM DITCH
298+0					4.9	37.3	
+25					3.2	39.0	
299+0					5.0	37.2	
+50					8.3	33.9	
300+10					12.2	30.0	
+56					11.2	31.0	
301+0					9.2	33.0	
B.M.					9.27	32.97	33.06 Int. LYMAH RD of N.C. # 172



























**VALUABLE**

SUBJECT \_\_\_\_\_  
\_\_\_\_\_  
\_\_\_\_\_  
RETURN TO  
PUBLIC WORKS  
OFFICE  
CAMP LEJEUNE  
NORTH CAROLINA

FIELD PARTY

\_\_\_\_\_  
IN CHARGE  
\_\_\_\_\_  
INSTRUMENT  
\_\_\_\_\_  
NOTES  
\_\_\_\_\_  
TAPE READ  
\_\_\_\_\_  
TAPE OR ROD  
\_\_\_\_\_  
TAPE OR ROD  
\_\_\_\_\_  
INSTRUMENT NO.  
\_\_\_\_\_  
TAPE NO. \_\_\_\_\_


WEATHER

CLEAR \_\_\_\_\_ SNOW \_\_\_\_\_  
CLOUDY \_\_\_\_\_ HOT \_\_\_\_\_  
WINDY \_\_\_\_\_ MODERATE \_\_\_\_\_  
RAIN \_\_\_\_\_ COLD \_\_\_\_\_  
FAIR \_\_\_\_\_ FOG \_\_\_\_\_  
FIGURED BY \_\_\_\_\_  
NOTES CHECKED BY \_\_\_\_\_  
PLOTTED BY \_\_\_\_\_

FILE No. \_\_\_\_\_  
FLDR. No. \_\_\_\_\_  
SHEET 80f  
DATE \_\_\_\_\_ 19\_\_\_\_

Quad. No. \_\_\_\_\_

STATION	DIST.	ANGLE		+	H. I. BEARING	VER: ANG. DIFF.	ELEVATION
		°	"				

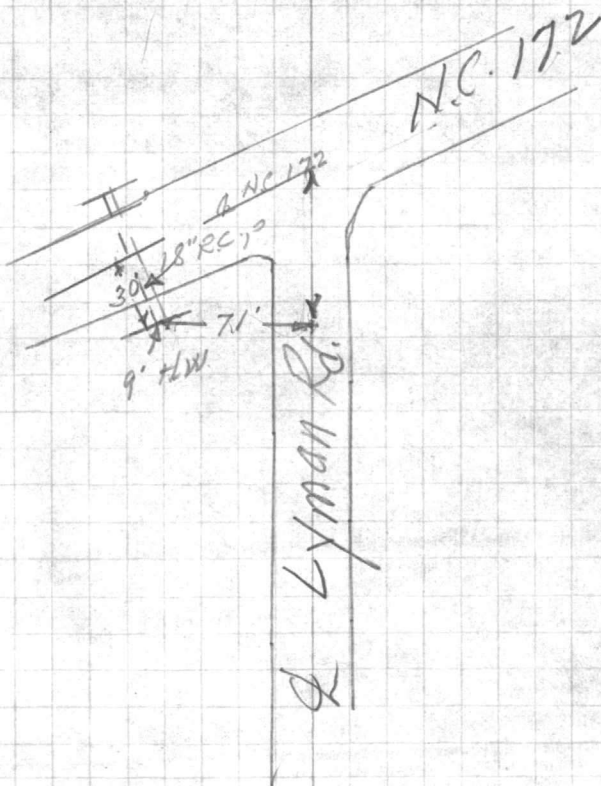








**VALUABLE**

RETURN TO  
PUBLIC WORKS  
OFFICE  
CAMP LEJEUNE  
NORTH CAROLINA

SUBJECT SOIL PROBING ACROSS  
BEAR CREEK ON 40'  
OFFSET LYMAN RD.

FIELD PARTY  
DENNIS IN CHARGE  
\_\_\_\_\_  
INSTRUMENT  
\_\_\_\_\_  
NOTES  
\_\_\_\_\_  
TAPE READ  
\_\_\_\_\_  
TAPE OR ROD  
\_\_\_\_\_  
TAPE OR ROD  
\_\_\_\_\_  
INSTRUMENT NO. \_\_\_\_\_  
TAPE NO. \_\_\_\_\_

WEATHER  
CLEAR \_\_\_\_\_  
CLOUDY \_\_\_\_\_  
WINDY \_\_\_\_\_  
RAIN \_\_\_\_\_  
FAIR \_\_\_\_\_  
SNOW \_\_\_\_\_  
HOT \_\_\_\_\_  
MODERATE \_\_\_\_\_  
COLD \_\_\_\_\_  
FOG \_\_\_\_\_  
FIGURED BY \_\_\_\_\_  
NOTES CHECKED BY \_\_\_\_\_  
PLOTTED BY \_\_\_\_\_

FILE No. \_\_\_\_\_  
FLDR. No. \_\_\_\_\_  
SHEET 10 of 1  
DATE 5-3 1957

Quad. No. \_\_\_\_\_

STATION	DIST.	ANGLE ° ' "	+	H. I. BEARING	VER. ANG. DIFF.	ELEVATION	
227+60 <sup>00</sup>				-	2.0		
227+83 <sup>00</sup>				-	4.1		NEAR west side CR.
228+50 <sup>00</sup>				-	6.0		NEAR EAST SIDE CR.
228+75 <sup>00</sup>				-	5.8		
229+00 <sup>00</sup>				-	7.2		
229+50				-	7.0		
229+75 <sup>00</sup>				-	9.0		
230+00 <sup>00</sup>				-	11.3		
230+25				-	8.7		
230+50				-	8.7		
230+75				-	5.0		
231+00				-	3.8		
231+25					0.0		








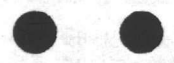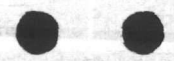


**VALUABLE**

RETURN TO  
PUBLIC WORKS  
OFFICE  
CAMP LEJEUNE  
NORTH CAROLINA

SUBJECT

*Clear Spans  
Tel. and Elec. Lines  
Intersection of S.F. and Lyman Rds.*

FIELD PARTY  
*Morton* IN CHARGE  
INSTRUMENT  
NOTES  
TAPE READ  
TAPE OR ROD  
TAPE OR ROD  
INSTRUMENT NO.  
TAPE NO.

WEATHER  
CLEAR  
CLOUDY  
WINDY  
RAIN  
FAIR  
SNOW  
HOT  
MODERATE  
COLD  
FOG  
FIGURED BY  
NOTES CHECKED BY  
PLOTTED BY  
FILE No. *160-D*  
FLDR. No.  
SHEET *1 of*  
DATE *5/13/1957*  
Quad. No.

STATION	DIST.	ANGLE ° ' "	+	H. I. BEARING	VER. ANG. DIFF.	ELEVATION Height above Ground	
①	77.6	11 24			4.1	+19.7	Bottom Telap Cable
②	43.4	25 58			4.4	+25.4	Bottom Cross Arm Telap Pole
③	43.4	30 36			4.4	+29.9	Top
S-47	38	39 30			4.2	+35.5	Bottom " " Power Pole
S-47	38	40 55			4.2	+37.1	Top " " " "
S-48	63.5	23 01			3.7	+30.7	Bottom " " " "
S-48	63.5	25 05			3.7	+33.4	Top " " " "

160-D  
to  
181-G






VALUABLE

RETURN TO  
PUBLIC WORKS  
OFFICE  
CAMP LEJEUNE  
NORTH CAROLINA

SUBJECT

Lpc. Poles and Spans  
Tel. Line Paralleling S.F. Rd. from  
Int. of Lyman Rd. to Mariners Rd.

FIELD PARTY  
Martin IN CHARGE  
\_\_\_\_ INSTRUMENT  
\_\_\_\_ NOTES  
\_\_\_\_ TAPE READ  
\_\_\_\_ TAPE OR ROD  
\_\_\_\_ TAPE OR ROD  
\_\_\_\_ INSTRUMENT NO.  
\_\_\_\_ TAPE NO.

WEATHER  
CLEAR \_\_\_\_\_ SNOW \_\_\_\_\_  
CLOUDY \_\_\_\_\_ HOT \_\_\_\_\_  
WINDY \_\_\_\_\_ MODERATE \_\_\_\_\_  
RAIN \_\_\_\_\_ COLD \_\_\_\_\_  
FAIR \_\_\_\_\_ FOG \_\_\_\_\_


FIGURED BY \_\_\_\_\_ SHEET 20f  
NOTES CHECKED BY \_\_\_\_\_  
PLOTTED BY \_\_\_\_\_ DATE 5/13/1957

FILE No. \_\_\_\_\_

FLDR. No. \_\_\_\_\_

Quad. No. \_\_\_\_\_

STATION	DIST.	ANGLE			H. I. BEARING	VER. ANG. DIFF.	ELEVATION
		°	'	"			

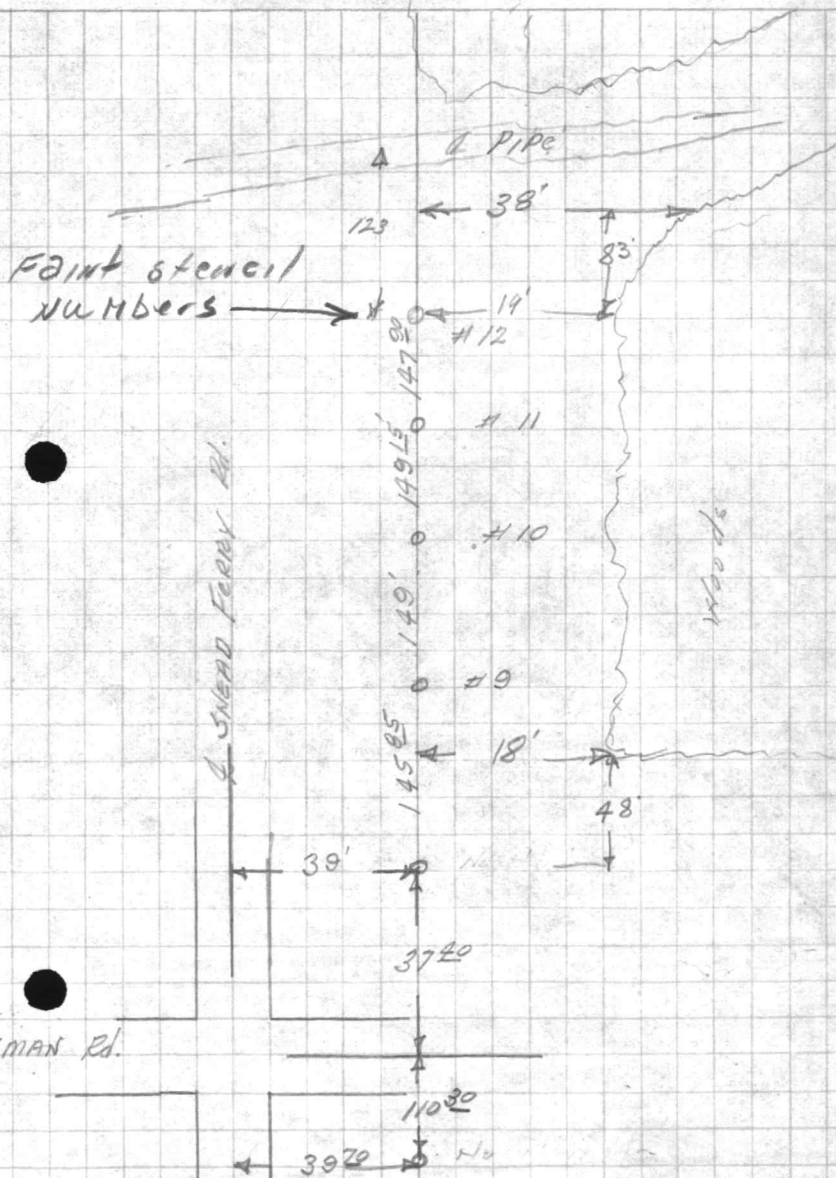







**VALUABLE**

SUBJECT \_\_\_\_\_

RETURN TO  
PUBLIC WORKS  
OFFICE  
CAMP LEJEUNE  
NORTH CAROLINA

**FIELD PARTY**

\_\_\_\_\_  
IN CHARGE  
\_\_\_\_\_  
INSTRUMENT  
\_\_\_\_\_  
NOTES  
\_\_\_\_\_  
TAPE READ  
\_\_\_\_\_  
TAPE OR ROD  
\_\_\_\_\_  
TAPE OR ROD  
\_\_\_\_\_  
INSTRUMENT NO.  
\_\_\_\_\_  
TAPE NO.

**WEATHER**

CLEAR  
CLOUDY  
WINDY  
RAIN  
FAIR

SNOW  
HOT  
MODERATE  
COLD  
FOG

FILE No. \_\_\_\_\_

FLDR. No. \_\_\_\_\_


FIGURED BY \_\_\_\_\_ SHEET 3 of

NOTES CHECKED BY \_\_\_\_\_

PLOTTED BY \_\_\_\_\_ DATE \_\_\_\_\_ 19\_\_

Quad. No. \_\_\_\_\_

STATION	DIST.	ANGLE ° ' "	+	H. I. BEARING	VER: ANG. DIFF.	ELEVATION
#18				148 50		
#17				152 90		
#16				138 20		
#15				148 80		
#14				148 90		
#13				148 50		
#12						

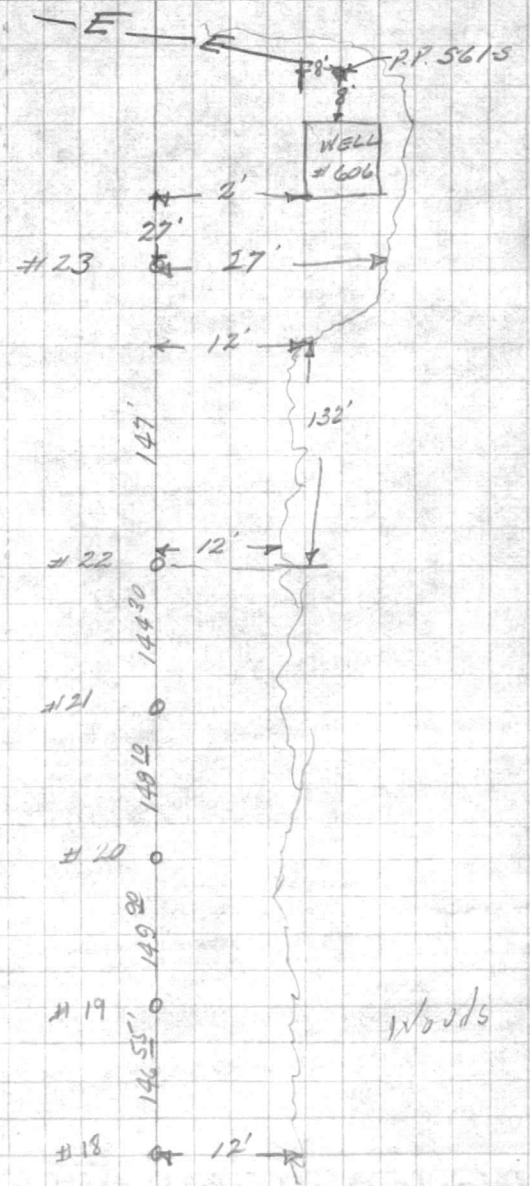






















**VALUABLE**

SUBJECT \_\_\_\_\_  
\_\_\_\_\_  
\_\_\_\_\_  
RETURN TO  
PUBLIC WORKS  
OFFICE  
CAMP LEJEUNE  
NORTH CAROLINA

**FIELD PARTY**

\_\_\_\_\_  
IN CHARGE  
\_\_\_\_\_  
INSTRUMENT  
\_\_\_\_\_  
NOTES  
\_\_\_\_\_  
TAPE READ  
\_\_\_\_\_  
TAPE OR ROD  
\_\_\_\_\_  
TAPE OR ROD  
\_\_\_\_\_  
INSTRUMENT NO.  
\_\_\_\_\_  
TAPE NO.


**WEATHER**

\_\_\_\_\_  
CLEAR  
\_\_\_\_\_  
CLOUDY  
\_\_\_\_\_  
WINDY  
\_\_\_\_\_  
RAIN  
\_\_\_\_\_  
FAIR  
\_\_\_\_\_  
SNOW  
\_\_\_\_\_  
HOT  
\_\_\_\_\_  
MODERATE  
\_\_\_\_\_  
COLD  
\_\_\_\_\_  
FOG

FILE No. \_\_\_\_\_  
FLDR. No. \_\_\_\_\_  
FIGURED BY \_\_\_\_\_  
NOTES CHECKED BY \_\_\_\_\_  
PLOTTED BY \_\_\_\_\_  
DATE \_\_\_\_\_ 19\_\_

Quad. No. \_\_\_\_\_

STATION	DIST.	ANGLE ° ' "	+	H. I. BEARING	VER. ANG. DIFF.	ELEVATION
---------	-------	----------------	---	------------------	--------------------	-----------

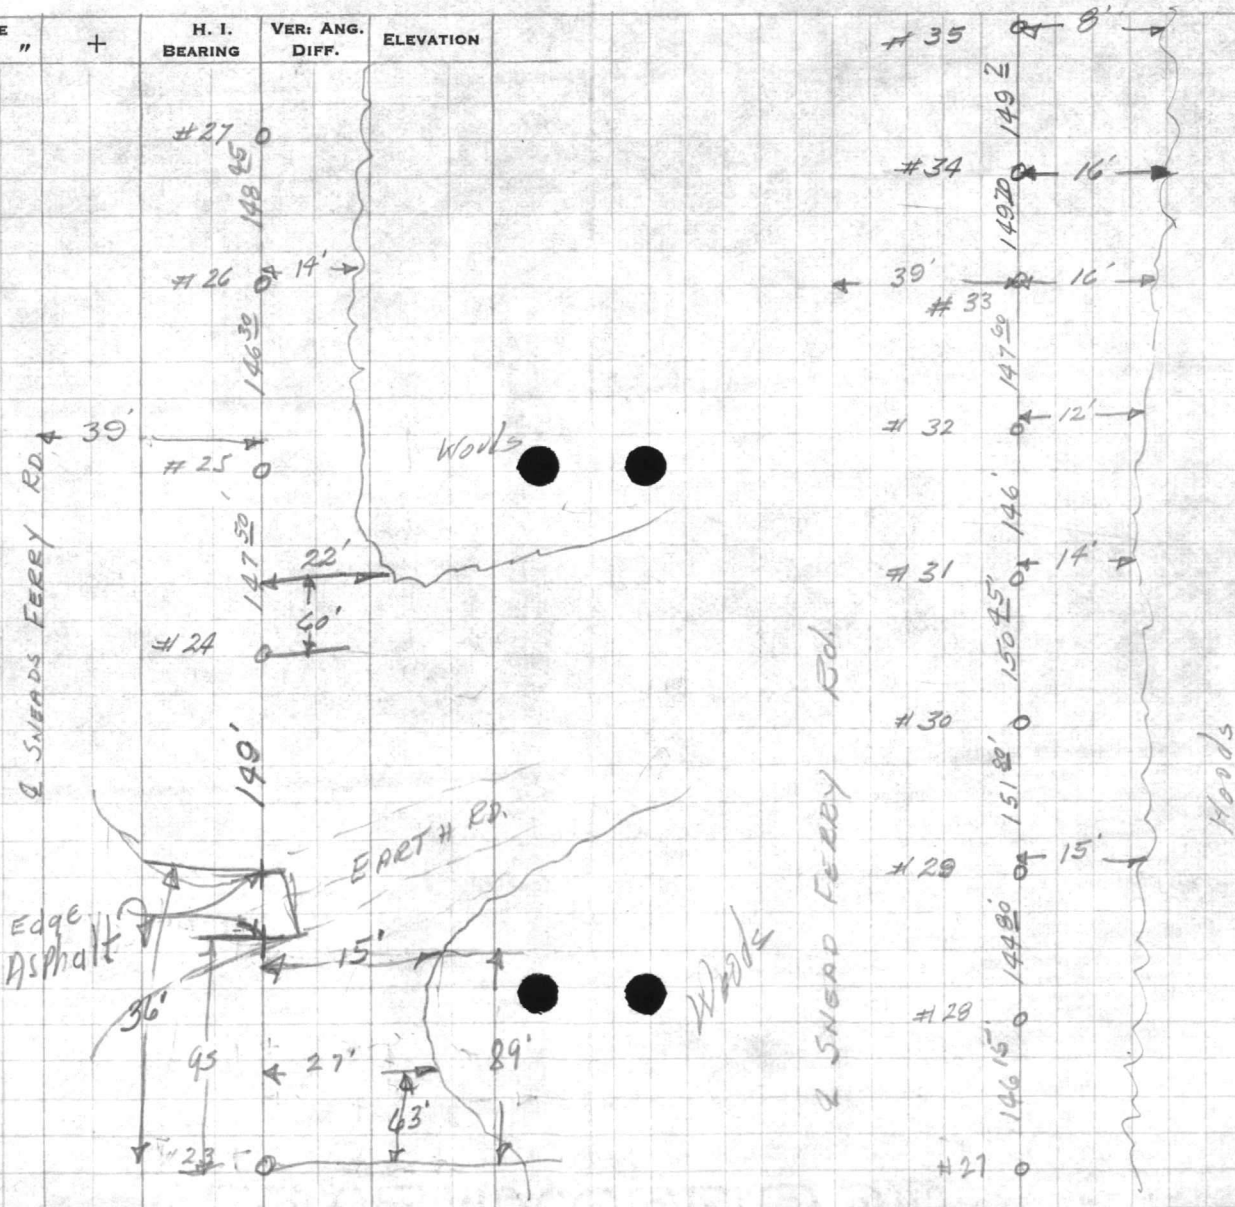








VALUABLE

SUBJECT \_\_\_\_\_

RETURN TO  
PUBLIC WORKS  
OFFICE  
CAMP LEJEUNE  
NORTH CAROLINA

FIELD PARTY

\_\_\_\_\_  
IN CHARGE  
\_\_\_\_\_  
INSTRUMENT  
\_\_\_\_\_  
NOTES  
\_\_\_\_\_  
TAPE READ  
\_\_\_\_\_  
TAPE OR ROD  
\_\_\_\_\_  
TAPE OR ROD  
\_\_\_\_\_  
INSTRUMENT NO.  
\_\_\_\_\_  
TAPE NO.

WEATHER

CLEAR  
CLOUDY  
WINDY  
RAIN  
FAIR  
SNOW  
HOT  
MODERATE  
COLD  
FOG

FILE No. \_\_\_\_\_

FLDR. No. \_\_\_\_\_


FIGURED BY \_\_\_\_\_ SHEET 50f

NOTES CHECKED BY \_\_\_\_\_

PLOTTED BY \_\_\_\_\_ DATE \_\_\_\_\_ 19\_\_

Quad. No. \_\_\_\_\_

STATION	DIST.	ANGLE ° ' "	+	H. I. BEARING	VER: ANG. DIFF.	ELEVATION
---------	-------	----------------	---	------------------	--------------------	-----------

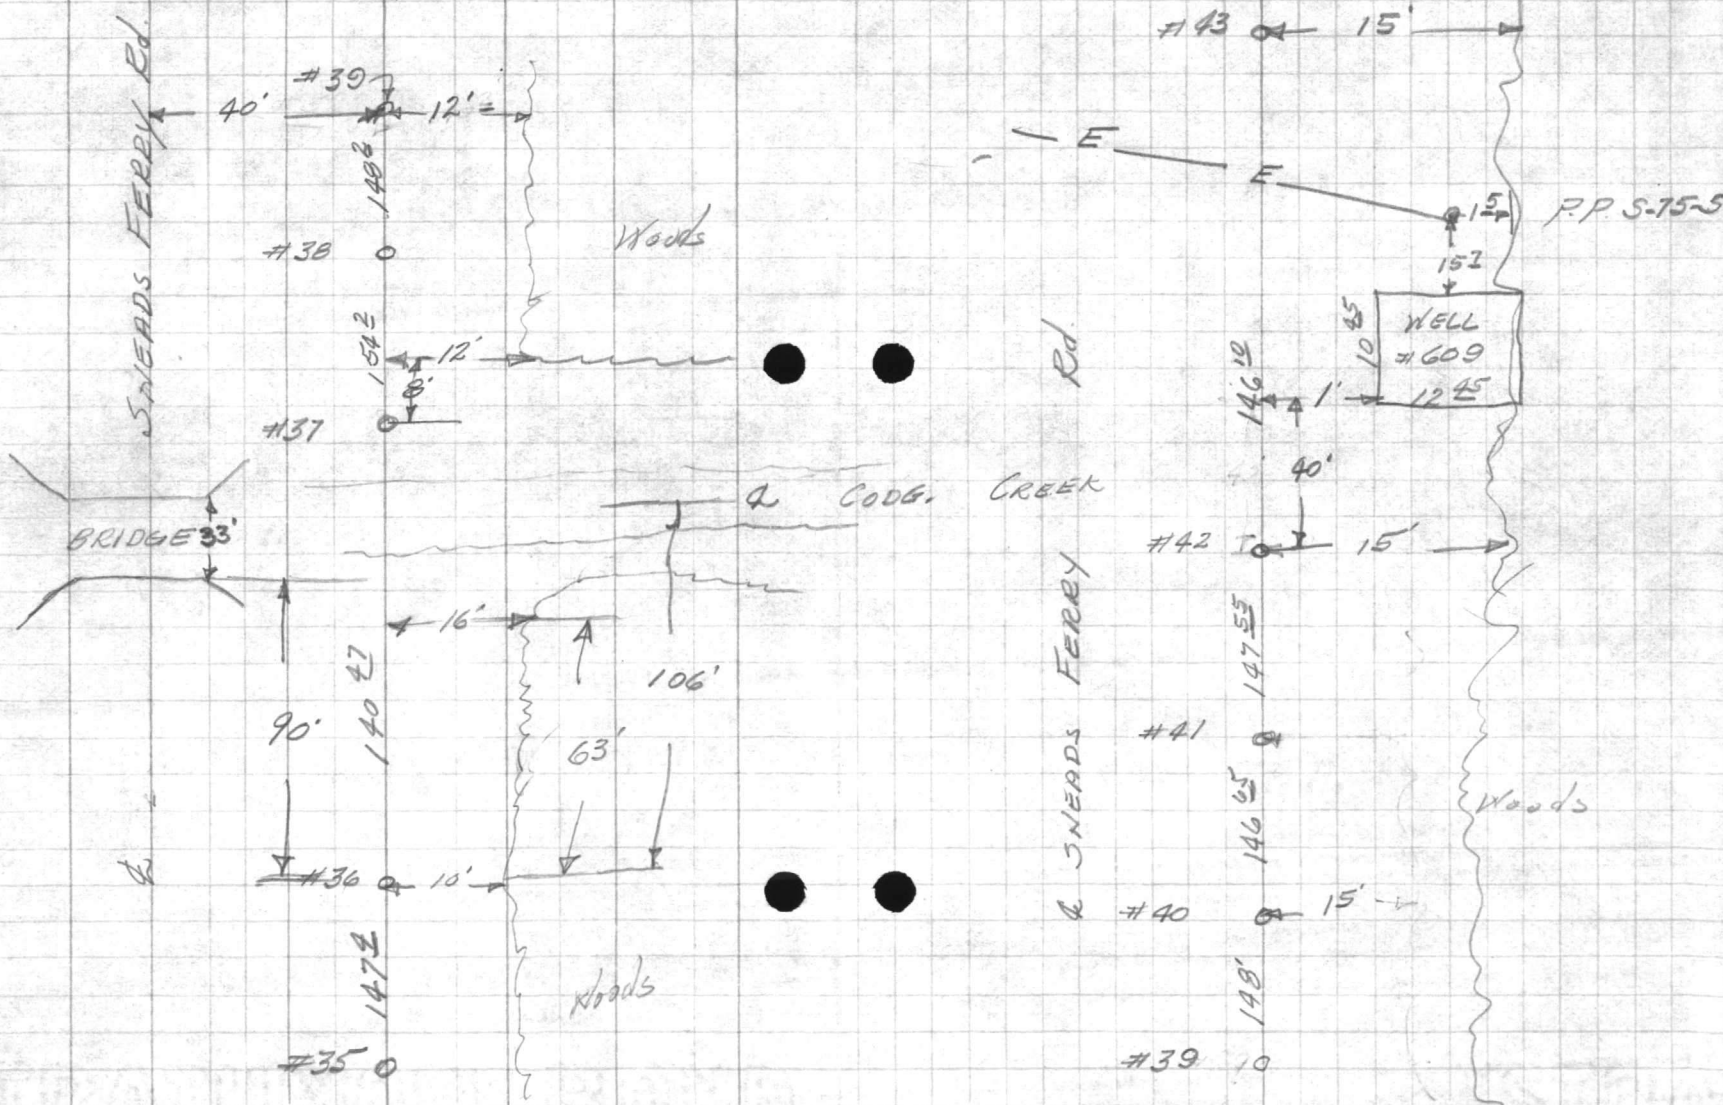










VALUABLE

SUBJECT \_\_\_\_\_  
\_\_\_\_\_  
\_\_\_\_\_  
\_\_\_\_\_  
\_\_\_\_\_

RETURN TO  
PUBLIC WORKS  
OFFICE  
CAMP LEJEUNE  
NORTH CAROLINA

FIELD PARTY

\_\_\_\_\_  
IN CHARGE  
\_\_\_\_\_  
INSTRUMENT  
\_\_\_\_\_  
NOTES  
\_\_\_\_\_  
TAPE READ  
\_\_\_\_\_  
TAPE OR ROD  
\_\_\_\_\_  
TAPE OR ROD  
\_\_\_\_\_  
STRUMENT NO.  
\_\_\_\_\_  
TAPE NO.

WEATHER

CLEAR  
CLOUDY  
WINDY  
RAIN  
FAIR  
SNOW  
HOT  
MODERATE  
COLD  
FOG

FILE No. \_\_\_\_\_

FLDR. No. \_\_\_\_\_


FIGURED BY \_\_\_\_\_ SHEET 605

NOTES CHECKED BY \_\_\_\_\_

PLOTTED BY \_\_\_\_\_ DATE \_\_\_\_\_ 19\_\_

Quad. No. \_\_\_\_\_



STATION	DIST.	ANGLE ° ' "	+	H. I. BEARING	VER. ANG. DIFF.	ELEVATION
---------	-------	----------------	---	------------------	--------------------	-----------

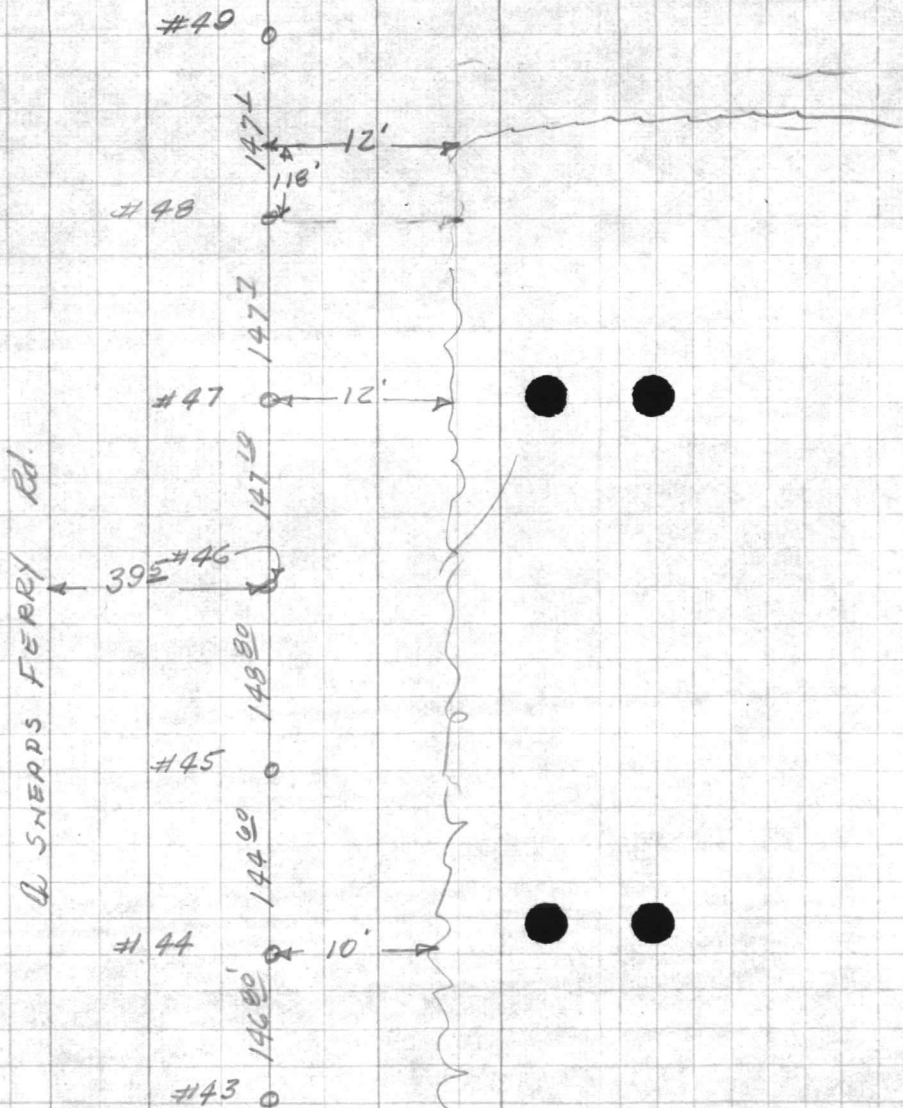




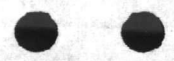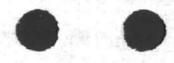



**VALUABLE**

SUBJECT \_\_\_\_\_

 RETURN TO  
 PUBLIC WORKS  
 OFFICE  
 CAMP LEJEUNE  
 NORTH CAROLINA

## FIELD PARTY

 \_\_\_\_\_ IN CHARGE  
 \_\_\_\_\_ INSTRUMENT  
 \_\_\_\_\_ NOTES  
 \_\_\_\_\_ TAPE READ  
 \_\_\_\_\_ TAPE OR ROD  
 \_\_\_\_\_ TAPE OR ROD  
 \_\_\_\_\_ INSTRUMENT NO.  
 \_\_\_\_\_ TAPE NO.

## WEATHER

 CLEAR SNOW  
 CLOUDY HOT  
 WINDY MODERATE  
 RAIN COLD  
 FAIR FOG

FILE No. \_\_\_\_\_

FLDR. No. \_\_\_\_\_

FIGURED BY \_\_\_\_\_ SHEET 7 of

NOTES CHECKED BY \_\_\_\_\_

PLOTTED BY \_\_\_\_\_ DATE \_\_\_\_\_ 19\_\_

Quad. No. \_\_\_\_\_

STATION	DIST.	ANGLE ° ' "	+	H. I. BEARING	VER: ANG. DIFF.	ELEVATION
#53	18'					
#52	10'					
#51	147 E					
#50	147 BC					
#49	149 15					
	26'					
	18'					
	90'					
	18'					
	8'					
	144'					
	197 E					
	71'					
	40'					
#49						


A. SNEADS FERRY RD

FIELD TEL  
CROSS OVER  
POLETANK  
CROSSING

20'

Woods

A. SNEAD FERR RD.

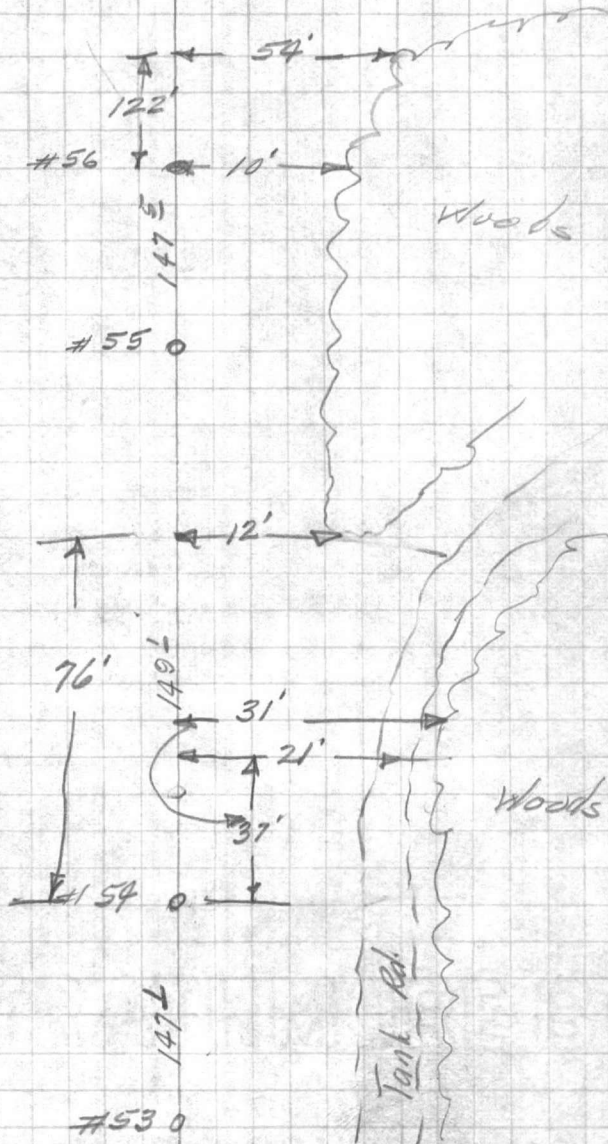










**VALUABLE**

SUBJECT \_\_\_\_\_

 RETURN TO  
 PUBLIC WORKS  
 OFFICE  
 CAMP LEJEUNE  
 NORTH CAROLINA

 55  
 90  
 145

## FIELD PARTY

 \_\_\_\_\_ IN CHARGE  
 \_\_\_\_\_ INSTRUMENT  
 \_\_\_\_\_ NOTES  
 \_\_\_\_\_ TAPE READ  
 \_\_\_\_\_ TAPE OR ROD  
 \_\_\_\_\_ TAPE OR ROD  
 \_\_\_\_\_ INSTRUMENT NO.  
 \_\_\_\_\_ TAPE NO.

## WEATHER

 CLEAR  
 CLOUDY  
 WINDY  
 RAIN  
 FAIR  
 SNOW  
 HOT  
 MODERATE  
 COLD  
 FOG

FILE No. \_\_\_\_\_

FLDR. No. \_\_\_\_\_


FIGURED BY \_\_\_\_\_ SHEET 80f

NOTES CHECKED BY \_\_\_\_\_

PLOTTED BY \_\_\_\_\_ DATE \_\_\_\_\_ 19\_\_

Quad. No. \_\_\_\_\_

STATION	DIST.	ANGLE ° ' "	+	H. I. BEARING	VER: ANG. DIFF.	ELEVATION
---------	-------	----------------	---	------------------	--------------------	-----------

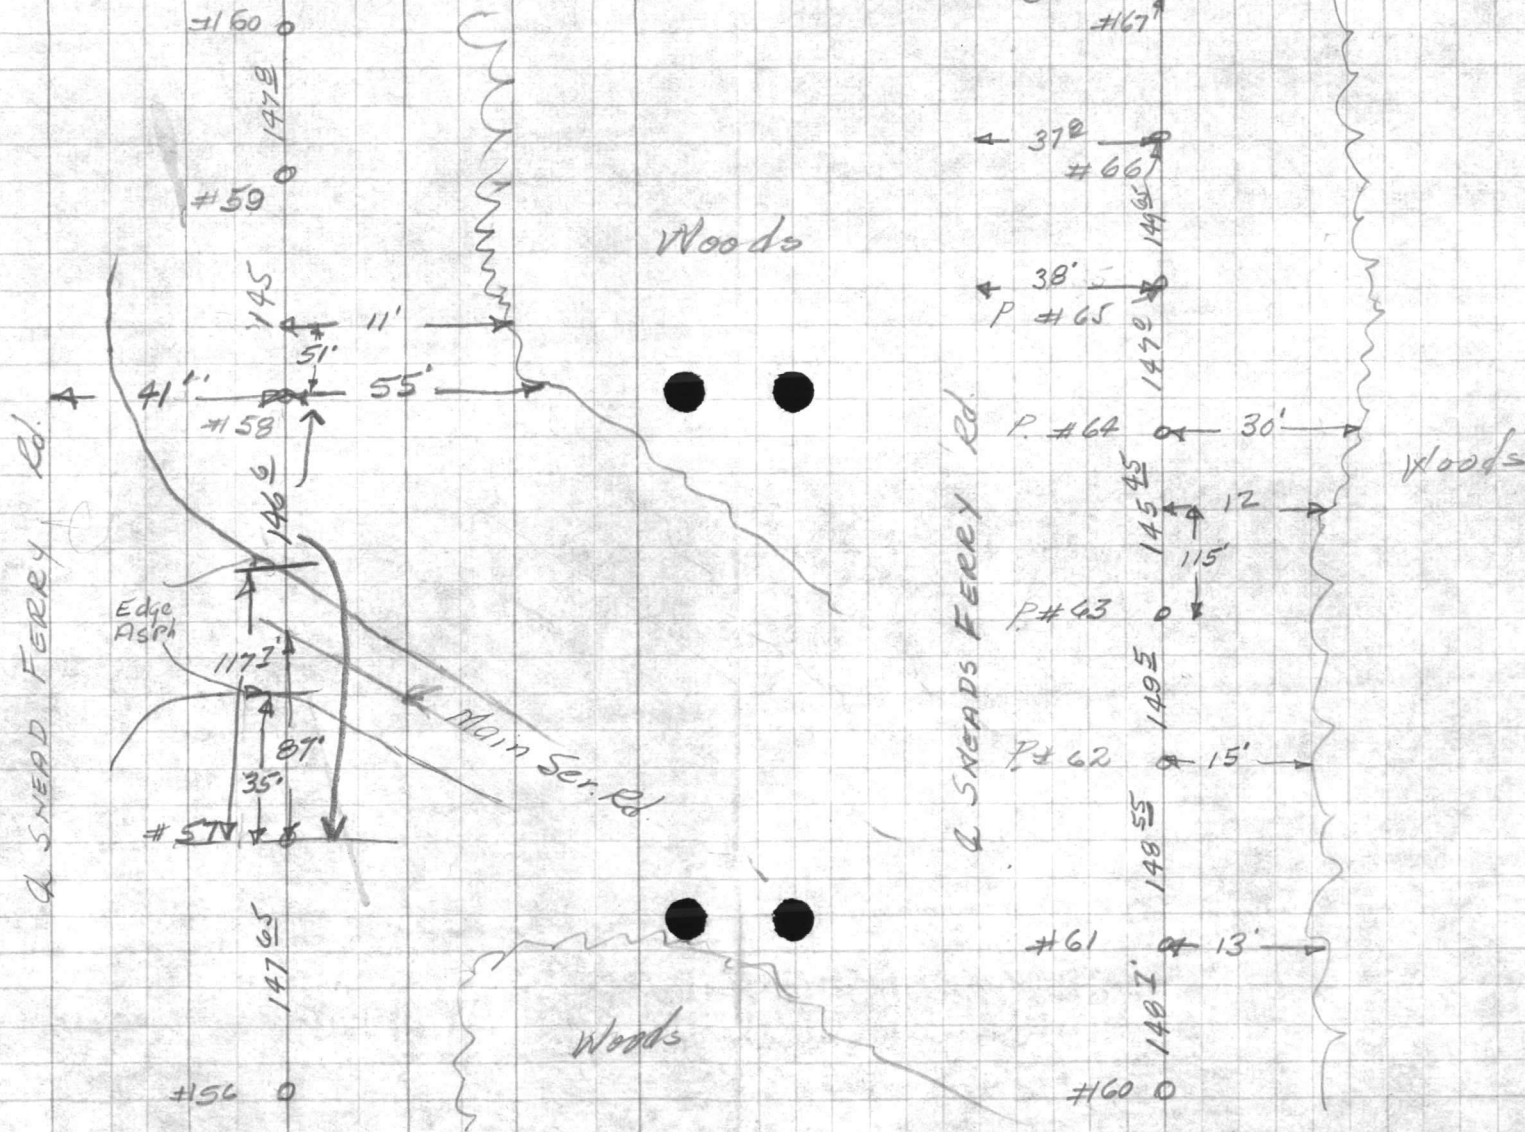






















**VALUABLE**

SUBJECT \_\_\_\_\_  
\_\_\_\_\_  
85  
6300  
10960

RETURN TO  
PUBLIC WORKS  
OFFICE  
CAMP LEJEUNE  
NORTH CAROLINA

**FIELD PARTY**

\_\_\_\_\_  
IN CHARGE  
\_\_\_\_\_  
INSTRUMENT  
\_\_\_\_\_  
NOTES  
\_\_\_\_\_  
TAPE READ  
\_\_\_\_\_  
TAPE OR ROD  
\_\_\_\_\_  
TAPE OR ROD  
\_\_\_\_\_  
INSTRUMENT NO.  
\_\_\_\_\_  
TAPE NO.


**WEATHER**

CLEAR  
CLOUDY  
WINDY  
RAIN  
FAIR  
SNOW  
HOT  
MODERATE  
COLD  
FOG

FILE No. \_\_\_\_\_  
FLDR. No. \_\_\_\_\_  
FIGURED BY \_\_\_\_\_ SHEET 9 of \_\_\_\_\_  
NOTES CHECKED BY \_\_\_\_\_  
PLOTTED BY \_\_\_\_\_ DATE \_\_\_\_\_ 19 \_\_\_\_\_

Quad. No. \_\_\_\_\_

STATION	DIST.	ANGLE ° ' "	+	H. I. BEARING	VER: ANG. DIFF.	ELEVATION
---------	-------	----------------	---	------------------	--------------------	-----------

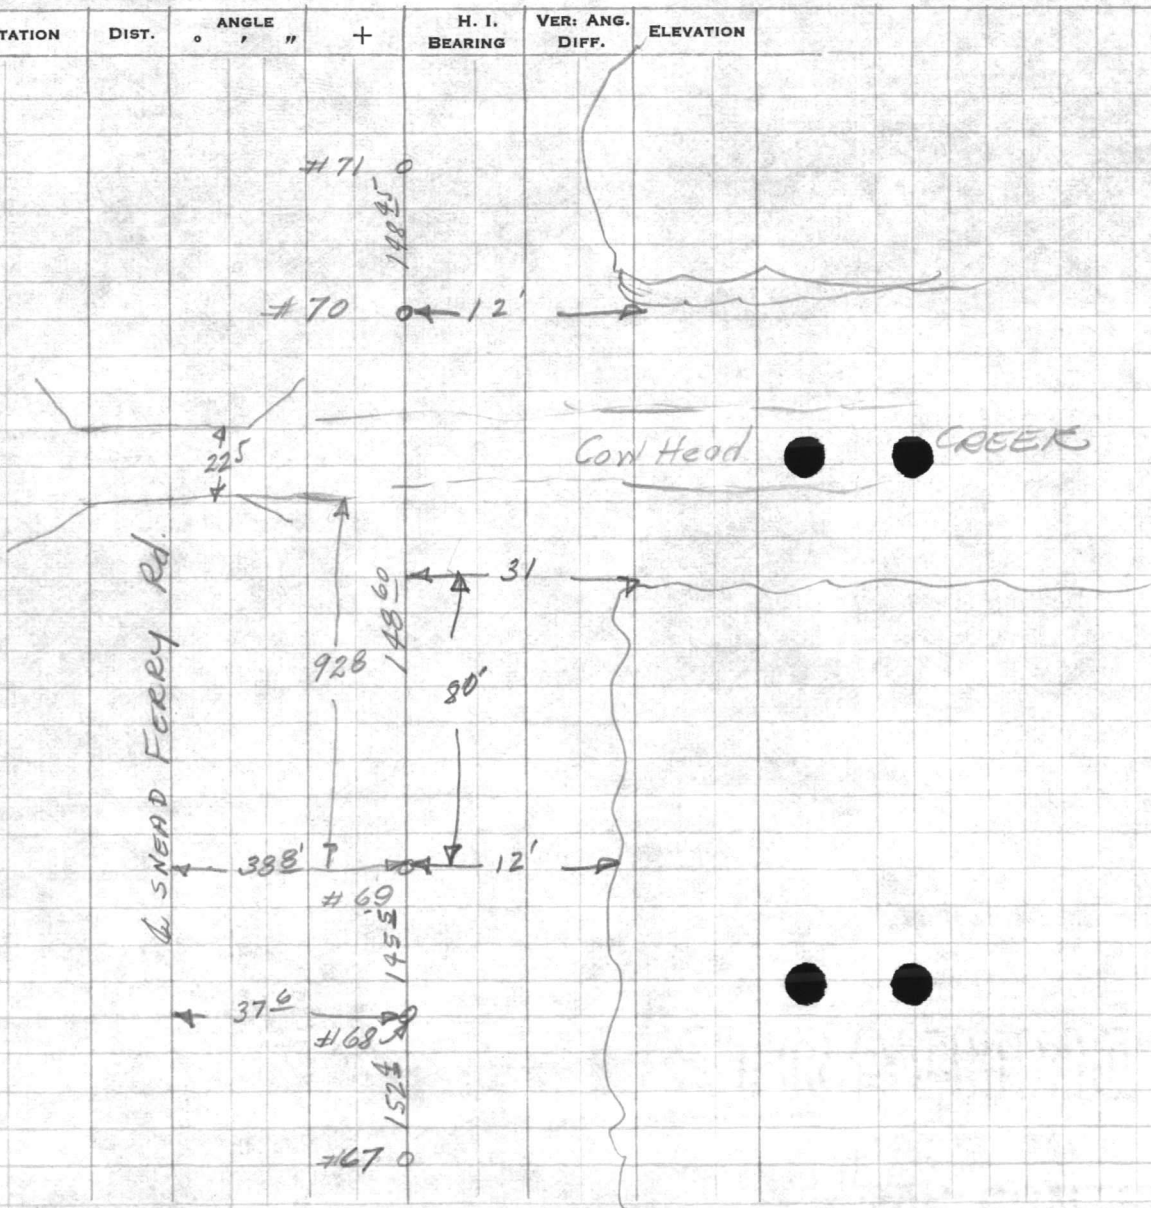













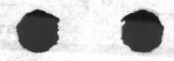

**VALUABLE**

SUBJECT \_\_\_\_\_  
\_\_\_\_\_  
\_\_\_\_\_  
RETURN TO  
PUBLIC WORKS  
OFFICE  
CAMP LEJEUNE  
NORTH CAROLINA

**FIELD PARTY**

\_\_\_\_\_  
IN CHARGE  
\_\_\_\_\_  
INSTRUMENT  
\_\_\_\_\_  
NOTES  
\_\_\_\_\_  
TAPE READ  
\_\_\_\_\_  
TAPE OR ROD  
\_\_\_\_\_  
TAPE OR ROD  
\_\_\_\_\_  
INSTRUMENT NO.  
\_\_\_\_\_  
TAPE NO.

**WEATHER**

CLEAR  
CLOUDY  
WINDY  
RAIN  
FAIR  
SNOW  
HOT  
MODERATE  
COLD  
FOG

FILE No. \_\_\_\_\_

FLDR. No. \_\_\_\_\_

FIGURED BY \_\_\_\_\_ SHEET 105f


NOTES CHECKED BY \_\_\_\_\_

PLOTTED BY \_\_\_\_\_ DATE \_\_\_\_\_ 19\_\_\_\_

Quad. No. \_\_\_\_\_

STATION	DIST.	ANGLE ° ' "	+	H. I. BEARING	VER: ANG. DIFF.	ELEVATION
---------	-------	----------------	---	------------------	--------------------	-----------

*B SNEAD FERRY RD*

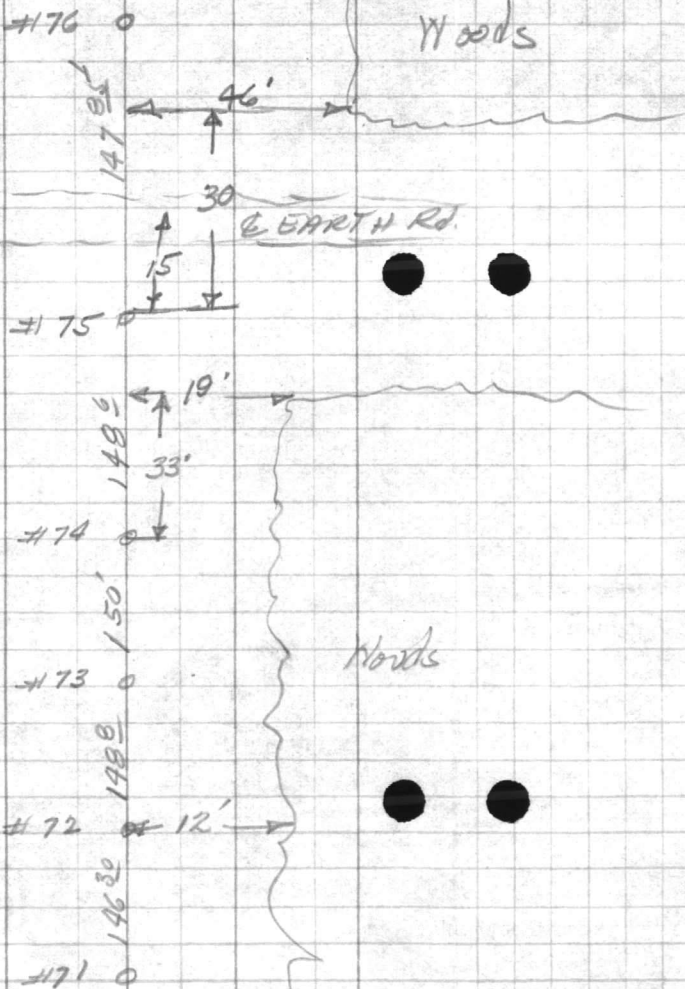




FIELD PARTY  
IN CHARGE  
INSTRUMENT  
NOTES  
TANG READ  
TANG ON ROD  
TANG NO.  
TANG NO.

WEATHER  
CLEAR  
CLOUDY  
WINDY  
RAIN  
FAIR  




VALUABLE

SUBJECT \_\_\_\_\_  
\_\_\_\_\_  
\_\_\_\_\_  
\_\_\_\_\_  
\_\_\_\_\_

RETURN TO  
PUBLIC WORKS  
OFFICE  
CAMP LEJEUNE  
NORTH CAROLINA

436

FIELD PARTY		WEATHER		FILE No. _____
_____	IN CHARGE	_____	CLEAR	_____
_____	INSTRUMENT	_____	CLOUDY	_____
_____	NOTES	_____	WINDY	_____
_____	TAPE READ	_____	RAIN	_____
_____	TAPE OR ROD	_____	FAIR	_____
_____	TAPE OR ROD	_____	SNOW	_____
_____	STRUMENT No.	_____	HOT	_____
_____	TAPE No.	_____	MODERATE	_____
		_____	COLD	_____
		_____	FOG	_____
		_____	FIGURED BY _____	SHEET _____
		_____	NOTES CHECKED BY _____	DATE _____ 19__
		_____	PLOTTED BY _____	
		_____	Quad. No. _____	

STATION	DIST.	ANGLE ° ' "	+	H. I. BEARING	VER: ANG. DIFF.	ELEVATION
---------	-------	----------------	---	------------------	--------------------	-----------

Profile East from Bear creek TO Level ground.

60' off E for Poles O.K.

Will take marked print in field for possible differential in Pole Heights.

Profile Around Curve East from Entrance TO "C" Range

Profile AT Triangle Outpost Intersection.

Location of Poles ON Duck creek starting Rd. 45' O.K.

Profile required from Triangle Outpost 1 mile west.

Profile KNOW near Anti Tank Range.

Profile AT Freeman's creek

Profile from intersection of Marine Rd. north TO End of Curve.

Profile Around Curve AT <sup>Last. Bridge</sup> Two pole branch P.C. TO P.T.


Profile AT French's creek on Marines Rd.

Profile AT Entrance Ad. TO French's creek  
Mon.

STATION DISTANCE  
BEARING  
DIP  
ELEVATION

STATION DISTANCE  
BEARING  
DIP  
ELEVATION


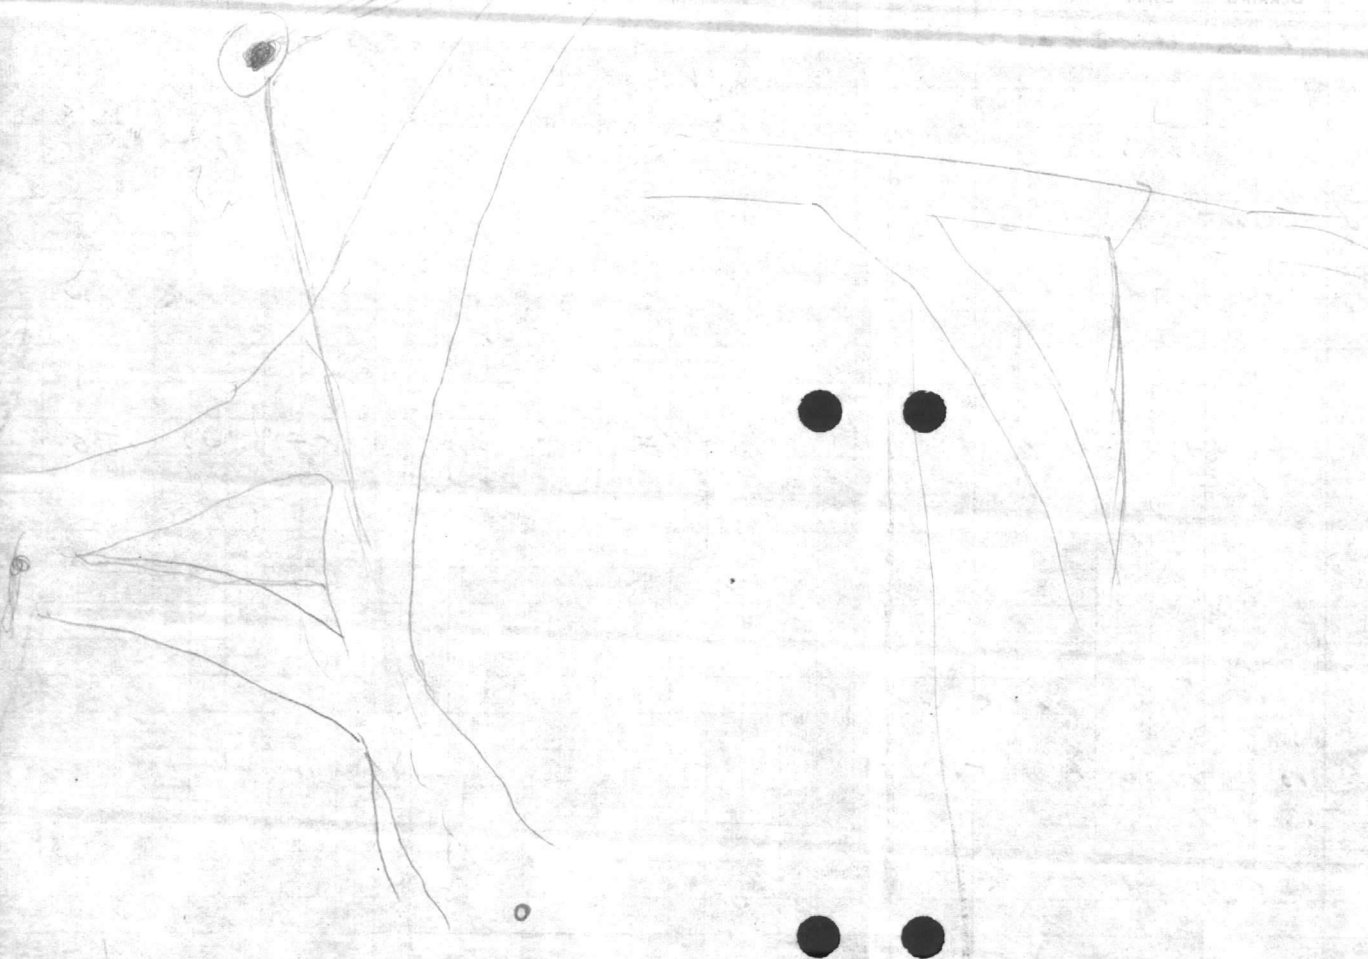

**VALUABLE**

SUBJECT \_\_\_\_\_  
\_\_\_\_\_  
\_\_\_\_\_  
\_\_\_\_\_  
\_\_\_\_\_

RETURN TO  
PUBLIC WORKS  
OFFICE  
CAMP LEJEUNE  
NORTH CAROLINA

**FIELD PARTY**

\_\_\_\_\_ IN CHARGE  
\_\_\_\_\_ INSTRUMENT  
\_\_\_\_\_ NOTES  
\_\_\_\_\_ TAPE READ  
\_\_\_\_\_ TAPE OR ROD  
\_\_\_\_\_ TAPE OR ROD  
\_\_\_\_\_ INSTRUMENT NO.  
\_\_\_\_\_ TAPE NO.

**WEATHER**

CLEAR  
CLOUDY  
WINDY  
RAIN  
FAIR  
SNOW  
HOT  
MODERATE  
COLD  
FOG


FILE No. \_\_\_\_\_  
FLDR. No. \_\_\_\_\_  
SHEET \_\_\_\_\_  
DATE \_\_\_\_\_ 19\_\_

Quad. No. \_\_\_\_\_

TO INDIAN  
941.2016  
75°  
5-130  
201'  
43'  
201'  
941.5  
235'  
5-131  
901

5-128

STATION	DIST.	ANGLE		+	H. I. BEARING	VER: ANG. DIFF.	ELEVATION
		'	"				

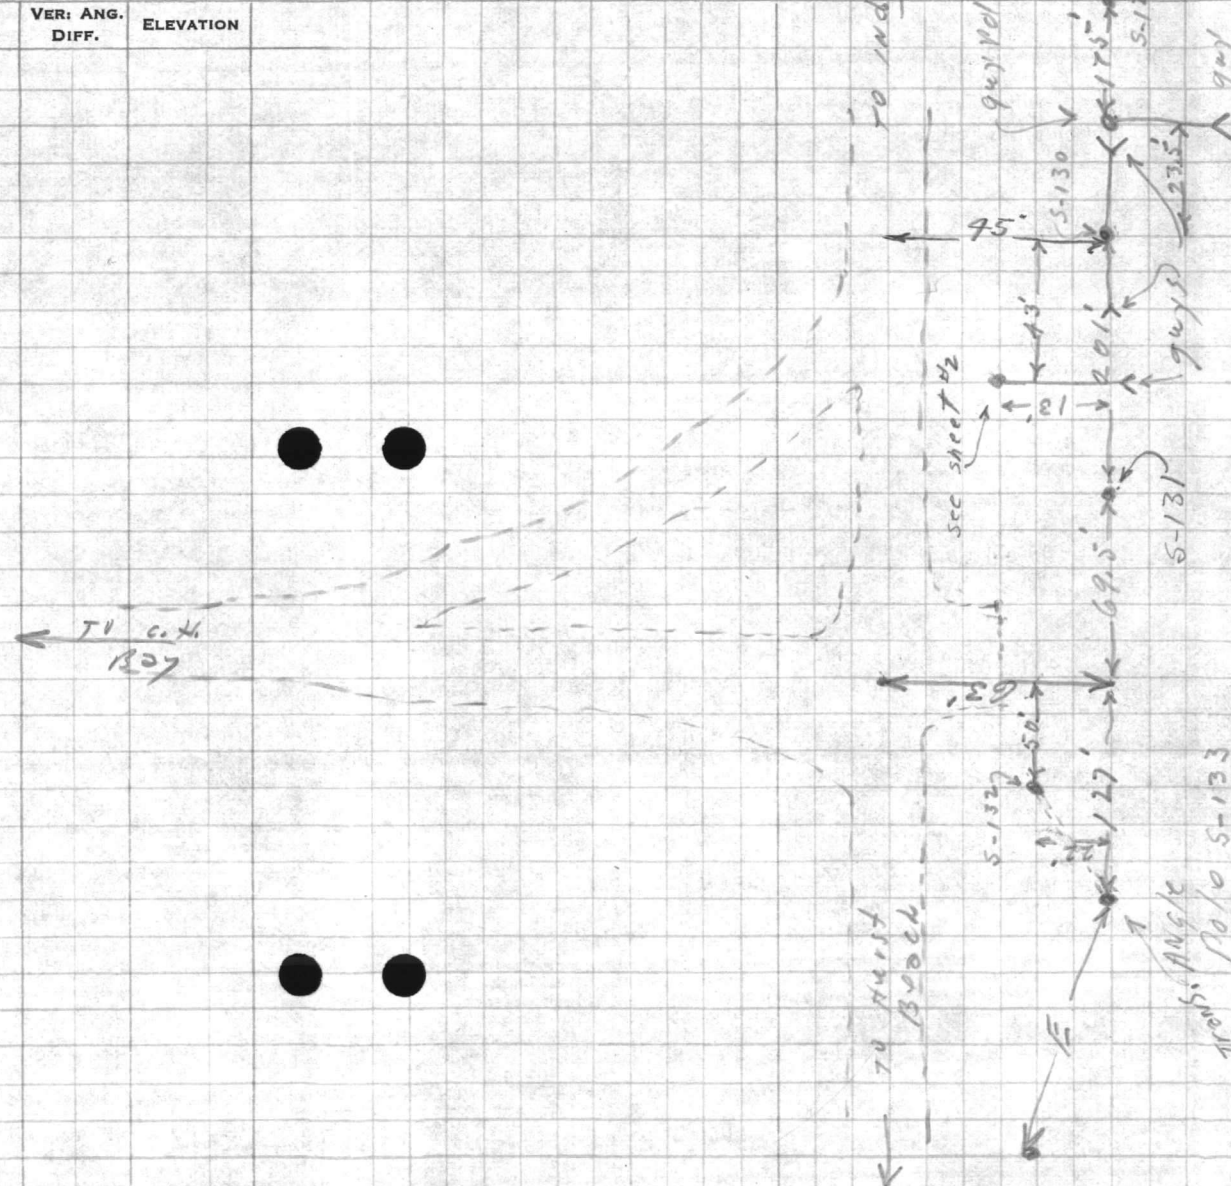

























**VALUABLE**

SUBJECT \_\_\_\_\_

RETURN TO  
PUBLIC WORKS  
OFFICE  
CAMP LEJEUNE  
NORTH CAROLINA

**FIELD PARTY**

\_\_\_\_\_  
IN CHARGE  
\_\_\_\_\_  
INSTRUMENT  
\_\_\_\_\_  
NOTES  
\_\_\_\_\_  
TAPE READ  
\_\_\_\_\_  
TAPE OR ROD  
\_\_\_\_\_  
TAPE OR ROD  
\_\_\_\_\_  
INSTRUMENT NO.  
\_\_\_\_\_  
TAPE NO.

**WEATHER**

CLEAR  
CLOUDY  
WINDY  
RAIN  
FAIR

SNOW  
HOT  
MODERATE  
COLD  
FOG

FILE No. \_\_\_\_\_

FLDR. No. \_\_\_\_\_


SHEET \_\_\_\_\_


NOTES CHECKED BY \_\_\_\_\_

PLOTTED BY \_\_\_\_\_ DATE \_\_\_\_\_ 19\_\_

Quad. No. \_\_\_\_\_

STATION	DIST.	ANGLE		+	H. I. BEARING	VER. ANG. DIFF.	ELEVATION
		°	"				

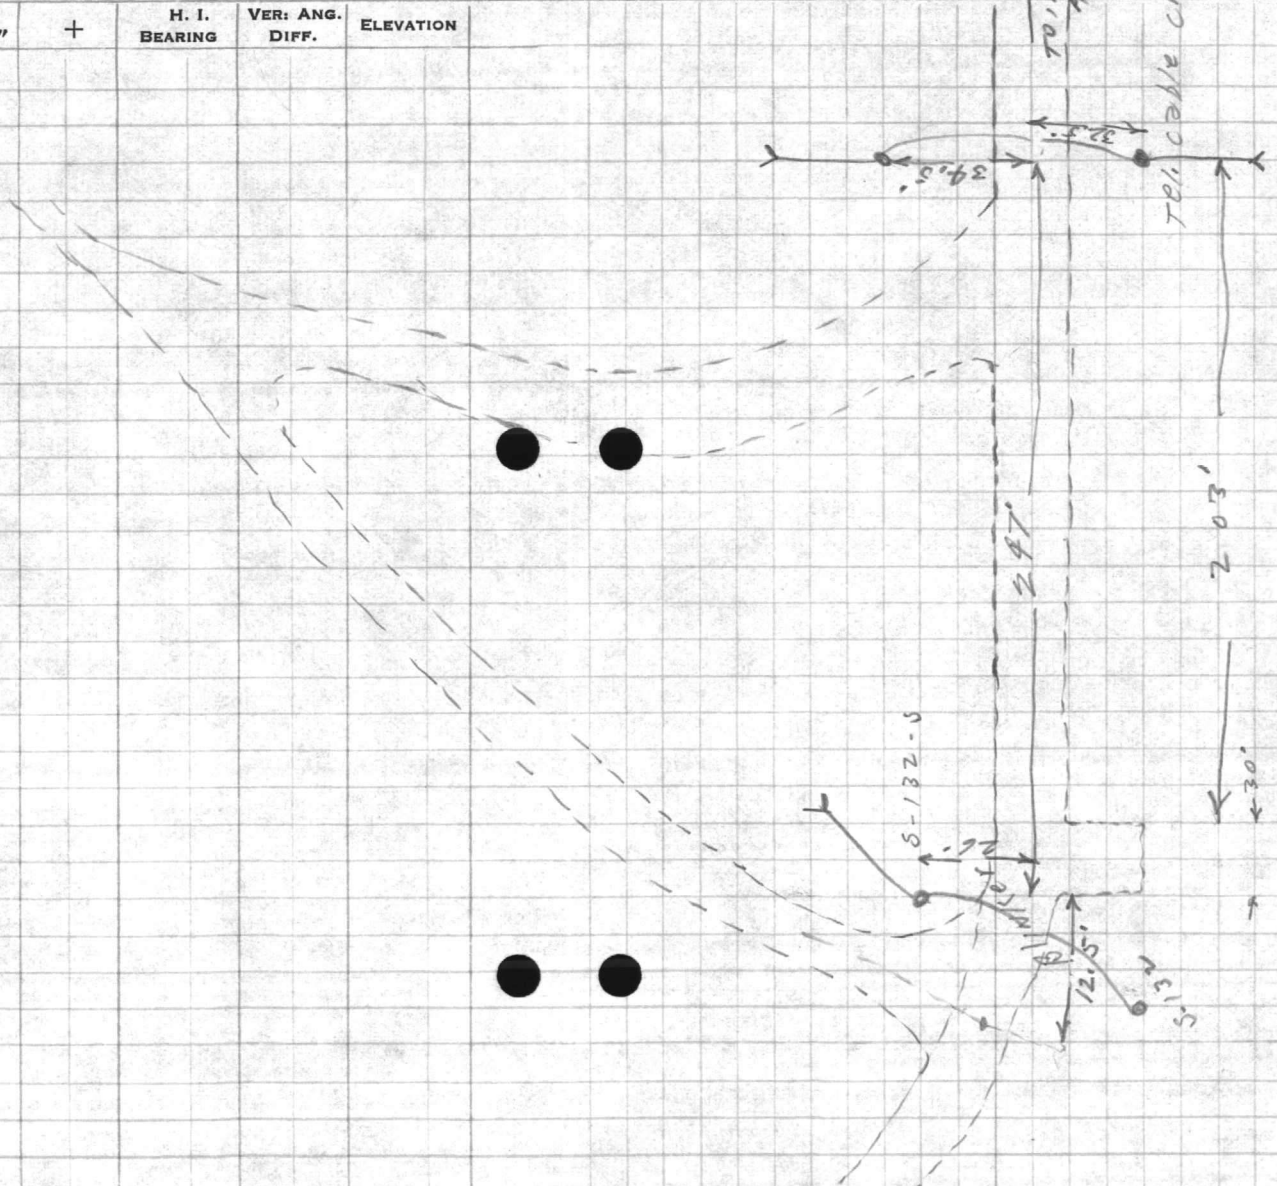

 

VALUABLE

RETURN TO  
PUBLIC WORKS  
OFFICE  
CAMP LEJEUNE  
NORTH CAROLINA

SUBJECT

Tel. Pole Height AT  
Sneads Ferry - Morines Rd.  
Intersection

FIELD PARTY

\_\_\_\_ IN CHARGE  
\_\_\_\_ INSTRUMENT  
\_\_\_\_ NOTES  
\_\_\_\_ TAPE READ  
\_\_\_\_ TAPE OR ROD  
\_\_\_\_ TAPE OR ROD  
\_\_\_\_ INSTRUMENT NO.  
\_\_\_\_ TAPE NO.

WEATHER

CLEAR  
CLOUDY  
WINDY  
RAIN  
FAIR

SNOW  
HOT  
MODERATE  
COLD  
FOG

FILE No. \_\_\_\_\_

FLDR. No. \_\_\_\_\_

SHEET 1-A

DATE 5-16-57

FIGURED BY \_\_\_\_\_  
NOTES CHECKED BY \_\_\_\_\_  
PLOTTED BY \_\_\_\_\_  
Quad. No. \_\_\_\_\_

STATION	DIST.	ANGLE ° ' "	+	H. I. BEARING	VER. ANG. DIFF.	ELEVATION
---------	-------	----------------	---	------------------	--------------------	-----------

						Height
	75'	12° 10' "		6.19		22.4
	75'	13° 12' "		6.19		23.8
	75'	14° 04' "		6.19		25.0
	75'	15° 29' "		6.19		
	75'	16° 50' "		6.19		
	75'	17° 18' "		6.19		29.6

Tel. cable

BOTTOM wire to C.H. 224

TOP " " " "

TOP of BOTTOM CROSS ARM

TOP of TOP CROSS ARM

TOP of Pole













**VALUABLE**

SUBJECT \_\_\_\_\_

RETURN TO  
PUBLIC WORKS  
OFFICE  
CAMP LEJEUNE  
NORTH CAROLINA

**FIELD PARTY**

\_\_\_\_\_  
IN CHARGE  
\_\_\_\_\_  
INSTRUMENT  
\_\_\_\_\_  
NOTES  
\_\_\_\_\_  
TAPE READ  
\_\_\_\_\_  
TAPE OR ROD  
\_\_\_\_\_  
TAPE OR ROD  
\_\_\_\_\_  
INSTRUMENT NO.  
\_\_\_\_\_  
TAPE NO.

**WEATHER**

CLEAR  
CLOUDY  
WINDY  
RAIN  
FAIR

SNOW  
HOT  
MODERATE  
COLD  
FOG

FILE No. \_\_\_\_\_

FLDR. No. \_\_\_\_\_


FIGURED BY \_\_\_\_\_ SHEET \_\_\_\_\_

NOTES CHECKED BY \_\_\_\_\_

PLOTTED BY \_\_\_\_\_ DATE \_\_\_\_\_ 19\_\_

Quad. No. \_\_\_\_\_

STATION	DIST.	ANGLE			H. I.	VER. ANG.	ELEVATION
		°	'	"			

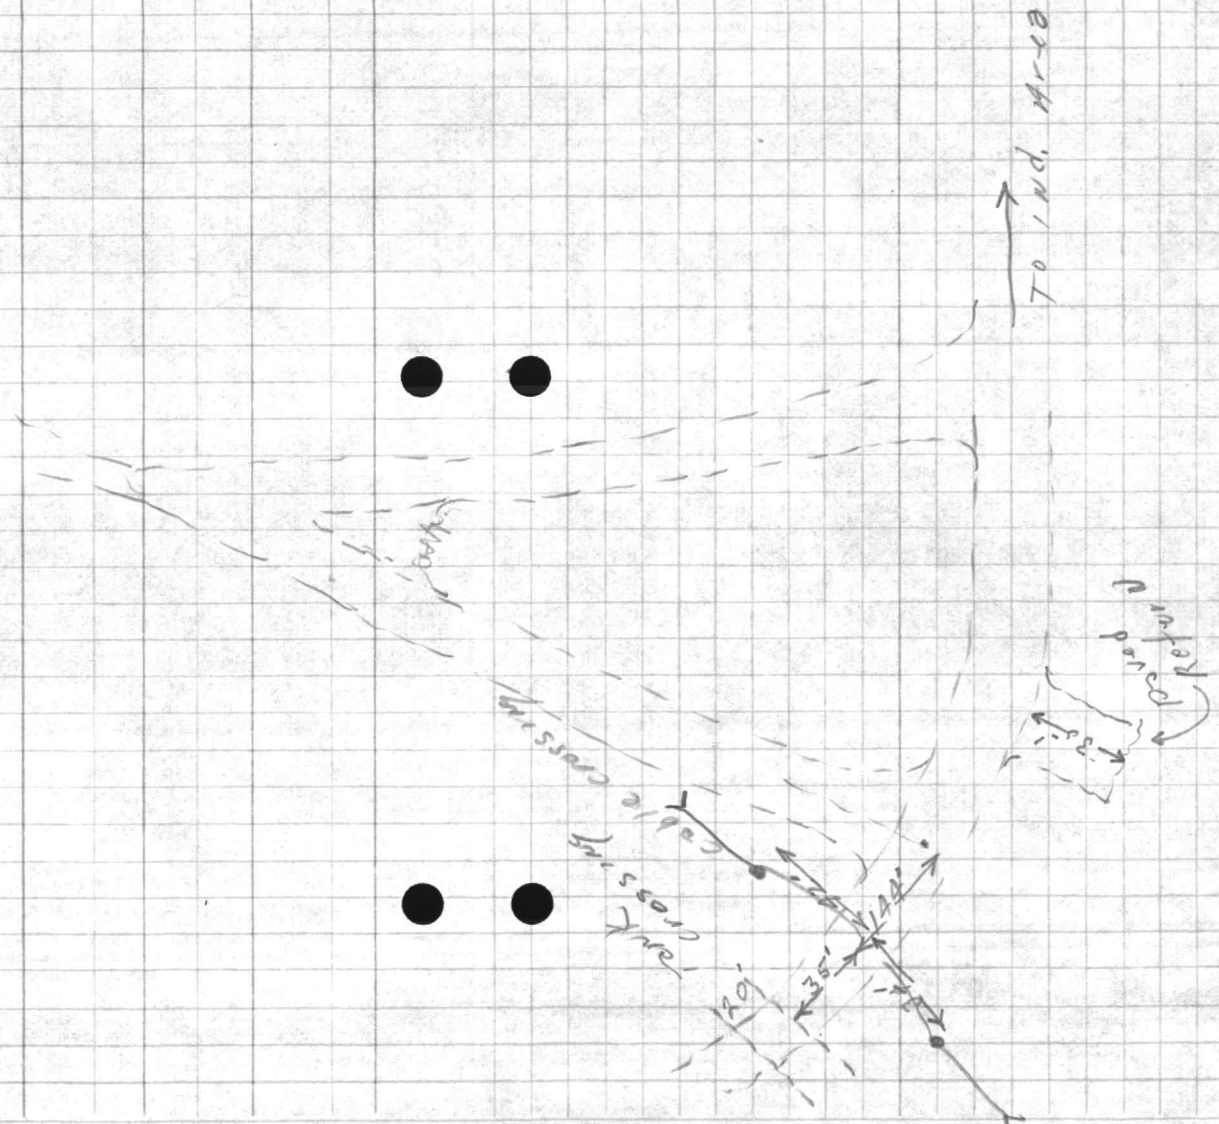



STATION

BEARING  
DIRE.

ELEVATION



VALUABLE

SUBJECT

BLDG 908 (Addition)

Location & Elev. of  
Water Lines

Return To  
Public Works  
Office  
Camp Lejeune  
North Carolina

FIELD PARTY

Sandelin In Charge  
Coulter Instrument  
S - Notes  
Kotchev Tape Read  
Tape or Rod  
Tape or Rod  
Instrument No.  
Tape No.

WEATHER

Clear  
Cloudy  
Windy  
Rain  
Fair  
Snow  
Hot  
Moderate  
Cold  
Fog

FILE No. 160-D

Fldr. No.

Sheet

Figured By

Notes Checked By

Plotted By


Date 19

Quad. No.

Station	Dist.	Angle	"	+	H. I. Bearing	Ver: Ang. Diff.	Elevation
BM		387	34	37			30.50
"A"	On top 6" Water line	76			26	77	
"B"	" " " " "	84			26	0	
"C"	" " " " "	63			28	1	
"D"	" " " " "	77			26	7	
"E"	" " " " "	73			27	1	

On Fin. Fl. Warehouse

BLDG 908  
(Addition)

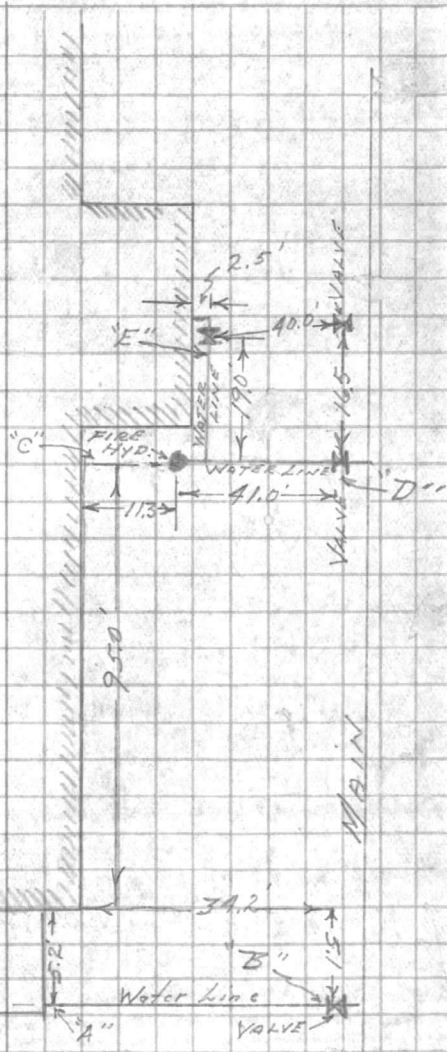

May 28 267

AVAILABLE

Return To  
Public Works  
Office  
Camp Lejeune  
North Carolina

SUBJECT

\_\_\_\_\_

\_\_\_\_\_

\_\_\_\_\_

\_\_\_\_\_

\_\_\_\_\_

FIELD PARTY

In Charge \_\_\_\_\_

Instrument \_\_\_\_\_

Name \_\_\_\_\_

Type Rod \_\_\_\_\_

Type of Rod \_\_\_\_\_

Type of Rod \_\_\_\_\_

Instrument No. \_\_\_\_\_

Type No. \_\_\_\_\_

WEATHER

Clear \_\_\_\_\_

Cloudy \_\_\_\_\_

Windy \_\_\_\_\_

Cold \_\_\_\_\_

Rain \_\_\_\_\_

Fog \_\_\_\_\_

Plotted By \_\_\_\_\_

Checked By \_\_\_\_\_

Plotted By \_\_\_\_\_

FILE NO.

\_\_\_\_\_

\_\_\_\_\_

\_\_\_\_\_

\_\_\_\_\_

\_\_\_\_\_

\_\_\_\_\_

\_\_\_\_\_

\_\_\_\_\_

Station

Date

Angle

Type

Sighting

ON

Horizontal

RECEIVED  
 PUBLIC WORKS  
 OFFICE  
 CAMP LEJEUNE  
 NORTH CAROLINA

VALUABLE

SUBJECT water line stub  
Locations at Butler  
BLDGs under construction  
on Michael Road.

Return To  
 Public Works  
 Office  
 Camp Lejeune  
 North Carolina

FIELD PARTY  
Kellum In Charge  
 \_\_\_\_\_ Instrument  
 \_\_\_\_\_ Notes  
 \_\_\_\_\_ Tape Read  
 \_\_\_\_\_ Tape or Rod  
 \_\_\_\_\_ Tape or Rod  
 \_\_\_\_\_ Instrument No.  
 \_\_\_\_\_ Tape No.

WEATHER  
 Clear \_\_\_\_\_  
 Cloudy \_\_\_\_\_  
 Windy \_\_\_\_\_  
 Rain \_\_\_\_\_  
 Fair \_\_\_\_\_  
 Snow \_\_\_\_\_  
 Hot \_\_\_\_\_  
 Moderate \_\_\_\_\_  
 Cold \_\_\_\_\_  
 Fog \_\_\_\_\_  
 Figured By \_\_\_\_\_  
 Notes Checked By \_\_\_\_\_  
 Plotted By \_\_\_\_\_

FILE No. 140-D  
 Fldr. No. \_\_\_\_\_  
 Sheet 1-0 F-1  
 Date 5-23-19 49

Quad. No. \_\_\_\_\_

Station	Dist.	Angle	"	+	H. I. Bearing	Ver: Ang. Diff.	Elevation
---------	-------	-------	---	---	---------------	-----------------	-----------

<u>Blk.</u>							<u>31.57</u>
-------------	--	--	--	--	--	--	--------------

2.75 34.32

5.91 28.41


6.15 28.17

spike in stump on north side of Michael Rd.  
near inspectors shack

TOP of 6" C.I. water stub

Michael Road

TOP of 4" C.I. water stub

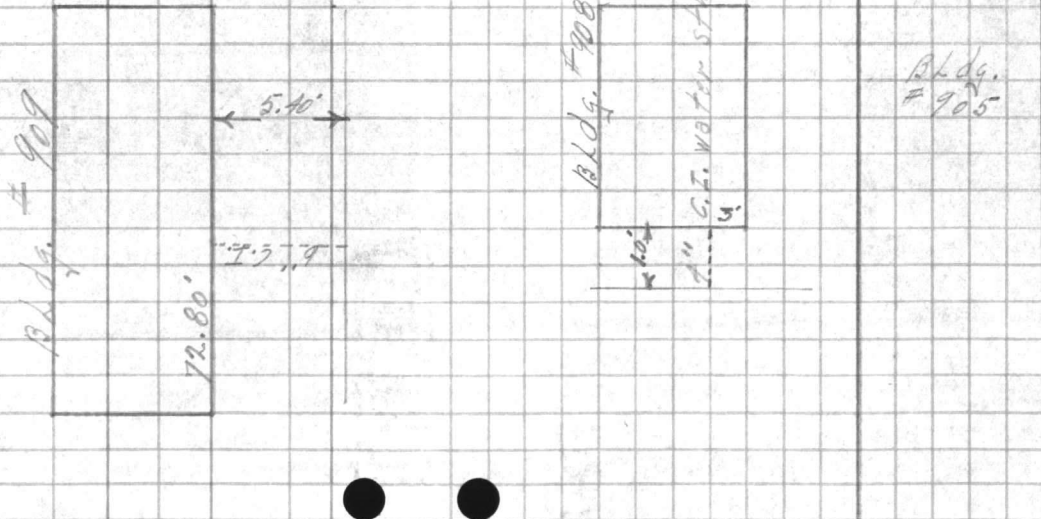

SNEEDS FERRY ROAD

VALENTINE

Subject

Return To  
Public Works  
Office  
Camp Lejeune  
North Carolina

Station

Angle

Bearing

Miles

Altitude

FIELD PARTY

Lin Charge

Instrument

Notes

Tapo Book

Tapo or Rqd

Tapo or Rqd

Instrument No.

Tapo No.

WEATHER

Snow

Clouds

Wind

Temp

Notes

Checked by

Plotted by

(Sheet No.)

FILE No.

Field No.

Sheet

Date

VALUABLE

SUBJECT Water Dist. - As built

Electronics Bldg. - Ind. Area Exp.

Return To  
Public Works  
Office  
Camp Lejeune  
North Carolina

FIELD PARTY  
Tuehington In Charge  
Instrument \_\_\_\_\_  
Notes \_\_\_\_\_  
Tape Read \_\_\_\_\_  
Tape or Rod \_\_\_\_\_  
Tape or Rod \_\_\_\_\_  
Instrument No. \_\_\_\_\_  
Tape No. \_\_\_\_\_


WEATHER  
Clear \_\_\_\_\_  
Cloudy \_\_\_\_\_  
Windy \_\_\_\_\_  
Rain \_\_\_\_\_  
Fair \_\_\_\_\_  
Snow \_\_\_\_\_  
Hot \_\_\_\_\_  
Moderate \_\_\_\_\_  
Cold \_\_\_\_\_  
Fog \_\_\_\_\_  
Figured By \_\_\_\_\_  
Notes Checked By \_\_\_\_\_  
Plotted By \_\_\_\_\_

FILE No. 160-D  
Fldr. No. \_\_\_\_\_  
Sheet # 107  
Date 8/12 19 49

Quad. No. \_\_\_\_\_

Station	Dist.	Angle	H. I. Bearing	Ver. Ang. Diff.	Elevation
B.M. ?					3160
		286	3446		
0400	"T."	EXIST		1040	24.1
+14.5	Valve			1029	
31				999	
70				916	
1723				929	25.2
14528	Front Bldg.				
+76.2	8" x 4" T	to Bldg		912	25.34
2				901	
+50				926	
88.3	8" x 4" T	to Bldg		908	25.4
3				904	
+52	Rear Bldg			940	25.1
79	Exc. Pipe	8/12/49		950	
91	8" x 6" T				
B.M.				286	

Whse # 909

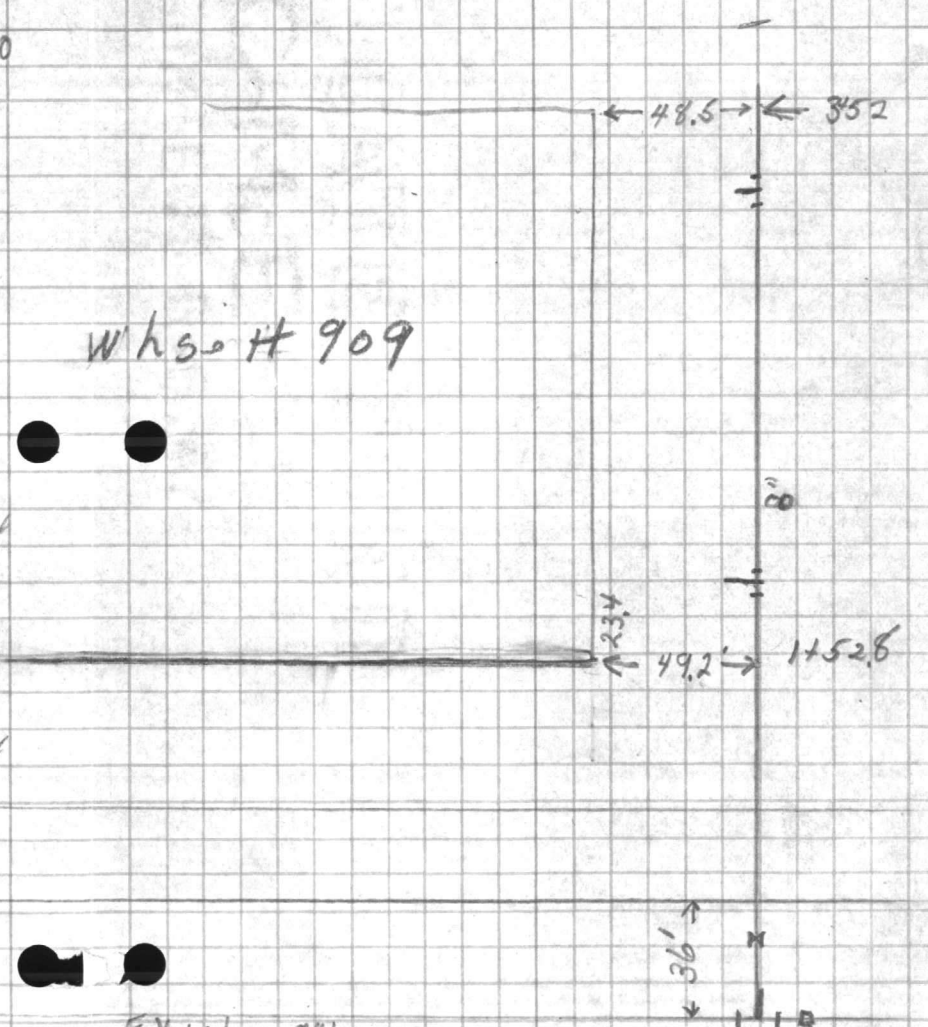










VALUABLE

SUBJECT \_\_\_\_\_

Return To  
Public Works  
Office  
Camp Lejeune  
North Carolina

FIELD PARTY

\_\_\_\_\_ In Charge  
\_\_\_\_\_ Instrument  
\_\_\_\_\_ Notes  
\_\_\_\_\_ Tape Read  
\_\_\_\_\_ Tape or Rod  
\_\_\_\_\_ Tape or Rod  
\_\_\_\_\_ Instrument No.  
\_\_\_\_\_ Tape No.

WEATHER

Clear \_\_\_\_\_  
Cloudy \_\_\_\_\_  
Windy \_\_\_\_\_  
Rain \_\_\_\_\_  
Fair \_\_\_\_\_  
Snow \_\_\_\_\_  
Hot \_\_\_\_\_  
Moderate \_\_\_\_\_  
Cold \_\_\_\_\_  
Fog \_\_\_\_\_

FILE No. \_\_\_\_\_

Fldr. No. \_\_\_\_\_



Figured By \_\_\_\_\_ Sheet \_\_\_\_\_

Notes Checked By \_\_\_\_\_

Plotted By \_\_\_\_\_ Date \_\_\_\_\_ 19\_\_

Quad. No. \_\_\_\_\_

Station	Dist.	Angle " +	H. I. Bearing	Ver: Ang. Diff.	Elevation
BM on Smead Ferry Rd					30 28
0+00 Exit "T"	435		3463	8 39	
0+04.3 Valve Top stem				6 73	
+40				7 65	
58.6	Line Bldg			7 14	
59.7	"T" to Bld			7 16	
98.6	Bldg line			6 90	
134.9	Top Pipe at valve			6 32	
	Top stem			4 86	
144.2.2	Bldg # 909				
BM					303 3160

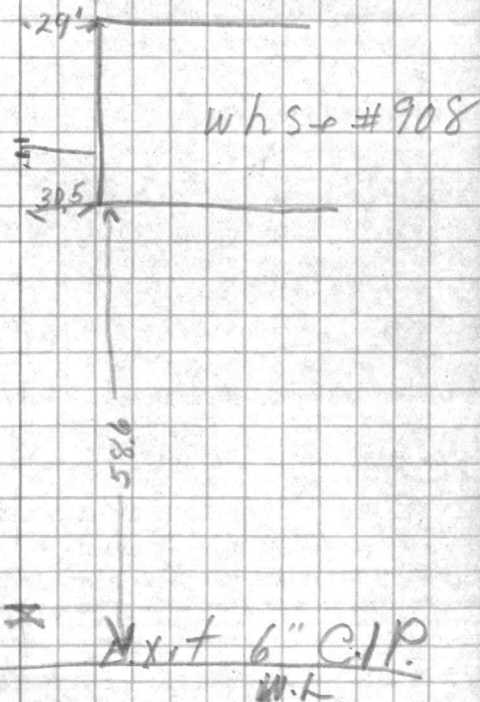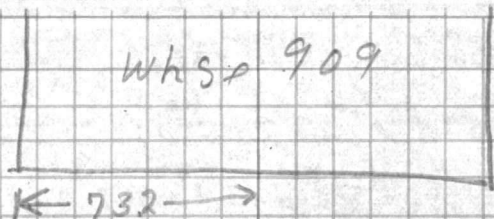








Blank lined area with faint markings and bleed-through from the reverse side of the page.

**VALUABLE**

Return To  
Public Works  
Office  
Camp LeJeune  
North Carolina

SUBJECT Location of new 4" and 6"  
C.I. Water line at new addition to  
Bldg. 908


FIELD PARTY  
Murphy In Charge  
Instrument \_\_\_\_\_  
Notes \_\_\_\_\_  
Tape Read \_\_\_\_\_  
Tape or Rod \_\_\_\_\_  
Tape or Rod \_\_\_\_\_  
Instrument No. \_\_\_\_\_  
Tape No. \_\_\_\_\_

WEATHER  
Clear \_\_\_\_\_  
Cloudy \_\_\_\_\_  
Windy \_\_\_\_\_  
Rain \_\_\_\_\_  
Fair \_\_\_\_\_  
Snow \_\_\_\_\_  
Hot \_\_\_\_\_  
Moderate \_\_\_\_\_  
Cold \_\_\_\_\_  
Fog \_\_\_\_\_  
Figured By \_\_\_\_\_  
Notes Checked By \_\_\_\_\_  
Plotted By \_\_\_\_\_

FILE No. 160-D  
Fldr. No. \_\_\_\_\_  
Sheet 1051  
Date 19 Oct. 1951

Quad. No. \_\_\_\_\_

Station	Dist.	Angle "	+	H. I. Bearing	Ver: Ang. Diff.	Elevation	
B.M.						30.5	Floor elev. Bldg. 908
		4 24		34 74			
00+00					8 9	25 8	New 4" 2.1. Valve
+04					7 2	27 5	Valve
+38					7 8	26 9	Bldg. Cor.
+77.5					7 7	27 0	Bldg. Cor.
1+07					7 8	26 9	Elbow
+87					7 7	27 0	Existing line To Bldg 909
2+21-7					7 7	27 6	
2+25					6 7	28 0	Elbow
		4 24		30 5		30.5	

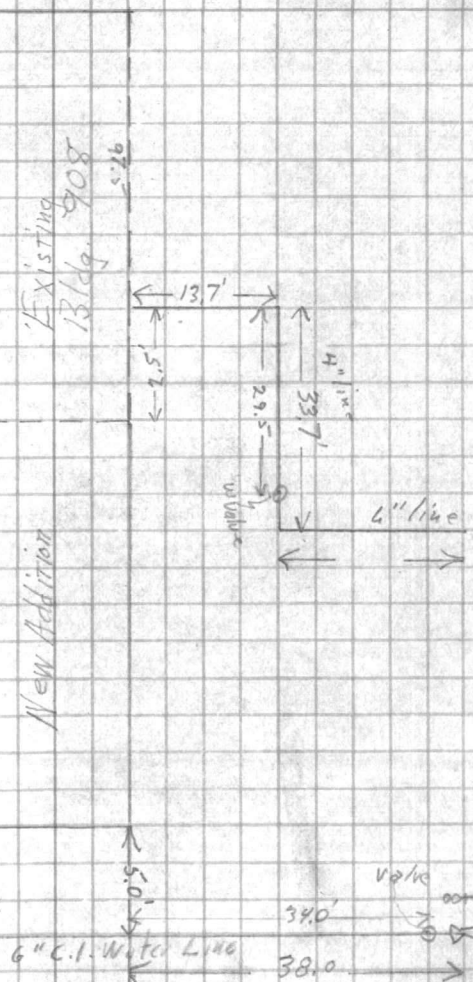



**VALENTINE**

Return To  
 Public Works  
 Office  
 North Carolina

Station \_\_\_\_\_  
 Dist. \_\_\_\_\_  
 Angle \_\_\_\_\_  
 H. I. Vantage Elevation \_\_\_\_\_  
 Bearing \_\_\_\_\_  
 Dist. \_\_\_\_\_

 

To  
 Office  
 Camp Lejeune  
 North Carolina

SUBJECT Warehouse Location  
Electronics Butler Bldgs.  
Sneads Ferry - Michael Rds.


FIELD PARTY  
Turley In Charge  
 Instrument \_\_\_\_\_  
 Notes \_\_\_\_\_  
 Tape Read \_\_\_\_\_  
 Tape or Rod \_\_\_\_\_  
 Tape or Rod \_\_\_\_\_  
 Instrument No. \_\_\_\_\_  
 Tape No. \_\_\_\_\_

WEATHER  
 Clear \_\_\_\_\_  
 Cloudy \_\_\_\_\_  
 Windy \_\_\_\_\_  
 Rain \_\_\_\_\_  
 Fair \_\_\_\_\_  
 Snow \_\_\_\_\_  
 Hot \_\_\_\_\_  
 Moderate \_\_\_\_\_  
 Cold \_\_\_\_\_  
 Fog \_\_\_\_\_  
 Figured By \_\_\_\_\_  
 Notes Checked By \_\_\_\_\_  
 Plotted By \_\_\_\_\_

FILE No. 160-0  
 Fldr. No. \_\_\_\_\_  
 Sheet 1-2  
 Date 7/1/49 19 49

Quad. No. \_\_\_\_\_

Station	Dist.	Angle	"	+	H. I. Bearing	Ver: Ang. Diff.	Elevation
---------	-------	-------	---	---	------------------	--------------------	-----------

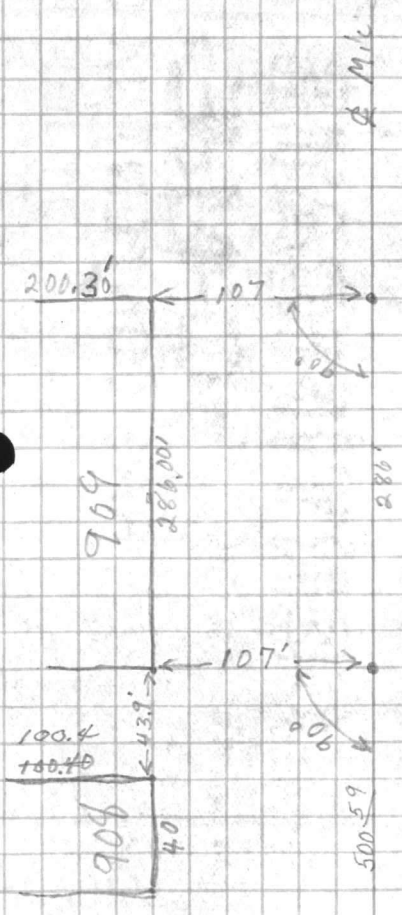

$$\begin{array}{r}
 500.59 \\
 - 215.00 \\
 \hline
 285.59
 \end{array}$$

Nail Sneads Ferry Rd  
 + Michael Rd

FIELD PARTY

\_\_\_\_\_ in charge  
\_\_\_\_\_ Instructor  
\_\_\_\_\_ Notes  
\_\_\_\_\_ Type Road  
\_\_\_\_\_ Type of Road  
\_\_\_\_\_ Type of Soil  
\_\_\_\_\_ Number  
\_\_\_\_\_ Type No.

WEATHER

\_\_\_\_\_ Clouds  
\_\_\_\_\_ Wind  
\_\_\_\_\_ Rain  
\_\_\_\_\_ Fog

OTHER

\_\_\_\_\_ Reported by  
\_\_\_\_\_ Checked by  
\_\_\_\_\_ Date


STATION \_\_\_\_\_

\_\_\_\_\_

\_\_\_\_\_

\_\_\_\_\_

\_\_\_\_\_

 



SUBJECT

Work  
Camp  
With

Station

Disc

Angle

M. J. Gearing

Vertical Station

FIELD PARTY

In Charge

Instrument

Notes

Tape Measure

Type of Rod

Type of Rod

Remarks

Time

WEATHER

Clear

Partly Cloudy

Light

Variable

Wind

Force

Direction

Remarks

FILE No.

Field No.

Checked By

Checked By

Date

Hand No.



PUBLIC WORKS DEPARTMENT  
Camp Lejeune, North Carolina  
Survey Department

File 160-D  
Quadrangle \_\_\_\_\_  
Date 7/5/49  
Sheet 47 of 7

Traverse Computation  
Description

*Electronics Addition - Butler Bldg. Co-ords. Michael + S.F. Pds.*

Station	Distance	Bearing	Cosine	Sine	Latitude	Departure	Y Coordinate North	X Coordinate East
<i>Nail Int. of Swards Ferry + Michael Pds.</i>		<i>548°24'26"W</i>	<i>To Michael Rd. + Ask St.</i>				<i>340,352.01</i>	<i>2,503,347.62</i>
<i>P.O.T.</i>	<i>500.64</i>	<i>"</i>	<i>663832</i>	<i>7478818</i>	<i>332.34</i> ✓	<i>374.42</i> ✓	<i>340,019.67</i>	<i>2,502,973.20</i>
<i>N.E. Cor. Bldg. #909 Butler Bldg.</i>	<i>107.00</i>	<i>541-35-34E</i>	<i>7478818</i> ✓	<i>663832</i> ✓	<i>80.02</i> ✓	<i>71.03</i> ✓	<i>339,939.65</i>	<i>2,503,044.23</i>
<i>P.O.T.</i>	<i>286.00</i>	<i>548-24-26W</i>	<i>663832</i>	<i>7478818</i>	<i>189.86</i> ✓	<i>213.89</i> ✓	<i>339,829.81</i>	<i>2,502,759.31</i>
<i>N.W. Cor. Bldg. #909 Butler Bldg.</i>	<i>107.00</i>	<i>541-35-34E</i>	<i>7478818</i>	<i>663832</i>	<i>80.02</i>	<i>71.03</i>	<i>339,749.79</i>	<i>2,502,830.34</i>

f



**VALUABLE**

RETURN TO  
PUBLIC WORKS  
OFFICE  
CAMP LEJEUNE  
NORTH CAROLINA

SUBJECT

Location of 2" G.I. Water  
for Proposed Head Facilities in  
Bldg. # 752-A  
Range Office Bldgs.

**FIELD PARTY**

IN CHARGE \_\_\_\_\_  
INSTRUMENT \_\_\_\_\_  
NOTES \_\_\_\_\_  
TAPE READ \_\_\_\_\_  
TAPE OR ROD \_\_\_\_\_  
TAPE OR ROD \_\_\_\_\_  
INSTRUMENT No. \_\_\_\_\_  
TAPE No. \_\_\_\_\_

**WEATHER**

CLEAR \_\_\_\_\_ SNOW \_\_\_\_\_  
CLOUDY \_\_\_\_\_ HOT \_\_\_\_\_  
WINDY \_\_\_\_\_ MODERATE \_\_\_\_\_  
RAIN \_\_\_\_\_ COLD \_\_\_\_\_  
FAIR \_\_\_\_\_ FOG \_\_\_\_\_

FILE No. 160-D


FLDR. No. \_\_\_\_\_

SHEET #1 of 1

DATE 12/4/1962

FIGURED BY \_\_\_\_\_  
NOTES CHECKED BY \_\_\_\_\_  
PLOTTED BY \_\_\_\_\_  
Quad. No. \_\_\_\_\_


STATION	DIST.	ANGLE ° ' "	+	H. I. BEARING	VER: ANG. DIFF.	ELEVATION
---------	-------	----------------	---	------------------	--------------------	-----------

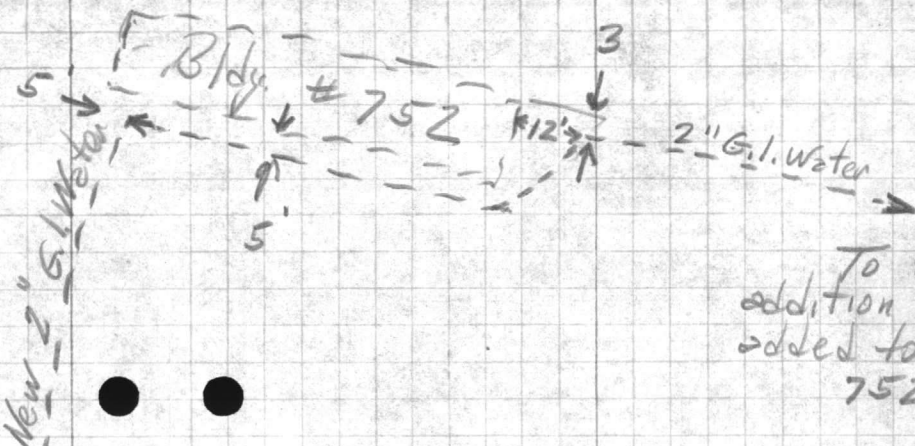

To an  
addition to be  
added to #  
752A

SNEADS FERRY ROAD

Old 51007

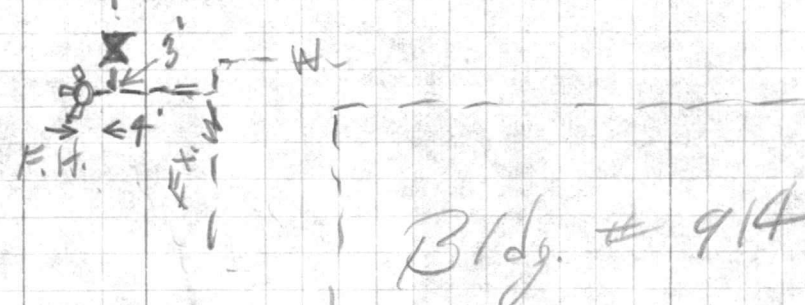







VALUABLE

Return To  
Public Works  
Office  
Camp Lejeune  
North Carolina

SUBJECT

6" CIP WATER LINE  
AT BLDG. 907

FIELD PARTY

Guthrie In Charge  
Instrument  
Notes  
Tape Read  
Tape or Rod  
Tape or Rod  
Instrument No.  
Tape No.

WEATHER

Clear  
Cloudy  
Windy  
Rain  
Fair  
Snow  
Hot  
Moderate  
Cold  
Fog

FILE No. 160-D

Fldr. No.


Sheet 1 of 1

Date 3/3

1952

Quad. No.

Station	Dist.	Angle	H. I.	Ver. Ang.	Elevation
		' "	Bearing	Diff.	

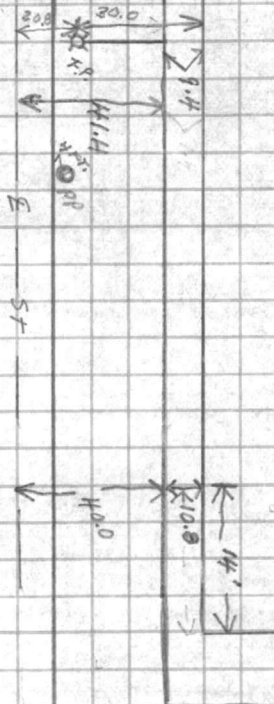

VALUABLE  
Return To  
Public Works  
Office  
Camp Lejeune  
North Carolina

SUBJECT

Station

Date

Barometer

Wind

Direction

WEATHER

FIELD PARTY

LINE NO.

Snow  
Fog  
Moderate  
Rain  
Fair

In Charge  
Instrument  
Notes

Plotted By

Legs Road

Notes Checked By


Type of Road

Plotted By

Table of Road

LINE NO.

Table No.

 

VALUABLE

Return To  
Public Works  
Office  
Camp Lejeune  
North Carolina


SUBJECT WATER LINE LOCATION  
AT WAREHOUSES ON LOUIS  
ROAD.

FIELD PARTY  
KELLMAN In Charge  
Instrument \_\_\_\_\_  
Notes \_\_\_\_\_  
Tape Read \_\_\_\_\_  
Tape or Rod \_\_\_\_\_  
Tape or Rod \_\_\_\_\_  
Instrument No. \_\_\_\_\_  
Tape No. \_\_\_\_\_

WEATHER  
Clear \_\_\_\_\_  
Cloudy \_\_\_\_\_  
Windy \_\_\_\_\_  
Rain \_\_\_\_\_  
Fair \_\_\_\_\_  
Snow \_\_\_\_\_  
Hot \_\_\_\_\_  
Moderate \_\_\_\_\_  
Cold \_\_\_\_\_  
Fog \_\_\_\_\_  
Figured By \_\_\_\_\_  
Notes Checked By \_\_\_\_\_  
Plotted By \_\_\_\_\_

FILE No. 160-0  
Fldr. No. \_\_\_\_\_  
Sheet 1-01-4  
Date 2-27-1947

Quad. No. 160

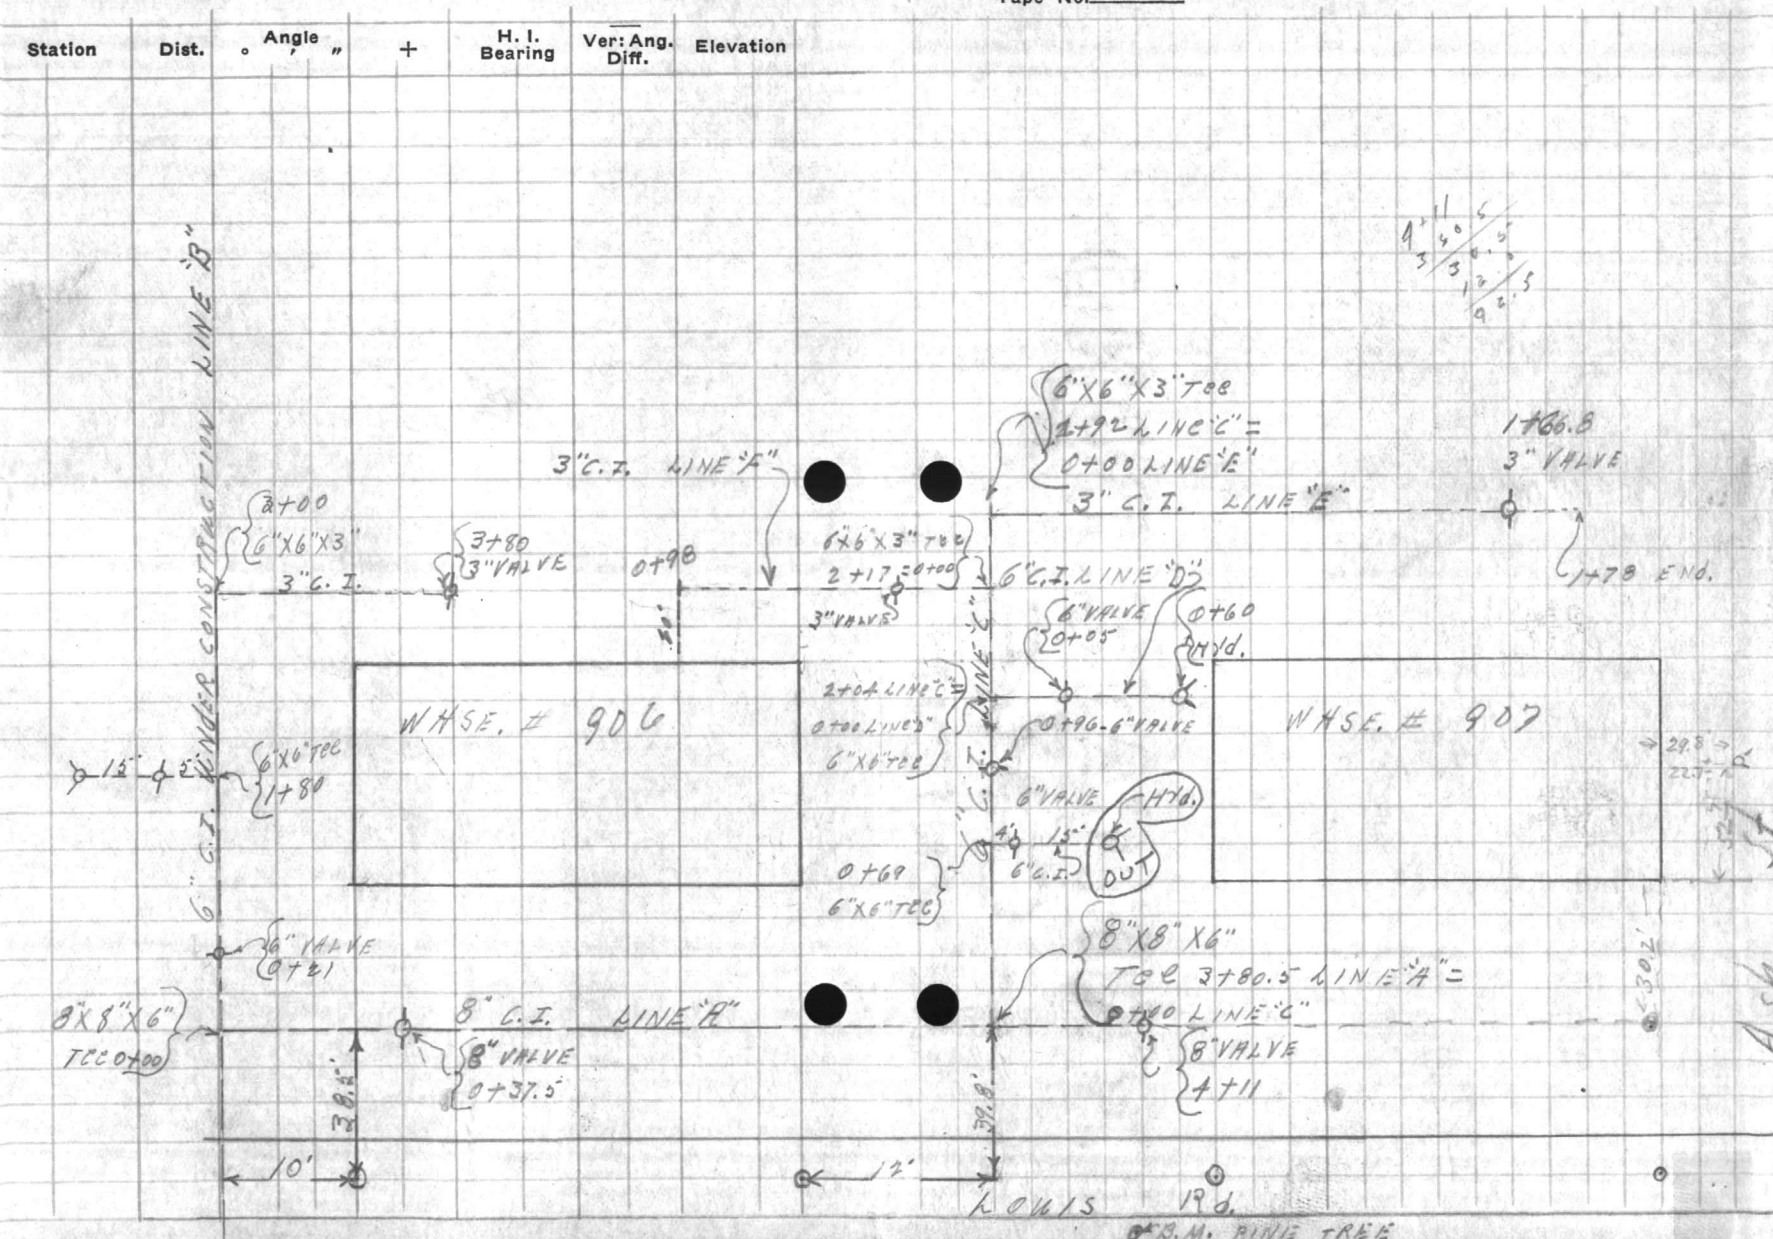



Handwritten notes on right side:  
 29.8  
 227  
 Ash  
 5302'

O.R.M. PINE TREE








VALUABLE

Return To  
Public Works  
Office  
Camp Lejeune  
North CarolinaSUBJECT PROFILE ON WATER LINE  
AT WAREHOUSES ON LOUIS ROAD,  
SEE SKETCH SHEET #1

## FIELD PARTY

KELLM In Charge  
Instrument \_\_\_\_\_  
Notes \_\_\_\_\_  
Tape Read \_\_\_\_\_  
Tape or Rod \_\_\_\_\_  
Tape or Rod \_\_\_\_\_  
Instrument No. \_\_\_\_\_  
Tape No. \_\_\_\_\_

## WEATHER

Clear \_\_\_\_\_  
Cloudy \_\_\_\_\_  
Windy \_\_\_\_\_  
Rain \_\_\_\_\_  
Fair \_\_\_\_\_  
Snow \_\_\_\_\_  
Hot \_\_\_\_\_  
Moderate \_\_\_\_\_  
Cold \_\_\_\_\_  
Fog \_\_\_\_\_FILE No. 160-D

Fldr. No. \_\_\_\_\_

Sheet 2-01-ADate 2-27-1947Figured By \_\_\_\_\_  
Notes Checked By \_\_\_\_\_  
Plotted By \_\_\_\_\_  
Quad. No. 160

Station	Dist.	Angle " "	+	H. I. Bearing	Ver: Ang. Diff.	Elevation	
B.M.			4.24	35° 31'		21.07	NAIL IN PINE TREE.
0+00					8.5		8" X 8" X 6" TEE
0+37.5					8.6		8" VALVE
0+50					8.6		
1+00					8.5		
1+50					8.8		
2+00					9.4		
2+50					10.3		
3+00					10.4		
3+50					10.5		
3+80.5					10.7	24.6	8" X 8" X 6" TEE
4+11					11.0		8" VALVE
0+50					11.2	24.1	
0+69					11.0	24.3	8" X 6" X 6" TEE
1' TO RT. VALVE					10.8		
15' RT. HYD.					10.2		








VALUABLE

 SUBJECT PROFILE ON WATER LINE  
CONTD. SEE SKETCH SHEET #1

 Return To  
 Public Works  
 Office  
 Camp Lejeune  
 North Carolina

 FIELD PARTY  
KELLM In Charge  
 \_\_\_\_\_ Instrument  
 \_\_\_\_\_ Notes  
 \_\_\_\_\_ Tape Read  
 \_\_\_\_\_ Tape or Rod  
 \_\_\_\_\_ Tape or Rod  
 \_\_\_\_\_ Instrument No.  
 \_\_\_\_\_ Tape No.

 WEATHER  
 Clear \_\_\_\_\_  
 Cloudy \_\_\_\_\_  
 Windy \_\_\_\_\_  
 Rain \_\_\_\_\_  
 Fair \_\_\_\_\_  
 Snow \_\_\_\_\_  
 Hot \_\_\_\_\_  
 Moderate \_\_\_\_\_  
 Cold \_\_\_\_\_  
 Fog \_\_\_\_\_  
 Figured By \_\_\_\_\_  
 Notes Checked By \_\_\_\_\_  
 Plotted By \_\_\_\_\_

 FILE No. \_\_\_\_\_  
 Fldr. No. \_\_\_\_\_  
 Sheet 3-014  
 Date 2-27-1917

Quad. No. \_\_\_\_\_

Station	Dist.	Angle "	+	H. I. Bearing	Ver: Ang. Diff.	Elevation	
				35.31			
				LINE "C" CONTD.			
0496	Valve				10.9	24.4	
1700					10.9	24.4	Top of Pipe Relayed to Permit Steam Line Const. by See Sheet Dated 6/25/17
1750					10.9	24.4	
2100					9.1	25.9	
2704	LINE "C" = 0400 LINE "D"				9.2	26.1	
				LINE "D"			
0405					9.1	24.2	Ø VALVE
0460					8.5	24.8	FIRE HYD.
				LINE "C"			
2750					8.7		
2792	LINE "C" = 0400 LINE "E"				7.0	28.3	6" X 6" X 3" TEE
				LINE "E"			
<del>0450</del>							
0450					7.1		
1700					7.1		
1750					7.1		
1766.8					7.0	28.3	3" VALVE

VALTARIL

Headquarters  
Public Works  
Office  
Camp Lejeune  

































VALUABLE

SUBJECT PROFILE OF WATER LINE  
CONTD. SEE SKETCH SHEET #1

Return To  
 Public Works  
 Office  
 Camp Lejeune  
 North Carolina

FIELD PARTY  
KELLY In Charge  
 \_\_\_\_\_ Instrument  
 \_\_\_\_\_ Notes  
 \_\_\_\_\_ Tape Read  
 \_\_\_\_\_ Tape or Rod  
 \_\_\_\_\_ Tape or Rod  
 \_\_\_\_\_ Instrument No.  
 \_\_\_\_\_ Tape No.

WEATHER  
 Clear \_\_\_\_\_  
 Cloudy \_\_\_\_\_  
 Windy \_\_\_\_\_  
 Rain \_\_\_\_\_  
 Fair \_\_\_\_\_  
 Snow \_\_\_\_\_  
 Hot \_\_\_\_\_  
 Moderate \_\_\_\_\_  
 Cold \_\_\_\_\_  
 Fog \_\_\_\_\_  
 Figured By \_\_\_\_\_  
 Notes Checked By \_\_\_\_\_  
 Plotted By \_\_\_\_\_

FILE No. \_\_\_\_\_  
 Fldr. No. \_\_\_\_\_  
 Sheet 1-01-A  
 Date 1-27- 1922

Quad. No. \_\_\_\_\_

Station	Dist.	Angle " "	+	H. I. Bearing	Ver: Ang. Diff.	Elevation	
				35.31			
				LINE "E" CONTD.			
1478					7.0		END.
				LINE "F"			
2417				LINE "E" = 0400 LINE "F"	9.0	26.3	6"X6"X3" T&C
0498					8.9	26.4	END.
R.M.					4.24	31.07	

VALUABLE

SUBJECT

Return To  
Public Works  
Office  









**VALUABLE**

SUBJECT PROFILE ON WATER  
LINE AT WARE HOUSES ON  
LOUIS ROAD

Return To  
 Public Works  
 Office  
 Camp Lejeune  
 North Carolina

FIELD PARTY  
WELLMAN In Charge  
 \_\_\_\_\_ Instrument  
 \_\_\_\_\_ Notes  
 \_\_\_\_\_ Tape Read  
 \_\_\_\_\_ Tape or Rod  
 \_\_\_\_\_ Tape or Rod  
 \_\_\_\_\_ Instrument No.  
 \_\_\_\_\_ Tape No.

WEATHER  
 Clear \_\_\_\_\_  
 Cloudy \_\_\_\_\_  
 Windy \_\_\_\_\_  
 Rain \_\_\_\_\_  
 Fair \_\_\_\_\_  
 Snow \_\_\_\_\_  
 Hot \_\_\_\_\_  
 Moderate \_\_\_\_\_  
 Cold \_\_\_\_\_  
 Fog \_\_\_\_\_  
 Figured By \_\_\_\_\_  
 Notes Checked By \_\_\_\_\_  
 Plotted By \_\_\_\_\_

FILE No. \_\_\_\_\_  
 Fldr. No. \_\_\_\_\_  
 Sheet 2-01  
 Date 3-4-1917

Quad. No. \_\_\_\_\_

Station	Dist.	Angle "	+	H. I. Bearing	Ver: Ang. Diff.	Elevation	
B.M.			3.99	37.42		33.45	NAIL IN PINE TREE AT EAST END OF EASTERN MOST WAREHOUSE
		LINE "B"					6" VALVE
0721					9.8		
1700					10.9		
1780					14.2		6"X6" T&C
2400					12.0		
3700					10.8		6"X6"X3" T&C
3780					9.4	28.0	3" VALVE
B.M.			3.99	37.42		33.45	

VALUABLE

SUBJECT

Return To  
Public Works  
Office  
Camp Lejeune  
North Carolina






















**VALUABLE**

RETURN TO  
PUBLIC WORKS  
OFFICE  
CAMP LEJEUNE  
NORTH CAROLINA

SUBJECT Floor Elev. Well  
House # 605 on  
Sneads Ferry Rd. Near  
Lynch Rd. Intersection

FIELD PARTY  
Kellam IN CHARGE  
INSTRUMENT \_\_\_\_\_  
NOTES \_\_\_\_\_  
TAPE READ \_\_\_\_\_  
TAPE OR ROD \_\_\_\_\_  
TAPE OR ROD \_\_\_\_\_  
STRUMENT No. \_\_\_\_\_  
TAPE No. \_\_\_\_\_

WEATHER  
CLEAR \_\_\_\_\_ SNOW \_\_\_\_\_  
CLOUDY \_\_\_\_\_ HOT \_\_\_\_\_  
WINDY \_\_\_\_\_ MODERATE \_\_\_\_\_  
RAIN \_\_\_\_\_ COLD \_\_\_\_\_  
FAIR \_\_\_\_\_ FOG \_\_\_\_\_

FILE No. 160-D  
FLDR. No. \_\_\_\_\_  
SHEET 1-0 f  
DATE 7-23-57

Quad. No. \_\_\_\_\_

STATION	DIST.	ANGLE		+	H. I. BEARING	VER: ANG. DIFF.	ELEVATION	
		°	"					
<u>B.M.</u>				✓			<u>30.48</u> ✓	<u>IN tele. pole 50' East of well #605</u>
		<u>3.76</u>	<u>34.24</u>	✓				
<u>Fin. Floor</u>				✓			<u>30.62</u> ✓	<u>Well House #605</u>
								<u>Note: Rod Readings Double checked</u>

AVAILABLE

RETURN TO  
FIELD WORKS  
OFFICE  
CAMP LEONIE  
NORTH CAROLINA








































































