

VALUABLE

SUBJECT

Location of water main
Serving G.M. White Area

RETURN TO
PUBLIC WORKS
OFFICE
CAMP LEJEUNE
NORTH CAROLINA

FIELD PARTY.

Cook IN CHARGE
INSTRUMENT
NOTES
TAPE READ
TAPE OR ROD
TAPE OR ROD
INSTRUMENT NO.
TAPE NO.

WEATHER

CLEAR
CLOUDY
WINDY
RAIN
FAIR
SNOW
HOT
MODERATE
COLD
FOG

FILE NO. 160-2


FLDR. No. _____

SHEET 1 of

DATE 10-2 1952

Quad. No. _____

STATION	DIST.	ANGLE		+	H. I. BEARING	VER: ANG. DIFF.	ELEVATION
		°	"				

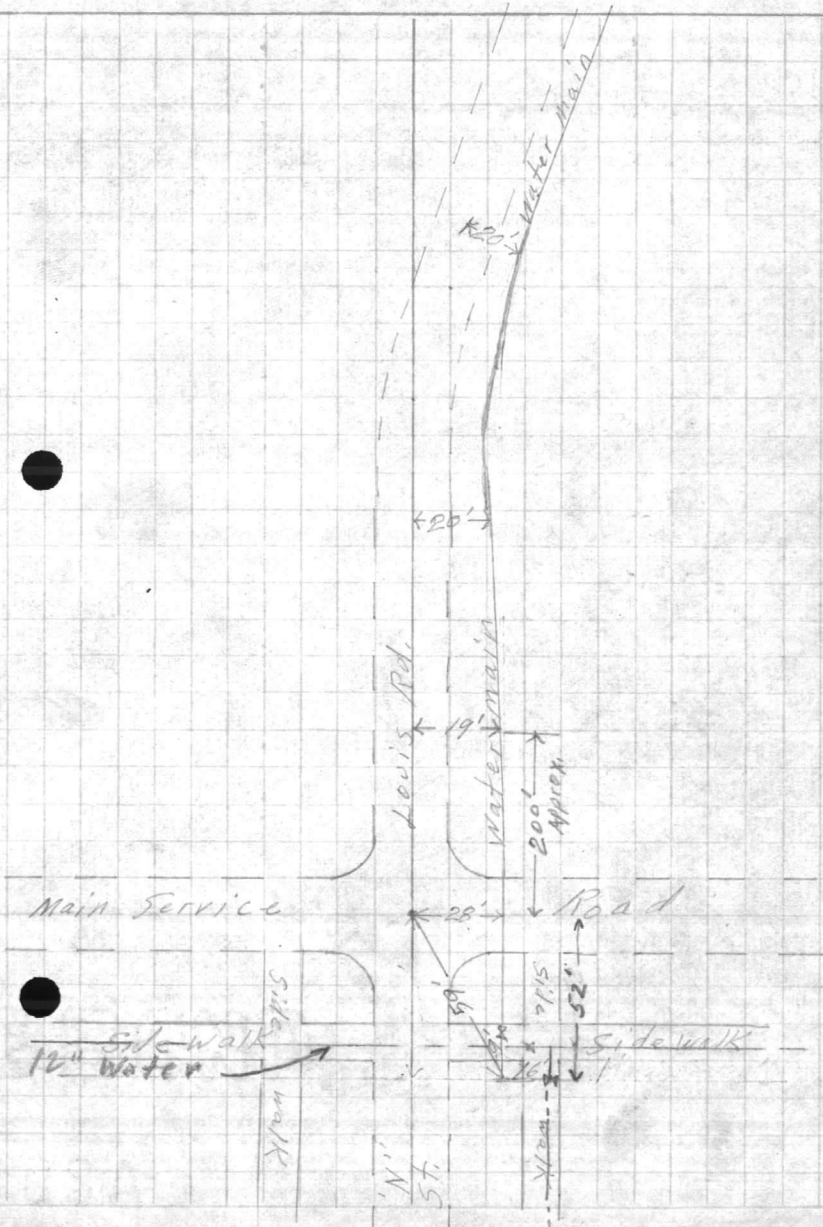









VALUABLE

SUBJECT _____

RETURN TO
PUBLIC WORKS
OFFICE
CAMP LEJEUNE
NORTH CAROLINA

FIELD PARTY

IN CHARGE

INSTRUMENT

NOTES

TAPE READ

TAPE OR ROD

TAPE OR ROD

INSTRUMENT NO.

TAPE NO.

WEATHER

CLEAR

CLOUDY

WINDY

RAIN

FAIR

SNOW

HOT

MODERATE


COLD

FOG

FILE No. _____
FLDR. No. _____
SHEET 2 of
DATE 10-2 1952

Quad. No. _____

STATION	DIST.	ANGLE			H. I. BEARING	VER. ANG. DIFF.	ELEVATION
		°	'	"			

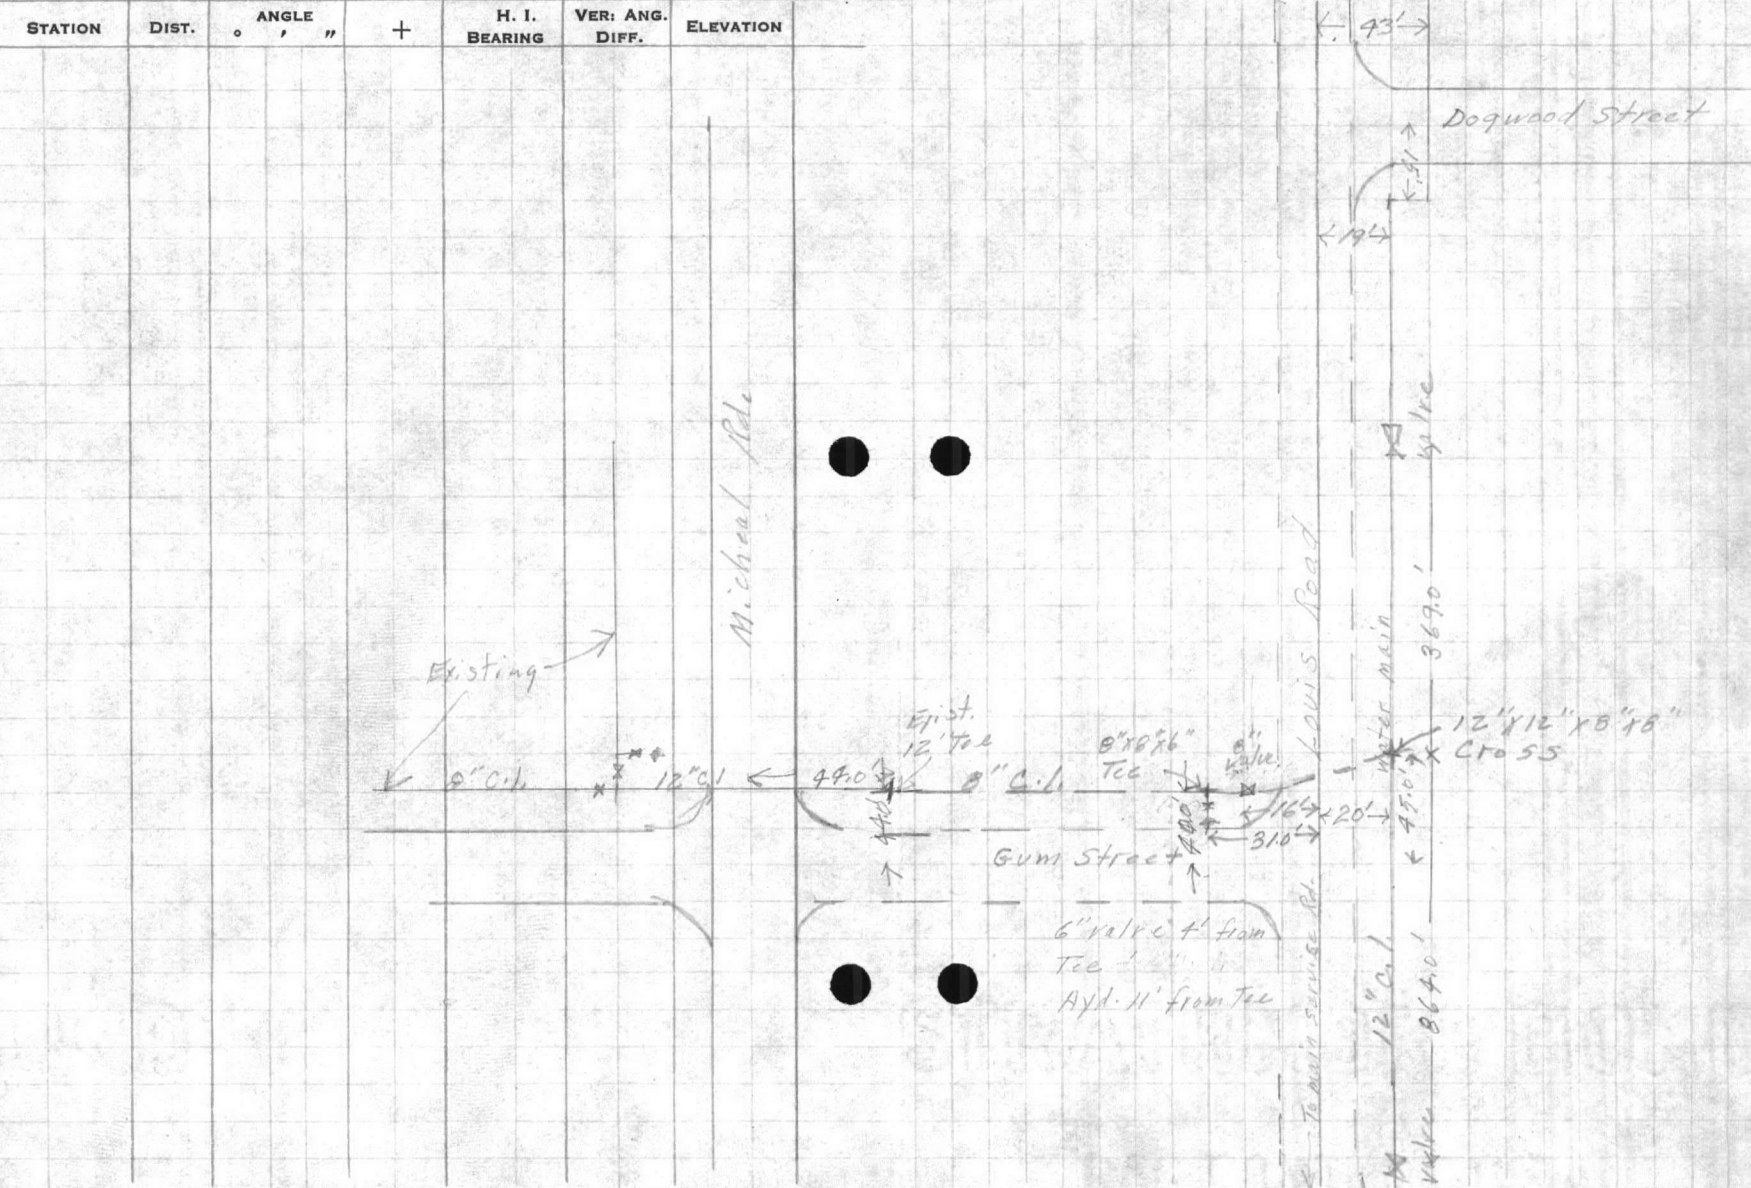



























VALUABLE

RETURN TO
PUBLIC WORKS
OFFICE
CAMP LEJEUNE
NORTH CAROLINA

SUBJECT

Water Line Loc.
Bldg. # 400

MAIN SURV Rd.

FIELD PARTY
Kellatt IN CHARGE
INSTRUMENT
NOTES
TAPE READ
TAPE OR ROD
TAPE OR ROD
INSTRUMENT NO.
TAPE NO.

WEATHER
CLEAR
CLOUDY
WINDY
RAIN
FAIR
SNOW
HOT
MODERATE
COLD
FOG
FIGURED BY
NOTES CHECKED BY
PLOTTED BY




FILE No. 160-L
FLDR. No.
SHEET 1 of 1
DATE 7-25-57

Quad. No.

18.60
42
18

STATION	DIST.	ANGLE ° ' "	+	H. I. BEARING	VER: ANG. DIFF.	ELEVATION
---------	-------	----------------	---	------------------	--------------------	-----------

Exist. steep tunnel

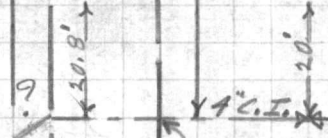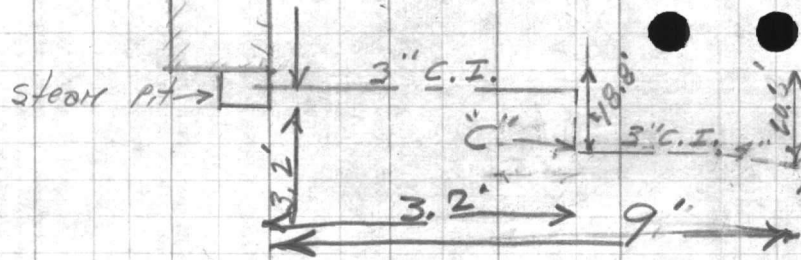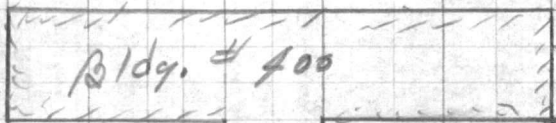

B.M.	DIST.	H. I.	VER: ANG.	ELEVATION
"A"	3.31	27.82		
"A"	Top 4" C.I.		9.22	18.60
"B"	Top 4" C.I.		8.18	19.64
"C"	Top 3" C.I.		8.23	19.59
			27.51	T.L. 24

Exist. steep tunnel
Curb

NEW steep & curbs

8" C.I.

12"

















VALUABLE

RETURN TO
PUBLIC WORKS
OFFICE
CAMP LEJEUNE
NORTH CAROLINA

SUBJECT Bench levels for construction
Louis Road & Main Service Road

12" Water Main to 12 B.M. Warehouses.

FIELD PARTY
Murphy IN CHARGE
INSTRUMENT _____
NOTES _____
TAPE READ _____
TAPE OR ROD _____
TAPE OR ROD _____
INSTRUMENT NO. _____
TAPE NO. _____

WEATHER
CLEAR _____ SNOW _____
CLOUDY _____ HOT _____
WINDY _____ MODERATE _____
RAIN _____ COLD _____
FAIR _____ FOG _____
FIGURED BY _____ SHEET 1 of
NOTES CHECKED BY _____
PLOTTED BY _____ DATE 21 Aug 1952
Quad. No. _____

FILE No. 160-L
FLDR. No. _____

STATION	DIST.	ANGLE ° ' "	+	H. I. BEARING	VER. ANG. DIFF.	ELEVATION	
B.M.						25.66	B.M. #5 18" pine 85' from Louis Rd 400' from int. Louis Rd. & Main Ser. Drive
			5.90	31.56			
B.M.					5.08	24.48	R.R. spike in pipe at int. of Louis Rd. & Main Ser. Rd.
			2.96	29.44			
0+00					9.45	19.99	12" treated water line
+08.5					7.52	21.92	Telephone cable (underground)
+31.2					7.87	21.57	14" raw water line
+31.2					9.45	19.99	12" treated water line (new)
+41.4					9.48	19.96	" " " " (new)
T.P.					3.02	26.42	
			5.22	31.44			
B.M.					5.98	25.66	B.M. #5

Top Elevations

25.66

VALUABLE

RETURN TO
PUBLIC WORKS
OFFICE
CAMP LEONIC
NORTH CAROLINA



























































VALUABLE

RETURN TO
PUBLIC WORKS
OFFICE
CAMP LEJEUNE
NORTH CAROLINA

SUBJECT Loc. observation
Well #1
OW-2

FIELD PARTY

____ IN CHARGE
____ INSTRUMENT
____ NOTES
____ TAPE READ
____ TAPE OR ROD
____ TAPE OR ROD
____ INSTRUMENT NO.
____ TAPE NO.


WEATHER

CLEAR
CLOUDY
WINDY
RAIN
FAIR
SNOW
HOT
MODERATE
COLD
FOG
FIGURED BY _____
NOTES CHECKED BY _____
PLOTTED BY _____

FILE No. 1605
FLDR. No. _____
SHEET _____
DATE 11-9-59

Quad. No. _____

STATION	DIST.	ANGLE ° ' "	+	H. I. BEARING	VER. ANG. DIFF.	ELEVATION
---------	-------	----------------	---	------------------	--------------------	-----------

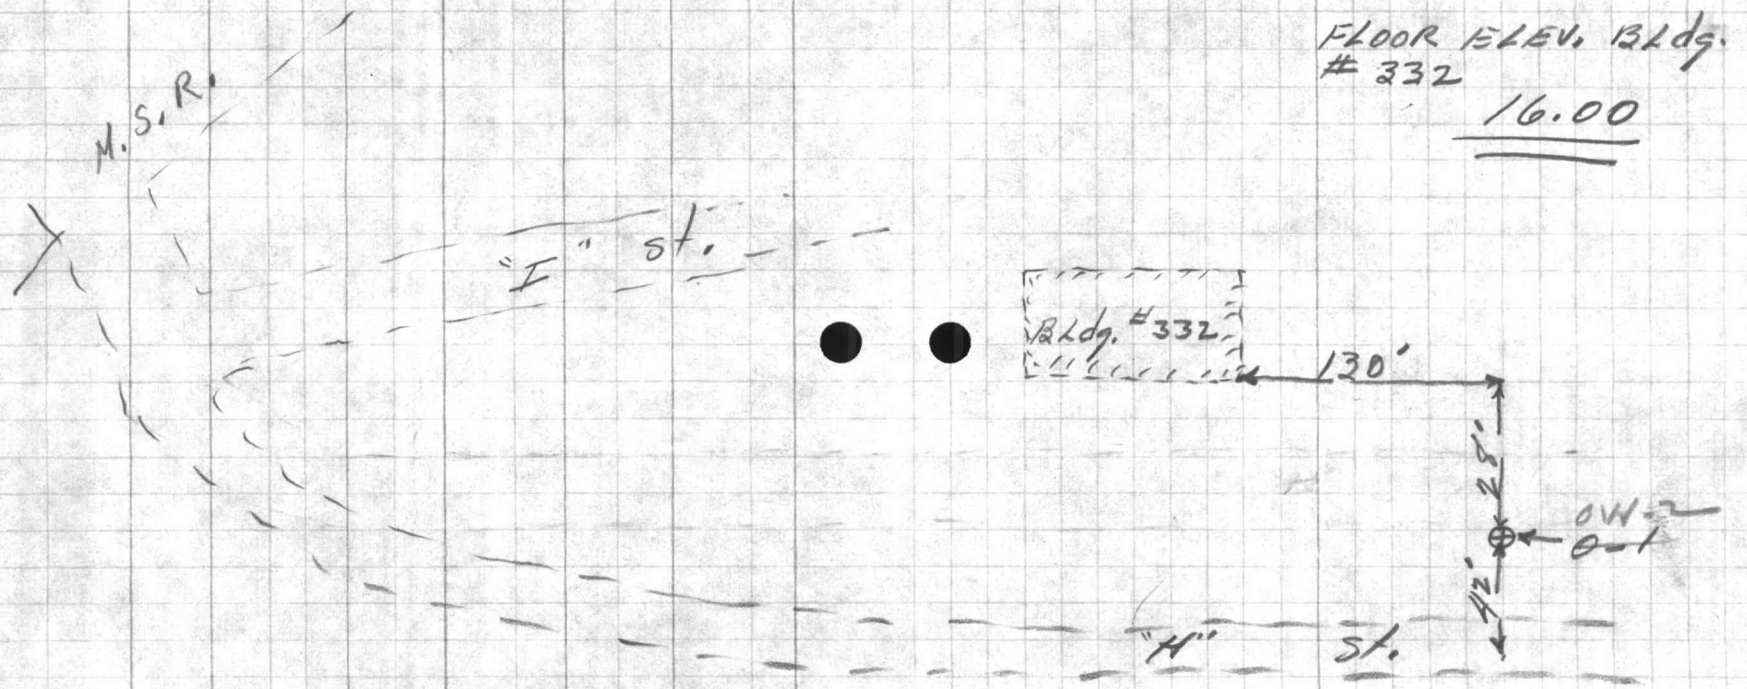

FLOOR ELEV. Bldg.
332
16.00

B.M.						16.00
	2.19	18.19				FIN. FLOOR Bldg. # 332
				7.8	10.4	GROUND AT observation well site #1 OW-2













VALUABLE
 RETURN TO
 PUBLIC WORKS
 OFFICE
 CAMP LEJEUNE
 NORTH CAROLINA

 SUBJECT LINE & TOPO. PROPOSED
ELEC. FEEDER. EXISTING
POWER LINE WEST 1/2" TO
POWER LINE BALK BLOC.#500

FIELD PARTY

 DENNIS IN CHARGE
 INSTRUMENT _____
 NOTES _____
 TAPE READ _____
 TAPE OR ROD _____
 TAPE OR ROD _____
 INSTRUMENT No. _____
 TAPE No. _____

WEATHER

 CLEAR
 CLOUDY
 WINDY
 RAIN
 FAIR
 SNOW
 HOT
 MODERATE
 COLD
 FOG
FILE No. 160-L

FLDR. No. _____

SHEET 1 of 2DATE 8-3-56

Quad. No. _____

STATION	DIST.	ANGLE ' " +	H. I. BEARING	VER: ANG. DIFF.	ELEVATION
3+63 ⁰⁰	10'	LT.	WATER VALVE		
3+62 ⁰⁰	32'	LT.	FIRE HYD.	42.50'	LT. EDGE M.S.R.

2+62-	23.50'	LT.	Φ DROP INLET.		
2+61 ²⁰	36"	R.C.P.	ON Φ		

2+58 ⁰⁰	121.50'				
--------------------	---------	--	--	--	--

1+97 ⁰⁰	38'	RT.	COR. WOODS		
--------------------	-----	-----	------------	--	--

1+18 ⁰⁰	43'	RT.	COR. WOODS		
--------------------	-----	-----	------------	--	--


0+82 ⁵⁰	42'	LT.	POINT RAD.		
--------------------	-----	-----	------------	--	--

0+58 ²⁰	33'	LT.	RAD.		
0+49 ⁰⁰	EDGE	2"	ST.		

0+26 ⁸⁰	EDGE	2"	ST.		
--------------------	------	----	-----	--	--

0+20 ⁵⁰	24'	LT.	RAD.		
--------------------	-----	-----	------	--	--

0+02 ⁵⁰	15.40'	LT.	TEL. MH		
--------------------	--------	-----	---------	--	--

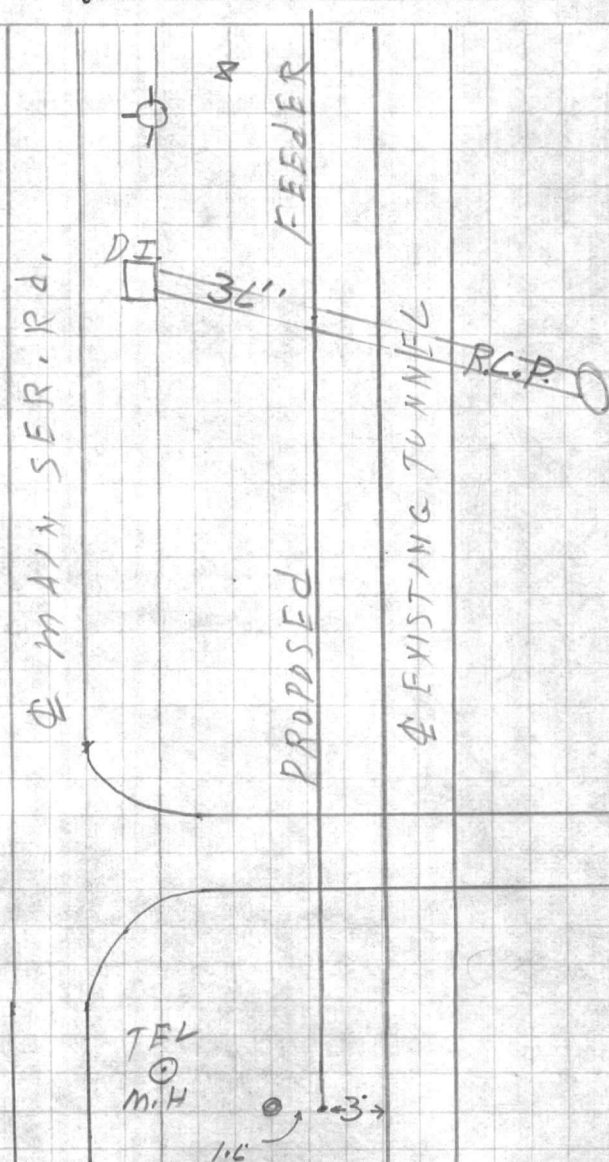









VALUABLE

SUBJECT _____

 RETURN TO
 PUBLIC WORKS
 OFFICE
 CAMP LEJEUNE
 NORTH CAROLINA

FIELD PARTY

 _____ IN CHARGE
 _____ INSTRUMENT
 _____ NOTES
 _____ TAPE READ
 _____ TAPE OR ROD
 _____ TAPE OR ROD
 _____ INSTRUMENT No.
 _____ TAPE No.

WEATHER

 CLEAR
 CLOUDY
 WINDY
 RAIN
 FAIR
 SNOW
 HOT
 MODERATE
 COLD
 FOG

FILE No. _____

FLDR. No. _____

SHEET 2 of 2

FIGURED BY _____ NOTES CHECKED BY _____

PLOTTED BY _____ DATE _____ 19__

Quad. No. _____

STATION	DIST.	ANGLE	H. I.	VER. ANG.	ELEVATION
		+ BEARING	BEARING	DIFF.	
7+26 ⁰⁰	43.50'	LT.	POINT RAD.		
7+03 ³⁴		POWER POLE	RN-1	28' LT. ON RAD.	CS80 RT. P.P. RN-2
7+03 ³³	71.00'	RT.	ON RAD.		
6+95 ⁵⁰		EDGE DRIVE	ON E		
6+84 ²⁰	17.20'	LT.	SEWER M.H		
6+72 ⁰⁰		EDGE DRIVE	ON E		
6+65 ²⁰	31' LT.	ON RAD.		52.30' RT. ON RAD.	
6+58 ⁰⁰	59'	RT.	COR. PARKING.		
6+45 ⁰⁰	43.	LT.	POINT RAD.		
5+55 ²⁰	24'	RT.	14' PINE		
5+21 ⁵⁰	29'	RT.	14' PINE		
4+94 ¹⁰	61.00'	RT.	COR. PARKING LOT.		
4+90 ⁴⁰	23.40'	LT.	E DROP INLET		
4+75 ⁰⁰	42.50'	LT.	POINT RAD.		
4+58 ⁵⁰	1.50'	LT.	WATER VALVE		
4+48	32'	LT.	ON RAD.		
4+31 ⁵⁰		EDGE	M' ST.		
4+12 ⁴⁰		EDGE	M' ST.		
3+97 ⁰⁰	30'	LT.	ON RAD.		
3+67 ⁰⁰	42.40'	LT.	POINT RAD.		

E MAIN SEWER Rd.

E TUNNEL

E M' ST.

SEWER
M.H

DRIVE TO

PARKING

P.P.
RN-1P.P.
RN-2

WATER





VALUABLE

SUBJECT

PROFILE ON ELEC,
FEEDER

RETURN TO
PUBLIC WORKS
OFFICE
CAMP LEJEUNE
NORTH CAROLINA

FIELD PARTY

IN CHARGE _____
INSTRUMENT _____
NOTES _____
TAPE READ _____
TAPE OR ROD _____
TAPE OR ROD _____
INSTRUMENT No. _____
TAPE No. _____

WEATHER

CLEAR _____ SNOW _____
CLOUDY _____ HOT _____
WINDY _____ MODERATE _____
RAIN _____ COLD _____
FAIR _____ FOG _____
FIGURED BY _____
NOTES CHECKED BY _____
PLOTTED BY _____

FILE No. _____

FLDR. No. _____

SHEET 1 of 2

DATE 8-3-56

Quad. No. _____

STATION	DIST.	ANGLE " "	+	H. I. BEARING	VER: ANG. DIFF.	ELEVATION	
B.M.			3.10	27 98		24 88	STEAM PIT T.L - 25 NEAR N.E. COR. BLDG #401
				28.0			
0+00					3.9	24.1	
0+26 ⁸⁰					3.96	24.0	EDGE "m" ST.
0+49 ⁰⁰					3.94	24.0	EDGE "m" ST.
1+00					4.1	23.9	
1+50					4.4	23.6	
2+00					4.6	23.4	
2+50					4.9	23.1	
2+58					18.70		121.50' RT. END
2+61 ²⁰					4.9	23.1	
2+62 ⁰⁰					15.04		BOTTOM D.I. 23.50' LT. 36" R.C.P.
3+00					4.9	23.1	
3+50					4.8	23.2	
4+00					4.5	23.5	
T.P.			5.59		3.48	24.50	
				30.09			
4+12 ⁴⁰					6.38	23.7	EDGE m. ST.






VALUABLE

SUBJECT _____

RETURN TO
PUBLIC WORKS
OFFICE
CAMP LEJEUNE
NORTH CAROLINA

FIELD PARTY

 _____ IN CHARGE
 _____ INSTRUMENT
 _____ NOTES
 _____ TAPE READ
 _____ TAPE OR ROD
 _____ TAPE OR ROD
 _____ INSTRUMENT No.
 _____ TAPE No.

WEATHER

 CLEAR
 CLOUDY
 WINDY
 RAIN
 RAIN
 FAIR
 SNOW
 HOT
 MODERATE
 COLD
 FOG

FILE No. _____

FLDR. No. _____

SHEET 20 of 2

DATE _____ 19__

FIGURED BY _____

NOTES CHECKED BY _____

PLOTTED BY _____

Quad. No. _____

STATION	DIST.	ANGLE ° ' "	+	H. I. BEARING	VER. ANG. DIFF.	ELEVATION	
				30.09			
				30.1			
A+31	50				4.51	23.6	EDGE in ST.
A+50					5.8	24.3	
A+75					4.8	25.3	
S+00					4.2	25.9	
S+50					3.4	26.5	
L+00					3.5	26.4	
L+50					3.5	26.6	
L+72	00				3.44	26.5	EDGE DRIVE TO PARKING LOT
L+95	50				3.42	26.7	EDGE DRIVE TO PARKING LOT.
7+00					3.3	26.8	
7+03	32				3.5	26.6	
B.m.					3.11	26.98	T.L #27






