ONSLOW COUNTY

U.S DEPARTMENT OF COMMERCE COAST AND GEODETIC SURVEY

INDEX TO TRIANGULATION DATA

NORTH CAROLINA DECEMBER 1957 NAME OF STATION		GRAPHIC	PLANE COORDINATES				DESCRIPTION 5		
AND FIRST AND THE PROPERTY OF THE PARTY OF T	VOL.	PAGE	ZONE	PAGE	ZONE	PAGE	воок .	PAGE	PAGE
NEW HANOVER COUNTY CONTINUED		505					1.7%	15	
VILLETT VILMINGTON	5	525	1	171			4.76	15	
VILMINGTON VILMINGTON	1 1	40 40 132	1	36			786 786 786	1 4 1	1
AMERICAN AGRIC CHEM CO TANK AM BANK AND TRUST CO FLAGSTAFF ATLANTIC COAST LINE OFFICE CUPOLA	2 2	593 592	1 1	196	land a		477	15	
ATLANTIC COAST LINE STA FLAGSTAFF BEACH DANCE HALL FLAGPOLE	8	592	1	196			477	10	
CHADBOURNS MIDDLE STACK CITY WATER TANK CLYDE WHARF N FLAGSTAFF	5 5	595 589	1	197			477 477 477	16 16 15	
	5	594	1 1	197			477	15	
FIFTH AVE M E CHURCH SPIRE FIRST BAPTIST CHURCH SPIRE 1908	2 2 1	594 592 134	1 1 1	196 195 71			477	6 15	66
FIRST PRESBYTERIAN CHURCH SPIRE	5	592	1	196			477	15	Ź
GRACE M E CHURCH SPIRE HARPERS WHARF SQUARE TOWER HIGH STACK	2 2 1	593 593 134	1 1 1	196 196 71			477	6	
HIGHEST STACK LARGE IRON STACK	2	134 595	1	71			477	16	
LONG GREY SHED WEST GABLE LOW CHURCH SPIRE	2	593 133	1 1	196			477	15	
MAFFIT BLOG W FLAGSTAFF MARKET HOUSE CUPOLA MASONIC BUILDING FLAGSTAFF	N 64 N	590 593 592	1 1 1	195 196 196			477	15	
MUNICIPAL INCINERATOR STACK	1	134	1	71	10		786 786	1 1	
MÜNICIPAL WATER WORKS TANK MURCHISON NAT BANK FLAGSTAFF N C SHIPBUILDING CO STACK	2 2	590 553	1 1 1	195			786	15	
N C SHIPBUILDING CO TANK	2	132	1	70			786	1	
OLD ROUND BRICK STACK OLD SQUARE BRICK STACK	2 2	595	1	197			477	15	
POST OFFICE TOWER POTTERS MILL CHIMNEY	5 5	590 591	1	195 195			477	5	
POWERHOUSE NORTH STACK POWERHOUSE SOUTH STACK ST ANDREWS PRESBYTERIAN CHURCH	8 8 8	594 594 591	1 1 1	197 197 195			477 477 477	15 15 5	
ST ANDREWS PRESBYTERIAN CHURCH ST JAMES CHURCH ST LUKES A M E CHURCH	88	5 8 9 5 9 4	1	194			477	15	
ST MARYS R C CHURCH N TOWER ST PAULS LUTHERAN CHURCH SPIRE	2 1	594 134	1 1	196			477	15	
ST STEPHENS A M E CHURCH	1	134	1 1	71 195			477	15	
SEABOARD AIR LINE RAILWAY TANK SHARP SPIRE WITH VANE SHIPYARD POLE	1 2	1.34 591	1	71			477	15	
SHIPYARD STACK	2	591	1	195			477	5	
SILVER WATER TANK BLACK WRITING SMITHS HOUSE CUPOLA	2 1	132 595 134	1 1 1	70 197 71			477	1.5	
STACK SWIFT AND CO TANK	5	553	1	181			786	1	
TERMINAL WAREHOUSE CO TANK THE CHAMPION CO TANK THE TEXAS CO TANK	3 3	553 553 552	1 1 1	181 181 181			786 786 786	1 1	100
TIDEWATER POWER CO STACK U S COURTHOUSE FLAGSTAFF	1 2	134 592	1	71			786	15	
U S COURTHOUSE SW CORNER U S CUSTOM HOUSE FLAGSTAFF	2 2	593 591	1	196	1		477	15	
U S CUSTOM HOUSE NW CORNER VIRGINIA CAROLINA CHEMICAL CO TANK WATER TANK	2 2	591 554 132	1 1 1	195 181 70			786	15	
WILLARD RED TANK	5 5	595	1 1	197			477	16	
RIGHT RIGHTSVILLE BEACH WATER TANK	- 2	526 132	1 1	171			476 477 477	16	
RIGHTSVILLE BEACH WATER TANK FINIAL RIGHTSVILLE NORTHWEST BASE	2	537 131 131	1	70			477	1 1	
RIGHTSVILLE NORTHWEST BASE ECCENTRIC RIGHTSVILLE SOUTHEAST BASE	1 1 2 2	131 526 587	1 1	69 171 194			477 477 477	1 1 6	
USE USE	5 5	587	1	194			477	6	
/ADKIN ADKIN ARD 1 USE	1 1 2	161 161 591	1 1 1	12 12 195			738 786 477	13 2 5	
/ARD 1 USE /ARD 2 USE /ELLOW HOUSE CHIMNEY ON WEST END	5 3 5	5 8 8 5 7 3	1	194			477	5 5 17	
OPP	5	589	1	194		100	477	. 5	
NORTHAMPTON COUNTY NC	1	117	1	64		1	192	217	1
CAMP 1933 NORTHAMPTON CO	1	111	1 1	34	100		1,70		1

76.

NORTH CAROLINA DECEMBER 1957 NAME OF STATION		GRAPHIC	PLANE COORDINATES				DESCRIPTION		
	VOL.	PAGE	ZONE	PAGE	ZONE	PAGE	воок	PAGE	PAG
NORTHAMPTON COUNTY CONTINUED		115					776		
CARE	1	117	1	64			738	3 4 2	3
C A R E C A Z C A Z C E D C E D	1 1 1 1 1	153 153 153 153 153	1 1 1 1 1	9 9 9 9			738 192 738 192 738	13 341 13 341 13	
CEF CEF CEL CEL	1 1 1 1 1 1	153 153 153 153 152	1 1 1 1 1 1	9 9 9 9			192 738 192 738 192	3 4 1 1 3 3 4 1 1 3 3 4 1	
EP ER ER ET	1 1 1 1 1 1	152 152 152 152 152	1 1 1 1 1 1	9 9 9 9			738 192 738 192 738	13 340 13 340 13	3
1 A	1 1 1	152 152 152	1 1 1	9 9 8			192	340	
CIB CID 1918 NORTHAMPTON CO	1 1	152	1 1	8 8			192 738 192	3 4 0 1 3 3 4 0	
ID 1918 NORTHAMPTON CO	1 1	152	1 1	8 8	in the		738	12	3
I G I K I K	1 1 1	152 152 152	1 1 1	8 8 8			738 192 738	12 339 12	
I E I L I M I N	1 1 1 1	152 152 151 151 151	1 1 1 1	8 8 8 8			192 738 192 738 192	339 12 339 12 339	
IN ONCORD 1933 NORTHAMPTON CO RA RA ANIEL	1 1 1 1 1	151 117 152 152 80	1 1 1 1	8 65 9 9 51			738 192 192 738 192	12 217 340 13 209	2
ANIEL UTRELL ARYSBURG ARYSBURG ORDON	1 1 1 1 1	80 119 151 151 77	1 1 1 1 1	51 65 . 8 8 50			738 192 192 738 192	23 220 339 12 204	
ORDON IASON 1933 NORTHAMPTON CO	1 1	77	1	5 0 6 4			738	35	
IT IS NO 4 USGS 1918 NORTHAMPTON CO TS NO 11 USGS 1933 NORTHAMPTON OANOKE ECCENTRIC OANOKE ECCENTRIC	1 1 2 2	117 157 117 656 656	1 1 1 1 1 1	65 10 64 247 247			192 192 192 192 738	218 346 217 229 4	2
EVERN EVERN TANCELL YKES ULTARE	1 1 1 1 1	79 79 77 116 77	1 1 1 1 1	51 51 50 64 50			192 738 192 192	208 23 203 216 202	200
ULTARE OODWARD	1 1	77 79	1	5 0 5 1	5		738	34208	
ONSLOW COUNTY NC									
MOS 1932 ONSLOW CO AKER 1914 ONSLOW CO ANK 1914 ONSLOW CO ARLOW AY 1914 ONSLOW CO	1 2 2 2 3	122 495 492 618 126	1 1 1 1 1	66 161 159 206 67			476 476 476 476 476	10 8 2 12 9	
EACH 1914 ONSLOW CO EACON USE 1931 ONSLOW CO	2 1	493	1 1	159			476	3 24	2
EACON NO 4 1932 ONSLOW CO EACON NO 5 1932 ONSLOW CO EACON NO 6 1932 ONSLOW CO	1 2 1	125 621 125	1 1 1	67 207 213			476 476	24	
EACON NO 7 1933 ONSLOW CO EACON NO 10 1932 ONSLOW CO	2 1	621	1	207		4	476 476	24	
EACON NO 13 1933 ONSLOW CO EACON NO 19 EAC 1914 ONSLOW CO	5 5 5	622	1 1 1	207 208 159			476	3	2
ETHEA ETHEA LUFF USE LUFF USE OG	1 1 1 1 1	41 41 124 124 127	1 1 1 1 1 1	37 37 67 67 68			476 476 192 738 476	11 21 304 14 24	200
OGUE SOUND BEACON NO 24 OGUE SOUND BEACON NO 25 OGUE SOUND BEACON NO 27 OGUE SOUND BEACON NO 27 OGUE SOUND BEACON NO 29	22222	512 512 512 512 512	1 1 1 1 1 1	166 166 166 166			476 476 476 476 476	2 2 2 2 2 2 2 2	S S S S S S S S S S S S S S S S S S S



				-	. 1			- 6 -
		PL	ANE COOF	RDINAT	ES	DESC	CRIPTION	New York
VOL.	PAGE	ZONE	PAGE	ZONE	PAGE	BOOK	PAGE	PAGE
	613		166			476	25	
5 8	496	1	161			476	9	5
1 1 2	128	1 1	68			738	15	3 2
8 8	501	1	162			476	5 4	3
1 2	127	1 1	68			738	14	
2	584	1	162			476	17	5
2	584	1 1	192			476 476	17	5 5
2	638	1 1	232			476	29	
2	638	1	232			476	29	
8 8	639	1	232			476	29	
5	639	1	233					
5 5	638	1	232			476	6	8 8
1 2	639	1	233			738	30	
1	122	1 1	66			738	303	1
1 1	123	1	66			192 738	15	:
2 2	608	1 1	202			476 476 476	28	
2 2	496	1 1	161			476 476	27	
1 2	492	1 1	26 159	877 -		476 476	9	
2	126	1 1	160 68 68			192 738	307	
1 1	122	1 1	66			192	303	3
2	639	1	233			476 476	30	
1 1	125	1	213			476	3.04	
1	21	1	29			192	192	
1 1	124	1	67			192	304	
1,019,00	497	1	161			476	9	
1 1	123	1	67		1.20	738	16	1
1	127	1	68					
1	123	1	66		N. N.	192	304	
5	617	1	206		100	476	10	1
1	123	1	67			738	304	-
				1	a similar	192	305	
	122	1	66			738 192 738	3 0 3 1 5	
2	500	1	162			476	3	
	122	1	66			738	15	
2	514	1	170			476	24	
2	496	1	161			476	9	
1	124	1	67			738	14	

NORTH CAROLINA DECEMBER 1957		GRAPHIC DSITION		PLANE CO	ORDINA	TES	DE	ESCRIPTIO	N 5
	VOL.	PAGE	ZONE	PAGE	ZONE	PAGE	ВООК	PAGE	PAGE
ONSLOW COUNTY CONTINUED HINES 1932 ONSLOW CO								1	
HINES 1932 ONSLOW CO	1	123	1	66			738	15	1
10BS 10RSEHEAD HUBERT HUFFMAN	2 2 1 1 1 1	617 501 37 37 37	1 1 1 1 1	206 162 35 35 28			476 476 192 738 192	11 7 157 31 191	5 5
HUGGINS ISLAND USE URST INLET 1914 ONSLOW CO NLET 2 JARMAN	2 2 2 1	511 494 493 500 127	1 1 1 1 1	166 160 160 162 68			476 476 476 476 192	2 6 4 4 306	8888
ARMAN ING 1914 ONSLOW CO IGHT NO 2 IGHT NO 8 IGHTER	1 2 1 1 2	127 618 125 126 519	1 1 1 1	68 206 67 213 170			738 476 476	16 11	3 2 2
ITTLE RAGGED USE ITTLE RAGGED USE OG 1914 ONSLOW CO OG 1914 ONSLOW CO OG 0G 2	1 1 2 2 2 2	124 124 607 607 608	1 1 1 1 1	67 67 202 202 202			192 738 476 476 476	3 0 5 1 4 1 0 2 8 1 9	3 1 2
OW 1914 ONSLOW CO IARSH USE IARSH USE EADOW ILL 1914 ONSLOW CO	2 1 1 2 2	495 128 128 493 493	1 1 1 1	160 68 68 160 160			476 192 738 476 476	7 307 15 4	3 2 2 2
ILL USE ILL USE ONTFORD USE ONTFORD USE ONTFORD USE	1 1 1 1	128 128 127 127 127	1 1 1 1	68 68 68 68			192 738 192 738 738	307 15 306 14 33	3
ONUMENT 371 USMC OSS USE OSS USE USH USH	2 1 1 2 2	638 128 128 617 617	1 1 1 1 1	232 68 68 206 206			476 192 738 476 476	30 306 16 11 28	3 2
EW RIVER DAY MARK NO 9 EW RIVER DAY MARK NO 13 EW RIVER DAY MARK NO 15 EW RIVER DAY MARK NO 31 EW RIVER DAY MARK NO 35	2222	639 639 639 638 639	1 1 1 1	233 233 233 232 233					
EW RIVER DAY MARK NO 41 EW RIVER DAY MARK NO 43	2 2	638 638	1	232					
EW RIVER LIGHT NO 11 EW RIVER LIGHT NO 17 RIVER LIGHT NO 19 EW RIVER LIGHT NO 21 EW RIVER LIGHT NO 23	2222	639 639 639 639 638	1 1 1 1 1	233			477	19	
EW RIVER LIGHT NO 25 EW RIVER LIGHT NO 27 EW RIVER LIGHT NO 29 EW RIVER LIGHT NO 32 EW RIVER LIGHT NO 33	2222	638 638 638 638 638	1 1 1 1 1 1	232222222222222222222222222222222222222					
EW RIVER LIGHT NO 34 EW RIVER LIGHT NO 36 EW RIVER LIGHT NO 38 EW RIVER LIGHT NO 39 EW RIVER LIGHT NO 44	2000	639 638 638 638 638	1 1 1 1 1 1	233222332223322				3	
EW RIVER LIGHT NO 70) 3 3 4 USE) 3 3 151 USE) 3 3 182 USE) 3 3 216 PLUS USE	200000000000000000000000000000000000000	639 621 621 621 621	1 1 1 1 1	233 207 207 207 207 207			476 476 476 476 476	30 17 17 17 17	2000
0 3 3 247 PLUS USE 0 3 4 5 USE 0 3 4 8 PLUS USE 0 3 4 140 PLUS USE 0 3 5 25 USE	20000000	621 622 622 622 623		207 208 207 207 207 208			476 476 476 476 476	17 17 17 17 17	3 3 3
D 22 PLUS USE 1 27 PLUS USE 29 PLUS USE RTH BASE USE RTHEAST	2 2 2 1 1	511 511 513 125 128		166 166 166 67 68			476 476 476 476 192	2 24 24 10 306	25
ORTHEAST BRTHEAST BASE ISLOW RADISE USE RADISE USE	1 2 1 1 1 1	128 501 41 25 25	1 1 1 1 1 1	68 162 37 31 31			738 476 192 192 738	16 9 163 202 15	3327
ARADISE ECCENTRIC ARADISE ECCENTRIC 438 438-5-1 438-5-1	1 1 2 1 1	25 25 495 126 126	1 1	31 31 160 67 67			192 738 476 192 738	201 31 8 305 32	27

ORTH CAROLINA DECEMBER 1957 NAME OF STATION		SRAPHIC	PL	ANE COO	RDINAT	ES	DES	CRIPTION	5
	VOL.	PAGE	ZONE	PAGE	ZONE	PAGE	BOOK	PAGE	PAGE
ONSLOW COUNTY CONTINUED	2	497	1	161			476	10	2
A VILION E A K	5	603	1	200			476	24	2
IG 1914 ONSLOW CO INE 1914 ONSLOW CO INE 1914 CNSLOW CO INE USE	2 2 1 1	4 9 4 4 9 5 4 9 5 1 2 8 1 2 8	1 1 1 1 1	160 160 160 68 68			476 476 192 738	5 7 27 307 15	200
IVER 1914 ONSLOW CO OINT 1914 ONSLOW CO OINT 1927 ONSLOW CO OVERTY	2 2 1 1	494 494 603 122 122	1 1 1 1 1	160 160 200 66 66			476 476 476 192 738	6 24 303 15	
UEEN 1914 ONSLOW CO AGGED USE AGGED USE ANGE THREE ANGE TWO	1 1 2 2 2	55 127 127 608 607	1 1 1 1 1	43 68 68 202 202			476 192 738 476 476	306 15 19 30	
HODES USE HODES USE ICHLANDS ICK	1 1 2 2	124 124 21 603 618	1 1 1 1	67 67 29 200 206			192 738 192 476 476	304 16 192 24 11	
OPER 1933 ONSLOW CO OPER 1933 ONSLOW CO OUGH USS 2	1 1 2 2 2 2	21 21 618 492 500	1 1 1 1	29 29 206 159 162			192 738 476 476 476	193 31 11 2 2	
USSELL 1932 ONSLOW CO USSELL 1932 ONSLOW CO AMWORTH AMWORTH ANDY 1914 ONSLOW CO	1 1 1 1 2	37 37 122 122 495	1 1 1 1	35 35 66 66 160			192 738 192 738 476	157 31 303 32 7	
AUNDERS 1914 ONSLOW CO EA EL HELL 1914 ONSLOW CO WITHS HOUSE CUPOLA	2 1 2 2 2 2	493 126 500 497 519	1 1 1 1 1	159 67 162 161 170			476 476 476 476 476	3 9 1 9	
NAG OUTH BASE USE OUTHWEST USE OUTHWEST USE OUTHWEST BASE	2 1 1 2	496 125 127 127 501	1 1 1 1 1	161 67 68 68 163			476 476 192 738 476	8 10 306 33 9	
PRING USE PRING USE	1 1	124	1 1	67 67			192 738	3 0 4 1 5	0.51
PRING 2 USE PY QUALL TILL 1914 ONSLOW CO	2 2 2 2 1	638 618 618 494 126	1 1 1 1 1	232 206 206 160 68			476 476 476 476	30 12 11 5 307	
TONE USE TONE USE ECCENTRIC TONE USE ECCENTRIC TONE USE ECCENTRIC TUMP 1914 ONSLOW CO TUMP 1933 ONSLOW CO	1 1 1 2 1	126 123 123 618 127	1 1 1 1	68 66 66 206			738 192 738 476 192	33 304 15 11 306	
TUMP 1933 ONSLOW CO WAMP 1914 ONSLOW CO WAMP 1933 ONSLOW CO WAMP 1933 ONSLOW CO WAMP 1933 ONSLOW CO WAMP 1931 ONSLOW CO WAMP 1931 ONSLOW CO	1 2 1 1 1 1	127 495 127 127 55	1 1 1 1	68 161 68 68 43			738 476 192 738 476	33 8 306 16 10	
WAN POINT USE NEW RIVER WAN POINT 2 WAN POINT ECCENTRIC WAN POINT ECCENTRIC WAN BORO BAPTIST CHURCH SPIRE	1 2 1 1 2	55 519 55 55 511	1 1 1 1 1	43 170 43 43 166			476 476 476 476 476	28 17 10 28 24	
WANSBORO METHODIST CHURCH SPIRE IE ILE OWER EIGHT OWER NINE	2 2 2 2 2 2 2 2 2 2 2 2 2 2 2 2 2 2 2 2	511 496 497 606 606	1 1 1 1	166 161 161 201 201			476 476 476 476 476	24 9 10 20 19	
OWER NINE OWER SEVEN OWER SIX OWN POINT USE OWN POINT USE	2 2 2 1 1	606 606 606 25 25	1 1 1 1	201 201 201 31 31			476 476 476 192 738	30 20 21 202 15	100
OWN POINT ECCENTRIC OWN POINT ECCENTRIC RUESDALE RUESDALE RUESDALE	1 1 1 1 1	25 25 11 11	1 1 1 1 1 1	31 31 25 25 25			192 738 192 738 192	201 15 155 15 155	
ERONA ERONA IEW 1932 ONSLOW CO IEW 1932 ONSLOW CO IEW 1932 ONSLOW CO	1 1 1 1 1	11 125 125 125	1 1 1 1 1	213			738 738 192 476 476	15 38 171 10 28	

ORTH CAROLINA DECEMBER 1957 NAME OF STATION		STAPHIC	P	LANE CO	ORDINA	TES	DES	SCRIPTION	N 5
	VOL.	PAGE	ZONE	PAGE	ZONE	PAGE	воок	PAGE	PAGE
ONSLOW COUNTY CONTINUED									
ALTON	1 1	126	1	67 30			192	201	50
VALTON VALTON	1 1	25 25	1 1	3 0 3 0			738	31	1
VATER 1932 ONSLOW CO VATER TANK NEAR STATION QUEEN VEEK	2 2	123 512 495	1 1 1	166 160			738 476 476	25	2
VILLIAMS 1914 ONSLOW CO	1	126	1	67			476 192	9	2
VILSON USE VILSON USE VINDY	1 1 2	128 128 495	1 1 1	68 68 160	le inte		738	307 15 6	3
VINDY	5	495 617	1	206		l Pois	476	26	2
WRIGHTS ISLAND USE	ž	519	1	170			476	10	3
ORANGE COUNTY NC			1						
BLACKWOOD CHAPEL 1954 ORANGE CO	5 5	749 749 17	1 1 1	292			1165	10	
CHAPEL HILL CHAPEL HILL CHAPEL HILL UNIVERSITY OF N C WATER T	1 1 2	17 755	1 1	27	materia		192 1165 1165	182	in contract
CHAPEL HILL UNIVERSITY OF NC STACK	8 8	755 746	1 1	295		And A	1165	10	
G A R R A R D H I L L S B O R O	1 1	23	1	29			192	195	19
HILLSBORO AT T MICRO WAVE RELAY MAST	2	755	1 1	295			1165	10	
LAWS SUNDIAL	1 1	16 23 23	1 1 1	26 29 29			192 738 192	180 38 196	18
JNIVERSITY JNIVERSITY	1	23	1	29			738	38	
JNIVERSITY OF NORTH CAROLINA BELL TWR WHITE CROSS	1 2	749	1	292			1165	9	
PAMLICO COUNTY NC									100
A USE 1913 PAMLICO CO	2 2	4 2 5 4 2 6	1 1	134			472 472	37	3
ALLICE ALLIGATOR 2 ARAPAHOE	2 2 1	377 479 36	1 1 1	116 154 35	in the	in the same	472 472 472	17	3
ASON	2	392		121			472	6	3
B USE 1913 PAMLICO CO	5	425	1	134			472	6	3
BAIRDS BAIRDS BALLS ISLAND 2	5 5 5	267 267 389	1 1 1	76 76 120		N-48	472 472 472	18 31 2	2 3
BARK BAY 1913 PAMLICO CO	5 5	425	1	134	izun:	in the same	472	5	3
BAY POINT BEACON 1933 PAMLICO CO BAY POINT BEACON 1935 PAMLICO CO BAY POINT LIGHT 1913 PAMLICO CO	5 5	447	1	142			472	37	
BAY POINT LIGHT 1913 PAMLICO CO BAY POINT LIGHT 1920 PAMLICO CO BAY RIVER BEACON NO 41	5 5 5	481 480 379	1 1 1	155 154 117			472	37	3
BAY RIVER BEACON 42 BAYBORO	2 2	447	1 1	142			472	37	2
BAYBORO BEACON NO 35 BEACON NO 37 1935 PAMLICO CO	2 2 2	376 373 373	1 1 1	116 114 115			472 473 473	26	2
BEACON NO 39931935 PAMLICO CO	5 5	373	1	115			473	3	5
BEACON NO 39A BEACON NO 39A BEACON NO 40A	5 5 5	393 393 393	1 1 1	122			472 472 472	37 41 37	4
BEACON NO 40A BEARD CREEK BEACON'LIGHT	3	393	1	122			472	41	
BEARDS CREEK 2 BEC	2 2	479	1 1 1	154		er en la	472	18	3
BELL POINT BEACON BELLS POINT 2 1913 PAMLICO CO	5 5	394 393	1	121			472	36	3
BIGHT 1913 PAMLICO CO BONNE,R 1935 PAMLICO CO BOS	8 8 8	425 389 392	1 1	134		13	472 472	5 2	33
3 O S B R A N C H	5 5 5	392 392 389	1 1 1	121			472 472 472	36	33
BRANT 5 BRANT ISLAND 4	2 2	363	1 1	111			472	24	3
BRICK 1935 PAMLICO CO BROAD 1932 PAMLICO CO	2	391 439	1	121			472	20	3
BROAD CREEK BEACON BROAD CREEK LIGHT	2	479	1	154			472	24	3
BRYANT 5 C 1913 PAMLICO CO	2 2	363	1 1	111			472	6	3
USE 1913 PAMLICO CO USE 1935 PAMLICO CO	2 2	426	1	134			472	37	2

0° 00' 0000 07 15 45.0 199 33 10.0

UNITED STATES COAST AND GEODETIC SURVEY Descriptions of Triangulation Stations

Bogue Inlet to Wrightsville Inlet, North Carolina.

Bogue Inlet to Wrightsville Inlet, North Carolina.

BOGUE (Carteret County, N.C., J.S.H., 1908;1911) -- Station is at the W end of Bogue Sound, on the main marsh at the E side of Bank Channel, the broad body of water N and E of Bogue Inlet, about 100 yards S of the extreme N end of this marsh, on which there are several clumps of bushes and large water oaks.

The surface mark is a brass nail in a drain tile, placed flange up, filled with cement and surrounded by concrete. The letters "U.S." are scratched in the concrete.

The underground mark is a 1-inch drain tile buried 2 feet below the surface of the grounds.

Three reference posts were placed N, E, and W of the station. Distances and azimuths from the station are as follows: to the W post with 1 nails, 2.27 meters (7.415 feet), 77°11; to the N post with 6 nails, 2.15 meters (7.05 feet), 172°25; to the E post with six nails, 1.85 meters (6.07 feet), 269°01; to a blazed live oak tree, 9.7 meters (31.8 feet), 19°42'.

BOGUE (Carteret County, N.C., J.S.H., 1908; K.T.A., 1927) -- Station was recovered and found in good condition. The three reference posts were no longer standing. The station is about 20 feet from high-water line.

BOGUE (Carteret County, N.C., J.S.H., 1908; H.O., 1933) -- The station is about 1 1/2 miles NE of Bogue Inlet on the main marsh at the E side of Bank Channel.

The station was found and used in the 1933 scheme. It was remarked with a standard brass disk, and stamped "BOGUE 1908-1933", set in concrete in an 8-inch tile, superimposed over the old mark. The underground mark is a 4-inch tile 2 feet below the surface of the ground.

The live oak tree mentioned in original description is dead. Triangular blaze on the tree was re-out on the side of the tree towards station.

One reference mark was established, a standard brass disk

one reference mark was established, a standard brass disk set in an 8-inch tile filled with concrete, projecting a few inches above ground surface.

OBJECT

DISTANCE

DIRECTION

meters 12.430 9.790 feet 40.775 32.120 BELL R.M. RM. 0

Bolazed oak tree

BELL (Carteret County, N.C., J.S.H., 1908;1915) -- Station is at the W end of Bogue Sound on the mainland, N of Bogue Inlet and E of Bank Channel, in a field belonging to K. Bell, about 180 yards E of the mouth of a creek which makes along the S side of the field, about mid-way between the edge of the water and a graveyard which is in the field.

The surface mark is a 4-inch tile filled with and set in concrete with a copper nail in the top, and the letters "U.S." scratched on the concrete.

The undergoound mark is a 4-inch drain tile buried 2 feet below the surface.

Three light-wood posts were set near the water in line toward the station; another post was placed to the N of the station and SE of the graveyard, and a 6-inch tree in the graveyard was marked with blaze and neils.

All the posts, the station, and the blazed tree are nearly in line. The three posts toward the water are, respectively, 20,5 meters (67,3 feet), 22.0 meters, (72.2 feet), and 25.5 meters (76.4, feet) from the station in azimuth 2012.

The other post and the tree in the graveyard are, respectively, 22.4 meters (73,5 feet), and 24,3 meters (79.7 feet) from the station in azimuth 182°47'.


BELL (Carteret County, N.C., J.S.H., 1908; N.C., Geod.S., 1927) -- Station and reference points in good condition. Description is adequate.

BELL (Carteret County, N.C., J.S.H., 1908; H.C., 1933) -- The station is on the mainland N of Bogue Inlet, Bank Channel, and the Inside Route Canal and is W of Beacon 20.

Surface mark was found as described and was re-marked with a standard disk set in concrete, according to note lo. It is stamped "BELL 1911,-1935." The light-wood posts were gone.


Two reference marks were established. They are standard brass disks set in concrete in the top of tile, as described in


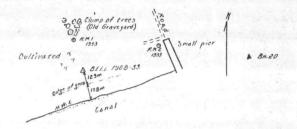

FLAGFOLE, BOGUE INLET (Carteret County, N.C., ,1914; K.T.A.,1927)--Flagpole has been torn down and a new one erected. See description of stations for description of new flagpole.

PLAGPOLE, BOGUE INLET (Carteret County, N.C., K.T.A., 1927) -Station is the center of the flagpole on the steel flag tower
at Bogue Inlet, about 20 meters E of the Coast Guard Station.
The flagpole as shown in previous triangulation has been torn

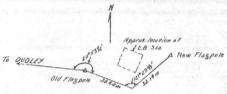

SEL (Onslow County, N.C., R.F.S., 1911) -Station is at the mouth of White Oak River, in a field at the SE corner of Ruggins' Island, NW of a large mersh about 150 yards from high-water mark to the E, and about 1h0 yards from high-water mark to the E, and about 1h0 yards from high-water mark to the S. The surface mark is a standard bronze disk set in concrete in the top of a tile, as described in note 6b.

The underground mark is set according to note 10d.

The reference mark is a tile filled with, and set in cement, projecting about 6 inches above the surface; it is in the bushes E of station, shout 20 yards from high-water mark 1h; meters (1h9 feet) from the station in azimuth 252°56'. The most easterly of a row of live oak trees about 155 yards S of reference mark is blazed on the side toward the station. There are blazes, with 5 nails in each blaze, on three small myrtle trees near the reference mark; one is about 12 yards N of the reference mark; a second is close by the reference mark on the station aids to-ward the station, and the third is about 20 yards toward the S.

SEL (Onslow County, N.C., R.P.S., 191h; H.O., 1933) -- The station is destroyed. The original brase disk and pieces of concrete and tile were found about 2 1/2 feet below the surface. No underground mark could be found.

DUDLEY (Onslow County, N.C., R.P.S., 1914) -- Station is about N of Bogue Inlet, on the S side of Dudley Island, about 50 yards E of the W end of a small sand ridge about mid-way between a creek, that runs along a line of scattered live oak trees, and the sound. It is about 50 yards from high-water mark on the S

the sound. It is about to standard bronze disk set in concrete in the top of a tile, as described in notes 6b.

The underground mark is set according to note 10d.

The reference mark is a tile, filled with, and set in cement, projecting about 6 inches above the surface of the ground. It is in range with Bogue Inlet L.S.S. boathouse.

DUDLEY (Onslow County, N.C., R.P.S., 1914; K.T.A., 1927) -- Station was found in good condition. The reference mark is on high-water line. The station mark is about 50 feet from high water.

DUDLEY (Onslow County, N.C., R.P.S., 1914; H.O., 1935).--Station is about one mile N of Bogue Inlet on the S side of Dudley Island. It was found in good condition and was used in 1935. The refrerence mark was broken and will soon be destroyed. One new reference mark was established.

Station mark is a standard bronze disk set in concrete in the top of a tile, as described in note 6b.

Reference mark No.1, (1935) is a standard brass disk stamped "DUDLEY 1-1935", and set in concrete in the top of a 10-inch vitrified clay tile filled with concrete, projecting 8 inches above the ground surface. It is about 6 meters N of high-water line, in the sand bushes.

OBJECT DISTANCE DIRECTION



RUSS (Onslow County, N.C., R.P.S., 191h) -- Station is on Huggins Island, at the mouth of White Oak River, in Dan Russell's field, about 200 yards W of Russell's house, and about the same distance S of another house on the water front, about 100 yards back from high-water mark on the S side of the island.

The surface mark is a standard bronze disk set in concrete in the top of a tile, as described in notes 6b.

The underground mark is set according to note 10d.

The reference marks are tiles, filled with, and set in cement, and projecting about 6 inches above the surface.

Reference mark No.1 is a 6-inch tile and is 37 meters, (121 feet) W of the station in range with the highest chimney on Russell's house.

Reference mark No.2 is a 4-inch tile, 66 meters, (217 feet) S of the station in range with a lone live oak tree.

RUSS (Onslow County, N.C., R., P.S., 1911; H.O., 1935) -- Station is near the southern edge of a cultivated field on the western end of Huggins Island. There is higher ground NW of the station mark. Old reference marks and live oak tree mentioned in original description are gone. Russell's house is still standing and is about 200 yards E of the station.

The station was re-marked by placing a surface mark directly over the position in which the underground mark was recovered. The new station was called "RUSS 2, 1933", and the old station considered destroyed.

Subsurface mark was recovered and found apparently intact about 1, 1/2 feet below the surface of the ground. Re-observations at this station showed an appreciable difference from the old observed angles.

at this station showed an appreciable difference from the old observed angles.

Reference mark No.1 is a standard brass disk stamped "1, RUSS, 1937", and set in an 8-inch tile filled with cement, projecting 6 inches above ground surface, and in line with "DUDLEY" and just inside the fence line.

Reference mark No.2 is a standard brass disk stamped "2, RUSS, 1937", and set in an 8-inch tile filled with cement, projecting 6 inches above the ground surface, and in line with "QUEEN", and at the edge of the oultivated field and just inside the line of bushes.



QUEEN (Onslow County, N.C., K.P.S., 1911; 1973) -- Station is about 2 1/2 miles inland, NNW of entrance to Bogue Inlet, on property owned by Dr. Sharp, and about 100 feet SE of SE corner of Dr. Sharp's house. Original surface mark was replaced in 1932 with a standard disk set in concrete, as described in note 1a, and stamped "QUEEN 1911-1932." Underground mark is set according to note 10d, was also found, but was not replaced at this time. Original reference mark is tile filled with and set in concrete, projecting about 6 inches, and 9.935 meters (32.59 feet) from station in atimuth 299'. Three standard reference disks set in concrete, as described in note 11a, were also placed in 1932. No.2 is 95,122 meters (305.52 feet) from station in azimuth 151°37'. No.3 is approximately one-half mile from station in azimuth 152°11'37". No.4 is 63.140 meters (207.15 feet) from station in azimuth 231°27'.

BANK (Onslow County, N.C., R.P.S., 1914) -- Station is on the N side of an old dredge channel that is now closed up, about 75 yards N of where the dredge channel from Bogue Inlet to Bear Inlet began, or about 50 yards E of the W end of the dredge dump nearest the Bogue Inlet entrance to the channel.

The surface mark is a standard bronze disk set in concrete in the top of a tile as described in note 60. The underground mark is set according to note 10d. There are no reference marks.

BANK (Onslow County, N.C., R.P.S., 1911; K.T.A., 1927) -- Station recovered as described. Original description is complete.

BANK (Onslow County, N.C., R.P.S., 1911; H.O., 1973) -- Station is on anarrow sand ridge in the marsh about one mile N, and W of Bogue Inlet. It is about 7 meters W of the most westerly of a clump of bushes on the ridge. These bushes are the only ones on the marsh.

The station was found in good condition and was used in the

The station was found in good condition and was used in tags of the station was found in good condition and was used in tags of the standard disk set in concrete in the top of an S-inoh tile in accordance with note 13a. It is in the center of the ridge W of the largest clump of bushes.

OBJECT

DISTANCE

DISTANCE

DISTANCE

QUEEN R.M.No.1

feet 61.750 meters 18,822

DIRECTION 00 001 0020 71 17 42.5

grassy sand ridge BONN BOS CO

MANAMAN

BEACON "BOQUE SOUND 25" (Onslow County,N.C.,H.O.,1975)--This station was determined with accuracy represented by 3 D/R, and is a lighted beacon described in Light Lint, Atlantic Coast, United States, 1932, as follows: "BOQUE SOUND, No.1855, BOQUE SOUND 25, Fl.W., 2 sec., in 2 feet, at bend in channel, light is 16 feet above high water, black slatted pile structure."

BEACON "BOGUE SOUND 27" (Onslow County, N.C., H.O., 1933) -This station was determined with accuracy represented by 3 D/R and is a lighted beacon described in Light List, Atlantic Coast, United States, 1932, as follows: "Bogue Sound, No. 1851, Bogue Sound 27, Fl.W., 2 sec., in 2 feet, at bend in channel, 16 feet above high water, black slatted daymark on pile."

BEAGON "BOGUE SOUND 29" (Onelow County, N.C., H.O., 1933) -This station was determined with accuracy represented by 3 D/R
andisalighted beacon described in Light List, Atlantic Coast,
United States, 1932, as follows: "Bogue Sound, No.1855, Bogue
Sound 29, Fl.W., 2 soo., in 2 feet, at bend in channel, light
16 feet above high water, black slatted daymark on pile."

########

BEACON "SWANSBORO 2½" (Onslow County, N.C., H.O., 1953)--This station was determined with accuracy represented by 3 D/R and is a lighted beacon described in Light List, Atlantic Coast, United States, 1952, as follows: "Bogue Sound, No.1852, Swansboro 2½, Fl.R., 3 seconds, in 3 feet, on E side of N end of out, light 16 feet above high water, red slatted pile structure."

U.S.E. (22+) (Onslow County, N.C., H.O., 1935) -- This station is a standard U.S.E. disk stemped "55", set in a 6-inch iron pipe filled with concrete, projecting 15 inches above surface of ground, on a small marsh island, 1/2 mile SE of Swansboro, 500 yards S of E end of bridge, 10 yards from edge of the channel, 20 yards from W side of the island, midway between Beacon No.22 and Beacon 24. Mark is on the N side of channel. Connection to triangulation scheme made by outs from main scheme stations with accuracy represented by 5 D/R.

U.S.E. (HUGGINS ISLAND) (Onslow County, N.C., H.O., 1957) -- This station is a standard U.S.E. brass disk comented in the top of a 6-inch square tile set in an irregular mass of concrete projecting about 1 inches above the ground. Station is about 8 meters inside the high-water line; about 125 yards E of a cottage known as "Camp Charmat." Station is about 5 1/2 meters N of the U.S. Coast Guard telephone line of poles going by this cottage; and is about 12 meters ENE of telephone pole No.11-RS 1.

Connection to triangulation scheme made by cuts from main scheme stations with accuracy represented by 3 D/R.

HAWK (Onslow County, N.C., R.P.S., 1911) -- This station is about 2 1/2 miles NE from Bear Inlet on Hewkins Island about 150 yards from high-water mark, to the SE and 30 yards from the NW shore of the Island about 75 yards S of a lone live oak tree (blazed on its S side), on the N end of the island or about 15 yards from the E side of the barn.

Surface mark is a standard bronze disk set in concrete in the top of a tile, as described in note 6b.

Underground mark is set according to note 10d.

HAWK (Onslow County, N.C., R.P.S., 1914; K.T.A., 1927) -- This station recovered in good condition. Dredged canal passes about 200 meters NW of station. Small barn has been moved. DIRECTION

DISTANCE OBJECT DISTANCE DIRECTION FLAGFOLE, BOGUE INLET meters feet 0.9. STATION 0°00' N. Car. small barn 75. 28.63 119 36 Lone live oak tree 75. 229 45 Reed's House Chimney 250. Reed's house is very prominent, can be seen from Bear Inlet.

HAWK (Inslow County, N.C., R.P.S., 1911; H.O., 1975) -- This station is on an island in the marsh about 1.8 miles NNE of Bear Inlet. It is in cultivated fiteld 25 yards, E of an old pump stuck into the ground and is 10 yards N of an old barn. It was found in good condition and used in the 1973 schemes.

Reference mark No.1 (1975) was established (a standard brass disk stamped "HAWK 1-1975", set in concrete in the upper end of a 10-inch vitrified clay tile filled with concrete, projecting slightly above ground surface). It is in edge of field and is almost in range with an oak tree 8 yards SW of old pump.

OBJECT

BEAR

meters feet 0°00°00°0 DIRECTION CRAWN, No.1 26.331 86.39 121 39 05.0 Nail in Blaze in

Nail in Blaze in Oak tree 67.34 221.0 127 00 53.8 D House

010 tang! Canal Speil banks Prominent oak tree Che

A HAWA (corntich)

UNITED STATES COAST AND GEODETIC SURVEY Descriptions of Triangulation Stations

BEACH (Onslow County, N.C., R.P.S., 1911)--This station is about 2 miles NE from Bear Inlet, on the 3 bank of the channel from Begue Inlet to Bear Inlet, about 300 yards N of two small sand mounds. The channel just beyond the dredge channel takes a northerly direction for about 300 yards and then turns W; the station is about 125 yards W of the latter turn, close to highwater mark, about 3 yards from the bank.


The station is marked by a standard bronze disk set in concrete in the top of a tile, as described in note 6c. There are no reference marks.

BEACH (Onslow County,N.C.,R.P.S.,1911;K.T.A.,1927) -- Station recovered. Top of mark broken off 3 inches above ground. Base of mark in good condition.

BEACH (Onslow County, N.C., R.P.S., 1914; H.O., 1973) -- This station is about 2 miles NE from Bear Inlet, on the S bank of the channel from Begue Inlet to Bear Inlet, and about 300 yards N of 2 small sand mounds. The channel turns to the N just after leaving the dredge channel for about 300 yards and then turns W; the station is about 125 yards W of the latter turn, is at about high-water mark, and 3 yards from the bank.

The tile was found chipped and cracked and the old disk removed by vandals. How station mark, a standard brass disk stamped "BEACH 1914-1953", was placed in a 10- by 12-inch concrete onlar built around old tile and concrete, and projects 6 inches above ground; disk being placed in the same hole in old concrete in old broken tile from which old disk had been removed. All of station is covered by extreme high water.

No suitable places for reference marks as marsh is all around station hence no reference marks were placed. Marsh is soft mud in which a 2 by 2 can be pushed a feet down by hand.

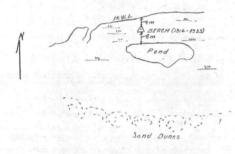

BEAR (Onslow County, N.C., R.P.S., 1914) -- This station is on the S side of the channel from Bogue Inlet to Bear Inlet, on the first point E of Bear Inlet, about 30 feet from the end of the point, or about 15 feet from high-water marks.

The station is marked by a standard bronze disk set in concrete in the top of a tile, as described in note 6c.

There are two reference marks, consisting of tiles, filled with and set in cement, projecting about 6 inches above the ground; one is 19.5 meters (65.5 feet) from the station to the SW; the other is 13.5 meters (13.6 feet) SE of the station.

The witness marks consist of blazes on three trees with 5 nails in each blaze; one is a cedar on the second point E of Bear Creek, about 200 yards from the station; the second is a large live oak, about 50 yards S; and the third is a cedar, about 10 yards SW, in range with the reference mark.

BEAR (Onslow County, N.C., R.P.S., 1914; K.T.A., 1927) -- Station


BEAR (Onslow County, N.C., R.P.S., 1914; K.T.A., 1927) -- Station is at high-water line.

Reference mark to SW no longer exists. Reference mark to SE is in good condition.

The witness mark 4,0 yards to SW was found in good condition. The other witness marks were not searched for.

BEAR (Onslow County, N.C., R.P.S., 1914; H.P.O., 1935) -- The station mark, a standard bronze disk set in concrete in the top of tile, as described in note 60, and reference marks were found in good condition. This station was used in the 1935 soheme. The station is on the S side of the channel running from Bogue Inlet to Bear Inlet, on the first point E of Bear Inlet. Distance and direction to triangular blaze on 21, inch cedar tree leaning to southward is as follows:

OBJECT DISTANCE DIRECTION

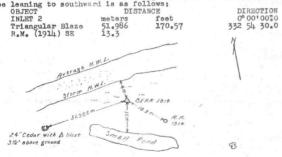

No. 476

Bogue Inlet to Wrightsville Inlet, North Carolina.

HAMMOCK (Onslow County, N.C., A.S.W., 1855;1914).--This station is about 2 miles NNE from the entrance to Bear Inlet, in front of the live oak hammock formerly known as Fins Island (?), in 1888, the island belonged to the estate of Mr. Hawkins.

The station was re-marked in 1914 by a standard bronze disk set in concrete in the top of a tile as described in note 6c.

The reference marks are 3 cedar stakes, 1 by 14 inches in size driven in the ground on three sides of the station, each having 3 nails placed in line with the station. A small live oak, with blaze and nails, is 3 yards N of the station in line with the southerly reference stake.

This station can be reached by landing near the mouth of the branch creek on the NW side of the hammock. Thence strike through the woods along the W side of a marshy glade, which runs in from the S to the station which is at the edge of the bushes at the

HAMMOCK (Onslow County, N.C., A.S.W., 1855; H.O., 1935).—Station recovered, station mark in good condition. Cedar posts gone. Blaze on live cak tree was re-out.


The station lies 2 miles N by E from Bear Inlet on the S edge of an cak and pine hammock known locally as Fins Island. The hammock lies just S of the canal and shows very prominently because of the heavy growth of timber.

Recent dredging operations have deposited thick sand banks on the E and W sides of the hammock.

The station may be most easily reached by landing on the NW point of the hammock and following the tree line along the W side to the most southerly tangent.

The station was re-marked 1914, by a standard bronze disk set in concrete on the top of a tile, as described in note 6c.

The only remaining reference mark is a triangular blaze on a small live cak 3 yards N of the station.

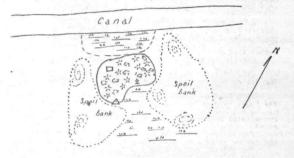

SAUNDERS (Onslow County, N.C., R.F.S., 1911). --This station is about 1 1/2 miles N from Bear Inlet, on the W side of Saunders Creek, on the S side of Saunder's Land, about 200 yards W of a slough about 100 yards S of a row of live oak trees that run from marsh to marsh, and about 5 yards above high-water mark on the W side of a marsh that runs up int the field on the W side of a fence, at the S edge of a small outton field.

The surface mark is a standard bronze diek set in concrete in the top of a tile, as described in note 6b.

The underground mark is set according to note 10d.
The reference mark is a tile, filled with and set in cement projecting about 6 inches above the surface; it is 60 meters (197 feet) from the station near two live oak trees on the edge of a field, about at high-water mark. The E tree is blazed on the E side and has nails in the blaze.

SAUNDERS (Onslow County, N.C., R.P.S., 1911; N.C.Geod.S., 1927) -- Station recovered, but concrete broken and bronze cap and pipe gone. It appears that the pipe and cap had been lifted out, concrete was broken, but not disturbed to the extent that the location was lost. I drove an iron pipe in center of concrete. My opinion is that the station is in original location. There was a temporary Coast Survey signal over station when I was there.

SAUNDERS (Onslow County, N.C., R.P.S., 1911; K.T.A., 1927) --Surface mark has been removed and lost. Concrete surrounding tile was still in place but observing party removed this to uncover subsurface mark. The latter mark is a tile filled with concrete with no mark in top. Broken pieces of concrete were piled over underground mark.

Dredged canal passes about 65 meters SE of station. Marsh E and NE of station is known as Goose Creek. Small boat landing known as Eddy or Saltworks Landing crosses high-water line about 30 meters S of station. Saunder's Creek branches off of canal about 100 meters E of station.

Reference mark searched for but not found. Blazed tree has fallen down but is still alive and blaze is still prominent.

SAUNDERS (Onslow County,N.C.,R.F.S.,1914;H.0.,1935)--This station is about 1 1/2 miles Nof Bear Inlet on a white shell bank W of Saunders Creek and on the N bank of the Inside Route


Canal. It was re-marked with a standard brass disk stamped "SAUNDERS 1911-1933" set in concrete in a 12-inch tile superimposed over old mark.

Neference mark No.1 as established 5 meters inshere from high water at a boat landing. Boat landing is prominent because of white bank of sholls. Reference mark is a standard brass dismarked "SAUNDERS NO.1, 1933" set in a 12- by 12-inch box filled

with concrete.
The station was used in the 1977 scheme.
OBJECT DISTANCE
BEAR meters fee meters feet 30.375 99.65 (Continued on p.4) R.M.No.1 (1933)

DIRECTION 0°00'00"0 52 55 00.0

SAUNDERS (Continued)

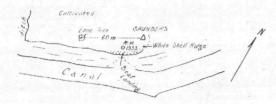

MILL (Onslow County, N.C., R.F.S., 1914) -- Station is about 300 yards E of Russell's Mill, on land owned by Saunders, about at high-water mark close to the brush. The station is about in line with SAUNDERS and the most southerly live oak tree at Russell's Mill. A live oak tree, with blaze and nails, is about 30 yards N of the station.

with SAUNDERS and the most southerly live oak tree at Massell's Mill. A live oak tree, with blaze and nails, is about 30 yards N of the station.

Surface mark is a standard bronze disk set in concrete at the center of the top of a tile, as described in note 6b. The underground mark is set according to note 10d.

The reference mark is a tile, filled with and set in cement, projecting about 6 inches above ground, with an arrow pointing toward the station scratched in the cement. It is 41.7 meters (136.8 feet) W of the station, and 1 yard E of a large live oak tree that is blazed on the S and E.

MILL (Onslow County, N.C., R.P.S., 1911; K.T.A., 1927) -- Station recovered in good condition. Russell's Mill has been torm down but a pile of sawdust is said to be there yet. The dredged canal passes about 50 meters SE of station and a spoil bank of white shells lies about 25 meters SE of station. Station is about 1 yard from high-water line.

MILL (Onslow County, N.C., R.P.S., 1914; A.P.R., 1932) -- Station was destroyed when the interwaterway was put through.

MILL (Onslow County, N.C., R.P.S., 1911; H.O., 1933) -- Station was found in good condition and was used in the 1933 scheme. It is about 1/2 mile E of Bear Creek, about 50 meters N of the inside route canal and about 50 meters N of a prominent white shell

mound.


The station is marked by a standard mark set in concrete at the center of the top of a tile, as described in note 6b.

The underground mark is set according to note 10d.

The reference mark is a 1-inch tile filled with and set in concrete with an arrow pointing toward the station scratched in the concrete.

one new reference mark was established and marked by a standard bronze disk set in concrete at the center of the top of an 8-inch tile, as described in note 13a. It is 15 meters S of an 8-inch tile the tree line. OBJECT

DIRECTION 0° 00' 00" 0 210 50 47.5 307 42 20.0 SAUNDERS feet 138.720 71.135 meters 42.284 21.680 R.M.No.1 (1914) R.M.No.2 (1933)

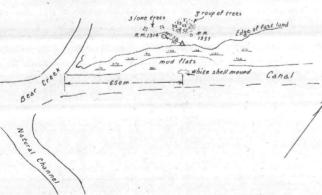

INLET (Onslow County, N.C., R.P.S., 1914) -- Station is on the inland side of the banks, about 200 yards W of the first bend W of Bear Inlet, about 75 yards W of a blazed lone cedar tree, 5 yards N of a blazed cedar in a clump of small trees, 5 yards from high-water mark.

The station is marked by a standard disk set in concrete at the center of the top of tile, as described in note 6c.

There are no reference marks.

INLET (Onelow County, N. C., R. P. S., 1911, 1K. T. A., 1927) -- Station inot be found. It has been washed away. could not

INLET (Onslow County, N.C., R.P.S., 1911; H.O., 1933) -- Station is lost. The beach has eroded up to the blazed ceder in bunches of small trees. Pieces of broken tile and cement were found on the beach.

INLET 2 (Onslow County, N.C., H.O., 1933) -- Station is on the N edge of sand dunes partly covered with grass, on the back side of the banks, about 200 yards W of the first bend W of Bear Inlet, and about 72 meters NW of a 10-inch blazed sedar trees. Gedar trees and other bushes grow southerly of station. Station mark is a standard bronze disk stamped "INLET 2, 1933" set in an 8-inch tile filled with cement, and projecting about 6 inches above ground

tile filled with cement, and projecting about tile filled with cement surface.

Reference mark No.1 is set in an 8-inch tile filled with cement projecting about 6 inches above the ground, and 3 meters N of a 10-inch cedar tree having a triangular blaze about 4 feet above the ground surface.


Reference mark No.2 is set in an 8-inch tile filled with cement, projecting about 6 inches above ground surface.

DIRECTION CAMP 2 DISTANCE

CAMP 2 meters feet 000000000

R.M.No.1 21.120 69.290 256 34 00.0 R.M.No.2 11.362 37.278 320 50 35.0 South gable of wooden shack N of the sta. (approx.) 500 yards

78 16 20.0

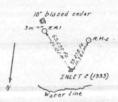

MEADOW (Onslow County, N.C., R.P.R., P.R.S., 1911). -- Station is about 1 mile SW of Russell's Mill, on the W side of Bear Creek, on land owned by Mr. Meadow, about 40 yards E of Meadow's Landing, at about high-water mark, close to the brush.

The station is marked by a standard disk set in concrete at the center of the top of a tile, as described in note 60.

Three 2- by 5-inch coak stakes, with nails in the top of each stake are driven in line from the station to the water.

MEADOW (Onslow County, N.C., R.P.S., 1914; A.P.R., 1933) -- Station was destroyed by the construction of the interwaterway.

MEADOW (Onslow County, N.C., R.P.S., 1911; H.O., 1933) -- Station is about 1 mile SW of the ruins of Russell's mill on the W side of Bear Creek, about 10 yards E of Meadow landing, at about highwater mark and close to the brush.

It was recovered in 1933 and re-marked with a standard disk set in a 10- by 10-inch block of concrete. A reference mark No.1 is a standard disk set.

established. A reference mark No.1 is a standard disk set in an 8-inch tile filled with oement, top of tile projecting 4 inches above ground surface. It is 8 50 meters from lone 4-trunk tree with triangular blaze on 8 trunk with 5 nails. Reference mark is 8E 57.545 meters (175.665 feet) from station mark, and N approximately 8 meters from high-water line.

0° 00' 00"0 32 57 02.5 MILL R.M.No.1 (1933) feet 175.665 53.545 blaze having 3 nails. 1933

CAMP (Onslow County, N.C., R.P.S., 1911).—Station is about 1 1/2 miles SW from Bear Inlet, about 100 yards NW of a high sand peak with two small grassy knolls, about 75 yards E of where the brush breaks off of banks, about 15 yards S of the point where the creek turns from the bank and extends N to the dredge channel, about 50 yards S of high-water mark.

The station is marked by a standard disk set in concrete at the center of the top of a tile, as described in note 6c.

There are no reference marks.

CAMP (Onslow County, N.C., R.P.S., 1914; K.T.A., 1927) -- Station could not be found. It has probably been washed away.

CAMP (Onslow County, N.C., R.P.S., 1914; H.P.C., 1933) -- Thorough search made for the station. It has been washed away.

CAMP 2 (Onslow County, N.C., H.O., 1933) -- Station is located about 1 2/5 miles SW from Bear Inlet. It is on a small sand spit that makes out into the marsh where channel leaves the bank and runs NW into the marsh. It is 7.5 meters W of the channel bank. Station mark is a standard disk stamped "CAMP 2-1937", set in cement in the top of an 8-inch vitrified clay tile filled with concrete, projecting slightly above ground surface, 3 1/2 meters S of high-water mark, and 12 meters N of a sand ridge at eastern extension of a bush line bordering southern edge of marsh. Reference mark No.1 is a standard brass disk stamped "1-CAMP 2-1935", set in cement in the top of an 8-inch tile filled with cement, projecting 6 inches above ground surface, 1 meter N of sand ridge mentioned before, and 5 meters W of high-water mark. Reference mark No.2 is a standard brass disk stamped "2-CAMP 2-1933" set in cement in the top of an 8-inch tile filled with cement, projecting 6 inches above ground surface, StW of station mark and about 10 meters SW of NE end of bush line bordering S (Continued on p.5)

UNITED STATES COAST AND GEODETIC SURVEY Descriptions of Triangulation Stations

CAMP 2 (Continued)

side of marsh, and 1 meter S of bush line.

Both station and reference mark No.1 are probably covered by storm high water but not by normal high water.

OBJECT DISTANCE DISTANCE

DIFECTION meters 10.996 43.112 0° 00' 00"0 211 49 30.0 300 09 55.0 STILL 36.072 R.M.No.1 R.M.No.2



STILI (Onslow County, N.C., R.P.S., 1911) -- Station is about 1 1/4 miles N from Brown's Inlet, about 200 yards from Still Landing on Still Creek, on property known as Ward's Tract but owned by a Mr. Gillett, on the S side of land that runs out into the marsh quite a distance from the station, about 1/0 yards from water on the S side which is covered with a growth of sage grass. The station is marked by a standard disk set in concrete at the center of the top of a tile, as described in note 6c.

The reference mark is a tile, filled with and set in coment, located 31.6 meters (104 feet) from the station, or just a little E of a line from BROWN. A large live oak tree near the station has a blaze with nails on it.

STILL (Onslow County, N.C., R.P.S., 1911; K.T.A., 1927) -- Station recovered as described with reference mark in good condition. Small boat landing about 1/1 mile S of station. Unimproved road leads NW 200 yards from landing and a dim foot path leads NE to blazed tree 200 yards approximately.

STILL (Onslow County, N.C., R.P.S., 1911; A.P.R., 1937) -- Station not recovered in 1937s. It had been destroyed, probably plowed up. Portions of concrete collar were found about 30 meters from reference mark. Reference mark had no bronze marker, only an arrow out in concrete. Location is in center of field on what is known as Gillette's Point, and 400 meters W of Inland waterway.

reference mark.

arrow out in concrete. Location is in concer.

known as Gillette's Point, and 400 maters W of Inland waterway.

STILL (Onslow County,N.C.,R.P.S.,1914;H.O.,1933)--Station is about 1 1/4 miles N of Brown's Inlet, and about 1/4 mile N of small boat landing on camal. From the boat landing a road leads into the woods past a small frame house. From this road a dim footpath leads past a blazed tree with nails in the blaze which is near reference mark "1914."

The station was recovered and re-marked with a standard disk stamped "STILL 1914-1933", set in a 10-inch tile filled with concrete, projecting 2 inches above the surface.

There is no underground mark.

Reference mark No.1 (1933) was established. It is a standard disk stamped "STILL No.1-1935", set in coment in the top of an 8-inch tile filled with concrete, projecting 6 inches above ground surface.

It is about 8 meters N of tree line that separates field from marsh, and about 3 meters W of small drainage ditch.

OBJECT

PIG meters feet 0 DIRECTION OF 00'00'00'0 PIG R.M. (1914) 31-17 105-22 25 49 15.0

R.M. (1914) 31-17 105-22 25 49 15.0



PIG (Onslow County, N.C., R.P., S., 1914) -- Station is about 1 mile NE of Brown's Inlet, about in the middle of the banks, 700 yards E from a fish house out in the marsh, on the largest sand knoll surrounded by three large sand pits, one to the N, one to the SE, and one to the SW. The SE pit has a few myrtle bushes on the side next to the station, the SW pit has a small knoll in the NE corner.

The station is marked by a standard disk set in concrete at the center of the top of a tile, as described in note 6c.

There are no reference marks.

PIG (Onslow County, N.C., R.F.S., 1911; K.T.A., 1927) -- Station could not be found. The sand dunes are constantly shifting, and the station was probably covered over.

PIG (Onslow County, N.C., R.P.S., 1911; H.C., 1933) -- Station is in about the middle of the banks about 2/3 the distance from Bear Inlet to Brown's Inlet. It is on a large sand knoll. To the SE

Bogue Inlet to Wrightsville Inlet, North Carolina,

Is a pit in which are growing some myrtle bushes.

Station is a standard disk set in concrete at the center of the top of a tile, as described in note 6c, and was recovered in perfect condition, and was used in the 1937 scheme. It was covered with about a foot of sand.

A reference mark was established, a standard disk set in a li- by li-inch concrete post, in range with station STILL and approximately NW of the station.

DISTANCE

DIRECTION

OBJECT

DIRECTION

OBJECT

OBJECT

DIRECTION

OBJECT

O

DIRECTION 0° 00'00"0 STILL R.M.No.1 (1933) meters 34.254 feet 112.390 359 50 30.0

BROWN (Onelow County, N.C., R.P.S., 1914) -- Station is about 400 yards E of Brown's Inlet, on the N side of the highest sand peak, at the S edge of the woods that run around the N side of tbanks. The peak breaks off very abruptly on the S side of the station and in the sand pit there are some small trees.

The surface mark is a standard disk set in concrete at the center of the top of a tile, as described in note 6b.

The underground mark is set according to note 10d.

Four small stubs are driven about 2 feet from the station.

There are no reference marks.

BROWN (Onslow County, N.C., R.P.S., 1914; K.T.A., 1927) -- Sand peak on which station was located has partly shifted. Station mark was found at the bottom of the peak. Underground mark could not be found.

BROWN (Onslow County, N.C., R.P.S., 1914; H.O., 1933) -- Station could not be found. All that remains of the sand dune is a narrow ridge about 1 yard wide, and a deep pit on its W side. Pieces of tile and cement found. Subsurface mark was also searched for but could not be found.

BROWN 2 (Onslow County, N.C., H.O., 1933) -- Station is located about 100 yards E of Brown's Inlet, on the highest point of a high sand dune, about 100 yards W of sand dune on which the original station was located. All that remains of old station dune is a narrow ridge about 1 yard wide and a deep pit on its waited. Now station is on the highest sand dune in the immediate vicinity.

violinity station mark is a standard disk stamped "BROWN 2, 1935" set in an 8-inch tile filled with cement, projecting 4 inches above

ground surface.

ground surface.

The reference mark is a standard brass disk set in an 8-inch tile filled with coment, projecting 5 inches above ground surface, at the edge of a fringe of bushes and small trees mostly codar and myrtle. Reference mark is approximately N of station mark.

OBJECT

EAGLE DISTANCE DISTANCE OF 00010020

EAGLE feet 00010020

E.M. 26.894 88.240 12 51 41.2



EAGLE (Onslow County, N.C., R.P.S., 1911) -- Station is about
1 mile NNW of Brown's Inlet, in Mr. 6111ett's field, about 150
yards from Hammook Creek. There is a small ditch that leads
about 15 yards S of the station and enters a clump of woods E
of the station.

The surface merk is a standard bronze disk set in concrete
in the top of a tile, as described in note 6b.

The underground mark is set according to note 10d.

The reference mark is a tile filled with, and surrounded
by cement, projecting about 6 inches above the surface. It is
locafed at the edge of the field, on the N side of a clump of
bushes near high-water mark, and is 101 meters, (331 feet) SN
of the station.

EAGLE (Onslow County, N.C., R.P.S., 1911; K.T.A., 1927) -- Station searched for but not found. Mr. Gillet reports striking station mark while plowing and mark is now buried.

mark while plowing and mark is now buried.

EAGLE (Onslow County, N.C., R.P.S., 1911; H.O., 1933) -- Station is located in a plowed field on land belonging to Mr. Gillett. It's about 1 mile NNW from Bear Inlet and W by N from a point on the canal where a prominent channel leads 3 toward Bear Inlet. Surface mark was broken by plow. Subsurface mark was found undisturbed and in perfect condition. New mark was placed over subsurface mark, but also below ground surface. It is a standard brass disk stamped "EAGLE, 1914-1935", set in coment in a section of 10-inch vitrified olay tile 1 foot long filled with concrete resting on a 3-inch cushin of sand. Top of tile is 12 inches below ground surface.

A new reference mark, reference mark No.2, was established. A standard brass disk stamped "EAGLE 2 1935", set in coment in the bell end of 10-inch vitrified clay tile filled with concrete. Top of tile is 1 inches above ground surface. It is in the edge of the bush line on the far side of a shallow ditch at the edge of the field N by W from the station.

Reference mark No.1, (1911) was recovered in good condition. It is a 1-inch vitrified tile set in and filled with concrete and projecting about 6 inches above ground on the N edge of the brush line which marks the high-water line and the edge of the field, 101 meters, (531 feet) SN of the station.

(Continued on p.6)

EAGLE (Continued)
OBJECT DISTANCE PIG R.M. (old-1914) 0° 00' 00"0 88 56 00.0 168 42 00.0 meters R.M. No.2 (1933)

cultivated field 00099 Spoil banks 10 Canal

FREE (Onslow County, N.C., R.F.S., 1914;1933) -- Station is about 1 1/4 miles W of Brown's Inlet, in Freeman's field, about 35 yards W of road which leads to Freeman Landing, about 450 yards From landing, 50 yards N of woods, about 300 yards E of high-water mark, and 40 yards W of head of ditch which drains field E of road. In 1932, surface mark was not found, but underground mark, set according to note 10d, was recovered and station was re-marked with standard disk station mark stamped "FREE 1914-1932" set in concrete block. Top of block is 10 inches below surface. Original reference mark is tile filled with and set in concrete, 1 yard W of road, and 31.562 meters (103.62 feet) from station in azimuth 231°35'. Three standard reference disks set in concrete, as described in mote 11a, was placed in 1932. No.2 is 53.242 meters (174.68 feet) from station in azimuth 297°47'. No.3 is approximate 1y 200 meters (656 feet) from station in azimuth 165°18152". No.4 is 32.690 meters (107.25 feet) from station in azimuth 228°31'.

CEDAR (Onslow County,N.C.,R.P.S.,1911) -- Station is about 3/4 mile SW from Browns Inlet, on the ocean side of the banks, on the highest sand knoll, 29.2 meters (96 feet) B of the NE corner of a fishing shed at Browns Inlet Fishing camp, nearly in line with a dead codar and the SE corner of the fishing shed. The station is marked by a standard bronze disk set in concrete in the top of a tile, as described in note 6c. There are no reference marks.

CEDAR (Onslow County, N.C., R.P.S., 1911; K.T.A., 1927) = The station could not be found. It was probably destroyed by shifting sand dunes.

CEDAR (Onslow County, N.C., R.P.S., 1914; H.O., 1933) -- Station recovered. Description is adequate except that the station is not on the highest sand dune.

The station was found in good condition and was used in the 1935 scheme. It was covered about a foot by sand but showed no evidence of having been disturbed.

One reference mark was established.

OBJECT

DISTANCE

DIRECTION

OCCURRED

feet 107.25 0° 00' 00"0 335 56 47.5 32,690 R.M. No.1, (1933) 0 fishing camp П. 0 a n (DEDAR

HURST (Onslow County, N.C., R.P.S., 1914) -- Station is about 3/4 miles westerly from Browns Inlet, about N of Hurst Landing, yards W of a fence that runs down to the water at the landing, yards S of a large live oak with blaze and nails near the

2 yards 5 of a large live on which water the station is marked by a standard bronze disk set in concrete in the top of a tile, as described in note 6c.

The reference mark is a tile, filled with and set in cement, projecting about 6 inches above ground. It is just E of the fence, between two large blazed oak trees, and 6.4 meters (21.0 feet) E of the station.

HURST (Onslow County,N.C.,R.P.S.,1911;H.O.,1933) -- Station recovered. Description adequate with the following addition; It is about 11 meters N of Hurst Landing.

The station was found in good condition and used in the 1933

PIVER (Onslow County, N. G., R. P. S. S., 1914) -- Station is about 1 3/4 miles SW from Browns Inlet, on the inland side of the banks, nearly in range with triangulation stations "BROWN" and "CEDAR", about 8 of a codar tree with blaze and nails.

The station is marked by a standard bronze disk set in con-in the top of a tile, as described in note 6c. There are no reference marks.

PIVER (Onslow County, N.C., R.P.S., 1911; K.T.A., 1926) -- Station ered. Mark was buried in sand. The witness marks were gone


PIVER (Onslow County, N.C., R.P.S., 191h; H.O., 1935) -- Station is on the sand dunes along the high-water line on the S side of the banks 1 5/4 miles SW from Browns Inlet, and on range with BROWN 2, and OEDAR.

banks 1 //4 miles Sw from browns finet, and on range with shown 2, and GEDAR.

Station recovered, top of tile with station disk had been broken off. About 2 feet of tile was in a vertical position firmly embedded in a collar of cement; the 2 by 2 stake came up through the center of the tile.

Station was re-marked by centering the same station disk over the wooden 2 by 2 stake, in an 3-inoh tile filled with cement, and projecting 6 inches above the top of the dune.

A reference mark disk was set in the top of an 3-inoh tile filled with cement and projecting 6 inches above the surface, approximately W of the station and just outside the SE corner of a clump of small cedar trees and myrtle bushes.

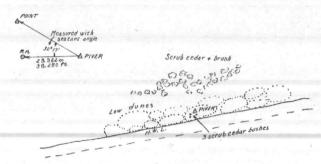

POINT (Onslow County, N.C., R.P.S., 1911) -- Station is about 2 miles SW from Browns Inlet, at the E point of woods, at an old log ditch, 30 yards E of a water fense that runs about S from the woods, at about high-water mark.

There is a blazed live oak 2 yards N of the station on which there is a bench mark established by U.S. Army Engineers.

The surface mark is a standard bronze disk set in concrete in the top of a tile, as described in note 6b.

The underground mark is set according to note 10d.

The reference mark is a tile filled with, and set in concrete, projecting about 6 inches above the surface. It is located behind three live oak trees, 6.3 meters (20.7 feet) N from the station.


POINT (Onslow County, N.C., R.P.S., 1914; A.P.R., 1932) -- Station recovered in good condition. Description adequate with the following additions: A U.S.E.D. bench mark is on a blazed tree (oak) 2 meters N of station. Station is at the second point of woods from station HURST. Reference mark is 6.3 meters N behind 3 live

POINT (Onslow County, N.C., R.P.S., 1914; H.O., 1933) -- Station is about two miles SW of Browns Inlet at the SE edge of a point of woods N of the Inside Route Canal. It was found in good condition and was used in the 1933 scheme.

The surface mark is a standard bronze disk set in concrete in the top of a tile, as described in note 6b.

The underground mark is set according to note 10d.

The reference mark is a standard bronze disk set in concrete in the top of a tile, as described in note 13b, is 6.3 meters (20.7 feet) N of the station behind three live oak trees.

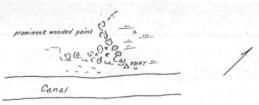

WINDY (Onslow County, N. C., R. F. S., 1911) -- Station is about 2 miles SW from Browns Inlet, on the first high sand knoll SW of FIVER, on the ocean side of the banks.

The station is marked by a standard bronze disk set in concrete in the top of a tile, as described in note 60.

WINDY (Onslow County, N.C., R.P.S., 1914; K.T.A., 1927) -- Station could not be found. It was probably destroyed by shifting sand dunes.

WINDY (Onslow County, N.C., R.P.S., 191h; H.O., 1935) -- This station, reported in 1927 as lost and probably destroyed by shifting sand dunes, was found intact and in excellent condition. The top of the mark with station disk in center was covered by about 18

of the mark with Staute war inches of sand.


Should have a reference mark to aid in future recovery.

The station lies on the highest part of the row of sand dunes along the S side of the banks, two miles SW from Browns Inlet.

(Continued on p.7)

UNITED STATES COAST AND GEODETIC SURVEY Descriptions of Triangulation Stations

WINDY (Continued)

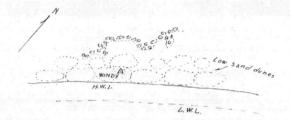


SANDY (Onslow County, N.C., R.F.S., 1914) -- Station is about 2 1/2 miles SW from Browns Inlet, on the ocean side of the banks, on top of a ridge which runs parallel with the beach, about 8 yards from high-water marks.

The station is marked by a standard bronze disk set in concrete in the top of a tile, as described in note 6c.

There are no reference marks.

SANDY (Onslow County, N.C., R.P.S., 1914; K.T.A., 1927) -- Station sould not be found. It was probably undermined by shifting sand dunes, and later covered over.

SANDY (Onslow County, N.C.R.P.S., 1911; H.O., 1953) -- Station recovered with brass disk and tile intact. It was covered by only an inch or two of sand. This station was reported in 1927 as lost and probably undermined by shifting sand dunes and cover over.
There is a fisherman's small dwelling about 300 yards W-SW

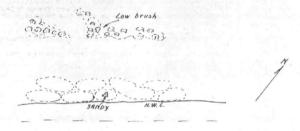

WEEK (Onslow County, N.C., R.P.S., 1914).—Station is about 2
1/2 miles SW from Browns Inlet, 75 yards NW of Weeks Landing, and
10 yards W of a road that runs into the woods from the landing.

The surface mark is a standard bronze disk set in concrete
in the top of a tile, as described in note 6b.

The underground mark is set according to note 10d.

The reference marks are tiles filled with, and set in cement.

A blazed live cak tree which is 5 yards W of the road, is
15 meters (19 feet) N of the station, Another blazed live cak
is 10 meters (35 feet) S of the station, in line with the station,
and the other blazed live cak.

Reference mark No.1 is 1 yard W of a blazed live cak, and 19.2
meters (65 feet) N of the station.

Reference mark No.2 is between three blazed live cak trees,
11.1 meters (36.4 feet) S of the station.

The two reference marks and the station are in line.

WEEK (Onslow County, N.C., R., P.S., 1911; K.T.A., 1926) -- Station and reference marks were found as described. The station is a little W of N from Weeks Landing.

WEEK (Onelow County, N.C., R.F.S., 1911; A.F.R., 1932) -- Station located about 2 1/2 miles SW from Browns Inlet and about 75 meters NW of Weeks Landing, and 10 meters W of road that runs into woods from landing.

Live oak tree blazed 15 meters N of station and 5 meters W

of road.

of road.
Live oak tree blazed 10 meters S of station. Two blazed trees and station on range.
Reference mark is 19.2 meters (taped) N of station, 1 meter W of large live oak (blazed).
Reference mark 11.1 meters S of the station between three blazed live oak trees.
Reference marks and station on range.
All marks found in good condition.
This station was not used as the seasons work did not extend this far.

WEEK (Onslow County, N.C., R.P.S., 1911; H.O., 1933) -- Station is 2 1/2 miles SW from Browns Inlet, about 75 yards N of Weeks Landing on the canal, and 10 yards W of a road that runs into the woods from the landing.


Reference mark No.1 is one yard W of a blazed live oak, and 19.2 meters (63 feet) N of the station.

Reference mark No.2 is between three blazed live oak trees, 11.1 meters (36.4 feet) S of the station are in line.

The two reference marks and the station are in line.

The station was found in good condition and was used in 1933.

Bogue Inlet to Wrightsville Inlet, North Carolina,

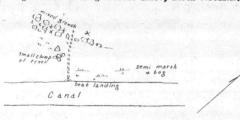

HORSEHEAD (Onslow County, N.C., A.S.W., 1855;1914) -- Station is about 2 1/2 miles SW from Browns Inlet, at a place locally known by the same name, at the E end of a grove of scrub oak and myrtle, close to the creek.

The atation was re-marked in 1914 by a standard bronze disk set in concrete in the top of a tile, as described in note 6c.

There are no reference marks.

LOW (Onslow County, N.C., R.P.S., 1931) -- This station is about 5 miles SW of Browns Inlet, on a ridge on the coesn side of the banks, about 150 yerds E of a fighting camp. There are small sand knolls just E and W of the station.

The station is marked by a standard bronze disk set in concrete in the top of a tile, as described in note 6c.


There are no reference marks.

LOW (Onalow County, N.C., R.P.S., 1914; K.T.A. 1927) -- The station could not be found. It was probably covered up by shifting sand

LOW (Onslow County, N.C., R.P.S., 1911; H.O., 1953) -- This station was recovered. It is nearly midway between New River Inlet and Browns Inlet on the first sand dune above high-water line. It is about 200 meters W of a fisherman's shack.

A reference mark was established. It is a standard brass disk set in concrete in an 8-inch vitrified clay tile, projecting 8 inches above the surface.

OBJECT PINE R.M.No.1 (1933) DISTANCE DIRECTION meters 20.908 0° 00' 00"0 16 00 00 (sextant angle) feet 68,600

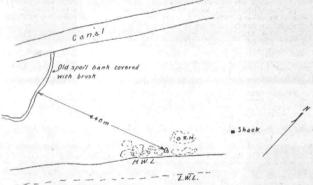

PINE (Onslow County, N.C., R.P.S., 1911) -- This station is about 5 miles SW of Browns Inlet, on the W edge of Inlet Point, where a clump of pine trees extend out to the marsh.

The surface mark is a standard bronze disk set in concrete in the top of a tile, as described in note 6b. The underground mark is set according to note 10d.

The reference mark is a tile, filled with and set in cement, projecting about 6 inches above the ground; it is 18.7 meters (60.0 feet) from the station in azimuth 22°4,7'.

Two pine trees are blazed on the sides toward the station and four or five nails are driven in each blaze; one is 4 meters (17 feet) N of the station; the other 4 meters (17 feet) E of the station.

PINE (Onslow County, N.C., R.P.S., 1911; A.P.R., 1933) -- Station was not recovered blazed trees were not found, nor was reference

PINE (Onslow County, N.C., R.P.S., 1911; H.O., 1933) -- Station recovered and used in scheme. It is about 5 miles NE of New River Inlet, on the Wedge of Inlet point, where a clump of pine trees comes out to the mersh.

Surface mark found in good condition. Underground mark not investigated. The reference mark could not be found. Both of the blazed trees are dead and one has fallen.


A 12-inch tree 5,1 meters W of the station was blazed and three natls driven in the blaze.

One new reference mark was established 25,113 meters (82,39 feet) SW, 225 301 of the station. It is about 15 meters 8 of the tree line on the pumped-in sand.

A 30-inch oak about 70 meters W of the reference mark was blazed with a triangular blaze and three nails driven in the blaze. The oak is along side a road that leads out of the woods.

(Continued on p.8)

PINE (Continued)

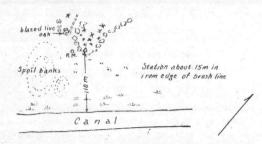

GILLETTS GREEK (Onslow County, M.C., A.S.W., 1855;1914) -- This station is about 3 1/1 miles SW of Browns Inlet, on a mersh which has a comparatively low growth of grass, about 30 yards ENE of filletts Greek, in line with the end of a hedge on the opposite

Side. The station was re-marked in 191h, by a standard bronze disk set in concrete in the top of a tile, as described in note 60.

There are no reference marks.

BAKER (Onslow County, N.C., R.P.S., 1911) -- This station is about 3 1/1 miles SW of Browns Inlet, about 60 yards NW of the log landing at Baker Creek.

The surface mark is a standard bronze disk set in concrete in the top of a tile, as described in note 6b. Underground mark is set according to note 10d.

The reference mark is a tile filled with and set in coment projecting about 6 inches above ground. It is 34.4 meters (112.9 feet) S of the station, in line with the first pine W of the landing which was blazed and had an arrow pointing toward the station out in its surface.

BAKER (Onslow County,N.C.,R.F.S.,1911,:A.F.R.,1933) -- Tile broken up, and marker not to be found. Point appears to have been torn up. Reference mark not searched for.

BAKER (Onslow County,N.C.,R.P.S.,1911;H.O.,1973)--The station is about midway between Brown Inlet and New River Inlet on the N side of the cangl. It is about 60 yards NW of the log landing on Baker Greek in a cultivated field.


The station was recovered in 1975. The surface mark had been plowed up and was found lying at the edge of the field.
Underground mark was found in good condition.

New surface mark, stendard disk was placed over it in a 12-inch tile filled with concrete. Lone live oak tree (24 inches in diameter), SSW of station was blazed with triangular blaze. Three nalls were driven in blaze.

Three reference mark (a standard disk set in a 4-inch tile filled with concrete) was found in good condition.


OBJECT
PASS
Blazed tree (Live oak)
R.M. (1914) 21 51 25.0

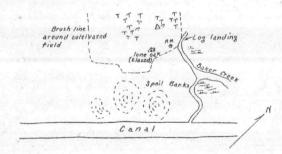

PASS (Onelow County, N.C., R.P.S., 1911) -- This station is about 3 1/1 miles SW of Browns Inlet, on the ridge on the ocean side of the banks, about 70 yards W of an old cabin, or 20 yards W of a former inlet.

The station is marked by a standard bronze disk set in concrete in the top of a tile as described in note 6c. There are no reference marks.


PASS (Chalow County, N.C., R.F.S., 1914; K.T.A., 1926) -- Found as ibed. Station in good condition. described.

PASS (Onslow County, N.C., R.P.S., 1911, A.P.R., 1933) -- Located about 31/1 miles SW of Browns Inlet on ridge on S side of banks about 70 meters W of old cabin and about 20 meters W of where there was once an inlet.

Station is marked by tile pipe and standard disk. Station was recovered in good condition, but was not used.

PASS (Onslow County, N.C., R.P.S., 1914; H.C., 1933) -- Station recovered and found in good condition.

Station is about half-way between New River and Bear Inlet, on the ridge on the S side of the banks, and it is about 20 yards W of where there was once an inlet.

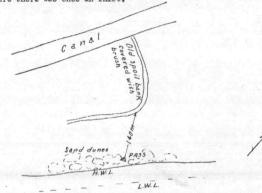

SWAMP (Onelow County, N.C., R.P.S., 1914) -- This station is about 3 3/4 miles SW of Browns Inlet, in the woods 8 of the SW corner of a field, about 20 yards from a slough to the 8 and W.

The station is marked by a standard bronze disk set in concrete in the top of a tile as described in note 6c.

The reference marks are tiles filled with and set in cement.

Reference mark No.1 is in the SW corner of the field, 5 yards Nof a blazed pine tree, and is 35.4 meters (116 feet) N of the station.



Reference mark No.2 is 4 yards N of the dredge cut, just W of a small ditch that leads up into the marsh, and is 294 meters (965 feet) from the station in azimuth 323°10'.

SWAMF (Onslow County, N.C., R.F.S., 1914; H.C., 1933) -- Station and reference mark No.1 were recovered and found in good condition. Station is nearly midway between New River Inlet and Brown Inlet in the woods to the N of the causal. It is S of the SW corner of a cultivated field.

Reference mark No.1, a 4-inch tile filled with and set in concrete, is in the SW corner of the cultivated field, 35.4 meters (116 feet) N of the station.

Reference mark No.2 is 294 meters (965 feet) from the station in azimuth 323-1014/r.

Reference mark No.2 was not searched for.

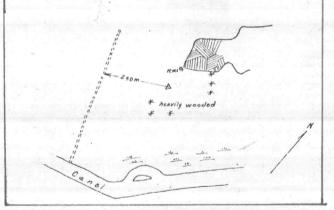

SNAG (Onslow County, N.C., R.F.S., 1914) -- This station is about 5.5/4 miles SW of Browns Inlet, on the S ridge of the banks 1 yard W of a ceder snag.

The station is marked by a standard bronze disk set in concrete in the top of a tile, as described in note 6c.

There are no reference marks.

SNAG (Onslow County, N.C., R.F.S., 1911; K.T.A., 1927) -- Station was recovered and found in good condition. It is 43 meters from high-water line.

NOTE: -- Destroyed during construction of Intracoastal Waterway. Letters from Atlantic, Gulf and Pacific Co., Swansboro, N.C., January 17 and February 19, 1930.

SNAG (Onelow County, N.C., R.P.S., 1914; A.P.R., 1973) -- Tile was recovered completely unearthed, and in a very battered condition. Marker had been removed. The station was not used in the new

SNAG (Onslow County, N.C., R.P.S., 1914; H.O., 1933) -- Station destroyed. Broken tile and cement work found washed out of sand dune.

CROSS (Onslow County, N.C., R.P.S., 1911) -- This station is about 3.3/1 miles NE from New River Inlet, on the E side of a sand hill, about 20 yards N of the ridge on the ocean side of the banks.

The station is marked by a standard bronze disk set in concrete in the top of a tile, as described in note 60.

There are no reference marks.

(Continued on p.9)

CROSS (Continued

CROSS (Onslow County, N.C., R.P.S., 1914; K.T.A., 1927) -- Station recovered and found in good condition. It is 15 meters from high-water line.

CROSS (Onslow County, N.C., R.P.S., 1914; A.P.R., 1933) -- Mark recovered. Sand had blown away, destroying station.

CROSS (Onslow County, N.C., R.P.S., 191h; H.O., 1937) -- Station destroyed. Tile and coment work found at the base of the sand dune from the top of which it had rolled down.

HIGH (Onslow County, N.C., R.P.S., 1914; H.O., 1933) -- This station shown as recovered on H. Odessey's Frogress Sketch, N.C.

No. 109. Not described in North Carolina compiled sheets. Was originally a 90-foot signal erected in the woods, and was not marked. See 0A 70059, Vol.2, page 12.

HENDERSON (Onslow County, N.C., N.P.S., 1914) -- This station is about 3 1/2 miles NE from New River Inlet, about 20 yards E of a road that runs to Horseford Landing, at the edge of woods, and at

road that runs to Horseford Landing, at the edge of woods, and a sbout high-water mark.

The station is marked by a standard bronze disk set in concrete in the top of a tile, as described in note 60.

The reference mark is a tile filled with and set in cement, projecting a little above ground. It is 5.3 meters (17.4 feet) about W from the station and 1 yard N of a blazed oak tree.

HENDERSON (Onslow County, N.C., R.P.S., 1911; H.O., 1933) -- This station is lost. It was probably destroyed when the new waterway was out.

TIE (Onglow County, N.C., R.F.S., 1914) =-Station is about 3 1/2 miles NE from New River Inlet, on the top of the ridge on the ocean aide of the benks, about S from Horseford Landing.

The station is marked by a standard disk set in concrete at the center of the top of a tile, as described in note 6c.

There are no reference marks.

TIE (Onslow County, N.C., R.P.S., 1914; K.T.A., 1927) -- Station recovered in good condition. It is about 50 meters to high-water line.

TIE (Onslow County, N.C., R.P.S., 1914; A.P.R., 1932) -- Station recovered in good condition. This station was used for topographic control along the interwaterway.

TIE (Onelow County, N.C., R.P.S., 1914; N.O., 1933) -- Station was recovered in good condition. It is about 5 1/2 miles NE from New River Inlet, on the top of the ridge on the S side of the banks. It is about S from Horseford Landing.



MORTHEAST BASE (Onslow County, N.C., R.F.S., 1914) -- Station is about 3 3/4 miles NE from New River Inlet, at about high-water mark, adjacent to station GROSS.

The station is marked only by a 4- by 4-inch pine stake with a tack for center.

There are no reference marks.

SOUTHWEST BASE (Onslow County, N.C., R.P.S., 1914) -- Station is about 3 1/2 miles NE from New River Inlet, on the beach at about high-water mark, adjacent to station TIE.

The station is marked only by a 1- by 1-inch pine stake with a tack for center.

There are no reference marks.


BRIER (Onslow County, N. 6., R. F. S., 1914) -- Station is about 3-1/2 miles NE from New River Inlet, about 250 yards W of a road t leads to Horseford Landing and about 150 yards back in the woods

from the marsh.

The station is marked by a standard disk set in concrete at the conter of the top of a tile, as described in note 60.

The reference mark is 8.3 meters (27.2 feet) from the station in estmath 27.65 591.

BRIER (Onslow County, N.C., R.F.S., 1911; H.O., 1933) -- Station recovered in good condition. It is about 3 1/2 miles NE from New River Inlet and is about 125 meters back in the woods from

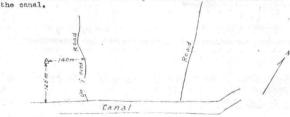

Bogue Inlet to Wrightsville Inlet, North Carolina.

Bogue Inlet to Wrightsville Inlet, North Carolina.

DUGK CREEK (Onslow County, N.C., C.D.W., 1932)—Station is 3 1/2 miles E of Marines post office. To reach from Finey Green on Route 2h, take road leading S at cross roal, keep main road straight ahead at 9.55 miles, turn right at forks with milesge sign "Jacksonville 19", proceed 0.55 mile, turn right at forks with tobacco barn in "v", and proceed 0.6 mile to Frank Dennis' house back off road to right. Station is in en area 65,2" meters (21h feet) SSW of SW corner of Frank Dennis' house, 1h,3 meters (1h feet) N of wagon road leading past station, and 7.2 meters (2h feet) W of Ione 12-inch persimmon tree. Surface, underground, and reference marks are standard disks set in concrete, as described in notes 1a, 7a, and 11a. Reference mark No.1 is at SW corner of Frank Dennis' house, and 65,10 meters (213.6 feet) from station in azimuth 185"|18' . No.2 is in out-over timber land, 11.7 meters (38 feet) S of center line of road leading to station, and 56.21 meters (118.8 feet) from station in azimuth 28"|18.1 mo.3 is in NW corner of garden lot, 20 meters (66 feet) NW of NW corner of Négro house, 30 meters (98 feet) N of center line of road leading past station, and approximately 0.25 mile from station in azimuth 58° 25'105".

SEA (Onslow County, N.C., R.P. S.S., 1911;1935) -- Station is about 3 miles NE of New River Inlet, on E end of ridge which is No fridge along S edge of beach. In 1927, mark was 15 meters (116 feet) from high-water line. Marked by a standard station disk in center of top of tile which is fastened by means of concrete to upper end of long wooden pile driven into march.

WILLIAMS (Onslow County, N.C., R.Y.S., 1911;1975) -- Station is about 3 miles NE of New River Inlet, at SE corner of field owned by John Williams, about 25 meters (82 feet) NW of alump of oak trees, and just above high-water mark. Marked by standard station disk in center of top of tile which is fastened by means of concrete to upper end of long wooden pile driven into marsh. Reference mark is tile filled with and set in concrete, 1 meter (3 feet) N of oak tree blazed with three nails which is at edge of marsh, and 22.82 meters (74.9 feet) from station in azimuth 268°18'.

SHELL (Onslow County, N.C., R.F.S., 1911).--Station is about 2 1/2 miles NE from New River Inlet, on a high sand peak on the ridge at the ocean side of the banks, about S from a bay that is on the S side of the channel, and E of a pine hammook.

The station is marked by a standard disk set in concrete at the center of the top of a tile, as described in note 6c.

There are no reference marks.

SHELL (Onslow County, N.C., R.P.S., 1914; K.T.A., 1927) -- Station could not be found. It was probably destroyed by shifting dunes.

SHELL (Onslow County, N.C., R.P.S., 1911; A.P.R., 1952) -- High peak in original description no longer exists. Tile, cement, and bronze marks were found in a demolished condition in hollow.

VIM (Onslow County, N.C., A.P.R., 1932)--Station is about 2.3 miles He of New River Inlet, about 0.3 miles He of intercoastal waterway, opposite small bay, about 75 yards inshore from main ridge of sand dunes, and on summit of westerly of two prominent dunes. Marked by standard station disk in center of top of 6-in tile embedded in ground, as described in note 6a. Top of tile is reinforced with 12-inch square cement collar which projects 6 inches. of 8-1nch

BAY (Onslow County, N.C., R.P.S., 1911;1932) -- Station is about 2 miles NE of New River Inlet, in march on W side of small bay which leads from interwaterway up into Williams' field, about 100 meters (328 feet) from edge of woods on W and N sides of bay, and about 10 meters (37 feet) W of edge of water. Originally marked by standard station disk in center of top of tile which was fastened by means of cement to upper end of long wooden pile driven into march. Re-marked in 1932 by standard station disk in center of top of 8-inch tile filled with concrete, embedded in ground, and reinforced with square concrete collars. Original reference mark was 3 yards from water and 19,8 meters (65 feet) from station. In 1932, mark was found to have been destroyed, and two standard reference disks in center of tops of tiles embedded in ground, as described in note 13a, were established. No.1 is 109,21 meters (3563 feet) from station in azimuth 11°06.

GAP (Onslow County, N.C., R.F.S., 1011) -- Station is about 2 miles

NE from New River Inlot, on the main ridge of the banks abreast
of the wharf at Graig Foint. It is best reached by the slough
that runs from the dredged out opposite the wharf at Graig Foint.

The station is marked by a standard disk set in concrete
at the center of the top of a tile, as described in note 6c.

There are no reference marks.

The knoll on which the station is located is of very shifting
sand and displacement of the station is probable.

GAP (Onslow County, N.C., R.P.S., 1914, K.T.A., 1927) -- Station has been undermined and was found lying at the bottom of the dunes.

GAP (Onslow County, N.C., R.P.S., 1911; A.P.R., 1932) -- Thorough search made but station was not found. This station is probably buried in shifting sand dunes.

CRAG (Onslow County, N.C., R.P.S., 1914;11952) -- Station is about 2 miles NE of New River Inlet, about 100 meters (1,512 feet) NW of Craig Point, and about 65 meters (213 feet) from trees on W border of Smith's field. Marked by standard station disk sot in concrete in center of top of tile surrounded by meas of concrete, projecting about 6 inches. Reference mark was tile filled with and surrounded with cement, at about high-water mark on W edge of field, 2 meters (7 feet) from blazed tree, and 61, we ters (201 feet) from station. Reference mark was not recovered in 1932.

SMITH'S HOUSE (Onslow County, N.C., R.P.S., 1914; K.T.A., 1927) --Station not described on original work. It is a cupola on a red

SMITH'S HOUSE CUPOLA (Onslow County, N.C., R.P.S., 1914; A.P.R., 1932) -- House was destroyed by fire.

PAVILION (Onslow County, N.C., R.P.S., 191h) -- Station is about 1/2 mile NE of New River Inlet, at the W end of a ridge on the ocean side of the banks, on the southeasterly one of two prominent gand hills, about 50 yards E of where the ridge is completely

PAVILION (Onslow County, N. C., R. P. S., 1914; K. T. A., 1927) -- Station could not be found. It was probably undermined by shifting sand dunes.

PAVILION (Onelox County, N.C., R.P.S., 1914; A.P.R., 1932) -- Station was found but in a demolished condition at the foot of a sand hill. This station was not used as the exact point could not be found. Station AMOS was established northward and in a location that would have more permanency.

AMOS (Onslow County, N.C., A.P.R., 1932) -- Station is about 0.6 mile NE of New Hiver Inlet, in slight hollow off southerly group of dunes, about 150 yards SE of 2 prominent dunes, about 35 yards S of myrtle bushes on edge of marsh, and about 50 yards SW of group of myrtle bushes in low land between 2 groups of dunes, about 35 yards SW of group of ground, as described in note to a. Reference marks are standard reference disks in center of top of tile embedded in ground, as described in note 13a. No.1 is in hollow NE of 2 high dunes, and 35,50 meters (16.5 feet) from station in azimuth 99°28¹. No.2 is on slight hummock, and 21.47 meters (70.4 feet) from station in azimuth 223°21¹.

GEDAR POINT (Onslow County, N.C., R.P.S., 1911; 1932) -- Station is on S side of Cedar Foint at mouth of New River, at about highwater mark, and 1 meter (3 feet) from brush. Marked by standard station disk set in concrete in center of top of 6-inot tile which is fastened by means of concrete to long wooden pile driven into marsh. In 1932, mark was reinforced with 12-inot square cement collar. Reference mark is tile filled with and set in cement, 3 yards S of blazed tree, and 10,975 meters (36,01 feet) from station in azimuth 267°36'.

SWAN POINT (U.S.E.) (Onslow County, N.C., R.P.S., 1911; 1932)—Station is located at W side of mouth of New River, on Swan Point. Surface mark is standard disk station mark in 1,-inch tile, cemented to iron pipe which was original station mark. Tile projects 6 inches, and in 1932 was reinforced by 12-inch square cement collar. Reference mark is tile filled with and set in cement, about 1, yards from high water, and 11,-69 meters (18.2 feet) from station in azimuth 61, 11. Station SWAN POINT ECCENTRIC is 200,211 meters (656.86 feet) from station in azimuth 116°35'149".

SWAN FOINT ECCENTRIC (Onslow County, N.C., C.D.M., 1932) -- Station is on Swan Foint, on W side of New River, To reach from Sneads Ferry post office, go E 1.6 miles on main road to Hatch Foint, turn right onto side road around house on S side of road and close to it, proceed 0.8 mile, take right-hand fork with blazed tree in V, continue 0.15 mile, turn through left-hand gate, follow dim road along edge of field just to right of timber line 0.5 mile to another gate, pass through gate, and continue along timber line 0.17 mile to point where road disappears opposite blazed pine tree at left of line of travel. Station is in open area, 16.8 meters (55 feet) NW of 12-inch triangle-blazed pine tree, and about 8 meters (26 feet) W of edge of woods. Surface, underground, and reference marks are standard disks set in concrete, as described in notes la, 7s, and lla. Reference mark No.1 is on W edge of woods, and 30.78 meters (101.0 feet) from station in azimuth 177°01'. No.2 is in cleared path to old station, on W edge of woods, and 31.415 meters (105.2 feet) from station in azimuth 301°28'. No.3 is 5 meters (10 feet) are for bank at water's edge (bank is 3 meters (10 feet) above water line at this point), about 15 meters (19 feet) NW of group of three 10-inch trees and approximately one-fourth mile from station in azimuth 170°01''. No.8.1''s constation water (10 feet) above water line at this point). Station SWAN POINT (U.S.E.) is 200.211 meters (56.86 feet) from station in azimuth 296°03'15". Reference mark of station SWAN POINT (U.S.E.) is in azimuth 300°03'75" from station and SWAN POINT

TILE (Onslow County, N. C., R. F. S., 191h) -- Station is about 1 mile SW of New River Inlet, on the main ridge of the banks, on the first high peak, about 50 yards W of the fishing camp.

The station is marked by a standard disk set in concrete at the center of the top of a tile, as described in note 6c.

There are no reference marks.

TILE (Onslow County, N.C., R.P.S., 191h; A.P.R., 1932) -- Thorough search was made for this station. Station was not recovered. This station is probably buried by shifting sand dunes. New station VIEW was established in this vicinity.

VIEW (Onslow County, N.C., A.F. R., 2,932) -- Station is on the ocean shore, about 1 1/4 miles SW of New River Inlet, about 125 yards from beach, 25 yards from edge of marsh bushes, and in hollow of first high dune S of path leading E from marsh. Marines Landing is visible midway between beacons Nos.2 and 4. Station and reference marks are standard disks set in concrete in center of top of tile embedded in ground. Reference mark No.1 is in hollow in direction of inlet, and 57.52 meters (110.0 feet) from station in azimuth 252°08'. No.2 is on slight rise at foct of above-mentioned dune, and 53.56 meters (109.4 feet) from station in azimuth 10°05'.

WRIGHTS ISLAND (U.S.E.) (Onslow County, N.C., R.P.S., 1914).—Station is located at New River Inlet, on a small sand knoll at the W end of Wright's Island, about 40 yards N of the pavilion. The station was originally established by U.S. Engineers and marked by an iron pipe. In 1914, this pipe was carefully driven down to the surface and surrounded by a tile in which a standard bronze station tablet of the U.S.C.& G.S. was cemented, centered at the same position as the original point.

WRIGHTS ISLAND (U.S.E.) (Onslow County, N.C., R.P.S., 1914; K.T.A., 1927) -- No description of station was furnished, however, station no longer exists.
Station lost, was on shifting sand dune.

LIGHTER (Onslow County, N.C., A.S.W., 1855;1914) --Station is in the marshes between New River and the banks, and about 3/4 mile back from the entrance to New River Inlets.

The station was re-marked in 1914 by a standard disk set in concrete at the center of the top of a tile, as described in note 60.

There are no reference marks.

LIGHTER (Onslow County, N.C., A.S.W., 1855; K.T.A., 1927) -- Sta-

NORTH BASE (U.S.E.) (Onslow County, N.C., A.P.R., 1932)--Station is about 1 1/2 miles NW of New River Inlet, about 550 meters (1,148 feet) from interwaterway, on NW shore of narrow straight cut which leads SE from interwaterway to inlet, and 11.5 feet from high-water mark of out. Marked by 6-inch square concrete monument projecting 0.3 foot, and inscribed with letters "U.S.E. 1913" and equilateral triangle.

SOUTH BASE (U.S.E.) (Onslow County, N.C., A.F.R., 1932) -- Station is about 1 mile N of New River Inlet, at SE end of 1 mile out which leads from waterway to inlet. Marked by 6-inch square concrete monument projecting about 1 inches, and inscribed with letters "U.S.E." and equilateral triangle.

WRECK (Onslow County, N.C., R.P.S., 1911) -- Station is about
2 1/4 miles SW of New River Inlet, on the main ridge of the banks.

The station is marked by a standard disk set in concrete at
the center of the top of a tile, as described in note 6c.

There are no reference marks.

WRECK (Onslow County, N.C., R.P.S., 1914; K.T.A., 1926) -- Station recovered as described. Station mark partially washed out and probably will not last long.

PISH (Onslow County, N.C., A.P.R., 1932) -- Station is about 2 miles W of New River Inlet, about 125 yards from ocean beach, near Beacon No.1, about 150 yards SW of old fish shack, and on edge of myrtle bushes and marsh. Station and reference marks are standard disks set in cement in center of top of tile embedded in ground. Reference mark No.1 is in hollow between 2 dunes, and 19.99 meters (65.6 feet) from station in azimuth 139°57'. No.2 is at edge of myrtle bushes, and 22.49 meters (73.8 feet) from station in azimuth 228°46'.

GRANT (Onslow County, N.C., R.P.S., 1914) -- Station is on a small march at the mouth of a small creek which leads NE from Alligator Bay, about 20 yards from the Sbank. 'the creek, and about 10 yards from the Bay.

The station is marked by a standard bronze disk set in concrete in the top of a tile, as described in note 6c.

There are no reference marks.

GRANT (Onslow County, N.C., R.F.S., 1911, 1A.F.R., 1932) -- Station located in marsh about 20 meters southeastward of small creek leading northeastward from Alligator Bay, and about 10 meters from the bay.

St.Lion and reference marks are standard bronze disks set in concrete in the center of the top of tile which are embedded in the ground.

Two reference marks were established. Reference mark No.1 is toward the waterway in high grass, 1 meters from the bay.
Reference mark No.2 is 2 meters from the water's edge of the Bay. Both reference marks project about 6 inches above the surface of the ground. the ground.

LOG R.M.No.1 R.M.No.2

DISTANCE meters 34.20

feet 112.2 82.3

DIRECTION 0° 00'00"0 20 41 197 23 30

LOG (Onslow County, N.C., R.P.S., 1914) -- Station is about 4 miles SW from New River Inlet, 25 yards inland from the main ridge of the banks, on the first high peak that breaks off from the ridge E of the fishing camp at Alligator Bay.

The station is marked by a standard bronze disk set in concrete in the top of a tile, as described in note 6c.

There are no reference marks.

IOG (Onslow County, N.C., R.P.S., 1914; K.T.A., 1926) -- Station recovered as described.

LOG (Onslow County, N. C., R. P. S., 19th; A. P. R., 1932) -- Station was found in good condition. It is located about 25 meters inlast from main ridge of banks and on first high peak that breaks from the ridge E of Alligator Bay.

Station and reference marks are standard disks set in concrete in the center of the top of tile which are embedded in the

ground.
Two reference marks were established. Reference mark No.1
1s NE of station in hollow. Reference mark No.2 is in the direction of the Bay on knoll.

OBJECT DISTANCE DIRECTION

GRANT R.M.No.2

feet meters 24.14 79.2 DIRECTION 0° 00' 00"0 74 43 40 301 07 45

UNITED STATES COAST AND GEODETIC SURVEY Descriptions of Triangulation Stations

Descriptions of Triangulation Stations

GRANT (Onslow County, N.C., C.D.M., 1932) -- Station is on land belonging to Jim Grant, 2.15 miles from Sneads Ferry post office, 5.4 miles from Folkstone on United States Route 17, in small open area, 19,8 meters (55 feet) SE of center line of Route 301, 5.8 meters (12 feet) SE of diagonal dim cross road leading into woods, and 30.5 meters (100 feet) SW of center line of intersection of Route 301 and cross road. Surface, underground, and reference marks are standard disks set in concrete, as described in notes 1e, 7a, and 11a. Reference mark No.1 is in NE angle between Route 301 and dim cross road, 2.0 meters (7 feet) SE of center line of road, 7.9 meters (26 feet) N of center line of Route 301, and 152.55 feet from station in azimuth 186°28'. No.2 is at SE corner of barn where lane torminates at farmyard, about 29 meters (95 feet) E of road, about 10 meters (131 feet) SE of farmhouse, and approximately 0.3 mile from station in azimuth 186°36'34". No.3 is 72.2 meters (257 feet) W of center line of intersection of Route 301, and 182.7 feet from station in azimuth 74°30'.

GROVE (Onslow County, N.C., R.P.S., 1911) -- Station is about 1/2 mile W from the W shore of Alligator Bay, on the N side of a pine grove, about 300 yards from the woods on the mainland or about 25 yards N of a small pond in the middle of the grove.

The station is marked by a standard bronze disk set in concrete in the top of a tile, as described in note 60.

The reference mark is a tile filled with and set in cement. It is 16.1 m.sters (53 feet) from the station in azimuth about 350°301.

375° 30'. There is a large pine, blazed on the two sides toward the station and reference mark, and about 5 meters (16 feet) S of the

GROVE (Onslow County, N.C., H.P.S., 1914; J.A.B., 1933) -- Station was recovered in good condition. Station is about 1/2 mile W from the W shore of Alligator Bay, in the center of the N side of the largest group of pine trees, about 300 yards SE from the mainland, and 500 yards NW from the Intracoastal Waterway, 5 yards inside tree line on firm ground. Several small trees have been cut around station, and there is a large blazed pine tree 5 yards S of the station.

The reference mark could not be found.

MUSH (Onslow County, NoC., R.P.S., 1914) -- Station is on the banks, about S of a muddy place in the channel extending from the SW end of Alligator Bay, known as the "Mush Pots."

The station is marked by a standard bronze disk set in concrete in the top of a tile, as described in note 60.

There are no reference marks.

MUSH (Onelow County, N.C., R.F.S., 1914; K.T.A., 1926) -- Station recovered as described.

MUSH (Onslow County, N.C., R.P.S., 1911; J.A.B., 1933) -Station recovered. Station is on the banks about S of a muddy place in the channel SW of Alligator Bay, known as the "Mush Pota." Azimuth to Beacon Fl. "5" N. 35° E. mag.

Station is in good condition, and marked by a standard bronze disk set in concrete in the top of a tile, as described in note 60.

GOOSE BAY (Onslow County, N.C., R.P.S., 1911,) -- Station is about 1 1/2 miles NE of the mouth of Turkey Creek, 2 yards from the W shore of Goose Bay, about 25 yards N of the point where a small ditch empties into the bay.

The station is marked by a standard bronze disk set in concrete in the top of a tile, as described in note 6c.

There are no reference marks.

GOOSE BAY (Onslow County, N.C., R.P.S., 1914; J.A.3., 1953) -Station was recovered in good condition. The station is 1 1/2
miles NE of the mouth of Turkey Greek, 1 yard from the W side of
Goose Bay, 25 yards N of where a small ditch runs W from the
bay, and 200 yards SW of a fence running at right angles to shore
of bay.

CRAB (Onslow County, N.C., R.P.S., 1911) -- Station is about 6 1/2 miles SW from New River Inlet, on the banks, about 400 yards from Grant's summer house.

The station is marked by a standard bronze disk set in concrete in the top of a tile, according to note 6c.

There are no reference marks.

CRAB (Onslow County, N.C., R.P.S., 1911; K.T.A., 1926) -- Station recovered as described. It is partially washed out.

CRAB (Onslow County, N.C., R., P.S., 1911; J.A.B., 1933) -- Station recovered. Station is 6 1/2 miles S of New River on the main ridge of sand dunes, 175 yards N (along beach) of a fence that runs at right angles to beach. Station is in good condition, but projects 15 inches above the surface of the sand.

HOBBS (Onslow County, N.C., R.P.S., 1914) -- Station is about 1/2 mile E of the mouth of Turkey Creek, on Turkey Point, 4 yards E of the road at a point about 5 yards S of the woods line.

The station is marked by a standard bronze disk set in concrete in the top of a tile, as described in note 6c.

The reference mark is a tile filled with and set in cement. It is about 70 paces from the station, 20 yards from high-water mark, and 2 yards from the NE corner of a shell mill.

HOBBS (Onslow County, N.C., R.P.S., 1911; K.T.A., 1927) -- Station marked; recovered in good condition.

Reference mark broken off 3 inches above ground. Original description correct.

No. 476

Bogue Inlet to Wrightsville Inlet. North Carolina.

ROGER (Onslow County, N.C., R.P.S., 1914) -- Station is about 5/4 mile E of the mouth of Turkey Creek, on a ridge on the beach about 1/2 mile S of Rogers Bay.

The station is marked by a standard bronze disk set in concrete in the top of a tile, as described in note 6c.

There are no reference marks.

ROGER (Onslow County, N.C., R.P.S., 1914; K.T.A., 1926) -- Station not recovered, probably buried by shifting sands.

ROGER (Onslow County, N.C., R.P.S., 1914; J.A.S., 1933) -- Station could not be found after a detailed search. There are shifting sand dunes in this vicinity.

ROUGH (Onslow County, N.C., R.P.S., 1911).-This station is about S of the westerly end of Ashe's Island, on a ridge of the banks about 100 yards W of an old fishing camp.

The station is marked by a standard bronze disk set in concrete in the top of a tile, as described in note 60.

There are no reference marks.

ROUGH (Onslow County, N.C., R.P.S., 1914; K.T.A., 1926) -- Not recovered probably buried by shifting sands.

ROUGH (Onslow County, N.C., R.P.S., 1911; J.A.B., 1933) -- The station could not be found, after a detailed search. There are shifting sand dunes in this vicinity.

KING (Onslow County, N.C., R.P.S., 1914)--This station is at wend of Spicer's Bay on the second small point E of Kings KING (Onslow county,...

the Wend of Spicer's Bay on the second small point

Greek.

The station is marked by a standard bronze disk set in concrete in the top of a tile, as described in note 6c.

There are no reference marks.

KING (Onslow County, N.C., R.P.S., 1911; J.A.B., 1935) -- Station recovered. The top was broken off but enough remained so that the position of disk could be determined. A new disk was cemented in place.

Station is on the second small point east of King's Creek at the W end of Spicer's Bay, 250 yards NW, of Beacon "13", and 2 yards from the edge of the bank.

SQUALL (Onslow County, N.C., R.F.S., 1914) -- This station is about 1/2 mile SW of Kings Creek, 1/4 mile NE of Molls Island 2 yards from the edge of the water.

The station is marked by a standard bronze disk set in concrete in the top of a tile, as described in note 6c.

There are no reference marks.

SQUALL (Onslow County, N.C., R.P.S., 1914; J.A.B., 1973) -- Station was recovered in good condition.

It is about 1/2 mile SW of King's Creek, at the edge of a spoils bank at the high-water line, and directly opposite Beacon "17."

STUMP (Onslow County, N.C., R.P.S., 1914) -- This station is almost directly 3 of the middle point of Permuda's Island, 1 1/2 miles SW from the Wend of Ashe's Island, on the banks.

The station is marked by a standard bronze disk set in concrete in the top of a tile, as described in note 6c.

There are no reference marks.

STUMP (Onslow County, N.C., R.F.S., 1914; K.T.A., 1926) -- Not recovered, probably buried by shifting sands.

STUMP (Onslow County, N.C., R.P.S., 1914; J.A.B., 1933) -- Station could not be found. The single steep line of dunes along the beach in this vicinity appear to be eroding and shifting.

PED (Pender County, N.C., J.A.B., 1953) -- This station is located on the sand dune ridge 8 miles S of New River Inlet, about opposite the northern half of Permuda Island, 75 yards N of a fence running at right angles to beach 1/2 mile S of fishing shack in ridge of dunes. The ridge of dunes in this vicinity is rather even in height.

Station and reference marks are standard disks set in con-crete at the center of the top of tile which are embedded in the ground. The marks set in 8-inch tile which project I foot above the surface.

surface.

Reference mark No.1 is on the main ridge of dunes S of the ion. Reference mark No.2 is on a low knoll inland.


BETHER (Onslow County, N.C., C.D.M., 1932) -- Station is 2 3/4 miles SE of Hollyridge. To reach from Hollyridge (on Route 17), go 0.25 mile on read from S side of Hollyridge service station which leads to Bethea Landing, keep main read to left at forks, proceed 1.05 miles, take left-hand fork, continue 0.15 miles, keep straight shead beyond school 0.25 mile, take right fork, and proceed on main-traveled read 1.5 miles to station. Station is near fence line, 6.0 meters (20 feet) N of read leading towards station, about 65 meters (215 feet) SW of R.H. Bethea's house, 9.414 meters (31 feet) W of 36-inch live cosk, and 11.2 meters (37 feet) S of S face of most westerly of face buildings. Surface, underground, and reference marks are standard disks set in concrete, as described in notes la, 7m, and lla. Reference mark No.1 is in old orchard, 12.45 meters (12 feet) N of NW orner of fence around house, and 170.3 feet from station in azimuth 2259/12'. No.2 is in copen field, 13 meters (13 feet) NE of read leading to station, and 110.2 feet (Continued on p.12)

BETHEA (Continued) from station in azimuth 106°00'. No.3 is 1 foot E of N and S wire fence, about 5 meters (16 feet) W of dirt road at bend, about 75 meters (216 feet) 3 of tobacoo house on W side of road, and approximately 0.2 mile from station in azimuth 112°53'34".

BARLOW (Onslow County,N.C.,R.P.S.,1914) -- This station is about 3/4 mile E from the mouth of Barlow's Creek, on a small point nearly opposite entrance to Cedar Snag Channel.

The station is marked by a standard bronze disk set in concrete in the top of a tile, as described in note 6c.

There are no reference marks.

BARLOW (Onslow County, N.C., R.P.S., 1911; J.A.B., 1935) -- This station was recovered in good condition.

Station is about 3/4 mile NE from the mouth of Barlow Creek, on a small point N of Cedar Snag Channel, 500 yards W of Beacon "21", and 2 yards from the edge of the bank.

3FY (Onslow County, N.C., R.P.S., 1911) --This station is about midway between New Topsail and New River Inlets, or 1 1/2 miles SE from mouth of Barlows Creek on the banks about 1/1 mile E of the point at junction of Gedar Snag Channel and Banks Channel. The station is marked by a standard bronze disk set in concrete in the top of a tile, according to note 6c.

There are no reference marks.

SPY (Onslow County, N.C., R.P.S., 1911; K.T.A., 1926) -- This station not recovered probably buried by shifting sands.

SPY (Onslow County, N.C., R.P.S., 1914; J.A.B., 1933) -- Station could not be found. The single steep line of dunes along the beach in this vicinity appear to be eroding and shifting.

BANKS (Pender County, N.C., 7, A.5., 1935) -- This station is on the sand dunes 9 1/2 miles SW of New River Inlet, 3/4 mile S of the southwestern end of Fermuda Island, 1/4 mile E of a sharp bend in Banks Channel, on the highest and most easterly of a group of dunes behind the main ridge along the beach, 100 yards from the beach line, 1/4 mile NE of a fishing shack along beach. This sand dune is very conspicuous from the beach for a mile on either side.

Station and reference marks are standard disks set in concrete at the center of the top of a tile which is embedded in the ground. The marks are both set in 8-inch tiles and project 8 inches above the surface of the ground.

The reference mark is on a nearby high dune.

OBJECT

DISTANCE

DIRECTION

DERECTION

0° 00' 00"0 30 52 50

DESTRUCT
BARLOW meters
R.M.No.1 10.500
Height of signal above station mark 4 meters.

HORSESHOE (Pender County,N.C.,R.P.S.,1914)--This station is on the banks, SE from the E end of Waters Bay, on a small sand hill S of the Horseshoe Channel, on the W bank of Old Stump Inlet.

The station is marked by a standard bronze disk set in concrete in the top of a tile, as described in note 6c.

There are no reference marks.

HORSESHOE (Pender County, N.C., R.P.S., 1914; K.T.A., 1926) -- Station recovered as described.

HORSESHOE (Pender County, N.C., R.P.S., 1914; J.A.B., 1933) -- Station could not be found. Stakes of an old signal were found in the vicinity, but considerable digging did not reveal any other traces of the station.

HIGH (Pender County, N.C., J.A.S., 1933) -- This station is on the sand dunes, 7 1/2 miles N of New Topsail Inlet 1 1/2 miles S of the southern end of Permuda Island, 1/2 miles SW of the southern end of Banks Channel. The dunes in this vicinity are very even in height, and there is only one row along the beach. The station and reference marks are on the top of the ridge.

Station and reference marks are standard disks set in concrete at the center of the top of a tile which is embedded in the ground. The marks are set in 8-inch tile and project S inches above the surface of the ground.

OBJECT

DISTANCE

BARLOW


DIRECTION 0° 00' 00" 0 54 55 25

BARLOW

BARLOW meters R.M. 18.380 Height of signal above station mark 4 meters.

WATER (Pender County, NC., R.P.S., 191h) -- Station is about 1/2 mile SW from the mouth of Barlow Creek, about NE of Batson's Island, on the marsh just E of an old landing, about 2 yards from the water.

The station is marked by a standard bronze disk set in concrete at the center of the top of a tile, as described in note 60.

There are no reference marks.

WATER (Pender County, N.C., R.P.S., 1914; J.A.B., 1933) -- Station could not be found after a detailed search. The shore line has eroded considerably at this point and the station is evidently lost.

MIK (Pender County, N.C., J.A.B., 1933) =- Station is on the mainland about 1/2 mile SW of Barlow Creek, 1/4 mile W of Beacon 25. Station is at the edge of the fast land, about at high-water line.

Station and reference marks are standard bronze disks set in concrete at the center of the top of tile, as described in notes 6a and 13a.

Reference mark is set in an 8-inch tile E of station.

OBJECT DISTANCE DIRECTION

DIRECTION 0° 00' 00"0 287 08 25

BARLOW R.M.No.1

BAT (Pender County, N.C., R.P.S., 1914) -- Station is on the NW shore of Water's Bay, on a small shell ridge on the mainland, opposite Batson Telland.

The station is marked by a standard bronze disk set in concrete at the center of the top of a tile, as described in note 60. There are no reference marks.

BAT (Pender County, N.C., R.P.S., 1914; J.A.B., 1933) -- Station could not be found after clearing the point and considerable

GANAT (Pender County, N.C., R.P.S., 1911) -- Station is about 7 miles NE from New Topsail Inlet, on the main ridge of the banks opposite Sears Landing.

The station is marked by a standard bronze disk set in concrete at the center of the top of a tile, as described in note 6c.

Station is best reached from the creek leading E from Bluff

GANAT (Pender County, N. C., R. P.S., 1914; K. T. A., 1926) -- Station not recovered. Probably buried by shifting sands.

GANAT (Pender County, N.C., R.P.S., 1911; J.A.B., 1933) -- Station was found with the top of the drain tile broken off. The broken parts were fitted together, the centerre-established and the station re-marked with a standard bronze disk set in a mounded mass

LACEY (Pender County, N.C., R.P.S., 1914) -- Station was a signal pole ersoted back in woods about 700 meters N of Sear's Landing. Station not marked.

LACEY (Pender County, N.C., R.P.S., 1914; J.A.B., 1933) -- No description available. No trace of station was found after a careful search in that vicinity.

BECK (Pender County, N.C., R.P.S., 1914) -- Station is on the second point of marsh about 500 yards W of entrance to Bishop Creek, about 100 yards E of a small hammook of oaks, and 2 yards from high-water mark.

The station is marked by a standard bronze disk set in concrete at the center of the top of a tile, ss described in note 6c.

There are no reference marks.

BECK (Pender County, N.C., R.P.S., 1914; J.A.B., 1933) -- Station was found as described in good condition. Description is adequate.

BLUFF (Pender County, N.C., R.P.S., 1914) -- Station is located at the NE end of Topsail Sound, nearly opposite Bishop Creek, about 100 yards from the N corner of the woods known as Topsail Bluffs, on the marsh about 2 yards from high-water mark.

The station is marked by a standard bronze disk set in concrete at the center of the top of a tile, as described in note 6c.

There are no reference marks.

BLUFF (Pender County, N.C., R.P.S., 1914; J.A.B., 1933) -- Station was recovered and was in good condition. At the SE side of Topsail Sound, about opposite Bishop Creek, about 100 yards from the N corner of the woods known as Topsail Bluff, on the marsh at about high water, and 4 yards from low water.

BEE (Pender County, N.C., R.P.S., 1911)--Station is on the marsh on the inland side of the banks, nearly opposite Virginia Creek, 3 yards from high-water mark.

The station is marked by a standard bronze disk set in concrete at the center of the top of a tile, as described in note 6c. The reference mark is a tile filled with and set in coment, it is about 20 meters (66 feet) from the station, just in the woods, 2 yards E of a blazed cedar tree.

BEE (Pender County, N.C., R., P.S., 1911; J., A.B., 1973) -- Station was recovered and was in poor condition. The top of the tile including the disk was broken off and was found lying beside the mark; this was fitted back on and a concrete mound was built around it. The station is on marshland that is covered at high water. It is on the sound side of the banks and the thick underbrush about opposite from Virginia Creek, and about 28 meters from the edge of the woods.

The reference mark was found with the top broken off leaving a tile stub.

The distance from the station to the mark is approximately 28 meters instead of 20, as stated in the description. The cedar tree mentioned in the description has blown over.

VIRGINIA (Pender County, N.C., P.P.S., 1914) -- Station is on the point of a shell rock island at the mouth of Virginia Creek.

The station is marked by a 4- by 4-inch stake driven in the ground with a copper tack for a center mark.

BUMBLE (Pender County, No.C., R.P.S., 1911).--Station is on the inland side of the banks, opposite Virginia Creek, about 150 yards from Yellow Hill Fishing Camp, on the marsh at the curve of the channel from Sloop Point to the banks, about 2 yards from ordinary high-water mark but under water at extreme high tide.

The station is marked by a standard bronze disk set in concrete at the center of the top of a tile, as described in note 60. The reference mark is a tile filled with and set in cement. It is about 30 meters (98 feet) from the station, about 150 yards from the house at the camp, and about 3 yards from high-water mark.

BUMBLE (Pender County, N.C., R.P.S., 1911; J.A.B., 1935) -- Station was recovered in good condition. At the back side of the banks, opposite Virginia Creek, on the marsh, about 150 yards from the remains of Yellow Hill Fishing Camp, and 1 yard inside high-water line. The channel from Sloop Point to the banks passes by station which is 150 yards N of bend in channel.

The reference mark is in good condition.

No. 476

UNITED STATES COAST AND GEODETIC SURVEY Descriptions of Triangulation Stations

PACTORY (Pender County, N.C., R.P.S., 1914) -- Station is about 1/2 mile SW of entrance to Vi.ginia Creek, on the first point E of the Atkinson's factory, at about high-water mark.

The station is marked by a standard bronze disk set in concrete at the center of the top of a tile, as described in note 6c. The reference mark is a vi.h filled with and set in cement. It is 10 meters (33 feet) from the station in line with the S end of the factory.

PACTORY (Pender County, N.C., R.F.S., 1914; J.A.B., 1955) -- Station was recovered in good condition.

Station is on the mainland, 1/2 mile SW of Virginia Creek, 200 yards SW of Beacon 20, in an open dredge filled place, 75 yards NW from channel, 15 yards from high-water mark, and around station there are a few bushes and some short grass. Atkinson's factory, mentioned in the description, is not apparent but there is a dwelling in that vicinity.

The reference mark is leaning over and a new distance and azimuth was taken to it. It is 16.213 meters distant from station, in azimuth 48°37'44" trus.

OAK (Pender County,N.C.,R.P.S.,J9ll)--Station is about 3 miles NE from New Topsail Inlet, on the inland side of the banks, just above high-water mark, nearly S of the E end of the first island W of EUNBLE, about 5 yards N of two blazed oak trees.

The station is marked by a standard bronze disk set in concrete at the center of the top of a tile, as described in note 6c.

There are no reference marks.

OAK (Pender County, NeC., R.P.S., 1911; J.A.E., 1957) -- Station is probably lost. Two blazed oak trees mentioned in description were found. Station is supposed to be but 5 yards from the blazed trees but no trace of it could be found.

ATKINSON (Pender County, N.C., R.P.S., 1911; 1935) -- Station is on back side of Topsail Sound, about 5 miles NE of Hampstead, about 3/4 miles SE of Virginia Creek, at Dick Jones Lending, and about 10 yards from high-water mark. To reach from Hampstead, go NE 5 miles on United States Route 17 to Woodside (Vista post office), turn onto road leading SE off main highway opposite railroad station, continue 0.65 mile to tembledown building, keep main road at dim right fork, proceed one-fourth mile, take left fork on left side of fence about 250 feet beyond large house on left, follow along fence 0.45 mile to left fork at end of field, and follow this road 0.7 mile to landing. Station, established in 1911, was marked with standard bronze disk set in concrete in the top of a tile, as described in note 6c. It was re-marked in 1932 in exactly same position with standard bronze disks set in concrete, as described in note of "Atkinson 1911-1922." Reference mark, established in 1911, is tile filled with and set in cement, on edge of woods, and 45.77 feet from station in azimuth 97°39'. It was found to be in poor condition in 1932; three reference marks, standard reference bronze disks set in concrete, as described in 1952." No.2 is 88.15 feet from station in azimuth 88°22'. No.3 is 1, meters (13 feet) W of center line of sandy road, and approximately 0.2 mile from station in azimuth 134°49'00". No.4 is 98.5 feet from station in azimuth 134°49'00".

BLAKE (Pender County, N. C., R. P. S., 1911) -- Station is on the inland side of the banks, about 2 1/4 miles NE from New Topsail inlet, on the main point about 650 yards W of the fishing camp, about 60 yards from the woods, at about high-water mark.

The station is marked by a standard bronze disk set in concrete at the center of the top of a tile, as described in note 6c.

There are no reference marks.

BLAKE (Pender County, N.C., R.P.S.1911; J.A.B., 1933) -- Station could not be found after reasonable search and is most likely lost.

ALEXANDER (Pender County, N.C., R.P.S., 1914) -- Station is located at the inland shore of Topsail Sound, about 2 1/2 miles northeasterly from New Topsail Inlet, on a point about 120 yards E of Alexander's Lending, about at high-water mark.

The station is marked by a standard bronze disk set in concrete at the center of the top of a tile, as described in note 60.

There is a blazed oak tree about 10 yards W of the station.

ALEXANDER (Pender County, N.C., R.P.S., 1914; J.A.B., 1933) -- Station was found and in good condition. Description is adequate.

NIX (Pender County, N.C., F.F.S., 1914) -- Station is about 1 1/2 miles nearly N from New Topsail Inlet, about 550 yards NW of J.E. Mixon's Landing, on the marsh about 200 yards from the woods.

The station is marked by a standard bronze disk set in concrete at the center of the top of a tile, as described in note 6c. are no reference marks.

NIX (Pender County, N.C., R.P.S., 1914; N.C., Geod. S., 1927) -- Station recovered in good condition. Description is adequate.

NIX (Pender County, N.C., R.P.S., 1911; J.A.B., 1933) -- Station was found but mark was leaning at a slight angle. It is located about 1 1/4 miles nearly N from New Topsail Inlet, in marsh about 20 meters SE of dradged cut.

PORPOISE (Pender County, N.C., F.P.S., 1911) -- Station is about 1 mile NE from New Topsail Inlet, on the benks, on a sand hill about 200 yards from Sidbery Pishing Camp, and about midway between the beach and the sound.

The station is marked by a standard bronze disk set in concrete at the center of the top of a tile, as described in note 6c.

There are no reference marks.

Bogue Inlet to Wrightsville Inlet, North Carolina.

PORPOISE (Pender County, N.C., R.P.S., 1914; K.T.A., 1926) -- Station mark has been weshed out by wind and rain action. However, parts of the three legs of the old triped were still in place so station could be tied to within a foot. Probably all trace of this station will be gone within a year.

PORPOISE (Pender County, N.C., R.P.S., 1914; J.A.B., 1933) -- Sta-tion could no be found after thorough search and is probably lost.

SAIL (Pender County, N.C., R.P.S., 1911) -- Station is on the inner shore of Topsail Sound, about 1 1/1 miles NW from New Topsail Inlet, about 1/1 mile W of Holmes Landing, 10 yards from the line of trees, at about high-water mark.

The station is marked by a standard bronze disk set in concrete at the center of the top of a tile, as described in note 6c.

There are no reference marks.

TOP (Pender County, N.C., R.P.S., 1914) -- Station is on the first high hill on the W side of New Topsail Inlet, about 5 yards from an old pump on the beach.

The station is a standard bronze disk set in concrete at the center of the top of a tile, as described in note 6c.

There are no reference marks.

TOP (Pender County, N.C., R.P.S., 1914; K.T.A., 1926) -- Station is lost. The location of the station is now underwater due to erosion of the shore line.

TOP (Pender County, N.C., R.P.S., 1914; J.A.B., 1933) -- Station could not be found after thorough search. The topography in the vicinity has changed considerably and the station is most likely

BRITT (Fender County, N.C., J.A.E., 1937) -- Station is on a prominent sand dune on the outside coast at the S side of the entrance to New Topsail Inlet. This is the highest dune in the vicinity, and station is at about the center of the highest part. Station and reference marks are standard bronze disks set in concrete at the center of the top of tile, as described in notes 6a and 15a.

Reference marks are set in an 8-inch tile projecting about 8 inches above ground.

OBJECT

OBJECT

WOW.

DISTANCE

DIRECTION

maters

DIRECTION 0° 00' 00"0 188 58 59 66 03 23 meters 12.125 38.48 WOW . R.M.No.1 R.M.No.2

POPE (Pender County, N.C., R.P.S., 1914) -- Station is located at the mouth of old Topsail Creek, about 100 yards W of Pope's Landing, at about high-water mark.

The station is marked by a standard bronze disk set in concrete at the center of the top of a tile, as described in note 6c.

The reference mark is a tile filled with and set in coment; it is about 15 meters (49 feet) from the station on a line to NIX.

NIX. There is a blazed tree just back of the station.

POPE (Pender County, N.C., R.P.S., 1914; N.C. Good.S., 1925) -- Station recovered in good condition. Description is adequate.

POPE (Pender County, N.C., R.P.S., 1914; J.A.B., 1933) --Station is about 300 yards SW of the mouth of old Topsail Creek, and 300 yards NE of an old landing 3 yards in front of a 12-inch cedar tree which is in a hedgerow of other small trees and bushes parallel to the beach. Station is 2 yards NW of high-water line. Station mark was recovered in good condition. The top of the reference mark was found broken off, was replaced and cemented

HAMPSTEAD (Pender County, N.C., C.D.M., 1932)—Station is about 19 miles by Route 17 NE of Wilmington, on grounds of Topsat1 High School which is large brick building on S side of highway, in SE corner of schoolyard, approximately 30 meters (98 feet) SE of SE corner of school building, and 6 meters (20 feet) E of E end of long metal garage. Surface, underground, and reference marks are standard bronze disks set in concrete, as described in notes 1a, 7a, and 11a. Reference mark No.1 is on S side of Route 17, 10 meters (33 feet) S of center line of road, 5 meters (10 feet) S of ditch on S side of road and approximately 1/4 mile from station in azimuth 203°24/41 s. Reference mark No.2 is just S of basketball field E of school, and 56.05 meters (185.9 feet) from station in azimuth 212°30'. Reference mark No.3 is at SW corner of school building, 0.3 meter (160t) S of S wall, 1 meter (3 feet) E of W wall, and 39.56 meters (129.8 feet) from station in azimuth 83°48'.

OLD (Pender County, N.C., R.P.S., 1911) -- Station is about 1/2 mile E of old Topsail Inlet, and about 200 yards N of an old fishing camp.

The station is marked by a standard bronze disk set in concrete at the center of the top of a tile, as described in note 6c.

There are no reference marks.

OLD (Pender County, N.C., R.P.S., 1914; K.T.A., 1926) -- Station is lost. The location of the station is now underwater due to erosion of shore line.

OLD (Pender County, N.C., R.P.S., 1914; J.A.B., 1933) -- Station could not be found after thorough search and is probably lost.

COUNCIL (Pender County, N.C., R.P.S., 1914) --Station is about 1 3/4 miles NW from old Topsail Inlet, about 150 yards E of the creek E of Long Point, 2 yards from high-water mark.

The station is marked by a standard bronze disk set in concrete at the center of the top of a tile, as described in note 6c.

(Continued on p.14)

COUNCIL (Continued)

COUNCIL (Continued)
The reference mark is a tile filled with and set in cement, about 10 meters (33 feet) E of the station in azimuth 232°52'.

COUNCIL (Pender County, N.C., R.F.S., 1911; N.C. Geod.S., 1927) -- Station recovered as described. Description is adequate.

COUNCIL (Pender County, N.C., R.P.S., 191h; J.A.B., 1933) -- Station is about 1 7/h miles WNW of old Topsail Inlet, about 300 yards NE of a creek that is N of Long Point, and about 200 yards NE of a small private pier and 2 yards inshore from high-water line.

The station and reference marks were found marked as described in good condition.

WOW (Pender County, N.C., R.P.S., 1914) -- Station is about 3/4 mile SW from old Topsail Inlet, on the ridge of the banks, just E of a point opposite the entrance to Mill Creek.

The station is marked by a standard bronze disk set in concrete at the center of the top of a tile, as described in note 6c.

There are no reference marks,

WOW (Pender County, N.C., R.P.S., 1914; N.C. Geod.S., 1925) -- Station recovered in good condition. At station WOW, COUNCIL to chimney of Hutaff Fishing Hut, 72°09' ND"; distance scales 1250 feet. Hut is about 8 by 10 feet and has a good brick chimney. Hut is located about 300 yards 8 of high-water mark of old Topsall Inlet. (Locally known as Elmore Inlet.)

WOW (Pender County, N.C., R.P.S., 1914; K.T.A., 1926) -- Station recovered as described

WOW (Fender County, N.C., R.P.S., 1911; J.A.B., 1933) -- Station was found and in good shape. It is about 3/1 mile SW from old Topsail Inlet on the ridge of the banks just E of where Mill Creek leaves the banks, about 300 yards E of cottage on sand ridge at head of Mill Creek, on highest sand bank of ridge overlooking ocean, about 200 yards from ocean and 300 yards from sound.

LONG POINT 2 (Pender County, N.C., R.P.S., 1914) -- Station is about 1 3/4 miles W from old Topsail Inlet, on Long Point, about 10 yards E of a house and 10 yards from high-water mark.

The station is marked by a standard bronze disk set in concrete at the center of the top of a tile, as described in note 60.

The reference mark located near the high-water line, is a tile filled with and set in coment, 21.2 meters (69.6 feet) from the station towards the landing. The first cak tree Nof the landing is blazed and is about 3 yards from the reference mark.

LONG POINT 2 (Pender County, N.C., R.P.S., 1914; N.C., Geod.S., 1927) -- Station recovered as described. Description is adequate. Station is on the property owned by J.S. King. Station is on the SW side of road leading to landing and about 15 feet away, also about 60 feet NW of a two-story garage. There is also a small house about SW approximately 60 feet from station.

LONG POINT 2 (Pender County, N.C., R.P.S., 1914; J.A.B., 1933) -Station recovered in good condition. The top of the reference
mark was found broken off. It was recepped and a new bronze disk
inserted. The station is 25 yards NW of high-water line near
the brush covered center of the point and 5 yards SW of an almost

the brush covered center of the point and 5 yards SW of an almost overgrown road.

The reference mark described is 14 yards NE of a large leaning and rotting oak tree and is SW of the landing at about high-water mark and 21.7 meters SE of the station mark. There is an old house at the landing 20 yards E of the station and an old shack 10 yards W of the station.

SID (Pender County, N.C., N.P.S., 1941). -- Station is on the banks, on the first sand hill E of Sidbury Inlet.

The station is marked by a standard bronze disk set in concrete at the center of the top of a tile, as described in note 6c.

There are no reference marks.

SID (Pender County, N.C., R.P.S., 1911; K.T.A., 1926) -- Station recovered. Station mark has been washed out by wind and rain action and moved several meters from old position. Station will be of no value in the future.

SID (Pender County, N.C., R.P.S., 1911; N.C. Geod. S., 1925) -- The hill this station was on has blown away, and station had fallen

SID (Pender County, N.C., R.P.S., 1911; J.A.B., 1957) -- Sidbury Inlet is no longer in existence. Traces of it remain but it has completely filled in. Station was not found and it is most likely lost as there is evidence of considerable changing of the topography in the vicinity.

BURRO (Fender County, N.C., R.F.S., 1914) -- Station is on the second point SW of Long Point, on a hill near the ruins of an old house.

second point SW of Long Point, on a hill near the ruins of an old house.

The surface mark is a standard disk set in concrete at the center of the top of a tile, as described in note 6b. Underground mark is set according to note 10d.

The reference mark is a tile filled with and set in cement near the high-water mark, about 50 meters (16h feet) from the station. There are two large blazed pine trees about 5 yards from the reference mark.

BURRO (Fender County, N.C., R.P.S., 1914; N.C., Geod.S., 1925) -- Station recovered as described. Coment and pipe broken up and scattered around. This station located in woods, and would have required quite a little outting for me to use it, so I didn't go to any trouble to locate underground station.

BURRO (Pender County, N.C., R.F.S., 1914; J.A.B., 1933) -- Station and reference marks were recovered but on both marks the tile containing the disk had been broken off flush with the concrete block in which it was embedded. The station is on a hill in the woods, about 50 meters from the shore line and in the middle of a road. Ruins of an old house mentioned in the description could not be found.

ORTON (Pender County, N.C., ..., 1953) -- Station is on the mainland, 1 1/2 miles N of Rich st, on the second point SW of Long Point, 250 yards N of Bear 5, on a shelly, open space, 75 yards from tree line and fast land, 50 yards from channel of Intracoastal Waterway, 125 yards SW of shack in woods.

Station and reference marks are standard bronze disks set in concrete at the center of the top of a tile, as described in notes 6a and 13a.

Reference mark is at edge of woods 3 yards from high-water line. Both marks are set in 8-inch tile, and project 8 inches above surface of ground.

OBJECT DISTANCE DIRECTION

OBJECT MALLORY DISTANCE 00000000 R.M.No.1 70.397 Li2 44 28
It is uncertain whether the distance measured are in meters

or feet.

Height of signal above station mark - 3 meters.

Height of telescope above station mark - 1.5 meters.

EDEN (Pender County, N.C., R.P.S., 1911) -- Station is about 1 3/4 miles a little N of W from Sidbury Inlet, on the first point E of Huggin's Landing, near the high-water line.

The station is marked by a standard bronze disk set in concrete at the center of the top of a tile, as described in note 60. The reference mark is a tile filled with and set in cement, near the high-water mark, about 8 meters (26.2 feet) E of the station

EDEN (Pender County, N.C., R.P.S., 1914; N.C., Good.S., 1927) -- Station recovered with concrete and pipe in good condition. Someone has removed bronze cap. This station is about E approximately 150 feet from a long house on top of a bluff at Huggin's Landing.

EDEN (Pender County, N.C., R.P.S., 1914; J.A.B., 1933) -- Station recovered with only one mark found, the top of the tile of which is broken off. From the description and topography this is thought to be the reference mark. The point is on the E side of an old descrted landing and is 1 1/2 miles NW of Rich Inlet.

RICH (Pender County, N.C., C.L.G., 1911) -- This station is on top of the highest hill on the extreme point to the NE of Rich Inlet.

The station is marked by a standard bronze disk set in concrete in the top of a tile, as described in note 60.

There are no reference marks.

RICH (Pender County, N.C., C.L.S., 1914; K.T.A., 1926) -- Station not recovered. Old position of station mark now underwater at high tide.

RICH (Pender County, N.C., C.L.C., 1914; J.A.B., 1933) -- Thorough search was made for this station but it was not found. The sand is loose and shifting and there has been considerable washing, and it is quite unlikely that the station will ever be found.

MALLORY (Pender County, N.C., J.A.B., 1973) -- This station is 500 yards NE of Rich Inlet, on the first group of high dunes N inlet, 200 yards from beach line, and 50 yards E of high-water line of Green Channel.

Station

Station and reference marks are standard bronze disks set in concrete at the center of the top of tile which are embedded in the ground, as described in notes 6a and 13a. Both marks are set in 6-inch tile, and project 8 inches above surface of the ground.

Reference mark is on a dune of the same height as the station mark. OBJECT

DISTANCE DIRECTION O° 00' 00"0 LONG POINT 2 LONG FOINT 2 meters 000000 Rg.M.No.1 13.650 230 32 41 Height of signal above station mark - 1 meters. Height of telescope above station mark - 1.5 meters.

BALD (New Hanover County, N.C., C.L.C., 1914) -- This station is near the inland shore of Topsail Sound, westerly from Rich Inlet, about 300 yards W from Bald Eagle Creek, 2 yards from the edge of the marsh on the S side of the channel at the point where it turn to the SE and runs almost directly out to Rich Inlet.

The station is marked by a standard bronze disk set in concrete in the top of a tile, as described in note 6c.

There are no reference marks.

BALD (New Hanover County, N.C., C.L.G., 1914; J.A.B., 1933) -- This station is lost. It was apparently out out by the dredge as it plots in the new dredged channel on the current topographic

U.S.E 100 (Pender County, N.C.,) --This is a U.S.E. Base Line Monument included in the third order scheme. Station is located at Balleagle Point.

FOEY (New Hanover County, N.C., C., L.G., 1914) -- This station is on the banks on the ocean side of Topsail Sound, about 1 1/2 miles Strom Rich Inlet, on the top of the highest hill to the S of the first woods W of the Inlet.

The station is marked by a standard bronze disk set in concrete in the top of a tile, as described in note 6c.

There are no reference marks.

FOEY (New Hanover County, N.C., C.L.G., 1914; K.T.A., 1926) -- This station not recovered, and station mark obliterated by shifting sands and storm waters.

FOEY (New Hanover County, N.C., C., L.3., 1911; J.A.B., 1933) -- Search was made for this station but it was not found. Because of the shifting nature of the sand dunes, it is probably lost.

DEALE (New Henover County, N.C., J.A.E., 1935) -- This station is 800 yards S of Rich Inlet, on the outermost of a group of sand (Continued on p.15)

No.476

UNITED STATES COAST AND GEODETIC SURVEY Descriptions of Triangulation Stations

DEALE (Continued)
dunes 200 yards back from the beach, 150 yards from the marsh,
600 yards, NE of a long group of trees paralleling the beach, and
150 yards N of a fishing shack on the beach. There are no high
dunes between station and the beach.

Station and reference marks are standard disks set in concrete at the center of the top of tile which are embedded in the
ground, as described in notes 6a and 13a. Marks are set in 8-inch
tiles and project 8 inches above the surface of the ground.

ORIGH DISTANCE DISTANCE DISTANCE ORIGH DIRECTION
ORIGH Meters feet 0°00'00'0
R.M.No.1 21:015 71.58 34 49 01
Height of signal above station mark - 1 meters.
Height of telescope above station mark - 1 1/2 meters. DEALE (Continued)

PORTER (New Honover County, N.C., C.L.G., 1914) -- This station is about 2 1/2 miles westerly from Rich Inlet, on the inland side of Topsail Sound, about 1/00 yards E from a small creek leading up into the mainland, 5 yards from the edge of the marsh on the Saide of the channel. The creek is the first along the coast, NE of Fage Creek.

The station is marked by a standard bronze disk set in concrete in the top of a tile, as described in note 6c.

There are no reference marks.

FORTER (New Hanover County, N.C., C., L.C., 1911, W.M., 1931) -- Station was not found. A short search only was made, but U.S. Engineers also have failed to find mark and it is believed to be lost. There are insufficient references to fixed objects to justify digging.

FORTER (New Hanover County, N.C., C.L.G., 1911; J.A.R., 1933) -The station was found as described in good condition. The station
is on the marsh between the new dredged cut and the old channel

CACTUS (New Hanover County, No.9, C.L.G., 1914) -- This station is about 2 1/4 miles 3W from Rich Inlet, on the first sand hill up from the beach, not more than 20 or 30 yards from high-water mark.

The station is mark by a standard bronze disk set in concrete in the top of a tile, ss described in note 6c.

There are no reference marks.

CACTUS (New Hanover County, N.C., C.L.G., 1914; K.T.A., 1926) -Not recovered. Station mark obliterated by shifting sands and

CACTUS (New Hanover County, N.C., C.L.O., 1914; J.A.B., 1953) --Station was searched for but was not found. Description was very meager, and dence covering of underbrush over sand hills makes chances of recovery very remote.

KIRKLAND (New Hanover County, N.C., C.D.M., 1932).—Station is 10 1/2 miles ENE of Wilmington, 5 1/2 miles SW of Hempstead, in NE corner of Kirkland schoolyard, 23.0 meters (76 feet) S of center line of Route 17, 13.28 meters (ht feet) E of NE corner of school building, and 13.56 meters (ht feet) E of NE corner of school building. To reach from Hampstead, go SW 5.6 miles on Houte 17 to Kirkland School on SE side of highway. Surface, underground, and reference merks are standard bronze disks set in concrete, as described in notes 1s, 7a, and 1la. Reference mark No.1 is between highway and railroad track, 9.7 meters (32 feet) N of center line of highway, 30.2 meters (99 feet) NW of NW corner of school, and 183.85 feet from station in azimuth (8011: No.2 is between high and railroad track, 11.7 meters (ht feet) S of center line of reilroad track, 21.4 meters (ht feet) N of center line of reilroad track, 12.
No.4 is on Pender-New Hanover County line, in Nr. Smith's backyard, about 100 meters (528 feet) S of highway, and approximately 0.9 mile from station in azimuth 227°16/hg's.

FLY (New Hanover County, N.C., C.L.G., 1914) -- This station is about 3 miles SW from Rich Inlet on a small hill about 100 yards from the first sand hill E of Queens Inlet, about midway between sea and sound.

The station is marked by a bronze disk set in concrete in the top of a tile, as described in note 6c.

There are no reference marks.

Bogue Inlet to Wrightsville Inlet, North Carolina.

FIY (New Hanover County, N.C., C.L.G., 1914; N.C., Geod.S., 1923) --The inlet referred to in the description of this station is locally known as Mason's Inlet. Station is in good condition.

PLY (New Hanover County, N.C., C.L.C., 1911; K.T.A., 1926) -- Station recovered as described,

PIY (New Hanover County, N.C., C.L.G., 1911, A.A.B., 1933) -- This station was recovered, and in good condition, and is about 3 miles SW from Rich Inlet, about 100 yards from first sand hill E of Queen Inlet, about 200 yards SW of peak of largest group of sand dunes in vicinity, and about midway between see and sound.

HOWE (New Hanover County, N.C., C.L.G., 1914) -- Station is about 3 1/2 miles ME from Wrightsville Inlet, on the inland side of Middle Sound, about 1 mile to the SW from Page's Creek, on a small shell point, about 3 yards from high-water mark. The shore at this point is backed by cleared land on which there are several

The station mark is a bronze disk set in a concrete block, as described in note la. The block or post being supported on a stake driven in the ground.

There are no reference marks.

HOWE (New Hanover County, N.C., C.L.G., 1914; N.C. Ceod.S., 1923) -- Station found in good condition. Description is adequate.

HOWE (New Hanover County, N.C., C.L.C., 1914; K.T.A., 1927) -- Station recovered and found in good condition. It is hyards from high-water line.

FOWE (New Ernover County, N.C., C.L.G., 1911; N.C. Geod. S., 1927) -Station in good condition. Station is on property wantd by J.K.
Cumming, and is about 200 feet NE of Corbatt's Landing. A small
branch entery sound just W of Station.

HOWE (New Hanover County, N.C., C.L.C., 1914; J.A.B., 1933) -- Station was found as described in good condition. Station is on a white shell point which covers only at extreme high-water.

Bearings to reference objects.

OBJECT

DISTANCE

AZIMITH (TRE

Descrings to reference of, OBJECT
S. gable of wharf house Large oak near beach
S. chimney nearest house
3-foot oak tree AZIMUTH (TRUE) 2146°51° 97°33 150°53 191°58 77 meters

WILLETT (New Hanover County, N.C., C.L.G., 1914) -- Station is about 3 1/4 miles NE from Wrightsville Inlet, on the summit of a small sand hill on the banks, on the E side of Queens Inlet, midway between the sea and the sound. It is on a bare sand hill of changing sand, and very probably will disappear in a short time. The station is marked with a standard bronze disk set in concrete in the top of a tile, as described in note 6c.

WILLETT (New Hanover County, N.C., C.L.G., 1914; K.T.A., 1926) -- Station is lost. The location of the station is now in the water due to erosion around the inlet.

WILLETT (New Hanover County, N.C., C., L.G., 1911; J.A.B., 1933) --This station could not be found and is probably lost. The sand dunes are of a shifting nature and the sea has been making over the beach into the sound in numerous places.

MOORE (New Hanover County, N.C., C.L.E., 1914) -- Station is about 2 1/4 miles, a little E of N from Wrightsville Inlet, on the inland side of Middle Sound on a small point of marsh on the S side of the channel opposite the NE entrance to Moore's Creek, about 2 yards from the water, at ordinary tides but covered at extreme high water, on the point formed by Moore's Creek and the Sound. There is a 2-story dwelling about NNW from the station. The station mark is a standard bronze disk set in a concrete block, as described in note la. The block is supported on a stak driven in the ground. There are no reference marks.

MOORE (New Hanover County, N.C., S.L.C., 191h; N.C., decd.S., 1923) -This station was under water when I occupied it, and could not
examine it carefully, but do not think it will last very long as
the marsh seems to be ending at this point.
The two-story house mentioned in the description has been
destroyed by fire.

MOORE (New Hanover County, N.C., C.L.C., 1911; K.T.A., 1927) -- Station was not recovered. It is probably covered with marsh grass, and could not be found after a reasonable search.

MOORE (New Hanover County, N.C., C.L.G., 1914; N.C. Geod.S., 1927) -Station is rather shaky. Have not seen this station on low water,
but feel as if it is in fair condition for ordinary work. Station
is 850° E magnetic 287 feet (Stadia) from a concrete monument,
marked "B", located near high-water mark on Howes Point. Concrete
monument is R.A. Brand's, 8% corner, and is about S, approximately
250 feet from his residence. The creek referred to as Moore Creek
is known locally as Barren Inlet Creek.

MOORE (New Hanover County, N.C., C.L.C., 1911; J.A.B., 1933) -- Station was recovered in good condition. The station is on marshland which covers at high-water, and is between the old charmel and the new dredged channel. The steep point of fast land at the intersection of the old channel and the NW bank of Moore's Creek is about opposite the station acress the old channel.

SHY (New Hanover County, N.C., Q. L.C., 1914) -- Station is about 2 miles NE from Wrightsvillo Inlet on the banks, on the first small sand hill W of the channel so the W of Queens Inlet, about 200 yards from the water.

The station is a standard bronza disk set in concrete in the top of a tile, as described in note 6c.

(Continued on p.16)

SHY (Continued)
There are no reference marks.
The sand here is changeable, and the station may not last

SHY (New Hanover County, N.C., C.L.G., 1914; K.T.A., 1926) -- Station not recovered. Station mark probably covered by shifting

SHY (New Hanover County, N. 2., C. L. G., 1911; J. A. B., 1933) -- This station has evidently been washed out as no traces of it could be found. The sand dunes in the vicinity have been leveled by the sea making in over the beach to the sound.

LOW (New Hanover County, J.A.B., 1973) -- This station is about 2 miles NE from Wrightsville in a region where the sand dunes have been washed away. Station is on a low sand hill but the only one of any extent in the vicinity, and about 100 yards N of the southern extremity of the arm of a creek that extends directly across the marsh from the canal to sand beach, and then turns N to Queen Inlet.

Station is about 100 feet from Ocean high water and 150 feet from Sound high water.

Station and reference marks are standard bronze disks set in concrete in the top of tiles which are each surrounded by a mass

DISTANCE

MOORE R.M.

meters 22.1,03

DIRECTION 0° 00'00.0 30 59 50

NEW KIRK (New Hanover County, N.C., C.L.G., 1911; 1918) --Station is on the inland side of Middle Sound about 1 1/2 miles a little W of N from Wrightsville Inlet, on a small shelly point at New Kirk Landing, about 15 yards from the road leading to Wrightsville, 5 yards from high-water mark. Several small boats are usually anchored at this landing.

The station and reference marks are standard bronze disks set in concrete blocks as described in notes la and lla. The blocks being supported on stakes driven in the ground.

The reference mark is 25.770 meters (Sh.55 feet) from the station in azimuth, 215 36'.

The water tank on the island N of Wrightsville Beach is in azimuth 1°49' from the station.

NEW KIRK (New Hanover County, N.C., C.L.G., 1914; N.C.Geod.S., 1927)--Station is on property (winter estate) of Mrs. Harry Walters. Water tank on island N of Wrightsville Beach has been destroyed by fire.
Station and reference mark in good condition.

NEW KIRK (New Hanover County, N.C., C.L.C., 1914; K.T.A., 1927)--Station recovered and found in good condition. Station is 18 feet N, 48 feet W, and 60 feet S of the high-water line.

NEW KIRK (New Hanover County C.L.G., 1911; J.A.B., 1933)--Station was recovered in good condition. It is on the mainland, 1 1/2 miles NW from Wrightsville Inlet, on a small shelly point at New Kirk Landing, about 15 yards from the road leading to Wrightsville, 2 yards from high-water merk, 30 yards from edge of marsh grass near back of bight on range with VILLE, and 500 yards N of Beacon "11."

A reference mark was placed on range with a spire on Wrightsville Beach. Mark is set in square block of concrete, projecting 6 inches above surface of the ground.

Distance to Reference mark is 7.185 meters, azimuth to Reference mark is 171,057:54" true.

WRIGHT (New Hanover County, N.C., C., L.G., 1911;1918) -- Station is 1 mile NE from Wrightsville Inlet on the banks, on the third grassy point E of the Inlet which runs out into the sound about normal to the banks. It is about 22 yards from the N end of the

normal to the banks. It is about 22 yards from the N end of the point.

The station mark is a standard bronze disk set in a concrete block as described in note la. The block being supported on a stake driven in the ground. Three 1- by 2-inoh stakes were driven in the ground forming a triangle about the station.

The reference mark is a standard bronze disk set in concrete as described in note llo. It is 20.115 meters (65.99 feet) from the station in azimuth 96°16'.

WRIGHT (New Hanover County, N. C., C. L. C., 191h; K. T. A., 1926) -Station recovered as described with the following corrections:
Station is now about 1/3 mile N of Wrightsville Inlet and
85 meters W of the sand dunes that form high-water mark to the E.

WRIGHT (New Hanover County, N.C., C.L.G., 1911; J.A.B., 1933) -Station and reference marks were both found out of place. Both
had been overturned, apparently by sea action, and station mark
was broken off about six inches from the top. This station can
no longer be used.

DUNE (New Hanover County, N.C., J.A.B., 1935) -- Station is on sand ridge about 150 yards NE of Wrightsville Inlet, about 150 yards from ocean high water. About 200 yards from small creek on sound side, and near northern limit of wreskage of old boardwalk

on sound side, and hear northern limit of wreskage of old sounds and houses.

Station and reference marks are standard disks set in concrete at the center of the top of tile which are embedded in the ground.

OBJECT

DISTANCE WRIGHTSVILLE (NW) BASE R.M. (Inclined) meters 26.632

DIRECTION 0° 00' 00" 0 35 48 50.0

WHITHHAM VILLE (New Hanover County, N.C., C., L.G., 1916) -- Station is on the inland side of Middle Sound about 1 1/4 miles NW of from Wrightsville Inlet, on a point of the mainland, 1 mile NE of wrightsville, on the property of Pembroke Jones, 10 yards from the edge of bushes at high-water mark.

The station and reference marks are standard bronze disks set in concrete, as described in notes la and 11a. ***

The underground mark is a blook of concrete containing a glass bottle with the neck projecting a little above the concrete. The reference mark is about 9 yards E of an oak stump, 13.55 meters (lik.in feet) from the station in azimuth 52°28'.

VILLE (New Hanover County, N.C., C.L.G., 1918; K.T.A., 1927) -- Station recovered and found in good condition. Both the station and reference marks were in good condition and do not seem to have been disturbed, however the distance to the 'ference mark was found to be 15.18 meters. The station is on high-water line.

VILLE (New Hanover County, N.C., C., L.C., 1916; N.C.Geod.S., 1927) -- Station in good condition. Description is adequate.

VILLE (New Hanover County, N.C., C.L.G., 1918; J.A.B., 1953) -Station recovered as described. Station is 2 yards inside highwater mark, and ground has eroded slightly away from tile.

It is on the mainland, 1 1/4 miles NE of Wrightsville, 1 mile
NW of Wrightsville Inlet, on a point 150 yards, WNW, and directly
across channel from Beacon "lil". Reference mark is in good condition.

WRIGHTSVILLE SOUTHEAST BASE (New Hanover County, N.C., C.L.G., 1918) -- Station is on the ocean side of Middle Sound, about 1/2 mile SW from Wrightsville Inlet, 150 yards W of Oceanic Hotel, 6 3/h rails W of the trolly station, 2 1/4 rails from the Eend of a trestle, and 4.56 meters (11.3 feet) S of the S rail of the electric car line.

The station and reference marks are standard bronze disks set in concrete, as described in notes la and 11a.

The underground mark is a block of concrete containing a glass bottle with the neck projecting a little above the concrete.

The reference mark is 25.995 meters (85.29 feet) from the station in azimuth 26°49'.

WRIGHTSVILLE SOUTHEAST BASE (New Hanover County, N.C., C.L.G., 1918; N.C., Geod. S., 1927) -- Surface station was found in bad condition, and was reset by means of plumb bob from underground mark. Station should be used with caution.

WRIGHTSVILLE SOUTHEAST BASE (New Hanover County, N.C., C.L.G., . 1918; K.T.A., 1926) -- Station recovered as described.

WRIGHTSVILLE SOUTHEAST BASE (New Hanover County, N.C.,C.L.G.,1918; N.C.,Geod.S.,1928).—Station WRIGHTSVILLE NORTHEAST BASE not now visible from WRIGHTSVILLE SOUTHEAST BASE due to the erection of an amusement booth called "The Strand", on the extreme sound shore of Wrightsville Beach, sometime between September 1927 and June 1928. WRIGHTSVILLE SOUTHEAST BASE was found disturbed by a coastal field party of The North Carolina Department of Conservation and Development in September 1927 and was reset approximately from the underground mark by plumb line.

WRIGHTSVILLE SOUTHEAST BASE (New Hanover County, N.C., C.L.G., 1918; J.A.B., 1935).—Station and reference marks were recovered, and in good condition. Station is on the sound side of Wrightsville Beach, about 150 yards W of the Oceanic Hotel, about 150 feet W of trolley station, about 100 feet B of E end of trolley trestle, and 14 feet S of the S rail of the trolley track. The azimuth given to the reference mark is given from the N instead of the S. This station is now under a boardwalk, and is shut in by buildings. There is also a telephone line directly over it.

WRIGHTSVILLE SOUTHEAST BASE (New Hanover County, N.C., C.L.G. 1918; N.C., Highway Dept., 1937) -- From a letter from Mr. C.P. Freema Resident Engineer, State Highway and Public Works Commission, Wrightsville Sound, North Caroline, atated April 9, 1937.

Due to highway construction along the Banks Channel, at Wrightsville Beach, it was necessary to destroy the station. Station and reference marks, stamped "S.E. BASE, 1918" received May 10, 1937.

WRIGHTSVILLE NORTHWEST BASE (New Hanover County, N.C., C.L., Q., 1918;1975)—Station is in Wrightsville, 3.5 meters (12 feet) E of Tidewater Power Company station, L, yards from side rail of car track, and 8 yards from edge of water. Surface, underground, and reference marks are standard bronze disks set in concrete, as described in notes la, 7a, and lla. Reference mark is at the NE side of paved road, 18 yards from high water, and 25;130 meters (82.15 feet) from station in azimuth 71,00; In 1927, reference mark was under corner of filling station. Station mark is so close to railroad track that signal could not be built over it; and station WRIGHTSVILLE NORTHWEST BASE ECCENTRIC was established in 1932, 174.559 meters (572.70 feet) from station in azimuth 117 36:21".

WRIGHTSVILLE NORTHWEST BASE ECCENTRIC (New Hanover County, N.C., C.D.M., 1932;1953) -- Station is in Wrightsville, on vacant lot, about 200 yards NW of post office, approximately 60 meters (197 feet) SW of paved road, if meters (1bf feet) SW of SW rail of car line, and 17 meters (56 feet) NW of NW eide of red house. Surface, underground, and reference marks are standard bronze disks set in concrete, as described in notes la, 7a, and lla. Reference mark No.1 is 9 meters (30 feet) N of center line of paved road, 8 meters (26 feet) W of 21-inch cedar, and approximately 1/h mile from station in azimuth 237°0; | 11 meter (3 feet) SW of cinder road past house, 0.6 meter (2 feet) N of N corner of yard of red house, and 39,87 meters (150.8 feet) from station in azimuth 210.8 is Nw of W corner of yard of red house, approximately 1/n meters (56 feet) wof W corner of red house, 35.1 meters (115.5 feet) from station in azimuth 21°35'. Station WRIGHTSVILLE NORTHWEST BASE is 174.559 meters (572.70 feet) from station in azimuth 297°36'18".

PILGRIM (New Hanovor County, N.O., O., D., M., 1932;1933) -- Station is 7/10 mile W of Wrightsville post office, on N side of asphalt road paralleling oar tracks, on grounds of St. Pilgrim's Rest colored church which is most westerly of two churches in this vicinity. Station in pine tree area in churchyard, 19±17 meters (64 feet) E of SW corner of church, 12.03 meters (40 feet) S of SE corner of main part of church building, and 57.9 meters (190 feet) (Continued on p.17)

UNITED STATES COAST AND GEODETIC SURVEY Descriptions of Triangulation Stations

(LORIM (Continued)
(E of center line of asphalt road at point opposite row of mail
pass. Surface, underground, and reference marks are standard
bronze disks set in concrete, as described in Notes 1s, 7a, and
lla. Reference mark No. 1 is 2.1 meters (7 feet) NE of center
line of easterly of two lines of tracks, 5.5 meters (18 feet)
SW of center line of paved road, 14.8 meters (49 feet) N of
electric pole on S side of tracks having sign "Macumber Station,"
and 241.7 feet from station in azimuth 323°59'. No. 2 is 18.8
meters (62 feet) WSW of NW corner of main part of church, 2.5
meters (68 feet) E of woven-wire fence, and 131.0 feet from station
in azimuth 64°05'. No. 3 is on N side of triangular plot of
ground, about 8 meters (25 feet) S of center line of private road
belonging to Mrs. Harry Maters, 1 foot N of wire fence, and approximately 1/4 mile from station in azimuth 128°40'14".

U.S.E. BASE LINE MARKS (Fender and New Hanover Counties, N.C., J.A.B., 1935) -- The following U.S.E. base line marks along the Intracastal Waterway between New River Inlet, and Cape Fear River were located by triangulation:

3-3-151	3-(4-5)	3-(9-10)	4-(3-4)
3-3-182	3-5-25	3-(10-11)	4-(2-3)
3-3-216+	3-5-43	3-11-147	4-(1-2)
3-3-247+	3-(5-6)	3-(11-12)	4-1-110
3-(3-4)	3-(6-7)	3-(12-13)	4-1-(3+64)
3-4-8+	3-(7-8)	3-(13-14)	
2 4 740.	2 (0 0)	4-14-51	

No. 476 Supplement

UNITED STATES COAST AND GEODETIC SURVEY Descriptions of Triangulation Stations

Bogue Inlet to Wrightsville Inlet, North Carolina.

The following description and recovery notes have been re-ceived since this pamphlet was lithographed. They are arranged in order along the arc with page reference of previous descrip-

SWAN POINT 2 (Onslow County, N.C., W.C.H., 1888 and 1914) -- At the W side of the mouth of New River, on Swan Point, about 1 foot from the edge of a shell bank and just about in front or SE of a small live oak and a larger oak stands on the flat below the bluff in line with "GRASSY." It is on land of Capt. John Hill. (Marked in 1914.)

Station is a standard disk set in concrete at the center of the top of a tile embedded on the ground.

CAMP DAVIS, TANK 1 (Onelow County, N.C., H.C.A., 1943) -- The station is the most southwesterly of the four large elevated tanks in Camp Davis. The point observed upon is the center of the ball on the top of the tank. This is an intersection station.

CAMP DAVIS, TANK 2 (Onslow County, N.C., H.C.A., 1943) -- The station is the most southwesterly, except one, of the four large elevated tanks in Camp Davis. The point observed upon is the center of the ball on the top of the tank. This is an intersection station.

CAMP DAVIS, TANK 3 (Onslow County, N.C., H.C.A., 1943) -- The station is the most northeasterly, except one, of the four large elevated tanks in Camp Davis. The point observed upon is the center of the ball on top of the tank. This is an intersection

CAMP DAVIS, TANK 4 (Onslow County, N.C., H.C.A., 1943) -- The station is the most northeasterly of the four large elevated tanks in Camp Davis. The point observed upon is the center of the bell on the top of the tank. This is an intersection station.

EEACON 71 (Pender County, N.C., H.C.A., 1943) -- The station is the lighted beacon on the Inland Waterway about 300 yards SW of the bridges at Sears Landing. The beacon is a standard Inland Waterway beacon bearing the number 71. This is an intersection station.

Bogue Inlet to Wrightsville Inlet, North Carolina.

BEACON 12 (Fender County, N.C. 1933, H.C.A., 1943) -- The beacon has been removed. A new lighted beacon has been installed a short distance away and bears the number 71.

BEACON 72 (Pender County, N.C., H.C.A., 1943) -- The station is the first unlighted beacon SW of the bridge at Sears Landing. The beacon is a standard channel marker with a red triangle bearing the number 72. This is an intersection station.

T 678- 5

BANKS (Previous description is on page 12.)

(U.S.E., 1942) -- Station in danger of destruction from wind ion. Reference mark in good condition.

(Camp Davis, 1945) -- Letter of Capt. Charles E. Swing, Anti-aircraft Record Section, Antiaircraft Artillery School, Camp Davis, North Carolina, dated 4/12/45:

"There has been considerable erosion and shifting of sand on the dune where the station is located. Very recently the station was found in very poor condition with all the supporting sand washed away. The concrete-filled tile had shifted womewhat from its original location. The station was relocated from the reference mark, which is in fairly good condition, and a box was built and then filled with sand to retain the tile in place.

FACTORY (Previous description is on page 13.)

(U.S.E., 1941) -- Monument was found on surface of ground, in vicinity of described location.

ALEXANDER (Previous description is on page 13.)

(U.S.E., 1941) -- Monument was found on surface of ground, in vicinity of described location.

POPE (Previous description is on page 13.)

(U.S.E., 1941) -- Recovered as described.

LONGPOINT 2 (Previous description is on page 14.)

(U.S.E., 1941) -- Recovered as described.

ORTON (Previous description is on page 14.)

(U.S.E., 1941) -- Recovered as described.

HIGH (Previous description is on page 12.)

(U.S.E., 1942) -- Top portion of tile and station marker destroyed.
Reference mark in good condition.

MIK (Previous description is on page 12.)

(U.S.E., 1942) -- Station and reference marks in good condition.

GANAT (Previous description is on page 12.)

(U.S.E., 1942) -- Station destroyed by erosion.

SEARS (Pender County, N.C., H.C.A., 1943) -- The station is on the SW side of Sears Landing Road, about 75 yards NW of the NW end of the bridge at Sears Landing, about 25 yards NW of the high-water line, 12 yards NW of a wooden fence, and 10 yards SW of the center line of the road. It projects about 3 inches and is stamped "SEARS 1943".

1943".

Station and reference marks are standard disks set in concrete at the center of the tops of tiles embedded in the ground.

Underground mark is a standard disk set in concrete.

Reference marks are stamped "SEARS NO. 1 1943" and "SEARS

NO. 2 1943. OB TROT

DISTANCE DIRECTION BECK 1914 feet 34.12 meters 10.40 0°00 100"0 257 25 25 257 25 44.3 350 50 51 SEARS LANDING TANK 18.93 5.77

SEARS LANDING TANK (Pender County, N.C., H.C.A., 1943) -- The station is the center of the orange and black water tank on the military reservation on the island directly opposite Sears Landing. The tank is NW of the intersection of the Sears Landing Road and the road on the island.

The tank is an elevated steel tank supported by a skeleton steel structure. It is about 50 feet high. This is an intersection station.

BECK (Previous description is on page 12.)

(U.S.E., 1942) -- Station in good condition.

(H.C.A., 1943)--The original description is accurate, but its adequacy is debatable.

The station is about 4-1/2 miles S of Camp Davis and 1-1/2 mile
W of Sears Landing, and it is located on the second point of marsh
S of the mouth of Bishop Creek, about 100 yards NE of a small hum-

BRCK (continued) BEOLA (continued) mock of oaks, and about 2 yards from the high-water mark. The station mark is described by Note 6c. There are no reference

marks.
To reach from Camp Davis railroad station (old Holly Ridge station), go SW 1.3 miles to triangulation station Pender on the right side of the highway, thence continue SW on U.S. Route 17 for 2.0 miles to a T-intersection and turn left onto a graded earth road, thence SR 0.8 mile to a T-intersection and continue straight ahead on the main road, thence 0.4 mile and continue about straight shead on poor road, thence mander generally SR on the main trail road about 1.2 miles to a small creek which is the end of truck travel in any but very dry weather. Continue along the trail road about 100 yards and bear right across field and marsh about 200 yards to the station.

BLUFF (Previous description is on page 12.)

(U.S.E., 1942) -- Station in fair condition. Action of water is loosening station.

(H.C.A., 1943) -- The original description is adequate and accu-. The beach is eroding and the station may be lest in a few

The station is about 1-1/2 miles SSW of Sears Landing, in the high-water line on the SE side of Topsail Sound, about opposite Bishop Creek, and about 100 yards N of the N corner of a woods known as Topsail Bluff. The station is a standard disk set in the center of the top of a tile embedded in the ground. There are no reference marks.

To reach from the bridge at Sears Landing, go SE 0.4 mile and turn right, thence on the only road SW 1.4 miles. Walk HW across dunes, woods, and marsh to the water edge 100 yards N of the above-named woods and the station.

BEE (Previous description is on page 12.)

(H.C.A., 1943) -- The station was recovered as described in the recovery note of J.A.B., in 1933. The beach is eroding and the station may be lost in a few years.

The station is about 2 miles SSW of Sears Landing, on the SE side of Topsail Sound, and about opposite the mouth of Virgina Creek. The station, as repaired in 1933, is a bronze disk set in the center of the top of a tile embedded in the

To reach from the bridge at Sears Landing, go SE 0.4 mile and turn right, thence on the only road SW 2.1 miles to a dim trail road on the right. From the beginning of the dim trail road, go straight into the woods NW about 150 yards to the water edge and the station.

'GANAT (Pender County, North Carolina, R.P.S.1914; K.B.1943)
(Previous description on page 12.) Letter of Mr. K. Bryan,
Holly Ridge, N. C., dated Oct. 22, 1943;
About eight miles northeast of Topsail Inlet, N.C. Removed
by Armed Forces in installing defense measures and is lying at foot
of dune from which it was removed.

NIX (Pender County, North Carolina, R.P.S., 1914; K.B. 1943)
(Previous description on page 15.) Letter of Mr. K. Bryan, Holly
Ridge, North Carolina, dated Oct. 22, 1943;
Near Topsail Inlet, N.C. and is just as reported in published
data, except that back-wash from passing craft in the Inland Waterway
has eroded the bank, and threatens to destroy this station within a
few years. Station leaning northeastward in the general direction of
the Inland Waterway. No name stamped on mark.

SAIL (Pender County, North Carolina, R.P.S., 1914; K.B. 1943) (Previous description on page 13.) Letter of Mr. K. Bryan, Holly Ridge, N.C., dated Oct. 22, 1943;
Near Topasil Inlet, N.C., as reported in published data. Leaning northeastward in the general direction of the Inland Waterway. No name stamped on mark.

BOGUE INLET, COAST GUARD, FLAGFOLE (Carteret County, N.C., K.T.A., 1927; R.J.S., 1946) (Previous description is on page 1)--Station recovered in good condition, as described except for the following additional change:

The Swansboro Lifeboat Station, a group of four buildings, was built in 1941 just north of the station. Coast Guard personnel claim the flagpole is the same as the one used as a attion in 1927.

FULLARD (Onslow County, N.C., R.P.S., 1914) -- It is a high pole erected in the woods near Fullard Greek. It was not marked or

UNITED STATES COAST AND GEODETIC SURVEY Descriptions of Triangulation Stations

Bogue Inlet to Wrightsville Inlet, North Carolina

CITE D. 10 RECOVERY NOTE, TRIANGULATION STATION 2209 R (U.S.E) STATE: North Carolina County: Onslow NAME OF STATION: SWAN POINT YEAR: 1914 LOCALITY: Snead's Ferry YEAR: 1947 10 Part. 192 p. 171 R.P.S. C.R. Reed 15.0.7.55 RECOVERED BY:0

Detailed statement as to the fitness of the original description:

See p. 10

The station was recovered as described and the mark was found to be in good condition. A complete new description follows:

The station is located on Swan's Point on the west sade of New River. It extends about 10 feet into the inland waterway. The mark is about 24 inches square and the disk is

MAN PT. ECC. 1932 is 200.211 meters from the station in Azimuth 116° 33' 49. To reach the station from the Post Office at Snead's Ferry, go east on the black top highway for 1.45 miles just past end of black top, turn right and go 0.8 mile, following main track road, to the water's edge and the station as described.

476 p.10 2210 R RECOVERY NOTE, TRIANGULATION STATION

NAME OF STATION: SWAN PT. ECC. STATE: North Carolina COUNTY: Onslow
RETAINING BY: C.D.M. YEAR: 1932 LOCALITY: Snead's Forry Ap. Pack. 1827.171 BD BY: C.D.M.

Recovered as: C.R.REED YEAR: 1947

Detailed statement as to the Stones of the original description: See p. 10

The Station was recovered as described and all marks were found to be in good condition except the Azimuth Mark which had been destroyed. A complete new description follows:

The station is located on Swan's Point on the west side of New River. The mark is in the woods about 200 yards west of Triangulation station SWANFOLNT 1914 and 60 feet north-east of a track road leading to Swan's Point. The mark is shout 12 inches below the surface of the ground and the disk is stamped SWAN PT. ECC. 1932.

Reference Mark No. 1 is 101.07 feet north of the station, in the woods. The mark projects about 10 inches and the disk is stamped SWAN PT. ECC. No 1 1932.

Reference Mark No. 2 is 103.28 feet east of the station on line with SWAN POINT 1914.

The mark projects shout 10 inches and the disk is stamped SWAN PT. ECC. No 2 1932.

SHAN POINT 1914 was used as an Asimuth Mark. It is 200 yards east of the station and extends about 10 feet into the water. The mark is about 24 inches source and the disk is untamped.

unstamped.

To reach the station from the Post Office at Snead's Ferry, so east on black top for 45 miles (just past end of black top) turn right and so 1.65 miles on track road. Here about 150 feet northeast in woods on left to the station near some blazed trees.

Direction 213 25 20.1 Objects V.G.

Discontinued Nine

Reference Mark No. 1

SWAN POINT 1914.

Reference Mark Newses Distance meters 30.806 200.211 card 1 of 2
DESCRIPTION OF TRIANGULATION STATION 2334

DEPARTMENT OF COMMERCE U. S. COAST AND GEODETIC SURVEY FORD. 525 Rev. Oct., 1933 North Carolina County: Onslow 1947 Locality: Holly Ridge ME OF STATION: TOWER NINE YEAR: CHIEF OF PARTY: C.R. Reed Surface-station mark, Note,* TANCES AND DIRECTIONS TO REFERENCE MARKS AND PR Underground-station mark, Note.* 00.0 ob Note,* TOWER EIGHT meters VIEW 1932 RANGE THREE 10 31 30.9 104.934 RANGE THREE 104.934 33 35 Reference Mark No. 1 4.814 265 36 Note. 38

Witness mark, Note, Note, RANCE THREE RANCE THREE LIGHT 18 15 54. Height of leiscope shows station mark 1 meters. Reference Mark No. 1 4.814 265 36 38 Height of leiscope shows station mark 1 meters. Detailed description: The station is located at the northeast end of Topsail Island about 15 miles northeast of Holly Ridge. The disk is in a drill hole near the north corner of a 25 foot square concrete platform. It is 11.9 feet south of the north corner, 9.0 feet southeast of the northwest side of the objection. The disk is stamped TOMER NINE 1947.

CLEK IS STEMPORT TUNEX NAME 1744. Reference Mark No. 1 is 15.80 feet southeast of the station and 7.5 feet west of teast corner of the platform. The disk is in a drill hole and is stamped TOWER NINE RM NO 1 1947.

A traverse connection was made to RANGE THREE and the distance was found to b

Refers to pages 108 and 109, Special Publication No. 120, or to pages 112 and 113, Special Publication No. 145.

the station as described.

Line Mark to TOWER EIGHT is 17.00 feet southwest of the station in the direction of TOWER EIGHT. The disk is in a mrill hole in the concrete platform and is stamped

An elevation has been determined.

Nove.—The initial direction must be to main scheme station.

DESCRIPTION OF TRIANGULATION STATION 2318 COUNTY: Onslow RANGE THREE STATE: North Carolina YEAR: 1947 LOCALITY: Holly Ridge DISTANCES AND DIRECTIONS TO REFERENCE MARKS AND PR CAN BE SEEN FROM THE GROUND C.R. Reed Underground-station mark, Note.* Note.* Reference mark, Note.* This is a traverse station

Height of light above station mark meters. Height of telescope above station mark meters. Betalled description: The station is located on the northeast end of Topsail Island about 15 miles northeast of Holly Ridge. It is 165 feet north west of the road, 10 feet south of the east leg and 10 feet east of the south leg of a 50 foot wooden observation and range tower. The mark conjects about 2 inches and the disk, a standard traverse disk, is stamped RANGE THREE 1947.

A traverse connection was made to Triangulation station TOWER NINE which is 104.934

Described by ...

meters to the east of the station bridge at Sears Landing, so southeast on the black top road toward the beach for 0.5 mile to a Trong, po southeast on the black top road toward the beach for 0.5 mile to a Trong, turn left and go 13.1 miles to a wooden range tower on the left and the station as described.

An elevation has been determined. LET tion must be to main scheme station.

Marked by _____MWW Refers to pages 108 and 108, Special Publication No. 120, or to pages 113 and 113, Special Publication No. 145.
† To nearest mater only, when no trigonometric leveline is balance.

4760.13 NAME OF STATION VIEW YEAR: 1932 LOCALITY HOLLY Ridge C.R. Reed YEAR: 1947 See p. 10 to the Stness of the original description: A Station was recovered as described and all OVERED BY:

Detailed statement as to the fitness of the original description: A Station was recovered as described and all marks were recovered in good condition. A complete new description follows: The station is located 13.1 miles northeast of Sears Landing and about 1½ miles southwest of New River inlet. It is 125 yards northwest of the road. The mark projects about 6" and the disk is unstamped. nt as to the fitness of the original descrip

about 6" and the disk is unstrammied,
Reference Mark No. 1 is 110.0 feet northeast of the station. The mark is in a 6"
tile which projects about 4". The disk is unstamped.
Reference Mark No. 2 is 109.4 feet south of the station. The mark is in a 6" tile
which projects about 2". The disk is unstamped,
To reach the station from the bridge at Sears Landing, so southeast toward the ocean
for 0.5mile, turn left and so 13.1 miles. The station is 125 yards northwest of the road
at this point as described.

Objects V.G. distance TOWER NINE 0 00 00.0 00 55 41.6 165 46 01.6 117 57 08.2 Reference Mark No. 1 meters 33.52 165 Reference Mark No. 2 33.36 An elevation has been determined.

*Name of to..... of party should be inserted here. The officer who actually visited the station should sign his name at the end of the reNOTE.—One of these forms must be used for every station recovered.

(Previous description is on page 10)

FISH (Onslow County, N.C., C.D.M., 1932:1942) -- Letter of Mr. B.E. Beavin, Chief of Surveys, Carr & J.E. Greiner Co., Marine Barracks, New River, N.C., dated Sept. 24, 1942:

"Station was recovered in good condition."

(176p 18

2200 R STATE: North Carolina County: Onslow YEAR: 1932 LOCALITY: Holly Ridge Sp. Part. 192 p305 A.P.R. C.R. Reed YEAR: 1947 RECOVERED BY: 5.1. p. 13A

Detailed statement as to the finess of the original description. See p. 10

The station was recovered as described and found to be in good condition. The reference mark is in poor condition due to construction of a road on the island and will probably soon be destroyed. A complete new description

The station is located about 12 miles northeast of Sears Landing near the northeast The station is located about 12 miles northeast or Dears Landing near the northeast end of Topsail Island. It is 75 feet northwest of the road which runs the length of the island. The mark projects about 5" and the disk is stamped FISM 1932.

To reach the station from Sears Landing, so southeast toward the ocean for 0.5 mile, turn left and go 11.8 miles to the station on the left as described.

An elevation has been determined.

BOTT OF COMMERCE RECOVERY NOTE, TRIANGULATION STATION TOTAL BOTTON U760.10 NAME OF STATION: LOG-

2205 R GA700592

ck

State: North Carolina Locality Holly Ridge ESTABLISHED BY: R.S.P.
RECOVERED BY: C.R. Reed YEAR: 1914 YEAR: 1947 B. P. p.515 Detailed statement as to the fitness of the original description: See p. 10

The station was recovered as described, but R.M. 2

was found to be in poor condition due to construction of a road near the station. R.M was recovered and found to be in good condition. R.M 1 is believed to be destroyed. A new station LOG 2 was established 5.556 meters east of the station. A complete new Station is located 10.0 miles northeast of Sears Landing at the top of a cut on the right side of the road. The disk is anstamped and is in the top of a 6" tile which projects about 10 inches. description follows:

jects about 10 inches.

To reach the station from Sears Landing, go 0.5 mile toward the ocean to a T-road, turn left and go 10.0 miles to a deep cut and the station as described.

Reference Mark No. 2 is 50.7% meters west of the station on the west side of the road. The disk is in a 6' tile and is stamped LOG 2.

No observations could be taken from this station due to the eroded condition of the

A traverse connection was made to TOWER EIGHT, the distance found to be 671.858meters An elevation has been determined.

* Name of chief of party should be inserted here. The officer who actually visited the station should sign his name at the end of the should be inserted here. Nove.—One of these forms must be used for every station recovered.

DEPARTMENT OF COMMERCE U, S. COAST AND GEODETIC SURVEY FORTO 525 Bay. Oct., 1922 DESCRIPTION OF TRIANGULATION STATION STATE: North Carolina LOG 2 COUNTY Onslow NAME OF STATION: YEAR: 1947 LOCALITY: HOLLY RIDGE
DISTANCES AND DIRECTIONS TO REFERENCE MARKS AND PR
CAN BE SEEN FROM THE GROUND CHIEF OF PARTY: C.R. Reed Note,* Surface-station mark. la Note.* Note,* 7a DISTANCE Reference mark, No. 3 Reference mark, No. 2 Note,* 13a 0 00 00 TOWER RIGHT meters Reference Mark No. 2 LOG 1914 Note. 50.902 47 15 39 81 53 52.

Wines mark, Mote, Mote,

tile and is stamped LOG 2.

tile and is stamped LOG 2.

Reference Mark No. 3 is 57.55 feet south of the station and 60 feet southeast of the road. The mark projects about 4° and the disk is stamped LOG TWO NO 3 1947.

To reach the station from Sears Landing, go 0.5 mile toward the ocean to a T-road, turn left and go 10,0 miles to a deep cuttand the station on the right as described.

An Slavetton hearbeen determined.

Marked by Wi

* Refers to pages 108 and 109, Special Publication No. 130, or to pages 112 and 113, Special Publication No. 145.

E OF STATION: TOWER EIGHT CHIEF OF PARTY: C.R. Reed urface-station mark. Note. Note,* Note.* Note.* Height of light above station mark 1 meters. STATE: North Carolina County: Onsl.
YEAR: 1947 LOCALITY: Holly Ridge
DISTANCES AND DIRECTIONS TO REFERENCE MARKS AND PRO-COUNTY: Onslow INENT OBJECTS WHICH 179 44 54.0 314 54 01 TOWER SEVEN

6.565 Reference Mark No. 1

Height of light above station mark 1 meters. Height of telescope above the station is located about 4 miles southeast of the northeast end of Topsail Island, along the seaward side. The disk is in a drill hole in the the roof of a concrete observing tower which is about 30 feet tell. It is 4,0 feet south of the northeorer, 2,9 feet southeast of the northwest side and 3,0 feet southwest of the northeast side of the tower. The disk is stammed TOWER EIGHT 1947.

Reference Mark No. 1 is 21.54 feet south of the station and 1 foot south of the south corner of the tower in a drill hole in the concrete amon that runs around the foot of the tower. The disk is stammed TOWER EIGHT NO 1 1947.

Line Mark Seven is 13.4 feet from the station in the direction of TOWER SEVEN. The disk is a standard Reference Mark disk and is stammed SEVEN.

Line Mark Wine is 12.58 feet from the station in the opposite direction from TOWER MING. The disk is a standard Reference Mark disk and is stammed NINS.

NIME. The disk is a standard Reference Mark disk and is stamped NIME.

Described by _LET (continued on card 2 of 2)

MANY Marked by _LET.

Described by LET

* Refers to pages 108 and 109, Special Fublication No. 120, or to pages
112 and 113, Special Fublication No. 142.
* To nearest meter only, when no trigonometric leveling is being dops.

A traverse connection was made to Triangulation station LOG 1914. The distance was found to be 671.858 meters. Station LOG 1914 is 0.4 mile northeast of TOWER EIGHT at the top of a cut on the right.

To reach the station from Sears Landing, go 0.5 mile toward the ocean to a T-road, turn left and go 09.6 miles to a white concrete tower on the right and the station as described.

GRANT

An elevation has been determined.

(Previous description is on page 10)

GRANT (Onelow County, N.C., C.D.M., 1932; 1942) -- Letter of Mr. B.E. Beavin, Chief of Surveys, Carr & J.E. Greiner Co., Marine Barracks, New River, N.C., dated Sept. 24, 1942:

Station was recovered in good condition.

476p.10

NAME OF STATION:

RECOVERY NOTE, TRIANGULATION STATION

STATE: North Carolina County: Onslow C.D.M. YEAR: 1932 LOCALITY: Folkstone

Ap. 8 st. 192 p. 155

201 R

Recovered by:

C.R. Reed Year: 1947

Detailed statement as to the finese of the original description:

The station was recovered as described and all marks were found to be in good condition. RM No. 1 had been run into by a tractor and more a slightly, but is still solid. Mr. S.D. Grant who now owns the land, requested that RM No. 2 (Azimuth Mark) be moved. A new Azimuth Mark was set near the old one as described yelow, A complete mew describition follows:

Station is located in a plowed field 2.15 miles from Snead's Ferry and 5.8 miles from Folkstone. It is 65 fest southeast of the approximate centerline of a dirt road, 17 fest southwest of the west track of a track road and 140 feet northwest of the northwest corner of a tobacco barn. The mark is flush with the ground and the disk is stamped GRANT 1932.

Reference Mark No. 1 is 152,39 feet north of the station and 25 feet northwest of the approximate centerline of the main dirt road. The mark protects about 6" and the disk is stamped GRANT NO 1 1932.

Reference Mark No. 2 is 0.3 mile north of the station, 25 feet south of a track roal leading to the farm just before resching the farm. The mark protects about 4" and the disk is

leading to the farm just before reaching the farm. The mark projects about 4" and the d is stamped GRANT NO 2 1932. This mark may be destroyed soon as it is stuated in ground

Reference Mark No. 3 is 182.70 feet west of the station and 25 feet northwest of the approximate centerline of the main dirt road. The mark projects about 4" and the disk is stamped GRANT NO 3 1932.

(continued on card 2 of 2) *Name of chief of party should be inserted here. The officer who actually visited the station should sign his name at the end of the recovery note.

NOTE.—One of these form: must be used for every station recovered.

The Azimuth Mark is 0.3 mile north of the station, 3 feet northeast of REA pole No. REA CO-OF X201B and 20 feet northwest of the track road leading to the farm. The mark projects about 4" and the disk is stammed GRANT 1932 RESET 1947.

To reach the station from Folkstone on U.S. Highway 17, so east on a main travelled dirt road bearing slightly left at times, for 5.8 miles to the station in

To reach the Azimuth Mark from the station, go north across dirt road on coods road for 0.3 mile to farm on left, Azimuth Mark is about 100 feet northeast as described.

as described.
Objects V.G.
SWAN PT. ECC. 1932
Reference Mark No. 3
Reference Mark No. 2, 0.3 mile
Aximuth Mark, 0.3 mile
Reference Mark No. 2 Distance 0 00 00 182 11 10 296 17 59.5 296 42 41.2 55.687 46.448 294 11 '19

* 474 P.//
DEPARTMENT OF COMMERCE
U. S. COAST AND SEIDSTIC SURVEY
FORTH 536

RECOVERY NOTE, TRIANGULATION STATION

2266 R

MISH NAME OF STATION: RoP.S. C.R. Reed YEAR: 1947

Vers. 1914 LOCALITY: Holly Ridge

STATE: North Carolina County: Onslow 8. P. 9.51V

RECOVERED MY:* C.R. Reed Year: 1947

Detailed sistement as to the fitness of the original description: A The station is located on the northern end of Topeail Island about 9 miles northeast of Sears issuding on the ridge of dumes near the ocean. It is 100 feet southeast of the road and 100 feet northwest of the high tide mark The disk is in the top of a 6° tile and is unstamped. The mark is in good condition.

To reach the station from Sears Landing, go southeast toward the ocean for 0.5 mile to a T-road, turn left and go 8.7 miles to the station on the right as described.

An elevation has been datawarded.

An elevation has been determined.

RECOVERY NOTE TRIANGULATION STATION

2199 R

13

STATE: North Carolina Countre Onslow CRAR NAME OF STATION: 6 GA 700 59 × YEAR: 1914 LOCALITY: Holly Ridge YBAR:1947 C.R. Reed 4.P.D. 55

Detailed statement as to the fitness of the original description: The station was recovered as described, but the mark was in poor condition due to the eroding action of the sand. A new mark was su the mark was in poor condition due to the eroding action of the sand. A new mark was set over the same spot and the station marked as riven below:

The station is located near the northeastern end of Topsail Island on the high ridge of dunes next to the ocean. It is 40 yards southeast of the main road that runs the length of the island and about 50 yards from high tide. The mark (notes la-7a) projects about 8 inches and the disk is stamped CRAB 1914 1947.

To reach the station from the bridge at Sears Landing, go southeast toward the ocean for 0.5 mile, turn left and go 7.8 miles to the station on the right as described.

Objects V.G.

Direction

MISH 1914

0 00 00.0 178 53 16.9

An elevation has been determined.

DESCRIPTION OF TRIANGULATION STATION 2217 NAME OF STATION: RANGE TWO STATE: North Carolina County: Onslow YEAR: 1947 LOCALITY: Holly Ridge
DISTANCES AND DIRECTIONS TO REFERENCE MARKS AND PR
CAM BE SEEN FROM THE GROUND CHIEF OF PARTY C.R. Red Surface-station mark, Note * Underground-station mark Reference mark. Note,* Note.* Height of light above station mark meters.

Height of telescope above station mark meters.

Detailed description: The station is located about 7 miles northeast of Sears Landing on the northern end of Topsail Island. It is 50 yards northwest of the main road of the Island, just in front of a wooden range tower. The mark is a standard traverse disk projecting about 2". The disk is stamped RANGS TWO 1947.

To reach the stationifrom Sears Landing, go southeast toward the ocean for 0.5 mile to a T-road, turn left and go 6.95 miles to a wooden range tower on the left and the station as described.

A traverse compection was read to make the station as described. This is a traverse station Note.*

A traverse connection was made to Triangulation station TOWER SEVEN and the distance was found to be 557,978 meters.

An elevation has been determined.

2330 14 card 1 of 2
DESCRIPTION OF TRIANGULATION STATION STATE: North Carolina County:
YEAR: 10/7 LOCALITY: Holly Ridge COUNTY: Onslow NAME OF STATION: TOWER SEVEN CHIEF OF PARTY: C.R. Reed
Surface-station mark, Note,*
Underground-station mark, Note,* YEAR: 19,7 LOCALITY: HOLLY RIGES
DISTANCES AND DIRECTIONS TO REFERENCE MARKS AND PROCEED BY THE GROUND Neference mark, Neta,*
Adminush mark, Neta,*

Refers to pages 108 and 109, Special Publication No. 120, or to pages 112 and 113, Special Publication No. 145.
† To meanest meter only, when no trigonometric leveling is below done.

Line mark six is 13.47 feet from the station in the direction of TOWER SIX. The disk is a standard reference mark disk stamped SIK.

Line mark eight is 13.48 feet from the station in the opposite direction from
TOWER EIGHT. The disk is a standard reference mark disk stamped EIGHT.

A traverse connection was made to RANGE TWO, the distance found to be 577.978

A traverse connection was made to meters.
An elevation has been determined.

Card 1 of 2. 1914R DEPARTMENT OF COMMERCE
U. S. COAST AND GEOGRID BURVEY
FORESTA 586 RECOVERY NOTE, TRIANGULATION STATION VAME OF STATION: BETHEA State: North Carolina Cou MADDISHED BY: C.D.M. BOOVERED BY: E.C.A.

" C.D.M YEAR: 1933 Localers: Bethea Landing Jak.

* H.C.A. YEAR: 1943 See D. 11

with as to the fitness of the original description: * Descri Original description adequate.

Griginal description adequate.

The station is 2 % miles southeast of Hollyridge on land owned by R.H. Bethea. The station is near the fence line and about 20 feet figsts of the road leading from the farm house to the main road. It is about 65 meters southwest of the farmhouse, 9.44 meters west of a 36-inch live oak, and 11.2 meters south of south face of most westerly of farm buildings.

Station and underground marks are standard dies station marks in concrete, notes la and 7a. Reference marks are standard reference disks in

concrete, note lla.

Reference mark Ná. 1 is in old orchard 12.8 meters northwest of 12 inch magnolia tree, 12.5 meters north of northwest corner of fence around house.

house.

Reference mark No. 2 is in an open field 15 meters northeast of old road leading to the station and 4 meters east of the road running diagonally across the field.

Enference mark No. 3, the asimuth mark is 1 foot east of north and south wire fence about 12 feet from the centerline of the main road and at the point where the farm road running diagonally across the field enters the main road, and about 75 meters south of old building on west side of road. continued on name 2

The main roung sum secret 70 and page 2

"Rome of chief of party should be inserted less. The officer who evidedly whited the station should sign the manus at the end of the re

To reach the station from Hollyridge (Camp Davis) go southeast on the first road northeast of the main gate of Camp Davis, following the main road, for 1.6 miles, take right fork and follow for 1.2 miles to farm road leading diagonally off to the left to the farmhouse and the station.

1 ell

STATE: North Carolina COUNTY:Onslow LOCALITY: Holly Ridge

Sp. Part. 192 p. 163 S.P.p.41

- PK

ed statement as to the fitness of the original description: See p. 11
The station was recovered as described and all marks were found to be in cood condition. An accurate measurement could not be made to the marks due to various fences and outbuildings which were on line. A complete new description follows:

tion follows:
The station is located 2 3/4 miles east of Holly Ridge on land owned by R.H. Bethea.
It is about 200 feet southwest of the farmhouse, 30 feet west of a 36" Live Oak tree and
25 feet north of a track road leading to the farm. The mark projects about 6" and the
disk is stamped BETHEA 1932, notes la 7a
Reference Mark No. 1 is 170.3 feet northeast of the station, 50 feet northwest of the
northwest corner of the house and 40 feet northwest of a 12" Marnolia tree. The disk is
stamped BETHEA NO 1 1932, note lla
Reference Mark No. 2 is 140.2 feet northwest of the station, 1 foot southwest of a
tall, chicken wire fence and 25 feet northeast of the track road leading to the farm. The
mark projects about 6" and the disk is stamped BETHEA NO 2 1932, note lla

YEAR: 1917

tall, chicken wire fence and 25 feet northeast of the track road leading to the farm. The mark projects about 6" and the disk is stamped BETHEA NO 2 1932, note 11a Reference Wark No. 3 (Azimuth Mark) is 0.2 mile northwest of the station and 15 feet west of the approximate centerline of a main travelled dirt road where the farm road enters it diagonally. The mark prejects about 6 inches and the disk is stamped BETHEA NO 3 1932. To reach the station form the Post Office at Holly Ridge, go northeast on U.S. Highway 17 for about one block to first street right. Turn right and go easterly for 1.6 miles to a fork. Take right fork and go 1.2 miles to the Azimuth Mark (con't on and 2 of 2)

* Name of chief of party should be inserted here. The officer who actually visited the station should sign his name at the end of the recovery note.

(continued from card 1 of 2) on the right as described. Go left diagonally for 0.2 mile and the station on the left just before coming to the farm buildings.

RECOVERED BY:

OF STATION

C.D.M.

C.R. Reed

Object		Distance	Din	rect	ion
TO AR SIX		meters	0	00	0.00
Reference	dark No.	42,773	137	02	52 -
		, 0.2 mile	143	57	09.8
Reference			256	45	46 -

2207 R DEPARTMENT OF COMMERCE
U. S. COAST AND GEODETIC SURVEY
FORD 596 RECOVERY NOTE, TRIANGULATION STATION STATE: North Carolina NAME OF STATION: PED LOCALITY: Holly Ridge YEAR: 1933 YEAR: 1947 Den. care 1469 J.A.B.

SP. p. 519 Detailed statement as to the fitness of the original description: See p. 11

The station was recovered as described and all marks were found to be in good condition except Reference Mark No. 2 which is believed to

have been destroyed when the road which runs the length of the island was constructed. A complete new description follows:

a complete new description follows:

The station is located near the middle of Toosail Island along the seaward side on the high ridge of dunes. It is about 35 yards from the road and 35 yards from the ocean. The mark is an 3" tile projecting about 8" and the disk is stammed PED 1933.

Reference Mark No. 1 is 37.63 feet (11.470 meters) northeast of the station. The

mark is an 8" tile projecting about 8" and the disk is stamped PED NO 1 1933.

To reach the station from the bridge at Sears Landing, go southeast toward the ocean for 0.5 mile, turn left and go 4.5 miles to the station on the right on the ridge of dunes

An elevation has been determined.

COMMERCE

C.R. Reed

DEPARTMENT OF CO
U. S. COAST AND GEODETH
FORM 525
Rev. Oct. 1939 DESCRIPTION OF TRIANGULATION STATION 2229 STATE: North Carolina County: TOWER STY Onslow 1947 1 Holly Ridge CHIEF OF PARTY: C.R. Reed DISTANCES AND DIRECTIONS TO REFERENCE MARKS AND PE Surface-station mark. Note.* NENT OBJECTS WHICH Inderground-station mark Note,* Note, leference mark, °o do bo Note.* ZERO meters TOWER FIVE 03 28.0 zimuth mark, TOWER FIVE 0.5 28 28.0 Witness mark, Note, Note, Tower Five 0.5 28 28.0 Witness mark, Note, The Mode, The Mode of the Mode of

the tower. The disk is stamped TOWER SIX 1947.
Reference Mark No. 1 is 21.55 feet south of the station and 1 foot south of the

south corner of the tower. The disk is stamped TOWER SIX RM NO 1 1947.

Line mark five is 13.22 feet from the station in the direction of TOWER FIVE. The lisk is a standard reference mark disk stamped FIVE.

Line mark seven is 12.35 feet from the station in the opposite direction from TOWER

BEVEN. The disk is a standard reference mark disk stamped SEVEN.

To reach the station from the bridge at Sears Landing, go southeast toward the ocean for 0.5 mile, turn left and go 3.5 miles to a concrete observation tower and the station

Marked by

A Described by LET

A Described by LET

Norz.—The initial direction must be to main scheme station.

* Refers to pages 100 and 100, fiperial Publication No. 120, or to pages

† To assert motor cally, when no trigonometric leveling is being done. ere 11-676

MENT OF COMMERCE ST AND GEODETIC SURVEY FORD 526 RECOVERY NOTE, TRIANGULATION STATION

2194 R BANKS STATE: North Carolina Pender NAME OF STATION: x card 1419 Very 1933 LOCALITY: Holly Ridge J.A.B. Do YEAR: 1947

b. P. p. 579 See p.13,17,18

Detailed statement as to the fitness of the original description. The station was recovered as described and all marks were found to be in good condition. A complete new description follows:

The station is located about 10 miles south of New River Inlet and 3 miles northeast of Sears Landing on Toosail Island. It is on a very high sand dune just at the curve of the main road which runs the length of the Island. 

Reference Mark No. 1 is 34.57 feet northwest of the station. The disk is in the top of a 6" tile which projects about 8" and is stamped BANKS 1933.

of a b" tile which projects about 8" and is stammed Banas 2722.

To reach the station from the bridge at Sears Landine, so southeast toward the ocean for 0.5 mile, turn left and so 3.2 miles to a curve in the road around a high sand dune and the station as described.

Direction Objects V.G. Distance 0 00 00 70 17 30.5 77 47 00.9 TOWER SIX 10.537 meters -Reference Mark No. 1 PED 1933

An elevation has been determined.

C.R. Reed

A traverse connection made to TOWER SIX, distance found to be 471.242 meters.

* Name of chief of party should be inserted here. The officer who actually visited the station should sign his name at the end of the recovery note.

Norz.—One of these forms must be used for every station recovered.

Bogue Inlet to Wrightsville Inlet, North Carolina

COLD 17417 RECOVERY NOTE, TRIANGULATION STATION

2204° R HIGH STATE: North Carolina Country Pender
J.A.B. YEAR: 1933 LOCALTY: Holly Ridge
C.R. Reed Year: 1947 See De 1217
be stored of the original description: The Station was recovered as described and the NAME OF STATION RECOVERED BY:*

RECOVERED BY:

C.R. Reed

174: See The Station was recovered.

Detailed statement as to the States of the original description:

"efference Mark was found to be in good condition. The station mark was loose and was replaced by a standard disk station mark, notes la-7a, A complete new description follows:

The station is located along the ridge of dunes on the seaward side of Topsail Island about 2 miles east of Sears Landing. It is 100 feet north of high tide and 100 feet south

a talenhone and power line. The mark projects about 6" and the disk is stamped HIGH

mark is flush and the disk is stamped HIGH 1933.

To reach from the bridge at Sears Landing, go east toward the beach for 0.5 mile, turn left at T-road and go 0.8 mile to point where main road bears left. Continue stanight and following telephone and power line next to the dunes for 0.8 mile and the station on the right as described.

Objects V.G.
TOWER FIVE Distance Direction 0 00 00.0 177 47 59.5 181 21 28 1908.119 **BANKS 1933** Reference Mark 18.367 -

A traverse connection was made to TOWER FIVE, the distance found to be 1908.119meters An elevation has been determined. 1.1.1 0 6

DESCRIPTION OF TRIANGULATION STATION 2727 NAME OF STATION: TOWER FIVE STATE: North Carolina COUNTY CHIEF OF PARTY C.R. Reed YEAR: 1947 Holly Ridge DISTANCES AND DIRECTIONS TO REFERENCE MARKS AND PRICAN BE SEEN FROM THE GROUND Underground-station mark. Note. ZERO TOWER FOUR TOWER SIX 00 30.9 17.2 Azimuth mark,

Without mark, Mota, Mota corner of the tower. The disk is in a drill hole in the concrete apron around the foot of the tower and is stamped TO-ER FIVE RM NO 1 1947.

To reach the station from the Post Office at Holly Ridge, go southwest on U.S. Highway 17 fot 0.1 mile, turn left and go 4.85 miles to Sears Landing. Continue straight ahead across bridge for 0.5 mile to T- road. Turn left and go 0.4 mile to sideroad, turn right and go 0.1 mile to white comparison to the continue straight 

and go 0.1 mile to white concrete to er and the station as described.

Line mark four is 13.42 feet from the station in the direction of TOWER FOUR. The
disk is a standard reference mark disk stamped FOUR.

Line mark six is 13.17 feet from the station in the opposite direction from TOWER SIX. The disk is a standard reference mark disk stamped SIX.

A traverse connection was made to Triangulation station HIGH 1914 1947 and the distance was found to be 1908.119 meters.

A traverse connection was made to CENTRAL , the distance found to be 599.770 meters. An elevation has been determined.

A traverse connection was made to triangulation station TOWER FOUR and the distance was found to be 3070.9335 meters.

DEPARTMENT OF COMMERCE
U. S. COAST AND GEODETIC SURVEY
FORM 525
Rev. Oct., 1932 DESCRIPTION OF TRIANGULATION STATION 2211 NAME OF STATION: STATE North Carolina CENTRAL. COUNTY: Pender YEAR: 1947 CHIEF OF PARTY C.R. Reed Holly Ridge Surface-station ma ES AND DIRECTIONS TO REFERENCE MARKS AND PROCESS AND DIRECTIONS TO REFERENCE MARKS AND DIRECTI INENT OBJECTS WHICH Underground-station mark. Note.* Reference mark. Note,* Reference mark, Note, Azimuth mark Note.* This is a traverse station Height of light above station mark Height of telescope above station mark

Detailed description: The station is located near the middle of Topsail Island on the seaward side of a wooden range tower. It is 95 feet east of a T-road intersection, 12 feet east of the south leg of the range tower and 12 feet south of the east leg of the range tower. The mark is flush with the ground and the disk is stamped CANRAL 1947.

A traverse connection was made to Triangulation station TOWER FIVE and the distance

was found to be 599.770 meters.
To reach the station from Sears Landing, go 0.5 mile southeast toward the ocean to a T-road intersection and the wooden range tower just across the road and the station as

An elevation has been determined. card 1 of 2

DEPARTMENT OF COMMERCE
U. S. COAST AND GEODETIC SURVEY
FORM 525
Ray. Oct., 1932 DESCRIPTION OF TRIANGULATION STATION . Holly Ridge NAME OF STATION: TOWER FOUR STATE: North Carolina YEAR: 1947 LOCALITY: CHIEF OF PARTY: C.R. Reed Surface-station mark. CTIONS TO REFERENCE MARKS AND PRICAN BE SEEN FROM THE GROUND Underground-station mark, Reference mark, Note,* Reference mark. Note .

INENT OBJECTS WHICH ZERO TOWER THREE TOWER FIVE neters 00 41 21 16 Azimuth mark Note.* Reference Mark No. 1 317 Height of light above station mark elight of light above station mark 3 meters.

leight of telescope above station mark 3 meters.

Deline description: The station is located about 5½ miles northeast of the southwest end of Toosail Island, about 30 miles northeast of Wilmington and 5½ miles south of Holly Ridge. The disk is in a drill hole in the roof of a white concrete observing tower about 40 feet tall. It is 1.2 feet south of the north corner, 2.3 feet coutheast of the northwest side, and 3.2 feet southwest of the northeast side of the tower. The disk is stamped TOVER FOUR

Reference Mark No. 1 is 21.43 feet south of the station and 1 foot south of the south

Reference Wark No. 1 is 21,43 feet south of the station and 1 foot south of the so corner of the tower in a drill hole in the concrete arron around the foot of the tower. The disk is stammed TOY-R FORM RW NO 1 1947. To reach the station from the Holly Ridge Post Office, so southwest on U.S. Highwa for 0.1 mile, turn left between two brick billars for 4.85 miles to Sears Landing. Com inue strai ht ahead across bridge for 0.5 mile to T-road. Turn right and go 1.6 miles to a white experge, tower on the left and the station as described. (cont on card 2)

(Tower Four continued on page 22)

22

TOURR FOUR

card 2 of 2

North Carolina

Pender Holly Ridge

2226

dr1 ...

. 3

Line Mark to Tower Three is 13.15 feet from the station in the direction of Tower Three. The disk is a standard Reference Mark disk stammed THREE.

Line Mark to Tower Five is 13.30 feet from the station in the opposite direction from Tower Five. The disk is a standard Reference Mark disk stammed FIVE.

An elevation has been determined.

was made to triangulation station A traverse connection was made to triangulation TOWER FIVE and the distance was found to be 3070.9335 meters.

PENDER (Pender County, N.C., C.D.M., 1932)—About 30 miles by road northeast of Wilmington, on north side of highway right-of-way, and is reached by following route 17 direct to station site. Station is 15 meters (49 feet) south of south rail of Atlantic Coast Line Railroad, 10 meters (33 feet) north of center line of route 17, and 13 meters (43 feet) west of intersection of sand road with highway. Surface and underground marks are standard disk station marks in concrete, notes la and 7a. Reference mark No. 1 is standard reference disk, on south end of cement bridge on highway, and approximately one-fourth mile from station in azimuth 220-39:45. Reference marks Nos. 2 and 3 are standard reference disks in concrete, note 11a. No. 2 is 4 meters (13 feet) west of the center line of sand road leading south, and 45.29 meters (148.6 feet) from station in azimuth 284909'. No. 3 is 10 meters (33 feet) north of center line of route 17, approximately 15 meters (49 feet) south of south rail of railroad, and 48.67 meters (159.7 feet) from station in azimuth 39023'.

DEPARTMENT OF COMMERCE
U, a. COMMERCE
FOREST, 836

RECOVERY NOTE, TRIANGULATION STATION

1680 R STATE: North Carolina County Pender County

NAME OF STATION: PENDER Reportance by: C. D. Meaney Year: 1932 Localiff:
Recovering by: R. A. Pollock, Year: 1940 Original description is
State Highway & Public Works Corn.
Dealed statement as the sinces of the original description:

YEAR: 1932 Localett: C. YEAR: 1940 Original description is published in

On August 2, 1940, Mr. R. A. Pollock, Resident Engineer, Stat Highway and Public Works Comm., Jacksonville, N. C., was sent a new reference mark disk stamped "PENDER NO. 1 RESET 1940". A letter dated Nov. 2, 1940, from Mr. Pollock contains the following statement:

"THE location of the new reference mark PENDER NO. 1 was not changed; so, all previous data will remain the same."

738 P. / 3
DEPARTMENT OF COMMERCE
B. B. COAST AND GEOSSTIC SUBVEY
BYOCKS, 596 NAME OF STATION: PENDER

RECOVERY NOTE, TRIANGULATION STATION STATE: North Carolina Countr: Yman: 1932 Localett: Camp Davis
Yman: 1943

1917 R Pender But 193 4. 163

RECOVERED BY: C.D.M.
RECOVERED BY: H.C.A.

Desaid statement as to the Siness of the original description: The original description is inadequate because of much recent construction which has caused the locality to become known as Gamp Davis instead of Holly Ridge which is the name of the railroad station and the old golf office. The station is 2.1 miles southwast of the Holly Ridge (or Gamp Davis) railroad station, about 1/m mile southwast of the Parlian Gounty Line, 149 feet southwast of the southwast of the southwast rail of the Atlentic Coast Line Railroad, and 35 feet northwest of the centerline of U. S. Route 17. The surface and underground marks are described by notes la and Reference mark No. 1 or asimuth murk. The present mark is in the floor of a concrete oulvert on reignal No. 1 or asimuth murk. The present mark is in the floor of a concrete oulvert on Pender-Onslow Gounty Line, about 6 feet southwast of the southwast edge of the road asphalt surface, and near the center line of the oulvert. It is a Coast Survey reference-mark disk surface, and near the center floor which is covered by about 10 inches of earth, and it is examped FEIDER NO 1 RSSET 1910. A U. S. Engineers arimuth mark disk in a concrete post tamped FEIDER NO 1 RSSET 1910. A U. S. Engineers arimuth mark disk in a concrete post projecting about 5 feet and set alongside the railroad about 0.2 mile northeast of the county line should not be combined with the Coast Survey mark.

Reference mark No. 2 is 13 feet southwast of the centerline of a sand road leading Southeast, it is 15.29 meters or 118.6 feet about east of the station and is stemped FEIDER NO 1.2522.

southeast. 1t is 15.29 meters or 118.6 feet about east of the a FEIDER NO. 2 192. Reference mark No. 3 was destroyed by highway construction.

M.C. apply

*Name of chief of party should be inserted here. The officer who scionily visited the station should sign his name at the end of the recovery note manner seem.

NOTE.—One of these forms must be used for every station recovered.

DEPARTMENT OF COMMERCE
U. S. COAST AND SECONTIC SURVEY
FORTE 526 PENDER

RECOVERY NOTE, TRIANGULATION STATION

2268 R

NAME OF STATION: C.R. Reed

STATE: North Carolina LOCALITY: Holly Ridge YEAR: 1932 YEAR: 1947

County: Pender - pr Put. 192p 163 8.1.9.41

Detailed statement as to the fitness of the original description:

The station was recovered as described and all marks were found in good condition that were recovered by H.C.A. in 1943. A complete new description follows:
The station is located about 28 miles northeast of Wilmington and 02.2 miles southwest of the Holly Ridge Post Office along the northwest side of U.S. Highway 17. It is 34 feet northwest of the centerline of the highway and 49 feet southeast of the southeast rail of the Atlantic Coast Line Railroad. The mark projects about 8 inches and the disk is PENDER 1932.

18 PENDER 1932.

Reference mark No. 1 (reset 1940) is used as an Azimuth Mark. It is 0.3 mile northReference mark No. 1 (reset 1940) is used as an Azimuth Mark. It is 0.3 mile northeast of the station on the southeast side of U.S. Highway 17 at the Onslow-Pender CountyLine. The disk is in a drill hole in the flat too of a concrete culvert 20 feet southeast of the senterline of the Highway at the approximate centerline of the culvert. The
disk is stamped PENDER NO 1 RESET 1940.

Reference mark No. 2 is 148.66 fest southeast of the station, 104 feet southeast of the centerline of U.S. Highway 17 and 15 feet south of the approximate cemterline of a dirt side road. The mark projects about 8 inches and the disk is stamped PENDER NO 2 1932. Objects V.G.

Direction Old Distance New Distance Object 0 00 00.0 meters 45.29 Reference Mark No. 2
Reference Mark No. 2
Reference Mark No. 1 reset 1940 O.3 mile
Name of chief of party about to be inserted here. The officer who actually
Nova.—One of these forms must be used to 16 11 46 312 51 01.0 RECOVERY NOTE, TRIANGULATION STATION

NAME OF STATION: ATALISCON YEAR: 1914 LOCALITY: Wolly Ridge YEAR: 1947

ESTABLISHED BY: R.P.S.
RECOVERED BY: C.R. Reed

STATE: North Carolina County: Pender

b. P. p. 132.

192 R

OKX

Detailed statement as to the fitness of the original description: See p. 13
The station was recovered as described and all marks were found in good condition with the exception of R.M. No. 1 which could not be found and R.M. No. 3 which had been

run over by a tractor and moved slightly. A complete new description follows:
The station is located about 25 miles northeast of Wilmington and 8 miles south of

The station is located about 25 miles northeast of Wilmington and S miles south of Holly Ridge on the west edge of The Inland Waterway about 10 feet west of high water. The mark projects about 10 inches and the disk is stamped ATKINSON 1914 1732, note la 7a.

Reference Mark No. 2 is 88.19 feet southwast of the station and about 40 feet west of high water. The mark projects about 10 inches and the disk is stamped ATKINSON NO 2.1932.

Reference Mark No. 3 was used as an Azimuth Mark. It is approximately 0.2 mile west of the station and 15 feet south of a track road. The mark projects about 8 inches and the disk is stamped ATKINSON NO 2.1932.

the disk is stamped ATKINSON NO 3 1932, note lla
Reference Mark No. 4 is 97.67 feet northwest of the station and 10 feet south of the

track road leading to the station. The mark projects about 8 inches and the disk is stamped ATKINSON NO 4 1932, note lla.

To reach the station from the Post Office in Holly Ridge, so southwest on U.S. Highway 17 for 05.4 miles, turn left on a main travelled dirt road for 01.85 miles, take right fork for 0.2 miles, turn right on track road for 0.7 miles and turn left along edge of field into the manus, ourning on trace on the right. To along edge of field for 0.45 mile to the Asimuth Mark (R.M. No. 3) on the right as described. (continued on card 2 of 2) continued from card 1 of 2) Continued straight ahead to edge of coosa, bearing left, them right thru woods to the beach and the station as described.

Objects V.G:

Object	old distance	new di	stance	Dir	ecti	on	
HAMPSTEAD 2	feet	feet	meters	0	00	0.0	
Reference Mark No. 2	88.15	88.19	26.880	19	11	51	
Reference Mark No. 3	Approximately 0.2	mile		65	39	1.5.5	
Reference Mark No. 4	98.57	97.67	29,770	99	45	09 -	
TOWER THREE	V			218	07	17.6 -	
TOWER TWO				282	22	57.4 -	
TOMER ONE	8 8 E			312	25	43.4 -	

U760.17 RECOVERY NOTE, TRIANGULATION STATION NAME OF STATION: BUMBLE

2198 R Countr: Pender STATE: North Carolina GA 70059 5

R.P.S. YEAR: 1914 LOCALITY: Holly Ridge ESTABLISHED BY: YEAR: 1947 C.R. Reed 1.0.2.118

Detailed statement as to the Stores of the original description: See p. 12

The station was recovered as described and the station mark was found to be in good condition. The deference Mark was searched for but not recovered. It has probably been destroyed due to the erosion of the beach. A complete new description follows:

new description follows:

The station is on the inland side of the banks, opposite Virginia Creek, on the marsh at the curve of the channel from sloop point to the banks. The station is on the beach and is under water at extreme high tide. The mark is a standard unstamped bronze disk in the end of a 4" tile which projects about 12" above the surface of the ground.

To reach the station from the bridge at Sears Landing, as carces bridge towards the beach for 0.5 mile, turn right and go 03.2 miles to E.T.T. (end of truck travel). Go northwest through the scrub trees and brush for about \(\frac{1}{2} \) mile to the beach and the station as lescribed.

Objects V.G.

Direction ATKINSON 1914 1932 0 00 00 TOWER THREE 303 12 45.0 321 09 19.8 TOWER TWO

DEPARTMENT OF COMMERCE U. S. COAST AND GEODETIC SURVEY FOTEN: \$95 Bet. Oct., 1952 DESCRIPTION OF TRIANGULATION STATION 2223 STATE: North Carolina YEAR: 1947 LOCALITY: NAME OF STATION: TOWER THREE COUNTY Pender Holly Ridge C.R. Reed CHIEF OF PARTY: DISTANCES AND DIRECTIONS TO REFERENCE MARKS AND PR CAN BE SEEN FROM THE GROUND Underground-station mark, Note,* Reference mark. ZERO TO TER TWO TOWER FOUR Reference Mark No. 1 BUMBLE 1914 58.0 12.1 57 40.3 Note,* meters Note,4 Azimuth mark, Note.

card 1 of 2

witness mark, Height of light above station mark 3 meters. Height of felescope above station mark 3 meters. Height of felescope above station mark 3 meters. Height of felescope above station mark 3 meters. The station is located about & miles northeast of the southwest end of Topsnil Island, 29 miles northeast of Wilmin-ton and 7 miles south of Holly Ridge. ropsail Island, 29 miles normeast of Wilman-ton and 7 miles south of holly hadge. The disk is in a drill hole in the roof of a white concrete observing tower which is about 40 feet tall. It is 4.0 feet south of the north corner, 2.8 feet southeast of the northwest side and 2.9 feet southwest of the northeast side of the tower. The disk is stamped TOWER THRES 1947.

Reference Mark No. 1 is 21.52 feet south of the station and i foot south of th

Reference mark no. 18 21.32 feet south of the station and 1 look south of the south corner of the tower in a drill hole in the concrete arron around the foot of the tower. The disk is stamped TOWER THRUE RM NO 1 19/7.

To reach the station from the Holly Ridge Post Office, so 0.1 mile southwest on U.S. Highway 17 to a sideroad left. Go left for 4.85 miles to Sears Landing. Continue straight ahead across bridge for 0.5 mile to a T-road. Turn right and go 3.65 mile to a white concrete tower and the station as described on the left.

Line Mark to Tower Two is 13.20 feet from the station in the direction of Tower Two. The disk is a standard Reference Mark disk stamped TWO. Line Mark to Tower Four is 13.30 feet from the station in the opposite direction from Tower Four. The disk is a standard Reference Mark disk stamped FOUR.

An elevation has been determined.

MENT OF COMMERCE RECOVERY NOTE, TRIANGULATION STATION +76 p.13 2197 STATE: North Carolina COUNTY: Pender NAME OF STATION: BLAKE 6A 70059 =

YEAR: 1914 YEAR: 1947 LOCALITY: Holly Ridge R.P.S. C.R. Reed RECOVERED BY:* b.P. J. 523 Detailed statement as to the fitness of the original de eription: See p. 13

Detailed statement as to the fitness of the original description: Dee P. 1)

The station was recovered as described. The mark was found in bad condition and will not last match longer due to erosion of the beach. A complete new description follows:

The station is located on the inshore side of Topsail Island about 2; miles northeast

The station is located on the inshore side of Tonsail Island about 2t miles northeast of Tonsail Inlet. It is about 1 foot from the bank at high tide and projects about 18 inches. The disk is in the end of a 4" tile and is unstamped. A traverse connection was made to TOWER TWO R.M. No. 1 and the distance was found to be92.123 meters.

To reach from Holly Ridge, go southwest on U.S. Highway 17 for 0.1 mile, turn left and go 4.85 miles to Sears Landing. Continue straight shead across bridge for 0.5 mile to T-road, turn right and go 5.0 miles to side road, turn right and go 0.1 mile to a white concrete observing tower about 40 feet tall. The station is about 100 yards west of this tower at the water's edge.

Objects V.G: Object Distance Direction 0 00 00.0 ATKINSON 1914-1932 TOWER TWO 90.326 115 43 15.8 -TOWER TWO, R.M. No. 1

Traverse connection made to TOWER TWO, distance found to be 90.326 maters.

°0 00 00 89 36 59.16-152 40 41.18-317 13 23.08-321 12 21.88

Form 525 Rev. Oct., 1932	. DESCRIP	TION OF TRIANGULATIO	ON STATI	ON			
	ER TWO	STATE: North Carolin	na Cour	Ridge	ende	r	
CHIEF OF PARTY: C. 1	R. Reed	TEAN: 1947 LOCALITY	: norry	RIUE	e		
Surface-station mark,	Note,*	DISTANCES AND DIRECTIONS TO	REFERENCE NE SEEN FROM	ARKS AN	D PRO	MI	
Underground-station mark,	Note,*	UAN 6	E SEEN FROM	THE UKO	UND		
Reference mark, Note,*		OBJECT	DISTANCE	DIRECTION			
Reference mark,	Note,*	HAMPSTEAD 2 ATKINSON 1914 19	meters	°O.	00	1	
Azimuth mark,	Note,*		12	89	36		
Witness mark,	Note.*	TOWER THREE	LA STATE	152	40	L	
		ZERO		317	13	1	
Height of light above station r		TOWER ONE	210 20	321	12	- ;	
Height of telescope above stat	lon mark 3 meters.†	Reference Mark No. 1	6.456	279	41	:	

Height of telescope above station mark 3 meters! Reference Mark No. 1 | 6.456 | 279 | 41 22 | betalled description: The station is located on the southwest end of Topsail Island about 25 miles northeast of Wilmington, 8 miles south of Holly Ridge and 2 miles northeast of the southwest end of Topsail Island, The station is located in a drill hole in the north corner of the concrete roof of a white concrete observing tower which is about 40 feet tall and 18 feet scuare. It is 4.1 feet south of the north corner, 3.4 feet southeast of the northwest wall and 2.9 feet southwest of the northeast wall of the tower. The disk is stamped TOWER TWO 1947.

**Reference Mark No. 1 is 21.18 feet south of the station, in a drill hole in the concrete apron at the foot of the tower. It is 1 foot south of the south corner of the tower and the disk is stamped TOWER TWO RM NO 1 1947.

To reach the station from the Holly Ridge Post Office, go southwest on U.S., Highway 7 for 0.1 mile. turn left between two herek cillars on a black too road (con't. on card 1.7 22 .

* Refers to pages 108 and 109, Special Publication No. 120, or to pages 112 and 113, Special Publication No. 146. † To nearest unster only, when no trigonometric leveling is being done.

(con't. from card 1) for 4.85 miles to Sears Landing and bridge. Continue straight ahead across bridge for 0.5 mile to Tercad. Turn right and go 5.0 miles to a side road right. Turn right and go 0.1 mile to a white concrete tower and the station on the left as described.

Line Mark to Tower One is 13.07 feet from the station in the direction of Tower

One. The disk is a standard Reference Mark disk stamped ONE.

Line Mark to Tower Three is 13,33 feet from the station deposite the direction of Tower Three. The disk is a standard Reference Mark disk stamped THREE.

Additional objects V.G. HAMPSTEAD 2 BLAKE 1914 BUMBLE 1914

Direction 0 00 00 23 53 18.5 144 59 57.2 -

A traverse connection was made to BLAKE, the distance found to be 90,326 meters. An elevation has been determined. 2236

card 1 of 2

DESCRIPTION OF TRIANGULATION STATION Name of Station: ZERO
C.R. Reed
Not Note,* la Note,* 7a Surface-station mark. Underground-station mark, Note,* Reference mark, Reference mark, Azimuth mark. Note,* Witness mark, Note,*
Height of light above station mark 3

STATE: North Carolina County: YEAR: 1947 LODALTY: Holly Ridge DISTANCES AND DIRECTIONS TO REFERENCE MARKS AND PROCAN SE SEEN FROM THE GROUND HAMPSTEAD 2 met.ers 47.14-TOWER TWO 124 31 TOWER ONE 331

the station as described,

Line Wark to Tower One is 87.17 feet from the station in the opposite direction from The disk is a standard Reference Mark disk stamped ONE, (cont on card 2) Tower One.

Described by ... LET . ion must be to main scheme station. Nove ... The initial di

* Refers to pages 108 and 108, Special Publication No. 120, or to pages 121 and 113, Special Publication No. 145, 17 Duescrat mater only, when no trigonometric leveling is being done.

Line Mark to Tower Two is 95.97 feet from the station in the direction of Tower Two.

The disk is a standard Reference Mark disk and is stammed TWO.

Steel Launching Pin is a 42 steel shaft embedded in the Launching platform and extending about 8" above the platform. It is 68.51 feet north of the station. The point measured to and observed is a center punch mark on the top and center of the pin.

A traverse connection was made to traverse station CONTROL and the distance was found to be 29.0.63 meters.

A traverse connection was made to traverse station CAMERA and the distance was found to be 29.0.64 meters.

found to be 242.634 meters.
A traverse sonnection was made to TOWER OWE. and the distance was found to

he 409.036 meters.

Note,*

2312

An elevation has been determined.

DEPARTMENT OF COMMERCE U. S. COAST AND GEODETIC SURVEY FORTH 595 Rev. Oct., 1932 CONTROL NAME OF STATION: C.R. Reed CHIEF OF PARTY Note,* Note,* Underground-station mark, Reference mark. Note.*

Azimuth mark, Witness mark. DESCRIPTION OF TRIANGULATION STATION STATE: North Carolina County: Pender

This is a traverse station

1947 LOCALITY: Holly Ridge YEAR: DISTANCES AND DIRECTIONS TO REFERENCE MARKS AND PROMINENT OBJECTS WHICH

Height of telescope above station mark meters.

Detailed description: Height of telescope above station mark meteral petalled descriptions of the southeastern end of Topsail Island about 6 miles southeast of Sears Lahding. It is 30 feet west of a crossroad intersection, 10 feet south of the east corner of a concrete control tower and 10 feet east of the south corner of the tower. The mark is flush with the ground and the disk is stamped CONTROL

A traverse connection was made to Triangulation station ZERO and the distance was

found to be 95.199 meters.

To reach the station from the bridge at Sears Landing, go southeast toward the ocean for 0.5 mile, turn right and go 6.4 mile to a crossroad with a concrete control tower in the west angle and the station as described.

An elevation has been determined.

Described by Norz.—The initial direction must be to main scheme station.

MDW Marked by ... * Refers to pages 108 and 198, Spacial Publication No. 128, or to pages 112 and 113, Spacial Publication No. 146.

**To search moter only, when no triponometric leveling is being done.

DESCRIPTION OF TRIANCHLATION STATION 2216 STATE: North Carolina County: Pender YEAR: 1947 LOCALITY: Holly Ridge RANGE ONE NAME OF STATION: CHIEF OF PARTY: Surface-station mark, C.R. Reed Note,* DISTANCES AND DIRECTIONS TO REFERENCE MARKS AND PROCESS OF THE GROUND CAN BE SEEN FROM THE GROUND Underground-station mark. Reference mark, Note,* Note,* Azimuth mark. Note.* This is a traverse station Witness mark Height of light above station mark negate or aget above station mark meters.
Height of telescope above station mark meters.†
Detailed description: The station is located on the southeastern end of Topsail Island about 6

begind description: The station is located on the southeastern end of 10,0011 Asimum and the belief description: The station is located on the inland side of the island. It is directly in front of a wooden range tower, 12 feet south of the east leg and 10 feet east of the south leg of the tower. The mark is flush with the ground and the disk, a standard triangulation

front of a wooden range tower, 12 feet south of the east leg and 10 feet east of the sout leg of the tower. The mark is flush with the ground and the disk, a standard triangulatidisk, is stamped RANGE ONE 1947.

To reach the station from Sears Landing, go across the bridge towards the ocean for 0.5 mile, turn right go 6.25 miles to a side road right, turn right and go 0.1 mile to a wooden range tower and the station as described.

An elevation has been determined.

A traverse connection was made to Triangulation station CAMERA and the distance was found to be 175.447 meters.

DESCRIPTION OF TRIANGULATION STATION 2210 STATE: North Carolina County: p NAME OF STATION: CAMERA
CHIEF OF PARTY: C.R. Reed
Surface-station mark, Note, COUNTY: Pender PART: 1947 LOGALITY: Holly Ridge
DISTANCES AND DIRECTIONS TO REFERENCE MARKS AND PROMINENT OBJECTS WHICH'.

CAN BE SEEN FROM THE ORDUND Underground-station mark. Note. Note,* DISTANCE Reference mark, Azimuth mark. Note,* Witness mark Note,* This is a traverse station Height of light above station mark meters.
Height of telescope above station mark meters.

Height of telescope above station mark meters!

Detailed descriptions: The station is located on the southeast end of Topsail Island about 6 miles southwest of Sears Landing. It is 50 feet north of a T-road intersection and 6 feet southwest of a telephone pole. The mark is flush with the ground and the disk (a standard triangulation disk) is stamped CAMERA 1947.

A traverse connection was made to triangulation station ZERO and the distance was found to be 242-634 meters.

To reach the station from the bridge at Sears Landing, go southeast toward the ocean for 0.5 mile, turn right and go 6.25 miles to a T-road intersection and the station as

described.

An elevation has been determined.

A traverse connection was made to triangulation station RANGE ONE and the distance, was found to be 175.447 meters.

card 1 of a OK DEPARTMENT OF COMMERCE U. S. COAST AND GEODETIC SURVEY FOREN 525 Rev. Oct., 1933 DESCRIPTION OF TRIANGULATION STATION 2219 COUNTY: Pender STATE: North Carolina Locality: NAME OF STATION: TOWER ONE CHIEF OF PARTY: C.R. Reed Note,*
Underground-station mark, Note,*
Pafarence mark, Note,* YEAR: 1947 LOCALITY: HOLLY RIGGE
DISTANCES AND DIRECTIONS TO REFERENCE MARKS AND PROMINENT OBJECTS WHICH
CAN BE SEEN FROM THE GROUND DISTANCE HAMPSTEAD 2 meters ATKINSON 1914 1932 0 00 00.0 05 23 13. Reference mark,
Almuth mark,
Note,*
Almuth mark,
Note,*
Height of light above station mark
Height of telescope above station mark
Lotted telescope above station mark
Lotted telescope above station is located about 7 miles south of Holly Ridge on the southwest

The station is located about 7 miles south of Holly Ridge on the southmest end of Topsail Island. The mark is in a drill hole in the west corner of the roof of a concrete observation tower. It is 3.9 feet east of the west corner of the tower, 2.9 feet southeast of the northwest side and 2.8 feet southwast of the northeast side. The disk is stamped TOWER ONE 1947.

Reference Mark No. 1 is 22.57 feet east of the station and 2 feet east of the east

corner of the tower in a drill hole in the concrete apron which runs around the foot of the tower. The disk is stamped TOWER ONE RM NO 1 1947.

Line mark two is 6.29 feet from the station in the direction of TOWER TWO. The disk

Nôtz.—The initial direction must be to main scheme station.

* Refers to pages 198 and 109, Special Publication No. 120, or to pages 112 and 113, Special Publication No. 145. † To nearest meter only, when no trigonometric leveling is being done.

To reach the station from the bridge at Sears Landing, go southeast toward the ocean for 0.5 mile, turn right and go 6.65 miles to a white concrete observing tower about 50 yards on the right and the station as described.

A traverse connection was made to ZERO, the distance found to be 409.036 meters.

An elevation has been determined.

DEPARTMENT OF COMMERCE STATION STATION

2203 R Sp Put. 1929.162

STATE: North Carolina County: Pender C.R. Reed Year: 1947 NAME OF STATION: HAMPSTEAD

1. 1.1.41 Detailed statement as to the fitness of the original description: See p. 13

This station was found to have been moved. Probably when a tile drain for Topsail school was laid. The underground mark was searched for but could not be found. The disk was restamped and now reads HAMPSTEAD 2 1947. Reference Mark No. 1 has been destroyed, probably due to widening of the road, An Azimuth Mark was set to replace it. Reference Marks Nos. 2 and 3 were recovered in good condition and were used as Reference Marks for the new station after being restamped HAMPSTEAD 2 No. 2 1947 and HAMPSTEAD 2 NO 3 1947.

To reach the station from the Post Office at Holly Ridge, go southest on U.S. Highway 17 for 12,45 miles to the Asimuth Mark on the left. Continue O.1 mile to Topsail School on the left and the station near the northeast end of a long metal parage at the

2213 STATE: North Carolina County Pender YEAR: 101. LOCALTY: HOLLY RIGHT OF THE STATE DISTANCE ATKINSON 1932 meters 0 00 00 Reference Mark No. 3 37,006 191 53 53 Azimuth Mark, Approx. 0.15 ml 305 05 47,4 Reference Mark No. 2 56,120 326 37 10 0 00 00

Withes mark, Notes and Mark No. 2 is 184.12 feet north of the station and about 100 yards east of U.S. Hairway 17. The mark projects about 2 is 184.12 feet north of the station and about 100 yards about 1000 yards yards

U.S. Highway 17. The mark projects about 10 inches and the disk is stamped HAMPSTEAD 2 NO 2 19/7

The Azimuth Mark is approximately 0.15 mile north of the station, 52 feet southeast The Azimuth Mark is approximately 0.15 mile north of the station, >2 leve Southeast of the centerline of U.S. Highway 17 and 6 feet southeast of (continued on card 2 of 2)

Described by LET Marked by Mi

* Refers to pages 108 and 100, Special Publication No. 120, or to pages as 11—4761 113 and 115, Special Publication No. 145. * To bearest interfer only. when page televisions.

(continued from card 1 of 1) Powerline Pole No. 203. The Mark projects about 6 inches and the disk is stamped HAMPSTEAD 2 1947.

To reach the station from the Post Office in Holly Ridge, go southwest on U.S. Highway 17 for 12,45 miles to the Azimuth Mark on the left as described. Continue for 0.1 mile to Topsail School on the left and the station in the rear as described.

DEPARTMENT OF COMMERCE
u. s. coast and decorte survey
Form 526
(Bev. Feb. 1948) RECOVERY NOTE, TRIANGULATION STATION 3996 R

NAME OF STATION: BORCON, 19856)

ESTABLISHED BY: USCACS YEAR: 1933 STATE: North Carolina
RECOVERED BY: H. F. Garber YEAR: 1950 COUNTY: Onelow

(No previous description)
Detailed statement as to the fitness of the original description; including marks found, stampings, chadges made, and other pertinent facts Destroyed

DEPARTMENT OF COMMERCE
U. B. COLST AND GEOGRIF SHIVEY
PORTING STATION
RECOVERY NOTE, TRIANGULATION STATION NAME OF STATION: EEACON NO. 5

BETALBURBURD BY: C & G. S.

RECOVERED BY: H. F. Garber

YEAR: 1950

YEAR: 1950

Detailed statement as to the fitness of the original description: (No previous description)

Station destroyed. Beacon has been rebuilt in hew location since date of triangulation.

U. S. COAST AND GEOGRAP (Rev. Feb. 1948) RECOVERY NOTE, TRIANGULATION STATION 3998 R BN. 6 NAME OF STATIONS

NAME OF STATION: BIL. 0

ENTABLISHED ST: C&CS YEAR: 1932 STATE: North Curolina

RECOVERED BY:* H. F. Gurber YEAR: 1950 COUNTY: Cnslow

Detailed statement as to the fitness of the original description; including marks found, stampings, changes made, and other pertinent for Station destroyed. Beacon moved.

DEPARTMENT OF CON U. S. COAST AND GEODETIC FORZII 526 (Ber. Feb. 1948) RECOVERY NOTE, TRIANGULATION STATION 3999 R

NAME OF STATION: BEACON 7 ESTABLISHED BY: YEAR: 1933 STATE: North Carolina RECOVERED BY: *H.F.Garber YEAR: 1950 COUNTY: Onslow

Detailed statement as to the fitness of the original description; including marks found Ramping, change man, and the pertinent

ents to be those of the original description; including marks found, simplify, thanks miss, which the Recovered in good condition. Not previously described.

Description follows: Station is located about 0.6 mile
W of the W side of the inlet to Goose Bay; on the S side
of the Intraceastal Waterway channel.
Station is the light atop a black, square daymark with
yellow border, on piles.
Listed in the Light List, Intracoastal Waterway as
Stump Sound Lt. 27.

DEPARTMENT OF COMMERCE

B. B. GRAFT AND STRUCTURE SUPPLY

(Bit 7, 189). 189) 4001 R

POTEN SEC.

(BATE OF STATION: B): 10 (1447)

NAME OF STATION: B): 10 (1447)

FEARLISESS STATE: North Carolina

RECOVERED BY: 1: F. Garber Year: 1930 County: Onslow

(No previous description) Station destroyed. Beacon moved.

DEPARTMENT OF COMMERCE
16. 6. COMPT AND SERONT: SUMMEY
(Bills: 7, 19.) 196) 4006 NAME OF STATION: BOG ESTABLISHED BY: USC&GS

NAME OF STATION: DOG ENTABLISHED ST: USCAGS YEAR: 1933 STATE: North Carolina RECOVERED SY:* H. F. Garber Year: 1950 COUNTY: Onslow

Detailed statement as to the fitness of the original description; including marks found, stampings, changes made, and other pertinent facts.

Station not recovered. There is evidence of considerable erosion in this area, and it is believed that this station is lost.

DEPARTMENT OF COMMERCE U. S. COMST AND GEODETIC SURVEY FORTH 526 (Box. Feb. 1948) RECOVERY NOTE, TRIANGULATION STATION 4035 R NAME OF STATION: CHIE RECOVERED ST: F. Garber Year: 1927 State: North Carolina
Recovered St: F. Garber Year: 1950 Count: Onelow
Recovered St: F. Garber Year:

Station not described. A search was made at the plotted position and it could not be found. The shoreline has receded considerably since 1927 and it protably has been washed out.

It is recommended the station be classified lost.

DEPARTMENT OF COMMERCE
16. 6.0047 DO BEDGE CHIPTY
(III. 78) 1190

NAME OF STATION HELIO ESTABLISHED BY YEAR: 1927 STATE: North Carolina Recovered BY: H. F. Garber Year: 1950 Counts: Onslow

Detailed statement as to the fitness of the original description; including mark quart, samplings, change made, and other pertinent facts:

4072 R

4076 R

4110 R

4137 R

4130 R

4119 R

4168 R

Not recovered after a reasonable search. No description

It is recommended the station be classified lost.

DEPARTMENT OF COMMERCE
6. LOSH MER DEPARTMENT OF COMMERCE
(18. P. DEPARTMENT OF COMMERCE
(18.

NAME OF STATION: HILT PAPER BUSINESS USCAGS USC&GS YEAR: 1927 STATE: North Carolina H. F. Garber Year: 1950 County: Onelow RECOVERED BY:* Onslow

603 Detailed statement as to the fitness of the original description; including marks found, stampings, changes made, and other perhent facts

Not recovered. A search was made and it could not be found. It is recommended the station be classified lost.

RECOVERY NOTE, TRIANGULATION STATION NAME OF STATION:

4109 R 274(USE) U. S. E. YEAR: 1933 STATE: North Carolina H. F. Garber YEAR: 1950 COUNTY: Conslow

RECOVERED BY:* Defailed statement as to the fitness of the original description; including marks forms, samping, this gas middle, and other periment facts:

Station recovered in good condition. New description follows: Located approximately 1.0 miles 5% of Swansboro, M. C., approximately 450 ft. of Beacon No. 49, 79.0 ft. S (outside) of MNML. Larked by a two inch iron pipe projecting 2 ft. above 'Hi.

DEPARTMENT OF COMMERCE
U. S. COMPT NO SECURITY SURVEY
PROTECTION

RECOVERY NOTE, TRIANGULATION STATION

MRE OF STATION: 294 (USE)

Betablished By: USE

YEAR: 1933 STATE: North Carolina

Recovered By: USE

Recovered By: USE

Year: 1935 County: Onslow

(No previous description)

Detailed statement as to the fitness of the original description; including marks found, stampings, changes made, and other pertinent facts

Not recovered. No description available.

There are a number of pipes in the area of the plotted position. It could not be determined which, if any, is the station.

DEPARTMENT OF COMMERCE
U. S. COAST AND GEODETIC SURVEY
FORM 526
(Rev. Feb. 1945) RECOVERY NOTE, TRIANGULATION STATION

NAME OF STATION: RICK ESTABLISHED BY: USC&GS REGOVERED BY: USCAGS YEAR: 1927 STATE: North Carolina RECOVERED BY:* H. F. Garber YEAR: 1950 COUNTY: Onslow

No previous description of the Original description; including marks found, stantomer, changes make, and other pertinent facts: Not recovered. A search was made and it could not be found. It is recommended the station be classified lost.

RECOVERY NOTE, TRIANGULATION STATION

NAME OF STATION: FOINT
ESTABLISHED BY: CEGS YEAR: 1927 STATE: North Carolina
RECOVERED BY: F. F. Garber Year: 1950 County: Onslow

nent as to the fitness of the original description; including marks found, stampings, changes made, and other pertinent facts: Station not described. A search was made at the plotted position and it

could not be found. The area is covered with shifting sand dumes and if it still exists it is probably covered.

It is recommended the station be classified lost.

U. S. COAST AND GEODETIC SURVEY
FOrm 526
(Rev. Feb. 1948) RECOVERY NOTE, TRIANGULATION STATION

NAME OF STATION: PEAK YEAR: 1927 STATE: North Curolina RECOVERED BY: H. F. Gerber YEAR: 1950 COUNTY: Onslow

600 Detailed statement as to the fitness of the original description; including marks found, samplings, changes made, and other pertinent facts:

Ctation not described. Shifting sand dunes exist in the area of the plotted position and it could not be found after a demiled search.

It is recommended the station be classified lost.

RECOVERY NOTE, TRIANGULATION STATION DEPARTMENT OF COMM
U. S. COAST AND GEOCETIC SUI
FORM 526
(Rev. Feb. 1948)

(MF.786.1848)
NAME OF STATION: SWAINSBORO, BAPTIS: CHURCH, SFIRE
ESTABLISHED BY: C & G S YEAR: 1933 STATE: Morth Carolina
RECOVERED FY: H. F. Garber YEAR: 1950 COUNTY: CIBLOW

Detailed statement as to the fitness of the original description; including marks found, stampings, changes made, and other pertin

Stat on recovered in good condition, no description available. Description follows:

Located in Swansboro, N. C. on the east corner of N. Main and Water Streets. Station is the finial atop the spire at the south and of the Church. The building is painted white with a green roof.

DEPARTMENT OF COMMERCE

6. B. COMPT AND RECOVERY NOTE, TRIANGULATION STATION
(18th 78th 196)

4169 R

Name of Station:

Name of Station:

SWANSBORO, METHODIST CHURCH, SPIRE

Betablished Bit: C & G S Year: 1933 State: North Carclina

Recovered Bit: H. F. Garber Year: 1950 County: Onslow

Detailed statement as to the fitness of the original description; including marks found, sharping commenced as 

btation recovered in good condition. However, it is no longer used as a church and the building is falling into disrepair.

Located in Swansboro, N. C. on the W corner of Church and Elm Sts. Station is the apex of the spire on the S end of the church.

UNITED STATES COAST AND GEODETIC SURVEY Descriptions of Triangulation Stations

WATER TANK NEAR STATIO. QUEEN (Onslow County, N.C., C.&G.S., 1935; H.F.G., 1950) (No previous description) -- Station was not recovered. There is no water tank in this area. It is recommended that this station be classified lost.

FULLARD (Onslow County, N.C., R.P.S., 1914) -- Station is a high pole erected in the woods near Fullards Creek. It was not marked

(H.F.G., 1950) -- A search was made in the vicinity of the plotted position and the station could not be found.

BOGUE (Carteret County, N.C., J.S.H., 1908; H.F.G., 1933) (Previous description is on page 1) -- Station and reference mark 1 (1933) were recovered in good condition. The 1933 description and sketch is adequate except that the oak tree mentioned no longer exists. A h- by h-inch white witness post was set 3 feet N of the

BOGUE INLET, COAST GUARD, FLAGPOLE (Carteret County, N.C., K.T.A., 1927; H.F.G., 1950) (Previous descriptions are on pages 1 and 18) -- Station was recovered in good condition. A new description follows .

Station is located at Bogue Inlet Coast Guard Station, approximately midway between the boat storage house and the lookout tower. It is the flagpole atop a steel skeleton tower, with an over-all height of approximately 65 feet.

DUDIEY (Onslow County,N.C.,R.P.S.,1914;H.F.G.,1950)(Previous description is on page 1)--Station was not recovered. The area has changed considerably and neither the description nor the accompanying sketch are adequate for present day recovery. A two-man party searched two hours for the station.

SEL (Onslow County, N.C., R.P.S., 1914; H.F.G., 1950) (Previous description is on page 1)--Station was destroyed, according to the 1933 recovery note.

BANK (Onslow County, N.C., R.P.S., 1914; H.F.G., 1950) (Previous description is on page 2)—Station and reference mark 1 (1933) were recovered in good condition. The 1933 description is adequate. A 4- by 4-inch white witness post projecting 3 feet was set 3 feet N of the station.

BOGUE SOUND BEACON 25 (Onslow County, N.C., C.&G.S., 1933; H.F.G., 1950) (Previous description is on page 2)--Station was destroyed. The beacon was moved.

BOGUE SOUND BEACON 27 (Onslow County, N.C., C.&G.S., 1933; H.F.G., 1950) (Previous description is on page 2) -- Station was recovered in good condition. It was not previously described. A new description follows:

description follows:
 Station is located approximately 1 mile SW of Swansboro, on
the 3 side of the Intracoastal Waterway. It is a three pile,
white slatted structure, surmounted by a black tank house, approximately 16 feet high, with light on top.
 Light List of the Intracoastal Waterway of the United States,
1949 edition, list this light as BOGUE SOUND LIGHT 49. According
to this publication, the light was last rebuilt in 1931.

BOGUE SOUND BEACON 27C (Onslow County, N.C., C.&G.S., 1933; H.F.G., 1950) (No previous description) -- Station was recovered in good condition. According to the Light List, Intracoastal Waterway of the United States, 1949 Edition, this light was last rebuilt in 1932. It is listed as SAUNDERS CREEK LIGHT 55. Description

Station is located approximately 1.5 miles N of Bear Inlet, on the S side of the Intracoastal Waterway at the junction of Saunders Creek. It is a three pile, white slatted structure, 16 feet high, surmounted by a black tank house, light on top.

BOGUE SOUND BEACON NO. 29 (Onslow County, N.C., H.O., 1933; H.F.G., 1950) (Previous description is on page 2) -- Station was destroyed. The beacon was rebuilt.

BOGUE SOUND BEACON NO. 29B (Onslow County, N.C., ,1933; H.F.G., 1950)(No previous description) -- Station was destroyed. The light was rebuilt in 1942.

HAWK (Onslow County, N.C., R.P.S., 1914; H.F.G., 1950) (Previous description is on page 2)--Station and reference mark were recovered in good condition. The description is no longer adequate.

No. 476 Supplement Bogue Inlet to Wrightsville Inlet, North Carolina

A new description follows:
Station is located on an island due S of Shell Landing and S of the spoil bank of the Intracoastal Water, in an abandoned field near the center of the island, 25 feet N of an animal pen, 110 feet E of two lone pines, and 100 feet W of two pines.
Station mark is a standard disk set in concrete in the top of

Station mark is a standard disk set in concrete in the top of a tile. It is not stamped. Reference mark 1 is NW of the station. It is a standard refer-ence disk, stamped "HAWK I 1953," and set in the top of a 10-inch tile projecting 3 inches above ground.

HUGGINS ISLAND (U.S.E.) (Onelow County, N.C., H.O., 1933; H.F.G., 1950) (Previous description is on page 2) -- Station was destroyed. The monument was found broken off and the disk removed. The remainder of the monument is firmly in place. A revised description

Station is located on the N shore of Huggins Island, approximately 325 feet SE of a house in ruins, 225 feet W of the E end of the island, 7 feet SW of the mean high-water line, and 3 feet SW of a 2-foot bank representing storm high-water line.

A 4- by 4-inch white witness post projecting 2 feet above ground was set 3 feet N.

22+ (U.S.E.) (Onslow County, N.C., H.O., 1933; H.F.G., 1950)(Previous description is on page 2)--Station was not recovered. The island on which this station was located is small and a thorough search was made without success.

The description is inadequate for further search.

QUEEN (Onslow County, N.C., R.P.S., 1914; H.P.G., 1950) (Previous description is on page 2) -- Station and reference marks were recovered in good condition. Distances to reference marks were measured and found to be correct. The original description is no longer adequate. A new description follows:

Station is lossted approximately 1.2 miles SW of Swansboro, on the Intracoastal Waterway, approximately 0.2 mile W of Beacon No. 49, 100 feet SE of the SE corner of a two-story frame red roofed house, and N of the mean high-water line.

Reference mark 2 is 93.122 meters NW of the station.

Reference mark 3 is 1/2 mile NW of the station.

Reference mark 4 is 63.140 meters NE of the station.

The old reference mark is 9.935 meters SE of the station.

To reach the station from the schoolhouse in Swansboro, travel NW 0.6 mile to a cross road, turn left (SW) and proceed 1.1 miles to cross road, turn left (S) and proceed 1.0 mile to the road end and station.

The disk is stamped "1914 1932," not "1933."

RUSS 2 (Onslow County, N.C.; H.O., 1933; H.F.G., 1950) (Previous description is on page 2) -- Station and reference mark 1 were not recovered. Reference mark 2 was recovered in condition. Pieces of tile and concrete were found in the approximate position of the station, and it is believed to have been destroyed. An approximate distance of reference mark 1 was ascertained but after a reasonable search, it could not be found. A new description of reference mark 2 follows:

It is located on the W side of Huggins Island, approximately 800 feet S of the N end, 20 feet SW of the edge of an abandoned field, in heavy brush and trees, and approximately 700 feet W of a house. Mark is a standard disk, stamped "2 RUSS 1933," and set in an 8-inch tile projecting 6 inches above ground.

A 4- by 4-inch white witness post was set 3 feet N of the reference mark

BOGUE SOUND BEACON NO. 24 (Onslow County, N.C., H.O., 1933; H.F.G., 1950) (Previous description is on page 2)--Station was destroyed. The light was rebuilt in 1944.

BEACH (Onslow County, N.C., R.P. 3., 1914; H.F.G., 1950) (Previous description is on page 3)--Station was recovered in good condition. The 1933 description is adequate.

A 4- by 4-inch white witness post projecting 3 feet was set 3 feet N of the station.

BEAR (Onslow County, N.C., R.P.S., 1914; H.F.G., 1950) (Previous description is on page 3) --Station and reference mark (1914) SE were recovered in good condition. The 1933 description is adequate with the following additions: 45.0 feet E of the last patch of scrub oak on the point.

A white 4- by 4-inch witness post projecting 3 feet above ground was set 3 feet N of the station.

HAMMOCK (Onslow County, N.C., A.S.W., 1855; H.F.G., 1950) (Previous description is on page 3) -- Station was recovered in good condition. The 1933 description is adequate with the following additions:
To reach station, land at partially ruined pier and proceed du S to the S side of the hammock and the station at the edge of the eed due

SAUNDERS (Onslow County, N.C., R.P.S., 1914; H.F.G., 1950) (Previous description is on page 3)—Station and reference mark were recovered in good condition. A revised description follows:

Station is located approximately 1.5 miles N of Bear Inlet, on the N bank of the Intracoastal Waterway, approximately 350 feet NW of Light 56, 500 feet W of Saunders Creek, and 100 feet NE of a shell beach.

shell beach.

Station mark is a standard disk, stamped "SAUNDERS 1914 1933,"
and set in concrete in a 12-inch tile, projecting 3 inches above

Reference mark 1, 1933, is SW of the station and 10.0 feet N of the mean high-water line. It is a standard disk, stamped (Continued on page 26)

SAUNDERS (continued)
"SAUNDERS NO 1 1933," and set in the top of a 12- by 12-inch concrete monument projecting 2 inches above ground.

CAMP (Onslow County, N.C., R.P.S., 1914; H.F.G., 1950) (Previous description is on page 4) -- No evidence of the station was found. The 1933 recovery states "it has been washed away".

It is recommended that the station be classified as lost.

CAMP 2 (Onslow County,N.C.,H.O.,1935;H.F.G.,1950)(Previous description is on page 4)-The disk and the top portion of the station monument have been destroyed. Only the butt of the monument remains. Reference mark 1 was not recovered and it is probably destroyed due to shore erosion. Reference mark 2 was recovered as described in good condition.

INLET (Onslow County, N.C., R.P.S., 1914; H.F.G., 1950) (Previous description is on page 4) -- This station was reported destroyed in the 1933 recovery note.

INLET 2 (Onslow County, N.C., H.O., 1933; H.F.G., 1950) (Previous description is on page 4) -- station and underground marks were found destroyed by shore erosion. The monuments were found lying in the water's edge. Reference marks 1 and 2 were recovered in good condition as described. A witness post was set 2 feet N of reference mark 2.

MEADOW (Onslow County, N.C., R.P.S., 1914; H.F.G., 1950) (Previous description is on page 4) -- Station and reference mark 1 (1933) were recovered in good condition. The description is inadequate. A new description follows:

Station is located on the N shore of an island-studded bay (first S of Bear Creek), approximately 300 feet N of the Intracoastal Waterway, 250 feet IW of a small shell island in the bay, and approximately 120 feet E of a ruined pier.

Three 2- by 2-inch oak stakes, with nails in the top of each stake, are driven in line from the station to the water.

Station mark is a standard disk set in a 10- by 10-inch block of concrete. A reference mark was established.

Station mark is a standard disk set in a 10- by 10-inch block of concrete. A reference mark was established.

Reference mark 1 is a standard disk set in an 8-inch tile filled with cement. The top of the tile projects 4 inches above ground surface. It is \$ 50 meters from a lone 4-trunk tree with triangular blaze on the S trunk with three nails. Reference mark is \$E 53.545 meters (175.656 feet) from the station mark, and N approximately 8 meters from high-water line.

MILL (Onslow County, N. R. P. S., 1914; H. F. G., 1950) (Previous description is on page 4)—station was recovered in poor condition. The disk has been removed and part of the concrete filling the tile has been dug out. However, the tile is still solidly set and is flush with the ground.

Reference mark 1 1914 was recovered in good condition.

Reference mark 2 1935 could not be found after a reasonable search by a two-man party. However, it is believed to be in position, a further search being deemed impracticable at this time.

The original description is adequate except "inside route canal" should read "Intracoastal Waterway."

BROWN (Onslow County,N.C.,R.P.S.,1914;H.F.G.,1950)(Previous description is on page 5) -- Station was not recovered. This station could not be found in 1927 and 1933. It is recommended that it be classified as lost.

BROWN 2 (Onslow County, N.C., H.O., 1933; H.F.G., 1950) (Previous description is on page 5) -- Station and reference mark were recovered in good condition. The description is adequate. A witness post was set 2 feet N of the station.

EAGLE (Onslow County, N.C., R.P.S., 1914; H.F.G., 1950) (Previous description is on page 5) -- Station and reference marks were recovered in good condition. Revised description follows:

Station is located approximately 1,500 feet NRW of the Intracoastal Waterway, on property of the U.S. Marine Corps, Camp Lejeune. It is best reached from Highway 172 at the entrance to the anti-tank firing range, From the entrance to the anti-tank firing range, From this point there is a wide fire lane leading SE to the marsh edge. Follow this fire lane 0.35 mile to the station located in the SE corner of a small clearing on the SW side of the fire lane. Station is 16 meters SW of the center line of the lane and 1 foot underground. Reference mark 1 (old 1914) was recovered in good condition as described. Reference mark 2, 1933, is NW of the station on the NW edge of the small clearing in the edge of woods.

PIG (Onslow County, N.C., R.P.S., 1914; H.F.G., 1950) (Previous description is on page 5)—Neither station nor reference mark was recovered. A two-hour search by two men revealed no evidence of the monuments. The station site and surrounding area is now used as a target range for heavy artillery.

It is recommended that the station be classified as lost.

STILL (Onslow County, N.C., R.P.S., 1914;H.F.G., 1950) (Previous description is on page 5)—Station and reference marks were recovered in good condition. A revised description follows:
Station is located approximately 1,500 feet NW of the Intracoastal Waterway, in a clump of pine trees, on property belonging to the U.S. Marine Corps, Camp Lejeune. It is best reached from State Highway 172 at the entrance to the anti-tank firing range (marked by U.S. Marine Corps sign). From this entmance, follow the sand road ES 0.4 mile to the SE edge of the range. At this point, follow sand road E 0.5 mile and turn NE. Follow this

meandering road 0.35 mile to station site. It is 9 meters W of the center line of the road and 20 meters NW of the last sharp curve where the road turns NE. This curve is about 0.4 mile W of Still Point.

CEDAR (Onslow County, N.C., R.P.S., 1914; H.F.G., 1950) (Previous description is on page 6)—Station and reference mark were recovered in good condition. The previous description is inadequate. A new description follows:

To reach the station from the intersection of State Highway 172 and the Onslow Beach Road, travel S on Beach road across the Intracoastal Waterway bridge and onto Onslow Beach for 1.7 miles. Go E along beach for 2.2 miles to station site. Station is located on a low sand dume, 310 feet N of the mean high-water line on the ocean side, 245 feet S of a marsh canal, in line with a yellow tower N of the Intracoastal Waterway Canal, and 75 feet N of an abandoned telephone line.

Station mark is a standard disk set in a 6-inch concrete-filled tile projecting 5 inches above ground.

Witness mark is a 4- by 4-inch wooden post projecting 18 inches above ground and 2 feet N of the station.

FREE (Onslow County, N.C.R.P.S., 1914;H.F.G., 1950) (Previous description is on page 6) --Station mark and reference marks 2 and 4 were recovered in good condition. Reference mark 3 was not recovered. The 1914-1933 description is inadequate. A new description follows: To reach the station from the intersection of State Highway 172 and Onslow Beach Road, travel 2.1 miles E along State Highway 172 to a dirt road S. Travel 0.9 mile S along the dirt road to the station site. It is located in a cleared field, 100 feet W of the road, and 150 feet N of the woods line.

Station mark is a standard disk set in concrete 4 inches below the surface of the ground.

A 4- by 4-inch wooden witness post projects 18 inches above ground and is set 2 feet N of the station.

HURST (Ohslow County, N.C., R.P.S., 1914; H.F.G., 1950) (Previous description is on page 6)—Station was not recovered. A search of two hours was made by a three-man party. The reference mark was recovered. The previous description for the recovery of the reference mark is adequate with the following addition: It is located approximately 1.5 miles EME of the Pontoon Bridge across the Intracoastal Waterway canal, 500 feet N of the mean high-water line of canal, and 11.4 feet E of a N-S fence line.

Reference mark is a standard reference disk set in a 6-inch concrete-filled tile pipe projecting 6 inches above ground.

Witness mark is a 4-by 4-inch wooden post 2.5 feet N of the station, and projecting 2 feet above ground.

PIVER (Onslow County, N.C., R.P.S., 1914; H.F.G., 1950) (Previous description is on page 6) --Station was recovered in good condition. Reference mark was not recovered. It is believed to have been destroyed by erosion. The previous description is inadequate. A new description follows:

To reach the station from the intersection of State Highway 172 and Onslow Beach Road, travel S along Beach Road across the Intracoastal Waterway Bridge and onto Onslow Beach. Go E along the sand ridge which separates the ocean and the marsh, 2,300 feet ENE of a concrete pillbox built in the sand ridge along the oceanside, 212 feet N of the ocean mean high-water line, 200 feet S of the S edge of the marsh, 102 feet N of an abandoned telephone line. Station mark is a standard disk set in an 8-inch concrete-filled tile projecting 12 inches above ground.

Station is witnessed by a 4- by 4-inch wooden post projecting 4 feet above ground and 3 feet N of the station.

POINT (Onslow County, N.C., R.P.S., 1914; E.R.McC., 1950) (Previous description is on page 6)—Station and reference mark were recovered in good condition. The previous description is adequate with the following additions: To reach the station from the intersection of State Highway 172 and the Onslow Beach Road, travel S along the Beach Road for 1.1 miles to a sand road E, take this road E for 0.3 mile to road intersection, go S along the road to the Intracoantal Waterway Canal, thence walk E along the canal for approximately 0.5 mile to a prominent point of woods and station site. Station is located 25 feet N of the mean high-water line at the SE edge of the point of Woods. noint of woods.

WINDY (Onslow County, N.C., R.P.S., 1914; H.F.G., 1950) (Previous description is on page 6) -- Station was not recovered. It was probably destroyed by shifting sand dunes.

HORSEHEAD (Onslow County,N.C.,A.W.S.,1855;E.R.McC.,1950)(Previous description is on page 7)-Station was not recovered. The 1914 description is inadequate. A one-hour search was made by two men and no evidence of the station could be found.

It is recommended that this station be classified as lost.

LOW (Onslow County, N.C., R.P.S., 1914; E.R.McC., 1950) (Previous description is on page 7) -- Station was not recovered. A thorough search was made to no avail. It is believed that the station was destroyed by erosion.

It is recommended that the station be classified as lost.

PINE (Onslow County, N.C., R.P.S., 1914; H.F.G., 1950) (Previous description is on page 7)—Station and reference marks were recovered in good condition. The previous description is adequate with the following addition. To reach the station from the intersection of Onslow Beach Road and State Highway 172, travel 1.4 miles along Onslow Beach Road to the bridge across the Intracoastal Waterway canal and station site. It is located 379.0 feet N of the N end of the bridge, 215.2 feet E of the center line of Beach Road, 23.5 feet E of a 12-inch cedar tree (the only one in the vicinity).

Station mark is a standard disk, unstamped, and set in a 6-inch (Continued on page 27)

UNITED STATES COAST AND GEODETIC SURVEY Descriptions of Triangulation Stations

PINE (continued) concrete-filled tile pipe projecting 3 inches above ground. Witness mark is a 4- by 4-inch wooden post set 2 feet station and projecting 18 inches above the ground. feet N of the

SANDY (Onslow County, N.C., R.P.S., 1914; H.F.G., 1950) (Previous description is on page 7)—Station was recovered in good condition. The 1914 description is inadequate. A new description follows:

To reach from the intersection of State Highway 172 and Onslow Beach Road, travel S on Onslow Beach Road for 1.7 miles across the bridge over the Intracoastal Waterway to the intersection of a sand road, go E along the sand road for 0.45 mile to the station site. Station is located on the top of a high sand dune, 80 feet S of the center line of the sand road, 300.2 feet E of the NE corner of a green stucco bathhouse, 200 feet SE of the intersection of the main road and a field road N, and 24 feet N of the mean high-water line.

Station mark is a standard disk set in a 6-inch concretefilled tile pipe projecting 5 inches above ground.

Witness mark is a 4- by 4-inch white wooden post, set 2 feet N of the station, and projecting 18 inches above ground.

WEEK (Onslow County, N.C., R.P.S., 1914; H.F.G., 1950) (Previous description is on page 7)—Station and reference marks were recovered in good condition. The previous description is adequate with the following additions:

To reach the station from the intersection of State Highway 172 and Onslow Beach Road, travel S on Beach Road for 1.1 miles to the sand road E. Go E along the sand road for 0.3 mile to a road intersection, thence S along sand road to the bank of the Intracostal Waterway Canal and the station site. It is located approximately 225 feet N of the mean high-water line and 30 feet W of the road.

BAKER (Onslow County, N.C., R.P.S., 1914; H.F.G., 1950) (Previous description is on page 8)—station and reference mark were recovered in good condition. The previous description is adequate with the following addition:

To reach the station from the intersection of State Highway 172 and Mockup Road, travel S one mile along Mockup Road to a cleared field and the station site. It is located approximately 1,200 feet N of the Intracoastal Waterway Canal, 207.4 feet E of the center line of the road.

Station mark is a standard disk, stamped "BAKER 1933," and set in a 12-inch concrete-filled tile pipe projecting 6 inches above ground.


Witness mark is a 4- by 4-inch wooden post 2 feet N of the station and projecting 18 inches above ground.

CROSS (Onslow County, N.C., R.P.S., 1914; H.F.G., 1950) (Previous description is on page 8) -- Station was not recovered. It was reported destroyed in 1933.

GILLETTS CREEK (Onslow County, N.C., A.S.W., 1855; H.F.G., 1950) (Previous description is on page 8)-Station was not recovered. A search was made and it could not be found. It is recommended that the station be classified

PASS (Onslow County, N.C., R.P.S., 1914; E.R.McC., 1950) (Previous description is on page 8)—Station was not recovered. A detailed search was made by two men. In the immediate vicinity, there has been considerable erosion. It is recommended that the station be classified as lost.

SNAG (Onslow County, N.C., R.P.S., 1914; H.F.G., 1950) (Previous description is on page 8) -- Station was not recovered. The 1935 description reported the station as lost. A thorough search was made to no avail. It is recommended that the station be classified as lost.

SWAMP (Onslow County, N.C., R.P.S., 1914; H.F.G., 1950) (Previous description is on page 8) --Station and reference marks were not recovered after a detailed search by three men. The area is heavily wooded, the field and road referred to in the 1933 description having been allowed to overgrow are no longer recognizable on the argument. on the ground.

BAY (Onslow County, N.C., R.F.S., 1914; H.F.G., 1950) (Previous description is on page 9) -- Station and reference marks were recovered in good condition. The previous description is adequate with the following additions:

Station is located on the property of Camp Lejeune (U.S.M.C.) on the N edge of Salliers Bay, in marsh, 1,200 feet W of the mouth of Holover Creek, 728.0 feet S of the woods line, 20.0 feet W of a small slough, and 30 feet N of the mean high-water line of the Bay.


Station mark is a standard disk, unstamped, and set in the top of an 8-inch concrete-filled tile pipe projecting 5 inches

above ground.
Witness mark is a 4- by 4-inch wooden witness post set 2.0 feet N and projecting 18 inches above ground.

BRIER (Onslow County, N.C., R.P.S., 1914; H.F.G., 1950) (Previous description is on page 9)—Station was not recovered. A thorough search of one hour was made by a three-man party. It is recommended that the station be classified as lost.

CRAG (Onslow County, N.C., R.P.S., 1914; H.F.G., 1950) (Previous description is on page 9) -- Underground mark was recovered. Station mark and reference mark were destroyed. Previous description

No. 476 Supplement Bogue Inlet to Wrightsville Inlet, North Carolina

is inadequate. A new description follows:
Station is located on the property of Camp Lejeune (U.S.M.C.)
on Crag Point. To reach from the intersection of Onslow Beach Road
and State Highway 172, travel W along Highway 172 for 2.0 miles to
a sand road S (left), take sand road for 1.4 miles to a cluster of
large oak trees and road fork. Take left fork for 0.5 mile to a
large cleared field and station site. Station is located 240.1 feet
NE of the SW corner of the woods, 210 feet SE of the NW corner of
the woods, and 84.3 feet E of the center line of the sand road.
Station mark is a standard disk, unstamped, and set in a 6-inch
concrete-filled tile pipe 3 feet below the surface of the ground.

DUCK CREEK (Onslow County, N.C., C.D.M., 1932; E.R.McC., 1950) (Previous description is on page 9)—Station and reference marks were recovered in good condition. The 1932 description is inadequate. A new description follows:

To reach from the intersection of State Highway 172 and Onslow Beach Road, travel SE along State Highway for 0.5 mile to an improved sand road leading W, travel W along the sand road for 0.7 mile to the station site. It is located on what is known locally as Frank Dennis' property but is now owned by U.S. Government (Camp Lejeune), in a clump of trees along the SE side of a cleared field, 36 feet N of the center line of the road, 214 feet SSE of the foundation ruins of Frank Dennis' house.

Reference mark 1 is N of the station at the SW corner of the foundation ruins of Frank Dennis' house.

Reference mark 2 is SE of the station in cut-over timber land, 45 feet S of the center line of the road.

Reference mark 3 is approximately 0.25 mile W of the station on the N edge of a small cleared field, 188.4 feet N of the center line of the road leading past the station.

HENDERSON (Onslow County, N.C., R.P.S., 1914; H.F.G., 1950) (Previous description is on page 9)--Station was not recovered. It was reported as "probably destroyed when the new waterway was cut" in 1935.

It is recommended that the station be classified as lost.

HIGH (Onslow County, N.C., R.F.S., 1914; H.F.G., 1950) (Previous description is on page 9) -- Station was not recovered. The description states that it was not marked. It is recommended that this station be classified as lost.

NORTHEAST BASE (Onslow County, N.C., R.P.S., 1914; E.R.McC., 1950) (Previous description is on page 9)--Station was not recovered. It was marked by a 4- by 4-inch pine post in 1914. A one-hour search by two men was made and no evidence of its existence could be found. It is recommended that the station be classified as lost.

SEA (Onslow County, N.C., R.P.S., 1914; H.F.G., 1950) (Previous description is on page 9) -- Station was recovered in good condition. The previous description is inadequate. A new description follows:
To reach from the intersection of State Highway 172 and the Onslow Beach Road, travel 1.7 miles 3 on Onslow Beach Road across the pontoon bridge over the Intracoastal Waterway Canal to an intersecting sand road, and go W along the sand road 2.0 miles to the station site.

Station is located on top of a high sand dune, 298 feet SW of an unnumbered telephone pole, 220.7 feet 3 of another telephone pole, 200 feet N of the mean high-water line, and 190 feet S of the center line of a sand road which parallels the telephone line.

Station mark is a standard disk, stamped "SEA," and set in a 6-inch concrete-filled tile pipe projecting 6 inches above ground.

Witness mark is a 4- by 4-inch wooden post, 2 feet N of the station, and projecting 18 inches above ground.

SHELL (Onslow County, N.C., R.P.S., 1914; H.F.G., 1950) (Previous description is on page 9) --Station was not recovered. A detailed search was made to no avail. It is recommended that the station be classified as lost.

SOUTHWEST BASE (Onslow Co.N.C.,R.P.S.,1914;E.R.McC.,1950)(Previous description is on page 9)—Station was not recovered. The station was marked by a 4- by 4-inch pine post in 1914. A thorough search was made but no evidence of the station could be found. It is recommended that the station be classified as lost.

TIE (Onslow County, N.C., R.P.S., 1914; E.R.McC., 1950) (Previous description is on page 9) -- Station was not recovered. It is believed that it was destroyed due to excavation in the immediate area. It is recommended that the station be classified as lost.

VIM (Onslow County, N.C., A.P.R., 1932; E.R.McC., 1950) (Previous description is on page 9) -- Station was recovered in good condition. The previous description is inadequate. A new description follows:

To reach the station from the intersection of State Highway 172 and the Onslow Beach Road, travel 1.7 miles S on Onslow Beach Road across the bridge over the Intracoastal Waterway Canal to an intersecting sand road, travel 2.55 miles W on sand road to station site. It is located approximately 225 feet inshore from the main ridge of sand dunes, and on the summit of the W of two prominent dunes, 81.0 feet W of the sand road which separates the two sand dunes, and 73.2 feet SW of a telephone pole.

Station mark is a standard disk, stamped "VIM 1914," and set in an 8-inch concrete-filled tile pipe projecting 5 inches above ground.

ground. Witness mark is a 4- by 4-inch white wooden post, 2 feet N of the station, and projecting 18 inches above ground.

WILLIAMS (Onslow County, N.C., R.P.S., 1914; H.F.G., 1950) (Previous description is on page 9)—Station and reference mark were recovered in good condition. The preveious description is inadequate. A new description follows:

Station is located on the property of Camp Lejeune (U.S.M.C.) on the N side of the Intracoastal Waterway Canal, in woods line at the N edge of the marsh, approximately 3.0 miles NE of New River Inlet, approximately 2.0 miles W of the Onslow Beach Road Pontoon Bridge which crosses the Intracoastal Waterway Canal, and 424.0 feet N of the mean high-water line of the canal.

Station mark is a standard disk, unstamped, and set in a 6-inch concrete-filled tile pipe projecting 3 inches above the ground.

Witness mark is a 4- by 4-inch wooden post, 2.0 feet N of the station, and projecting 18 inches above ground.

AMOS (Onslow County, N.C., A.P.R., 1932; H.F.G., 1950) (Previous description is on page 10) -- Station was recovered in good condition. The 1932 description is inadequate. A new description fol-

lows:
To reach from the intersection of State Highway 172 and Onslow Beach Road, travel 1.7 miles S on Beach Road across the bridge over Intracoastal Waterway Canal to an intersecting sand road. Travel 4.5 miles W along the sand road to the station site. It is located on the summit of a dune which is N of the sand ridge which parallels the ocean, 141 feet SE of a telephone line, 82 feet SE of the sand road, 220 feet N of the mean high-water line, 100 feet S of myrtle bushes on the edge of the marsh, and approximately 0.6 mile NE of New River Inlet.

Reference mark 1 is believed lost due to erosion.

Reference mark 2, located NE of the station, was recovered in good condition.

in good condition: Station mark is a standard disk, stamped "AMOS 1932," and set in concrete in the top of a tile pipe embedded 5 inches below the

Surface of the ground.

Witness mark is a 4- by 4-inch wooden post, 2 feet N of the station, and projecting 18 inches above the ground.

CEDAR POINT (Onslow County, N.C., R.P.S., 1914; H.F.G., 1950) (Previous description is on page 10)—Station and reference mark were recovered in good condition. The previous description is adequate with the following additions:

Station is located on the SE side of a small point known locally as "Shell Point," approximately 1,100 feet E of Cedar Point on the N bank of Howard Bay, 13.2 feet N of the mean highwater line, and in the edge of the woods.

Station mark is a standard disk, unstamped, and set in a 12-inch concrete-filled tile pipe projecting 12 inches above ground.

A 4- by 4-inch wooden witness post projecting 18 inches was set 2 feet N.

FISH (Onslow County, N.C., A.P.R., 1932; H.F.G., 1950) (Previous descriptions are on pages 10 and 19) -- Station and reference mark 2 were recovered in good condition. Reference mark 1 was found lying on its side.

The 1947 description is adequate with the following addition: Witness mark is a 4-by 4-inch wooden witness post, 2 feet S of the station, and projecting 18 inches above the ground.

GRANT (Onslow County, N.C., R.P.S., 1914; H.F.G., 1950) (Previous descriptions are on pages 10 and 20)--Station and reference marks 1 and 2 were recovered in good condition. The original description is adequate.

LIGHTER (Onslow County, N.C., A.S.W., 1855; H.F.G., 1950) (Previous description is on page 10) -- Station was not recovered. A thorough search of one hour was made by a three-man party. It is recommended that the station be classified as lost.

LOG (Onslow County, N.C., R.P.S., 1914; H.F.G., 1950) (Previous descriptions are on pages 10 and 19)—Station was lost. The mark was found lying in the sand and out of position. Reference mark 1 could not be found and is believed to be lost. Reference mark 2 was found in good condition. Witness mark is a 4- by 4-inch wooden post, 2 feet N of the station, and projecting 18 inches.

NORTH BASE (U.S.E.) (Onslow County, N.C., A.P.R., 1932; H.F.G., 1950) (Previous description is on page 10) -- Station was recovered in good condition. The previous description is inadequate. A new description follows:
Station is located 0.8 mile SE of the E end of Peru Road, 0.5 mile SW of Cedar Point, on the W side of the channel of New River Inlet, 75 feet S of New River Inlet Light No. 5, and 12.2 feet E of the mean high-water line.

Station mark is a standard U.S.E. disk, unstamped, set in the center of a 3- by 3 foot concrete monument, and set on five 2-inch pipes projecting 5 feet above mean high-water line.

PAVILION (Onslow County, N.C., R.P.S., 1914; H.F.G., 1950) (Previous description is on page 10) -- Station was not recovered after a thorough search. It is recommended that this station be classified as lost.

SMITH'S HOUSE, CUPOLA (Onslow County, N.C., R.P.S., 1914; H.F.G., 1950) (Previous description is on page 10) -- Station was destroyed. The property is now owned by Camp Lejeune (U.S.M.C.) and the house has been torn down.

SOUTH BASE (U.S.E.) (Onslow County, N.C., A.P.R., 1932; H.F.G., 1950) (Previous description is on page 10)—Station was not recovered. The previous description is inadequate. A thorough one-hour search was made by a three-man party and the station could not be found. It is recommended that the station be classified as lost.

SWAN POINT (U.S.E.) (Onslow County, N.C., U.S.E., 1914; H.F.G., 1950) (Previous descriptions are on pages 10 and 19) -- Station was destroyed. The remains of the station were found lying on the beach. The reference mark was not recovered. It is believed to have been destroyed, since there has been considerable erosion in the immediate vicinity.

SMAN POINT ECCENTRIC (Onslow County, N.C., C.D.M., 1932; H.F.G., 1950) (Previous descriptions are on pages 10 and 19) -- Station was not recovered. Reference marks 1 and 2 were recovered in good condition. The distance was measured from the reference marks and a house has been built over the station. The 1947 description is adequate with the following additions:

Reference mark 1 is located 208.2 feet N of the center line of the road, 100.4 feet N of the SW corner of the new house.

Reference mark 2 is 88.0 feet E of the SE corner of the house.

TILE (Onslow County, N.C., R.P.S., 1914; H.F.G., 1950) (Previous description is on page 10) -- Station was not recovered after a detailed search by two men. It is recommended that this station be classified as lost.

VIEW (Onslow County, N.C., A.P.R., 1932; H.F.G., 1950) (Previous descriptions are on pages 10 and 19) -- Station and reference marks 1 and 2 were recovered in good condition. The 1947 description is

adequate.

A 2- by 4-inch wooden post witnesses the station. It is 2 feet N and projects 5 feet above ground.

WRECK (Onslow County, N.C., R.P.S., 1914; H.F.G., 1950) (Previous description is on page 10) -- A detailed search was made and the station could not be found. The shoreline has receded considerably since the 1926 recovery and the station is believed to have been washed out.

It is recommended that this station be classified as lost.

WRIGHTS ISLAND (U.S.E.) (Onslow County, N.C., R.P.S., 1914; H.F.G., 1950) (Previous description is on page 10) -- Station was not recovered. A search was made and it could not be found. It is recommended that the station be classified as lost.

BETHEA (Onslow County, N.C., C.D.M., 1932; H.F.G., 1950) (Previous descriptions are on pages 11,20, and 21)—Station and reference marks were recovered in good condition. The distances to the reference marks were measured and found to be correct. The 1947 description is adequate.

CRAB (Onslow County,N.C.,R.P.S.,1914;H.F.G.,1950)(Previous descriptions are on pages 11 and 20)--Station was recovered in good condition. The 1947 description is adequate. Witness mark is a 4- by 4-inch wooden post, 2 feet S, and projecting 2 feet above ground.

The observing stand used in 1947 was found intact.

GOOSE BAY (Onslow County, N.C., R.P.S., 1914; H.F.G., 1950) (Previous description is on page 11)--Station recovered in poor condition. The water line of Goose Bay has reached the base of the station and the earth is washing away. The station may be washed out in the near future. The 1914, 1935 description is adequate.

GRANT (Onslow County, N.C., D.M., 1932; H.F.G., 1950) (Previous descriptions are on pages 11 and 20)—station and reference marks 1, 2, and 3 were recovered. Station mark and reference marks 2 and 3 are in good condition. Reference mark 1 is resting on an angle as stated in the 1947 recovery. The 1947 description is adequate with the following addition. Station is 65 feet SW of the main dirt road which is State Highway 301.

Witness mark is a 4 - by 4-inch wooden post set 2 feet E and projecting 2 feet above ground.

GROVE (Onslow County, N.C., R.P.S., 1914; H.F.G., 1950) (Previous description is on page 11) -- Station was not recovered. Reference mark was recovered in good condition. The distance to the station was measured and the blazed pine tree mentioned in the description was found but the station was not. The 1914 description is adequate for the recovery of the reference mark.

HOBBS (Onslow County, N.C., R.P.S., 1914; H.F.G., 1950) (Previous description is on page 11)—Station was recovered in good condition. The reference mark could not be found after a detailed search. The 1914-1932 descriptions are correct.

Station may be reached by land. From the Folkstone Post Office, travel 2.6 miles E on the dirt road to road right (3). Proceed 2.6 miles to the end of the road and station site.

Witness mark is a 2-inch pipe, 1 foot W, and projecting 3 feet above the marsh.

KING (Onslow County, N.C., R.P.S., 1914; H.F.G., 1950) (Previous description is on page 11) -- Station was destroyed. The mark was found lying overturned in the marsh. The disk had been removed.

MUSH (Onslow County, N.C., R.P.S., 1914; H.F.G., 1950) (Previous descriptions are on pages 11 and 20)—Station was recovered in good condition. The 1947 description is adequate.
Witness mark is a 4- by 4-inch wooden post, 1 foot E, and projecting 2 feet above ground.

PED (Onslow County, N.C., J.A.B., 1933; H.F.G., 1950) (Previous descriptions are on pages 11 and 21) -- Station and reference mark 1 (Continued on page 29)

UNITED STATES COAST AND GEODETIC SURVEY Descriptions of Triangulation Stations

reD (continued)
were recovered in good condition. The 1947 description is adequate except that the station is located in Onslow County, not Pender. Reference mark 2 is leaning.
Witness mark is a 4- by 4-inch wooden post, 2 feet NE, and projecting 2 feet above ground.

ROGER (Onslow County, N.C., R.P.S., 1914; H.F.G., 1950) (Previous description is on page 11) --Station was not recovered after a detailed search. As it was not recovered in 1926 and 1933, it is recommended that this station be classified as lost.

ROUGH (Onslow County, N.C., R.P.S., 1914; H.F.G., 1950) (Previous description is on page 11)--Station could not be found after a detailed search. There are shifting sand dunes in this vicinity and the station, if still in existence, is probably covered. It is recommended that this station be classified as lost.

STUMP (Onslow County, N.C., R.P.S., 1914; H.F.G., 1950) (Previous description is on page 11) -- Station was, not recovered after a detailed search. As it was not recovered in 1926 and 1933, it is recommended that this station be classified as lost.

BANKS (Onslow County, N.C., J.A.B., 1933;H.F.G., 1950) (Previous descriptions are on pages 12, 18, and 21)--station and reference mark were recovered in good condition. The distance to the reference mark was found to be correct. The 1947 description is adequate except that the station is located in Onslow County, not Pender.

SPY (Onslow County, N.C., R.P.S., 1914; N.P.C., 1950) (Previous description is on page 12)—Station was not recovered. It is believed to be covered by shifting sand. As it was not recovered in 1926 and 1933, it is recommended that this station be classified as

CAMP DAVIS TANK NO. 1 (Onslow County, N.C., H.C.A., 1943; H.F.G., 1950) (Previous description is on page 17) -- Station was destroyed. The tank has been dismantled.

CAMP DAVIS TANK NO. 2 (Onslow County, N.C., H.C.A., 1943; H.F.G., 1950) (Previous description is on page 17) -- Station was destroyed. The tank has been dismantled.

CAMP DAVIS TANK NO. 3 (Onslow County, N.C., H.C.A., 1943; H.F.G., 1950) (Previous description is on page 17) -- Station was destroyed. The tank has been dismantled.

CAMP DAVIS TANK NO. 4 (Onslow County, N.C., H.C.A., 1943; H.F.G., 1950) (Previous description is on page 17) -- Station was destroyed. tank has been dismantled.

3-(3-4) (U.S.E.) (Onslow County, N.C., U.S.E., 1933; H.F.G., 1950) (Previous description is on page 17)--Station was not recovered. A thorough search was made but it could not a found.

3-3-151 (U.S.E.) (Onslow County, N.C., U.S.E., 1933; H.F.G., 1950)
(Previous description is on page 17)--Station was recovered in good condition. No description was available. Description follows: Station is located about 5 miles W of New River Inlet, in the Intracoastal Waterway, on the W side of Alligator Bay. It is 90 feet W of the point of land and 14 fee N of the high water line of the Intracoastal Waterway.

Station mark is a standard U.S.E. disk, stamped "151," and set in a 6-inch concrete-filled tile projecting 4 inches above ground.

3-3-182 (U.S.E.) (Onslow County, N.C., U.S.E., 1933; H.F.G., 1950) (Previous description is on page 17)-No description was available. A thorough search was made by two men in the vicinity of the plotted position but the station could not be found.

3-3-216+ (U.S.E.) (Onslow County, N.C., U.S.E., 1933; H.P.G., °
1950) (Previous description is on page 17)--Station was recovered
in good condition. The previous description is not available. A
complete description follows:

Station is located on the N bank of the Intracoastal Waterway
and the E shore of Goose Bay, 59 feet E of the mean high-water
line of Goose Bay, 13.2 feet N of the mean high-water line of the
Intracoastal Waterway.

Station mark is a standard U.S.E. disk, unstamped, and set
in a 6-inch round concrete-filled tile pipe projecting 4 inches.

3-3-247+ (U.S.E.) (Onslow County, N.C., U.S.E., 1933; H.F.G., 1950) (Previous description is on page 17) -- Station was destroyed. The mark was found lying on its side.

3-4-8+ (U.S.E.) (Onslow County, N.C., U.S.E., 1933; H.F.G., 1950)
(Previous description is on page 17)--Station was not recovered. A thorough search was made by two men, but station could not be found.

3-4-140+ (U.S.E.) (Onslow County, N.C., U.S.E., 1933; H.F.G., 1950) (Previous description is on page 17) -- Station was destroyed. The remains were found lying on the ground.

No. 476 Supplement Bogue Inlet to Wrightsville Inlet, North Carolina

SMAN POINT 2 (Onslow County, N.C., M.C.H., 1888; H.F.G., 1950) (Previous description is on page 17) -- Station was not recovered. Anthorough search of one hour was made by a three-man party but the station could not be found. It is recommended that this station be classified as lost.

LOG 2 (Omslow County, N.C., C.R.R., 1947;H.F.G., 1950) (Previous description is on page 19)-station and reference marks were recovered in good condition. The 1947 description is adequate, with the following additions:

Station is witnessed by a 7-inch round wooden post, 2 feet SE, and projecting 2 feet above ground.

Reference mark 2 is witnessed by a 4- by 4-inch wooden post, 1 foot SW, and projecting 2 feet above ground.

Reference mark 3 is witnessed by a 7-inch round wooden post, 2 feet W, and projecting 30 inches above ground.

RANGE THREE (Onslow County, N.C., C.R.R., 1947; H.F.G., 1950) (Previous description is on page 19) -- Station was recovered in good condition. The observation tower is lying on its side and is in partial ruins. Otherwise, the description is adequate.

TOWER NIME (Onslow County, N.C., C.R.E., 1947; H.F.G., 1950) (Previous description is on page 19) -- Station and reference ma 's were recovered in good condition. The description is adequate.

RANGE TWO (Onslow County, N.C., C.R.R., 1047; H.F.G., 1950) (Previous description is on page 20) - Station recovered in good condition. The description is adequate, with the following addi-

Witness mark is a 4- by 4-inch wooden post, 2 feet E, and projecting 2 feet above ground.

TOWER SEVEN (Onslow County, N.C., C.R.R., 1947; H.F.G., 1950) (Previous description is on page 20)--station and reference mark were recovered in good condition. The description is adequate.

TOMER EIGHT (Onslow County, R.C., C.R.R., 1947; H.P.G., 1950) (Previous description is on page 20)—This tower has been remodeled into a beach club, a roof being added and a one-story structure to its rear. The disk was not visited, as the owner could not be found. It is believed to be intact, however. Reference mark 1 is covered by a one-story addition. The original description is sdequate for reaching the station.

TOWER SIX (Onslow County, N.C., C.R.R., 1947; H.F.G., 1950) (Previous description is on page 21)—The building on which the station is located is now privately owned and the roof was not accessible but it is believed to be intact. Reference mark'l is covered by an addition to the tower.

camp IEJEUNE, ARKA 1, WATER TANK (Onslow County, N.C., H.F.C., 1950) -- Station was recovered in good condition. No description is available. A complete description follows:
Station is located in Camp Lejeune in the Women's Reserve Area, approximately 100 feet N of Service Road, and approximately 150 feet NW of the intersection of Service Road and Virginia Dare Drive. Station is the center of a skeleton steel water tank 150 feet high and painted green.

CAMP LEJEUNE, AREA 5, WATER TANK (Onslow County, N.C., H.F.G., 1950) --Station was recovered in good condition. No description is available. A complete description follows:
Station is located in Camp Lejeune, approximately 350 feet N of Service Road and Louis Road. Station is the center of a skeleton steel water tank 150 feet high and painted green.

CAMP LEJEUNE, PARACHUTE TOWER 2 (Onslow County,N.C.,H.F.G., 1950) -- Station was recovered in good condition. No description is available. Bescription follows:

Station is located in the Parachute Training Area of Camp Lejeune, approximately 0.5 mile W of the intersection of Parachute Tower Road and Holcomb Boulevand. It is the most E of two skeleton steel parachute jump towers. It is 260 feet high.

CAMP LEJEUNE, PARACHUTE TOWER 3 (Onslow County, N.C., H.F.G., 1950) -- Station was recovered in good condition. No description is

available. Description follows:
Station is located in the Parachute Training Area of Camp Le-jeune, approximately 1.0 mile W of the intersection of Parachute Tower Road and Holcomb Boulevard. It is the most W of the two skeleton steel parachute jump towers. It is 260 feet high.

CAMP LEJEUNE, RED AND WHITE WATER TANK (Onslow County, N.C., H.F.G., 1950) --Station was recovered in good condition. No description is available. Description follows:

Station is located at Camp Lejeune (U.S.M.C.), at the NE corner of the intersection of Cecil Street and St. Mary Drive. It is the center of a large red and white checkerboard steel tank approximately 165 feet high.

CAMF IEJEUNE, RIFIE RANGE NO. 2, WATER TANK (Onslow County, N.C., H.F.G., 1950) - Station was recovered in good condition. No description is available. Description follows:

Station is located on the E side of New River, at the SW corner of Camp Lejeune Rifle Range No. 2. It is the center of a large green water tank on skeleton steel legs and approximately 150 feet high.

FIRE TOWER NO. 2 (Onslow County, N.C., H.F.G., 1050) -- Station was recovered in good condition. Description follows:
Station is the center of a 135-foot steel skeleton tower painted green. It is located on the N bank of New River, 2,400 feet N of the center of the New River Bridge (Sneads Ferry), and 250 feet E of State Highway 172.

MONUMENT 371 (U.S.M.C.) (Onslow County,N.C.,H.F.G.,1950) -- Station was recovered in good condition. No previous description is available. Description follows:

Station is located at Camp Lejeune (U.S.M.C.) on Hadnot Point, 68.0 feet back from the extrently of the point, 25.5 feet S of line oak tree on point, 5.4 feet N of the E end of the concrete sea wall, 9.1 feet N of the mean high-water line, and 68.0 feet E of the W end of the concrete sea wall.

Station mark is a nail in the center of an 8- by 8-inch concrete monument set 2 inches below the surface.

NEW RIVER LIGHT 70 (Onslow County, N.C., H.F.G., 1950) -- Station is located on the E side of the Intracoastal Waterway Channel in New River. It is a red triangular daymark on a slatted pile structure.

New New River Light 70 Intracoastal Water Way Land

SPRING 2 (U.S.E.) (Onstow County, N.C., H.F.G., 1950) -- Station was recovered in fair condition. A revised description follows:

Station is located on the W side of New River, on the wooded point known as Spring Point, which is the first prominent point on the W side of the river 3 of Town Point.

Station mark is a concrete monument projecting 2 feet above the ground (now loose), approximately 3 meters E of a 20-foot bluff, and I meter outside the mean high-water line.

To reach the station from the post office in Verona, travel 3 2.8 miles to a T-road left (E), turn left and proceed 4.1 miles to a dirt road leading E, and follow the dirt road to Spring Point and station site.

and station site.

Computations show that this station is not in the same posi-tion as the old station SPRING (U.S.E.), therefore, the name has been changed to SPRING 2 (U.S.E.).

BEACON NO. 31 (Onslow County, N.C., J.A.B., 1933;1950) (No pre-vious description) -- Report from Notice to Mariners No. 44 dated November 4, 1950: Beacon No. 31 renamed Topsail Sound Light 83 has been

destroyed.

SEARS (Pender County, N.C., H.C.A., 1943; D.A.J., 1954) (Previous description is on page 18)—The subsurface station mark was recovered, but the surface mark was gone. Reference marks 1 and 2 were recovered and found in good condition. Due to highway construction, a new station, SEARS 2, and reference marks 3 and 4 were established. The 1943 description is adequate with the following exceptions: exceptions:

Exceptions;
The Sears Landing Tank, which was used for the azimuth mark, has been destroyed, and the village of Sears Landing has been renamed Surf City.

SEARS 2 (Pender County, N.C., D.A., J., 1954) --Station is located about 1-1/2 mi. W of the viliage of Surf City, 80 yds. SW of the SW end of a drawbridge, and on the S side of Topsail Road. It is 72 ft. S of the centerline of Topsail Road, and 50 ft. N of the high-waterline. The mark projects 6 in., and the disk is stamped "SEARS 2 BY STATES 2 1954" (note la).

Reference mark 3 is 75 ft. S of the centerline of Topsail Road, and 55 ft. N of the high-waterline. The mark projects 6 in., and the disk is stamped "SEARS 2 RN 3 1954" (note lla).

Reference mark 4 is 85 ft. S of the centerline of Topsail Road, and 50 ft. N of the high-waterline. The mark projects 6 in., and the disk is stamped "SEARS 2 RN 4 1954" (note lla).

To reach the station from the SW end of the village of Surf City, go SW on Topsail Road for 2.0 mi. to a drawbridge and the station as described.

A traverse connection was made from station SEARS to station SEARS 2, and the distance is 44.30 ft. or 13.502 m.

DISTANCE

DISTANCE

DISTANCE

DIRECTION

SEARS

DIRECTION

SEARS

DIRECTION

DIRECTION 0°00'00"0 104 22 17 271 42 11 OBJECT DISTANCE
SEARS meters feet
R.M. 3 E 12.280 40.29
R.M. 4 W 11.550 37.89
Height of instrument above station mark - 1 m.
Height of light above station mark - 1 m.

VARIOUS STATIONS (Onslow County, N.C., A.P.R.-C.R.R., 1932-47; U.S.M.C., 1957)-Report of 2d Topo Co., Fleet Marine Force, Atlantic, Camp Lejeune, North Carolina, dated 26 August 1957; The following stations were recovered; FISH -- see pages 10, 19 and 28. TOWER NIME -- see pages 19 and 29. VIEW -- see pages 10, 19 and 28.