

**VALUABLE**

SUBJECT

*Stone Street Extension*

*River Drive to Brewster Blvd.*

*Length 2.15 mi.*

RETURN TO  
PUBLIC WORKS  
OFFICE  
CAMP LEJEUNE  
NORTH CAROLINA


FIELD PARTY  
*Turlington*  
IN CHARGE  
INSTRUMENT  
NOTES  
TAPE READ  
TAPE OR ROD  
TAPE OR ROD  
INSTRUMENT NO.  
TAPE NO.

WEATHER  
CLEAR  
CLOUDY  
WINDY  
RAIN  
FAIR  
SNOW  
HOT  
MODERATE  
COLD  
FOG  
FIGURED BY  
NOTES CHECKED BY  
PLOTTED BY

FILE No. *139-6cu*  
FLDR. No.  
SHEET *1-16*  
DATE *10/15/1947*  
Quad. No. *139-120-140*

STATION	DIST.	ANGLE ° ' "	+	H. I. BEARING	VER: ANG. DIFF.	ELEVATION
17		2° 03' 14"				
+50		1° 44' 17"				
16		1° 25' 20"				
+50		1° 06' 23"				
15		0° 47' 26"				
+50		0° 28' 29"				
14		0° 09' 32"				
+74.84 P.C.		00° 00'				
13						
12						
11						
10						
9						
8+41.74						
<i>Stone St. = 15+45.25 Bevin St.</i>						
<i>0+00 River Drive</i>						


*MON. #164  
Elev. 23.42*

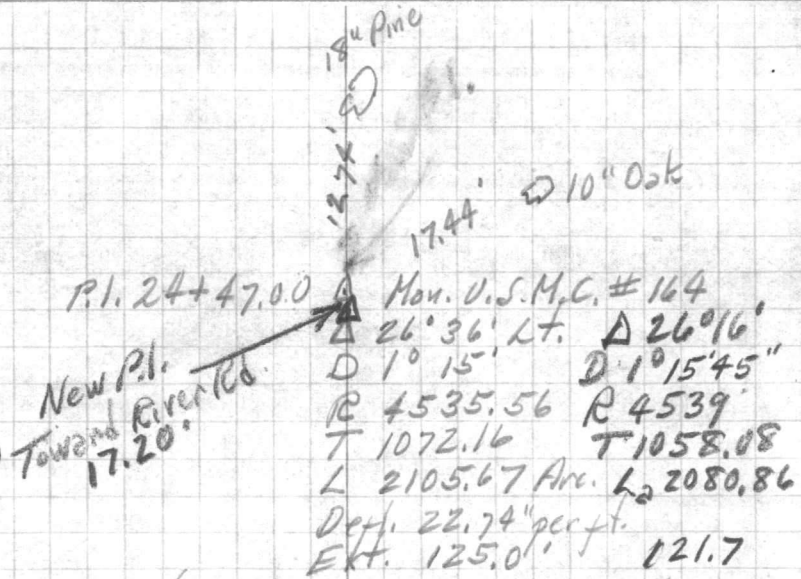

*See Copenhart Housing, Water Line Notes on Stone St.  
for As built Location.  
Note: Road built by Camp Maintenance and  
Marine Corps Engineers.*



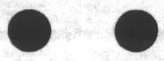

E

SUBJECT \_\_\_\_\_  
 \_\_\_\_\_  
 \_\_\_\_\_  
 \_\_\_\_\_

Return To  
 Public Works  
 Office  
 Camp Lejeune  
 North Carolina

FIELD PARTY

\_\_\_\_\_ In Charge  
 \_\_\_\_\_ Instrument  
 \_\_\_\_\_ Notes  
 \_\_\_\_\_ Tape Read  
 \_\_\_\_\_ Tape or Rod  
 \_\_\_\_\_ Tape or Rod  
 \_\_\_\_\_ Instrument No.  
 \_\_\_\_\_ Tape No.

WEATHER

Clear \_\_\_\_\_  
 Cloudy \_\_\_\_\_  
 Windy \_\_\_\_\_  
 Rain \_\_\_\_\_  
 Fair \_\_\_\_\_  
 Snow \_\_\_\_\_  
 Hot \_\_\_\_\_  
 Moderate \_\_\_\_\_  
 Cold \_\_\_\_\_  
 Fog \_\_\_\_\_

FILE No. \_\_\_\_\_

Fldr. No. \_\_\_\_\_

Sheet 2-16

Figured By \_\_\_\_\_

Notes Checked By \_\_\_\_\_

Plotted By \_\_\_\_\_

Date \_\_\_\_\_ 19\_\_

Quad. No. \_\_\_\_\_

Station	Dist.	Angle "	+	H. I. Bearing	Ver: Ang. Diff.	Elevation
+50		6 47 29	V V			
24		6 28 32	V V			
+50		6 09 35	V V			
23		5 50 38	V			
+50		5 31 41	V V			
22		5 12 44	V	(V) B.S.		
+50		4 53 47	V V	B.S.		
21		4 34 50	V V			
+50		4 15 53	V V			
20		3 56 56	V V			
+50		3 37 59	V V			
19		3 19 02	V V			
+50		3 00 05	V V			
18		2 41 08	V V			
+50		2 22 11	V V			

1316  
 518































































































SUBJECT \_\_\_\_\_  
 \_\_\_\_\_  
 \_\_\_\_\_  
 \_\_\_\_\_

Return To  
 Public Works  
 Office  
 Camp Lejeune  
 North Carolina

FIELD PARTY

\_\_\_\_\_ In Charge  
 \_\_\_\_\_ Instrument  
 \_\_\_\_\_ Notes  
 \_\_\_\_\_ Tape Read  
 \_\_\_\_\_ Tape or Rod  
 \_\_\_\_\_ Tape or Rod  
 \_\_\_\_\_ Instrument No.  
 \_\_\_\_\_ Tape No.

WEATHER

Clear  
 Cloudy  
 Windy  
 Rain  
 Fair

Snow  
 Hot  
 Moderate  
 Cold  
 Fog

FILE No. \_\_\_\_\_

Fldr. No. \_\_\_\_\_

Sheet 3-16

Date \_\_\_\_\_ 19\_\_\_\_

Figured By \_\_\_\_\_

Notes Checked By \_\_\_\_\_

Plotted By \_\_\_\_\_

Quad. No. \_\_\_\_\_

Station	Dist.	Angle "	+	H. I. Bearing	Ver: Ang. Diff.	Elevation
32		11 31 47	V			
+50		11 12 47	V			
31		10 53 50	V			
+50		10 34 56	V			
30		10 15 56	V			
+50		9 56 59	V			
29		9 38 02	V			
+50		9 19 05	V			
28		9 00 08	V			
+50		8 41 11	V V			
27		8 22 14	V V			
+50		8 03 17	V V			
26		7 44 20	V V			
+50		7 25 23	V V			
25		7 06 26	V V			





SUBJECT \_\_\_\_\_

Return To-  
Public Works  
Office  
Camp Lejeune  
North Carolina

FIELD PARTY

\_\_\_\_ In Charge  
\_\_\_\_ Instrument  
\_\_\_\_ Notes  
\_\_\_\_ Tape Read  
\_\_\_\_ Tape or Rod  
\_\_\_\_ Tape or Rod  
\_\_\_\_ Instrument No.  
\_\_\_\_ Tape No.

WEATHER

Clear \_\_\_\_\_  
Cloudy \_\_\_\_\_  
Windy \_\_\_\_\_  
Rain \_\_\_\_\_  
Fair \_\_\_\_\_  
Snow \_\_\_\_\_  
Hot \_\_\_\_\_  
Moderate \_\_\_\_\_  
Cold \_\_\_\_\_  
Fog \_\_\_\_\_  
Figured By \_\_\_\_\_  
Notes Checked By \_\_\_\_\_  
Plotted By \_\_\_\_\_

FILE No. \_\_\_\_\_

Fldr. No. \_\_\_\_\_

Sheet 4-16

Date \_\_\_\_\_ 19\_\_\_\_

Quad. No. \_\_\_\_\_

Station	Dist.	Angle "	+	H. I. Bearing	Ver: Ang. Diff.	Elevation
54		00212				
79593 PC		000				
53						
52						
51						
50+79 <sup>65</sup> P.O.T.						
P.C. 46+63.27						New Data
45+80 <sup>51</sup> P.O.T.						
P.C. 43+57.32						
35						
80 <sup>51</sup> PT		1318				
+50		130629	✓			
34		124732	✓			
+50		122835	✓			
33		120938	✓			
+50		115041	✓			

See Sheets Dated 6/6/49 ~~9-9-48~~ for Revised Alignment
































VALUABLE

SUBJECT Revised Line data  
ON A's + Contd.

Return To  
 Public Works  
 Office  
 Camp Lejeune  
 North Carolina

FIELD PARTY

\_\_\_\_\_ In Charge  
 \_\_\_\_\_ Instrument  
 \_\_\_\_\_ Notes  
 \_\_\_\_\_ Tape Read  
 \_\_\_\_\_ Tape or Rod  
 \_\_\_\_\_ Tape or Rod  
 \_\_\_\_\_ Instrument No.  
 \_\_\_\_\_ Tape No.

WEATHER

Clear  
 Cloudy  
 Windy  
 Rain  
 Fair

Snow  
 Hot  
 Moderate  
 Cold  
 Fog

FILE No. \_\_\_\_\_

Fldr. No. \_\_\_\_\_

Figured By \_\_\_\_\_ Sheet 2+0+2

Notes Checked By \_\_\_\_\_ Date 6-6-19 29

Plotted By \_\_\_\_\_

Quad. No. \_\_\_\_\_

Station	Dist.	Angle "	+	H. I. Bearing	Ver: Ang. Diff.	Elevation
---------	-------	---------	---	---------------	-----------------	-----------

117 87.51  
53 07.22

90°00'00"

P.I. 117+87.51 "A" St. = 23+21.50 Brewster Blvd.

P.O.T. 98+63.11 "A" St. = 0+00 "H" St.

P.O.T. 86+23.98 "A" St. = 0+02.27 "E" St. ?

P.O.T. 73+63.11 "A" St. = 0+00 "C" St.

= 53+07.22 4h. Use

P.T. 54+35.64 18°33'15" Blk.


+50 17°51'03.4"

54+ 16°51'04"

+50 15°51'04.6"

51+ 14°51'05.2"

50+50 13°51'05.8"

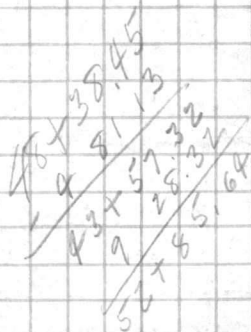


 1112 10

4813805  
 481.13  
53219.58

15.0  
1.00

*[Handwritten scribble]*

37  
 50  
 00

VALUABLE

SUBJECT \_\_\_\_\_

Return To  
Public Works  
Office  
Camp Lejeune  
North Carolina

FIELD PARTY

\_\_\_\_ In Charge  
\_\_\_\_ Instrument  
\_\_\_\_ Notes  
\_\_\_\_ Tape Read  
\_\_\_\_ Tape or Rod  
\_\_\_\_ Tape or Rod  
\_\_\_\_ Instrument No.  
\_\_\_\_ Tape No.

WEATHER

Clear  
Cloudy  
Windy  
Rain  
Fair

Snow  
Hot  
Moderate  
Cold  
Fog

FILE No. \_\_\_\_\_

Fldr. No. \_\_\_\_\_

Sheet 3

Date \_\_\_\_\_

19 \_\_\_\_\_

Quad. No. \_\_\_\_\_

Station	Dist.	Angle "	+	H. I. Bearing	Ver: Ang. Diff.	Elevation	
B.M						28 37	B.M #3 R
50+01.29 PT				561 33 98	3 98	30 00	
<del>51</del>					4 2	29 8	
<del>52+00</del>					5 9	28 1	
<del>53</del>					4 5	29 5	
707.22 = 52+85.64							
54					4 5	29 5	
55					4 1	29 9	
TP					3.28	30.70	TOP STAFF +00
56				3 79 34.49	3 8	30 7	
57					4 3	30 2	
58					5 8	28 7	
+40					7 3	27 2	VALLEY
59					6 6	27 9	59+00 ⊙
B.M.#1					2 78	31 71	Spike in 12" Pine 60ft station 59+50 ⊙
				2 91 34 62			60± ⊙ B.M.#1 SPIKE IN 12" PINE
60+00					4 5	30 1	60+00 ⊙
61+00					3 7	30 9	









VALUABLE

SUBJECT \_\_\_\_\_  
 \_\_\_\_\_  
 \_\_\_\_\_  
 \_\_\_\_\_

Return To  
 Public Works  
 Office  
 Camp Lejeune  
 North Carolina

FIELD PARTY  
 \_\_\_\_\_ In Charge  
 \_\_\_\_\_ Instrument  
 \_\_\_\_\_ Notes  
 \_\_\_\_\_ Tape Read  
 \_\_\_\_\_ Tape or Rod  
 \_\_\_\_\_ Tape or Rod  
 \_\_\_\_\_ Instrument No.  
 \_\_\_\_\_ Tape No.

WEATHER  
 Clear \_\_\_\_\_  
 Cloudy \_\_\_\_\_  
 Windy \_\_\_\_\_  
 Rain \_\_\_\_\_  
 Fair \_\_\_\_\_

Snow \_\_\_\_\_  
 Hot \_\_\_\_\_  
 Moderate \_\_\_\_\_  
 Cold \_\_\_\_\_  
 Fog \_\_\_\_\_

FILE No. \_\_\_\_\_  
 Fldr. No. \_\_\_\_\_  
 Figured By \_\_\_\_\_ Sheet 4  
 Notes Checked By \_\_\_\_\_  
 Plotted By \_\_\_\_\_ Date \_\_\_\_\_ 19\_\_\_\_  
 Quad. No. \_\_\_\_\_

Station	Dist.	Angle "	+	H. I. Bearing	Ver: Ang. Diff.	Elevation
62+00				34 62	3 8	30 8
63+00					3 7	30 9
64					4 2	29 4
65+00					4 5	29 1
T.P.					3 65	30.97
		3 17		34 14		
66					5 5	28 6
+40					6 7	27 4
67					4 3	29 8
+50					4 5	29 6
68					6 3	27 8
69+00					5 5	28 6
B.M.#2					4 42	29.72
		3 74		33.46		
70+00					4 5	29 0
71					6 4	27 1
72					5 1	28 1
73					3 4	30 1
74					3 8	29 7

LEFT

TOP STATION 65+00

B.M.#2

75' ← STA. 70+00

← SPIKE IN 15" Pine 75' left station 70+00














**VALUABLE**

SUBJECT \_\_\_\_\_

Return To  
Public Works  
Office  
Camp Lejeune  
North Carolina

**FIELD PARTY**

\_\_\_\_\_ In Charge  
\_\_\_\_\_ Instrument  
\_\_\_\_\_ Notes  
\_\_\_\_\_ Tape Read  
\_\_\_\_\_ Tape or Rod  
\_\_\_\_\_ Tape or Rod  
\_\_\_\_\_ Instrument No.  
\_\_\_\_\_ Tape No.

**WEATHER**

Clear \_\_\_\_\_  
Cloudy \_\_\_\_\_  
Windy \_\_\_\_\_  
Rain \_\_\_\_\_  
Fair \_\_\_\_\_

Snow \_\_\_\_\_  
Hot \_\_\_\_\_  
Moderate \_\_\_\_\_  
Cold \_\_\_\_\_  
Fog \_\_\_\_\_

FILE No. \_\_\_\_\_

Fldr. No. \_\_\_\_\_

Sheet 5

Date \_\_\_\_\_ 19\_\_

Quad. No. \_\_\_\_\_

Station	Dist.	Angle	"	+	H. I. Bearing	Ver: Ang. Diff.	Elevation	
					33.46			
T.P.						2.87	30.59	TOP STA. 74400
	4.05				34.64			
75						4.2	30.4	
76						4.4	30.2	
77						4.8	29.8	
78						4.8	29.8	
79+00						4.9	29.7	STA 79
B.M. #3						3.52	31.12	79+50 60' ± B.M. #3
	3.54				34.66			SPIKE IN 12" PINE
80+00						4.7	30.0	80+00 60' RT station 79+50
81						4.9	29.8	
82						5.1	29.6	
83						4.7	30.0	
84+00						4.6	30.1	
T.P.						3.80	30.86	TOP STA 84400
	4.29				35.15			
85						5.1	30.1	
86+00						4.8	30.4	



**VALUABLE**

SUBJECT \_\_\_\_\_

Return To  
Public Works  
Office  
Camp Lejeune  
North Carolina

**FIELD PARTY**

\_\_\_\_\_ In Charge  
\_\_\_\_\_ Instrument  
\_\_\_\_\_ Notes  
\_\_\_\_\_ Tape Read  
\_\_\_\_\_ Tape or Rod  
\_\_\_\_\_ Tape or Rod  
\_\_\_\_\_ Instrument No.  
\_\_\_\_\_ Tape No.

**WEATHER**

Clear  
Cloudy  
Windy  
Rain  
Fair

Snow  
Hot  
Moderate  
Cold  
Fog

FILE No. \_\_\_\_\_

Fldr. No. \_\_\_\_\_

Sheet 6

Date \_\_\_\_\_ 19\_\_

Figured By \_\_\_\_\_  
Notes Checked By \_\_\_\_\_  
Plotted By \_\_\_\_\_

Quad. No. \_\_\_\_\_

Station	Dist.	Angle "	+	H. I. Bearing	Ver: Ang. Diff.	Elevation			
				35 15					
87+00					4 7	30 5			
88+00					4 9	30 3			
89+00					4 7	30 5			
90					4 7	30 5			
B.M.#4					2 97	32 18			
	3.11			35.29					
91+00					4 1	31 2			
92+00					4 3	31 0			
93+00					4 4	30 9			
T.P.					4 42	30 58			
	5.52			36.39					
94					5 2	31 2			
95					4 9	31 5			
96					4 9	31 5			
97					4 8	31 6			
98					4 7	31 7			
99					5 0	31 4			

90+00 ○

90+25 ○

91+00

60±

B.M.#4

Spike in 2" Pine

60' Rt station 90+25



**VALUABLE**

SUBJECT \_\_\_\_\_

Return To  
Public Works  
Office  
Camp Lejeune  
North Carolina

**FIELD PARTY**

\_\_\_\_\_ In Charge  
\_\_\_\_\_ Instrument  
\_\_\_\_\_ Notes  
\_\_\_\_\_ Tape Read  
\_\_\_\_\_ Tape or Rod  
\_\_\_\_\_ Tape or Rod  
\_\_\_\_\_ Instrument No.  
\_\_\_\_\_ Tape No.

**WEATHER**

Clear  
Cloudy  
Windy  
Rain  
Fair

Snow  
Hot  
Moderate  
Cold  
Fog

FILE No. \_\_\_\_\_

Fldr. No. \_\_\_\_\_

Figured By \_\_\_\_\_ Sheet 7

Notes Checked By \_\_\_\_\_

Plotted By \_\_\_\_\_ Date \_\_\_\_\_ 19\_\_

Quad. No. \_\_\_\_\_

Station	Dist.	Angle "	+	H. I. Bearing	Ver: Ang. Diff.	Elevation	
T.P.				36 39	4 03	32.36	TOP STA. 99+00
100+00				3 57 35.93	4 4	31.5	
101					4 7	31.2	
102					4 6	31.3	102+00
B.M.#5					3 12 32.81		103+00 80 ± B.M.#5 ⊕ SPIKE IN 12" BLACK GUM
103				3 27 36.08	4 8	31.3	
104					4 8	31.3	
105					4 9	31.2	
106					5 0	31.1	
107					5 0	31.1	
108 ←					5 8	20.3	108+60 BANK ELEV. 30.5
See FLY LEAF →							
T.P.					5 06	31.02	108+63 DITCH 28.4
				199 33.01			
109					4 1	28.9	108+66 BANK 30.5
110					4 4	28.6	
111					4 6	28.4	
112					4 9	28.1	







VALUABLE

SUBJECT \_\_\_\_\_

Return To  
Public Works  
Office  
Camp Lejeune  
North Carolina

## FIELD PARTY

In Charge \_\_\_\_\_  
Instrument \_\_\_\_\_  
Notes \_\_\_\_\_  
Tape Read \_\_\_\_\_  
Tape or Rod \_\_\_\_\_  
Tape or Rod \_\_\_\_\_  
Instrument No. \_\_\_\_\_  
Tape No. \_\_\_\_\_

## WEATHER

Clear \_\_\_\_\_  
Cloudy \_\_\_\_\_  
Windy \_\_\_\_\_  
Rain \_\_\_\_\_  
Fair \_\_\_\_\_  
Snow \_\_\_\_\_  
Hot \_\_\_\_\_  
Moderate \_\_\_\_\_  
Cold \_\_\_\_\_  
Fog \_\_\_\_\_

FILE No. \_\_\_\_\_

Fldr. No. \_\_\_\_\_

Figured By \_\_\_\_\_ Sheet 8

Notes Checked By \_\_\_\_\_

Plotted By \_\_\_\_\_

Date \_\_\_\_\_ 19\_\_

Quad. No. \_\_\_\_\_

Station	Dist.	Angle "	+	H. I. Bearing	Ver: Ang. Diff.	Elevation	
				3301			
113 +08					52	278	
SEE FLY LEAF							
114 +00					60	270	
115 +00					30	300	
116 +00					33	300	
T.P.					246	3055	
				117 3172			
116 +60					23	294	BANK
+70					45	272	OLD ROAD
116 +87					50	267	ditch
116 +92					22	295	BANK
117 +00					29	288	
117 +52					39	278	BANK AT ROAD
61					66	251	ROADSIDE ditch
70					46	271	
77					428	2744	EDGE ASPH
88					412	2760	BRUCESTER ROAD
BM # 427					114	3058	BM # 427 (30.59)













PUBLIC WORKS DEPARTMENT  
Camp Lejeune, North Carolina  
Survey Department

File 139-Gen.  
Quadrangle \_\_\_\_\_  
Date 6/6/49  
Sheet #1 of 1

Traverse Computation  
Description

*Stone Street - From River Road to Brewster Blvd.*

Station	Distance	Bearing	Cosine	Sine	Latitude	Departure	Y Coordinate North	X Coordinate East
0+00 Stone St. = Int. of River Road							345,554.00	2,491,521.37
8+41 <sup>74</sup> " " = Int. of Bevin St.	841.74	N56°44'E	5485405	836124	461.73 <sup>75</sup> +102	704.35 <sup>703.80+55</sup>	346,015.75	2,492,225.72
P.I. 24+47.00 = Mon. #164	1605.26	"	"	"	880.55 <sup>58</sup> +03	1343.24 <sup>1342.20+104</sup>	346,896.33	2,493,568.96
P.I. 48+38.45 = Mon. #411	2430.10	N30°08'E	8648595	502014	2101.70 <sup>77</sup> +07	1220.90 <sup>1219.44+96</sup>	348,998.10	2,494,789.86
117+87.51 Stone St.								
23+21.50 Brewster Blvd.	6961.42	N6°59'30"W	9925639	121725	6909.66 <sup>88</sup> +23	846.72 <sup>847.38-66</sup>	355,907.98	2,493,943.14 <sup>v</sup>
							355,907.63 <sup>x</sup>	2,493,939.93 <sup>x</sup>
<p>Note: See Capehart Water Line notes for As Built Location of Road at Curves at P.I. 24+47 and 48+38.45 (Road built by Maintenance and Engineer Battalion)</p>								
Un-numbered Mon. on St. Extended	35.04	N6-59-30 W	9925639	121725	34.78	4.27	355942.76	2,493,938.87

Err. 00°00'17"  
Not Adj.

- 0.35  
- 3.21  
Adjusted.

