

VALUABLE

SUBJECT WATER LINE LOCATION
HOSPITAL AREA

Return To
Public Works
Office
Camp Lejeune
North Carolina

FIELD PARTY
KELUM In Charge
Instrument _____
Notes _____
Tape Read _____
Tape or Rod _____
Tape or Rod _____
Instrument No. _____
Tape No. _____

WEATHER
Clear _____
Cloudy _____
Windy _____
Rain _____
Fair _____
Snow _____
Hot _____
Moderate _____
Cold _____
Fog _____
Figured By _____
Notes Checked By _____
Plotted By _____

FILE No. 139-X
Fldr. No. _____
Sheet 1-012
Date 6-10 1946
Quad. No. 139

Station	Dist.	Angle " "	+	H. I. Bearing	Ver: Ang. Diff.	Elevation	
B.M.		11.72		21.39		9.67	SPIKE IN 16" PINE NEAR H-61
						6" C.T.	WATER LINE
1+28.5					9.61	11.78	H-51
2+28.5					8.43	12.96	H-52
3+28					7.56	13.83	H-53
T.P.	4.00	23.16		2.23	19.16	✓	
4+32.7					8.61	14.55	H-54
T.P.	5.48	27.71		0.93	22.23	✓	
5+32					11.83	15.88	H-55
T.P.	3.79	23.69		7.41	20.30	✓	

1+26.9 6" Line
= 0+00 2" "

2" C.T.

FILE

Issued To
Public Works
Office
Camp Lejeune
North Carolina

SUBJECT

Station
Date
Angle
Dist
H. Dist
Vert. Dist
Elevation

FIELD PARTY

In Charge
Instrument
Notes
Tape Book
Type of Rod
Type of Trip
Amount No.
Tape No.

WEATHER

Clear
Cloudy
Fog
Rain
Snow
Thunder
Wind
Bar
Temp
Humidity
Direction
Speed

FILE No.

Field No.

Sheet

Date

Field No.

VALUABLE

SUBJECT WATER LINE LOCATION
CONTD.

Return To
 Public Works
 Office
 Camp Lejeune
 North Carolina

FIELD PARTY
KELMAN In Charge
 _____ Instrument
 _____ Notes
 _____ Tape Read
 _____ Tape or Rod
 _____ Instrument No.
 _____ Tape No.

WEATHER
 Clear _____
 Cloudy _____
 Windy _____
 Rain _____
 Fair _____
 Snow _____
 Hot _____
 Moderate _____
 Cold _____
 Fog _____
 Figured By _____
 Notes Checked By _____
 Plotted By _____
 Quad. No. 139

FILE No. 139-Y
 Fldr. No. _____
 Sheet 2-012
 Date 6-10 1946

Station	Dist.	Angle	H. I. Bearing	Ver: Ang. Diff.	Elevation	
			23.69 ✓			3+12.9 6" L.I. = 0+00 2" "
1+28.5			11.96	11.73		H- 56
2+28.3			11.16	12.53		H- # 57
3+27.5			10.16	13.53		H- 58
4+32			8.57	15.12		H- 59
5+31.5			10.31	13.38		H- 60
B.M.			0.00	23.69 ✓ (23.70)		NAIL IN 14" SHEET GUM AT Bldg. H- 60

Public Works
Office
Camp Lejeune
North Carolina

SUBJECT

Station _____
Dir. _____
Angle _____
Barrels _____
H. V. _____
Vertical _____
Feet _____

FIELD PARTY
In Charge _____
Instrument _____
Notes _____
Tape Rod _____
Type of Rod _____
Tape of Rod _____
Account No. _____
Tape No. _____

WEATHER
Clear _____
Cloudy _____
Hazy _____
Misty _____
Rain _____
Cold _____
Fog _____
Lighted BY _____
Notes Checked BY _____
Plotted BY _____
Date _____

FIELD No. _____
Field No. _____
Sheet _____
Date _____

VALUABLE

SUBJECT High Water
Wallace Creek BOATHOUSE

Return To
 Public Works
 Office
 Camp Lejeune
 North Carolina

FIELD PARTY

_____ In Charge
 _____ Instrument
 _____ Notes
 _____ Tape Read
 _____ Tape or Rod
 _____ Tape or Rod
 _____ Instrument No.
 _____ Tape No.

WEATHER

Clear _____
 Cloudy _____
 Windy _____
 Rain _____
 Fair _____
 Snow _____
 Hot _____
 Moderate _____
 Cold _____
 Fog _____
 Figured By _____
 Notes Checked By _____
 Plotted By _____

FILE No. 139-Y
 Fldr. No. _____
 Sheet 1-1
 Date 9-24 19 46
 Quad. No. 139-Y

Station	Dist.	Angle	"	+	H. I. Bearing	Ver: Ang. Diff.	Elevation	
BM		363			769		406	Nail in 12" P. 200
Pier						5.16	253	
Top Water	AT 1500					6.32	137	
High Water Eler.								
	1" or 0.08 above Walk						2.53	4:00 P.M. 9/20/46
							.08	
							<u>2.61</u>	High Water Rain High Water
	0.32 below Walk						<u>2.21</u>	High Water 10/9/46 Sea Tide High Water
	3" or 0.25 above Walk - Eler.						<u>2.78</u>	" " 9/25/47 Storm Tide & Heavy Rainfall
	0.2' above Walk.						<u>2.73</u>	" " 10/15/47 " " " "
	"						3.00	" " 11/3/47 N.E. Winds + Apparent Quake in Ocean
	4" above Walk.						2.56	" " 10/6/48 N.E. Winds & Hurricane off Florida.

VALUABLE

Return To
Public Works
Office












































VALUABLE

SUBJECT Ext on water
Lino to Houses 68+69
Hospital Area

Return To
 Public Works
 Office
 Camp Lejeune
 North Carolina

FIELD PARTY
Turling In Charge
 Instrument _____
 Notes _____
 Tape Read _____
 Tape or Rod _____
 Tape or Rod _____
 Instrument No. _____
 Tape No. _____

WEATHER
 Clear _____
 Cloudy _____
 Windy _____
 Rain _____
 Fair _____
 Snow _____
 Hot _____
 Moderate _____
 Cold _____
 Fog _____
 Figured By _____
 Notes Checked By _____
 Plotted By _____
 Quad. No. 139

FILE No. 139-Y
 Fldr. No. _____
 Sheet 1-1
 Date 10-17 1946

Station	Dist.	Angle " "	+	H. I. Bearing	Ver: Ang. Diff.	Elevation
B M						16.84
		0 95		17.79		
0+00					9 07	8.72
0+48					8 51	9.28
1					8 09	9.70
+32					7 71	10.08
+64					7.77	10.02
2					7.70	10.09
+44					7.82	9.97
55					7.85	9.94


Nail intersection River 0+00

45°s Band

Tap in

Tap in

End line

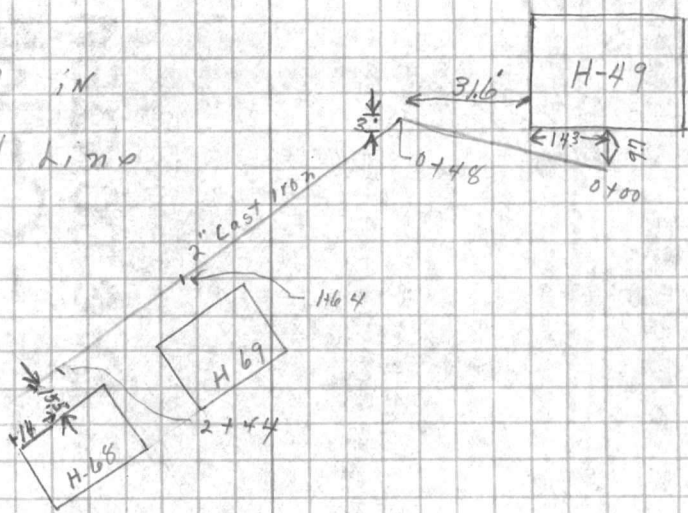







VAD

Return To
Public Works
Office
Camp Lejeune
North Carolina

SUBJECT WATER AND GAS METER
LOCATION NEAR ENTRANCE TO
NAVAL HOSPITAL, CAMP LEJEUNE,
N. C.
Bldg. # 741

FIELD PARTY
KELLY In Charge
 _____ Instrument
 _____ Notes
 _____ Tape Read
 _____ Tape or Rod
 _____ Tape or Rod
 _____ Instrument No.
 _____ Tape No.

WEATHER
 Clear _____
 Cloudy _____
 Windy _____
 Rain _____
 Fair _____
 Snow _____
 Hot _____
 Moderate _____
 Cold _____
 Fog _____
 Figured By _____
 Notes Checked By _____
 Plotted By _____

FILE No. _____
 Fldr. No. 139-V-2
 Sheet 1-01-1
 Date 3-14-47

Station	Dist.	Angle "	+	H. I. Bearing	Ver: Ang. Diff.	Elevation
B. M. MON # 380			2.33	27.11		24.78
FLOOR OF PIT					11.40	15.71
TOP OF 2" GAS LINE					7.79	19.33
TOP OF 8" C.I. WATER LINE					9.63	17.48
TOP OF BLDG.					1.40	25.91

VALVE "H"
 VALVE "B"
 VALVE "C"

MAN # 379


WATER VALVE "C"

WATER VALVE "B"

WATER VALVE "H"

TO COR. "B"
 1. 67° 29' 15"
 2. 134° 58' 00"
 MEAN. 67° 29' 00"

TO COR. "H"
 1. 65° 28' 00"
 2. 130° 56' 00"
 MEAN. 65° 28' 00"

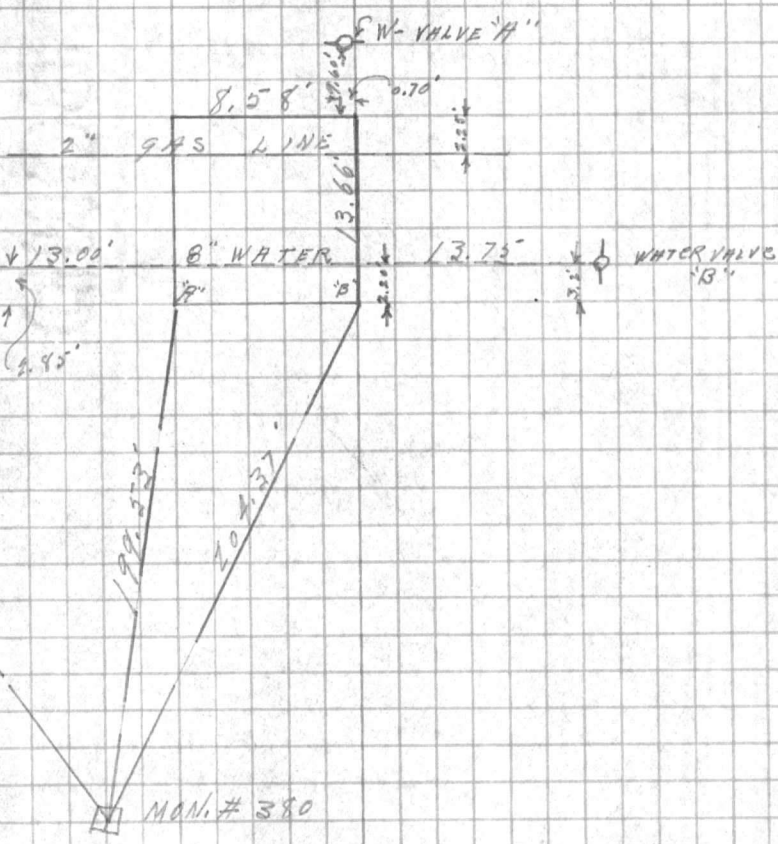

Plotted By: J. E. M. 8-28-47












VALUABLE

Return To
Public Works
Office
Camp Lejeune
North Carolina

SUBJECT Location 1" water line
17 rear bldg # H-23

FIELD PARTY

Morton In Charge
Padrick Instrument
Notes
Richardson Tape Read
Everett Tape or Rod
Tape or Rod
Instrument No. _____
Tape No. _____

WEATHER


Clear
Cloudy
Windy
Rain
Fair

Snow
Hot
Moderate
Cold
Fog

FILE No. _____
Fldr. No. _____
Sheet 1 of 1
Date 2/10 1953

Figured By _____
Notes Checked By _____
Plotted By _____
Quad. No. _____

Station	Dist.	Angle " "	+	H. I. Bearing	Ver: Ang. Diff.	Elevation
B.M.			1.41	15.41		14.00
①					5.45	9.96
②					6.15	9.26
③					6.35	9.06
④					8.38	7.03
B.M.			1.41			14.00

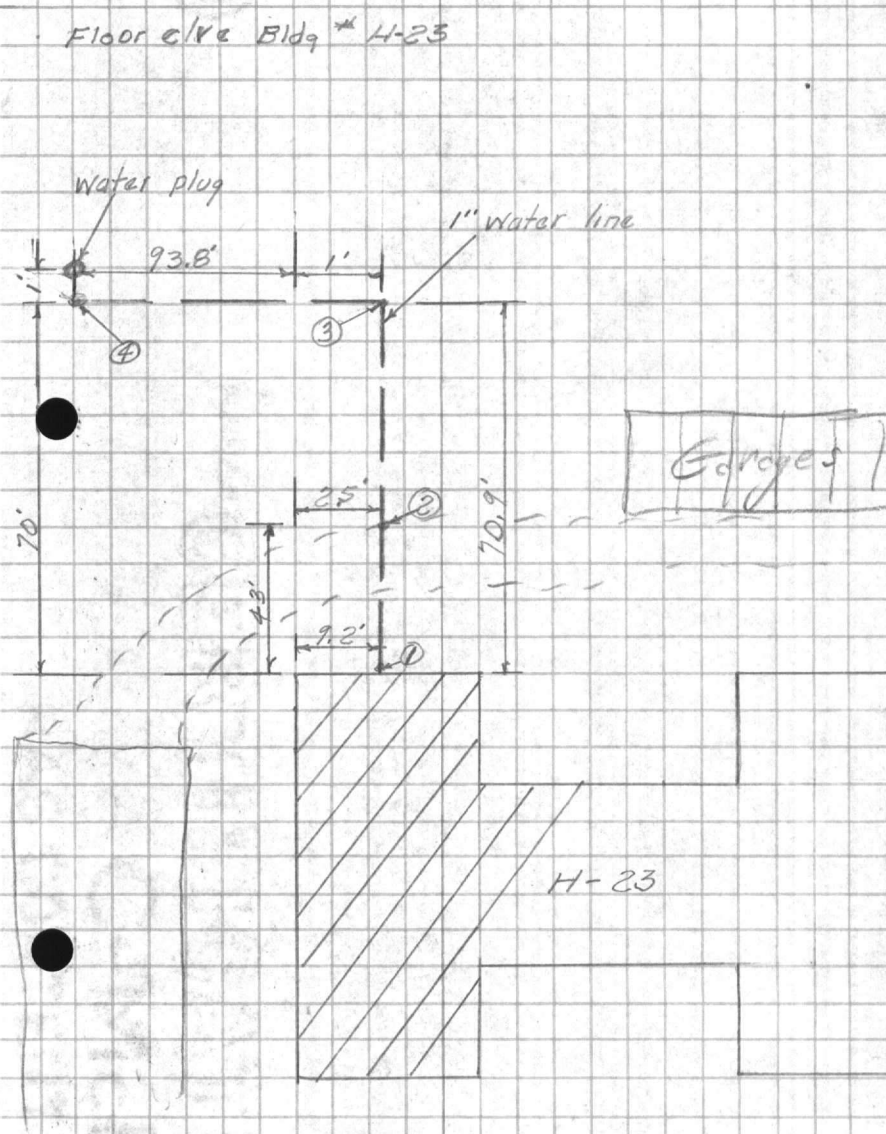
































VALUABLE

SUBJECT

High Water

RETURN TO
PUBLIC WORKS
OFFICE
CAMP LEJEUNE
NORTH CAROLINA

Wallace Creek Boathouse

FIELD PARTY
Dennis IN CHARGE
INSTRUMENT
NOTES
TAPE READ
TAPE OR ROD
INSTRUMENT No.
TAPE No.WEATHER
CLEAR
CLOUDY
WINDY
RAIN
FAIR
SNOW
HOT
MODERATE
COLD
FOG
FIGURED BY
NOTES CHECKED BY
PLOTTED BY

FILE No. 1394

FLDR. No.

SHEET

DATE Oct. 3 1955

Quad. No.

STATION	DIST.	ANGLE ° ' "	+	H. I. BEARING	VER. ANG. DIFF.	ELEVATION
---------	-------	----------------	---	------------------	--------------------	-----------

AT WALLACE CK.
BOAT HOUSE

D- +2.2

ABOVE BOARD WALK

I ONE +1.5

ABOVE BOARD WALK

Top of Walk

2.53

+2.2 4.7

+1.5 4.0

Aug. 1955

Sept. 1955






