


LEGEND

- BUILDINGS AND STRUCTURES
- ROADS AND HIGHWAYS
- ROADS (Unpaved)
- FENCE
- 5' CONTOUR (Source - USGS Maps)
- RESERVATION BOUNDARY
- SWAMP OR MARSH
- POTABLE WATER MAIN
FIELD LOCATED
- VALVE
TERTIARY FIELD LOCATED
VALVE FIELD LOCATED
- FIRE HYDRANT
- CAPPED MAIN

NOTES:
ALL ELEVATION DATA ARE EAST FROM UNLESS NOTED OTHERWISE.

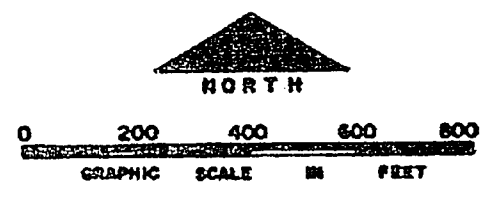

NO.	DESCRIPTION OF REVISION	DATE	INT.
DEPARTMENT OF THE NAVY MARINE CORPS BASE CAMP LEJEUNE, NORTH CAROLINA			
WATER DISTRIBUTION SYSTEM EXISTING CONDITIONS			
DATE 31 JULY 84	SCALE: GRAPHIC	SHEET N-12 of 73	
APPROVED / DATE	0000172		

00 FC440-024-003