1 1 the des

1 1

1 L. L. H 1 H



1 1

> 48'-0" EL. 31.0 TOP

> > TANK S-830 BERKLEY MANOR 300,000 GAL.

3-0 #

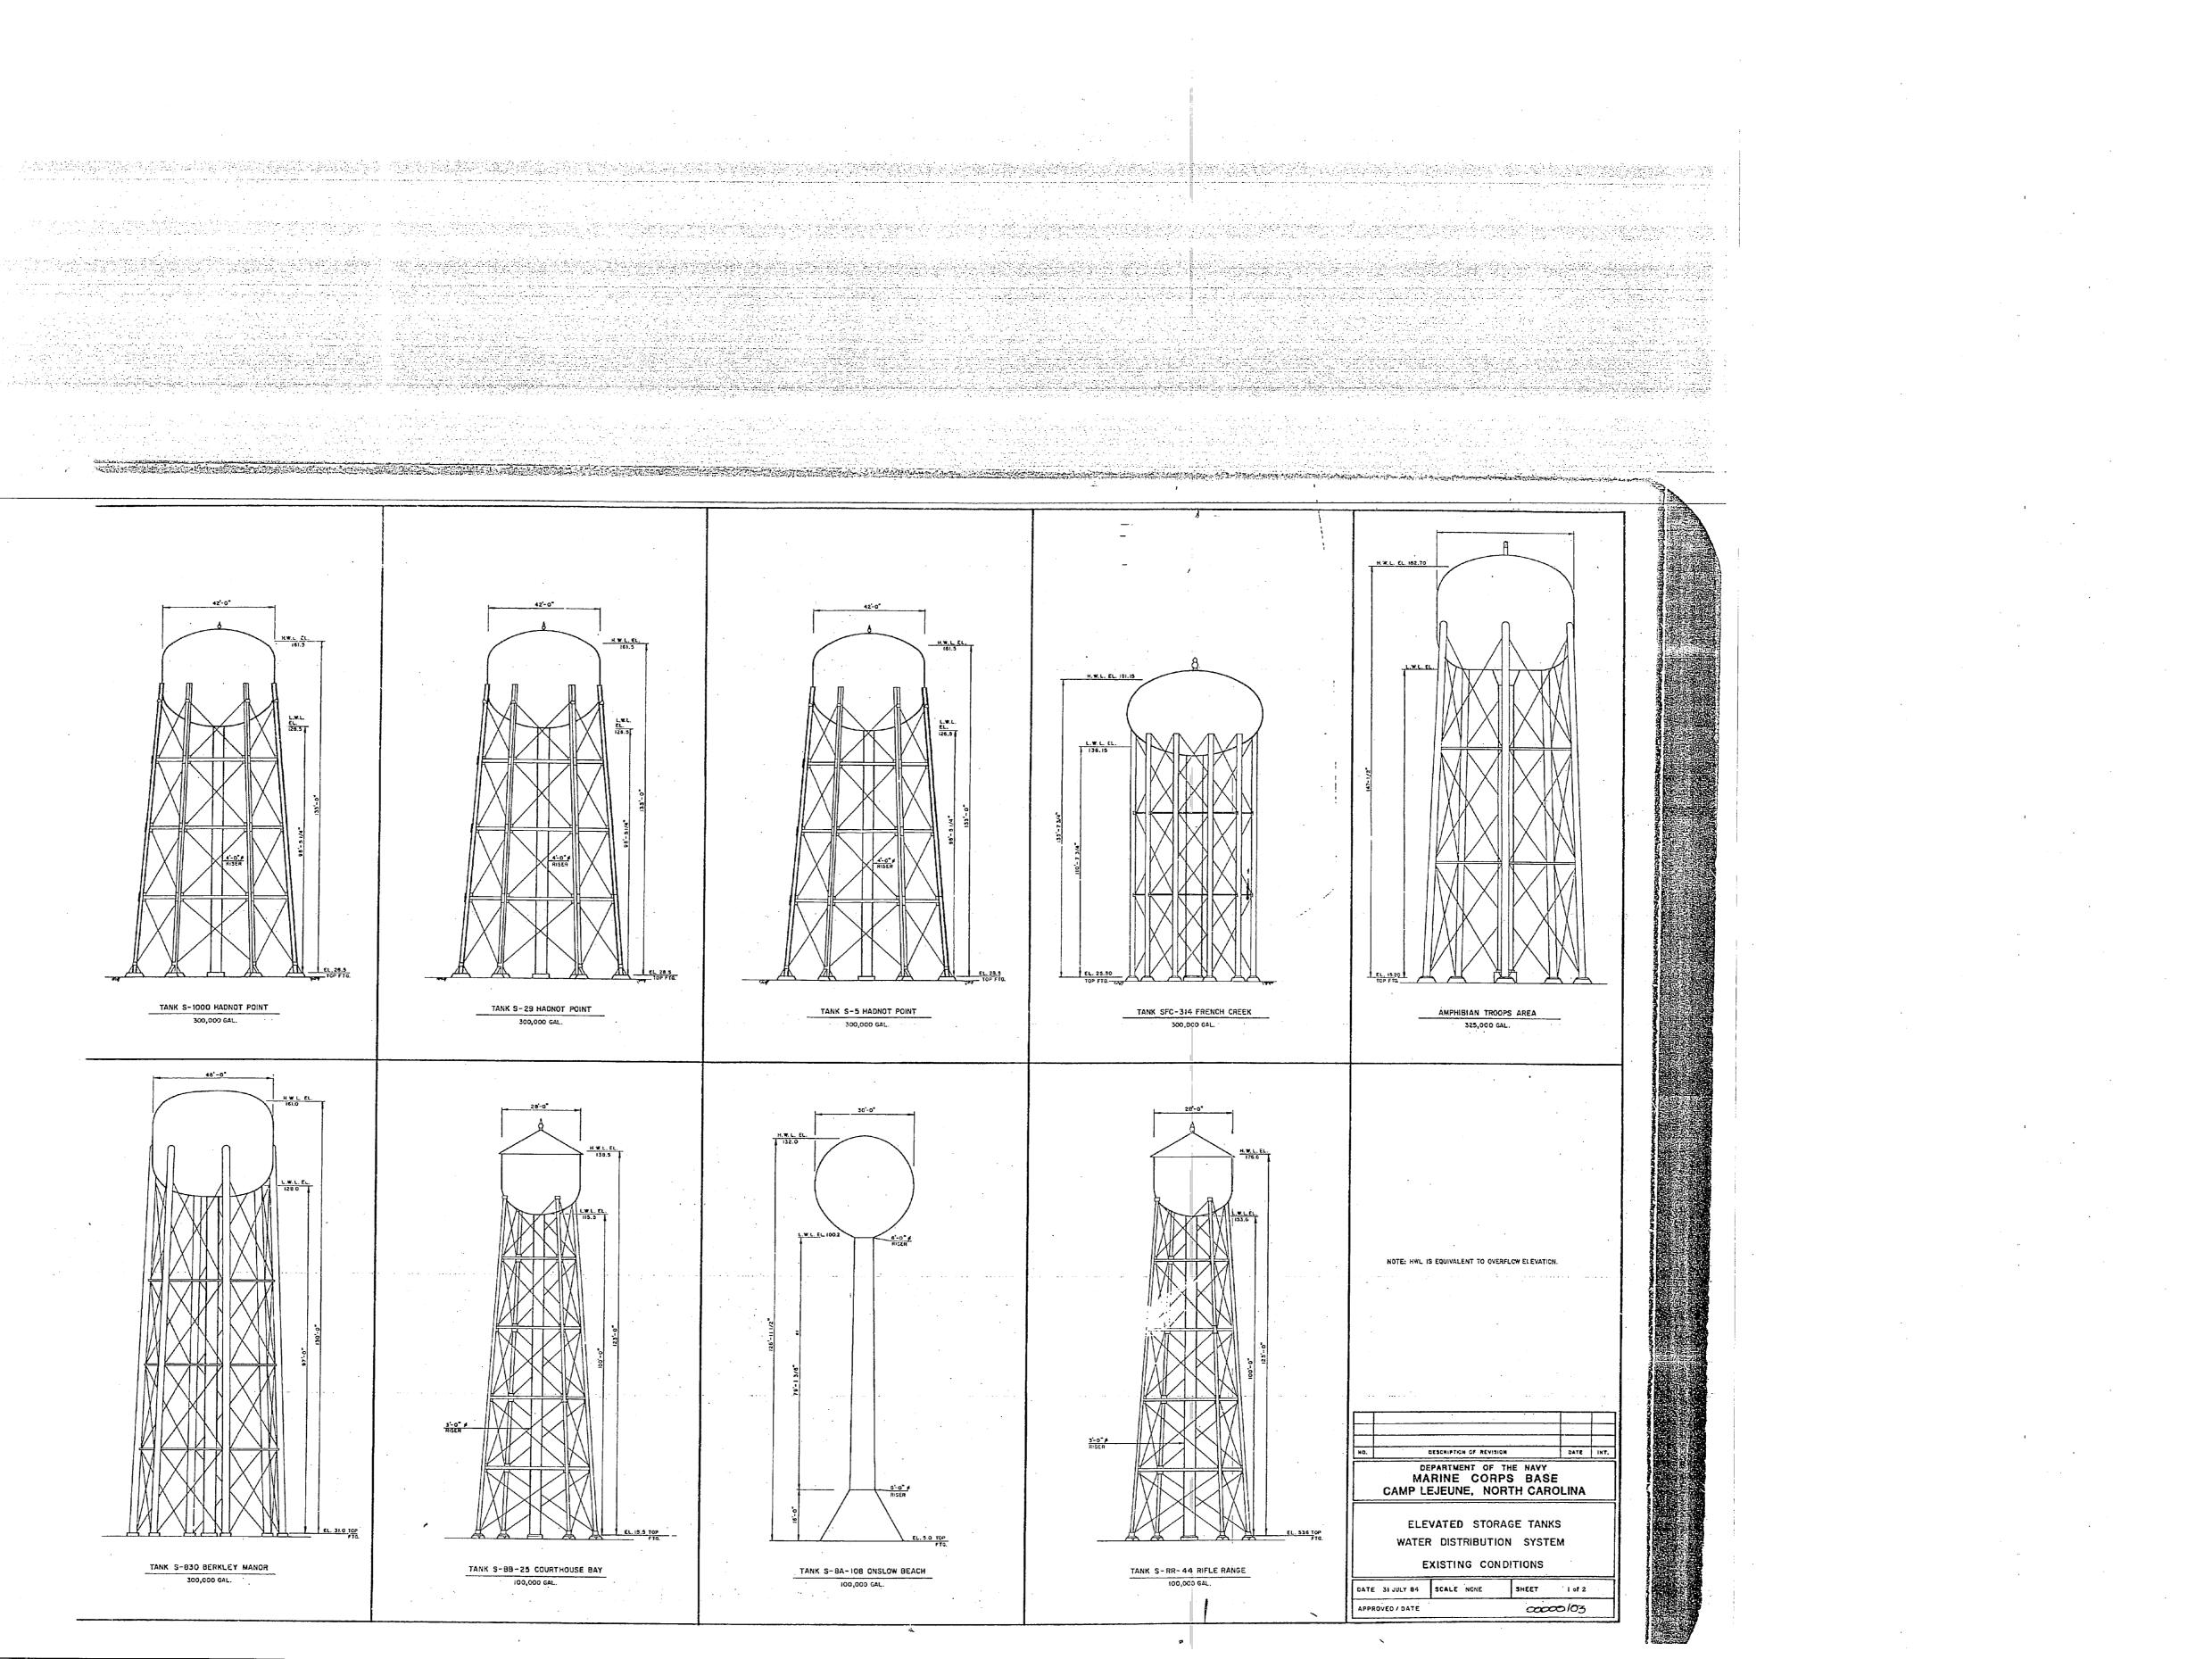

1 · · · 1 1

I. 1 • , 1 1 ı

1 1 •

1. 4. 4. 4. 9. 22 .

ł

•

•

.

ų I

t B 1

(ł


t H

(H

1 H


1


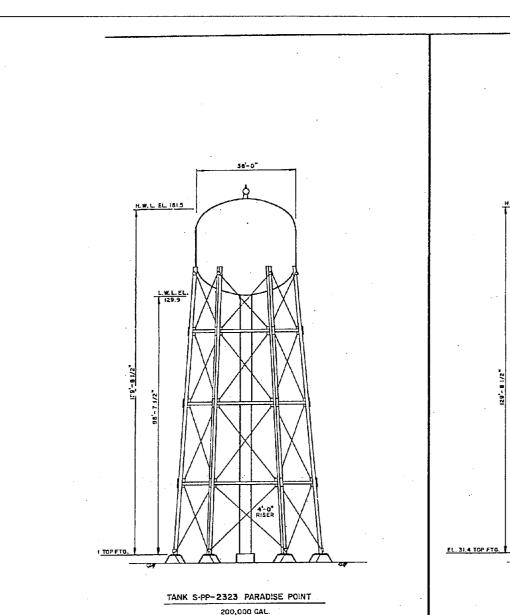

48'-0" H.W.L. EL. 168 0 138.0 TANK AS-310 M. C. AIR STATION

350,000 GAL.

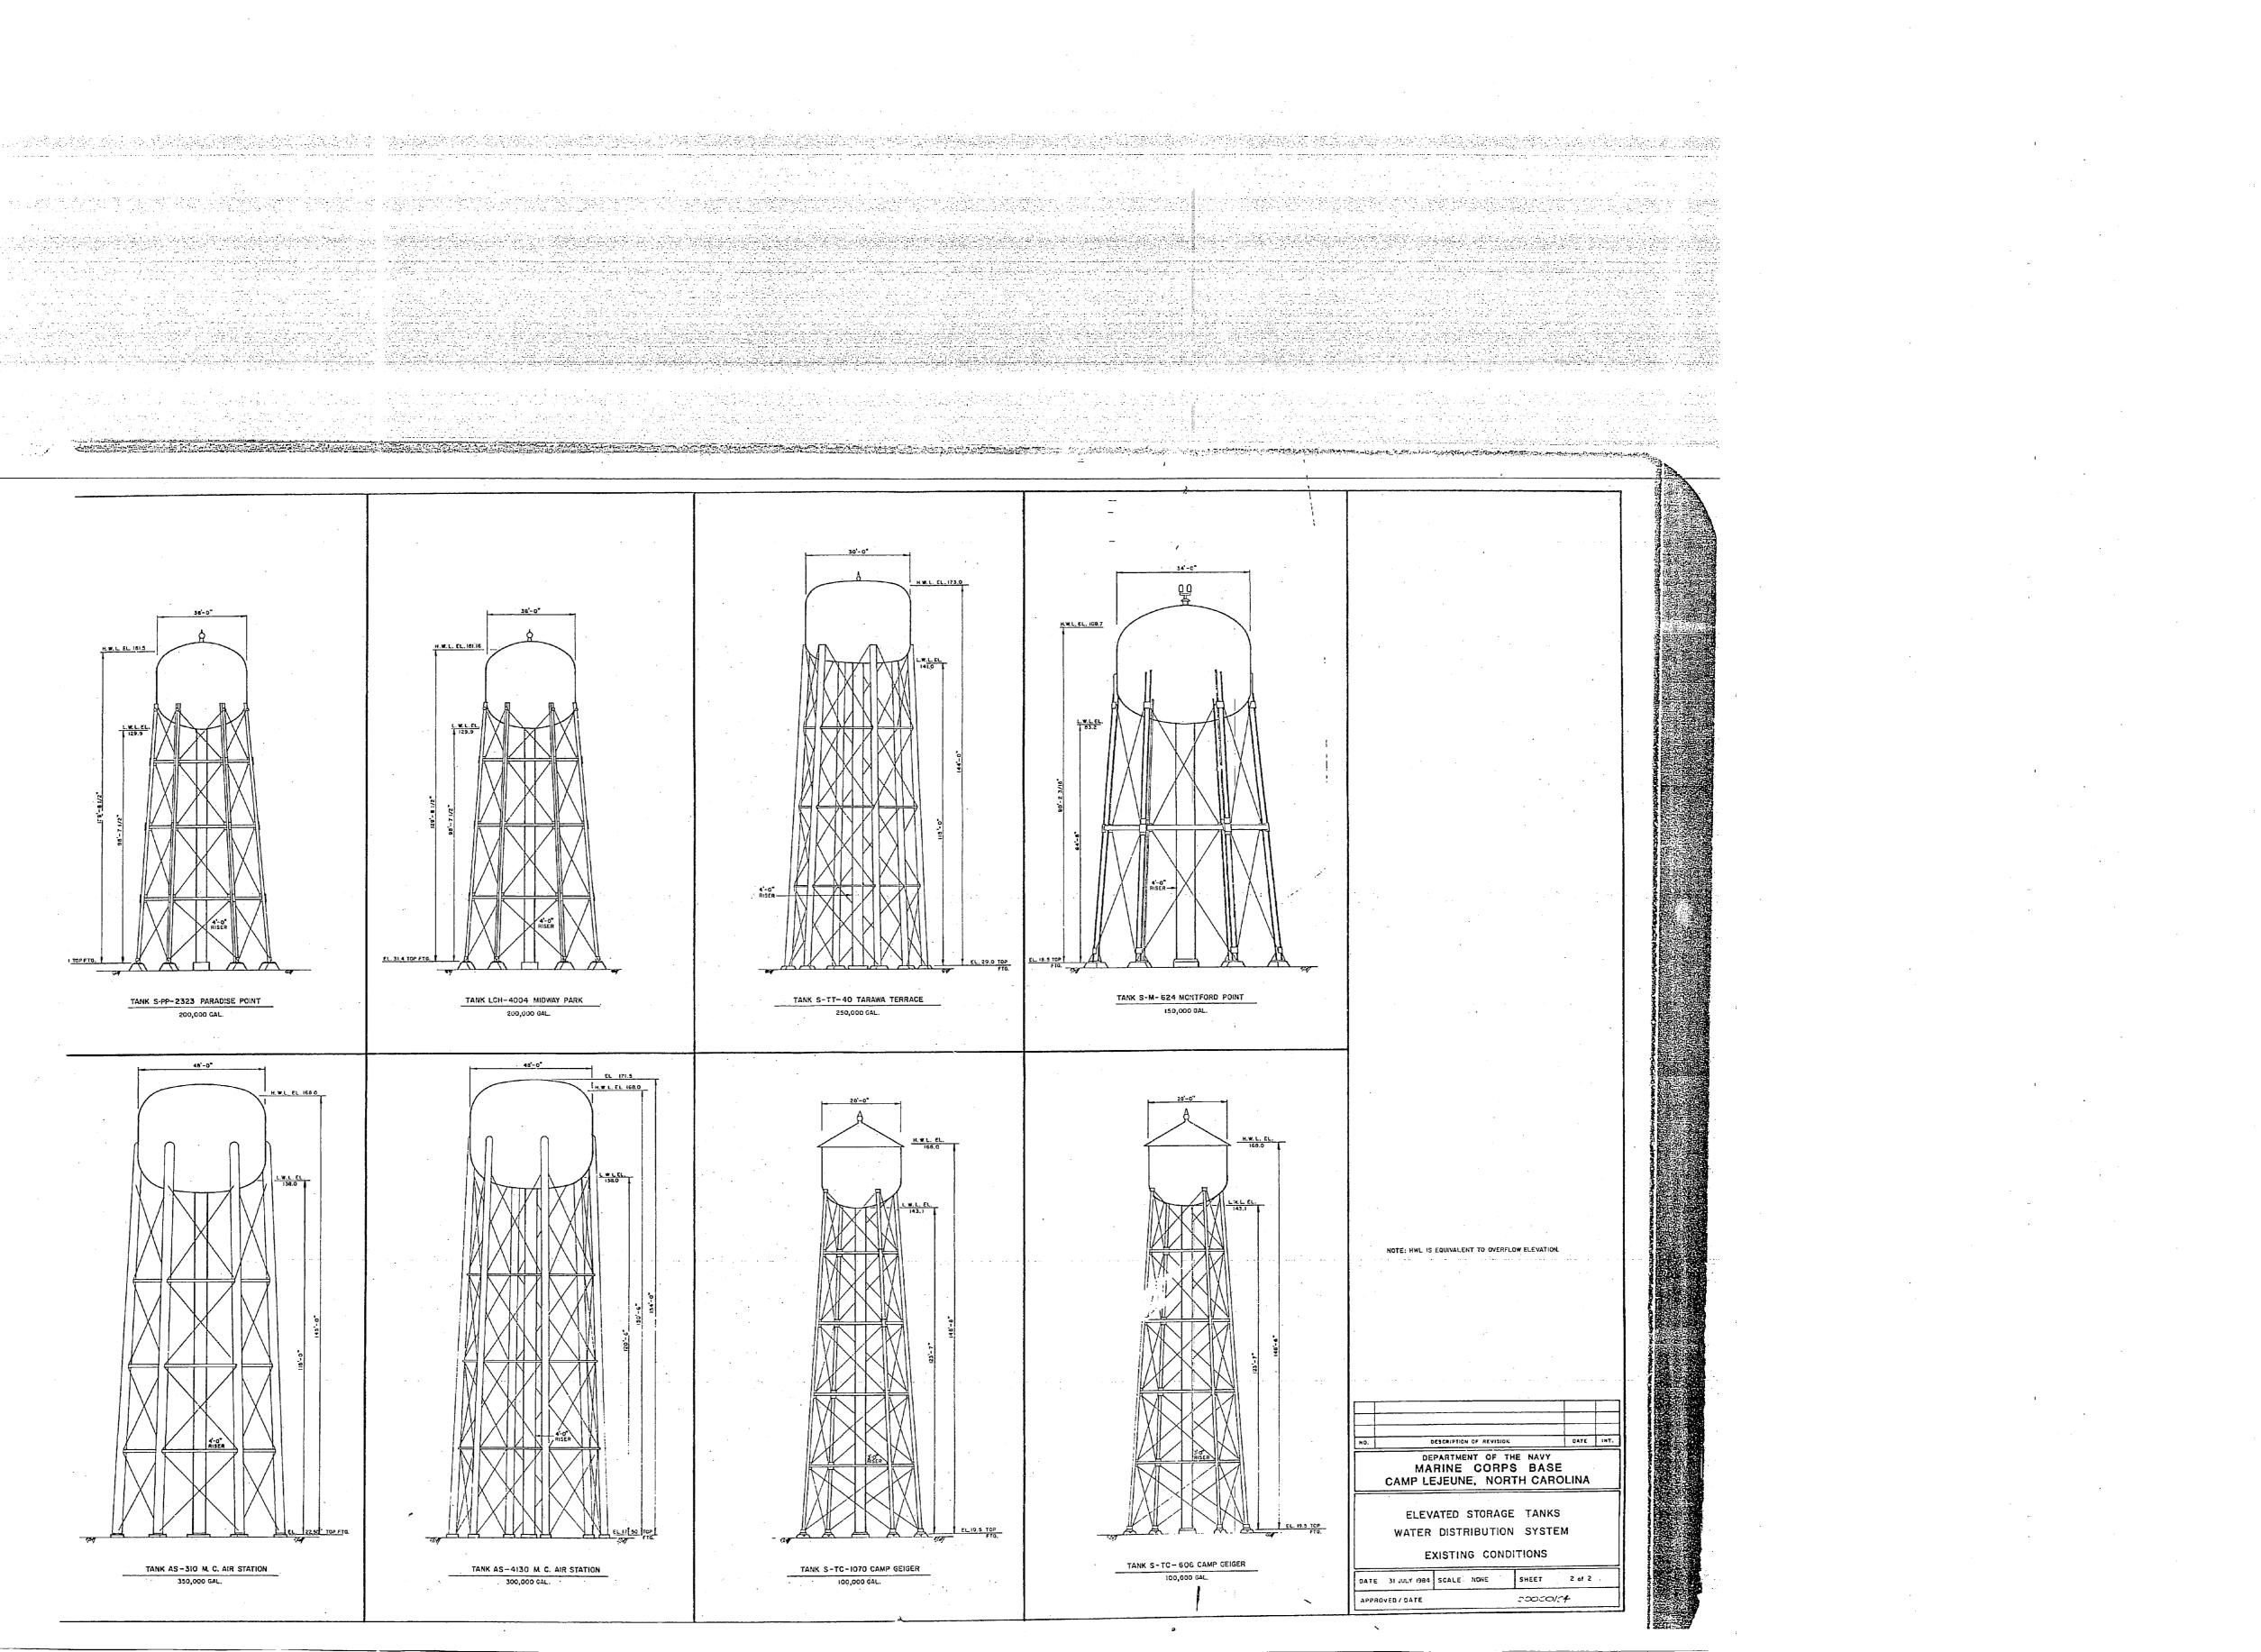

, u N the second se

1 1 1 A A A

· · · . 1 1 the state 1

· .

l . ц — П


. .


1

I. a de

1 N • •

i H

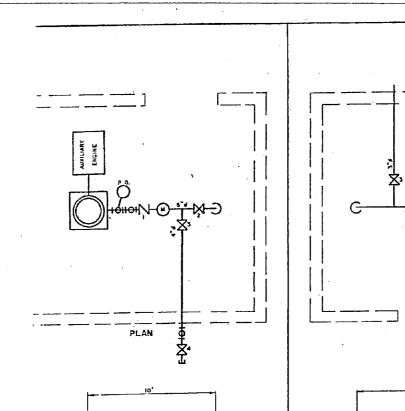


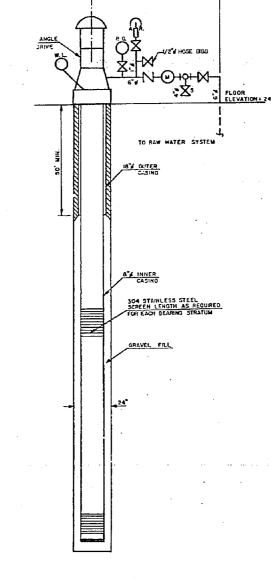

ELEVATION

CONTAMINATED

• WELL NO. HP 660 PUMP CAPACITY 250 GPN WELL YIELD DATE INSTALLED 1984

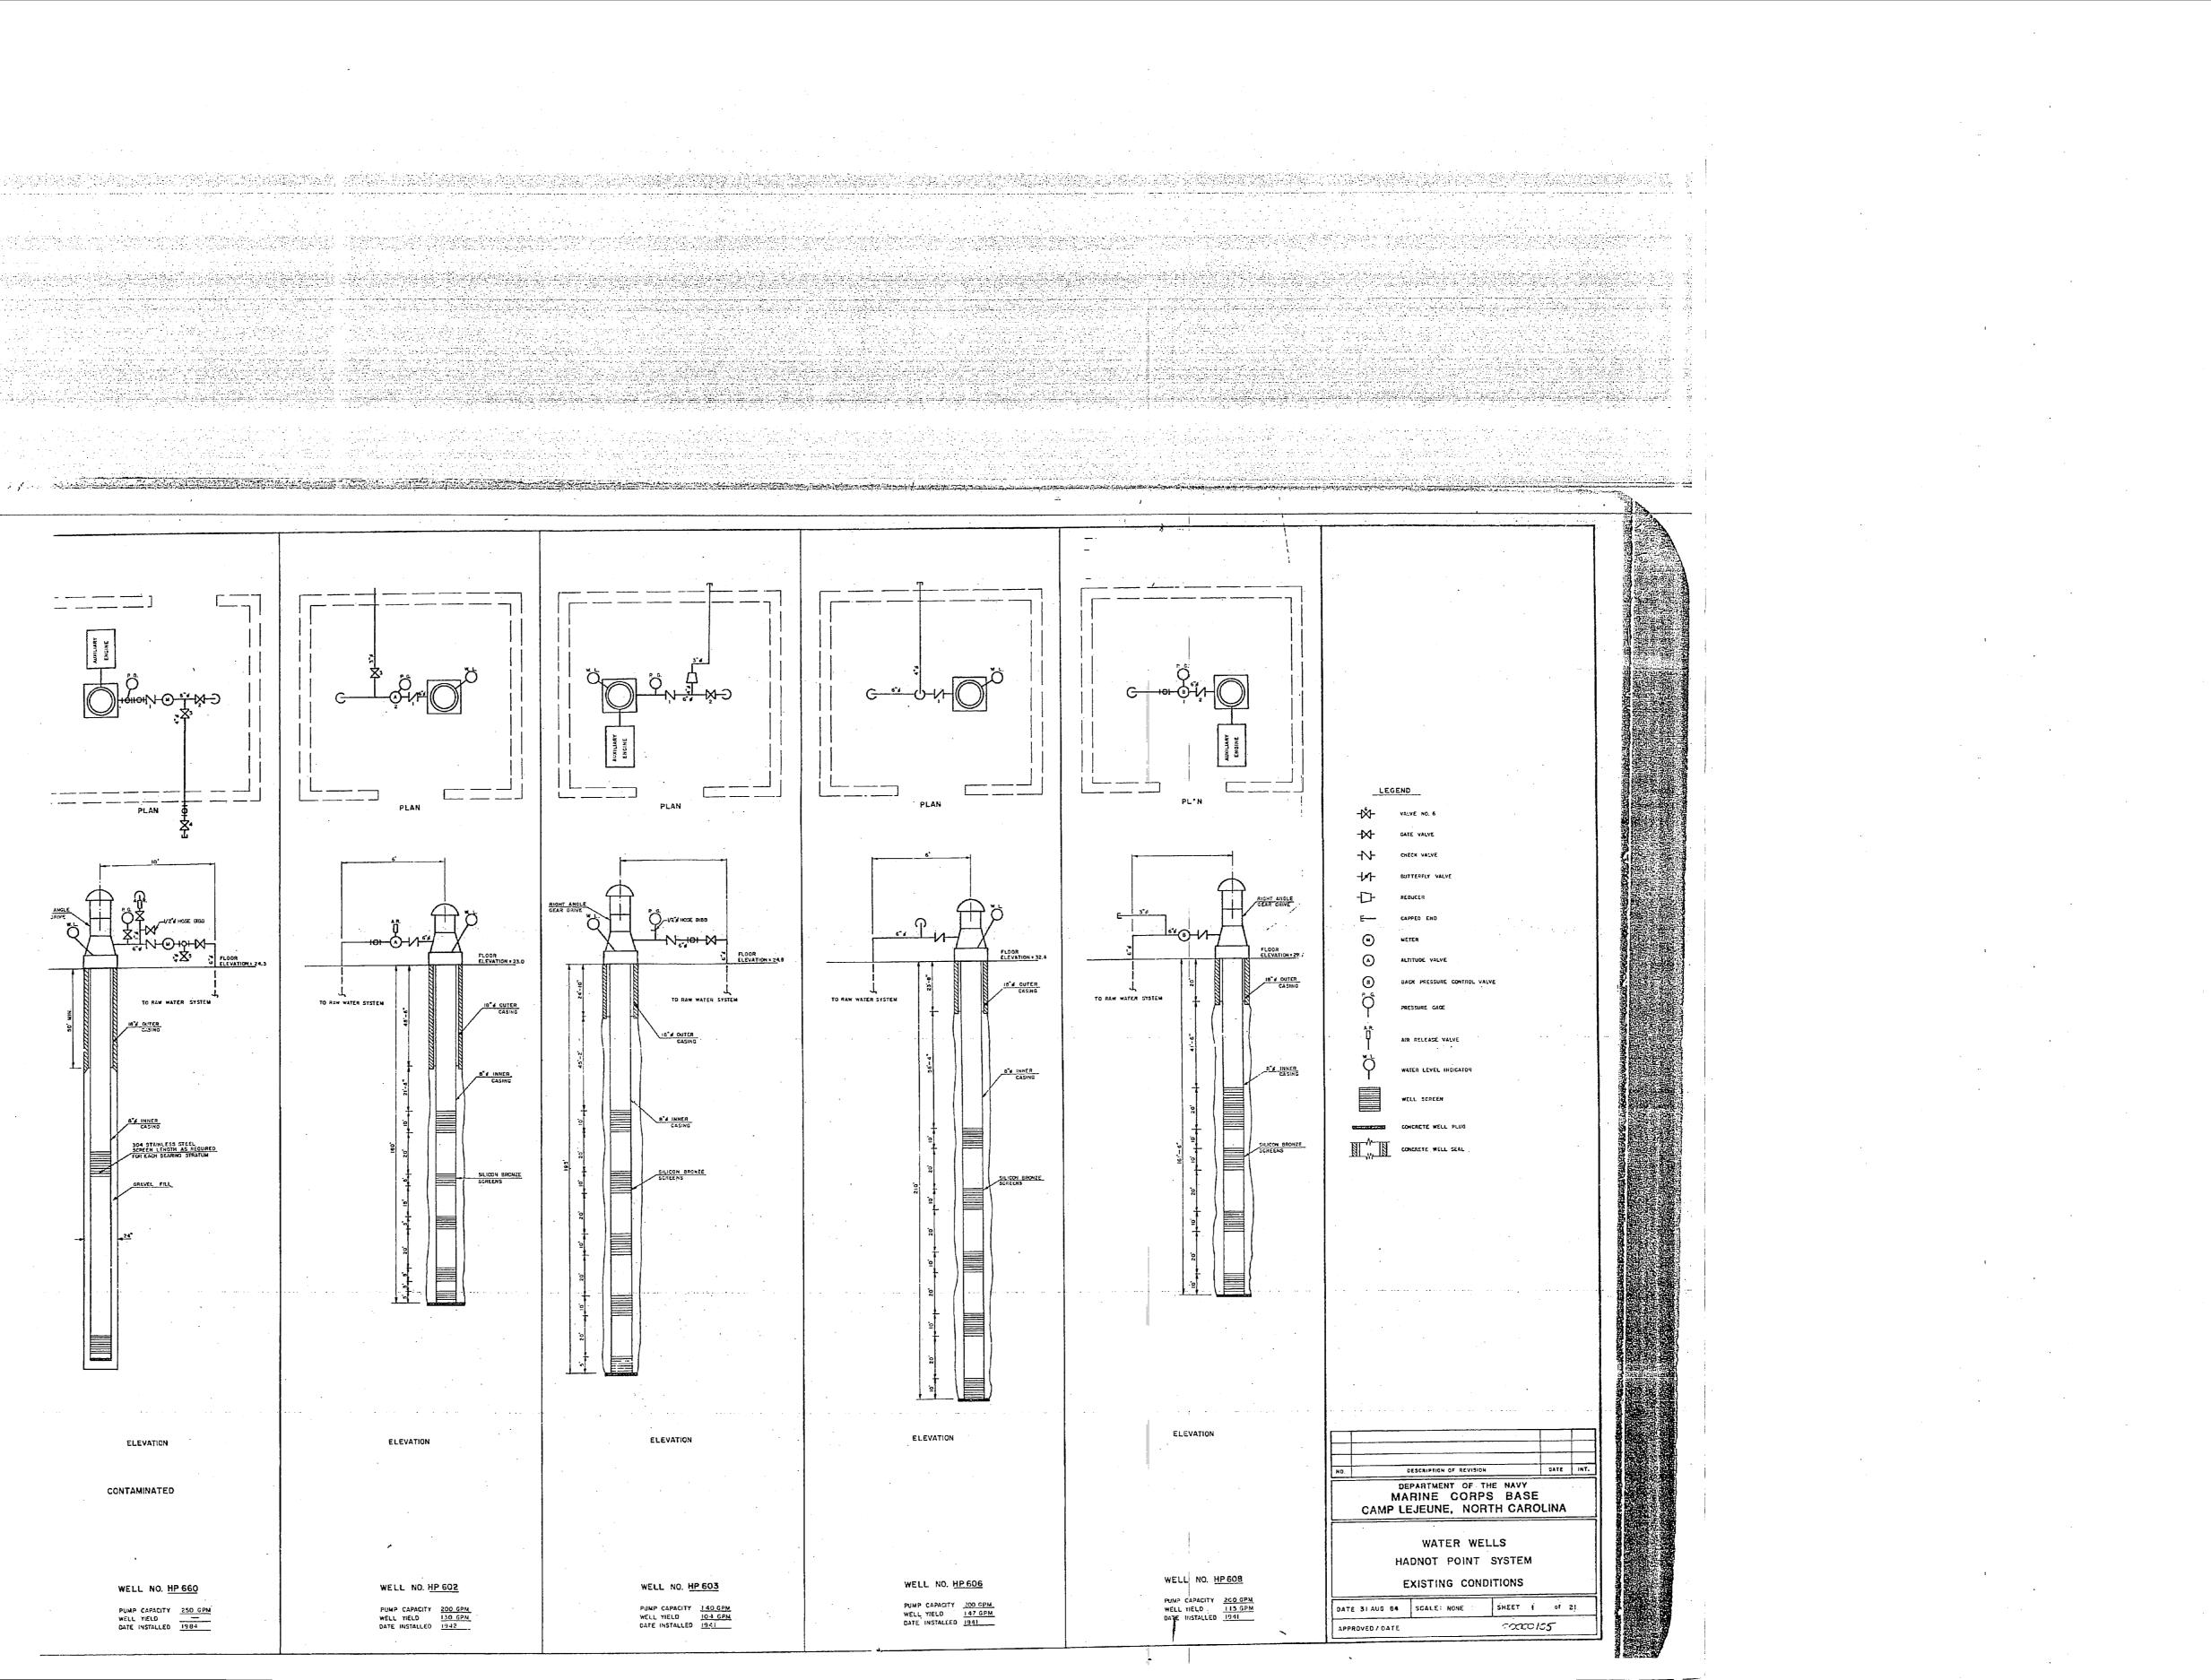

, , ÌI · · · · ·

1 N 1 · . i N

· . • ı İ , •

· . . € ₩

A LA

.

lj l

. | ı.


i i

1 1 • •

. . . ∎ L' L'

• • 1 1

and the Course

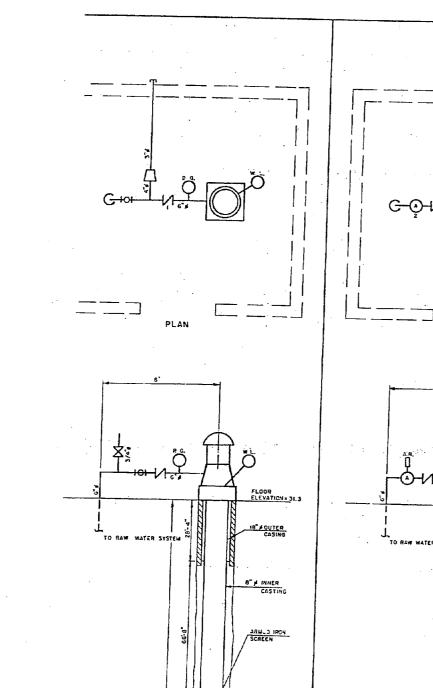

-0-1/-

.

.


. ,

1

ELEVATION

WELL NO. HP.616

PUMP CAPACITY <u>200 GPM</u> WELL YIELD <u>210 GPM</u> DATE INSTALLED <u>1942</u>

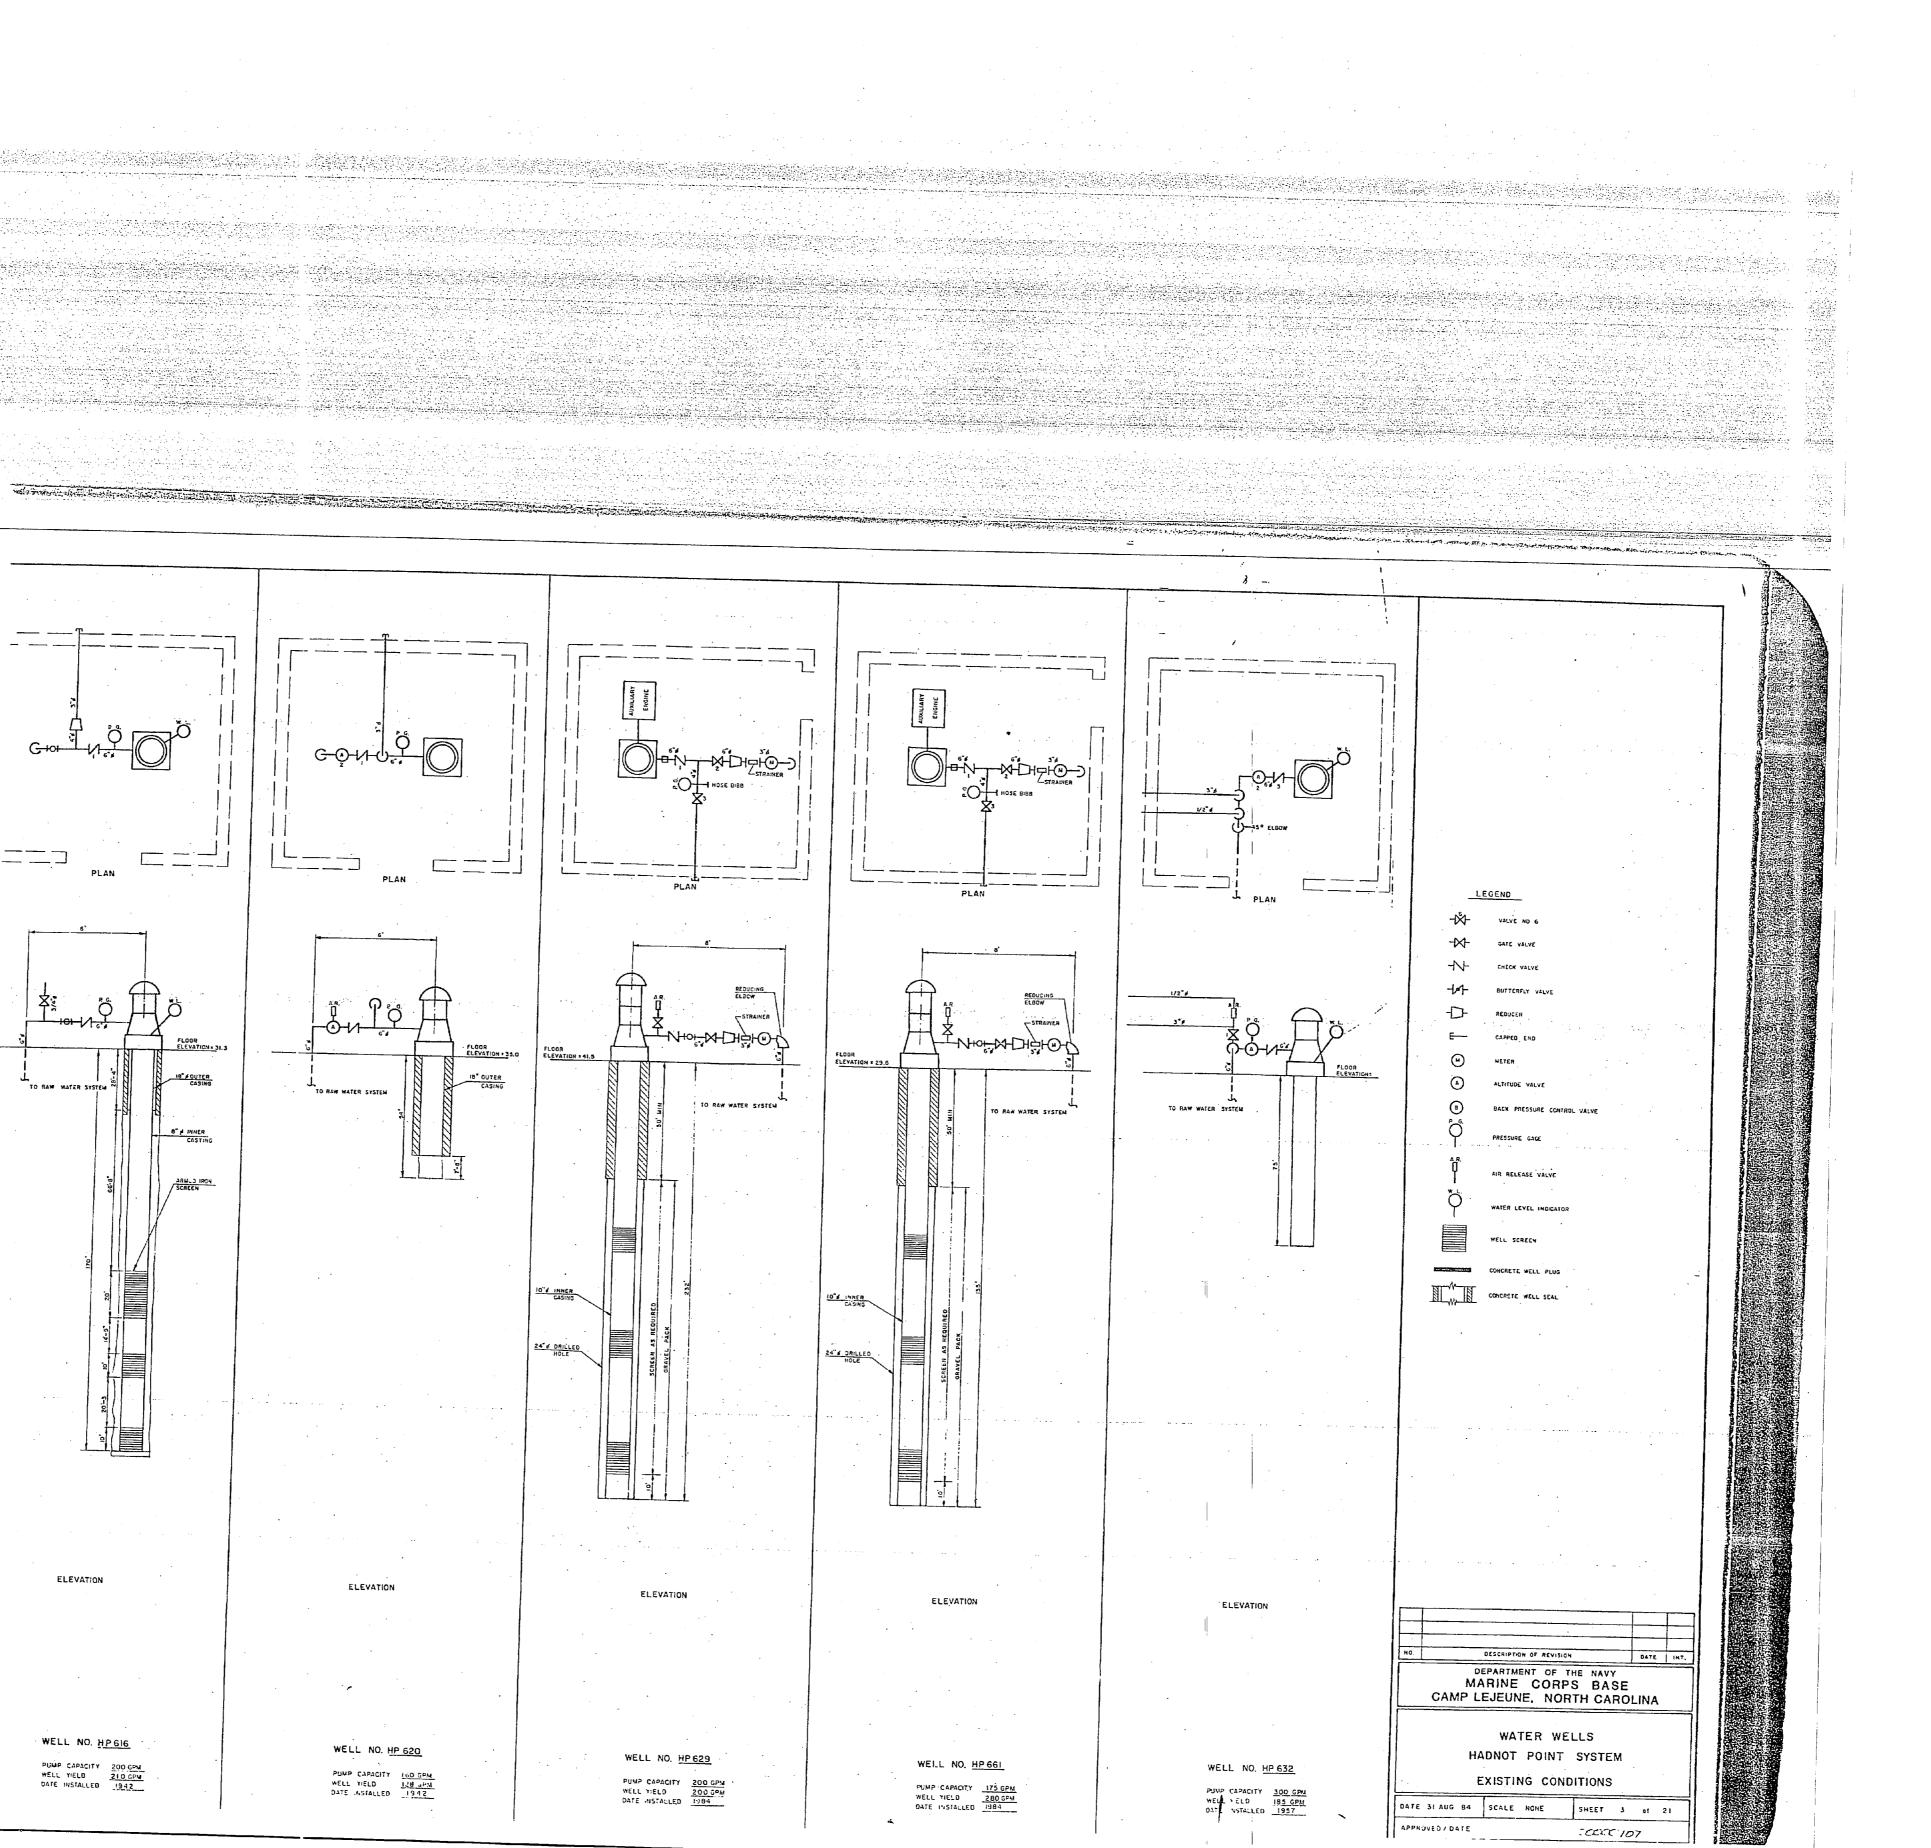

.

i F


t A in the

1 H 1. L. 1 1


L'ST L i A

• • 1 1

والأبوا والمعادلة والمروا الموادين والأولية والمؤاج والمروا والمعاد والمروا والمعاد المراد المعاد المعاد en en ante de la companya en la companya de la comp La companya de la comp

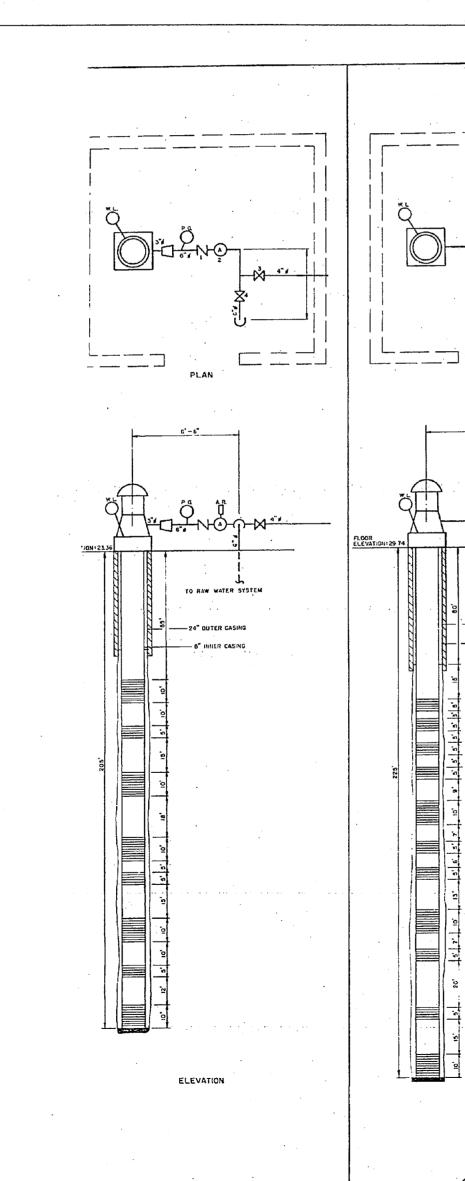

WELL NO. HP 633 PUMP CAPACITY 200 GPM WELL YIELD 175 GPM DATE INSTALLED 1960

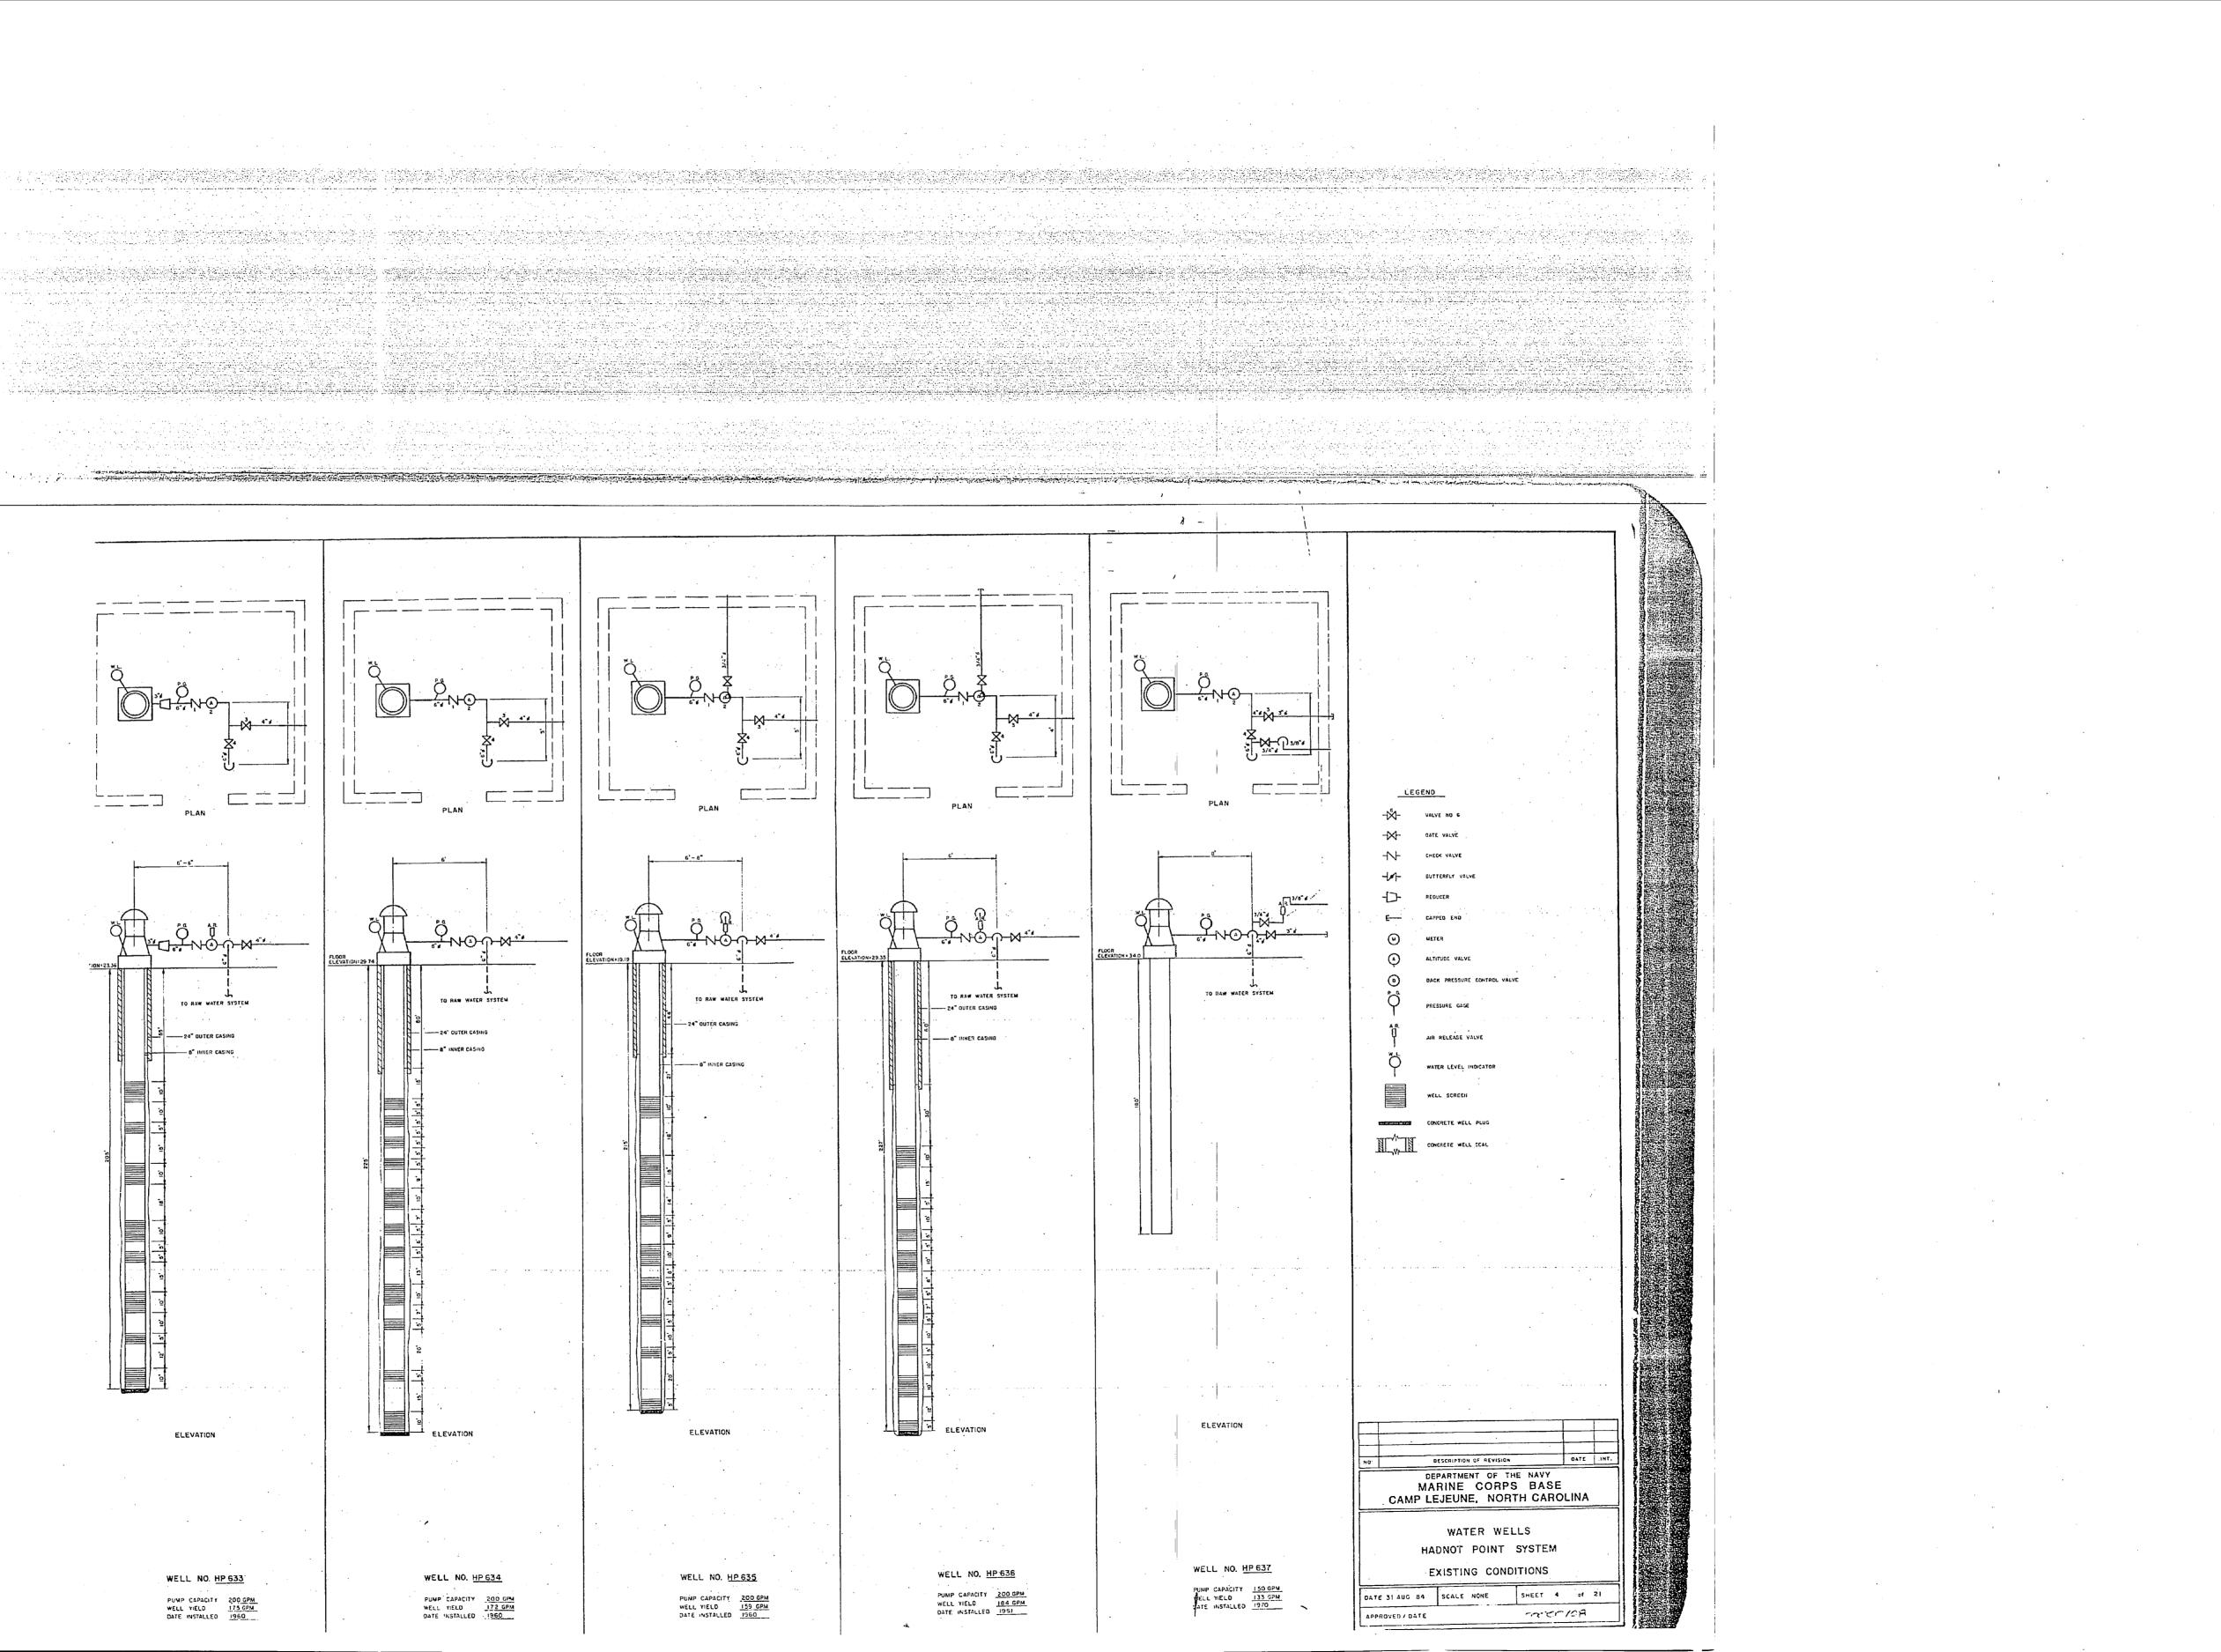












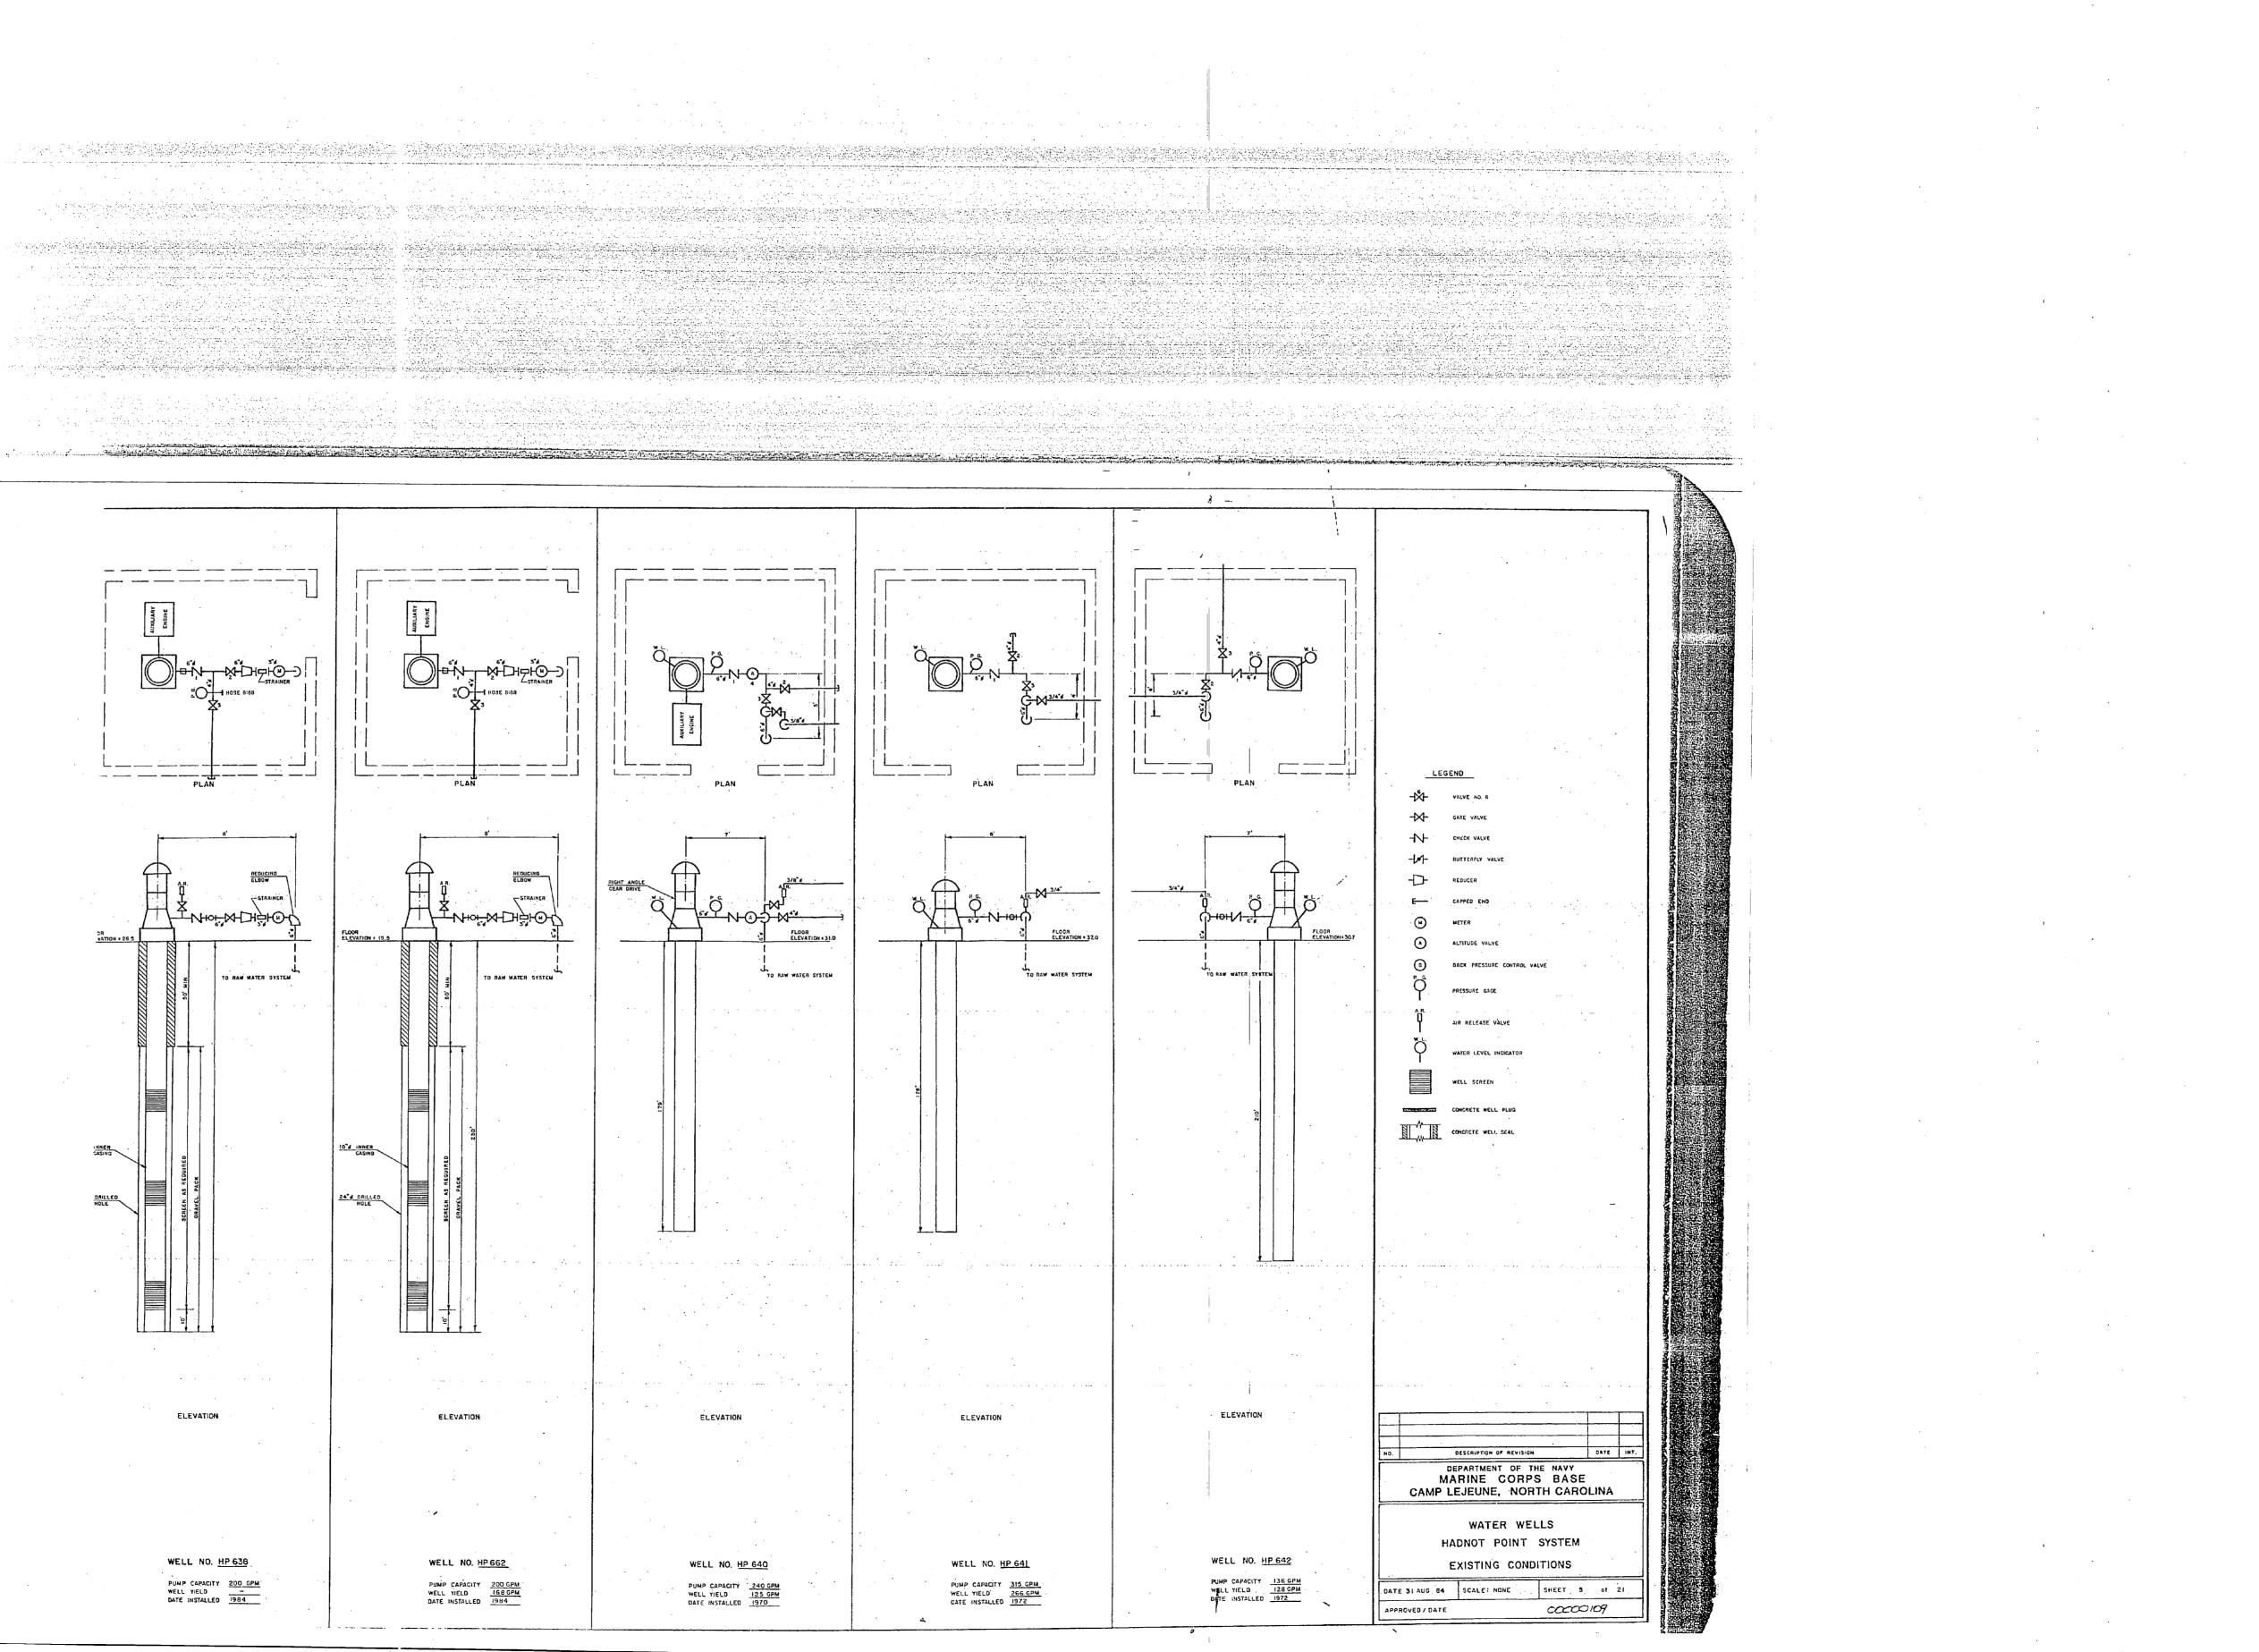













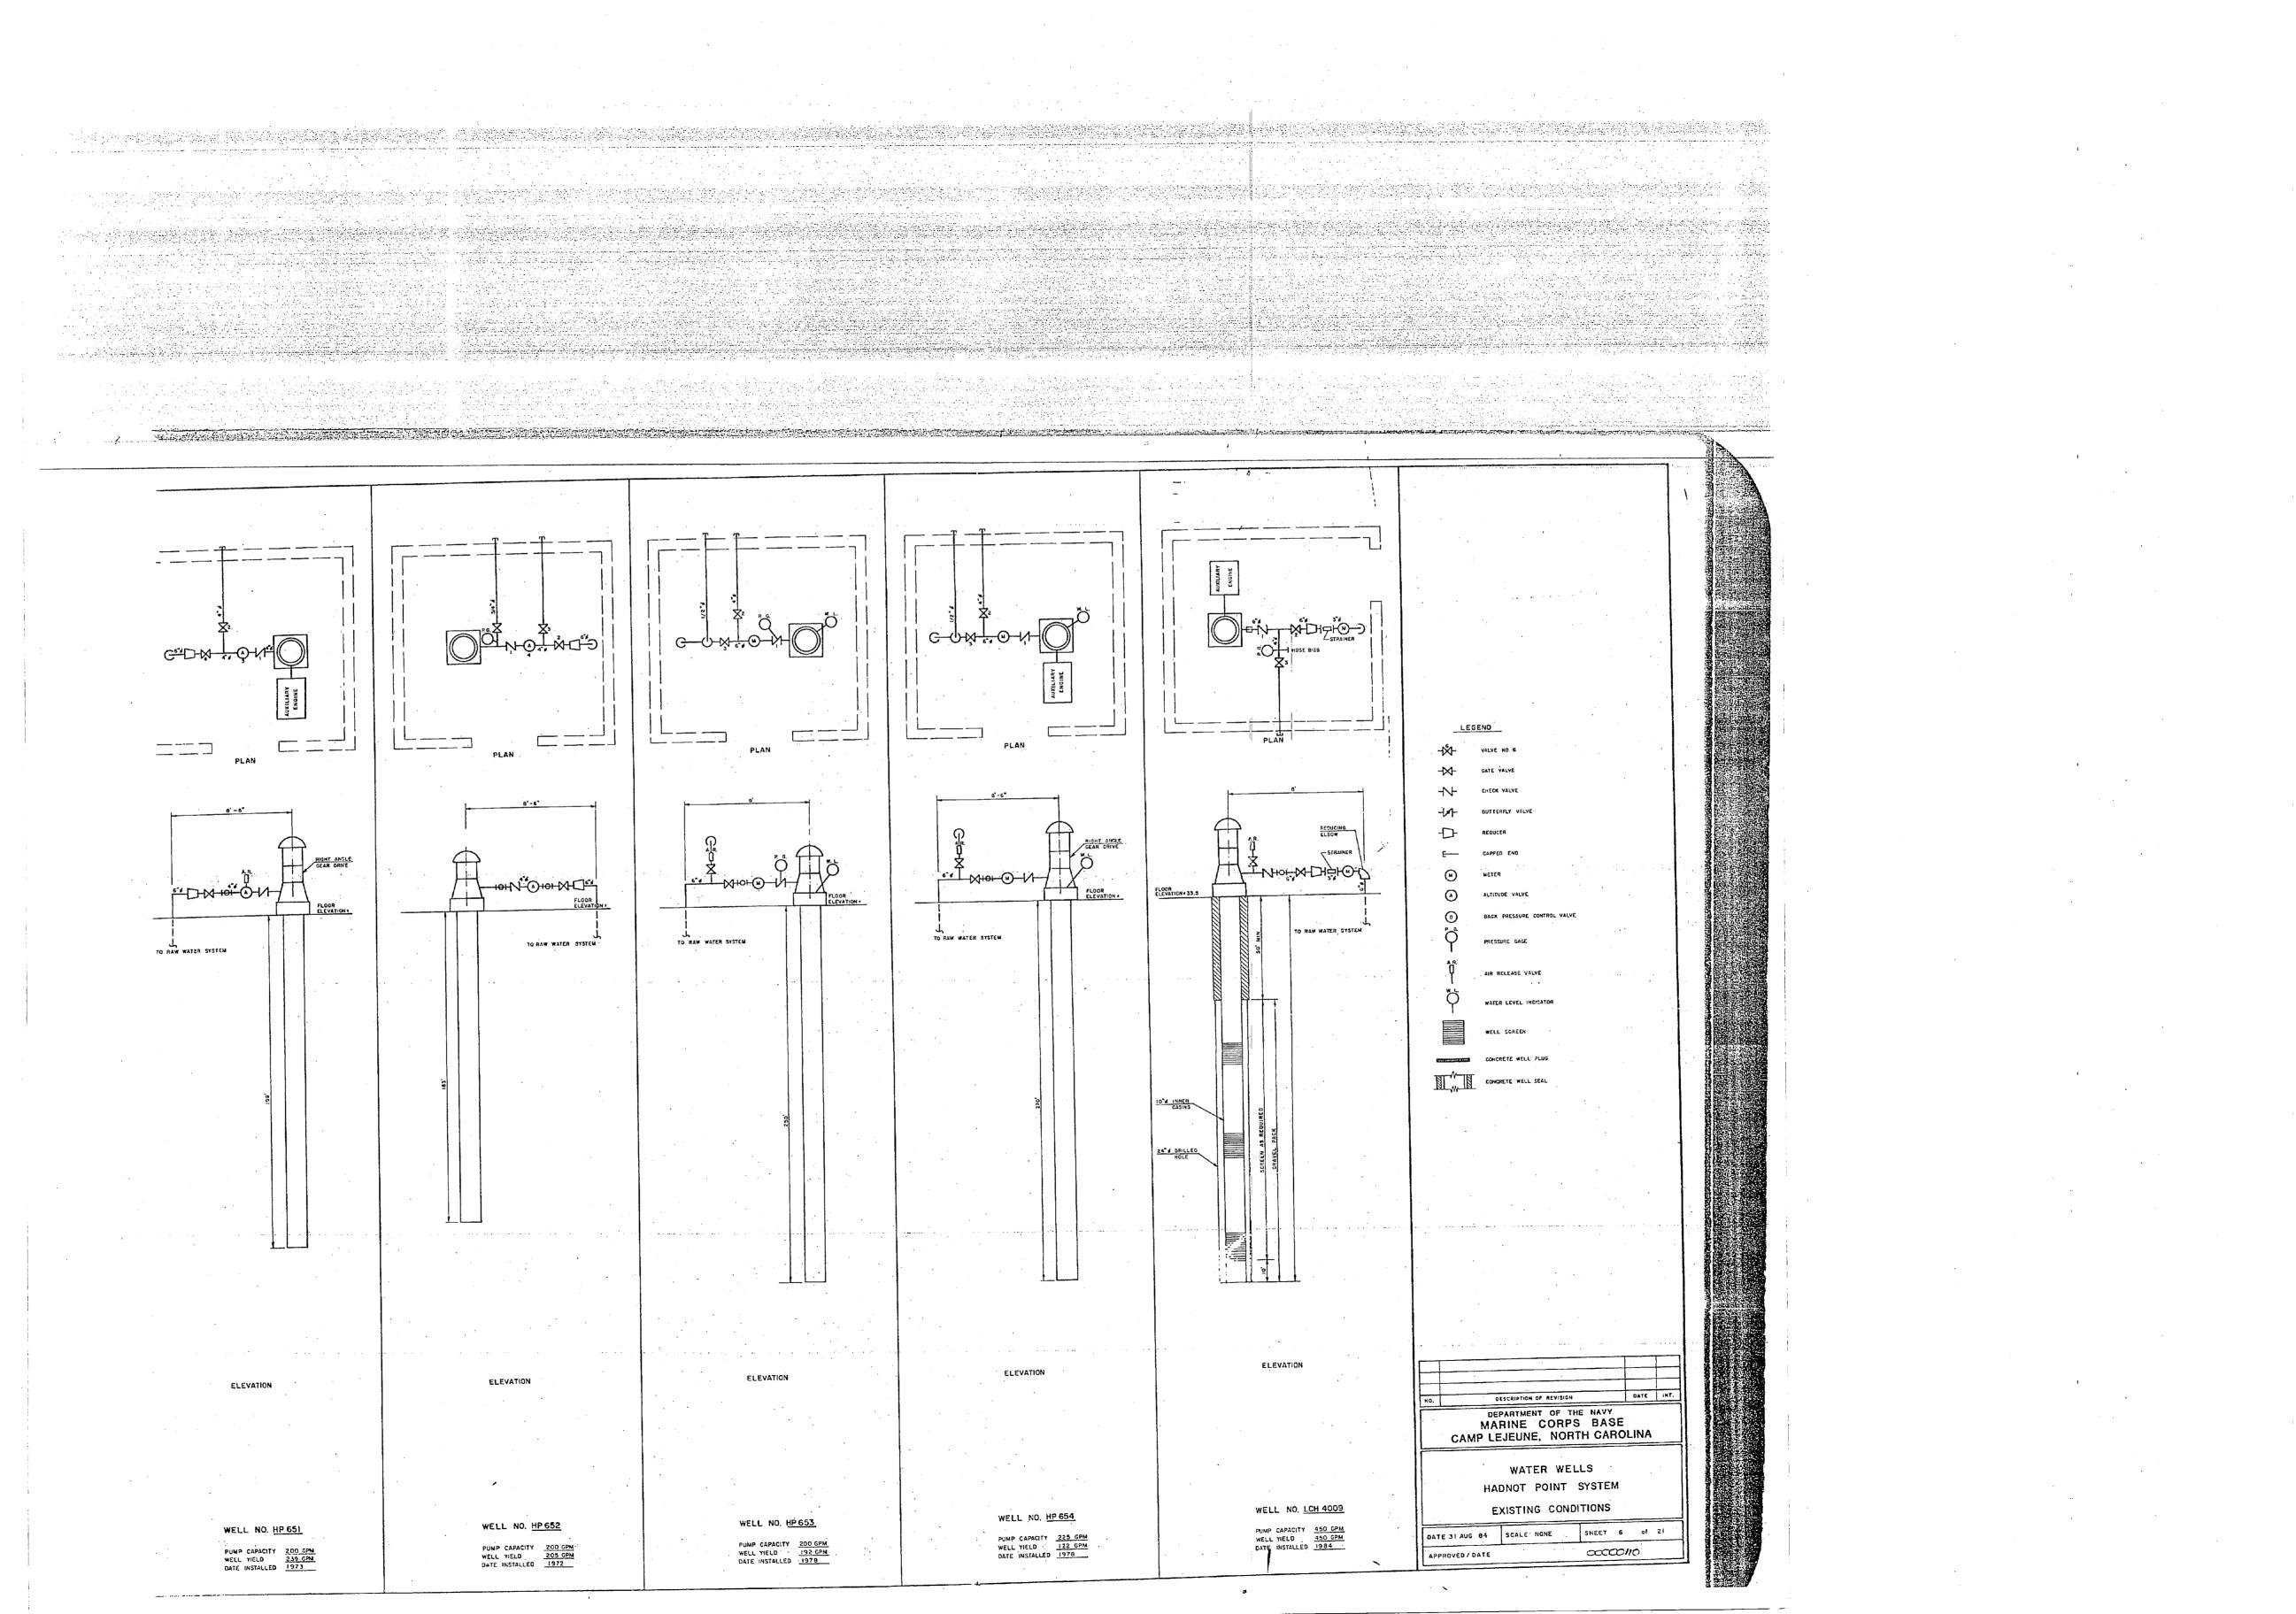

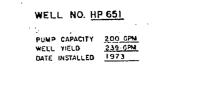

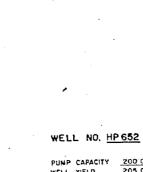














 

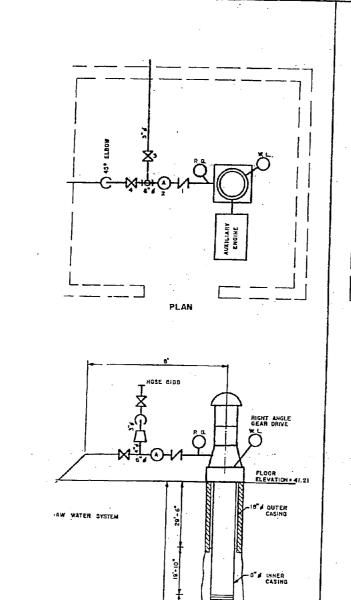

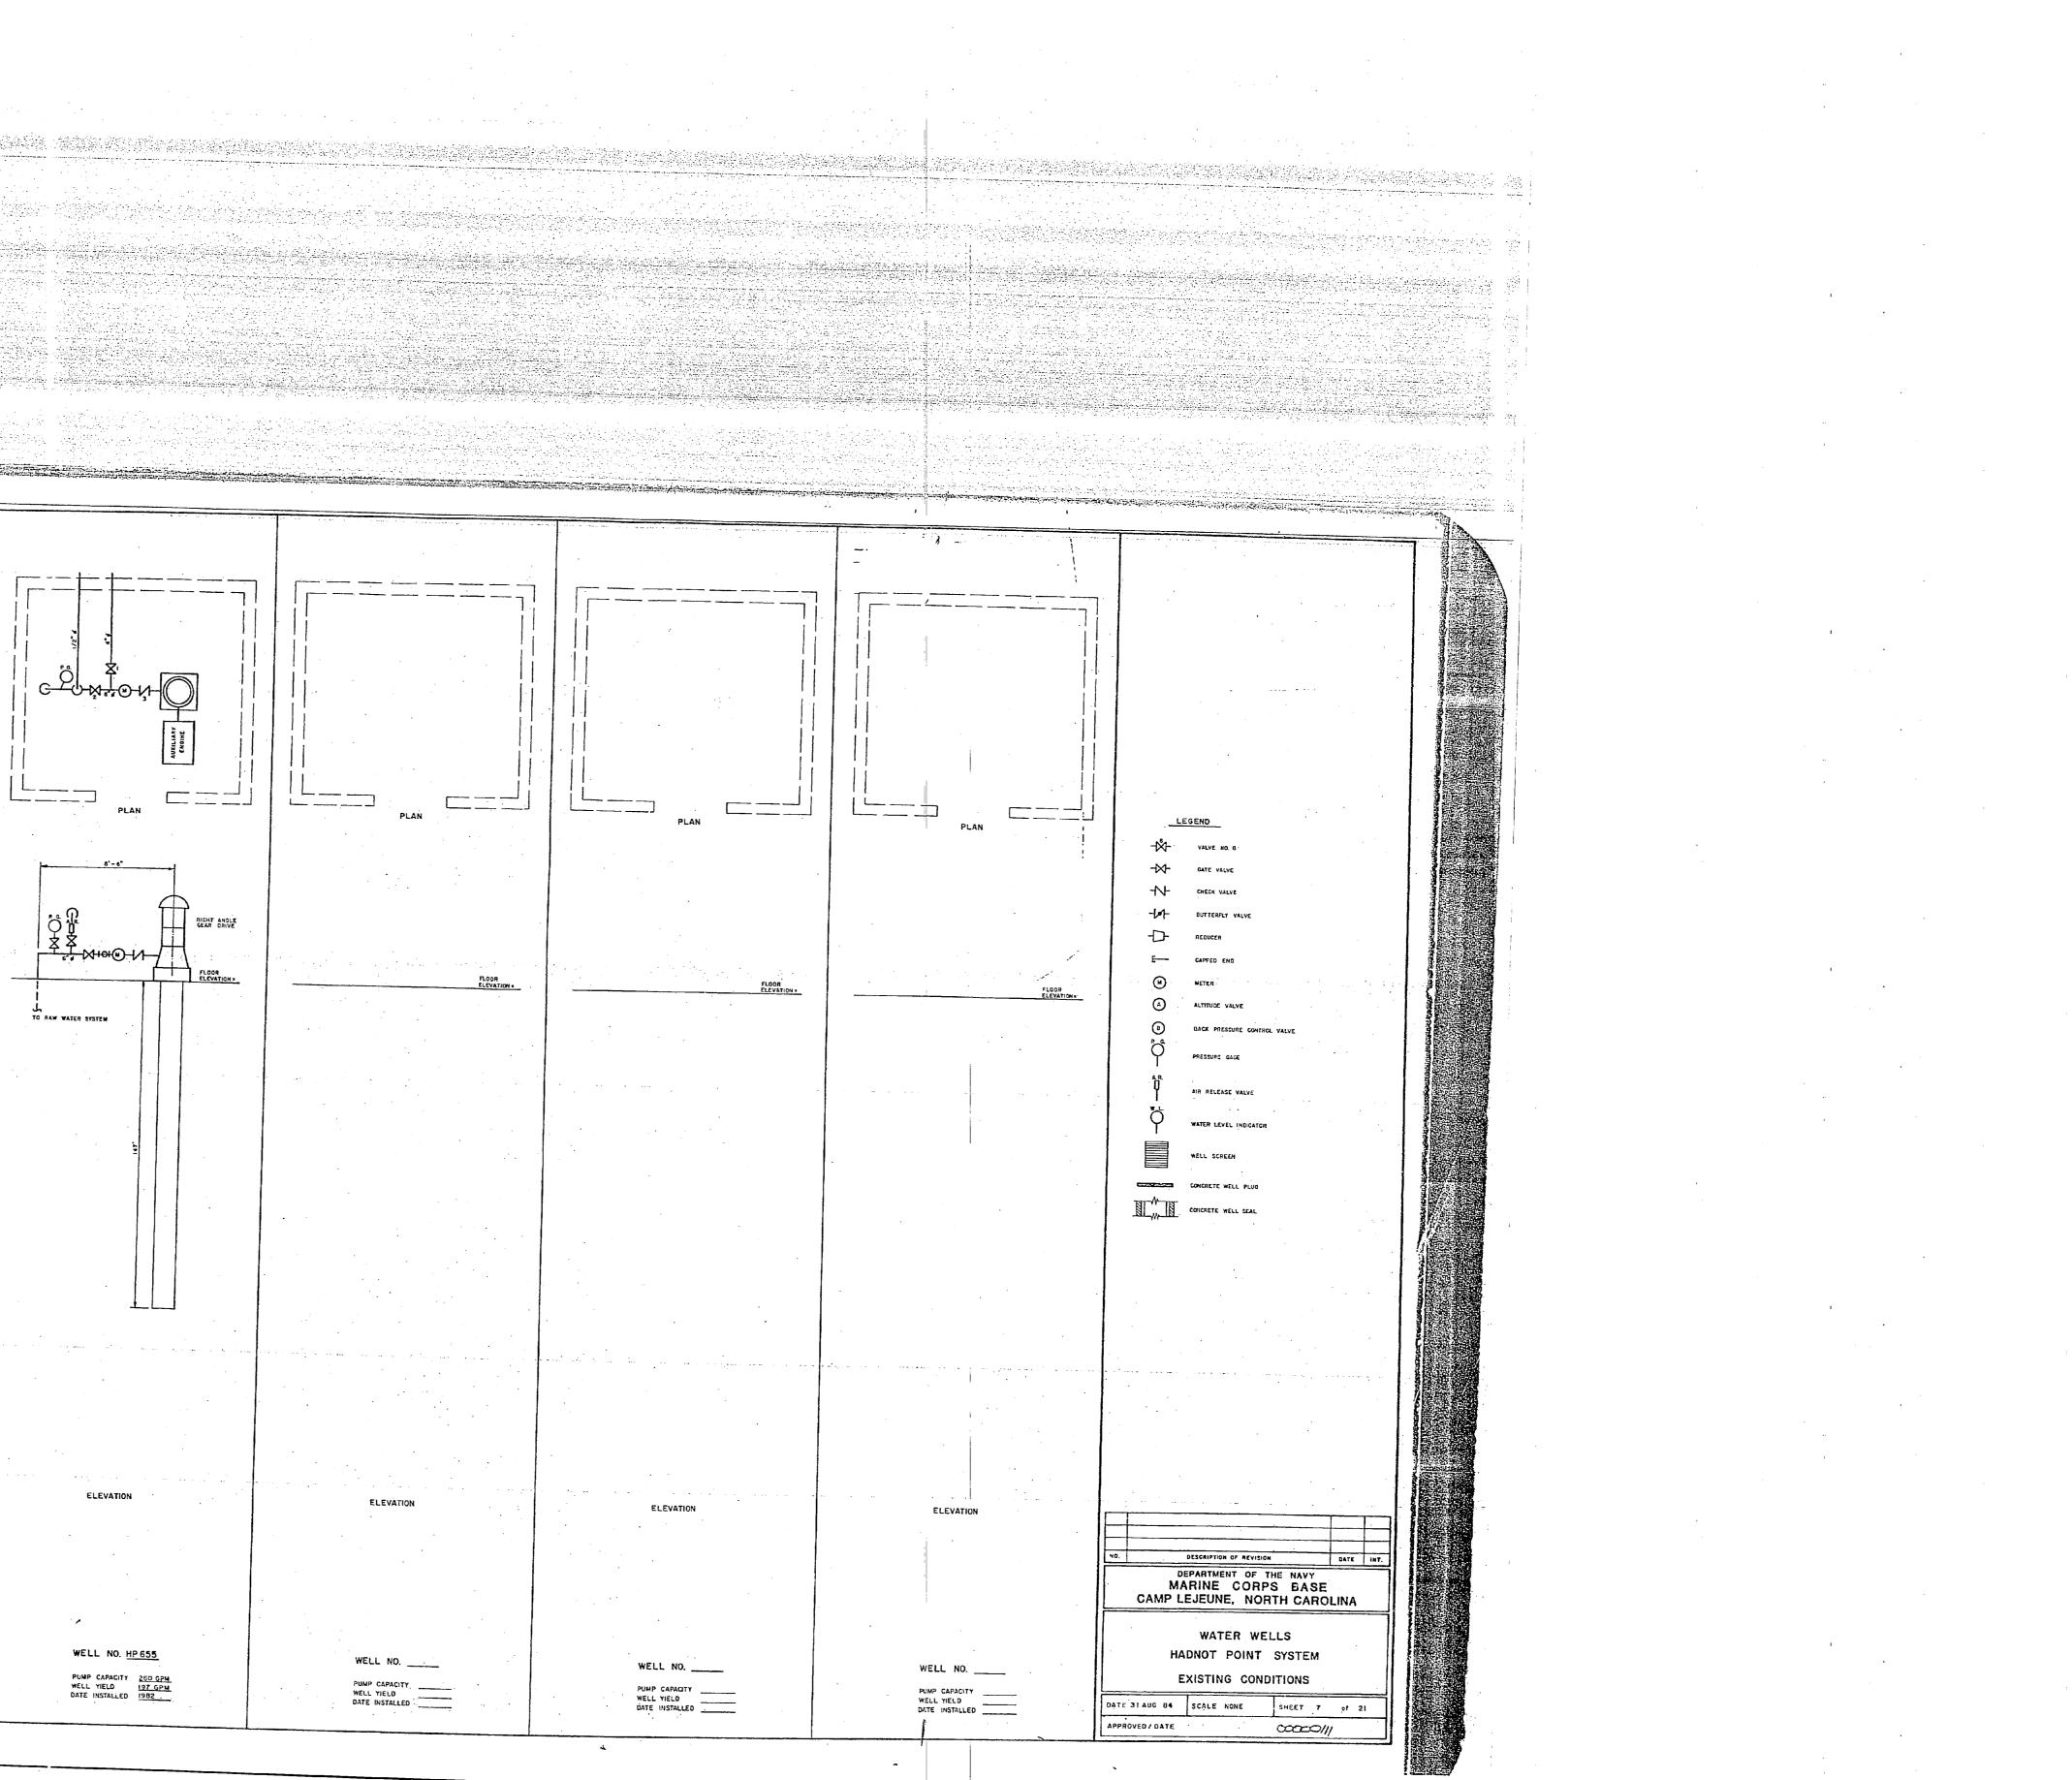

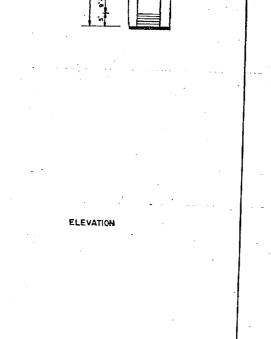

WELL NO. LCH 4007 PUMP CAPACITY 320 GPM WELL YIELD 104 GPM DATE INSTALLED 1942









 

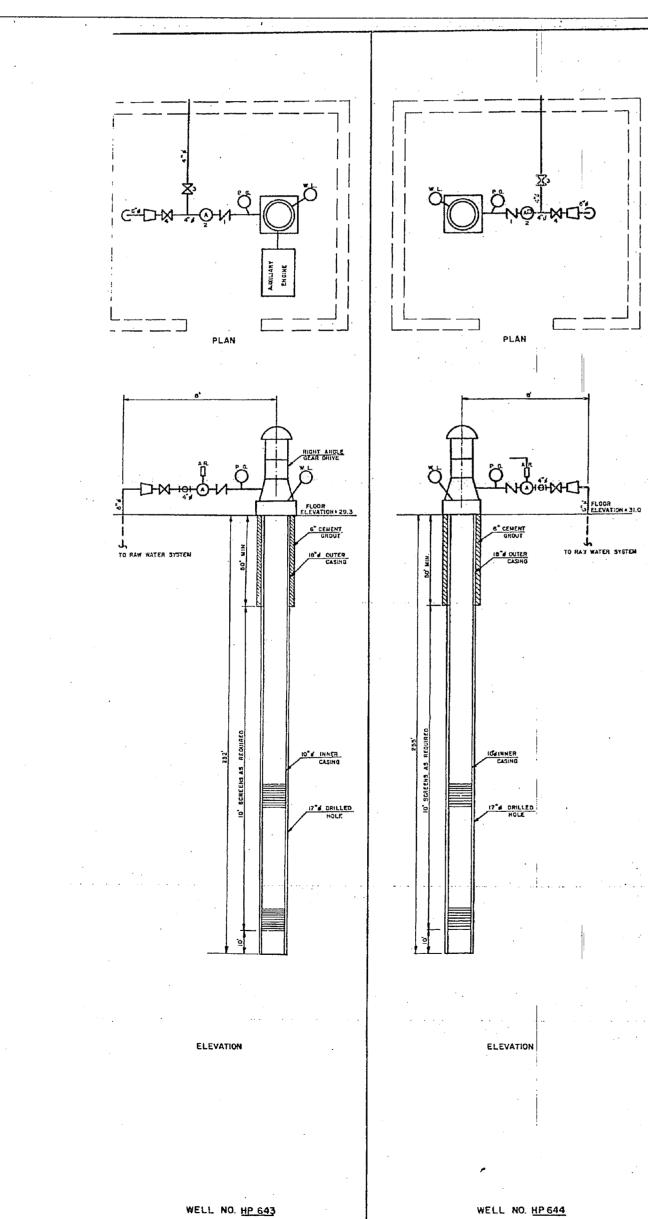


PUMP CAPACITY <u>260 GPN</u> WELL YIELD <u>197 GPN</u> DATE INSTALLED <u>1973</u>

PUMP CAPACITY <u>260 GPM</u> WELL YIELD <u>180 GPM</u> DATE INSTALLED <u>1973</u>

 




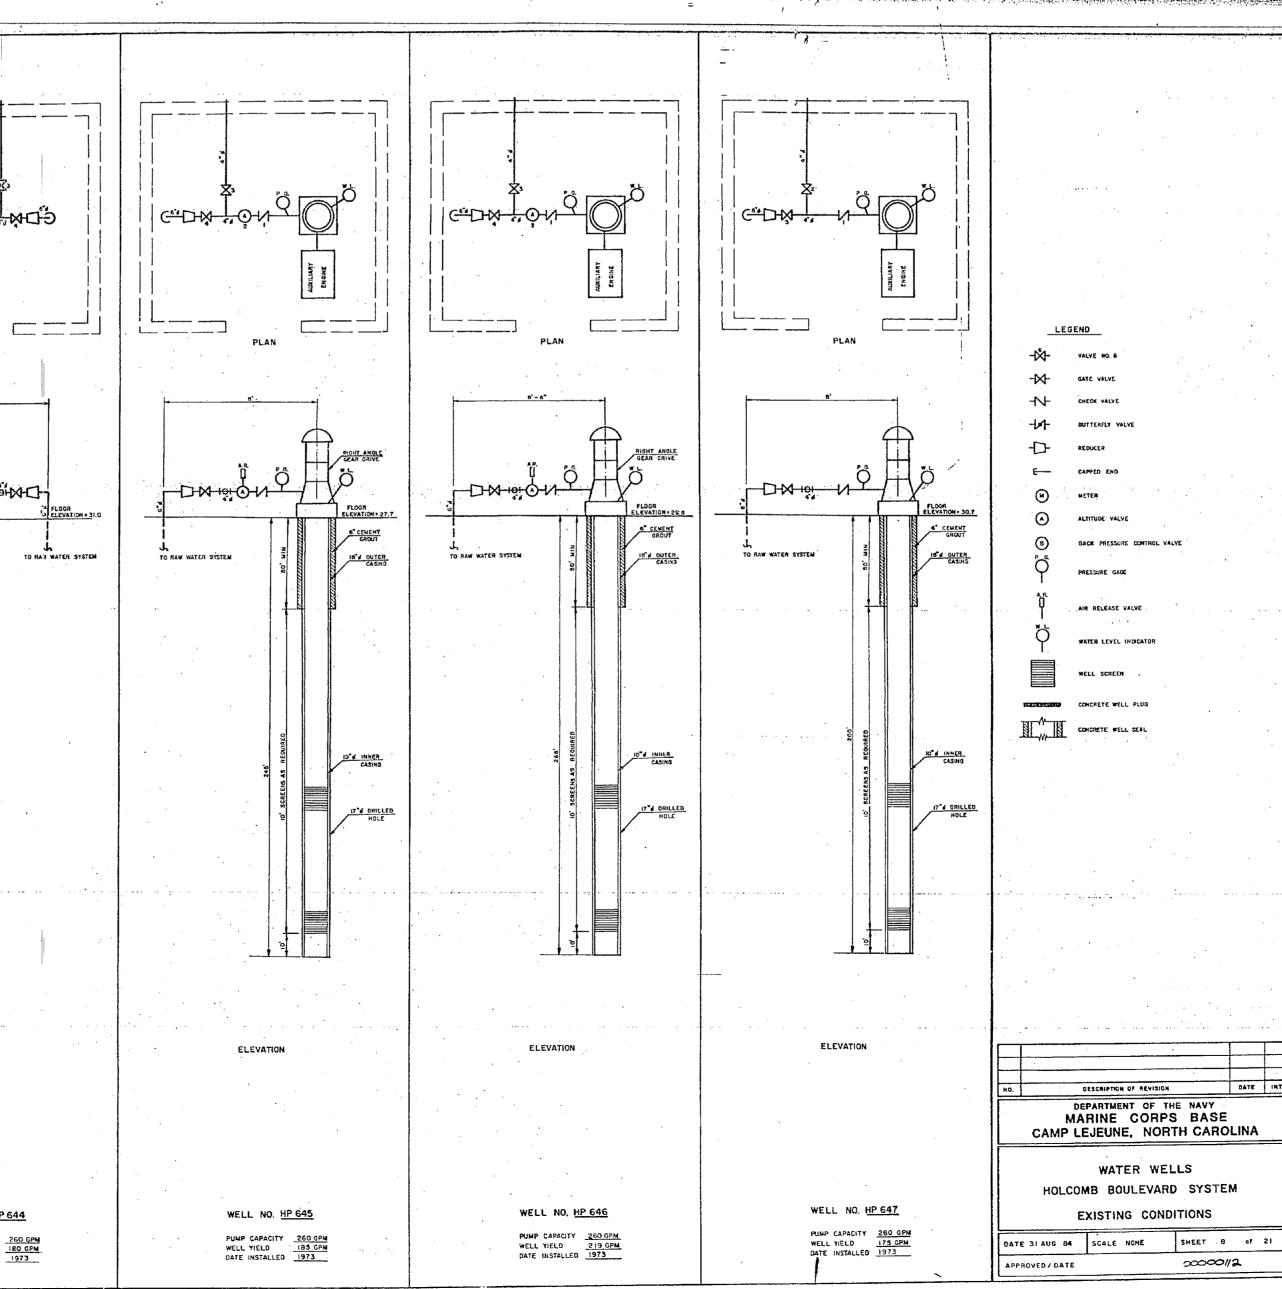

э

`

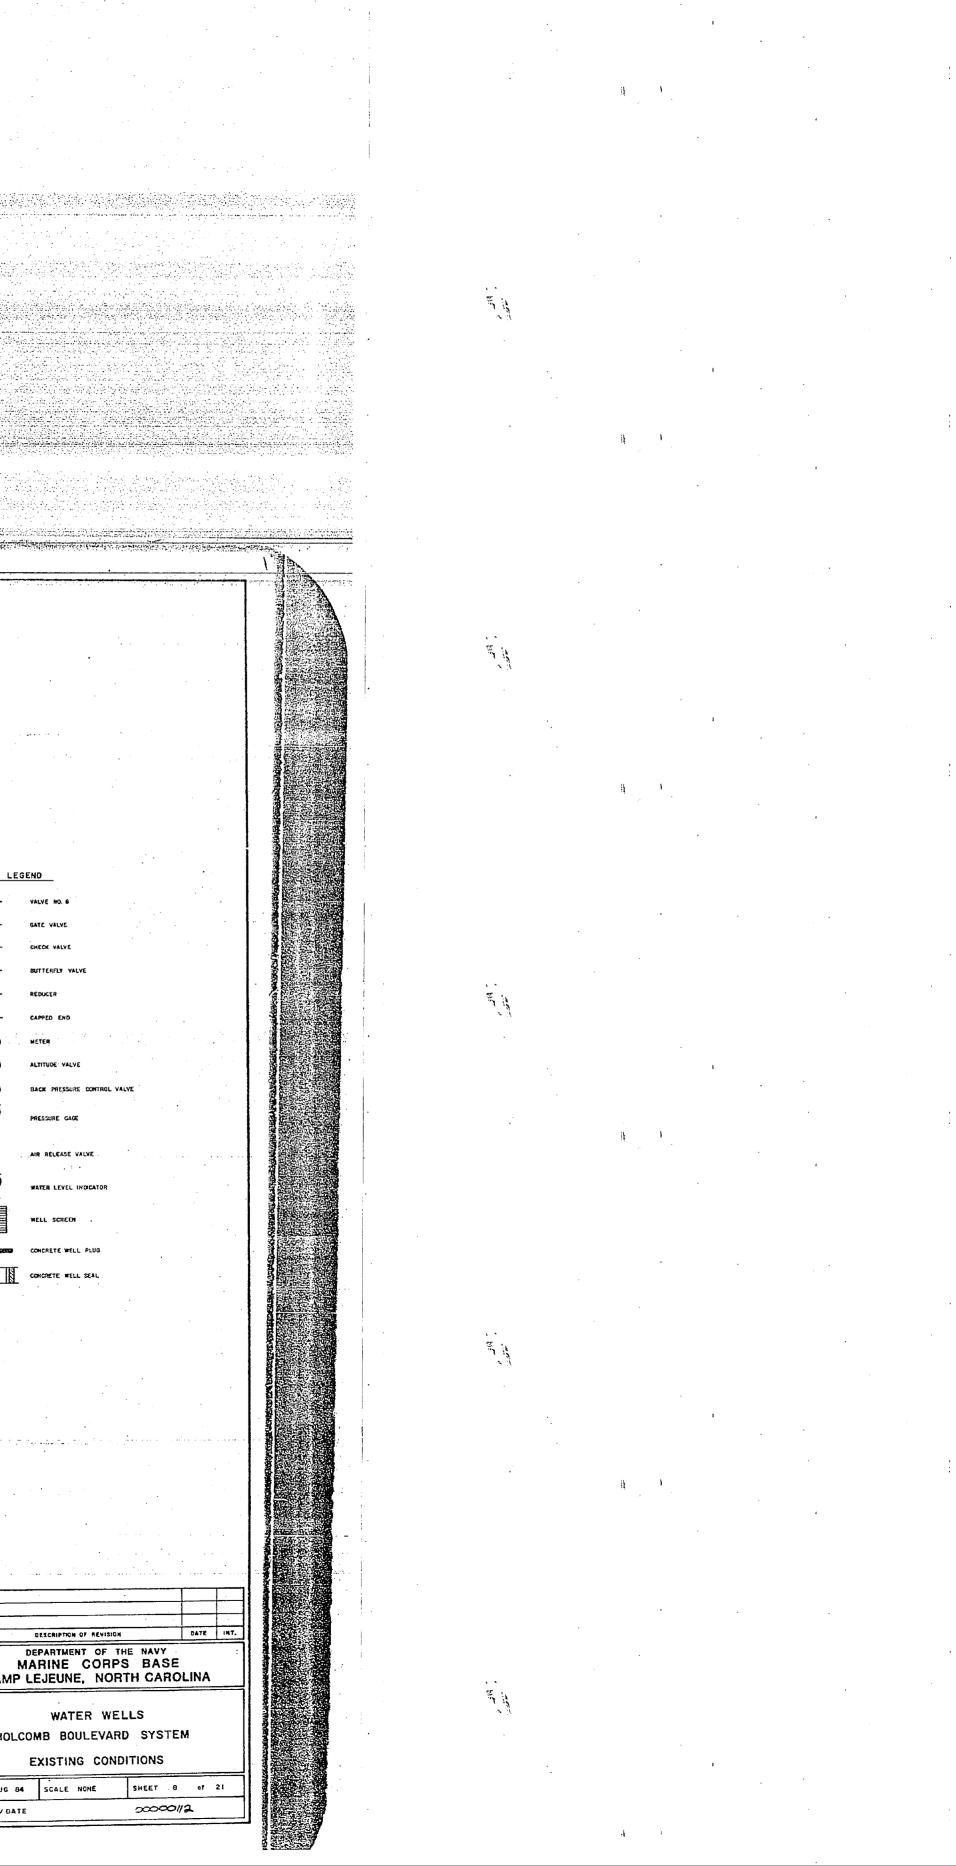

t I

. . · . , <u>1</u>

· .

i ₩ , 1

. . . . · · · · , 1

. . I

A A A


· .

.

I

1 La La


1 a k t łł


1. k. 1 1


• •



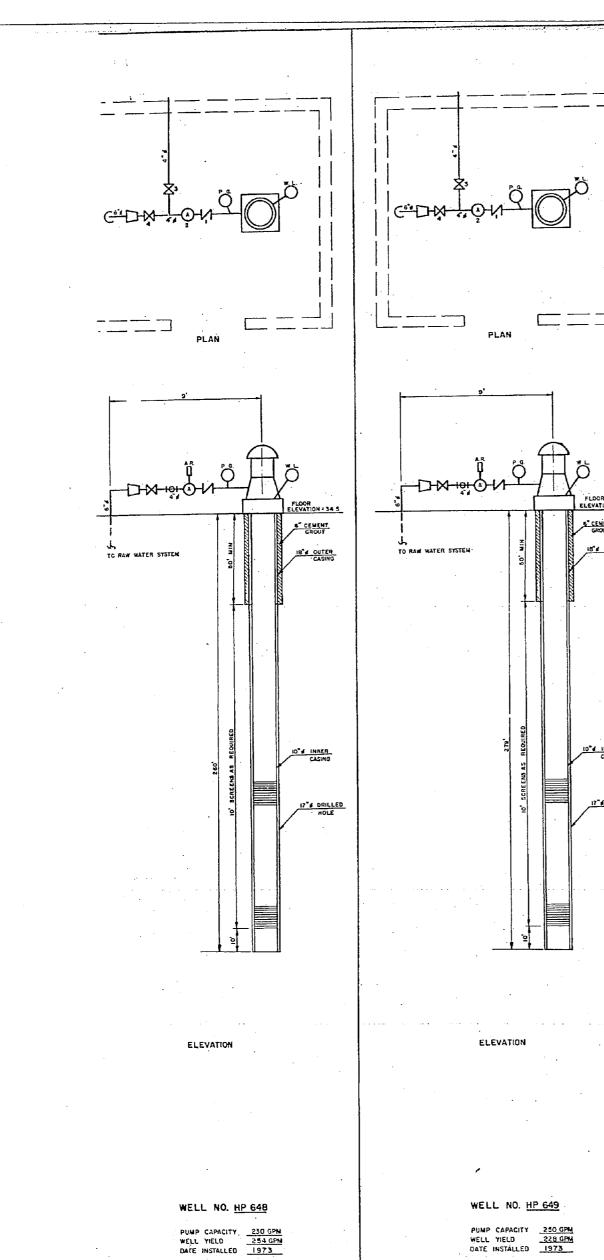

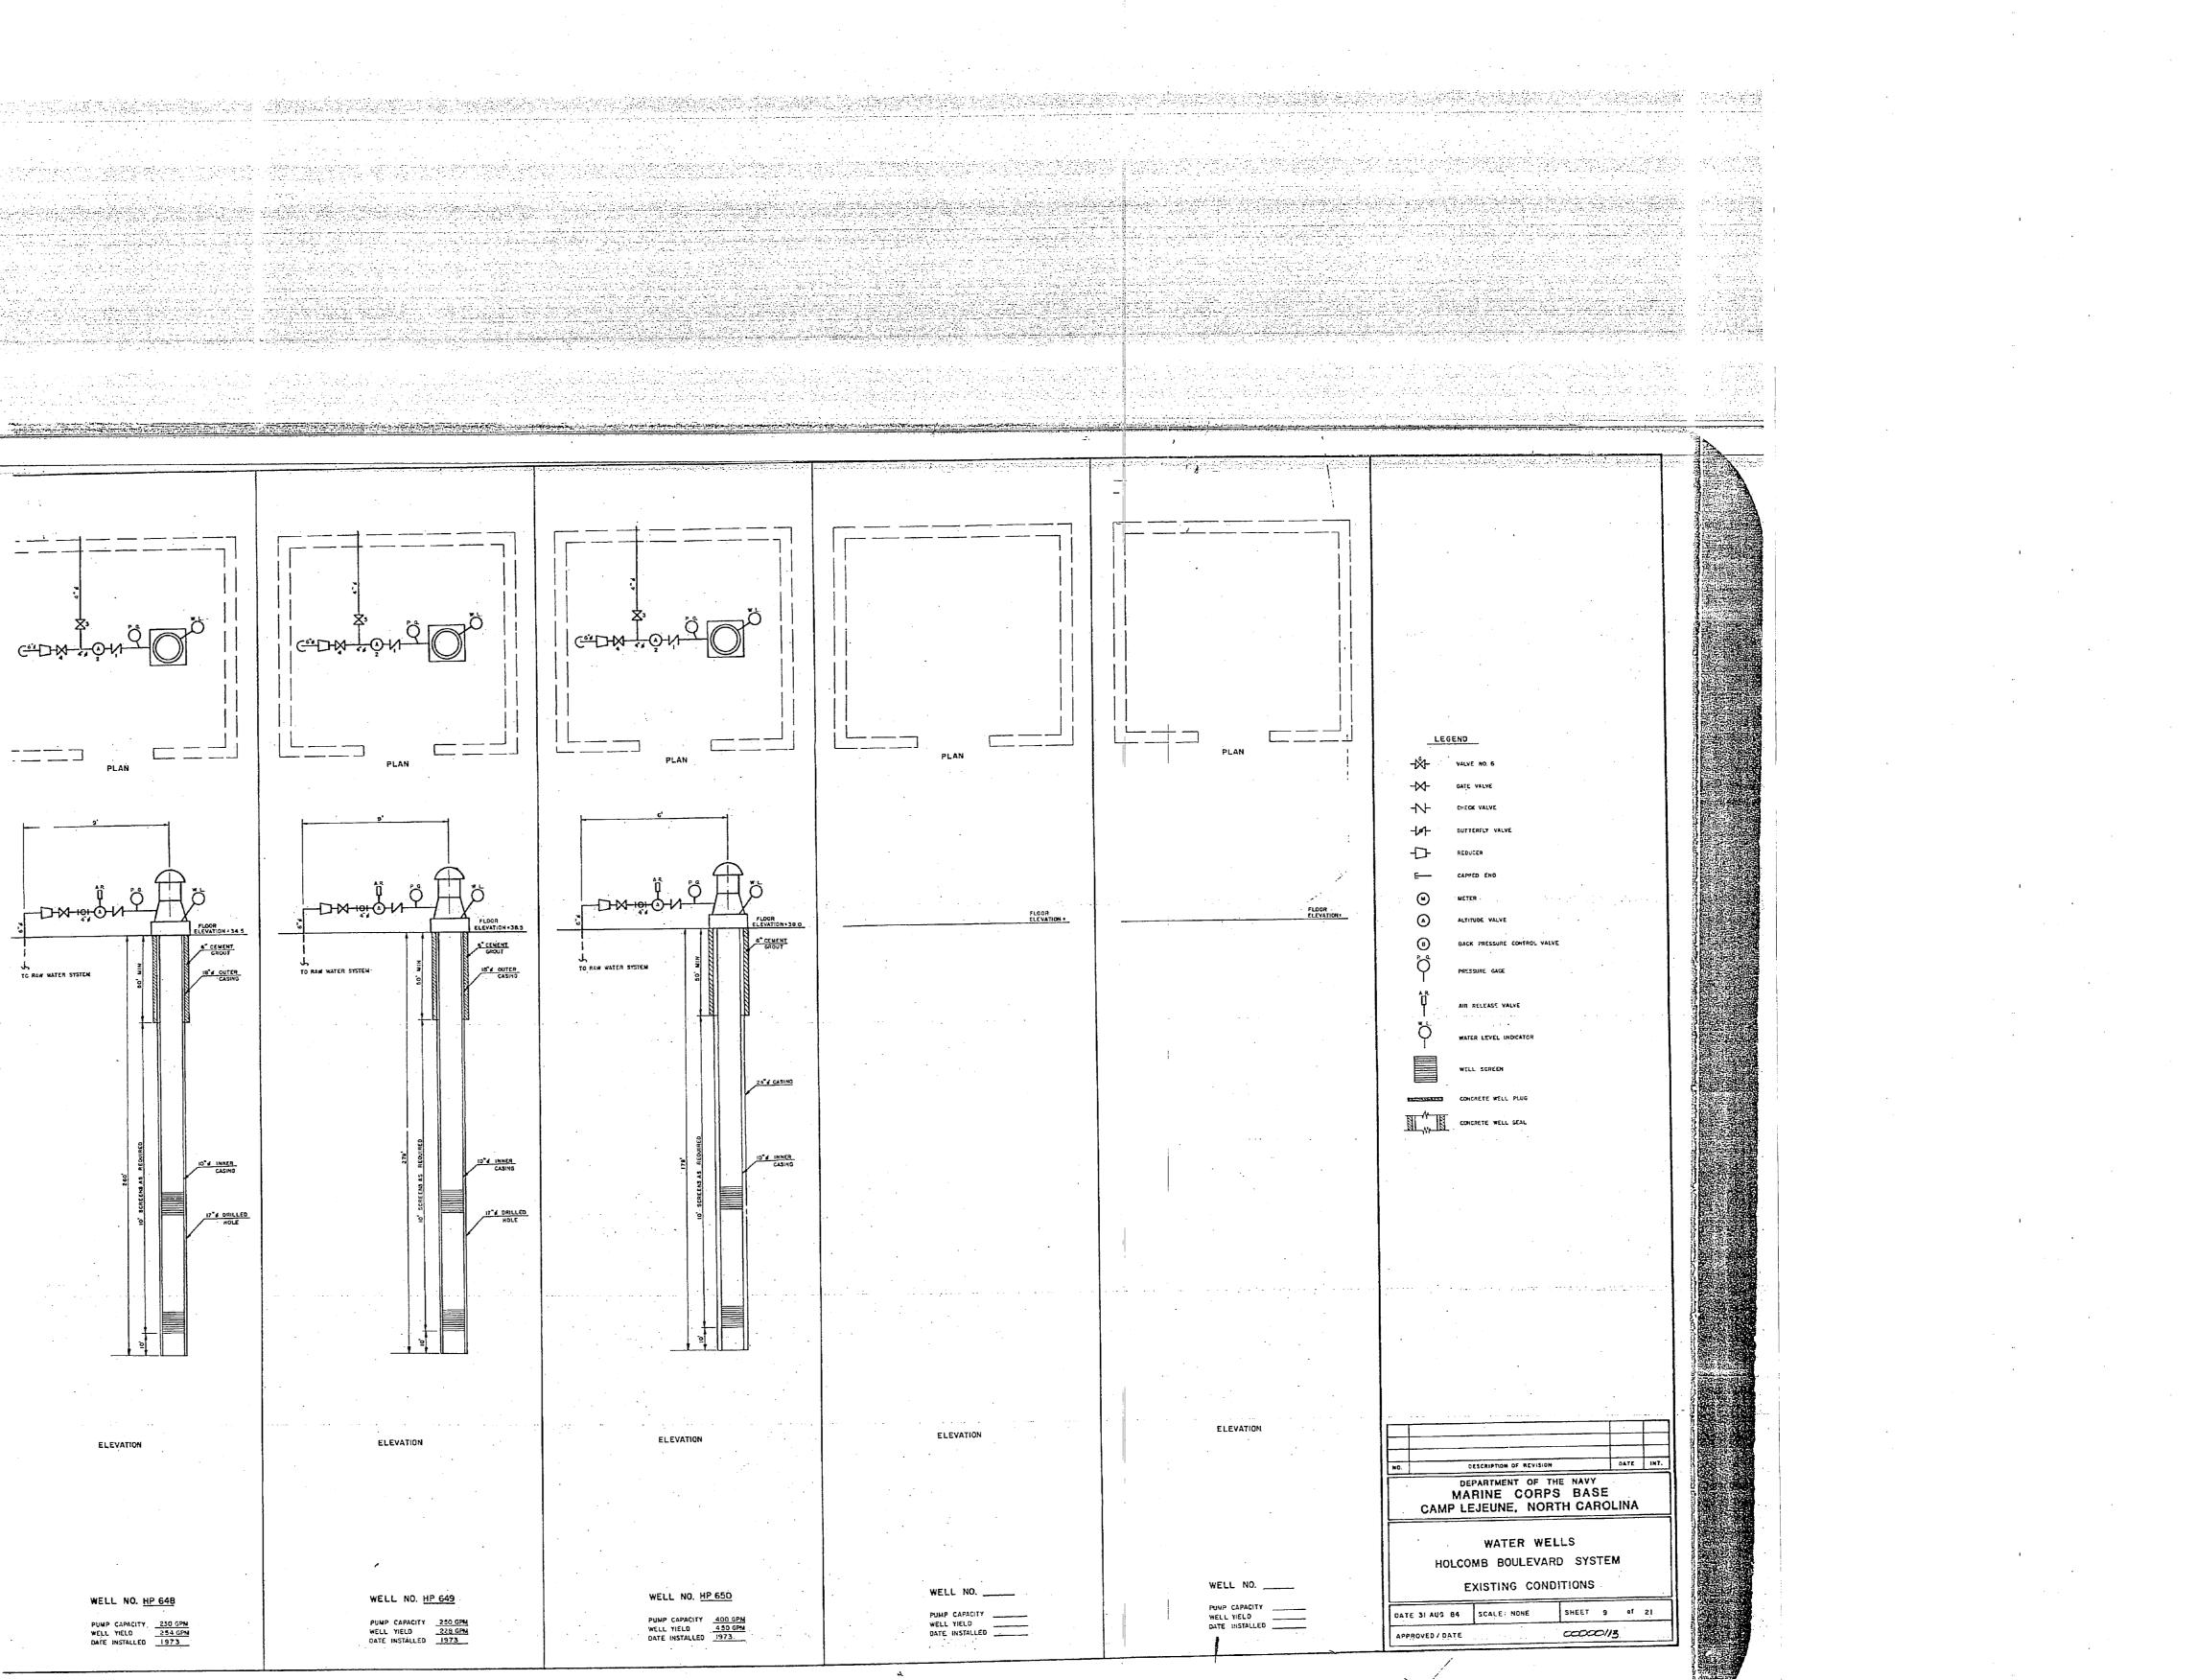

1 •

1 · · · · . 1

the state · · 1 r L'in Lin · .

1

.

14. 14. 14. 14. 14.

.


ı 1 A. A.


1 1

t N 1 1

1 1


• •

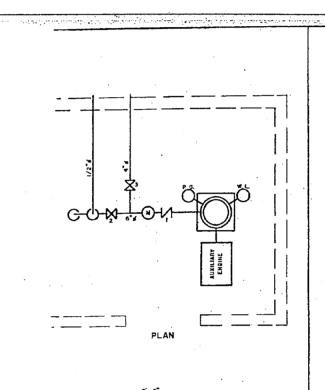

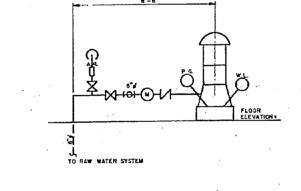

ELEVATION

. WELL NO. TT 25

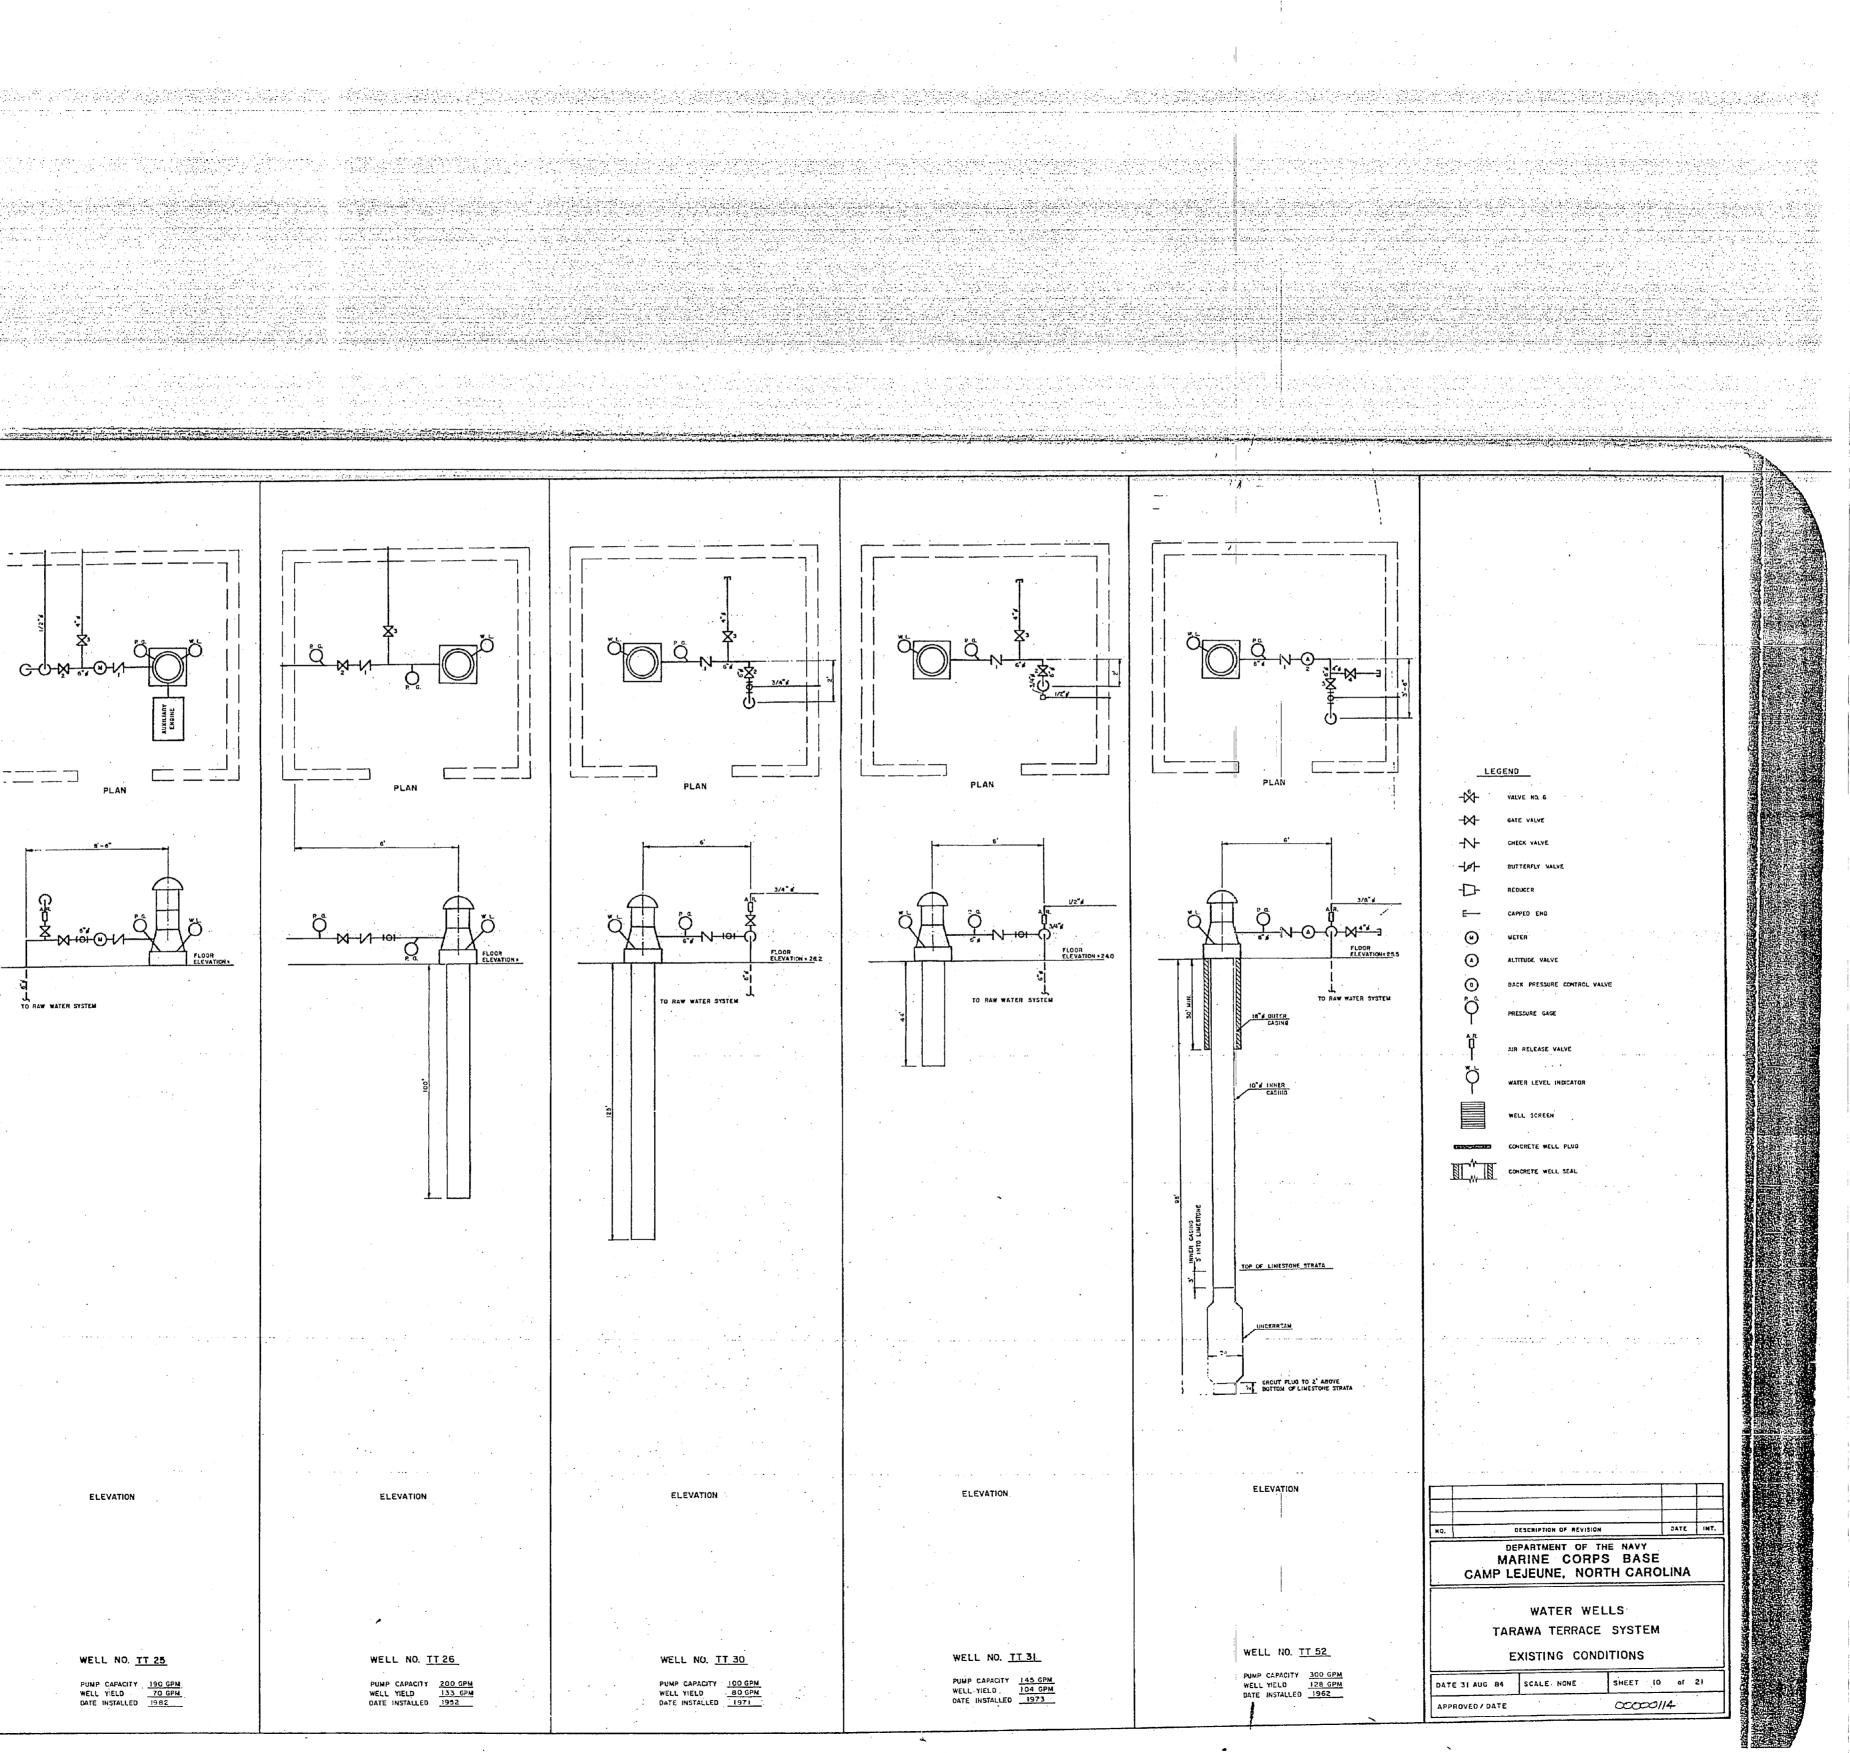

PUNP CAPACITY 190 GPN WELL YIELD 70 GPN DATE INSTALLED 1982

. 1

· . , 1 1 ı. •

1

1 H . 1 • , łį

ı .

1 H

,

4

1


.

,

· 1 -

-

I. 1

 

and a state 1 1


A. H 1 鞋

1

and a state




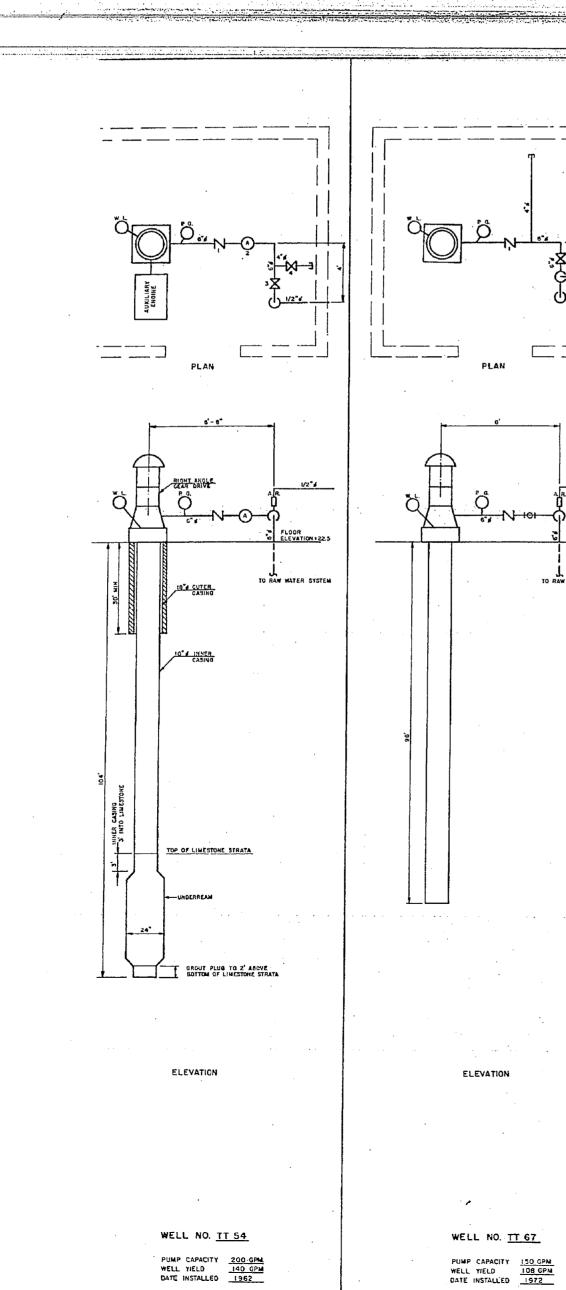

한 전화는 것 사람이 가격했다. 것 같이 많은 것이 있었다. 가격에서 가격한 것을 몰랐다. The second 1 1 ... ----------_ ___ _ LEGEND PLAN PLAN VALVE NO. 6 CHECK VALVE **(I)** METER FLOOR ELEVATION . FLOCR ELEVATION . FLOOR ELEVATION (A)ALTITUDE VALVE 働 BACK PRESSURE CONTROL VALVE TO RAW WATER SYSTEM PRESSURE GADE WELL SCREEN CONCRETE WELL PLUG CONCRETE WELL SEAL ELEVATION ELEVATION ELEVATION DESCRIPTION OF REVISION DEPARTMENT OF THE NAVY MARINE CORPS BASE CAMP LEJEUNE, NORTH CAROLINA . WATER WELLS TARAWA TERRACE SYSTEM WELL NO. WELL NO. WELL NO. EXISTING CONDITIONS PUMP CAPACITY _____ WELL YIELD _____ DATE INSTALLED _____ PUMP CAPACITY ______ WELL YIELD ______ OATE INSTALLED _____ PUNP CAPACITY ______ WELL YIELD ______ DATE INSTALLED _____ DATE 31 AUG 84 SCALE: NONE SHEET 11 of 21 PPROVED / DATE

i

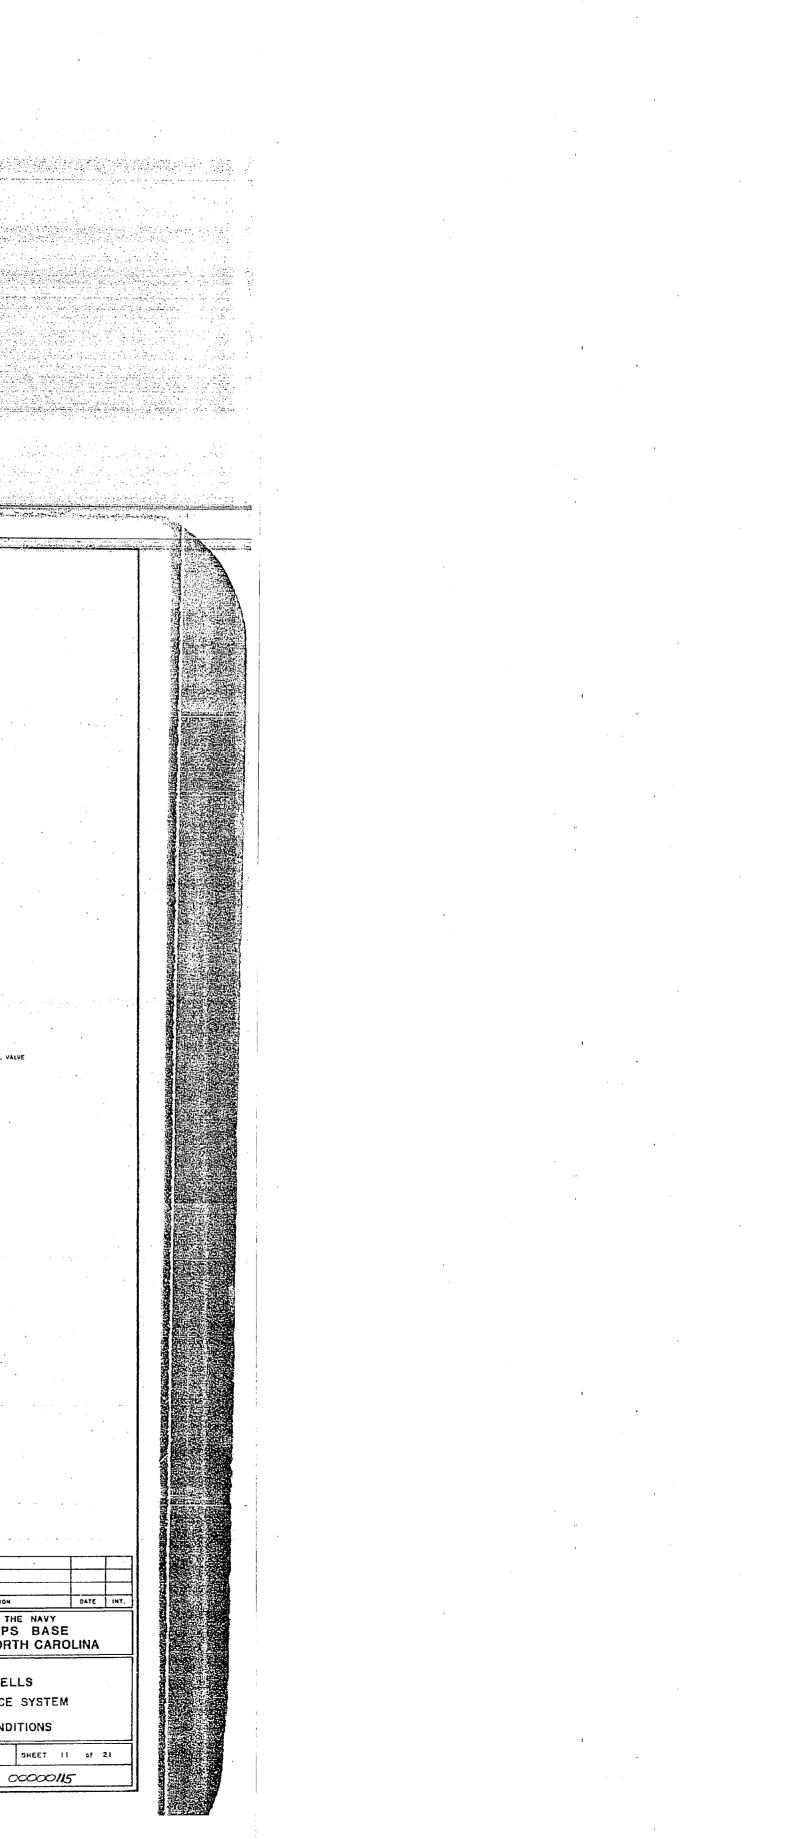

· .

1

1 N r · · ·

1 · .

1

A A A

.

•


1

1 鞋 • •

1 1

iι ≹ • •

t H

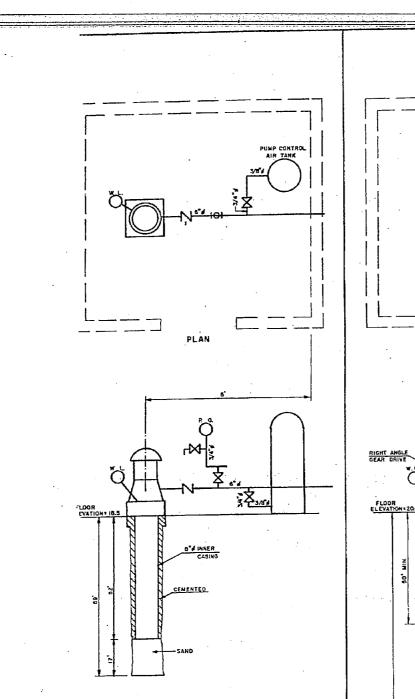


1

ELEVATION

•

WELL NO. M142 PUMP CAPACITY 100 GPM WELL YIELD 100 GPM DATE INSTALLED 1942

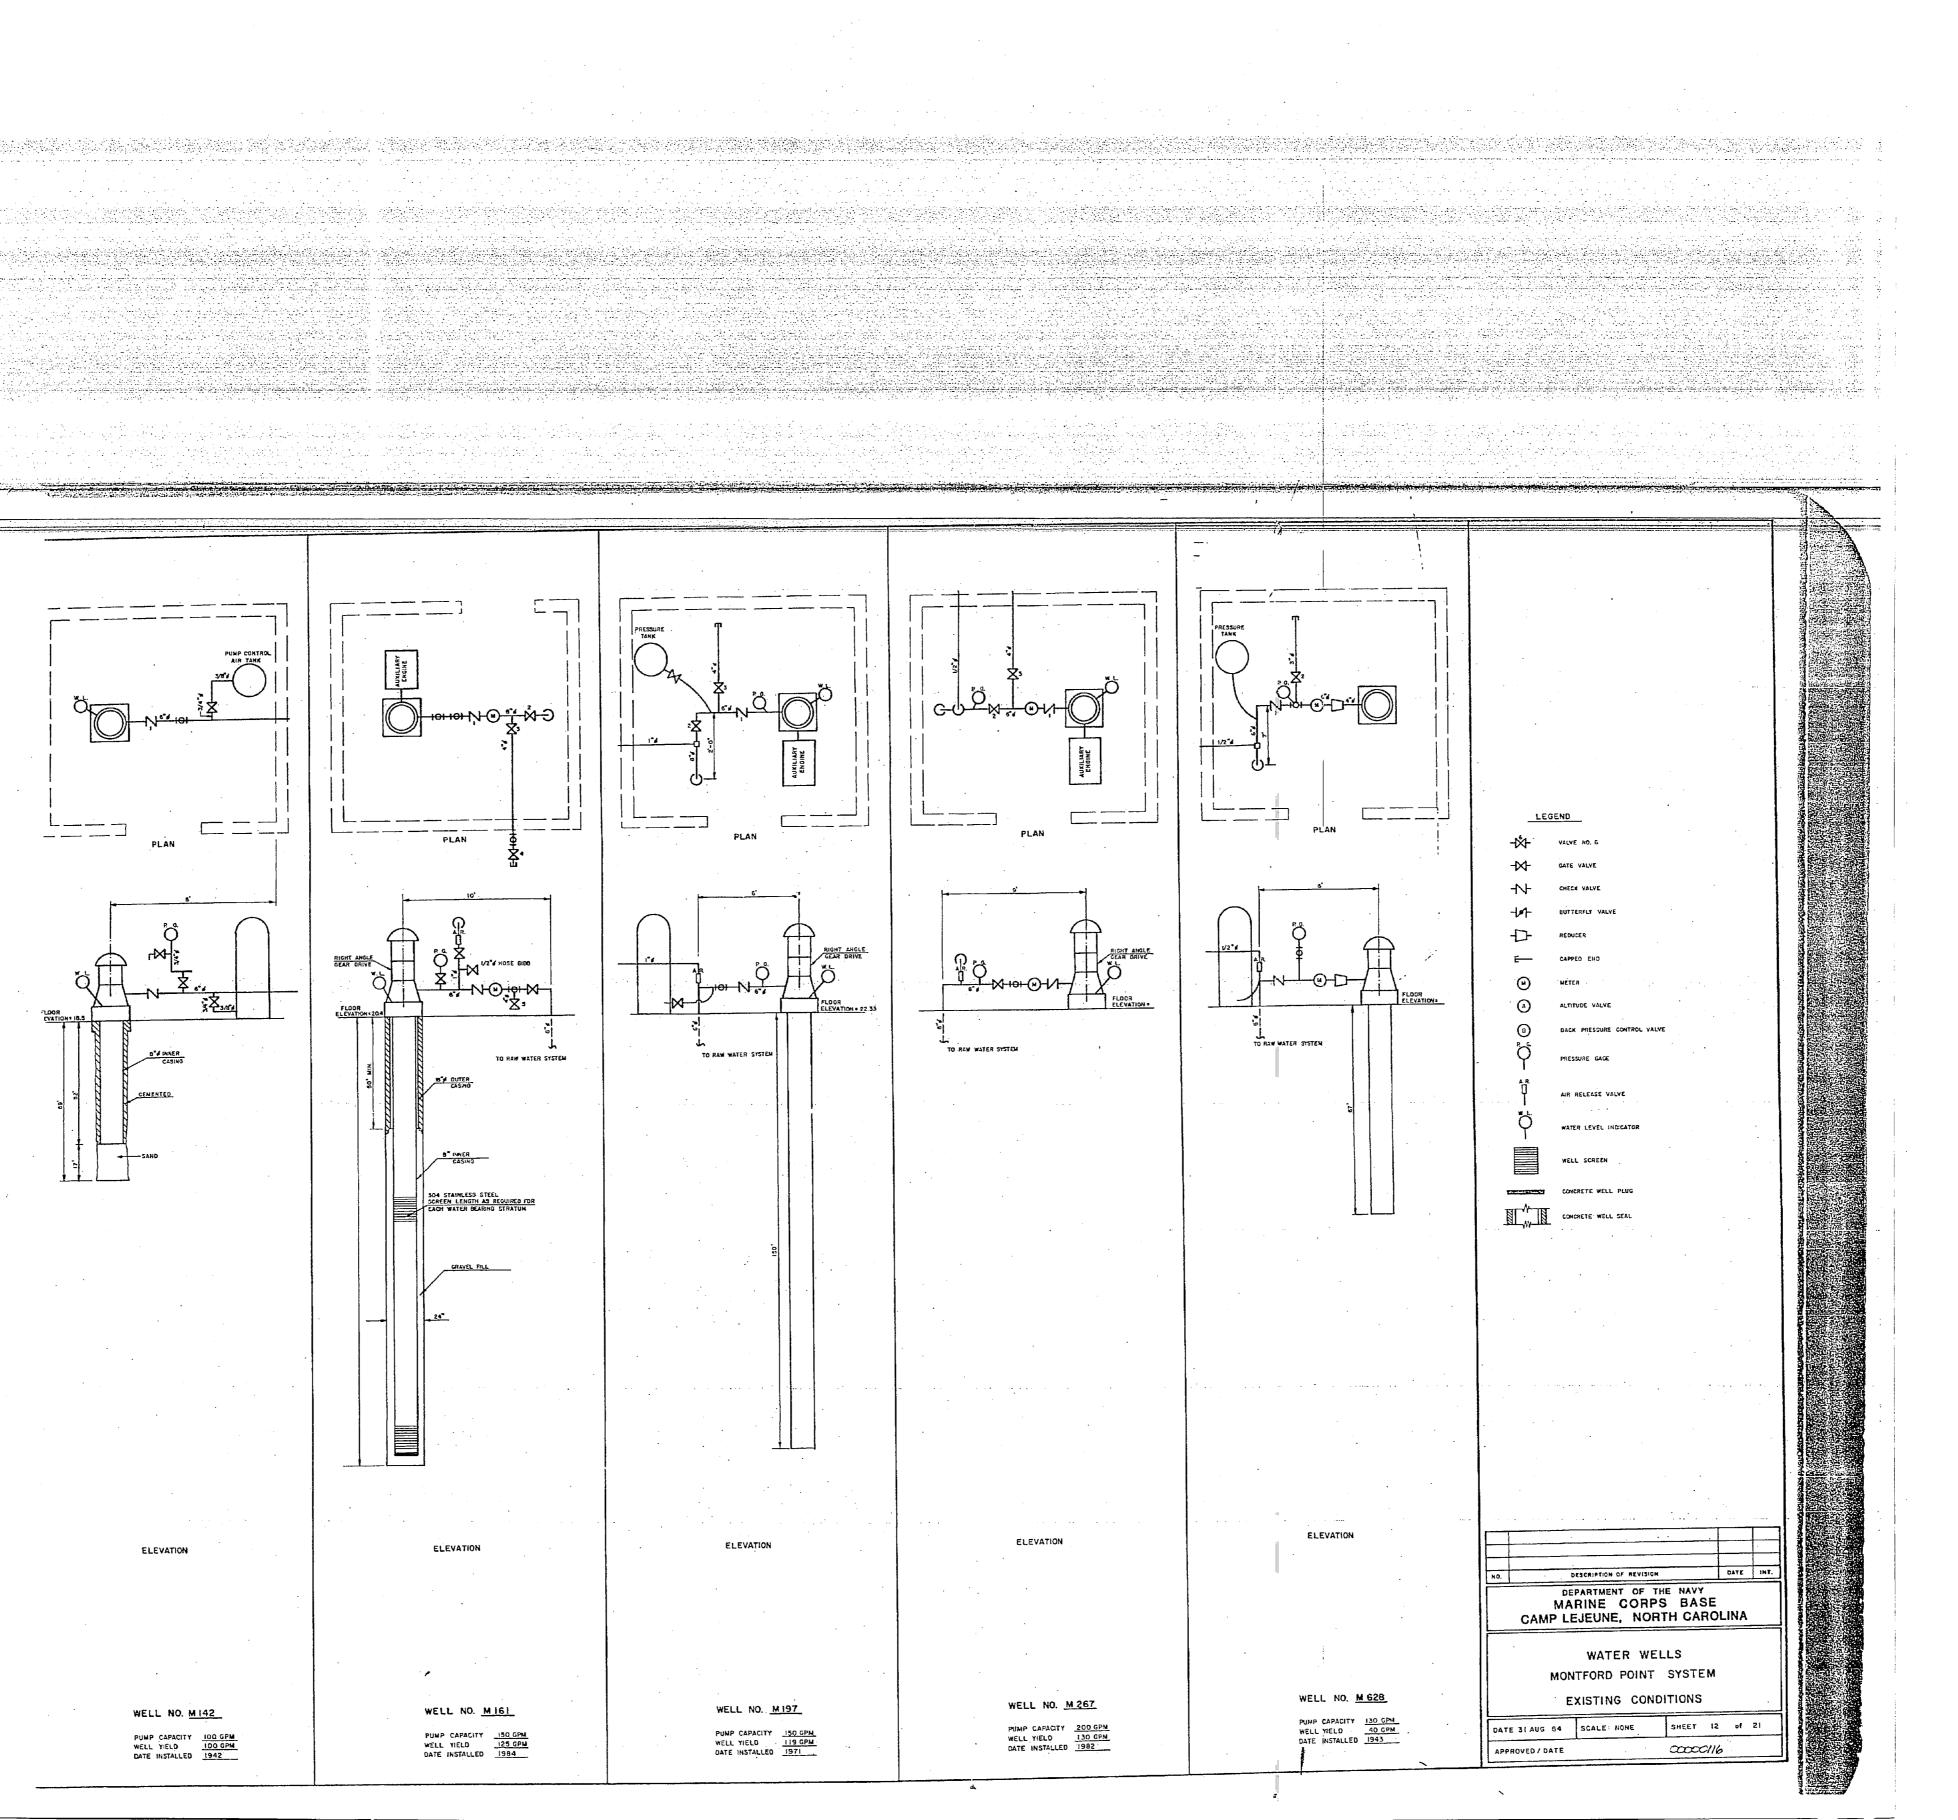

ŀ

.

.


·






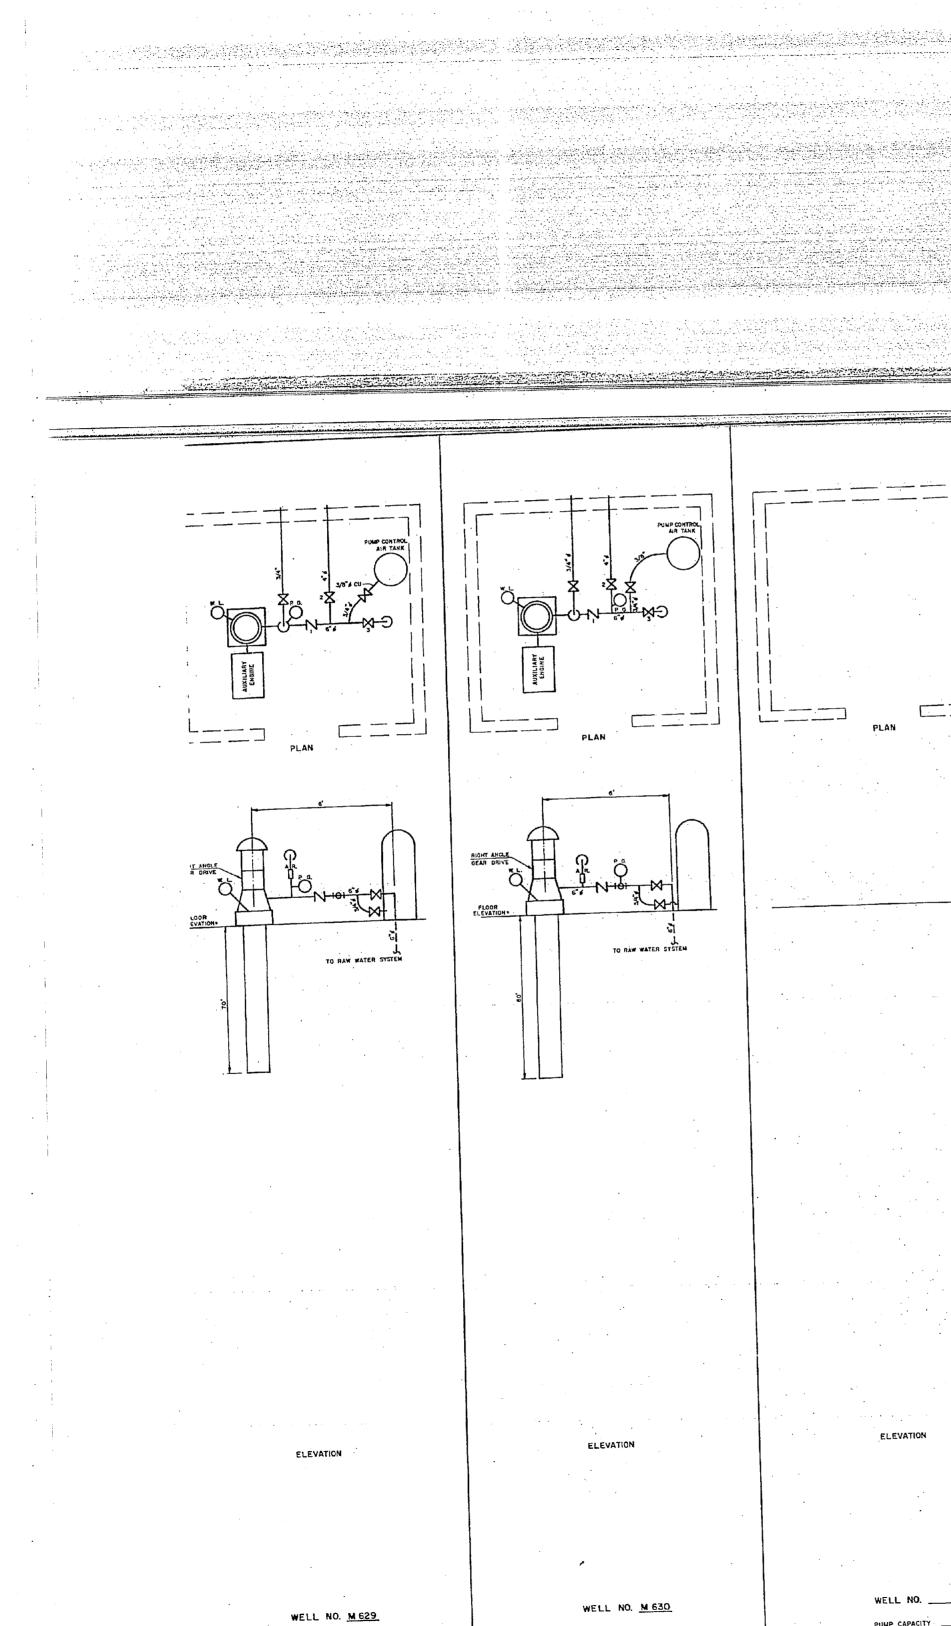

PUMP CAPACITY 150 GPM WELL YIELD 100 GPM DATE INSTALLED 1976

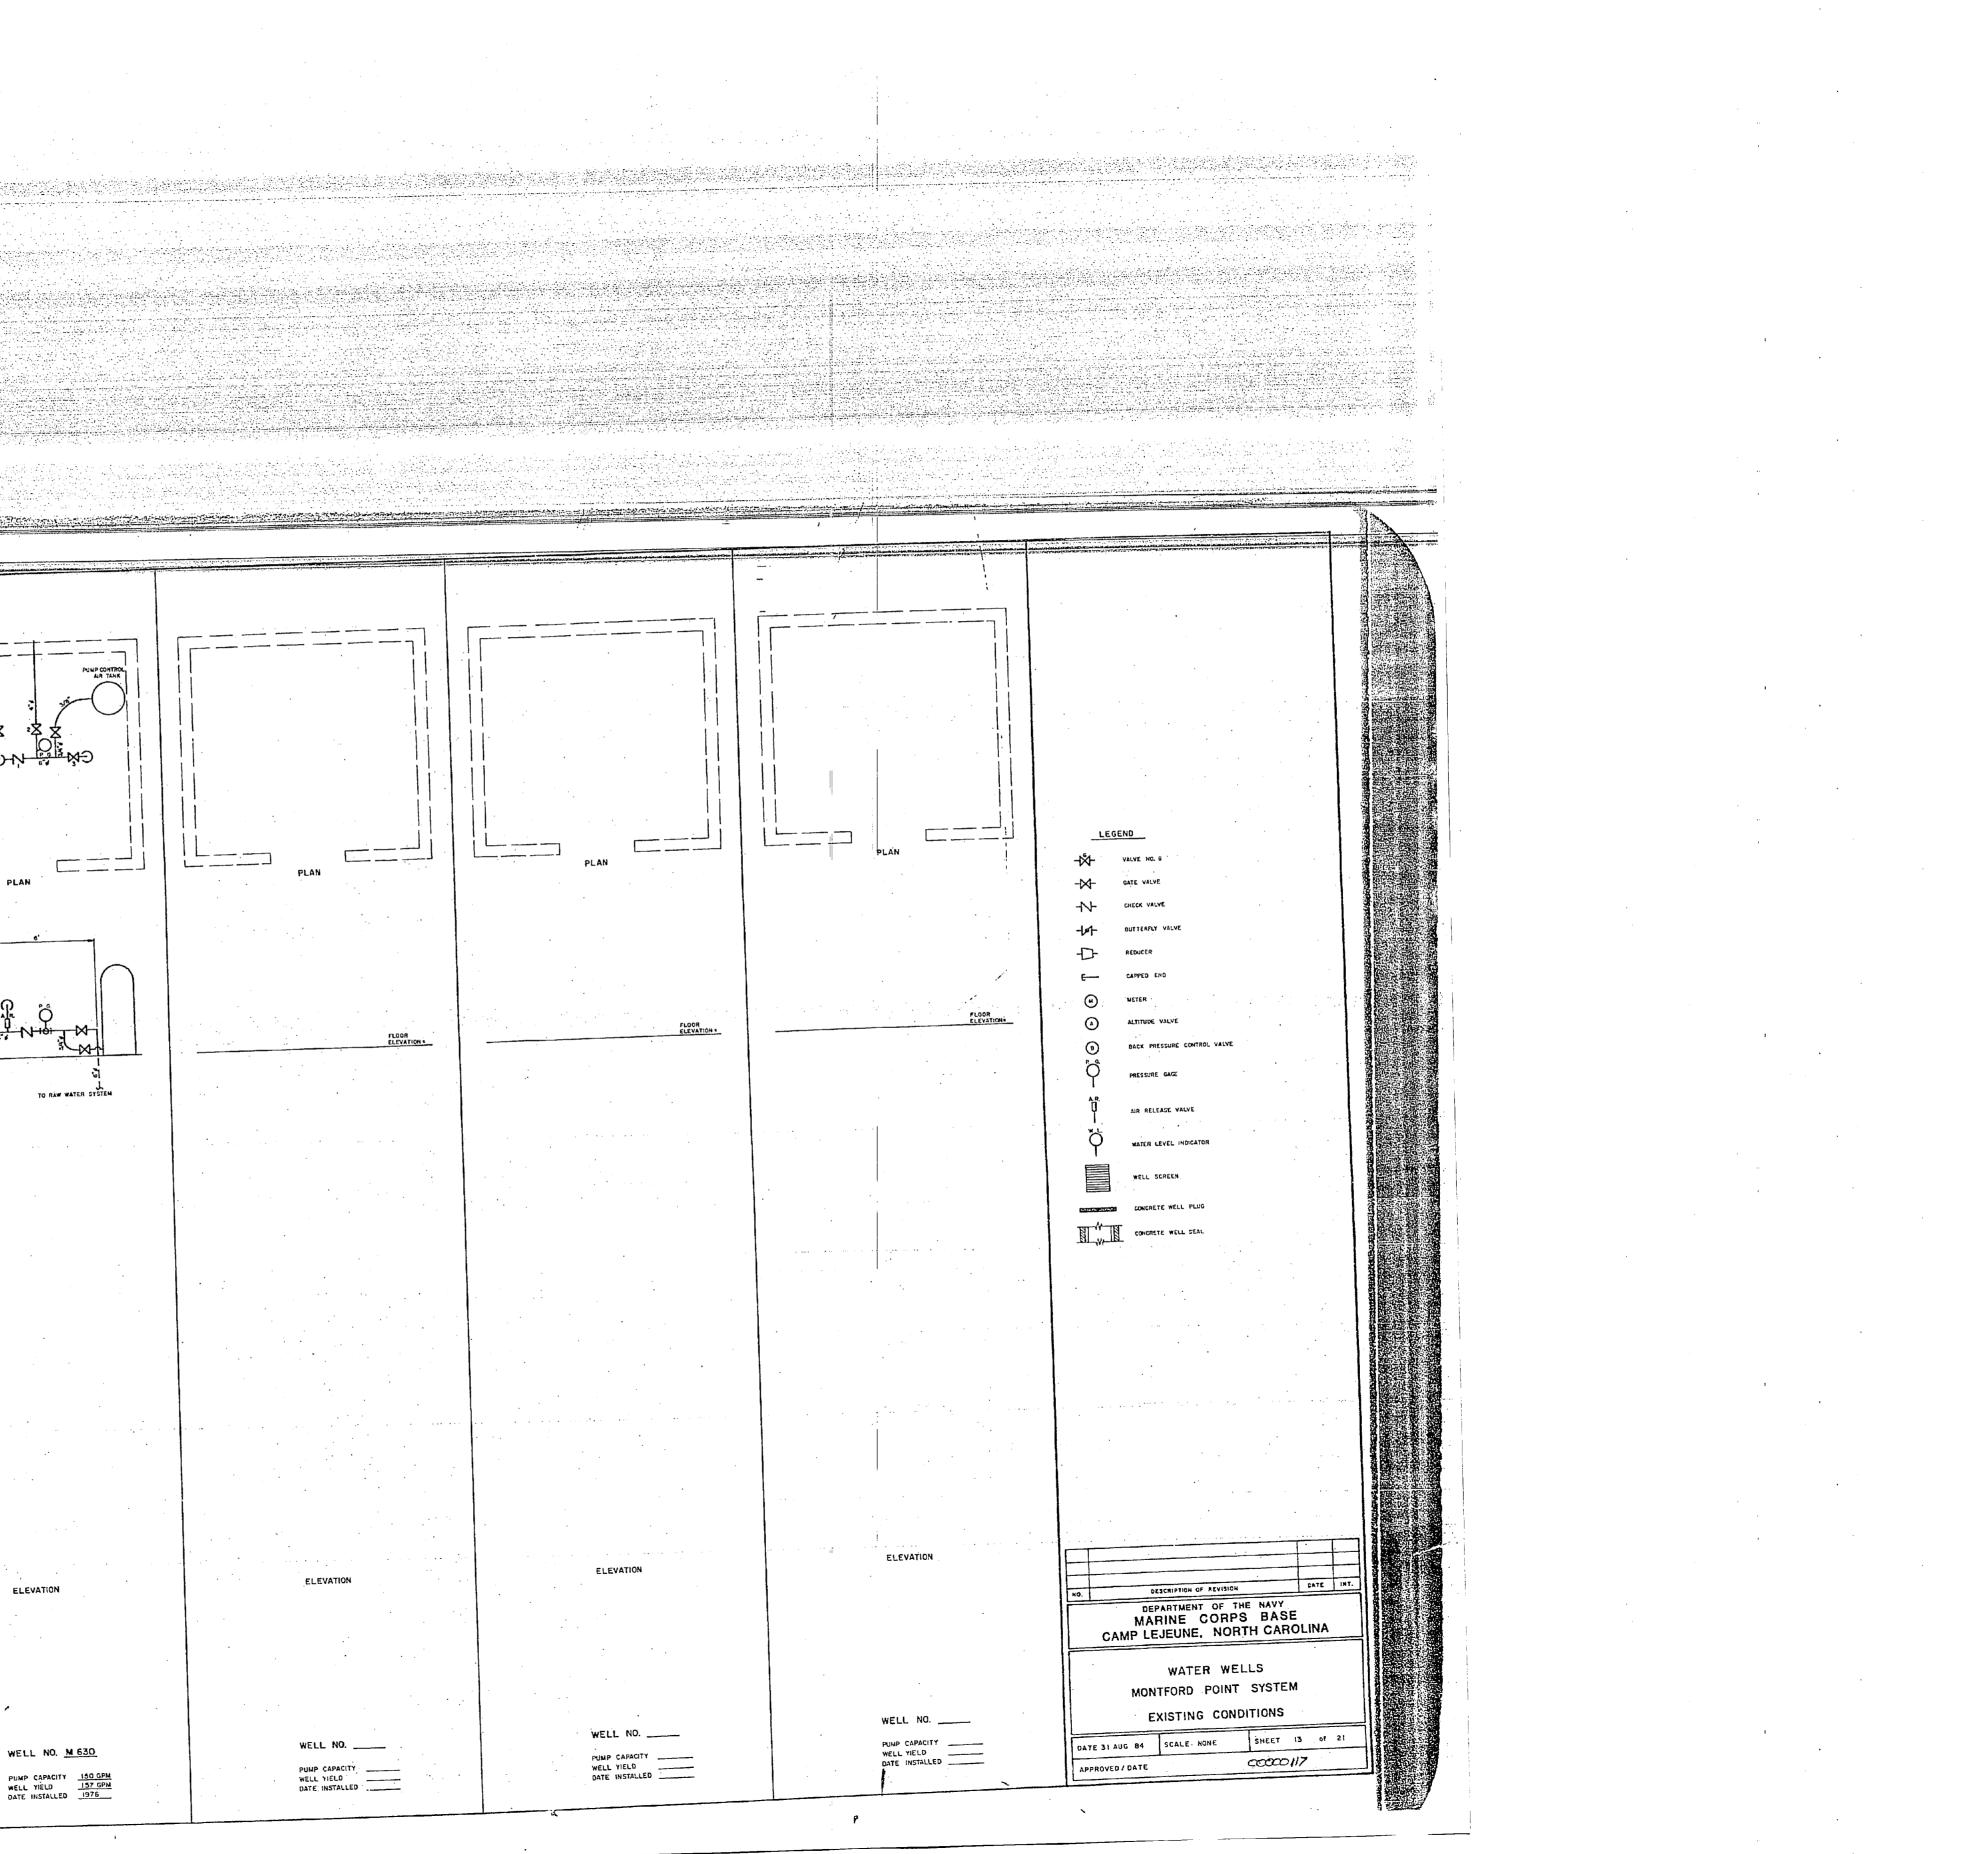



















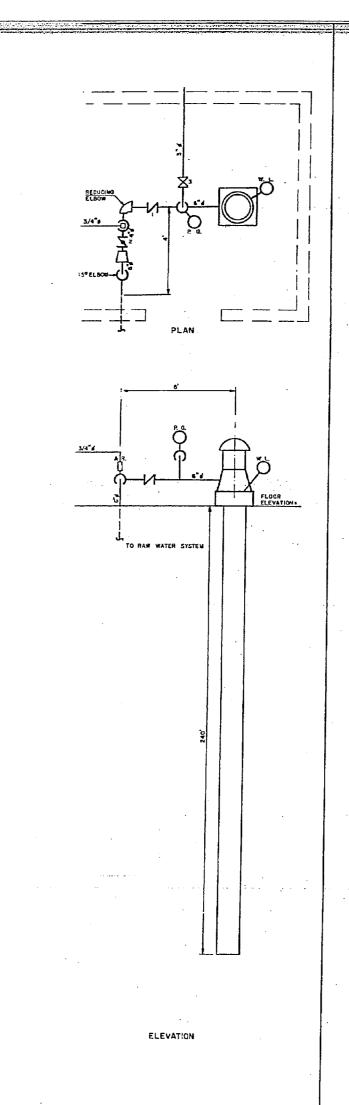

.

WELL NO. AS-106

PUMP CAPACITY 125 GPM WELL YIELD 125 GPM DATE INSTALLED 1955

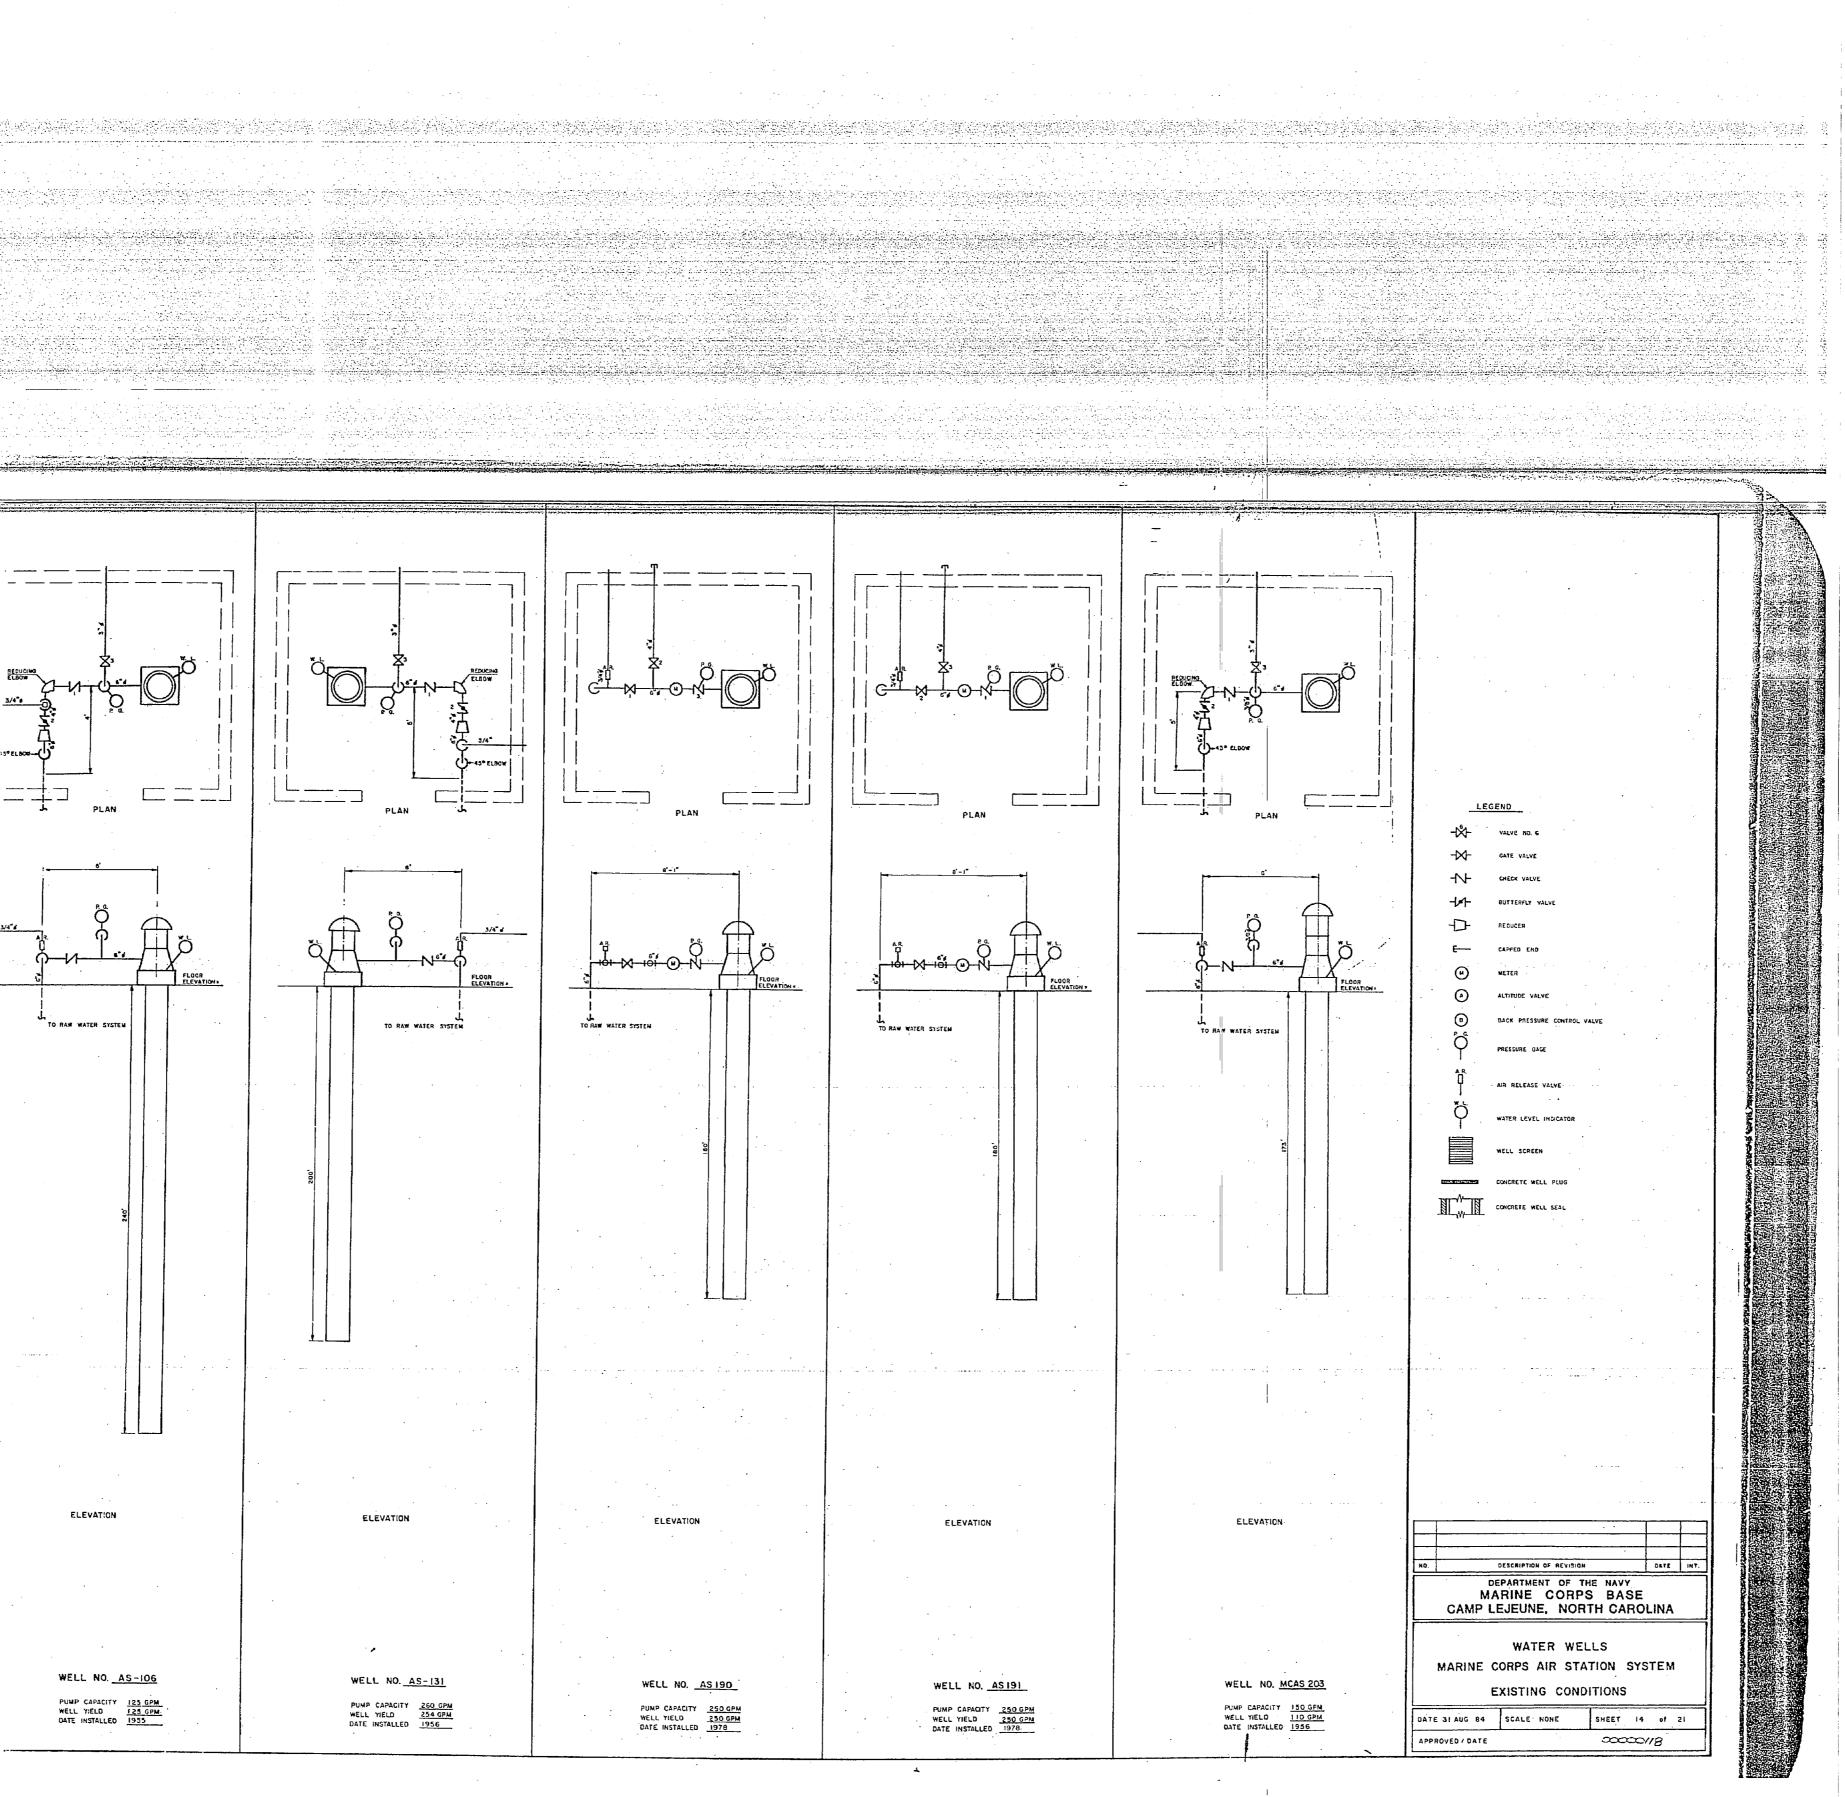

.

ų (į 4: L


1 1

ι II

i A

• •


1

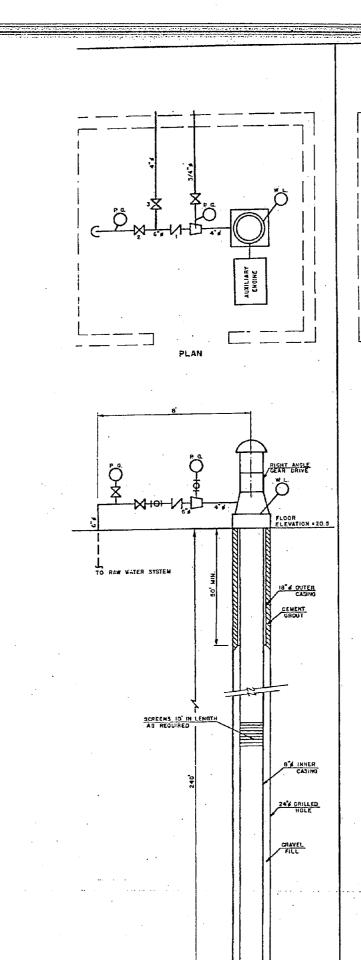

ELEVATION

· · · · · · ·

WELL NO. TC 1251 PUMP CAPACITY <u>200 GPM</u> WELL YIELD <u>146 GPM</u> DATE INSTALLED <u>1975</u>

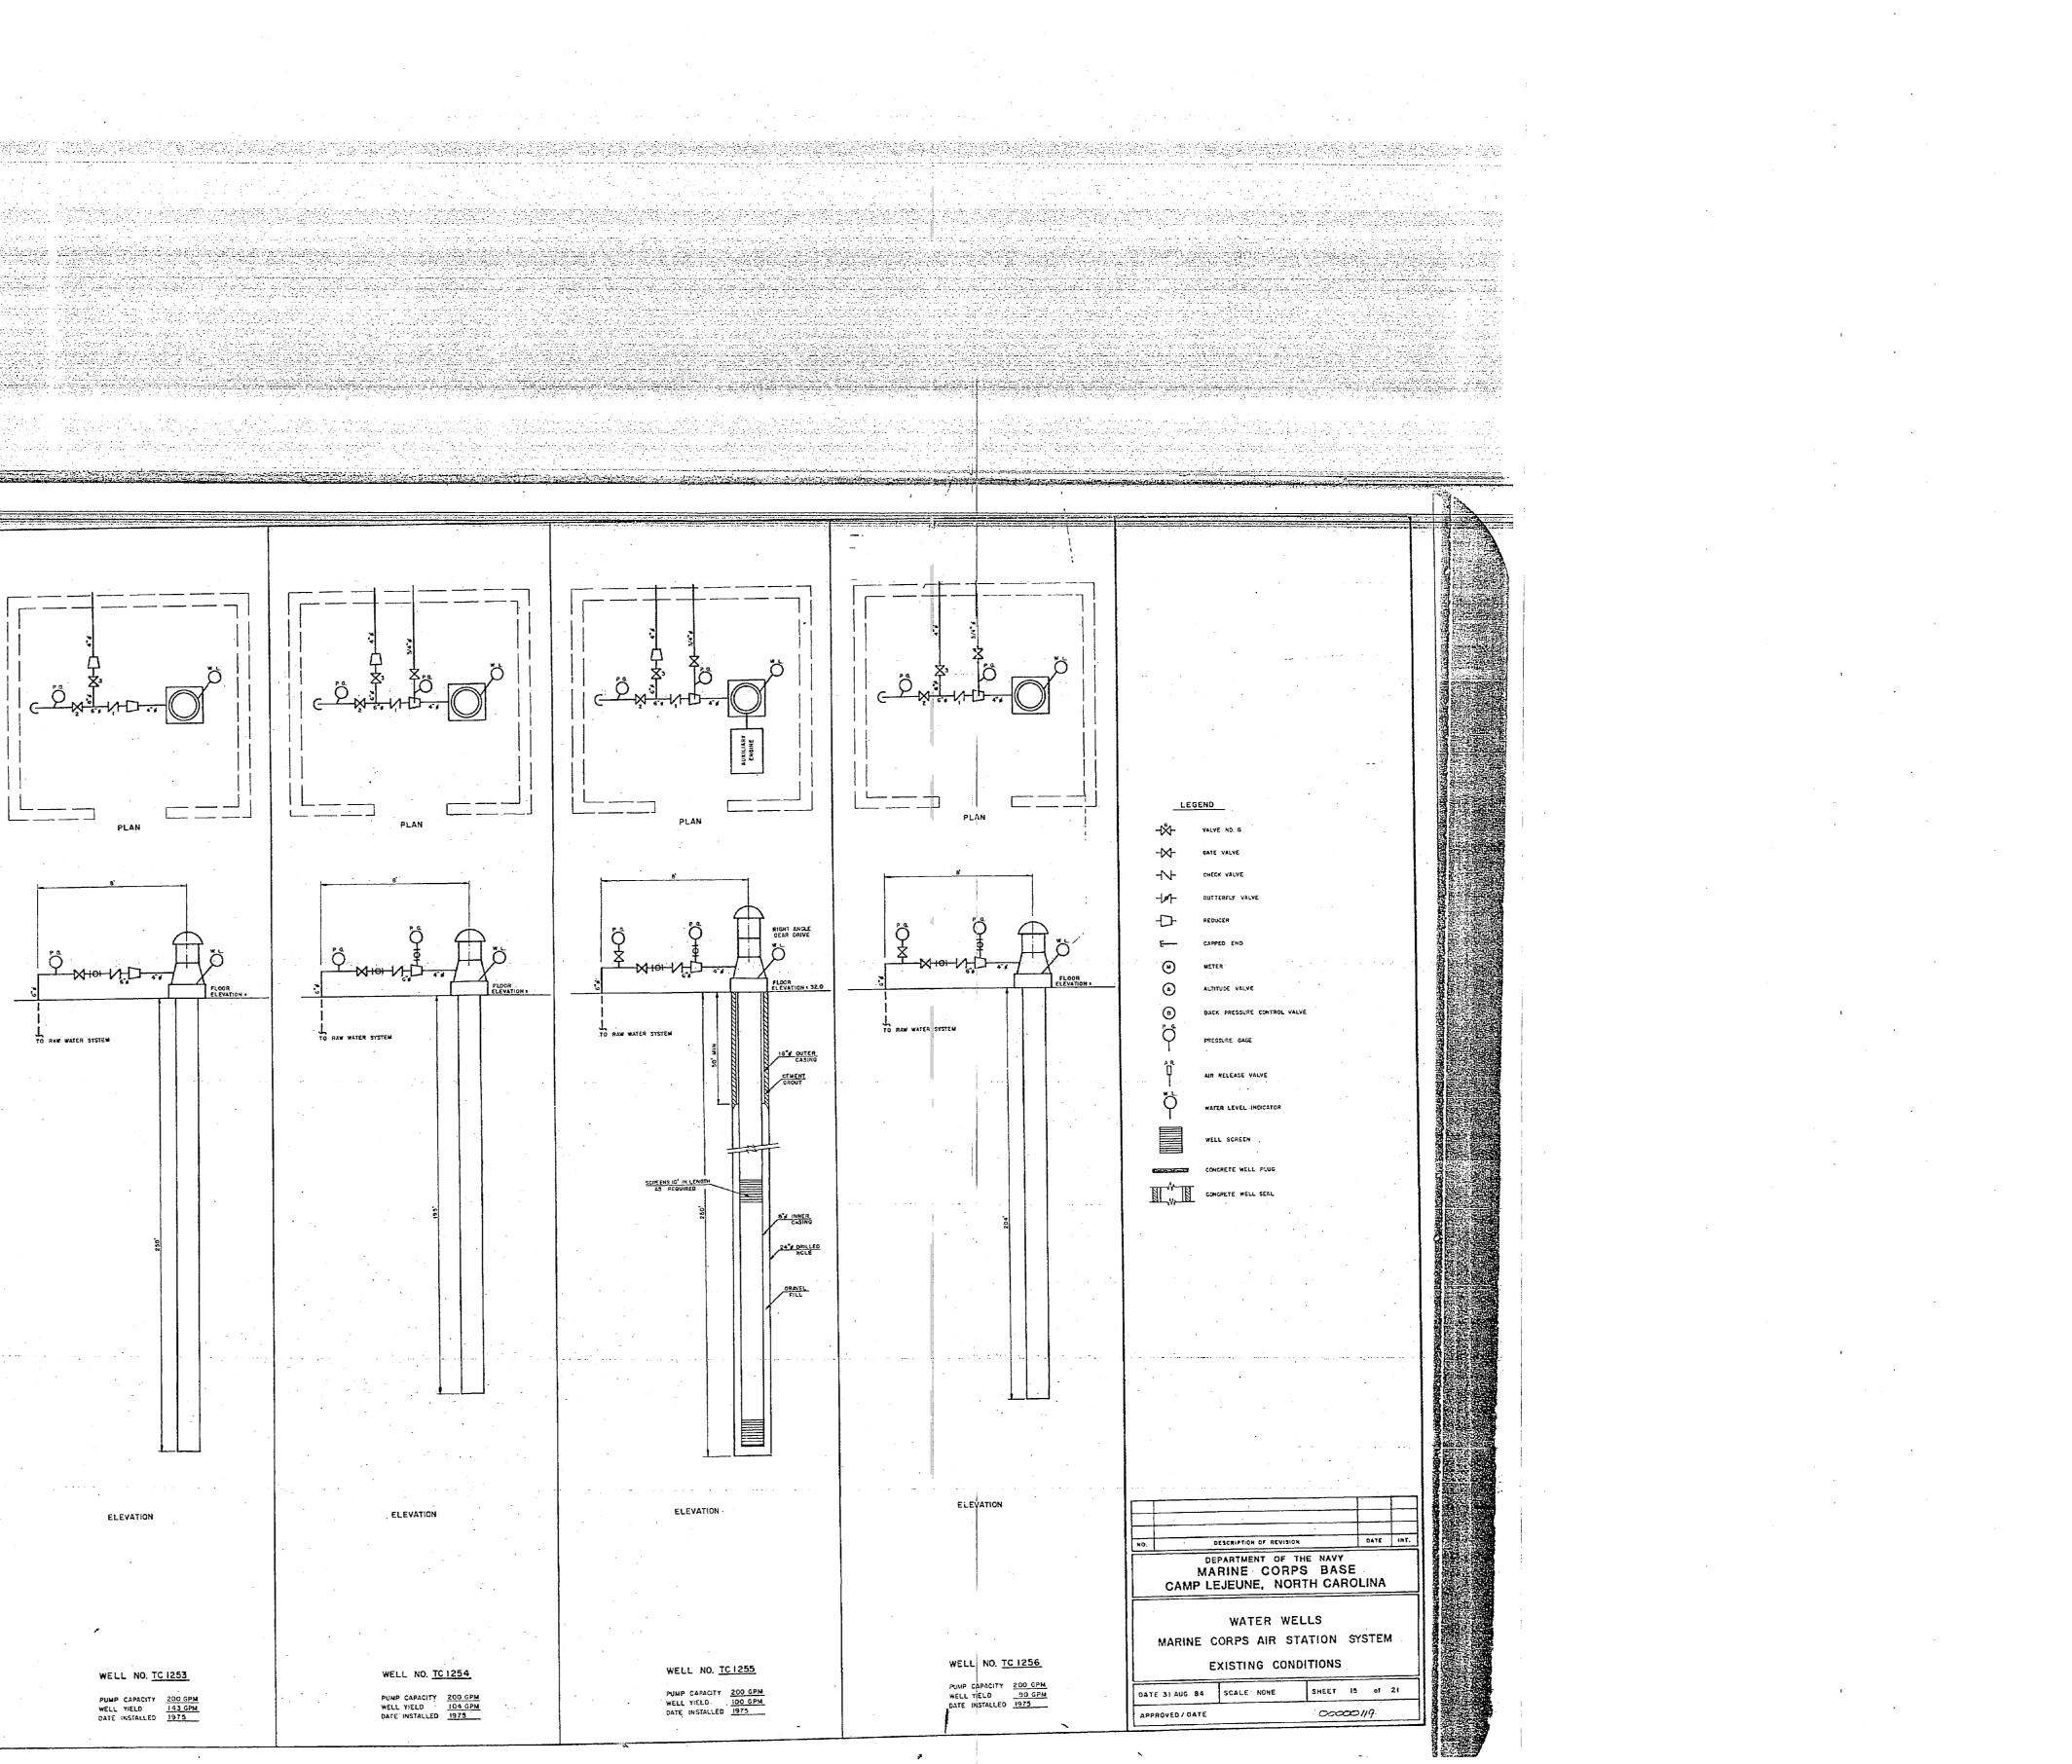

. .


· . 1

i ∰ . € ≹

.

.

I


.


i H

(¥ at his (ł

t H 1. A.

1

 


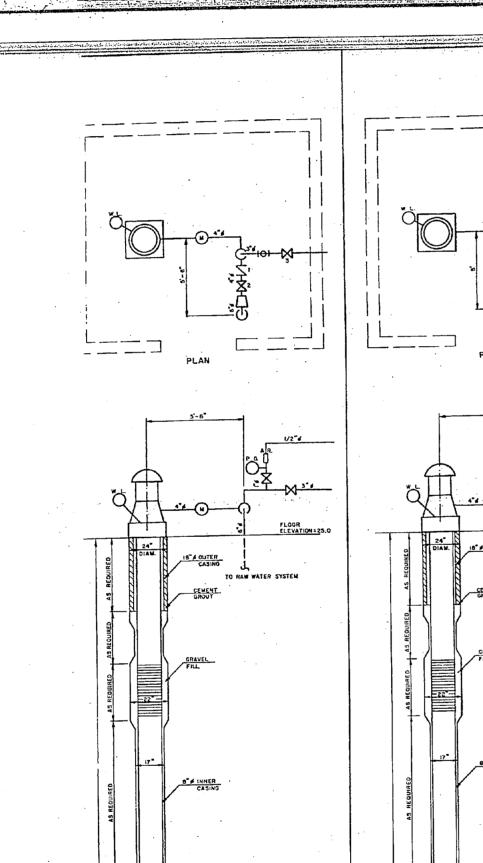



ELEVATION

WELL NO. AS 4140

PUMP CAPACITY WELL YIELD <u>110 GPM</u> DATE INSTALLED 1972

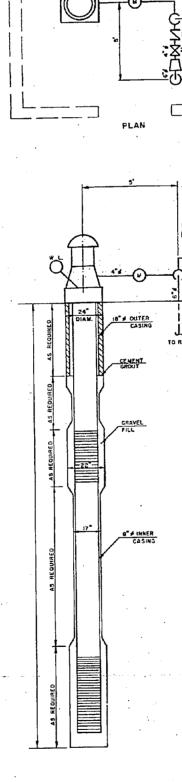

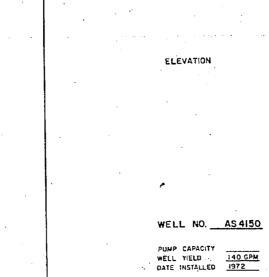

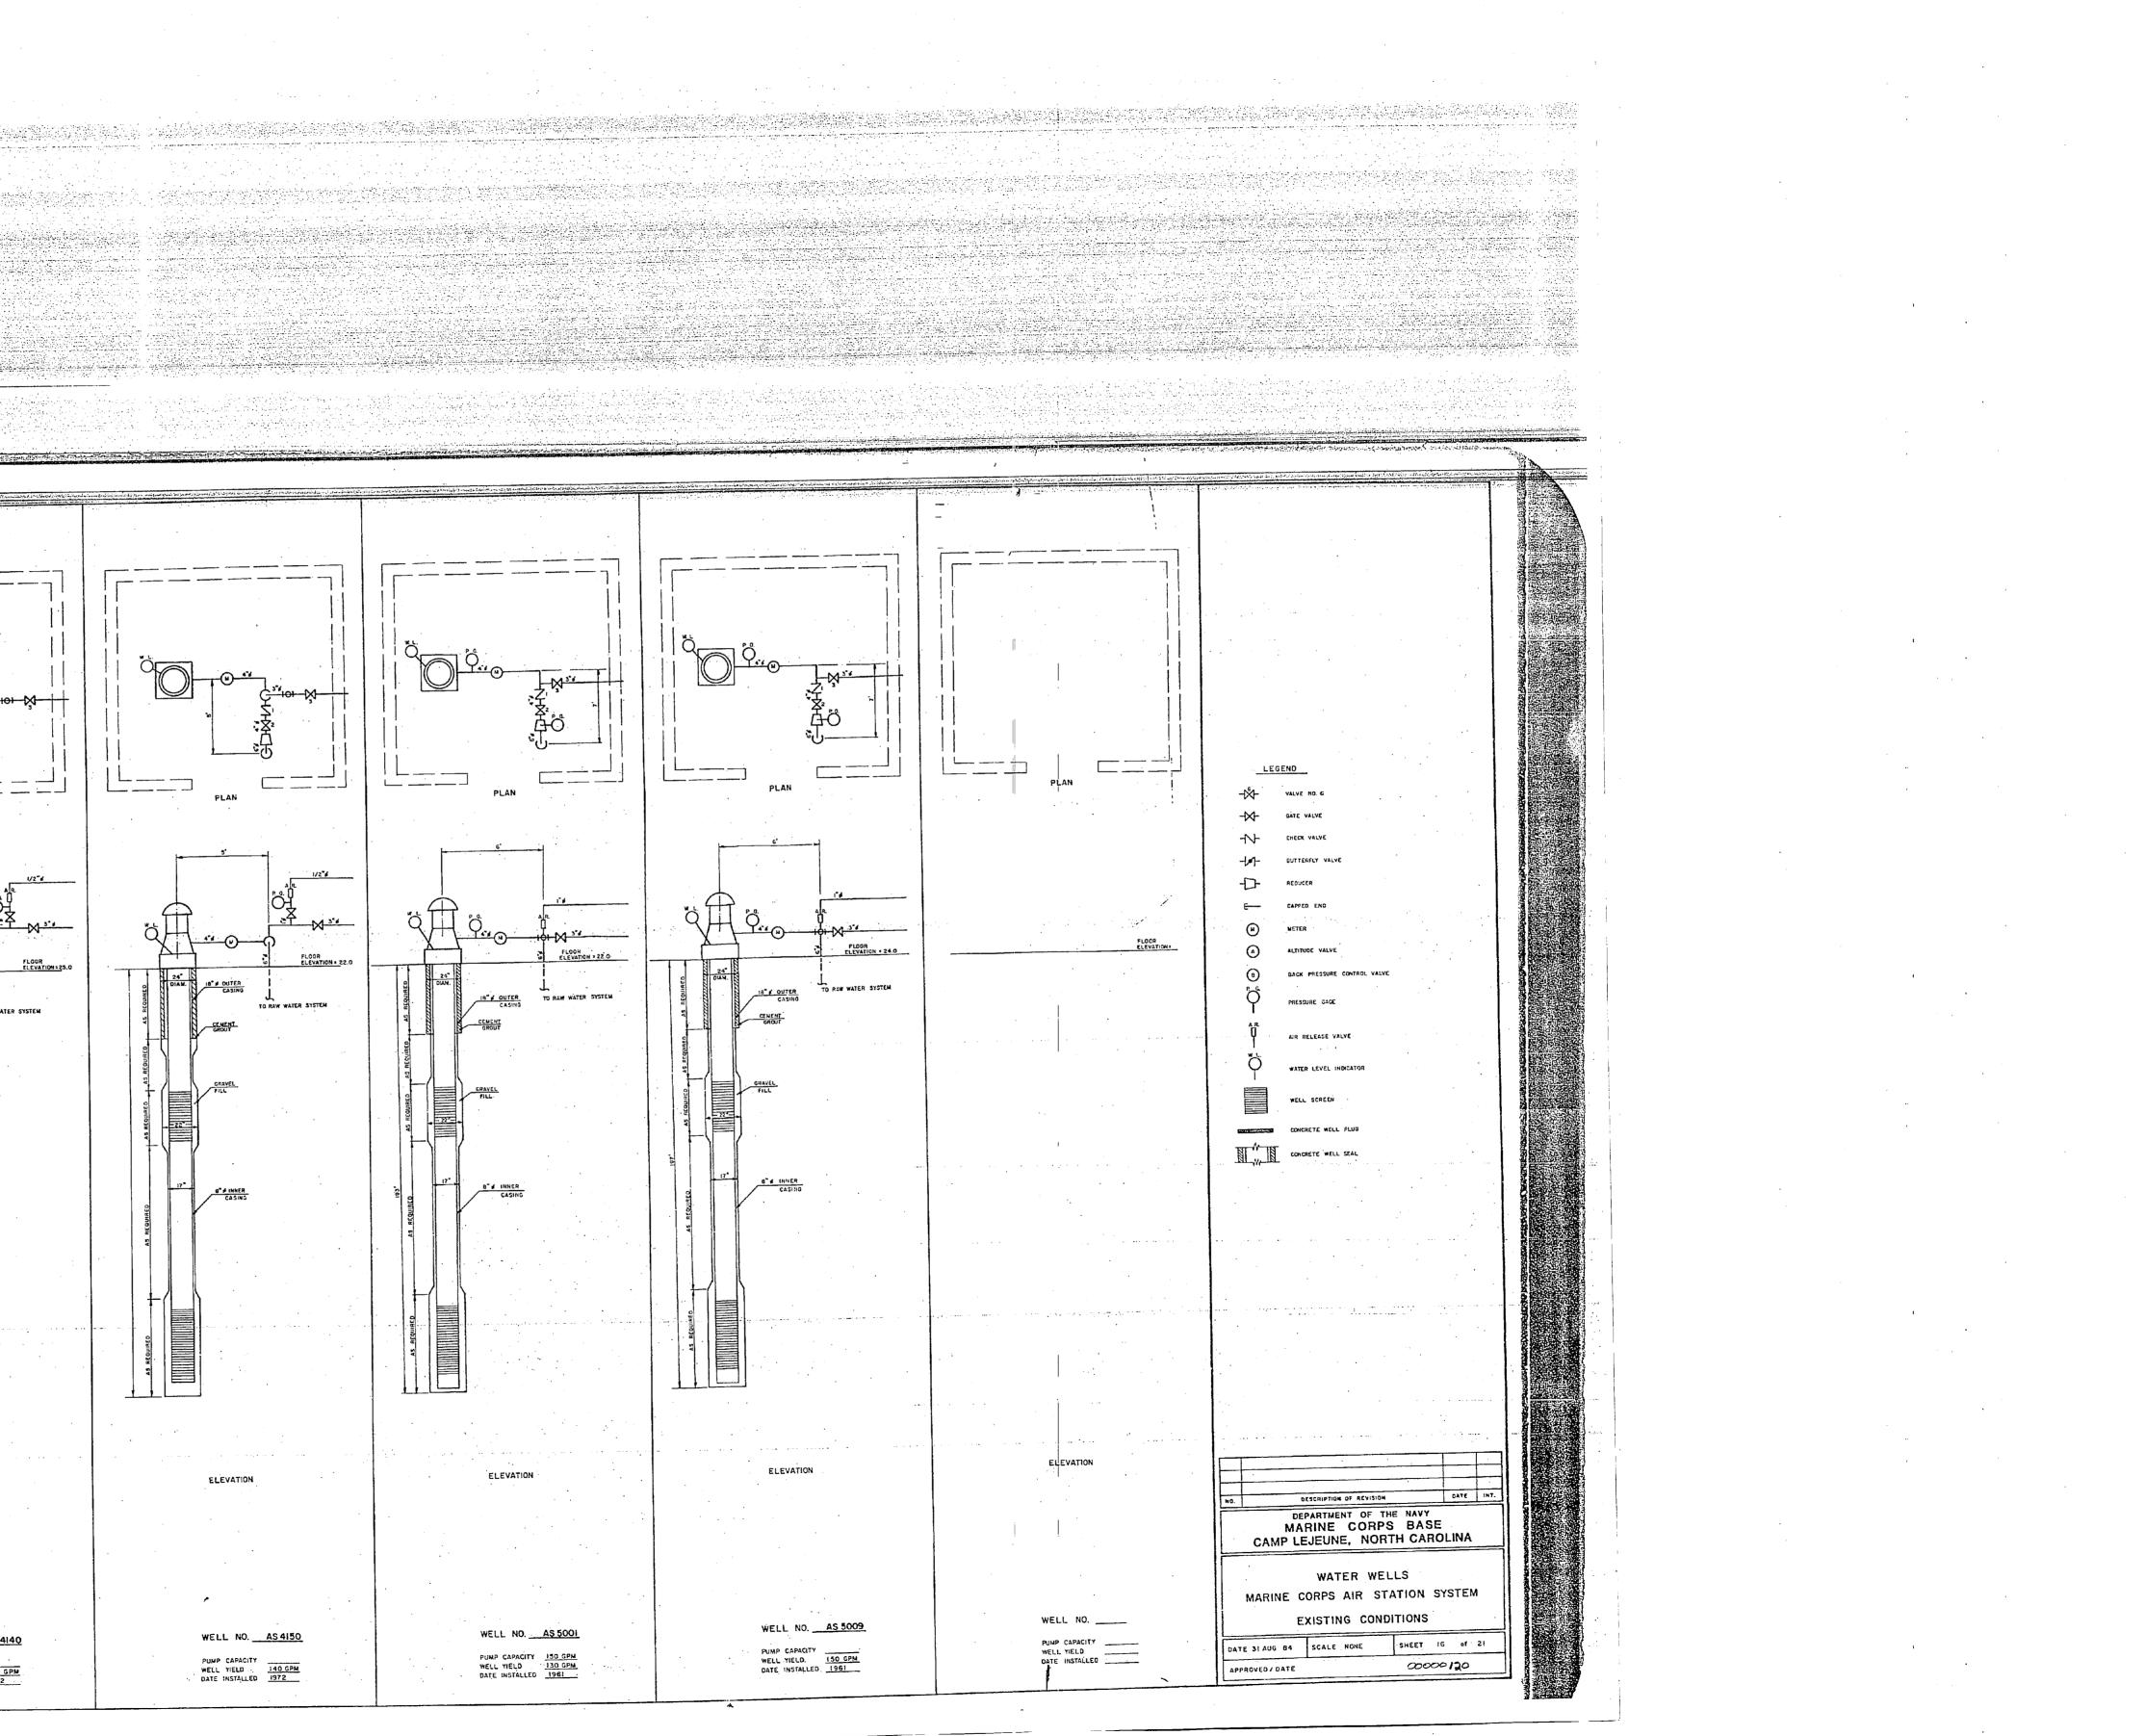



1 A LA · . 1

, · · · ·


· · · · · 1 · .

, 1 T

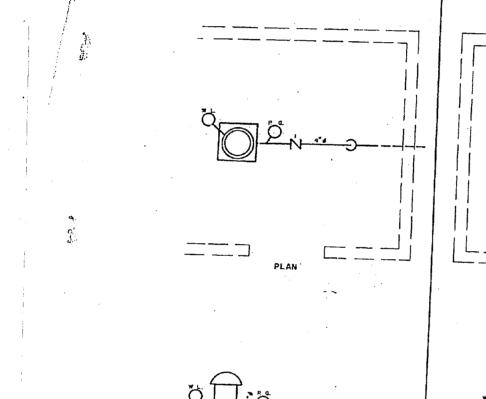


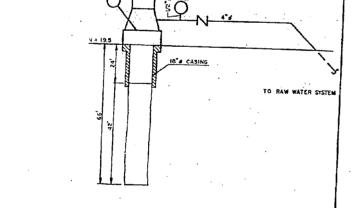

ELEVATION WELL NO. TC 100 PUMP CAPACITY <u>50 GPM.</u> SO GPM. DATE INSTALLED <u>50 GPM.</u>

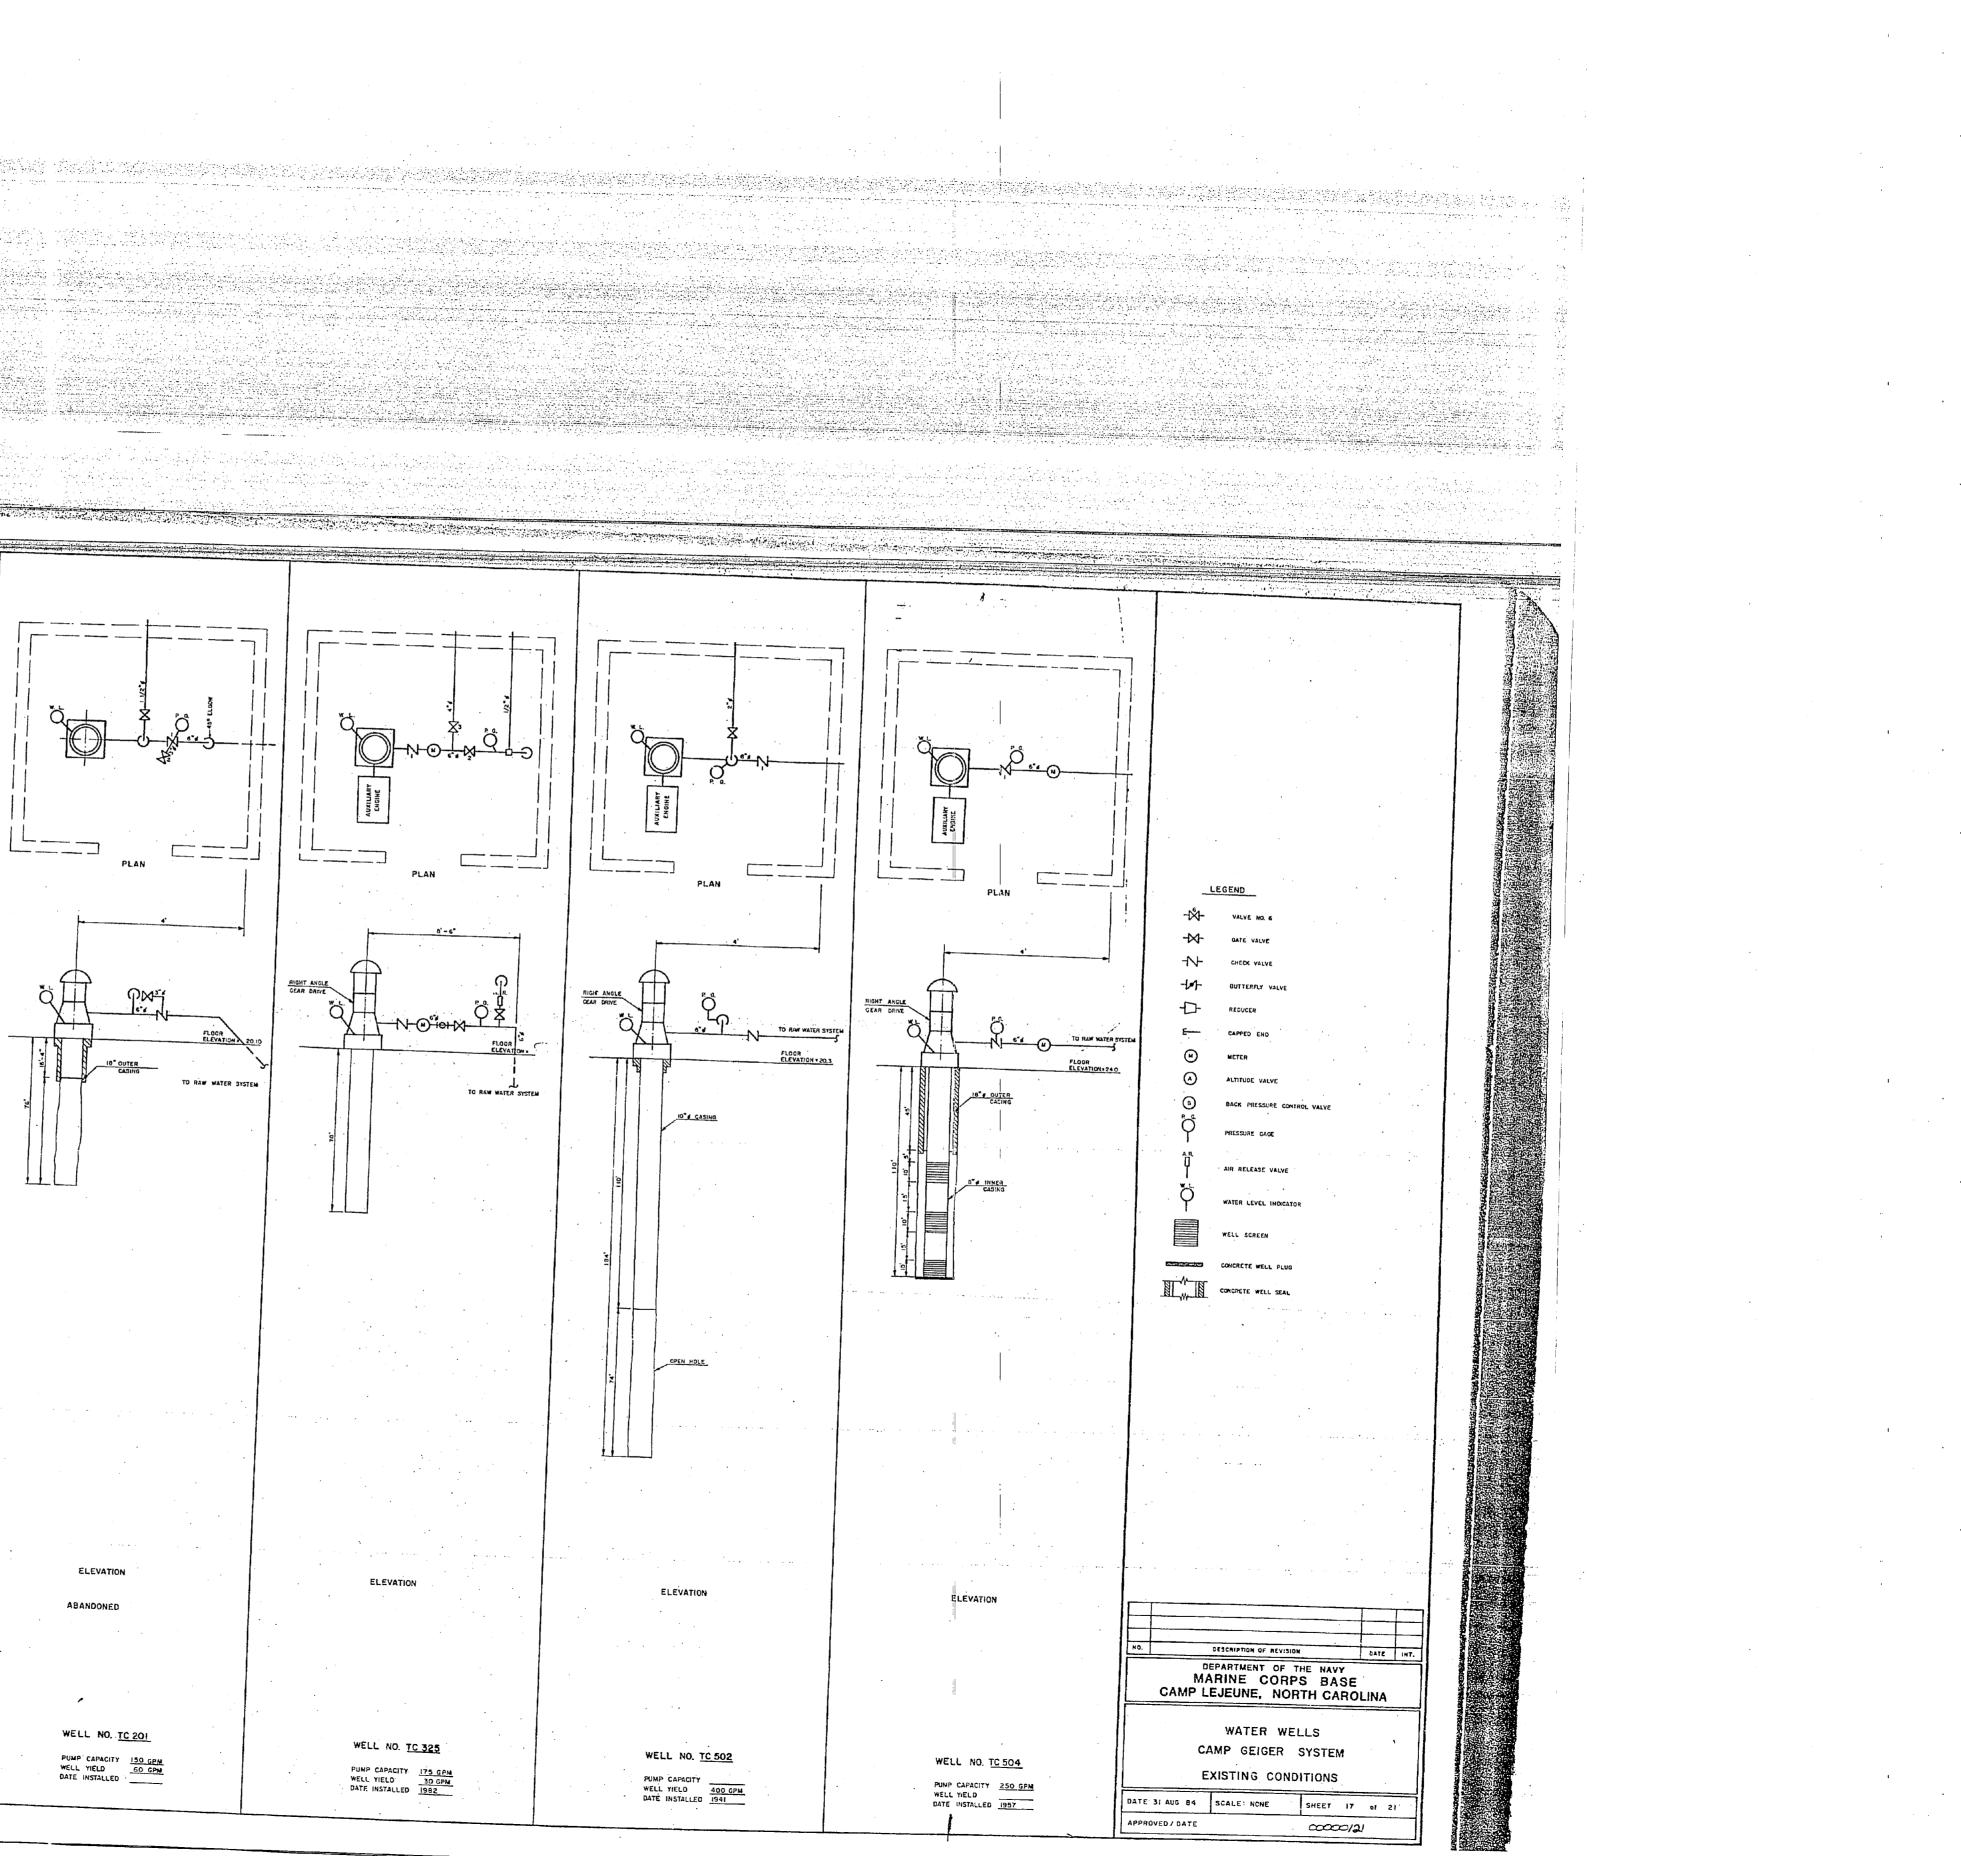


 

. .