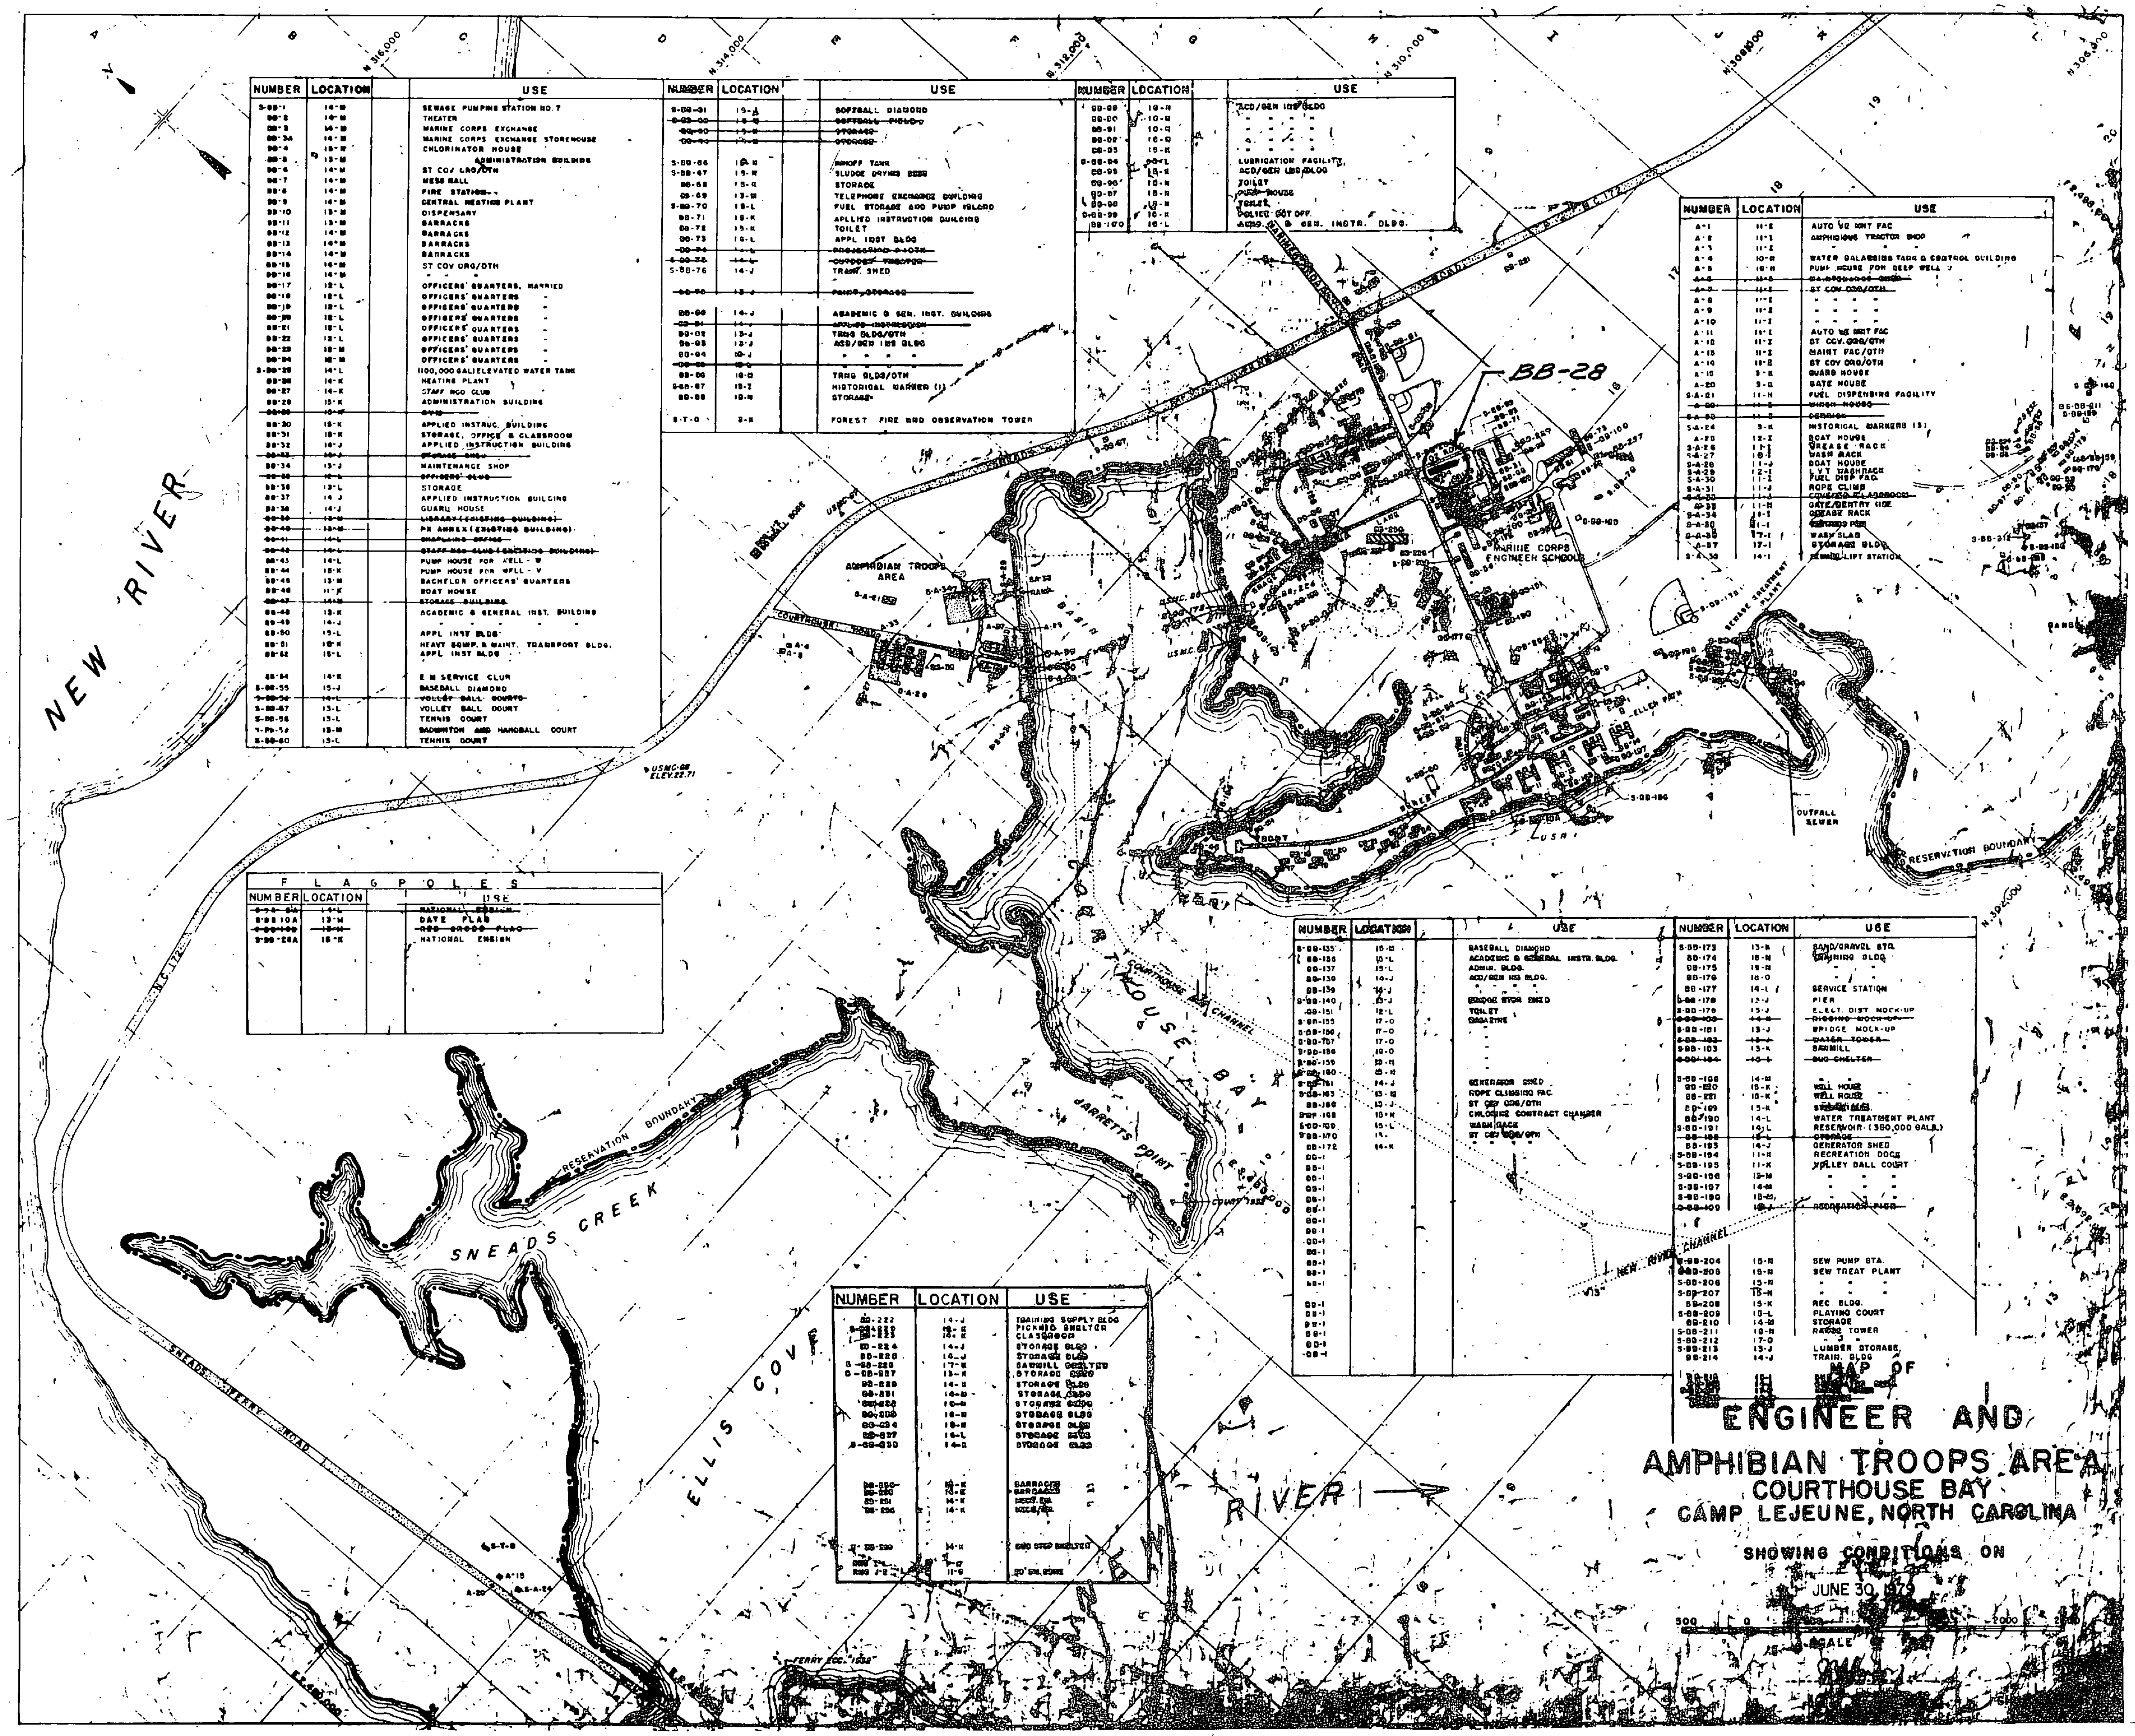

NUMBER	LOCATION		USE
S-BB-1	14-M		SEWAGE PUMPING STATION NO. 7
BB-2	14-M		THEATER
BB-3	14-M		MARINE CORPS EXCHANGE
BB-3A	14-M		MARINE CORPS EXCHANGE STOREHOUSE
BB-4	15-N		CHLORINATOR HOUSE
BB-5	13-M		ADMINISTRATION BUILDING
BB-6	14-M		ST COV ORG/OTH
BB-7	14-M		MESS HALL
BB-8	14-M		FIRE STATION
BB-9	14-M		CENTRAL HEATING PLANT
BB-10	13-M		DISPENSARY
BB-11	13-M		BARRACKS
BB-12	14-M		BARRACKS
BB-13	14-M		BARRACKS
BB-14	14-M		BARRACKS
BB-15	14-M		ST COV ORG/OTH
BB-16	14-M		" "
BB-17	12-L		OFFICERS' QUARTERS, MARRIED
BB-18	12-L		OFFICERS' QUARTERS
BB-19	12-L		OFFICERS' QUARTERS -
BB-20	12-L		OFFICERS' QUARTERS -
BB-21	12-L		OFFICERS' QUARTERS -
BB-22	12-L		OFFICERS' QUARTERS -
BB-23	12-M		OFFICERS' QUARTERS -
BB-24	12-M		OFFICERS' QUARTERS -
S-BB-25	14-L		(100,000 GAL) ELEVATED WATER TANK
BB-26	14-K		HEATING PLANT
BB-27	14-K		STAFF NCO CLUB
BB-28	15-K		ADMINISTRATION BUILDING
~~BB-29~~	~~15-K~~		~~GYM~~
BB-30	15-K		APPLIED INSTRUC. BUILDING
BB-31	15-K		STORAGE, OFFICE & CLASSROOM
BB-32	14-J		APPLIED INSTRUCTION BUILDING
~~BB-33~~	~~14-J~~		~~STORAGE SHED~~
BB-34	13-J		MAINTENANCE SHOP
~~BB-35~~	~~12-L~~		~~OFFICERS' CLUB~~
BB-36	13-L		STORAGE
BB-37	14-J		APPLIED INSTRUCTION BUILDING
BB-38	14-J		GUARD HOUSE
~~BB-39~~	~~13-M~~		~~LIBRARY (EXISTING BUILDING)~~
~~BB-40~~	~~13-M~~		~~PX ANNEX (EXISTING BUILDING)~~
~~BB-41~~	~~14-L~~		~~CHAPLAINS OFFICE~~
~~BB-42~~	~~14-L~~		~~STAFF NCO CLUB (EXISTING BUILDING)~~
BB-43	14-L		PUMP HOUSE FOR WELL - W
BB-44	15-K		PUMP HOUSE FOR WELL - V
BB-45	13-M		BACHELOR OFFICERS' QUARTERS
BB-46	11-K		BOAT HOUSE
~~BB-47~~	~~14-M~~		~~STORAGE BUILDING~~
BB-48	13-K		ACADEMIC & GENERAL INST. BUILDING
BB-49	14-J		" "
BB-50	15-L		APPL INST BLDG
BB-51	15-K		HEAVY EQUIP. & MAINT. TRANSPORT BLDG.
BB-52	15-L		APPL INST BLDG
BB-54	14-K		E M SERVICE CLUB
S-BB-55	15-J		BASEBALL DIAMOND
~~S-BB-56~~	~~14-L~~		~~VOLLEY BALL COURTS~~
S-BB-57	13-L		VOLLEY BALL COURT
S-BB-58	13-L		TENNIS COURT
S-BB-59	13-M		BADMINTON AND HANDBALL COURT
S-BB-60	13-L		TENNIS COURT

NUMBER	LOCATION		USE
S-BB-61	15-A		SOFTBALL DIAMOND
~~S-BB-62~~	~~15-~~		~~SOFTBALL FIELD~~
~~BB-63~~			~~STORAGE~~
~~BB-64~~			~~STORAGE~~
S-BB-66	15-K		RUNOFF TANK
S-BB-67	15-K		SLUDGE DRYING BEDS
BB-68	15-K		STORAGE
BB-69	13-M		TELEPHONE EXCHANGE BUILDING
S-BB-70	15-L		FUEL STORAGE AND PUMP ISLAND
BB-71	15-K		APPLIED INSTRUCTION BUILDING
BB-72	15-K		TOILET
BB-73	15-L		APPL INST BLDG
~~BB-74~~	~~14-L~~		~~PROJECTION BOOTH~~
~~S-BB-75~~	~~14-L~~		~~OUTDOOR THEATER~~
S-BB-76	14-J		TRANS. SHED
~~BB-79~~	~~13-J~~		~~PAINT STORAGE~~
BB-80	14-J		ACADEMIC & GEN. INST. BUILDING
~~BB-81~~	~~14-J~~		~~APPLIED INSTRUCTION~~
BB-82	13-J		TRNG BLDG/OTH
BB-83	13-J		ACD/GEN INS BLDG
BB-84	10-J		" " " "
~~BB-85~~	~~10-~~		
BB-86	16-D		TRNG BLDG/OTH
S-BB-87	19-I		HISTORICAL MARKER (1)
BB-88	19-N		STORAGE
S-T-0	3-K		FOREST FIRE AND OBSERVATION TOWER

NUMBER	LOCATION		USE
BB-89	10-N		ACD/GEN INS BLDG
BB-90	10-N		" "
BB-91	10-N		" "
BB-92	10-N		" "
BB-93	10-N		
S-BB-94	10-L		LUBRICATION FACILITY
BB-95	10-N		ACD/GEN INS BLDG
BB-96	10-N		TOILET
BB-97	10-N		PUMP HOUSE
BB-98	10-N		TOILET
S-BB-99	10-N		POLICE OUT OFF.
BB-100	10-L		ACAD. & GEN. INSTR. BLDG.

NUMBER	LOCATION	USE
A-1	11-I	AUTO VE MNT FAC
A-2	11-I	AMPHIBIOUS TRACTOR SHOP
A-3	11-I	" "
A-4	10-H	WATER BALANCING TANK & CONTROL BUILDING
A-5	10-H	PUMP HOUSE FOR DEEP WELL
~~A-6~~	~~11-I~~	[illegible]
~~A-7~~	~~11-I~~	~~ST COV ORG/OTH~~
A-8	11-I	" " " "
A-9	11-I	" " " "
A-10	11-I	" " " "
A-11	11-I	AUTO VE MNT FAC
A-12	11-I	ST COV ORG/OTH
A-13	11-I	MAINT FAC/OTH
A-14	11-I	ST COV ORG/OTH
A-19	3-K	GUARD HOUSE
A-20	3-K	GATE HOUSE
S-A-21	11-H	FUEL DISPENSING FACILITY
~~A-22~~	~~11-I~~	~~WASH HOUSE~~
~~S-A-23~~	~~11-I~~	[illegible]
S-A-24	3-K	HISTORICAL MARKERS (3)
A-25	12-I	BOAT HOUSE
S-A-26	11-I	GREASE RACK
S-A-27	10-I	WASH RACK
S-A-28	11-J	BOAT HOUSE
S-A-29	12-I	LVT WASHRACK
S-A-30	11-I	FUEL DISP FAC
S-A-31	11-J	ROPE CLIMB
~~S-A-32~~	~~11-J~~	~~COVERED CLASSROOM~~
A-33	11-H	GATE/SENTRY HSE
S-A-34	11-I	GREASE RACK
S-A-35	11-I	[illegible]
S-A-36	17-I	WASH SLAB
A-37	17-I	STORAGE BLDG
S-A-38	14-I	SEWAGE LIFT STATION

FLAGPOLES

NUMBER	LOCATION		USE
~~S-BB-9A~~	~~14-L~~		~~NATIONAL ENSIGN~~
S-BB-10A	13-M		DATE FLAG
~~S-BB-10B~~	~~13-M~~		~~RED CROSS FLAG~~
S-BB-24A	15-K		NATIONAL ENSIGN

NUMBER	LOCATION		USE
S-BB-135	15-N		BASEBALL DIAMOND
BB-136	15-L		ACADEMIC & GENERAL INSTR. BLDG.
BB-137	15-L		ADMIN. BLDG.
BB-138	14-J		ACD/GEN HQ BLDG.
BB-139	14-J		" " " "
S-BB-140	13-J		BRIDGE STOR SHED
BB-151	12-L		TOILET
S-BB-155	17-O		MAGAZINE
S-BB-156	17-O		"
S-BB-157	17-O		"
S-BB-158	18-O		"
S-BB-159	18-N		"
S-BB-160	18-N		
S-BB-161	14-J		GENERATOR SHED
S-BB-163	13-N		ROPE CLIMBING FAC.
BB-166	13-J		ST COV ORG/OTH
S-BB-168	15-N		CHLORINE CONTRACT CHAMBER
S-BB-169	15-L		WASH RACK
S-BB-170	15-		ST COV ORG/OTH
BB-172	14-K		" " " "

NUMBER	LOCATION	USE
S-BB-173	13-K	SAND/GRAVEL STG.
BB-174	18-N	TRAINING BLDG
BB-175	19-N	" "
BB-176	18-O	" "
BB-177	14-L	SERVICE STATION
S-BB-178	13-J	PIER
S-BB-179	15-J	ELECT. DIST MOCK-UP
~~S-BB-180~~	~~14-N~~	~~RIGGING MOCK-UP~~
S-BB-181	13-J	BRIDGE MOCK-UP
~~S-BB-182~~	~~13-J~~	~~WATER TOWER~~
S-BB-183	13-K	SAWMILL
~~S-BB-184~~	~~13-J~~	~~BUS SHELTER~~
S-BB-186	14-M	" "
BB-220	15-K	WELL HOUSE
BB-221	16-K	WELL HOUSE
BB-189	15-K	STORAGE BLDG.
BB-190	14-L	WATER TREATMENT PLANT
S-BB-191	14-L	RESERVOIR (350,000 GALS.)
~~BB-192~~	~~15-L~~	~~STORAGE~~
BB-193	14-J	GENERATOR SHED
S-BB-194	11-K	RECREATION DOCK
S-BB-195	11-K	VOLLEY BALL COURT
S-BB-196	13-M	" " "
S-BB-197	14-M	" " "
S-BB-198	16-M	" " "
~~S-BB-199~~	~~16-J~~	~~RECREATION PIER~~
S-BB-204	16-N	SEW PUMP STA.
S-BB-205	16-N	SEW TREAT PLANT
S-BB-206	15-N	" " "
S-BB-207	15-N	" " "
BB-208	15-K	REC. BLDG.
S-BB-209	16-L	PLAYING COURT
BB-210	14-M	STORAGE
S-BB-211	16-N	RANGE TOWER
S-BB-212	17-O	"
S-BB-213	13-J	LUMBER STORAGE
BB-214	14-J	TRAIN. BLDG

NUMBER	LOCATION	USE
BB-222	14-J	TRAINING SUPPLY BLDG
S-BB-223	16-K	PICNIC SHELTER
BB-223	14-K	CLASSROOM
BB-224	14-J	STORAGE BLDG
BB-225	14-J	STORAGE BLDG
S-BB-226	17-K	SAWMILL SHELTER
S-BB-227	13-K	STORAGE [illegible]
BB-228	14-K	STORAGE BLDG
BB-231	14-M	STORAGE BLDG
BB-232	16-N	STORAGE BLDG
BB-233	16-N	STORAGE BLDG
BB-234	16-N	STORAGE BLDG
BB-237	16-L	STORAGE BLDG
S-BB-230	14-K	STORAGE BLDG
BB-250	16-K	BARRACKS
BB-250	16-K	BARRACKS
BB-251	14-K	MESS HALL
BB-256	14-K	MESS HALL
S-BB-239	14-K	BUS STOP SHELTER
RBS J-1	11-F	
RBS J-2	11-G	20' STL CONE

P-624 UEPH (RELOCATION OF AIR CONDITIONING FOR EXISTING BUILDINGS)
SHEET 2 OF 2 12/13/83 [illegible]