

UNITED STATES MARINE CORPS

Marine Corp Base

Camp Lejeune, North Carolina 28542-5000

6280 FAC 2 3 OCT 1984

From: Assistant Chief of Staff, Facilities, Marine Corps Base,

Camp Lejeune

To: Public Works Officer

Subj: ENVIRONMENTAL REVIEW OF REVISED SITE LOCATION, P-808, OF-35

MECHANICS SCHOOL, INCR 1

Encl: (1) Preliminary Environmental Assessment, P-808 dtd 13 Jan 82

(2) Revised Site Location Map


- 1. The environmental impacts associated with construction of the project at the site described in enclosure (1) are similar to the impacts at the site in enclosure (2). The primary environmental concerns to be addressed in project planning and design are the erosion controls and storm water runoff and drainage due to the limited natural drainage of the site. Further, the harvesting of commercially valuable timber from the site must be scheduled upon receipt of the 35% design drawings.
- 2. In summary, no significant environmental impact is anticipated with the revised site location provided a State-approved sediment control plan is obtained and the timber harvest is pursued. Request that upon receipt of the 35% drawings, coordination be completed with Mr. Julian Wooten, Natural Resources and Environmental Affairs Division, ext. 5003/2195, on the timber harvest.


3. Point of contact in this matter is Mr. Alexander at ext. 3034.

J. C. FITZUERA

By direction

Copy to:

 

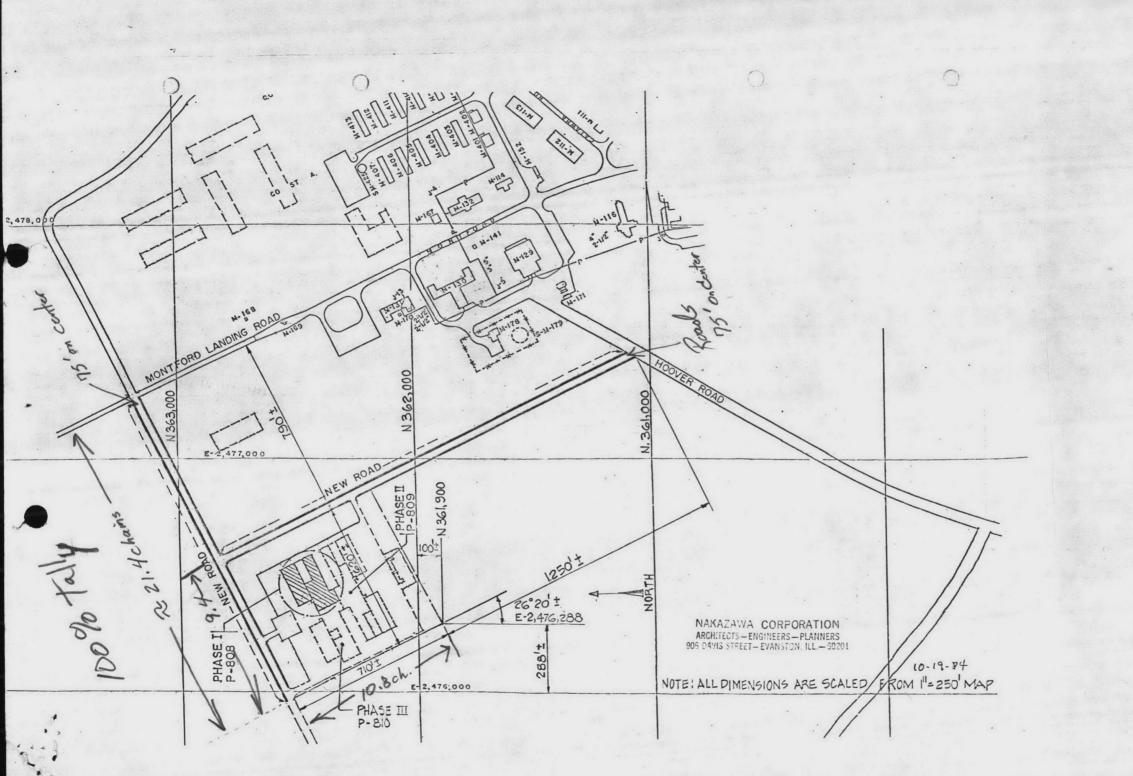



