

FLOORS	42. BASEMENT	43. FIRST FLOOR	44. SECOND FLOOR	45. THIRD FLOOR	46. FOURTH FLOOR	47. FIFTH FLOOR
(a) LIVE LOAD (Lbs. per sq. ft.)		600				
(b) MATERIAL CODE		JJ				
(c) SQ. FT. FLOOR		156				

48. MAJOR CONSTRUCTION BY

(a) CONTRACT NO. <b>NOY 4750</b>	(b) TYPE OF CONTRACT <b>Fixed Fee</b>	(c) YARD LABOR J. O. NO. <b>None</b>	(d) SPECIFICATION NO. <b>405</b>	(e) YARDS AND DOCKS DR <b>162153, 162154, 228696</b>
(f) CONTRACTOR (Name) <b>Goode Const. Co., Hlythe Bros., Harrison Wright, Charlotte, N.C.</b>				

49. MISCELLANEOUS

(a) HEATING SYSTEM FUEL: <b>None</b> TYPE: <b>None</b>	(b) ELECTRICAL CURRENT VOLTS: <b>208</b> PHASES: <b>3</b> CYCLES: <b>60</b>	(c) HOT WATER STORAGE CAP. (Gals.) FUEL: <b>None</b>	(d) CRANES NO. OF IDENTIFICATION NO. <b>None</b>	TON CAPACITY	(e) ELEVATORS NO. OF IDENTIFICATION NO. <b>None</b>
(f) SPRINKLER SYSTEM YES <input type="checkbox"/> NO <input checked="" type="checkbox"/>	(g) TELEPHONE SYSTEM YES <input type="checkbox"/> NO <input checked="" type="checkbox"/>	50. DESIGN <b>None</b>		(a) COST <b>None</b>	(b) CONTRACT NO. <b>None</b>

51. ACQUISITION INFORMATION

(a) DATE	(b) METHOD	(Code)	(c) APPROPRIATION	(d) PROJECT NUMBER
----------	------------	--------	-------------------	--------------------

52. DISPOSITION INFORMATION

(a) DISPOSED OF TO:	(b) DISPOSAL NO.	(c) METHOD	(Code)	(d) DATE DISPOSED OF	(e) COST
---------------------	------------------	------------	--------	----------------------	----------

53. NET CHANGE ON CANCELLED CARDS

(a) REASON FOR CANCELLATION	(b) CODE	(c) NEW CARD NO.	(e) NET CHANGE COST TO GOVERNMENT	(f) APPROPRIATION AND PROJ.
	<input type="checkbox"/> CORR.	(d) FORM NO.	<input type="checkbox"/> INCR. \$ _____ <input type="checkbox"/> DECR. \$ _____	
	<input type="checkbox"/> CAP. IMPR.			

54. BUILDING TITLE  
**Sewage Pumping Station**

Marine Corps Base		Camp Lejeune		LIEBLOW		No. 12		STREPS		CORREC				
1. ACTIVITY			2. CITY			3. COUNTY			4. STATE/COUNTRY			5. COMPONENT		
6. ACCTG. NO.	7. MGMT. BUREAU (Code)	8. FIN. BUREAU (Code)	9. STATE	10. CO.	11. CITY	12. DATE PREPARED	13. DIST.	14. ACTIVITY CODE	15					
67001	USMC	9	32	133	735	8 Nov 60	M-05	8270-175	2					
16. BUILT ON LAND (Type of ownership)			(Land category code)	17. YEAR BUILT	18. EST. LIFE	19. TYPE OF CONSTRUCTION			20. CONDITION					
<input checked="" type="checkbox"/> OWNED <input type="checkbox"/> IN-LEASED OR OTHER			911 40	1942	50	PERM. <input checked="" type="checkbox"/> S <input type="checkbox"/> T <input type="checkbox"/>	USABLE			<input checked="" type="checkbox"/> U <input type="checkbox"/> T <input type="checkbox"/> R <input type="checkbox"/> C				
21. BUILDING NUMBER	22. ELEVATION (1st floor)	23. MAP GRID NO.			24. VOL. CU. FT.	25. COST PER CU. FT.	26. TOTAL CO							
46	17.45 5	8-I Page 26 <sup>16</sup> / <sub>20</sub>			1,716	.9312	\$1,59							
27. DESCRIPTION			28. NAVY CODE	29. AREA MEASURE		30. SQ. FT. NOT IN USE	31. OTHER MEASURE		32. CAPACITY					
(a) PRI. USE <b>Sewage Pumping Sta</b>			832 30	QUANTITY	(Sym)	None	QUANTITY (Sym)		QUANTITY					
(b) SEC. USE														
(c) TER. USE														
(d) OTHER USE														
34. DIMENSIONS				33. TOTAL AREA		TOTAL SQ. FT. NOT IN USE	35. ROOF TYPE							
LINE	(a) LENGTH (ft.)	(b) WIDTH (ft.)	(c) HEIGHT (ft.)	(d) NO. OF STORIES	156	None	Lean-to							
1.	13	12	11	1										
2.														
3.														
4.														
5.														
36. MATERIAL CODES				37. IN PROCESS OF DISPOSAL DATE		38. DATE REPORTED TO GSA	39. DATE DETERMINED SURPLUS		40. SURVEY OF DATE					
(a) FOUNDATIONS <b>JJP</b>				(b) EXTERIOR WALLS <b>J</b>		(c) ROOF <b>CJ</b>								
41. TYPE OF ACTION				REMARKS: <b>Add to Cost of Bldg. (2) Pumps Sewer, dropped Class 3 on PAO Vou# 424, Oct 61, Total Cost \$960.00.</b>										
<input type="checkbox"/> 1. ACQUISITION <input type="checkbox"/> 3. CANCELLATION														
<input checked="" type="checkbox"/> 2. CORRECTION <input type="checkbox"/> 4. DISPOSITION				CLASS 2 PAO VOU# 18 Oct 61										

BUILDING CARD - NAVCOMPT FORM 277 (5 PT) (REV. 8-57) - COMPLETE REVERSE SIDE AS NECESSARY  
Sewage Pumping Station

Rtd. No. 16

FLOORS →	42. BASEMENT	43. FIRST FLOOR	44. SECOND FLOOR	45. THIRD FLOOR	46. FOURTH FLOOR	47. FIFTH FLOOR
(a) LIVE LOAD (Lbs. per sq. ft.)		600				
(b) MATERIAL CODE		JJ				
(c) SQ. FT. FLOOR		156				

48. MAJOR CONSTRUCTION BY

(a) CONTRACT NO. <b>NOY 4790</b>	(b) TYPE OF CONTRACT <b>Fixed Fee</b>	(c) YARD LABOR J. O. NO. <b>None</b>	(d) SPECIFICATION NO. <b>405</b>	(e) YARDS AND DOCKS DRAWING NO. <b>162153, 162154, 228696</b>
(f) CONTRACTOR (Name) <b>Goode Const. Co., Elythe Bros., Harrison Wright, Charlotte, N.C.</b>		(City)	(State)	

49. MISCELLANEOUS

(a) HEATING SYSTEM FUEL: <b>None</b> TYPE: <b>None</b>	(b) ELECTRICAL CURRENT VOLTS: <b>208</b> PHASES: <b>3</b> CYCLES: <b>60</b>	(c) HOT WATER FUEL: <b>None</b> STORAGE CAP. (Gals.): <b>None</b>	(d) CRANES NO. OF: <b>None</b> IDENTIFICATION NO.: <b>None</b> TON CAPACITY: <b>None</b>	(e) ELEVATORS NO. OF: <b>None</b> IDENTIFICATION NO.: <b>None</b>
(f) SPRINKLER SYSTEM YES <input type="checkbox"/> NO <input checked="" type="checkbox"/>	(g) TELEPHONE SYSTEM YES <input type="checkbox"/> NO <input checked="" type="checkbox"/>	50. DESIGN	(a) COST <b>None</b>	(b) CONTRACT NO. <b>None</b>

51. ACQUISITION INFORMATION

(a) DATE	(b) METHOD	(Code)	(c) APPROPRIATION	(d) PROJECT NUMBER
----------	------------	--------	-------------------	--------------------

52. DISPOSITION INFORMATION

(b) DISPOSED OF TO:	(b) DISPOSAL NO.	(c) METHOD	(Code)	(d) DATE DISPOSED OF	(e) CON
---------------------	------------------	------------	--------	----------------------	---------

53. NET CHANGE ON CANCELLED CARDS

(a) REASON FOR CANCELLATION	(b) CODE <input type="checkbox"/> CORR. <input type="checkbox"/> CAP. IMPR.	(c) NEW CARD NO.	(e) NET CHANGE COST TO GOVERNMENT <input type="checkbox"/> INCR. \$ _____ <input type="checkbox"/> DECR. \$ _____	(f) APPROPRIATION AND PROJ
	(d) FORM NO.			

54. BUILDING TITLE  
**Sewage Pumping Station**


Marine Corps Base		Camp Lejeune		Onslow		N.C.		NORC		
1. ACTIVITY		2. CITY		3. COUNTY		4. STATE/COUNTRY		5. COMPONENT		
6. ACOTG. NO.	7. MGMT. BUREAU (Code)	8. FIN. BUREAU (Code)	9. STATE	10. CO.	11. CITY	12. DATE PREPARED	13. DIST.	14. ACTIVITY CODE	15.	
67001	USMC	9	32	133	735	8 Nov 60	H-05	8270-175	2	
16. BUILT ON LAND (Type of ownership)		(Land category code)	17. YEAR BUILT	18. EST. LIFE	19. TYPE OF CONSTRUCTION			20. CONDITION		
<input checked="" type="checkbox"/> OWNED <input type="checkbox"/> IN-LEASED OR OTHER		911 40	1942	50	PERM. <input checked="" type="checkbox"/> SEMI. <input type="checkbox"/> TEMP. <input type="checkbox"/>	USABLE <input checked="" type="checkbox"/> T <input type="checkbox"/> R <input type="checkbox"/> C <input type="checkbox"/>				
21. BUILDING NUMBER	22. ELEVATION (1st floor)	23. MAP GRID NO.		24. VOL. CU. FT.	25. COST PER CU. FT.	26. TOTAL CO				
46	17.45	8-K Page 24		1,716	.9312	\$1,59				
27. DESCRIPTION			28. NAVY CODE	29. AREA MEASURE	30. SQ. FT. NOT IN USE	31. OTHER MEASURE		32. CAPACITY		
(a) PRI. USE Sewage Pumping Sta			832 30	QUANTITY (Sym) 156	None	QUANTITY (Sym)		QUANTITY		
(b) SEC. USE										
(c) TER. USE										
(d) OTHER USE										
34. DIMENSIONS			33. TOTAL AREA		TOTAL SQ. FT. NOT IN USE	35. ROOF TYPE				
LINE (a) LENGTH (ft.) (b) WIDTH (ft.) (c) HEIGHT (ft.) (d) NO. OF STORIES			156		None	Lean-to				
1.	13	12	11	1	36. MATERIAL CODES					
2.					(a) FOUNDATIONS JJP	(b) EXTERIOR WALLS J	(c) ROOF CJ			
3.					37. IN PROCESS OF DISPOSAL DATE		38. DATE REPORTED TO GSA	39. DATE DETERMINED SURPLUS	40. SURVEY OF DATE	
4.					REMARKS: Add to Cost of Bldg. (2) Pumps Sewer, dropped Class 3 on PAO Vouf 424 Oct 61, Total Cost \$980.00.					
5.					CLASS 2 PAO VOU# 18 Oct 61					
41. TYPE OF ACTION										
<input type="checkbox"/> 1. ACQUISITION <input type="checkbox"/> 3. CANCELLATION										
<input checked="" type="checkbox"/> 2. CORRECTION <input type="checkbox"/> 4. DISPOSITION										

**PROPERTY RECORD CARD (For Buildings Only)**  
 NAV. S. AND A. FORM 277 (Rev. Jan. 1946 Replaces S. and A. Form 277 Dated Feb. 1942 and Navdocks 115 Revised.)

ACTIVITY NAME AND LOCATION: Marine Barracks, Camp Lejeune, N.C.  
 ACCOUNTING NO. \_\_\_\_\_ DATE OF CARD: 10 July 1, 50

Revised for Bureau Use **A**

IDENTIFICATION \_\_\_\_\_ BLDG. NO. \_\_\_\_\_ USE OF BUILDING \_\_\_\_\_

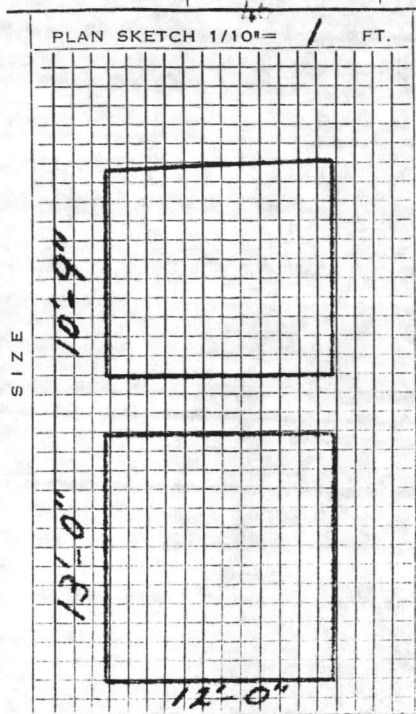

CONSTRUCTION	ITEMS		MATERIAL CODE	
	FOUNDATION			
EXTERIOR WALLS	THICKNESS			
	"			
ROOF				
FLOORS	NO.	LIVE LOAD (LB/SF)	FL. AREA (SQ. FT.)	MAT. CODE
	B			
	1			
	2			

CARD NUMBER \_\_\_\_\_  
 EXPENSE GROUP \_\_\_\_\_  
 TOTAL COST \$ \_\_\_\_\_  
 YEAR BUILT \_\_\_\_\_  
 ESTIMATED LIFE \_\_\_\_\_  
 MONTHLY DEPR'N \$ \_\_\_\_\_  
 YR. FULLY DEPR'D \_\_\_\_\_  
 ANNUAL MAINT. \$ 50

LENGTH (FT.)	WIDTH (FT.)	HEIGHT TO		NO. OF STORES
		EAVES	RIDGE	
<u>13'</u>	<u>12'</u>	<u>11'-0"</u>	<u>11'-3"</u>	<u>1</u>

CAPACITY \_\_\_\_\_  
 TOTAL GROSS FLOOR ARE \_\_\_\_\_  
 TOTAL GROSS CUBIC VOLU \_\_\_\_\_  
 TEMPORARY \_\_\_\_\_  
 PERMANENT \_\_\_\_\_  
 LEASED \_\_\_\_\_ TO \_\_\_\_\_  
 SURVEYED DATE \_\_\_\_\_

MISCELLANEOUS	HEATING SYSTEM		ELECTRICAL CURRENT			SPRINKLER S
	FUEL	TYPE	VOLTS	PHASES	CYCLES	
	HOT WATER		*NO. OF CRANES	NO. OF ELEVATORS		OTHER
	FUEL	STORAGE CAPACITY			TELEPHONE: YES	

MAJOR CONSTRUCTION BY	FIXED FEE NO.	LUMP SUM NO.	YARD LABOR-JOB ORDER NO.	DATE CONSTR
	SPECIFICATION NO.	Y & D DRAWING NOS.		DATE CONSTR
	CONTRACTOR AND ADDRESS (City and State)			

METHOD OF ACQUISITION AND DATE (If acquired other than by construction.)

PURCHASED
  TRANSFERRED TO NAVY
  OTHER (Specify)

REMARKS:

\* FOR INFORMATION PURPOSES ONLY (Do not include in cost of building reported on front side hereof.)